

# O.D.O.T. DISTRICT 2 SURVEY OFFICE (USE ONLY)

PERSONNEL

REFERENCE NO. 31

SHEET 26 OF 34

NOTES PRESTON-COLVIN

H.C. NEISE

R.C. PRESTON-COLVIN

DATE 11/26/24

WEATHER WINDY

TEMP. 40°

ROUTE SR 281

COUNTY HENRY

TOWNSHIP RICHFIELD

SECTION 28

DWG BY PRESTON-COLVIN PID PAVING TRAIN

T 4 N R 8 E

TYPE MONUMENT MAG/WASHER

~~ON SURFACE~~ - BELOW ON

OFFSET  $\odot$  PAVEMENT 1.7' ~~LT~~ : RT

- TO - EDGE PAVEMENT

STATION: 787+93

HORZ.DATUM: NAD83 2011


GEOID: 18

GRID: NORTHING: 592437.952

EASTING: 1572551.483


LDP: NORTHING: 449565.4

EASTING: 207808.7

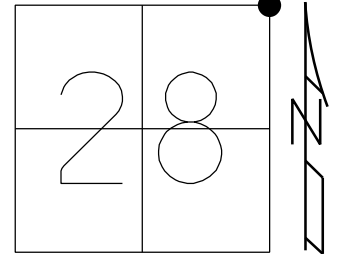

RECORD:  
R.R.SPIKE SET  
BY COUNTY ENG  
FD MAG/WASHER  
9/16/02, DCH  
SET MAG/WASHER  
11/21/02, MB  
FD MAG/WASHER  
7/11/12, MC  
FD MAG/WASHER  
REF17  
5/10/17, JFO  
SET MAG/WASHER  
9/22/17, JFO  
FD MAG/WASHER  
1/11/23, JMR  
FD MAG/WASHER  
REF31  
7/24/24, JAM  
FD MAG/WASHER  
11/26/24, TDN

NOT: REF 17 SR 65

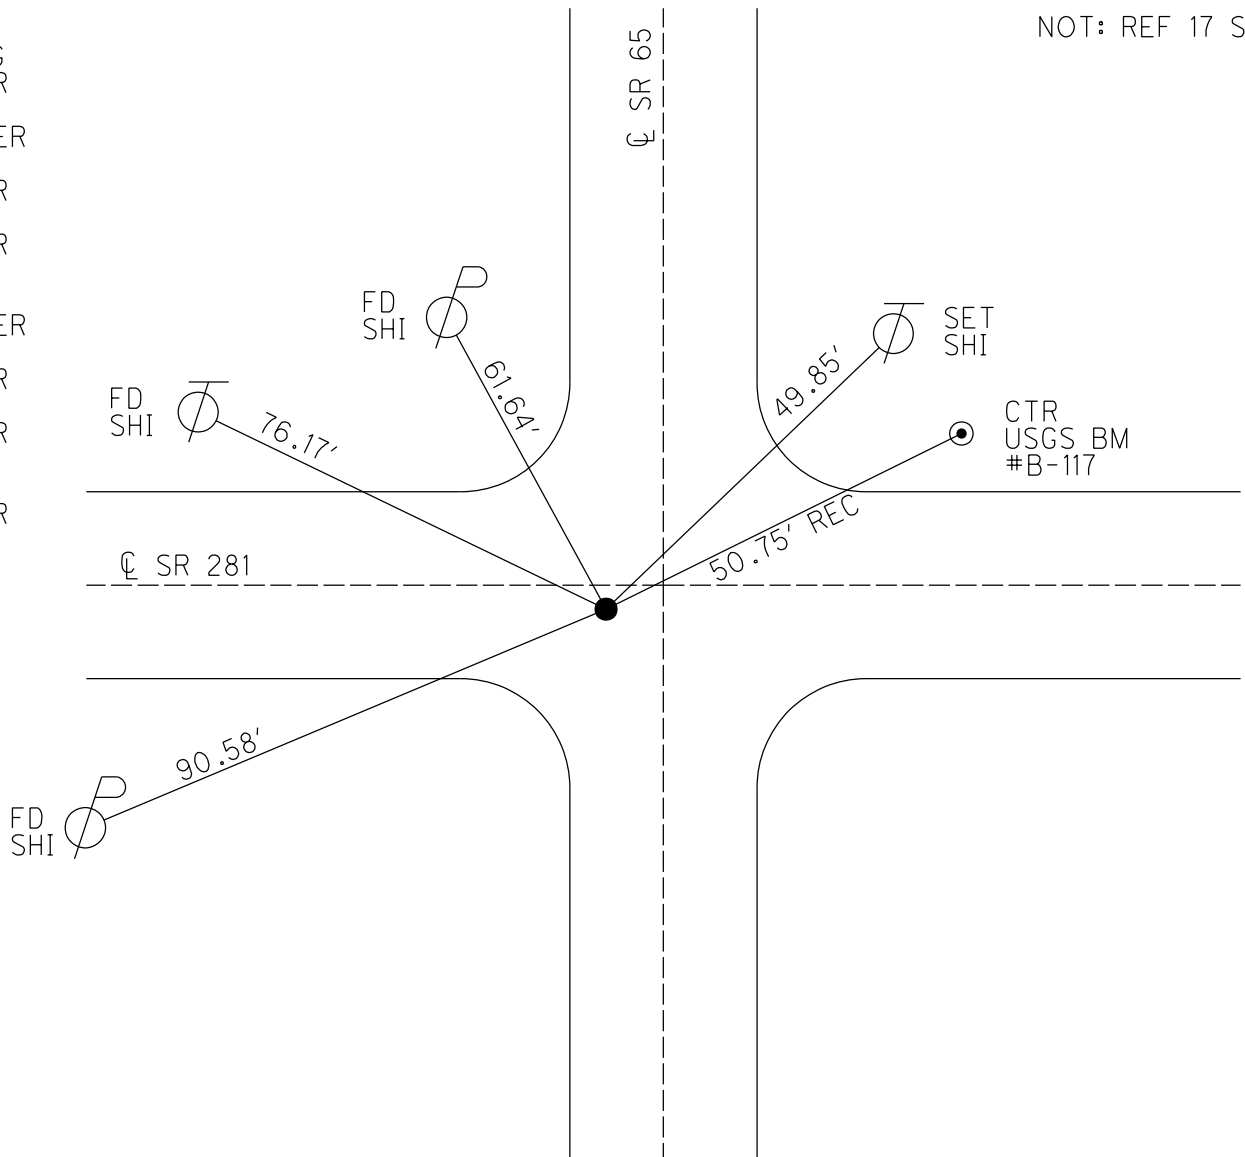

O.D.O.T. DISTRICT 2 SURVEY OFFICE (USE ONLY)

PERSONNEL

REFERENCE NO. 31

SHEET 26 OF 34

NOTES RHOADES

DATE 5/8/17

ROUTE SR 281

H.C. O'DONNELL

WEATHER SUNNY

COUNTY HENRY

R.C. RHOADES

TEMP. 44°

TOWNSHIP RICHFIELD

DWG BY NIESE

PID PAVETRAIN

SECTION 28

T 4 N R 8 E

TYPE MONUMENT MAG/WASHER

ON SURFACE - ~~BELOW~~ ON

OFFSET CL PAVEMENT 1.7' ~~LT~~ : RT

- TO - EDGE PAVEMENT


STATION: 787+93

HORIZ.DATUM: NAD83(2011)


GEOID: 2012A

GRID: NORTHING: 592437.952

EASTING: 1572551.483

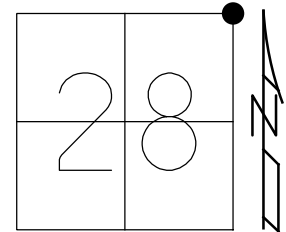

NOT: REF 17 SR 65

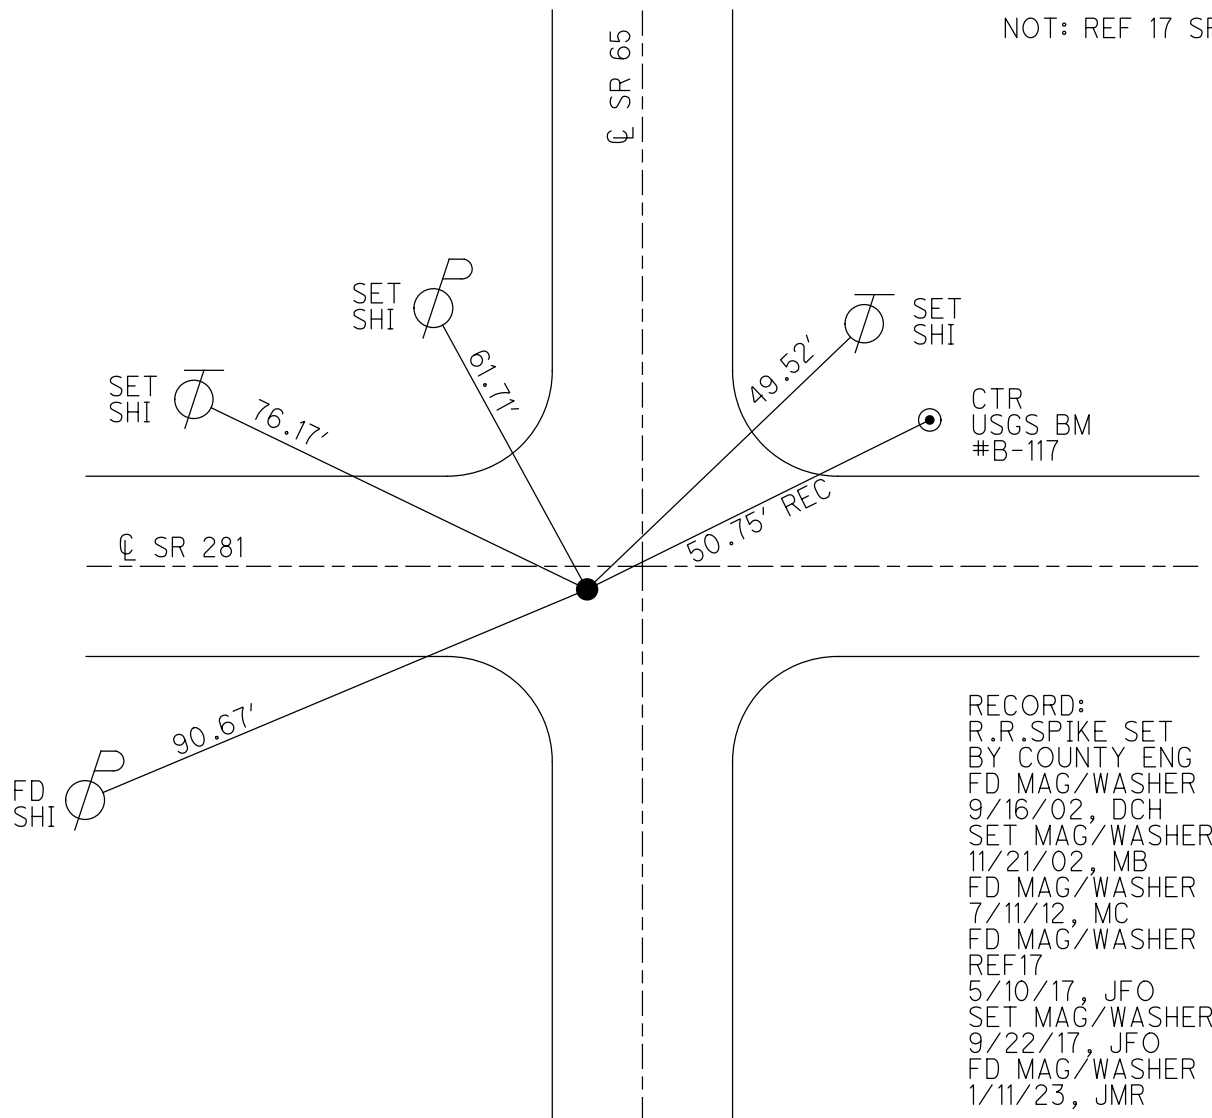

RECORD:  
R.R.SPIKE SET  
BY COUNTY ENG  
FD MAG/WASHER  
9/16/02, DCH  
SET MAG/WASHER  
11/21/02, MB  
FD MAG/WASHER  
7/11/12, MC  
FD MAG/WASHER  
REF17  
5/10/17, JFO  
SET MAG/WASHER  
9/22/17, JFO  
FD MAG/WASHER  
1/11/23, JMR

O.D.O.T. DISTRICT 2 SURVEY OFFICE (USE ONLY)

PERSONNEL

REFERENCE NO. 31

SHEET 26 OF 34

NOTES RHOADES

DATE 5/8/17

ROUTE SR 281

H.C. O'DONNELL

WEATHER SUNNY

COUNTY HENRY

R.C. RHOADES

TEMP. 44°

TOWNSHIP RICHFIELD

SECTION 28

DWG BY NIESE

PID CHIP\_2

T 4 N R 8 E

TYPE MONUMENT MAG/WASHER

ON SURFACE - ~~BELOW~~ ON

OFFSET CL PAVEMENT 1.7' LT : RT

- TO - EDGE PAVEMENT


STATION: 787+93

HORZ.DATUM: NAD83(2011)


GEOID: 2012A

GRID: NORTHING: 592437.952

EASTING: 1572551.483

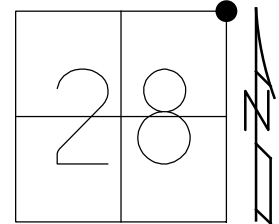

NOT: REF 17 SR 65

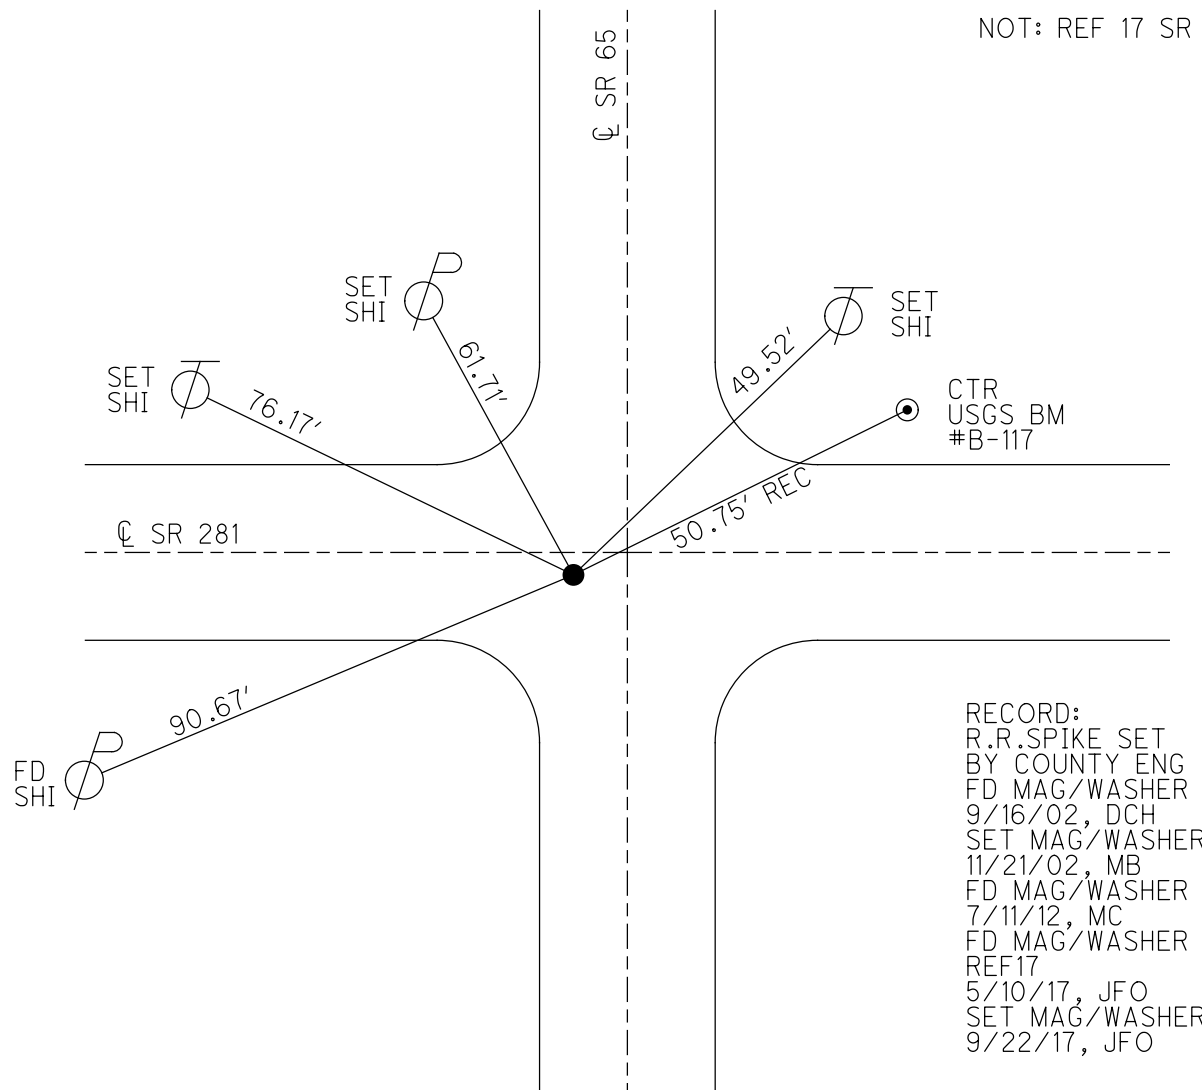

RECORD:  
R.R.SPIKE SET  
BY COUNTY ENG  
FD MAG/WASHER  
9/16/02, DCH  
SET MAG/WASHER  
11/21/02, MB  
FD MAG/WASHER  
7/11/12, MC  
FD MAG/WASHER  
REF17  
5/10/17, JFO  
SET MAG/WASHER  
9/22/17, JFO

# O.D.O.T. DISTRICT 2 SURVEY OFFICE

PERSONNEL

REFERENCE NO. 31

SHEET 27 OF 34

NOTES Canterbury

H.C. Rousos

R.C. Nuffer

DATE 6-2-98

WEATHER SUNNY

TEMP. +70°F

ROUTE SR 281

COUNTY Henry

TOWNSHIP Richfield

SECTION 21, 22, 28, 27

T 4 N R 8 E

TYPE MONUMENT PK & WASHER

ON SURFACE - ~~BELOW~~ Surface

LEFT - CL PAV'T. - RIGHT 3.0' R+ SR 281


TO EDGE PAVEMENT

S.L.M. 24+00 2.35 SLK (787+9285 SLK)

|    |    |
|----|----|
| 21 | 22 |
| 28 | 27 |



Not COVERED

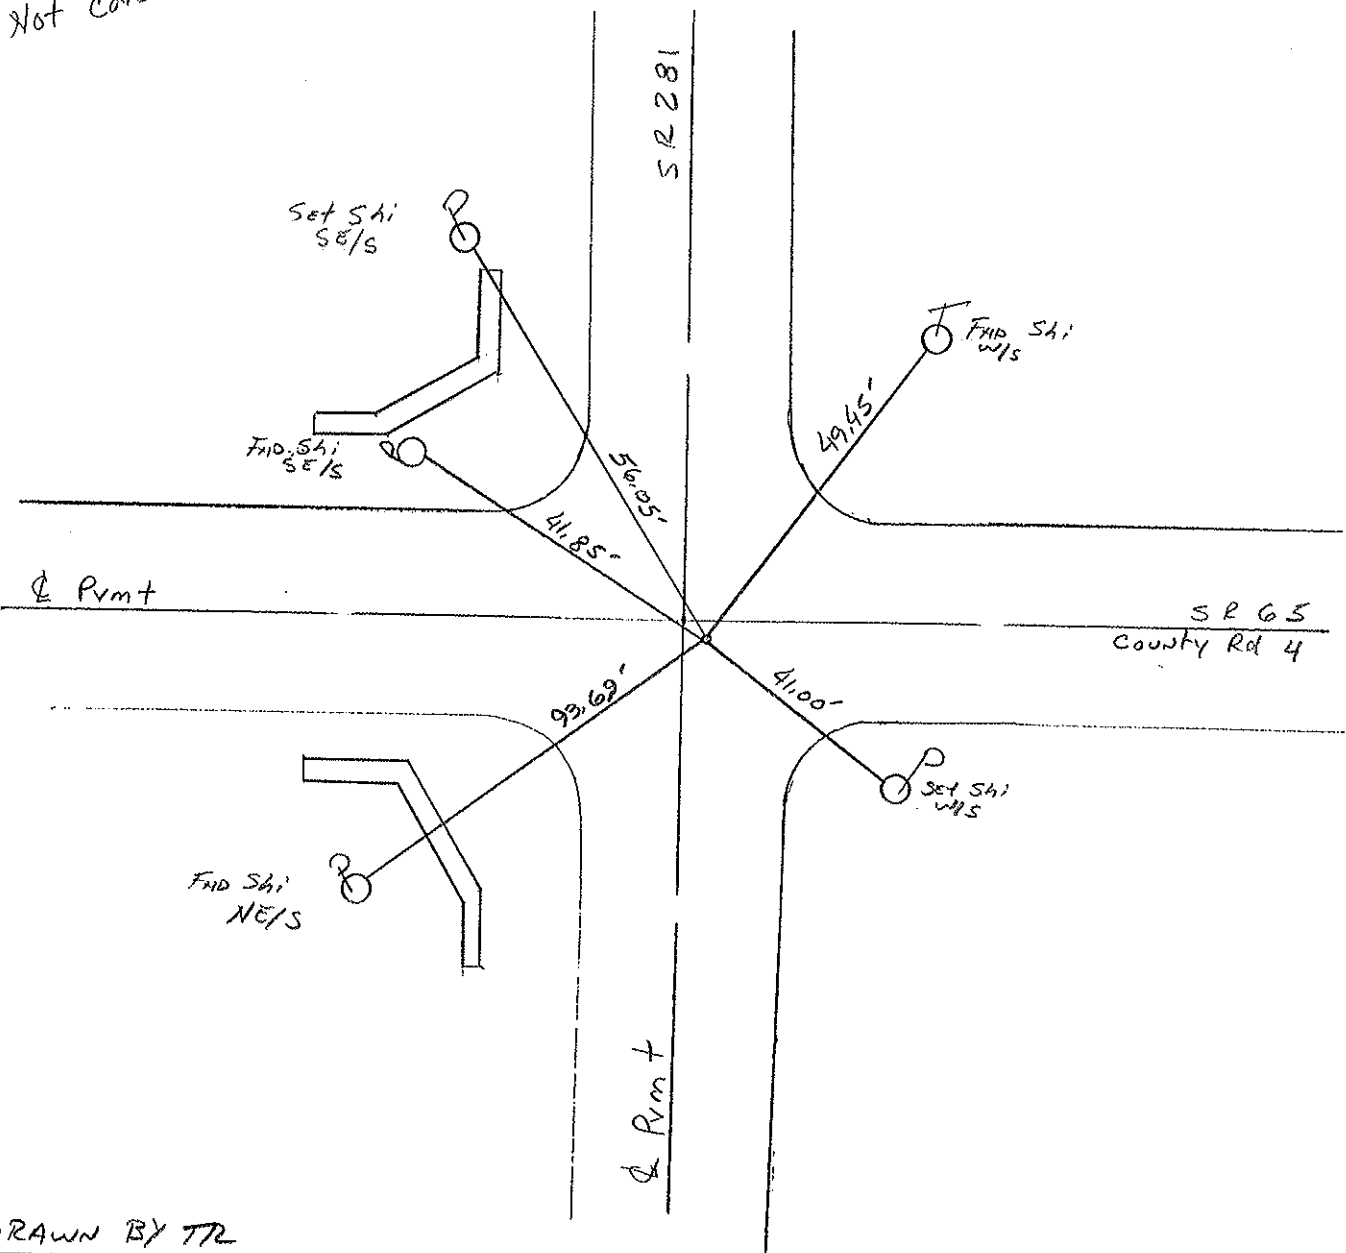

DRAWN BY TL

# O.D.O.T. DISTRICT 2 SURVEY OFFICE

PERSONNEL

NOTES BARNHISEL

H.C. " " "

R.C. HOFFMAN

REFERENCE NO. 17 SR 65 SHEET 18 OF 18  
31 SR 281

DATE 4-11-90

WEATHER SUNNY

TEMP. +35°

ROUTE 65

COUNTY HENRY

TOWNSHIP Richfield

SECTION 28

T. 4 N. R B E


TYPE MONUMENT P.K. & Washer

ON SURFACE - BELOW yes


LEFT - 0 PAV'T. - RIGHT 3.2

- TO - EDGE PAVEMENT 1.7 S. OF E SR 281

S.L.M. 423 + 56

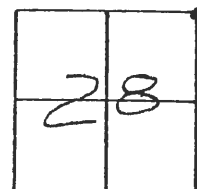

Not Covered  
10-13-93

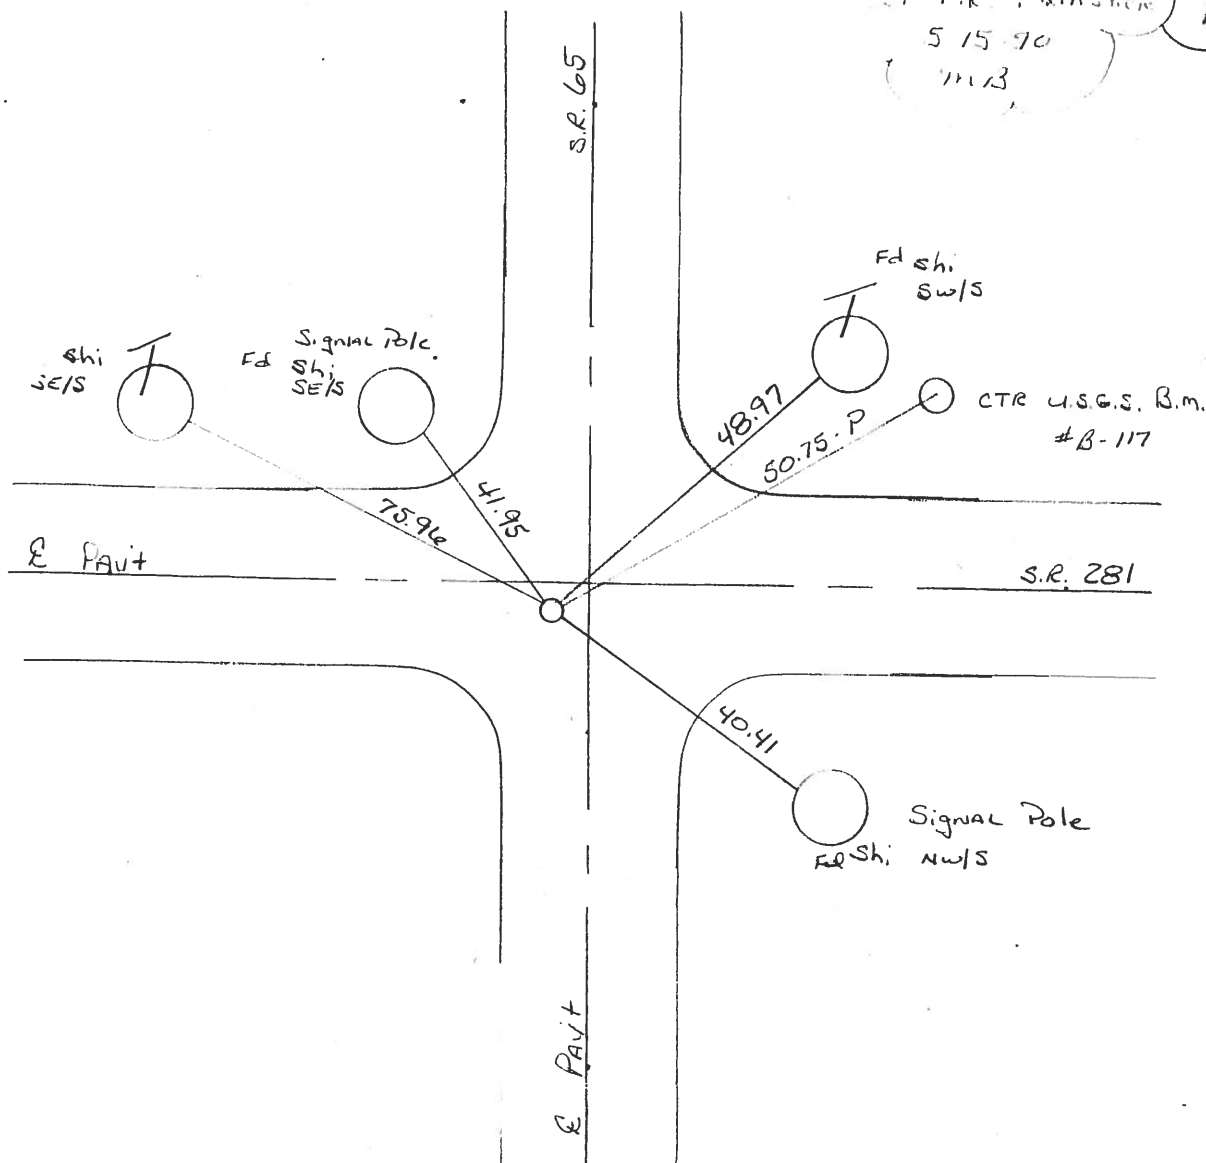


COUNTY HENRY

SHEET 1 OF 2  
T-4-N, R-8-E

TOWNSHIP RICHFIELD

SECTION 27

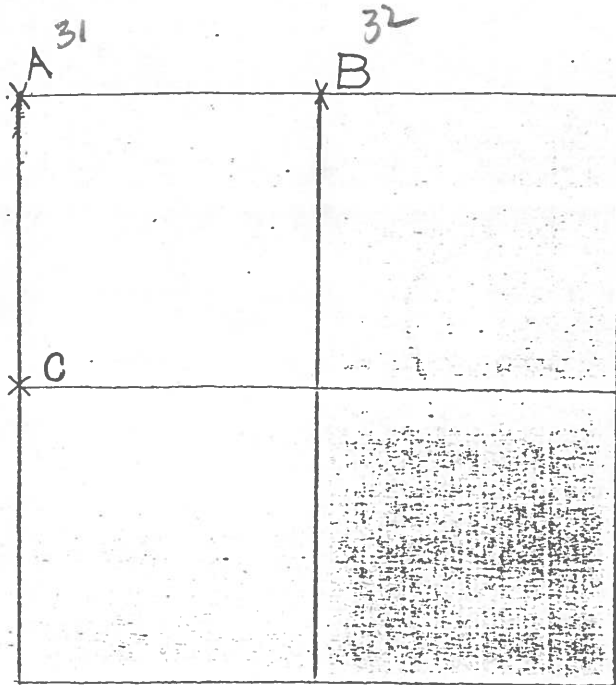

7-26-79 R.W. J.J. G.M.

A-- FOUND RECORDED IRON PIPE OVER  
IRON PIN. NO STONE COULD BE  
LOCATED. REPLACED IRON PIPE IN  
ORIGINAL POSITION. P.K.'S 6 N&W.  
56.30' N.W. TO DUPLEX  $\frac{SE}{S}$  I  
29.88' N.W. TO "+" TOP NORTH END HDWL.  
49.04' N.E. TO SHINER  $\frac{SW}{S}$  I  
50.75' N.E. TO CTR. U.S.G.S. B.M. \*B-11  
28.68' S.W. TO "+" TOP SOUTH END HDWL

12-21-79 R.W. C.S.

B- CORNER IS LOST. RE-ESTABLISHED  $N\frac{1}{4}$  POST MIDWAY  
BETWEEN AND IN LINE WITH THE N.E. COR. AND N.W. COR.  
OF SEC. 27. PLACED  $\frac{5}{8}$ " x 8" IRON PIN @  $N\frac{1}{4}$  POST.  
P.K.'S 15' N.E. & N.W. STONE IS 8.0' SOUTH OF SOUTH EDGE  
OF 20' PAVEMENT.  
43.55' N.N.E. TO "+" TOP EAST END CONC. HEADWALL (PLUMBED)  
52.81' N.N.E. TO DUPLEX  $\frac{S}{S}$  I (PLUMBED)  
19.72' S.E. TO  $\frac{5}{8}$ " x 30" IRON PIN ON DITCH BANK  
22.02' S.W. TO  $\frac{5}{8}$ " x 30" IRON PIN ON DITCH BANK

| PERSONNEL | TITLE | PERSONNEL | TITLE |
|-----------|-------|-----------|-------|
| 1         | 2     | 3         | 4     |
| 5         | 6     | 7         | 8     |
| 9         | 10    | 11        | 12    |
| 13        | 14    | 15        | 16    |
| 17        | 18    | 19        | 20    |
| 21        | 22    | 23        | 24    |
| 25        | 26    | 27        | 28    |
| 29        | 30    | 31        | 32    |
| 33        | 34    | 35        | 36    |
| 37        | 38    | 39        | 40    |
| 41        | 42    | 43        | 44    |
| 45        | 46    | 47        | 48    |
| 49        | 50    | 51        | 52    |
| 53        | 54    | 55        | 56    |
| 57        | 58    | 59        | 60    |
| 61        | 62    | 63        | 64    |
| 65        | 66    | 67        | 68    |
| 69        | 70    | 71        | 72    |
| 73        | 74    | 75        | 76    |
| 77        | 78    | 79        | 80    |
| 81        | 82    | 83        | 84    |
| 85        | 86    | 87        | 88    |
| 89        | 90    | 91        | 92    |
| 93        | 94    | 95        | 96    |
| 97        | 98    | 99        | 100   |

COUNTY HENRY

DATE Nov 26, 1971

Tomsic

Neuser,

Grenada

S. R. 281

## WEATHER

SEC. RICHFIELD WY.

TEMP.

### DESCRIPTION.

LEFT

**CENTER LINE**

**RIGHT**

JOB NO. \_\_\_\_\_

