

O.D.O.T. DISTRICT 2 SURVEY OFFICE (USE ONLY)

PERSONNEL

REFERENCE NO. 34

SHEET 29 OF 34

NOTES PRESTON-COLVIN

H.C. NEISE

R.C. PRESTON-COLVIN

DATE 11/26/24

WEATHER WINDY

TEMP. 40°

ROUTE SR 281

COUNTY HENRY

TOWNSHIP RICHFIELD

SECTION 26

DWG BY PRESTON-COLVIN PID PAVING TRAIN

T 4 N R 8 E

TYPE MONUMENT MAG/WASHER

~~ON SURFACE~~ - BELOW ON

OFFSET 7.9' ~~LT~~ : RT

2.9' TO RT EDGE PAVEMENT

STATION: 867+60

HORIZ.DATUM: NAD83 2011


GEOID: 18

GRID: NORTHING: 592370.588


EASTING: 1580527.030

LDP: NORTHING: -

EASTING: -

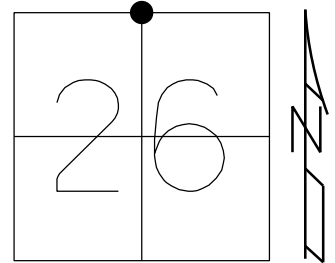

RECORD:
 N¹/₄ CORNER SEC 26
 FD IPIPE OVER STONE
 REMOVED PIPE AND PLACED
 RR SPIKE OVER STONE
 HENRY CO., 1979
 SET SM.R.R.SPIKE
 10/28/86
 FD SM.R.R.SPIKE
 ATOP R.R.SPIKE
 6/2/98, MC
 SET P.K./WASHER
 9/29/98, MRC
 FD SM.R.R.SPIKE
 REF34
 9/7/18, JFO
 7/25/19,
 1/11/23, JMR
 SET MAG/WASHER
 NEWREF34
 11/26/24, TDN
 SET BY GPS

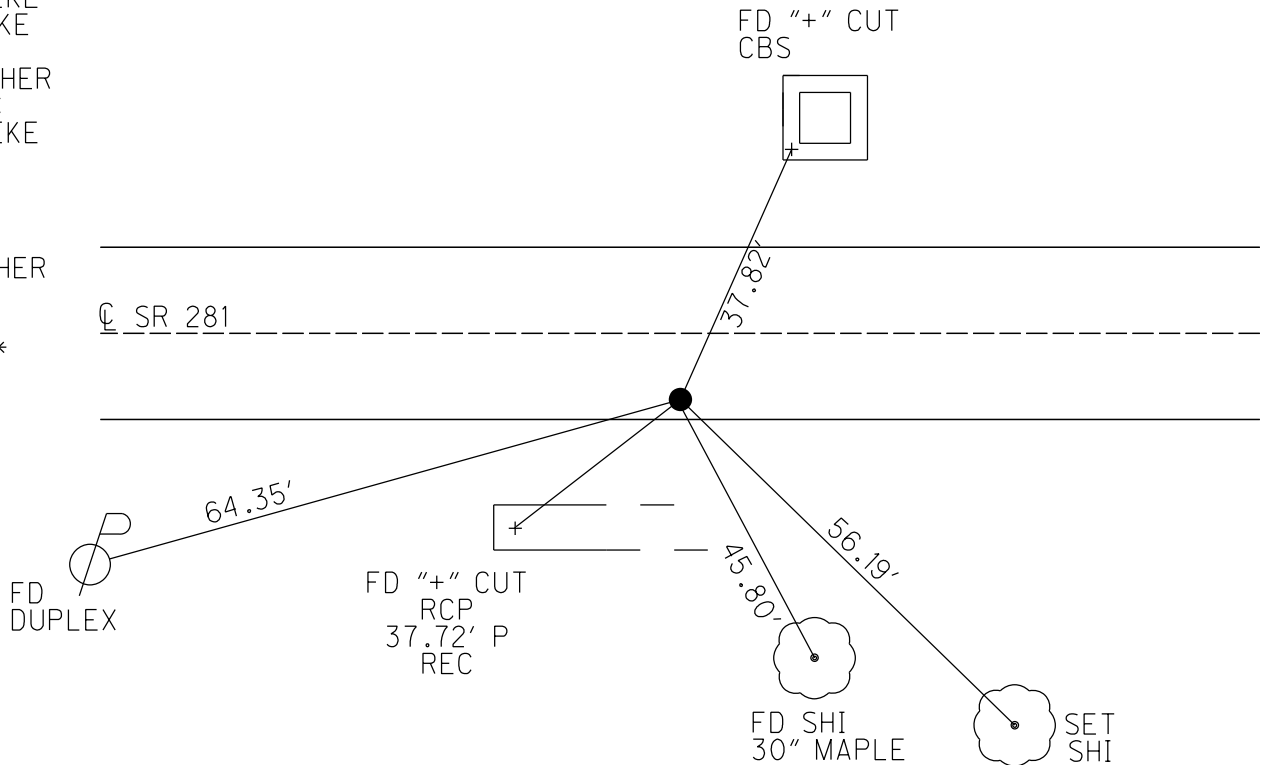

O.D.O.T. DISTRICT 2 SURVEY OFFICE (USE ONLY)

PERSONNEL

REFERENCE NO. 34

SHEET 29 OF 34

NOTES RHOADES

DATE 9/7/18

ROUTE SR 281

H.C. O'DONNELL

WEATHER CLOUDY

COUNTY HENRY

R.C. RHOADES

TEMP. 69°

TOWNSHIP RICHFIELD

DWG BY NIESE

PID PAVETRAIN

SECTION 26

T 4 N R 8 E

TYPE MONUMENT SM.R.R.SPIKE

ON SURFACE - ~~BELOW~~ ON

OFFSET Q PAVEMENT 8.1' ~~LT~~ : RT

1.6' TO RT EDGE PAVEMENT


STATION: 867+60

HORZ.DATUM: NAD83(2011)

GEOID: 2012A


GRID: NORTHING: 592370.588

EASTING: 1580527.030

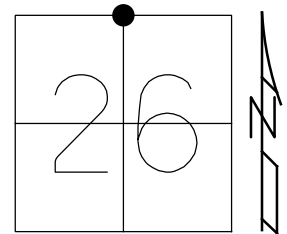

RECORD:
N¹/₄ CORNER SEC 26
FD IPIPE OVER STONE
REMOVED PIPE AND PLACED
RR SPIKE OVER STONE
HENRY CO., 1979
SET SM.R.R.SPIKE
10/28/86
FD SM.R.R.SPIKE
ATOP R.R.SPIKE
6/2/98, MC
SET P.K./WASHER
9/29/98, MRC
FD SM.R.R.SPIKE
REF34
9/7/18, JFO
7/25/19,
1/11/23, JMR

Q SR 281

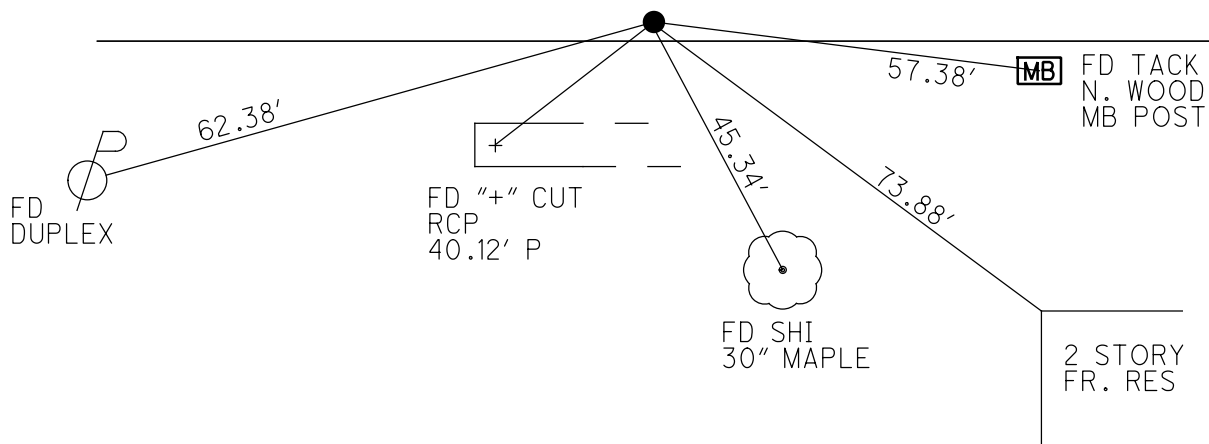

O.D.O.T. DISTRICT 2 SURVEY OFFICE (USE ONLY)

PERSONNEL

REFERENCE NO. 34

SHEET 29 OF 34

NOTES RHOADES

DATE 9/7/18

ROUTE SR 281

H.C. O'DONNELL

WEATHER CLOUDY

COUNTY HENRY

R.C. RHOADES

TEMP. 69°

TOWNSHIP RICHFIELD

SECTION 26

DWG BY NIESE

PID CHIP_2

T 4 N R 8 E

TYPE MONUMENT SM.R.R.SPIKE

ON SURFACE - ~~BELOW~~ ON

OFFSET CL PAVEMENT 8.1' ~~LT~~ : RT

1.6' TO RT EDGE PAVEMENT


STATION: 867+60

HORZ.DATUM: NAD83(2011)

GEOID: 2012A


GRID: NORTHING: 592370.588

EASTING: 1580527.030

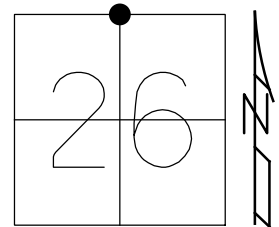

RECORD:
N¹/₄ CORNER SEC 26
FD IPIPE OVER STONE
REMOVED PIPE AND PLACED
RR SPIKE OVER STONE
HENRY CO., 1979
SET SM.R.R.SPIKE
10/28/86
FD SM.R.R.SPIKE
ATOP R.R.SPIKE
6/2/98, MC
SET P.K./WASHER
9/29/98, MRC
FD SM.R.R.SPIKE
REF34
9/7/18, JFO
7/25/19, JMR

CL SR 281

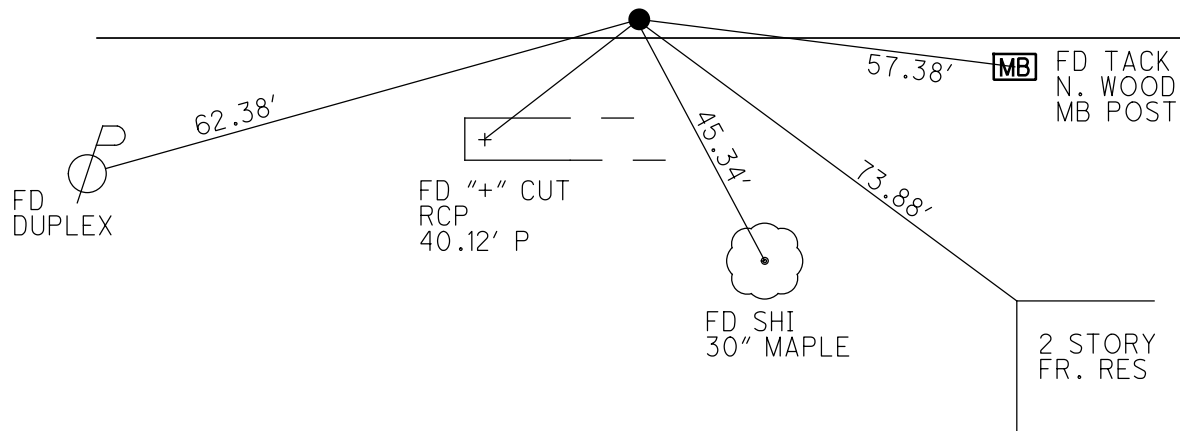

O.D.O.T. DISTRICT 2 SURVEY OFFICE

PERSONNEL

REFERENCE NO. 34

SHEET 30 OF 34

NOTES Conterbury

H.C. Rossas

R.C. Nuffer

DATE 6-2-98

WEATHER Sunny

TEMP. +70°F

ROUTE SR 281

COUNTY HENRY

TOWNSHIP Richfield

SECTION 26

T 4 N R 8 E


TYPE MONUMENT Sm. RR spk atop RR spk

ON SURFACE - BELOW surface

LEFT - ℄ PAV'T. - RIGHT 8.1 Rt

1.6' TO RT EDGE PAVEMENT

S.L.M. 26+431.70 SLK, 867+60 SLM

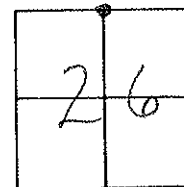


Reset PK & Washen
9-29-98
MRL

RECORD
N 1/4 CORNER SEC 26
Fnd I. Pipe over stone
REMOVED PIPE & PLACED
RR spike OVER STONE
HENRY Co. 1999

Sm. RR Spk set
6-28-86

℄ Rmt

SR 281

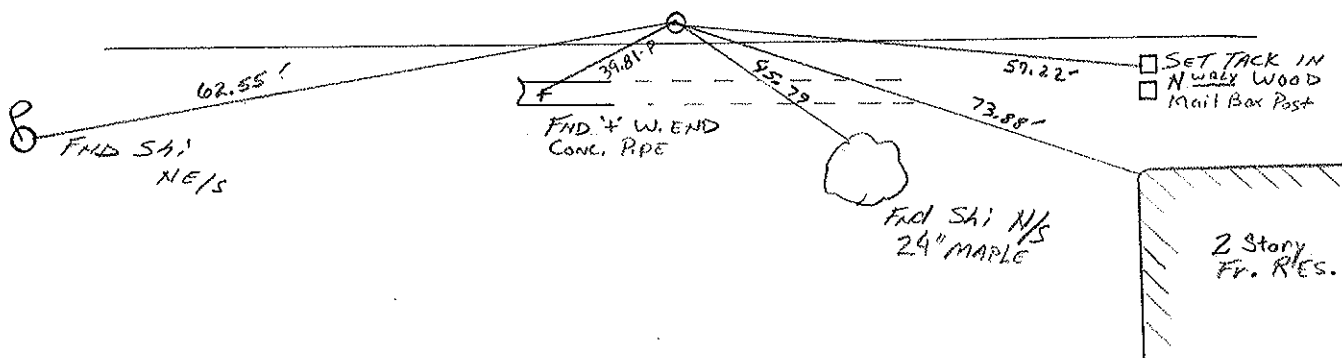

DRAWN BY TR

O.D.O.T. DISTRICT 2 SURVEY OFFICE

PERSONNEL

REFERENCE NO. 34

SHEET OF

NOTES LOEMKE

H.C. BARUHSEL

R.C. SACKMAN

DATE 8-11-86

WEATHER CLOUDY

TEMP. +65

ROUTE SR 281

COUNTY HENRY

TOWNSHIP RICHFIELD

SECTION 26

T4 N R S E

TYPE MONUMENT R.R. SPIKE


ON SURFACE - BELOW yes

LEFT - C PAV'T. - RIGHT 8.4'

O.S. TO RT EDGE PAVEMENT


S.L.M. 867+60

Set SMALL
R.R. SPIKE
10-28-86

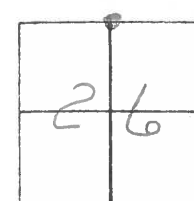

Records:

N 1/4 COR Sec 26
Fd. I. PIPE OVER STONE
Removed PIPE & PLACED
R.R. SPIKE OVER STONE
HENRY COUNTY 1979

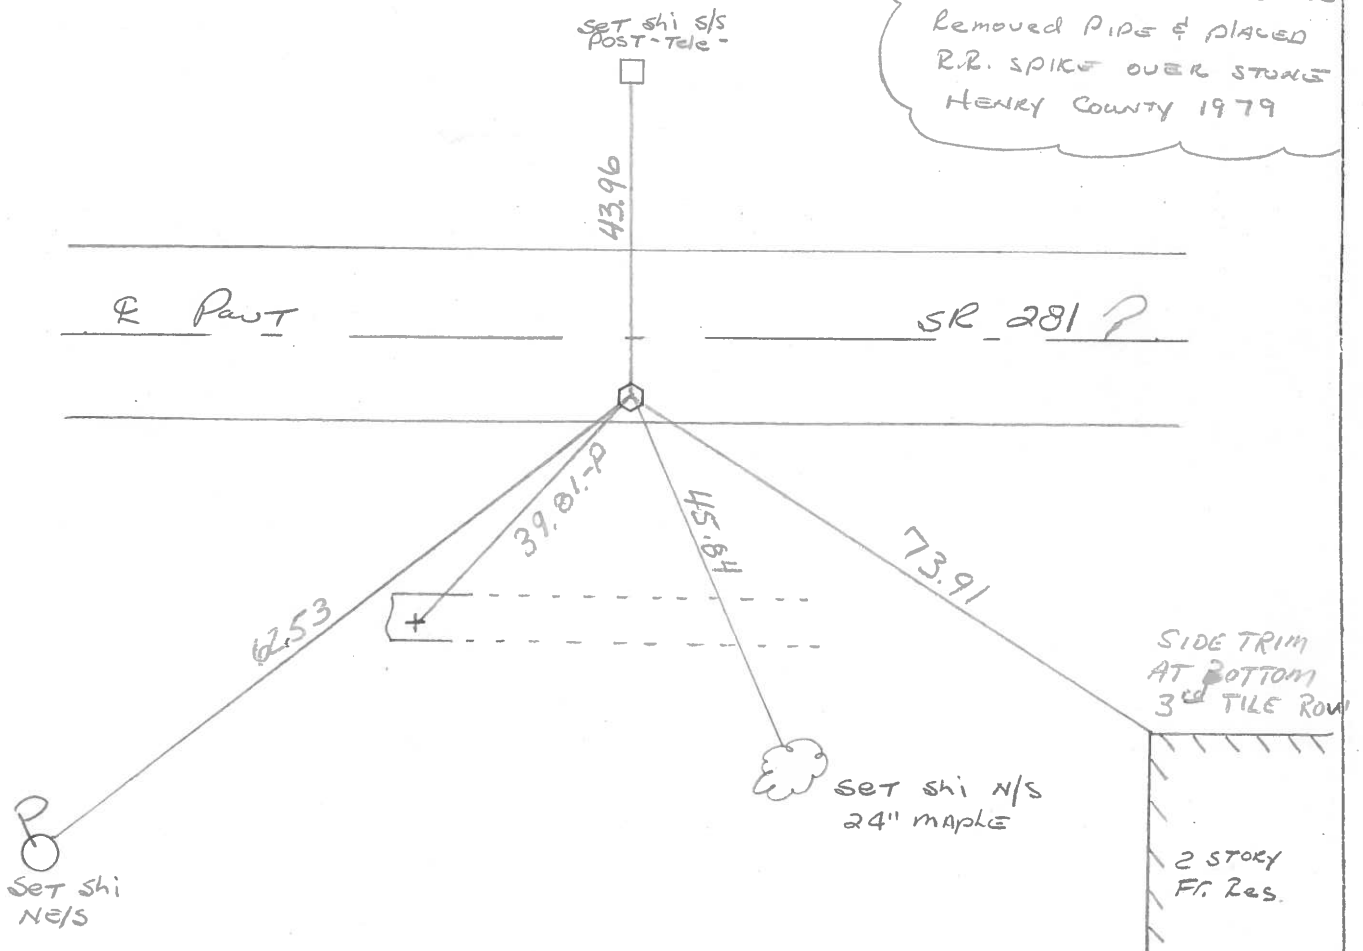


COUNTY HENRY

T-4-N , R-8-7 E

TOWNSHIP RICHFIELD

SECTION 26

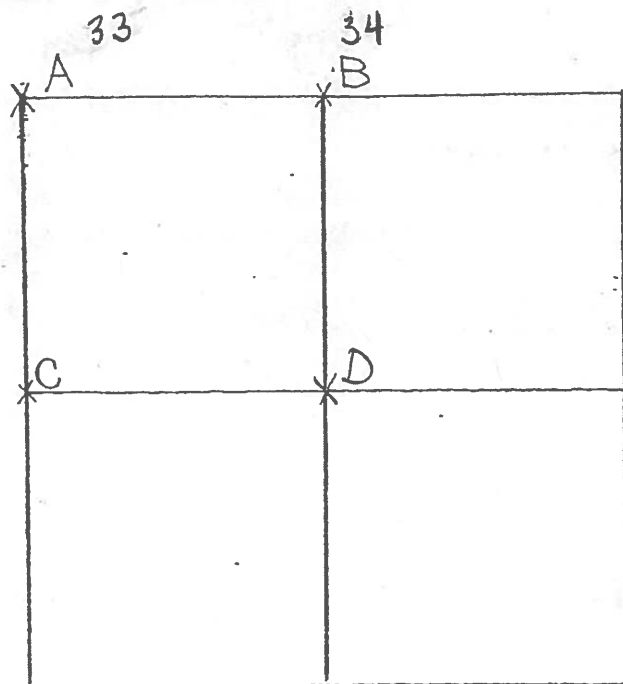

8-8-79 R.W, J.J, G.M.

A- FOUND IRON PIN IN CLAY TILE
OVER HIGH POINT OF STONE (8" x 8" x 10")
12" BELOW ROAD SURFACE. ALSO
FOUND FLAT STONE (8" x 10" x 4") UNDER
TRUE STONE. REMOVED IRON PIN.
PLACED CENTER PUNCHED R.R. SPIKE
ON SURFACE OVER HIGH POINT OF
TRUE STONE. P.K.'s 6' N. & W.

STONE IS 4.2' NORTH OF SOUTH EDGE OF 18' PAVEMENT.

48.37' N.W. TO 60D SPIKE E/S BRACE POLE

34.51' S.E. TO "+" TOP CONC. HEADWALL.

29.43' S.W. TO "+" TOP CONC. HEADWALL.

52.35' N.W. TO CENTER U.S.G.S. BENCH MARK A-117 1947

8-7-79 R.W, J.J, G.M.

B- FOUND IRON PIPE OVER TOP CENTER OF STONE (9" x 10" x 14") 19" BELOW
ROAD SURFACE. REMOVED IRON PIPE. PLACED CENTER PUNCHED RAILROAD
SPIKE ON SURFACE OVER TOP CENTER OF STONE. P.K.'s 6' N. & W.

STONE IS 1.0' NORTH OF SOUTH EDGE OF 18' PAVEMENT.

45.61' W.N.W. TO SHINER E/S I

44.09' N. TO NEAR FACE WOOD COR. POST

73.89' S.S.E. TO N.W. COR. HOUSE FOUNDATION.

46.73' S. TO DUPLEX W/S 22" MAPLE

39.78' S.W. TO "+" TOP WEST END OF R.C.P. (PLUMBED)

62.69' S.W. TO SHINER E/S I