

O.D.O.T. DISTRICT 2 SURVEY OFFICE (USE ONLY)

PERSONNEL

REFERENCE NO. 35

SHEET 30 OF 34

NOTES PRESTON-COLVIN

DATE 11/26/24

ROUTE SR 281

H.C. NEISE

WEATHER WINDY

COUNTY HENRY

R.C. PRESTON-COLVIN

TEMP. 40°

TOWNSHIP RICHFIELD

SECTION 25

DWG BY PRESTON-COLVIN

PID PAVING TRAIN

T 4 N R 8 E

TYPE MONUMENT RR SPIKE

~~ON SURFACE~~ - BELOW 1"

OFFSET $\angle$ PAVEMENT 10.0' ~~LT~~ : RT

ON TO RT EDGE PAVEMENT

STATION: 899+27

HORIZ.DATUM: NAD83 2011


GEOID: 18

GRID: NORTHING: 592359.117


EASTING: 1583189.767

LDP: NORTHING: 449681.8

EASTING: 218447.6

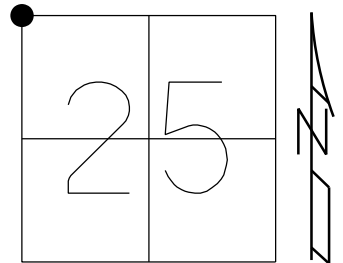

RECORD:
 SET SM.R.R.SPIKE
 10/28/86
 FD SM.R.R.SPIKE
 ATOP R.R.SPIKE
 6/2/98, MC
 SET P.K./WASHER
 9/29/98, MRC
 FD R.R.SPIKE
 1" DOWN
 REF35
 9/7/18, JFO
 7/25/19,
 1/11/23, JMR
 FD RRS 1" DOWN
 REF35
 7/25/24, TDN
 FD RRS 1" DOWN
 11/26/24, TDN

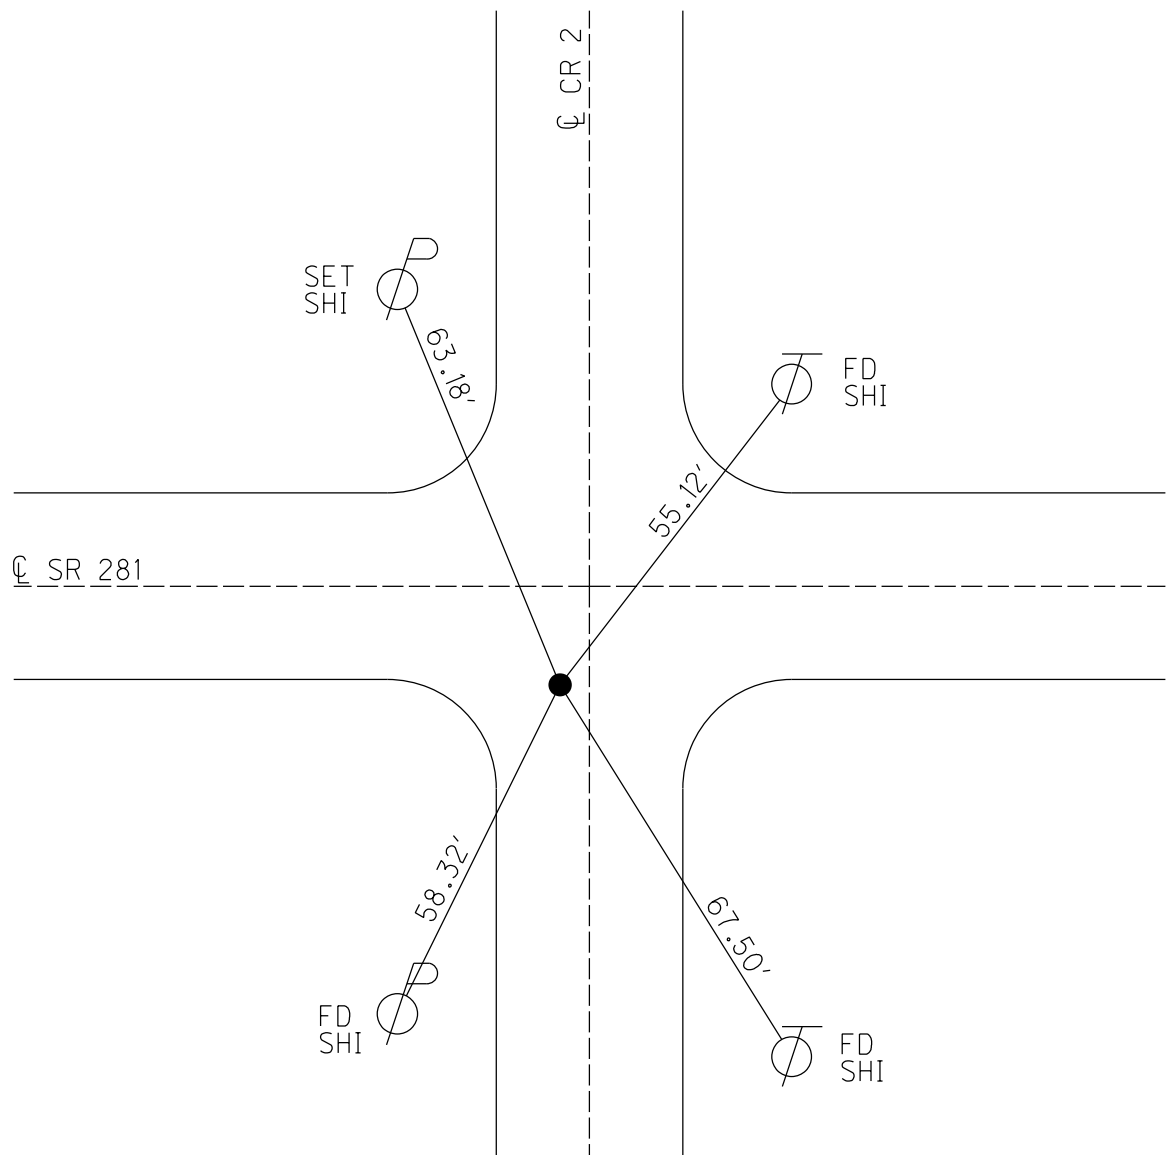

O.D.O.T. DISTRICT 2 SURVEY OFFICE (USE ONLY)

PERSONNEL

REFERENCE NO. 35

SHEET 30 OF 34

NOTES RHOADES

DATE 9/7/18

ROUTE SR 281

H.C. O'DONNELL

WEATHER CLOUDY

COUNTY HENRY

R.C. RHOADES

TEMP. 69°

TOWNSHIP RICHFIELD

DWG BY NIESE

PID PAVETRAIN

SECTION 25

T 4 N R 8 E

TYPE MONUMENT R.R.SPIKE

~~ON SURFACE~~ - BELOW 1"

OFFSET Q PAVEMENT 10.0' ~~LT~~ : RT

ON TO RT EDGE PAVEMENT


STATION: 899+27

HORIZ.DATUM: NAD83(2011)


GEOID: 2012A

GRID: NORTHING: 592359.117

EASTING: 1583189.767

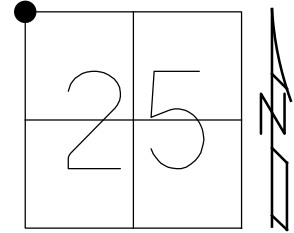

RECORD:
SET SM.R.R.SPIKE
10/28/86
FD SM.R.R.SPIKE
ATOP R.R.SPIKE
6/2/98, MC
SET P.K./WASHER
9/29/98, MRC
FD R.R.SPIKE
1" DOWN
REF35
9/7/18, JFO
7/25/19,
1/11/23, JMR

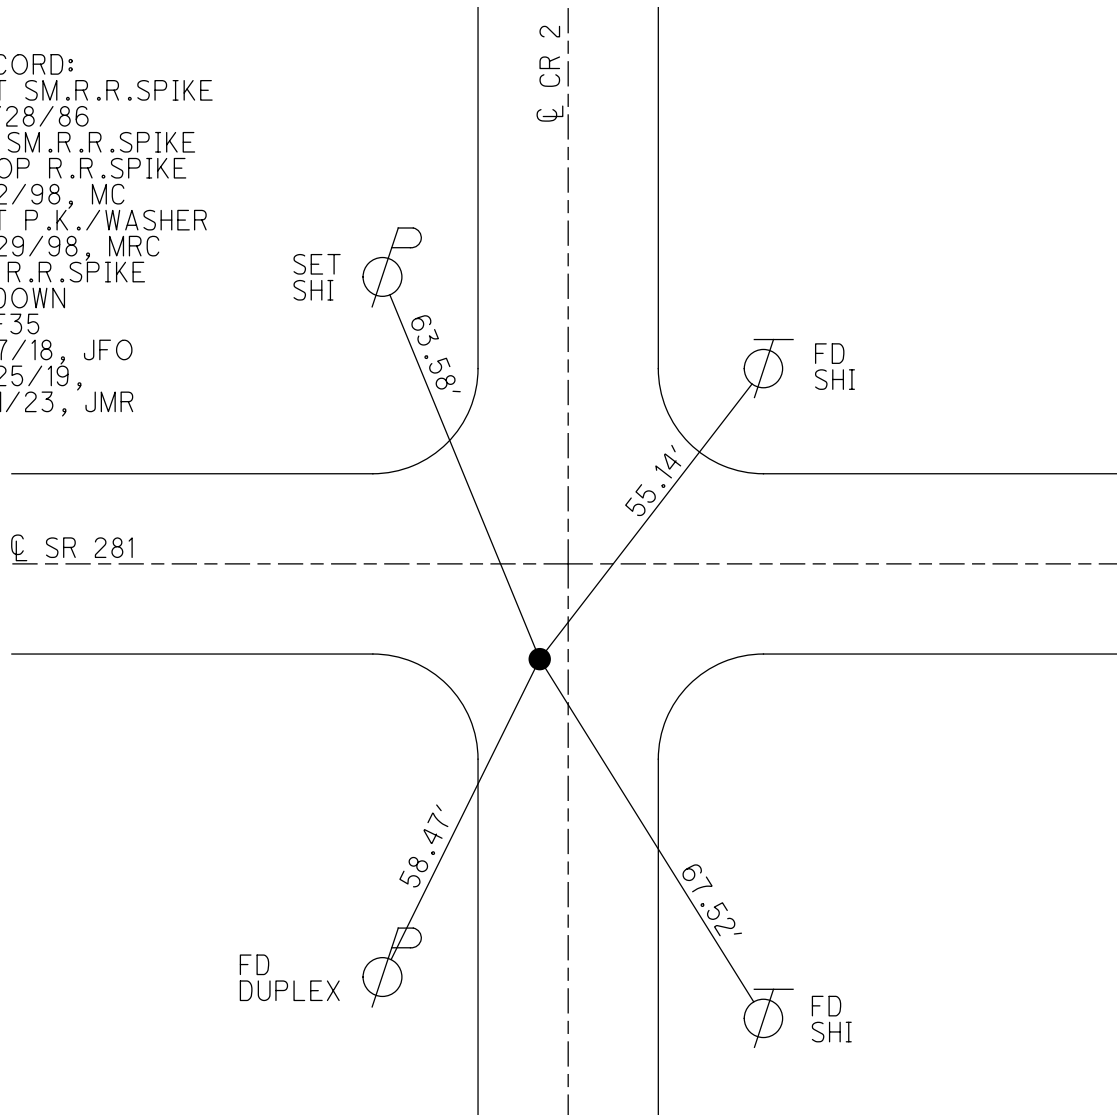

O.D.O.T. DISTRICT 2 SURVEY OFFICE (USE ONLY)

PERSONNEL

REFERENCE NO. 35

SHEET 30 OF 34

NOTES RHOADES

DATE 9/7/18

ROUTE SR 281

H.C. O'DONNELL

WEATHER CLOUDY

COUNTY HENRY

R.C. RHOADES

TEMP. 69°

TOWNSHIP RICHFIELD

SECTION 25

DWG BY NIESE

PID CHIP_2

T 4 N R 8 E

TYPE MONUMENT R.R.SPIKE

~~ON SURFACE~~ - BELOW 1"

OFFSET CL PAVEMENT 10.0' ~~LT~~ : RT

ON TO RT EDGE PAVEMENT


STATION: 899+27

HORIZ.DATUM: NAD83(2011)


GEOID: 2012A

GRID: NORTHING: 592359.117

EASTING: 1583189.767

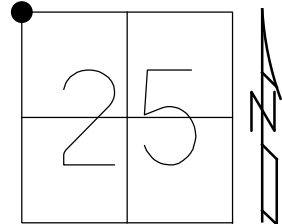

RECORD:
SET SM.R.R.SPIKE
10/28/86
FD SM.R.R.SPIKE
ATOP R.R.SPIKE
6/2/98, MC
SET P.K./WASHER
9/29/98, MRC
FD R.R.SPIKE
1" DOWN
REF35
9/7/18, JFO
7/25/19, JMR

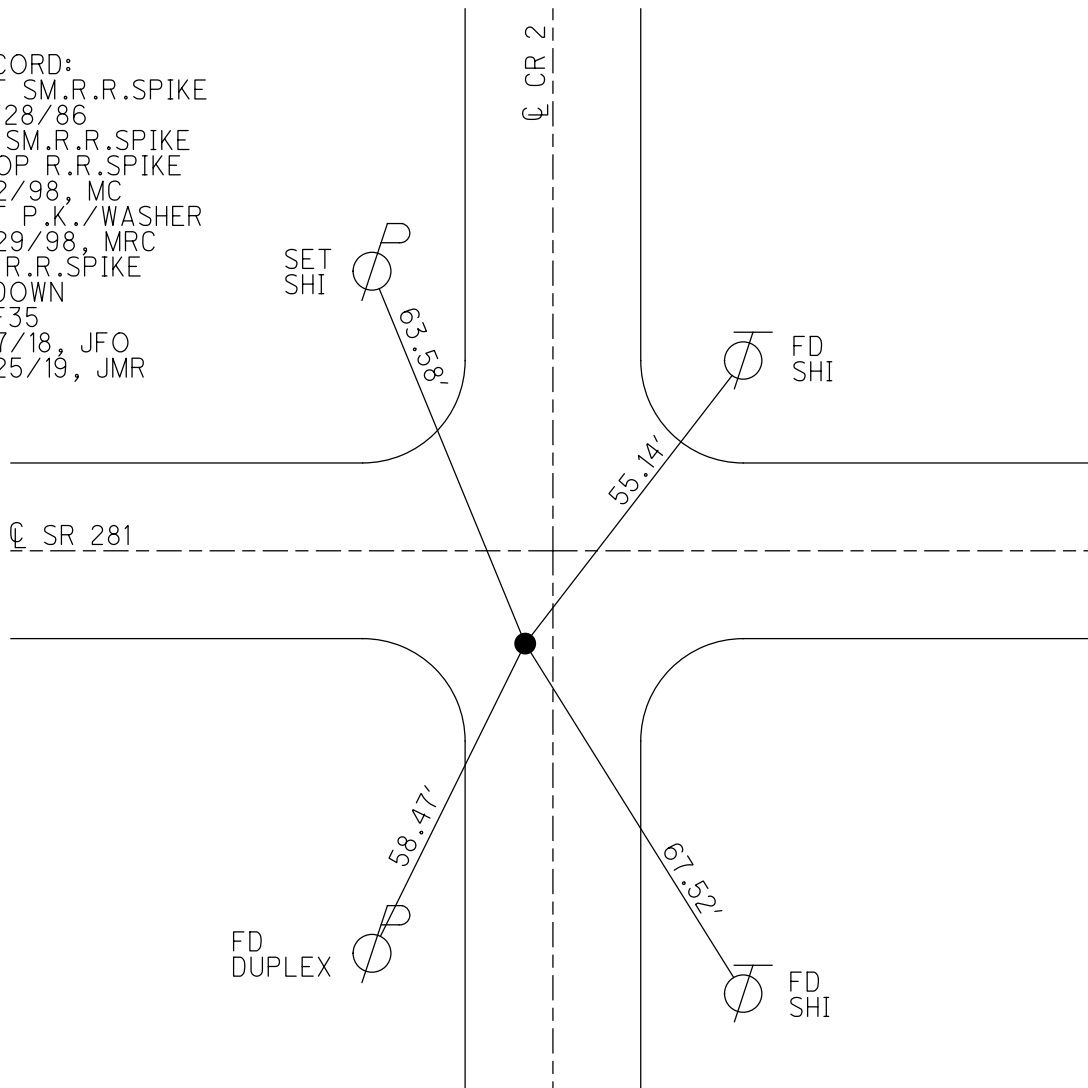

O.D.O.T. DISTRICT 2 SURVEY OFFICE

PERSONNEL

REFERENCE NO. 35

SHEET 31 OF 34

NOTES Canterbury

H.C. Rousos

R.C. Nuffer

DATE 6-2-98

WEATHER SUNNY

TEMP. +70°F

ROUTE SR 281

COUNTY Henry

TOWNSHIP Richfield

SECTION 25

T. 4 N. R. 8 E.


TYPE MONUMENT Sm. RR spike ATop RR spk

ON SURFACE - ~~BELOW~~ Surface

LEFT-CL PAW'T. - RIGHT 10.0 RT


ON TO RT EDGE PAVEMENT

S.L. 271 242.80 SLK (899+27 SLK)

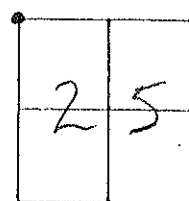

Reset PK & WASHER
9-29-98
MRC

Sm. RR SPL. SET
10-28-86

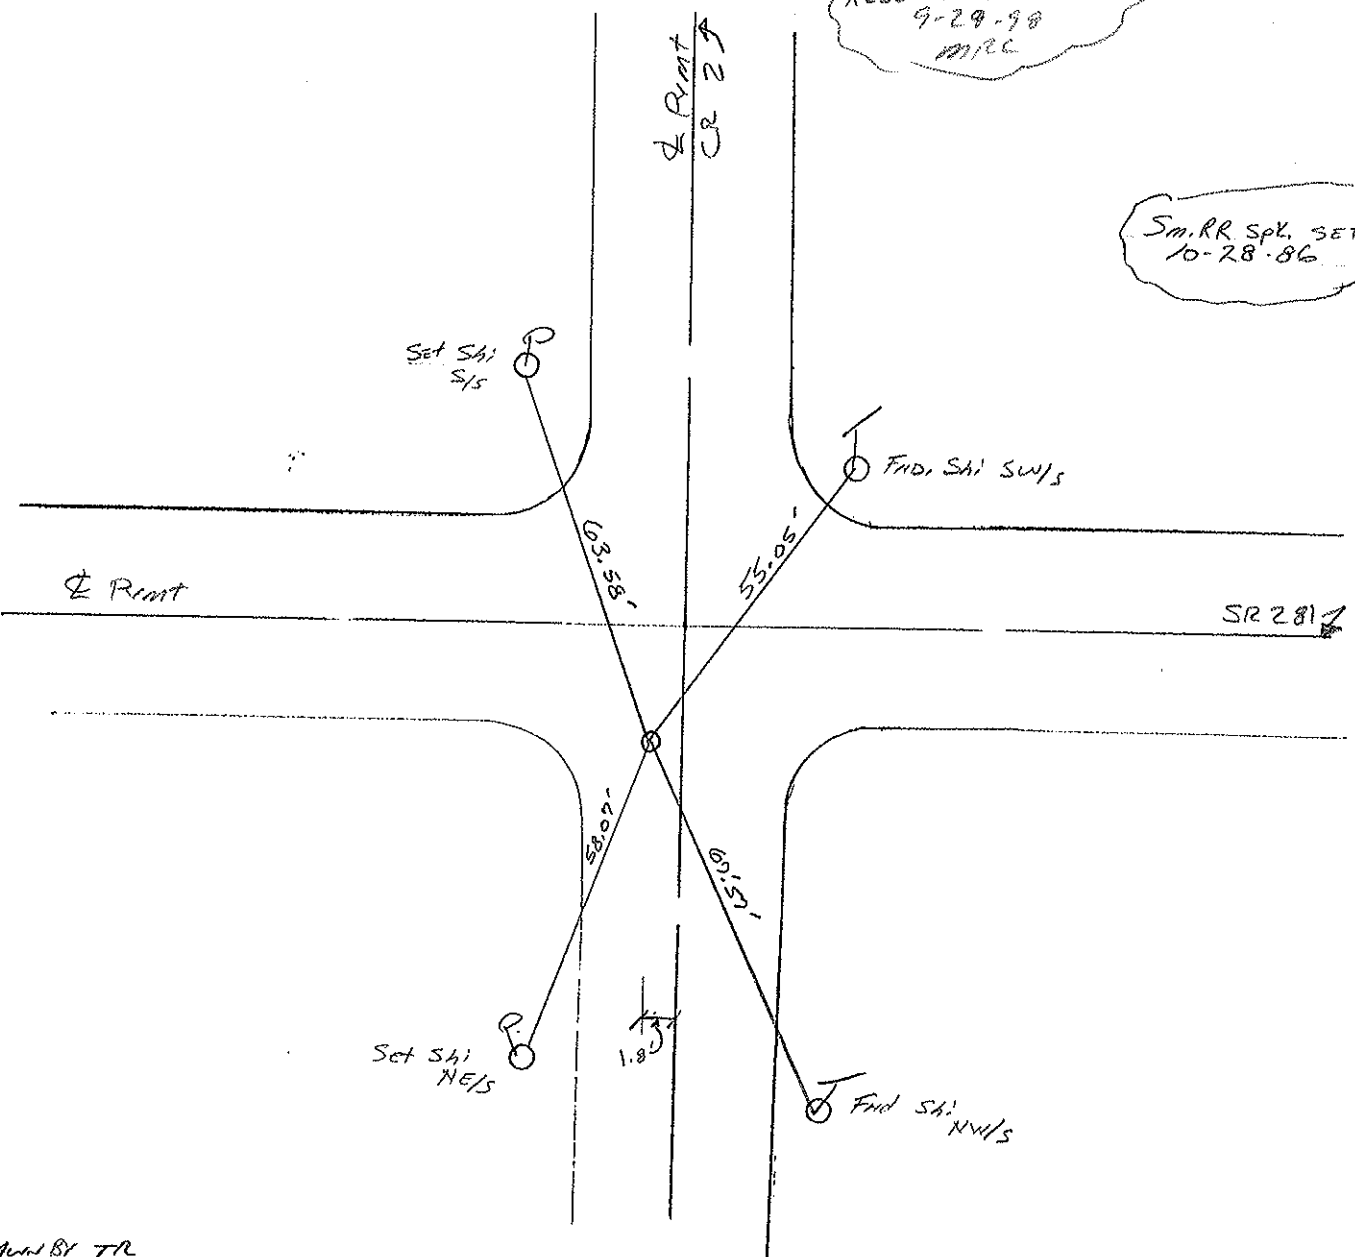

O.D.O.T. DISTRICT 2 SURVEY OFFICE

PERSONNEL

REFERENCE NO. 35

SHEET OF

NOTES LOGHARKE

H.C. BARONISEL

R.C. SOCKMAN

DATE 8-11-86

WEATHER Pt Cloudy

TEMP. +65

ROUTE SR 281

COUNTY HENRY

TOWNSHIP RICHFIELD

SECTION 25

T4 N R 8 E

TYPE MONUMENT RR SPIKE



ON SURFACE - BELOW 1/2"

LEFT-~~C~~ PAV'T. - RIGHT 10.0'

ON TO RT EDGE PAVEMENT

S.L.M. 894 +27

Set small
RR SPIKE
10-28-86

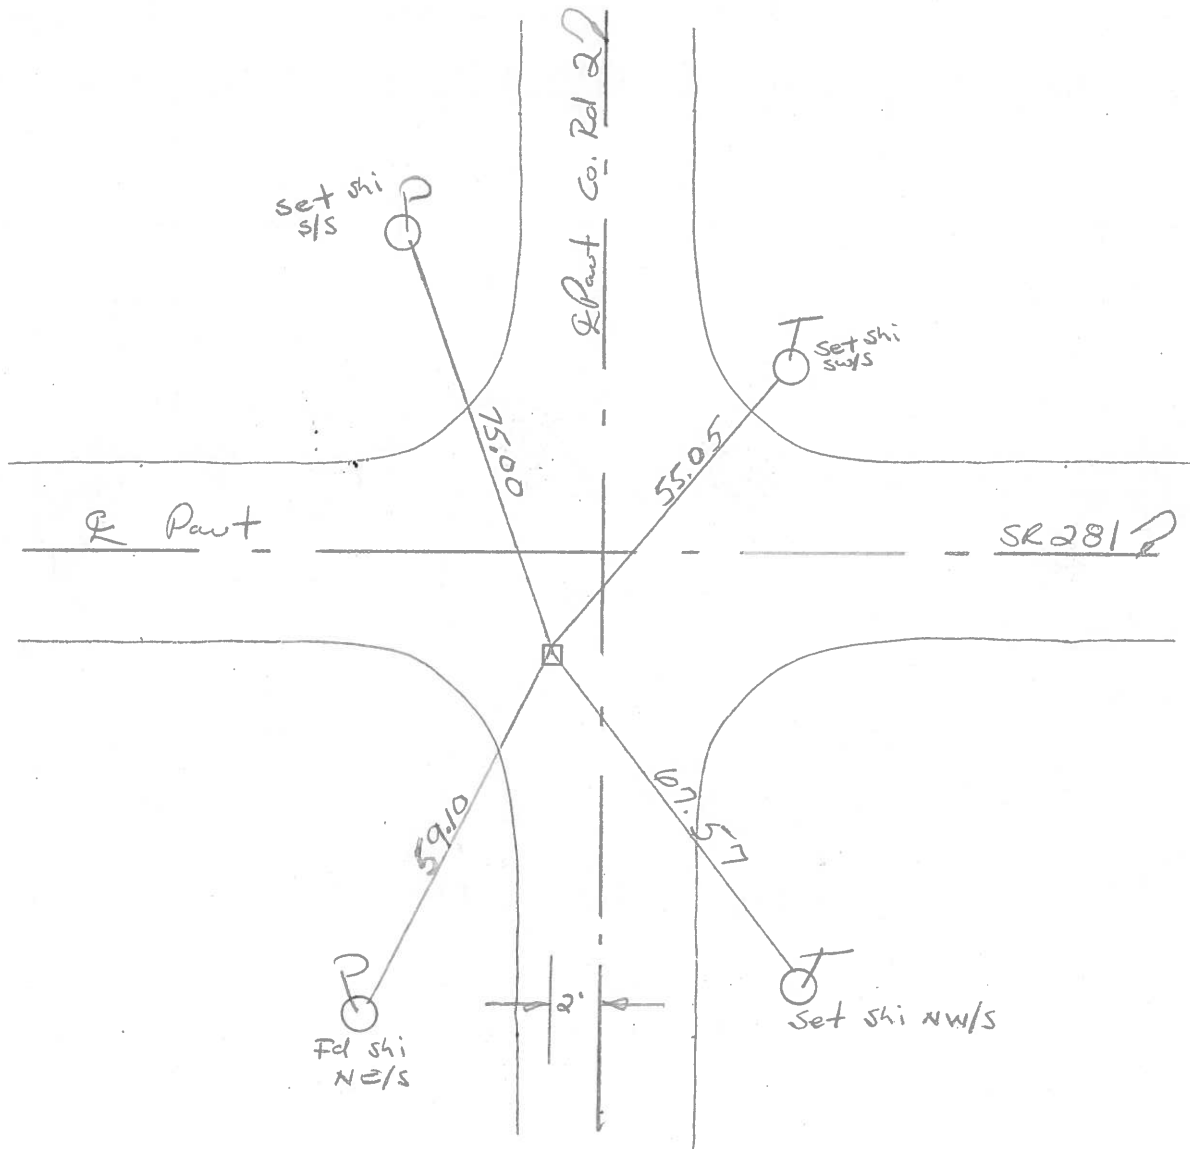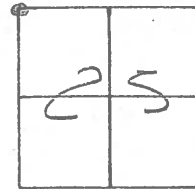

PERSONNEL TITLE PERSONNEL TITLE

COUNTY HENRY

DATE Nov 26, 1917

Tomsic
Neuser
Granata

S. R. 281

WEATHER

SEC. RICHFIELD TWP.

TEMP.

DESCRIPTION

LEFT

CENTER LINE

RIGHT

JOB NO.

