

PERSONNEL

SHEET 32 OF 34

DATE 11/26/24ROUTE SR 281

WEATHER WINDY

COUNTY HENRY

TEMP. 40°

TOWNSHIP RICHFIELDPID PAVING TRAIN

T 4 N R 8 F

ON SURFACE - BELOW 2"

OFFSET C PAVEMENT 11' ~~17'~~ : RT

0.3' TO RT EDGE PAVEMENT

STATION: 936+03.62

HORZ.DATUM: NAD83 2011


GEOID: 18

GRID: NORTHING: 592318.170


EASTING: 1587371.210

LDP: NORTHING: 449717.7

EASTING: 222629.4

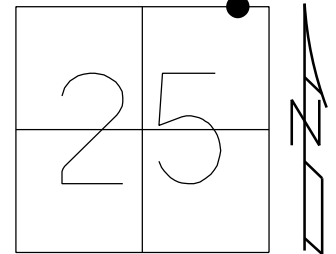

RECORD:
FD MONBOX
W/BOLT
SHOT TOP CTR LID
REFA36
9/7/18, JFO
7/25/19, JMR
FD MON BOX
REF36A
7/25/24, JAM

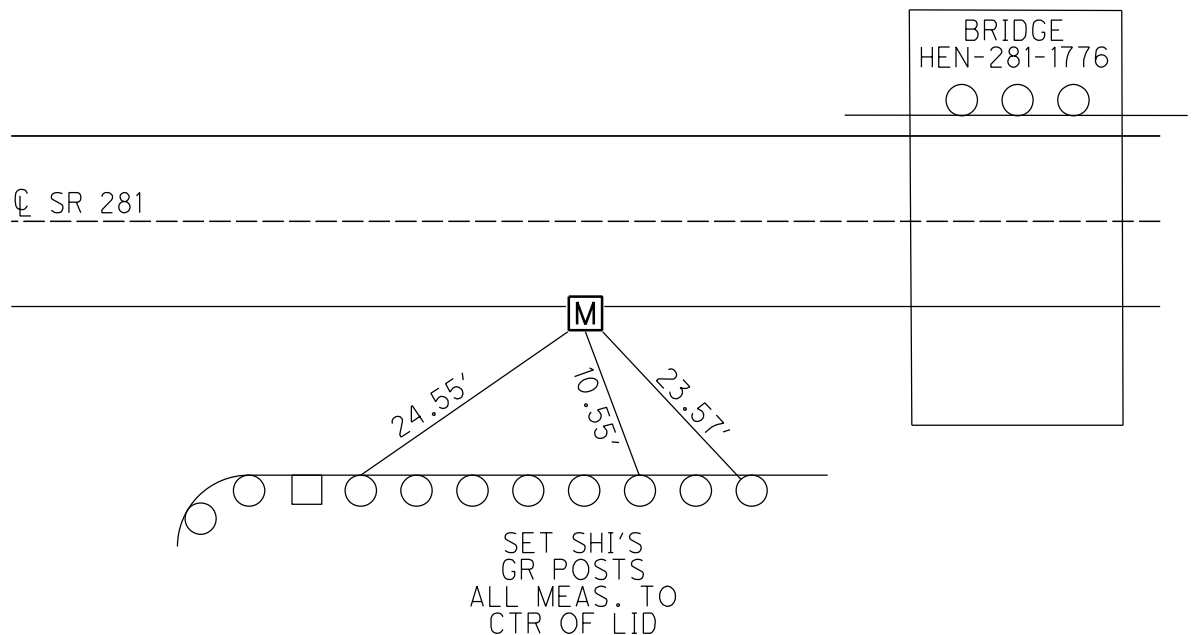

O.D.O.T. DISTRICT 2 SURVEY OFFICE (USE ONLY)

PERSONNEL

REFERENCE NO. 36 A

SHEET 32 OF 34

NOTES CANTERBURY

DATE 6/2/98

ROUTE SR 281

H.C. ROUSOS

WEATHER WINDY

COUNTY HENRY

R.C. NUHFER

TEMP. 75°

TOWNSHIP RICHFIELD

SECTION 25

DWG BY NIESE PID CHIP_2

T 4 N R 8 E

TYPE MONUMENT MONBOX

ON SURFACE - ~~BELOW~~ ON

OFFSET CL PAVEMENT 11.0' ~~LT~~ : RT

0.3' LT TO RT EDGE PAVEMENT


STATION: 936+03.62

HORIZ.DATUM: NAD83(2011)


GEOID: 2012A

GRID: NORTHING: 592318.170

EASTING: 1587371.210

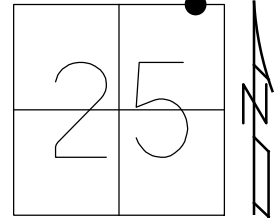

RECORD:
FD MONBOX
W/BOLT
SHOT TOP CTR LID
REFA36
9/7/18, JFO
7/25/19, JMR

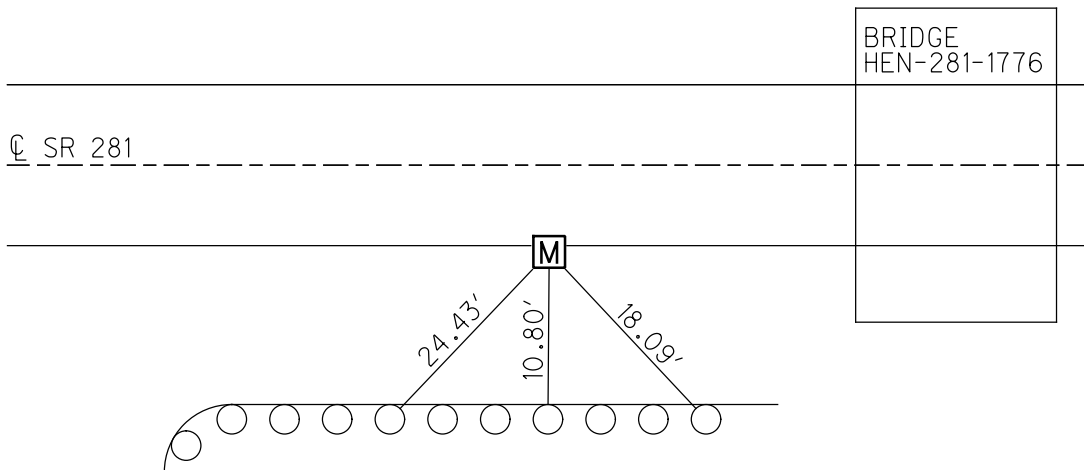

SET SHI'S
GR POSTS
ALL MEAS. TO
CTR OF LID