

O.D.O.T. DISTRICT 2 SURVEY OFFICE (USE ONLY)

PERSONNEL

REFERENCE NO. 1

SHEET 1 OF 11

NOTES HOMAN

DATE 6/15/03

ROUTE SR 2

H.C. HOMAN

WEATHER FAIR

COUNTY LUCAS

R.C. RYALL

TEMP. 75°

TOWNSHIP SWANTON

SECTION 7

T 7 N R 5 E

TYPE MONUMENT BRASS CAP MON.



~~ON SURFACE~~ - BELOW 2"

LEFT - ☉ PAV'T - RIGHT ON

22.1' TO S EDGE PAVEMENT

S.L.M. 0+00

GRID: NORTHING: _____ EASTING: _____

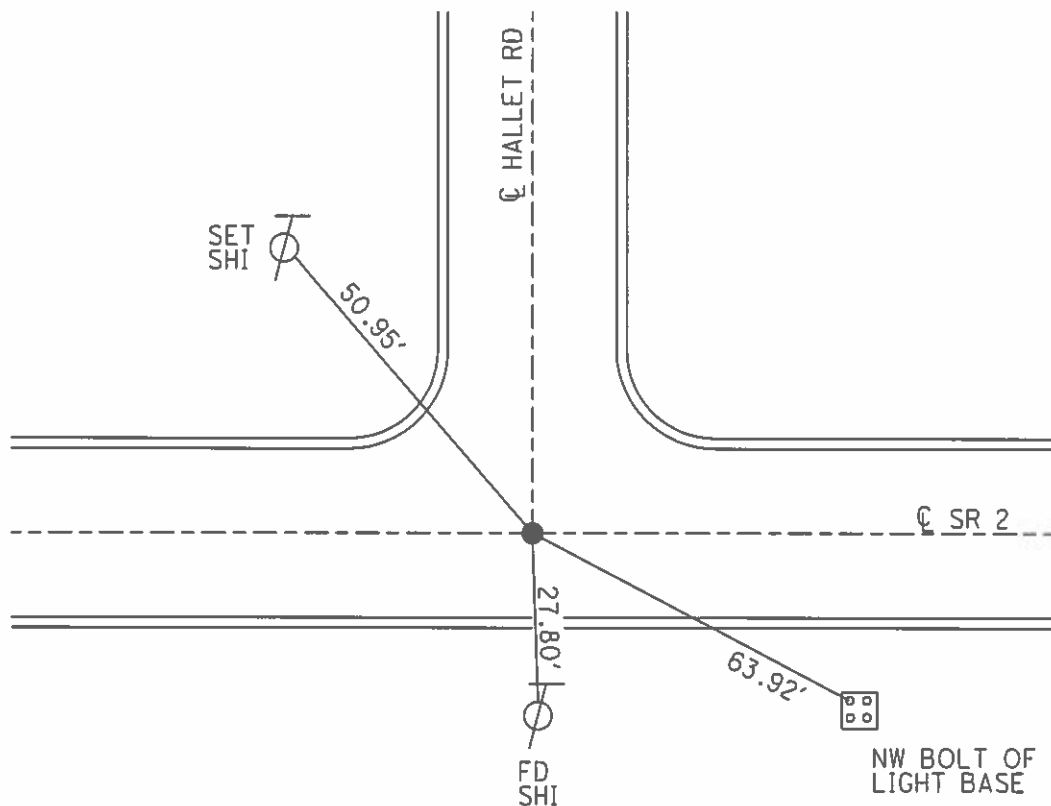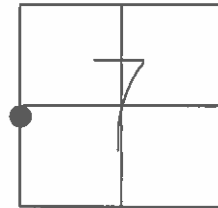

O.D.O.T. DISTRICT 2 SURVEY OFFICE (USE ONLY)

PERSONNEL

REFERENCE NO. 2

SHEET 2 OF 31

NOTES BALBAUGH

DATE 5/11/20

ROUTE SR 2

H.C. LEU

WEATHER CLOUDY

COUNTY LUCAS

R.C. AUBLE

TEMP. 39°

TOWNSHIP SWANTON

SECTION 7

DWG BY GARRETT

PID 107059

T 7 N R 5 E

TYPE MONUMENT MAG/WASHER

ON SURFACE - ~~BELOW~~ ON

OFFSET Q PAVEMENT ON LT : RT

- TO - EDGE PAVEMENT


STATION: 25+56

HORIZ.DATUM: NAD83(2011)

GEOID: 2012A


GRID: NORTHING: 700674.256

EASTING: 1592809.771

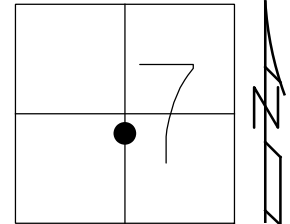

RECORD:
FD MOBORA MON.
6/15/03 DCH
SET MAG/WASHER
1/13/04, DCH
FD MOBORA MON
2" DOWN
REF2
7/29/16
SET MAG/WASHER
NEWREF2
10/05/16, JFO

NOTE:
SR 64 REF57

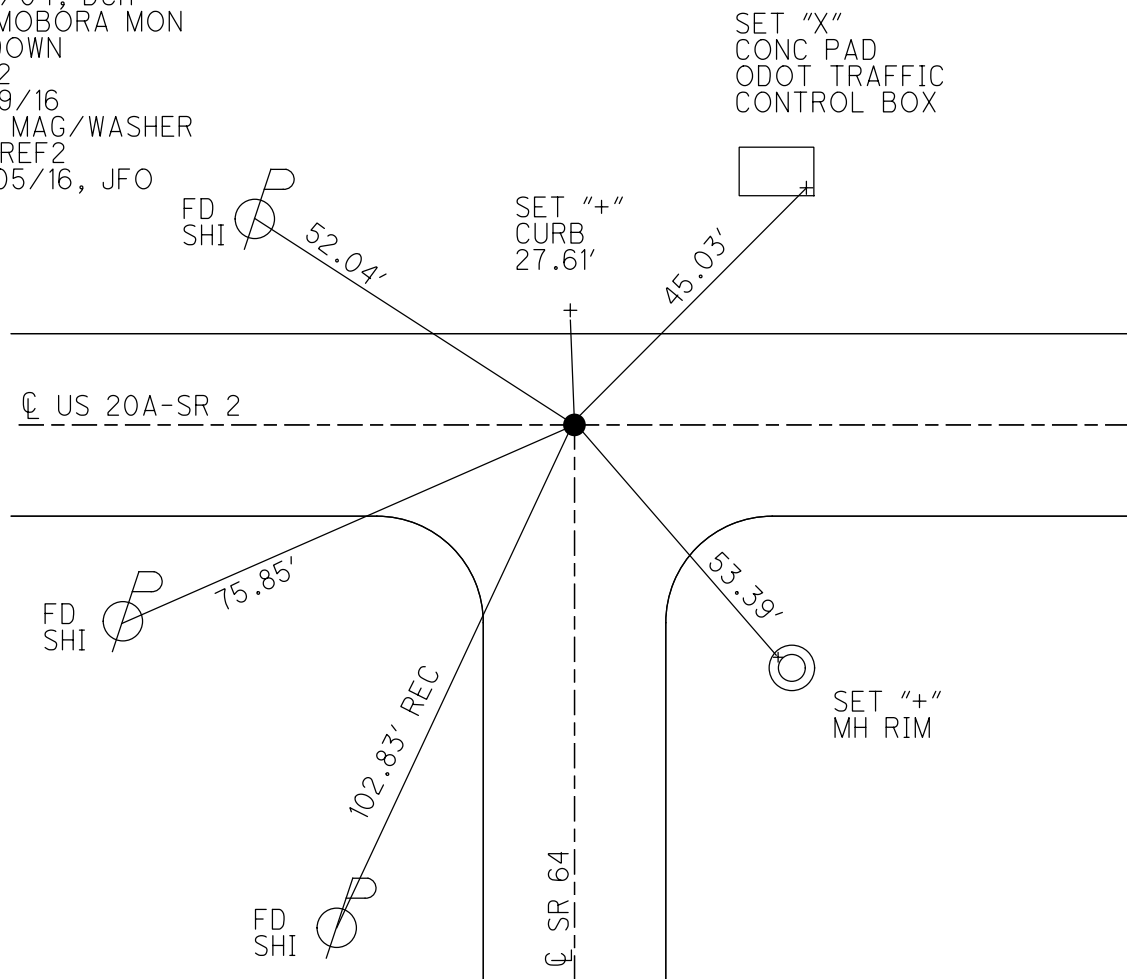

O.D.O.T. DISTRICT 2 SURVEY OFFICE (USE ONLY)

PERSONNEL	REFERENCE NO.	<u>3</u>	SHEET	<u>3</u>	OF	<u>11</u>
NOTES	<u>HOMAN</u>	DATE	<u>7-29-16</u>	ROUTE	<u>SR 2</u>	
H.C.	<u>HOMAN</u>	WEATHER	<u>CLOUDY</u>	COUNTY	<u>LUCAS</u>	
R.C.	<u>RYALL</u>	TEMP.	<u>75°F</u>	TOWNSHIP	<u>SWANTON</u>	
				SECTION	<u>7</u>	
				<u>T 7 N</u>	<u>R 5 E</u>	

TYPE MONUMENT MOBORA MON


~~ON SURFACE~~ - BELOW 3"

LEFT - ℄ PAV'T - RIGHT ON

27.2' TO RT EDGE PAVEMENT

S.L.M. 52+26

Grid: Northing: 700882.1963 Easting: 1595450.313

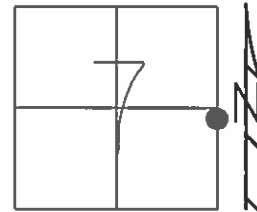


RECORD:
FD. MOBORA MON.
6-15-03 DCH

SET MAG/WASH
1-13-04 DCH

FD MOBORA MON
3" DOWN
GPS, REF3
7-29-16

SET MAG/WASHER
GPS, NEWREF3
10-05-16

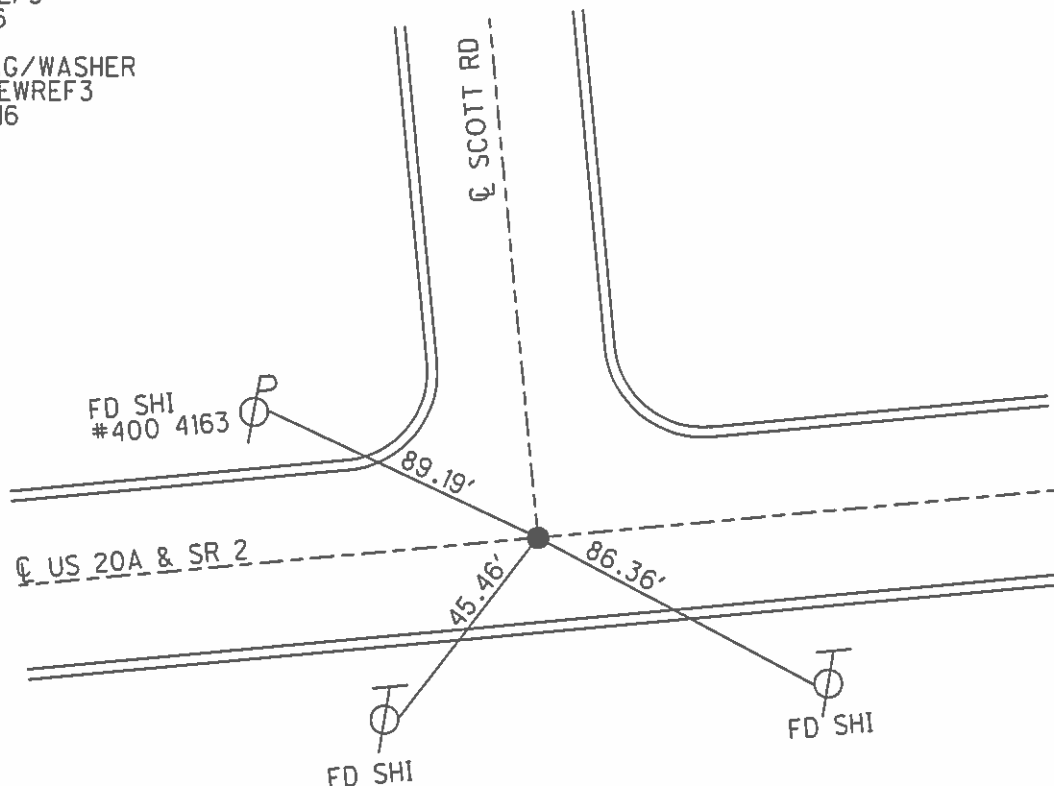


O.D.O.T. DISTRICT 2 SURVEY OFFICE (USE ONLY)

PERSONNEL _____ REFERENCE NO. 4 SHEET 4 OF 11
NOTES HOMAN DATE 7-29-16 ROUTE SR 2
H.C. HOMAN WEATHER CLOUDY COUNTY LUCAS
R.C. RYALL TEMP. 75°F TOWNSHIP SWANTON
SECTION 8
T 7 N R 5 E

TYPE MONUMENT MOBORA MON
~~ON SURFACE~~ - BELOW 3"
LEFT - ℄ PAV'T - ~~RIGHT~~ 1.0'
27' TO LT EDGE PAVEMENT
S.L.M. 78+70

Grid: Northing: 701091.3889 Easting: 1598079.533

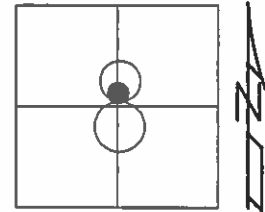


RECORD:
FD. MOBORA MON.
6-15-03 DCH

SET MAG/WASH
1-13-04 DCH

FD MOBORA MON
3" DOWN
GPS, REF4
7-29-16

SET MAG/WASHER
GPS, NEWREF4
10-05-16

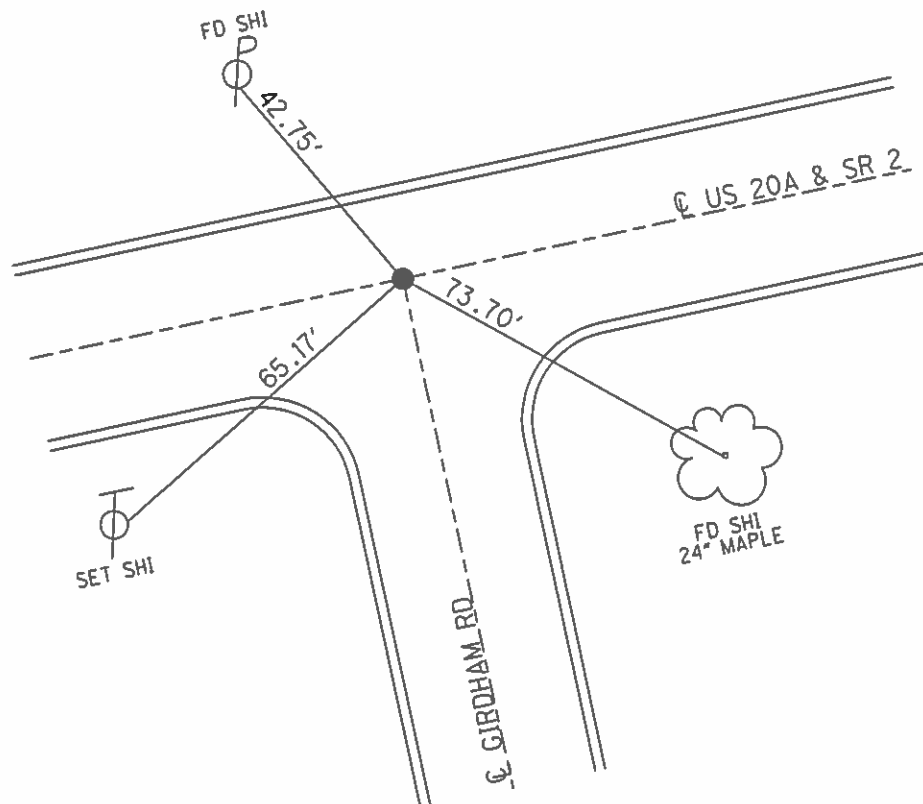

O.D.O.T. DISTRICT 2 SURVEY OFFICE (USE ONLY)

PERSONNEL _____ REFERENCE NO. 4 A SHEET 5 OF 11
NOTES HOMAN DATE 7-29-16 ROUTE SR 2
H.C. HOMAN WEATHER CLOUDY COUNTY LUCAS
R.C. RYALL TEMP. 75°F TOWNSHIP SWANTON
SECTION 8
T 7 N R 5 E

TYPE MONUMENT MOBORA MON


~~ON SURFACE~~ - BELOW 5"

~~LEFT~~ - C PAV'T - RIGHT 3.0'

23.5' TO RT EDGE PAVEMENT

S.L.M. 100+55

Grid: Northing: 701267.101 Easting: 1600251.266

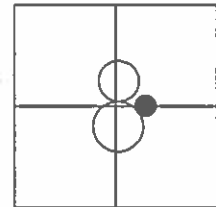


RECORD:
PI CURVE LEFT
EAST OF GIRDHAM

FD. MOBORA MON.
6-15-03 DCH

SET MAG/WASH
1-13-04 DCH

FD MOBORA MON
5" DOWN
GPS, REFA4
7-29-16

SET MAG/WASHER
GPS, NEWREFA4
10-05-16

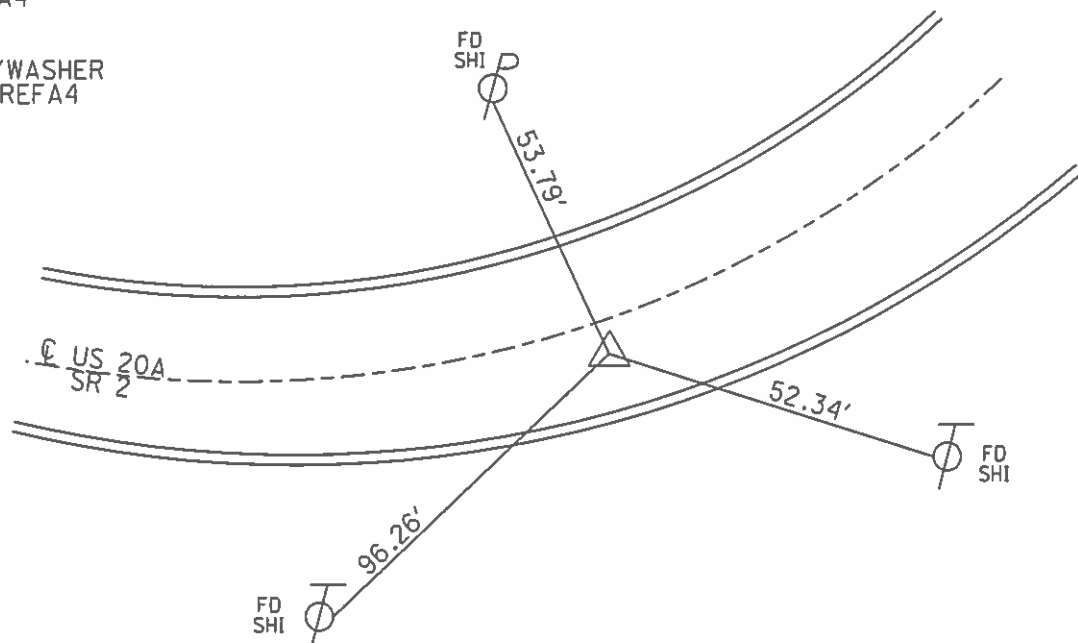

O.D.O.T. DISTRICT 2 SURVEY OFFICE (USE ONLY)

PERSONNEL _____ REFERENCE NO. 5 SHEET 6 OF 11
NOTES HOMAN DATE 7-29-16 ROUTE SR 2
H.C. HOMAN WEATHER CLOUDY COUNTY LUCAS
R.C. RYALL TEMP. 80°F TOWNSHIP SWANTON
SECTION 8
T 7 N R 5 E

TYPE MONUMENT SM RR SPIKE


~~ON SURFACE~~ - BELOW 2"

LEFT - ℄ PAV'T - RIGHT ON

26.9' TO RT EDGE PAVEMENT

S.L.M. 105+28

Grid: Northing: 701345.5995 Easting: 1600721.366

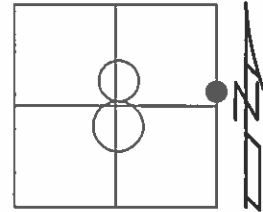


RECORD:
FD SM RR SPIKE
6-15-03, DCH

SET MAG/WASH
1-13-04 DCH

FD MOBORA MON
5" DOWN
GPS, REFA4
7-29-16

SET MAG/WASHER
GPS, NEWREFA4
10-05-16

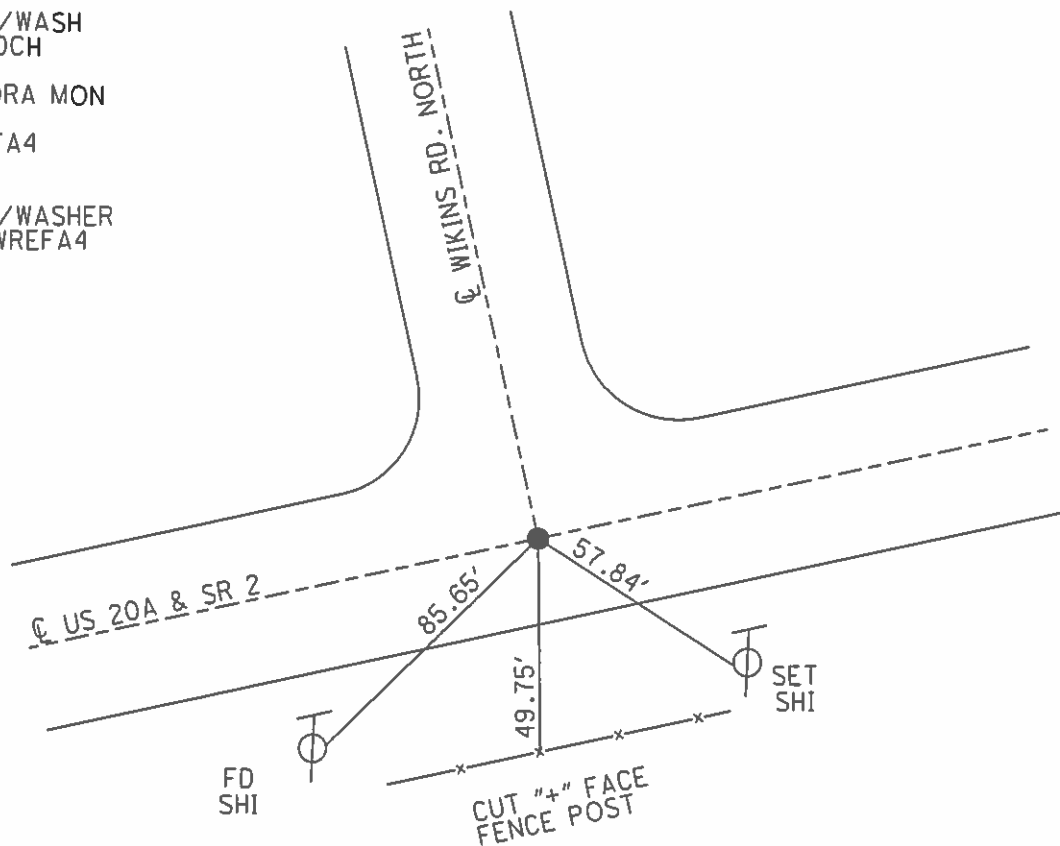


O.D.O.T. DISTRICT 2 SURVEY OFFICE (USE ONLY)

PERSONNEL _____ REFERENCE NO. 6 SHEET 7 OF 11
NOTES HOMAN DATE 7-29-16 ROUTE SR 2
H.C. HOMAN WEATHER CLOUDY COUNTY LUCAS
R.C. RYALL TEMP. 75°F TOWNSHIP SWANTON
SECTION 9
T 7 N R 9 E

TYPE MONUMENT R.R. SPIKE
~~ON SURFACE~~ - BELOW 8"
LEFT - ℄ PAV'T - RIGHT ON
- TO - EDGE PAVEMENT
S.L.M. 117+74.4

Grid: Northing: 701562.9063 Easting: 1602020.194

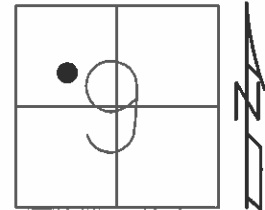


RECORD:
FD RR. SPIKE
1" DOWN
6-15-03

SET MAG/WASHER
1-13-04

GPS, REF6
8" DOWN
7-29-16


SET MAG/WASHER
GPS, NEWREF5
10-05-16

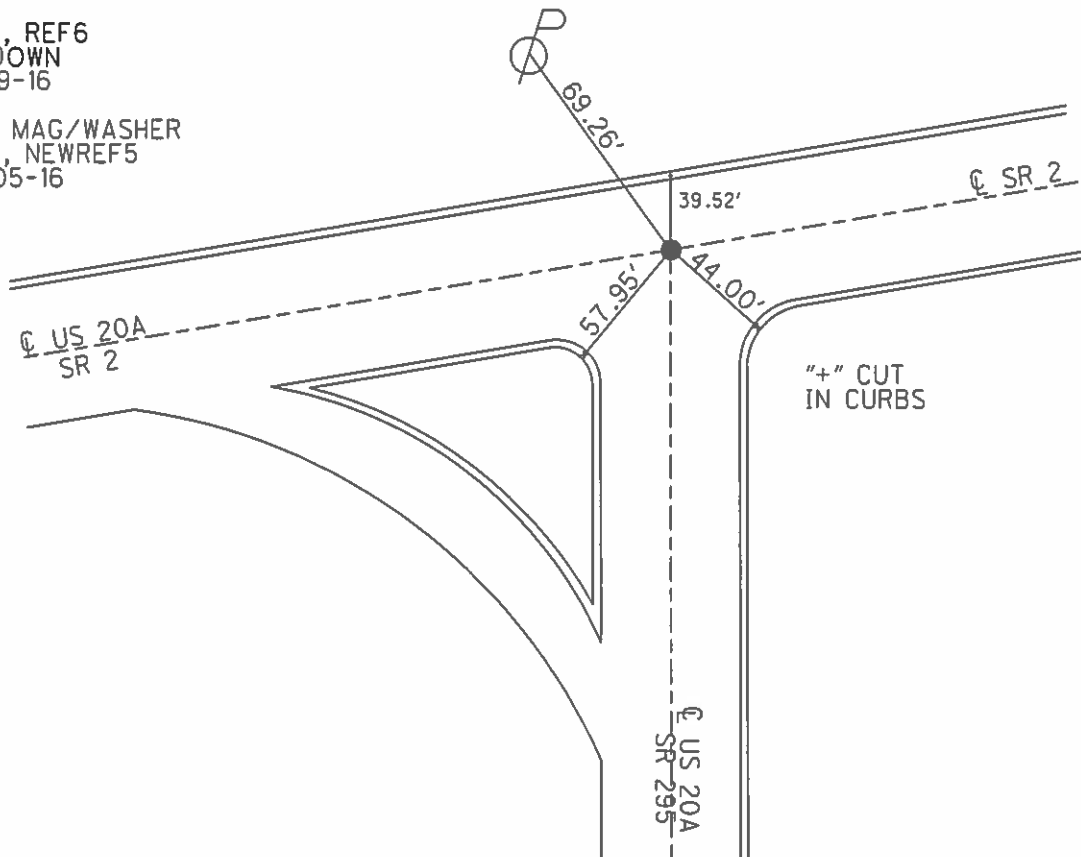

O.D.O.T. DISTRICT 2 SURVEY OFFICE (USE ONLY)

PERSONNEL _____ REFERENCE NO. 7 SHEET 8 OF 11
 NOTES HOMAN DATE 6-15-03 ROUTE SR 2
 H.C. HOMAN WEATHER FAIR COUNTY LUCAS
 R.C. RYALL TEMP. 75°F TOWNSHIP SWANTON
 _____ SECTION 9
 _____ T 7 N R 5 E

TYPE MONUMENT MAG NAIL
 ON SURFACE - ~~BELOW~~ ON
~~LEFT~~ - Q PAV'T - RIGHT 18.8'
8.2' TO S EDGE PAVEMENT
 S.L.M. 134+30

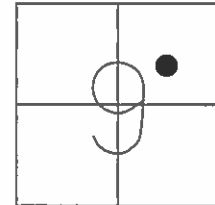

GRID: NORTHING: 701827.1201 EASTING: 1603598.047

RECORD: P.I.
 CURVE LEFT E. OF
 US 20A SOUTH


FD. I. ROD - MON. BOX
 6-15-03, DCH

SET MAG/WASHER
 1/13/04, DCH

GPS, REF7
 4/6/11, KPM

FD MAG NAIL
 GPS, REF7
 7-29-16


SET PK/WASHER
 GPS, NEWREF7
 10-05-16

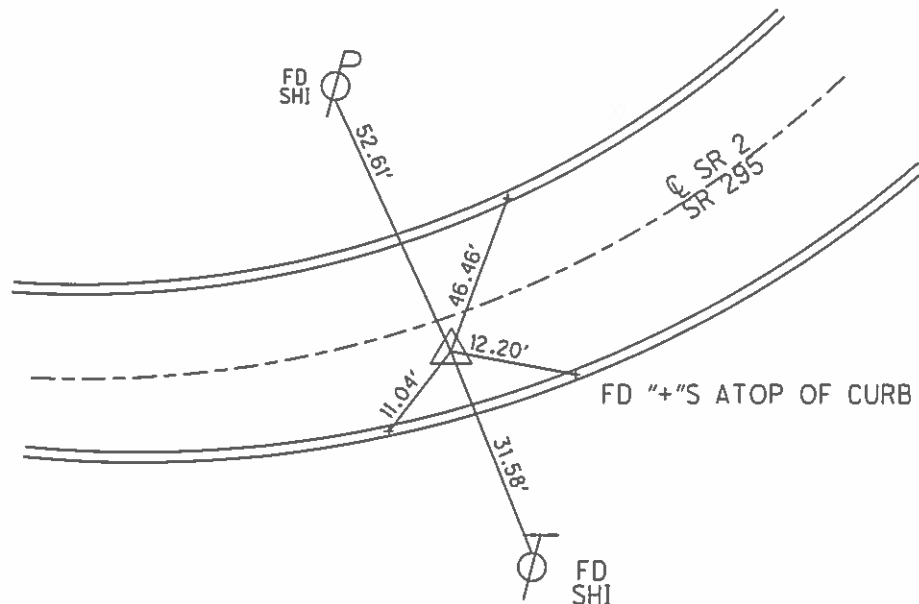

O.D.O.T. DISTRICT 2 SURVEY OFFICE (USE ONLY)

PERSONNEL _____ REFERENCE NO. 8 SHEET 9 OF 11
 NOTES HOMAN _____ DATE 7-29-16 ROUTE SR 2
 H.C. HOMAN _____ WEATHER SUNNY COUNTY LUCAS
 R.C. RYALL _____ TEMP. 84°F TOWNSHIP SWANTON
 _____ SECTION 9
 _____ T 7 N R 5 E


TYPE MONUMENT MON BOX W/ IPIN
 ON SURFACE - ~~BELOW~~ ON
 LEFT - Q PAV'T - RIGHT ON
 - TO - EDGE PAVEMENT
 S.L.M. 160+33

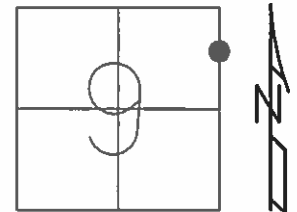

GRID: NORTHING: 702942.9249 EASTING: 1605937.436

RECORD:
 GPS, CL1
 3/25/10, KPM


FD MON BOX
 W/ IPIN
 GPS, REF8
 07-29-16

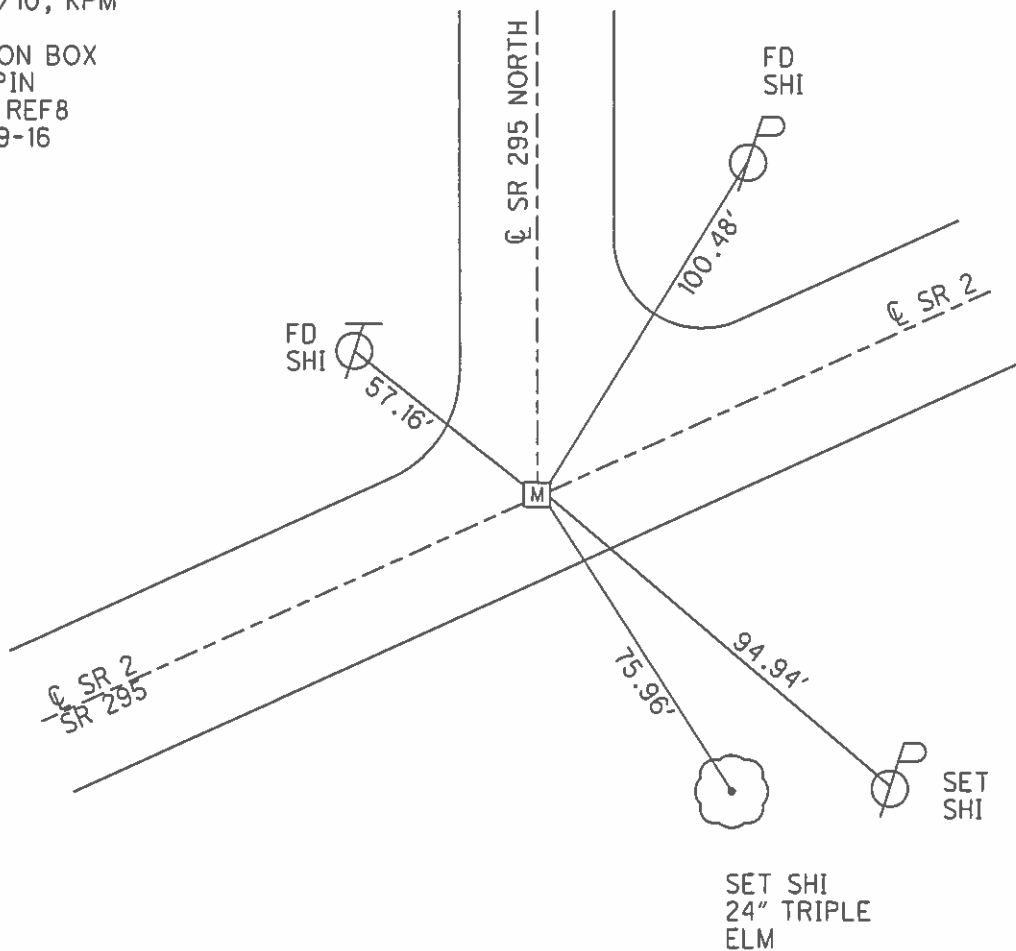

O.D.O.T. DISTRICT 2 SURVEY OFFICE (USE ONLY)


PERSONNEL	REFERENCE NO. <u>8 A</u>	SHEET <u>10</u> OF <u>11</u>	
NOTES	DATE <u>7-29-16</u>	ROUTE <u>SR 2</u>	
H.C. <u>HOMAN</u>	WEATHER <u>SUNNY</u>	COUNTY <u>LUCAS</u>	
R.C. <u>RYALL</u>	TEMP. <u>84°F</u>	TOWNSHIP <u>SWANTON</u>	
		SECTION <u>3</u>	
		T <u>7</u> N R <u>5</u> E	

TYPE MONUMENT MON BOX W/ IPIN
 ON SURFACE - ~~BELOW~~ ON
 LEFT - ℄ PAV'T - RIGHT ON
- TO - EDGE PAVEMENT
 S.L.M. 200+57

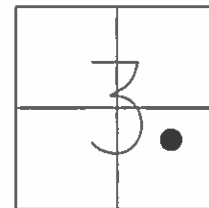

GRID: NORTHING: 705022.4238 EASTING: 1610279.754

RECORD:
 FD MON BOX
 W/ IPIN
 GPS, REFA8
 07-29-16

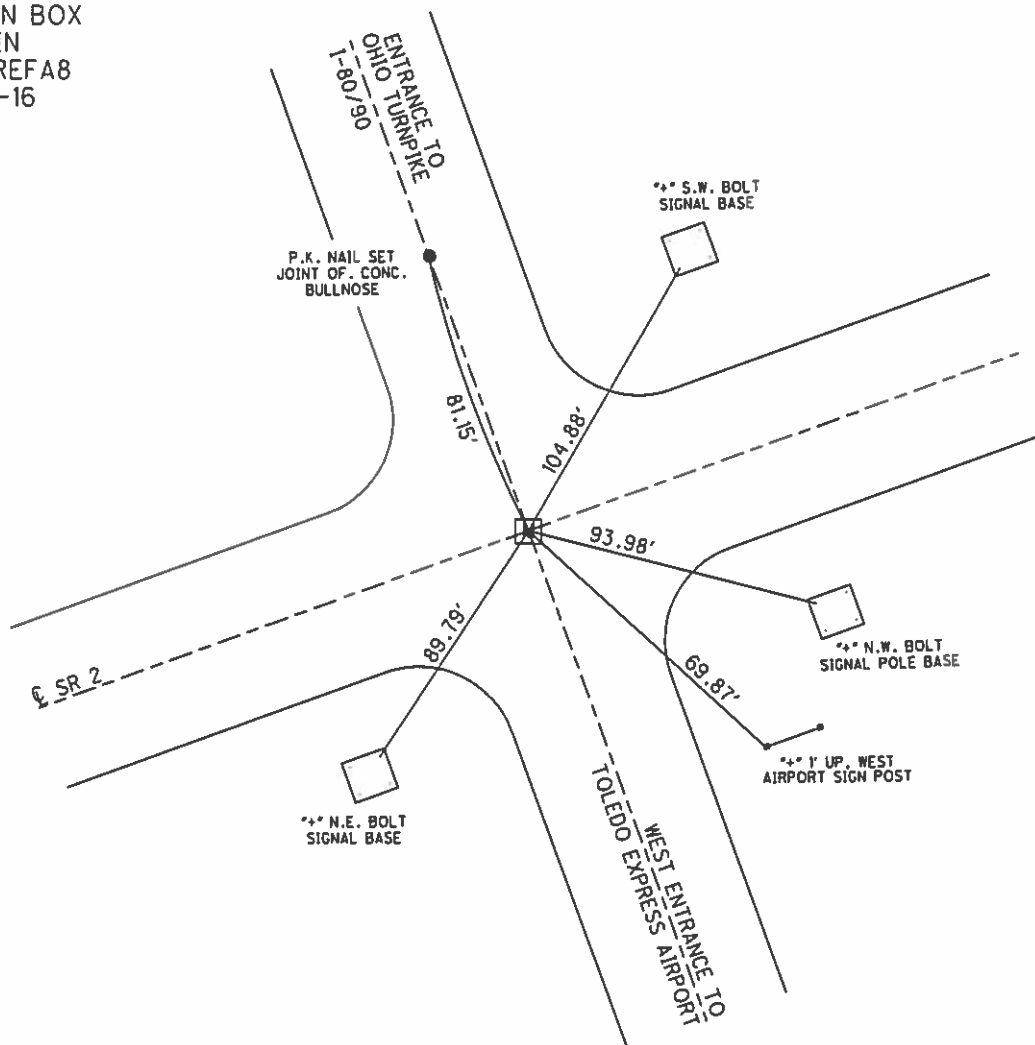

O.D.O.T. DISTRICT 2 SURVEY OFFICE (USE ONLY)

PERSONNEL

REFERENCE NO. 9

SHEET 11 OF 29

NOTES_____HOMAN

DATE 6/15/03

ROUTE SR 2

H.C. HOMAN

WEATHER FAIR

COUNTY LUCAS

R.C. RYALL

TEMP. 75°

TOWNSHIP MONCLOVA

SECTION

DWG BY RHOADES

PID 88525

T_7_N R_9_E

TYPE MONUMENT MONBOX W/5/8" IPIN

ON SURFACE - ~~BELOW~~ _____ ON

OFFSET C PAVEMENT ON LT : RT


_____TO_____EDGE PAVEMENT

STATION: 219+12.00


HORZ.DATUM: NAD83 2011

GEOID: NAVD88 2012A

GRID: NORTHING: 705501.828

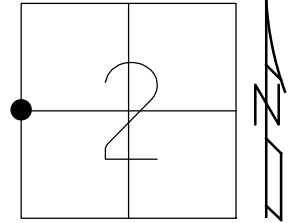EASTING: 161281.334

RECORD:
FD MON BOX
W/ IPIN
4/1/94, CL
FD MONBOX
W/ 5/8" IPIN
REF9
1/27/15, EBW
7/29/16, DCH

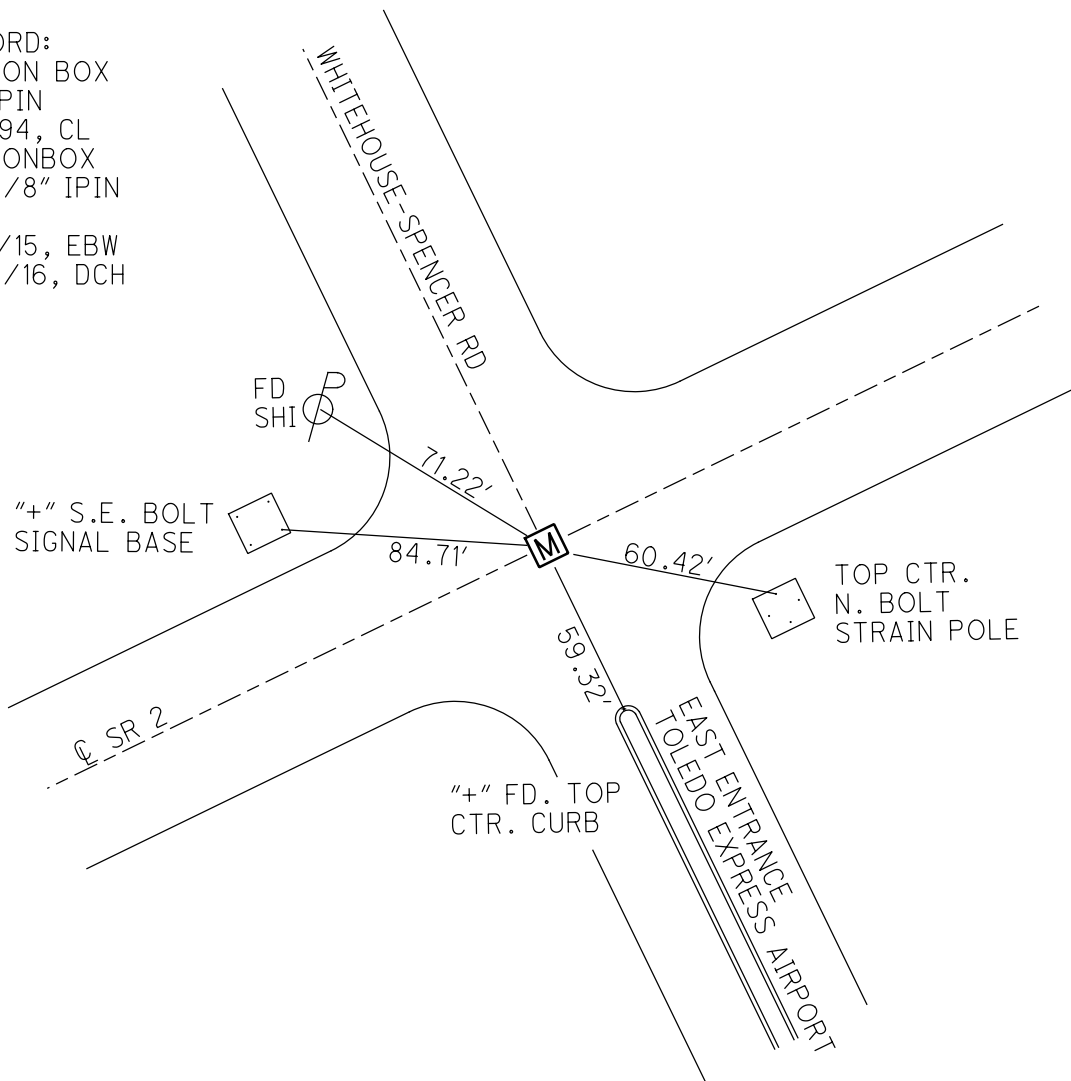

O.D.O.T. DISTRICT 2 SURVEY OFFICE (USE ONLY)

PERSONNEL

REFERENCE NO. 10

SHEET 12 OF 29

NOTES LOEHRKE

DATE 4/1/94

ROUTE SR 2

H.C. CANTERBURY

WEATHER NICE

COUNTY LUCAS

R.C. VOGEL

TEMP. 52°

TOWNSHIP MONCLOVA

DWG BY RHOADES

PID 88525

SECTION 2

T 7 N R 9 E

TYPE MONUMENT MONBOX W/1" IPIN

ON SURFACE - ~~BELOW~~ ON

OFFSET Q PAVEMENT ON LT : RT

- TO - EDGE PAVEMENT


STATION: 258+23.08

HORIZ.DATUM: NAD83 2011


GEOID: NAVD88 2012A

GRID: NORTHING: 707199.929

EASTING: 1614804.559

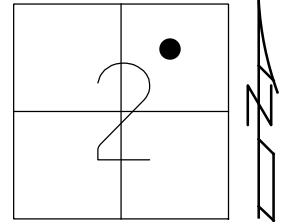

RECORD:
FD MON BOX
W/ IPIN
4/1/94, CL
FD MONBOX
W/ 1" IPIN
REF10
1/27/15, EBW

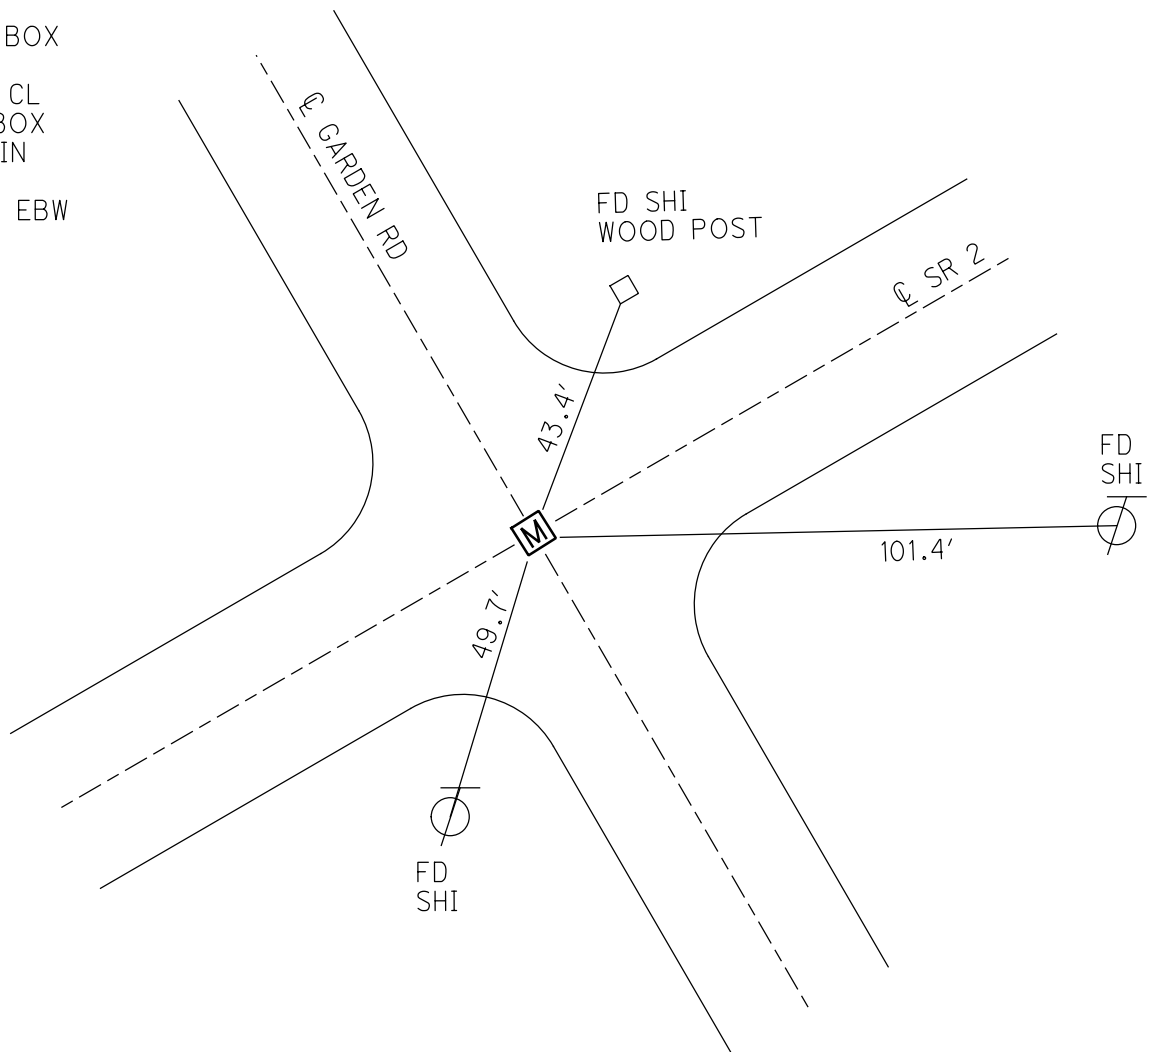

O.D.O.T. DISTRICT 2 SURVEY OFFICE (USE ONLY)

PERSONNEL

REFERENCE NO. 11

SHEET 13 OF 29

NOTES LOEHRKE

DATE 4/1/94

ROUTE SR 2

H.C. CANTERBURY

WEATHER NICE

COUNTY LUCAS

R.C. VOGEL

TEMP. 52°

TOWNSHIP MONCLOVA

DWG BY RHOADES

PID 88525

SECTION 2

T 7 N R 9 E

TYPE MONUMENT MONBOX W/1" IPIN

ON SURFACE - ~~BELOW~~ ON

OFFSET Q PAVEMENT ON LT : RT

- TO - EDGE PAVEMENT


STATION: 278+80.54

HORZ.DATUM: NAD83 2011


GEOID: NAVD88 2012A

GRID: NORTHING: 708090.573

EASTING: 1616659.261

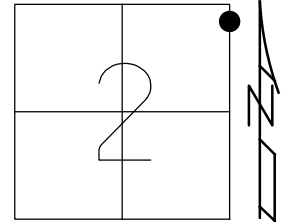

RECORD:
FD MON BOX
W/ IPIN
4/1/94, CL
FD MONBOX
W/ 3/4" IPIN
REF11
1/27/15, EBW

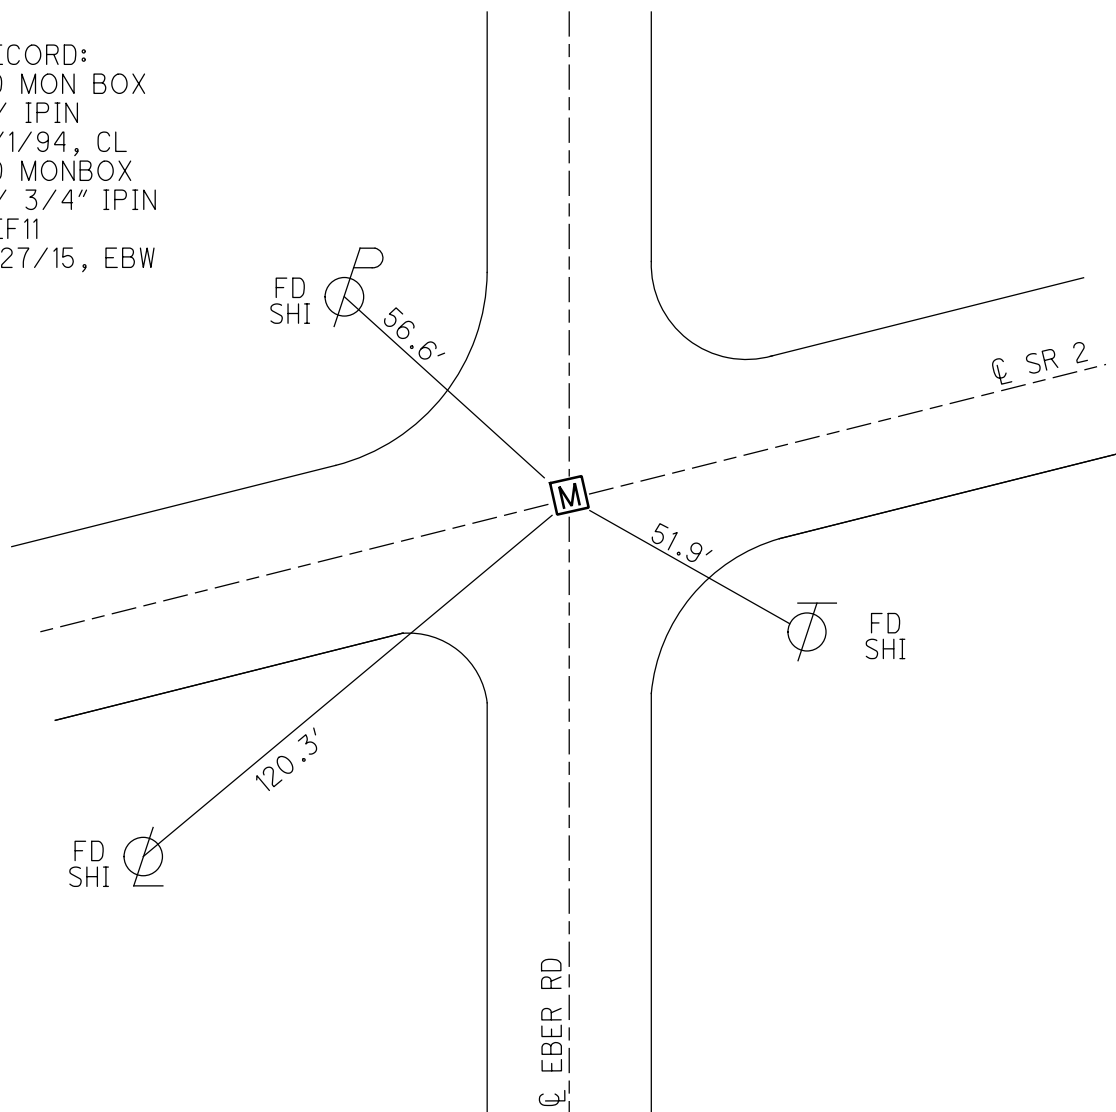

O.D.O.T. DISTRICT 2 SURVEY OFFICE (USE ONLY)

PERSONNEL

REFERENCE NO. 11 A

SHEET 14 OF 29

NOTES LOEHRKE
H.C. CANTERBURY
R.C. VOGEL

DATE 4/1/94
WEATHER NICE
TEMP. 52°

ROUTE SR 2
COUNTY LUCAS
TOWNSHIP SPRINGFIELD
SECTION 1

DWG BY RHOADES PID 88525

T 7 N R 9 E

TYPE MONUMENT MONBOX W/ 3/4" IPIN

ON SURFACE - ~~BELOW~~ ON

OFFSET CL PAVEMENT ON LT : RT

- TO - EDGE PAVEMENT


STATION: 284+30.42

HORZ.DATUM: NAD83 2011


GEOID: NAVD88 2012A

GRID: NORTHING: 708331.709

EASTING: 1617153.446

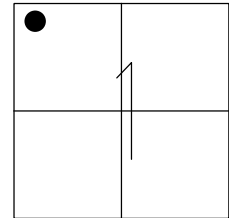

RECORD:
FD MON BOX
W/IPIN
4/1/94, CL
FD MONBOX
W/ 3/4" IPIN
REFA11
1/27/15, EBW

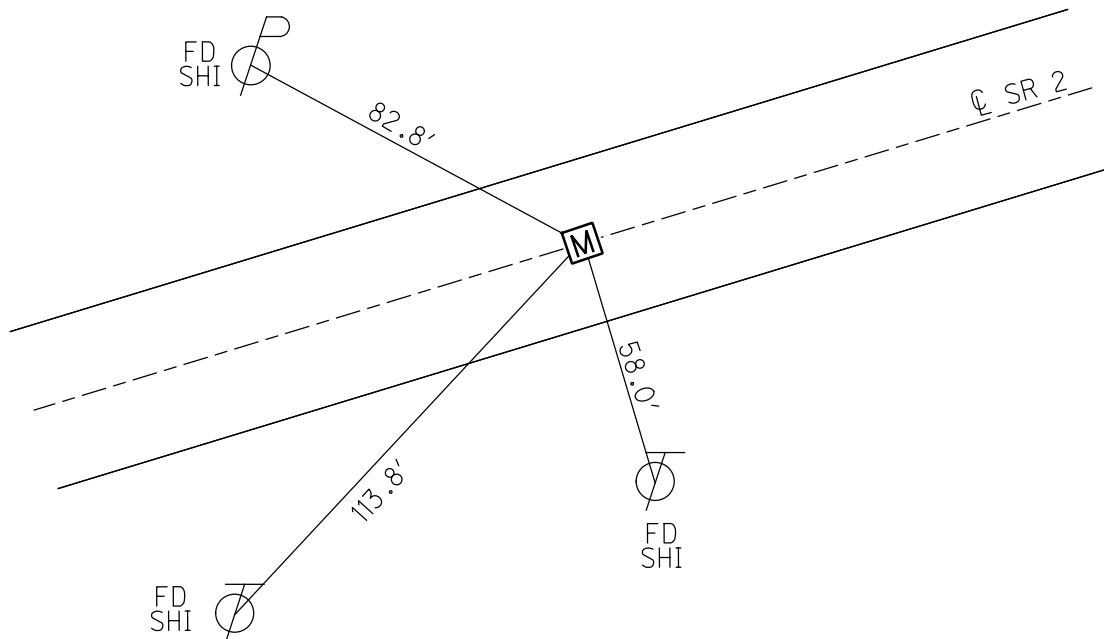

O.D.O.T. DISTRICT 2 SURVEY OFFICE (USE ONLY)

PERSONNEL

REFERENCE NO. 11 AA

SHEET 15 OF 29

NOTES LOEHRKE

DATE 4/1/94

ROUTE SR 2

H.C. CANTERBURY

WEATHER NICE

COUNTY LUCAS

R.C. VOGEL

TEMP. 52°

TOWNSHIP SPRINGFIELD

SECTION 1

DWG BY RHOADES PID 88525

T 7 N R 9 E

TYPE MONUMENT MONBOX

ON SURFACE - ~~BELOW~~ ON

OFFSET CL PAVEMENT ON LT : RT

31' TO RT EDGE PAVEMENT


STATION: 289+90.09

HORIZ.DATUM: NAD83 2011


GEOID: NAVD88 2012A

GRID: NORTHING: 708578.891

EASTING: 1617660.503

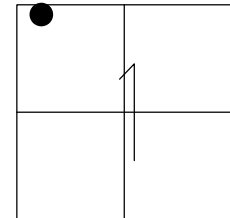

RECORD: T.S.
FD MONBOX
4/1/94, CL
FD 1/2" IPIPE
0.3' DOWN
REFAA11
1/28/15, EBW
FD MONBOX
11/21/22, TDN

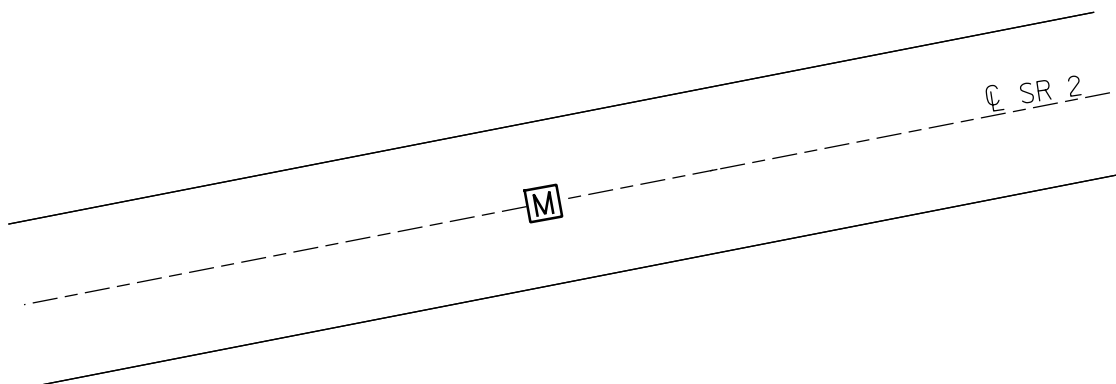

O.D.O.T. DISTRICT 2 SURVEY OFFICE (USE ONLY)

PERSONNEL

REFERENCE NO. 11 AB

SHEET 16 OF 29

NOTES LOEHRKE

DATE 4/1/94

ROUTE SR 2

H.C. CANTERBURY

WEATHER NICE

COUNTY LUCAS

R.C. VOGEL

TEMP. 52°

TOWNSHIP SPRINGFIELD

DWG BY RHOADES

PID 88525

SECTION 36

T 7 N R 9 E

TYPE MONUMENT MONBOX W/ 1" IPIN

ON SURFACE - ~~BELOW~~ ON

OFFSET CL PAVEMENT ON LT : RT

31' TO RT EDGE PAVEMENT


STATION: 295+48.08

HORIZ.DATUM: NAD83 2011


GEOID: NAVD88 2012A

GRID: NORTHING: 708608.169

EASTING: 1618224.305

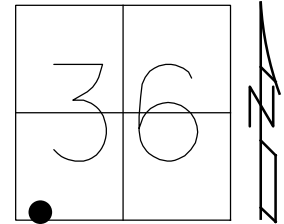

RECORD:
FD MONBOX
W/ 1" IPIN
4/1/94, CL
REFAB11
1/29/15, EBW
11/21/22, TDN

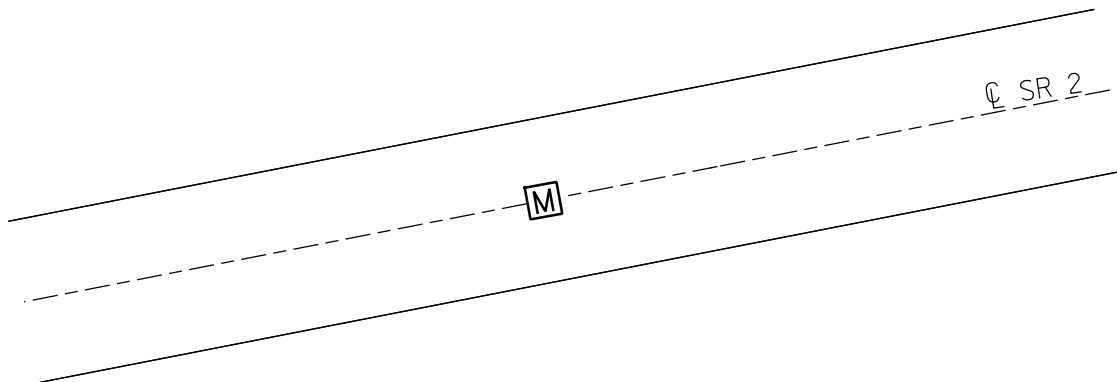

O.D.O.T. DISTRICT 2 SURVEY OFFICE (USE ONLY)

PERSONNEL

REFERENCE NO. 11 AC

SHEET 17 OF 29

NOTES LEU

DATE 6/1/17

ROUTE SR 2

H.C. HOMAN

WEATHER SUNNY

COUNTY LUCAS

R.C. CARSON

TEMP. 70°

TOWNSHIP SPRINGFIELD

DWG BY RHOADES

PID 88525

SECTION 36

T 8 N R 9 E

TYPE MONUMENT MAG/WASHER

ON SURFACE - ~~BELOW~~ ON

OFFSET Q PAVEMENT ON LT : RT

TO EDGE PAVEMENT


STATION: 302+98.46

HORIZ.DATUM: NAD83 2011


GEOID: NAVD88 2012A

GRID: NORTHING: 708648.499

EASTING: 1618973.614

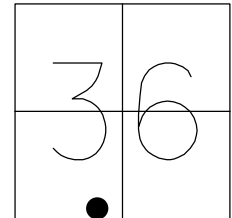

RECORD:
FD P.K.NAIL
SET MAG/WASHER
NEWREFAC11
6/01/17, JLL
FD MAG/WASHER
REFAC11
8/18/20, DSA
4/30/21, DSA
11/21/22, TDN

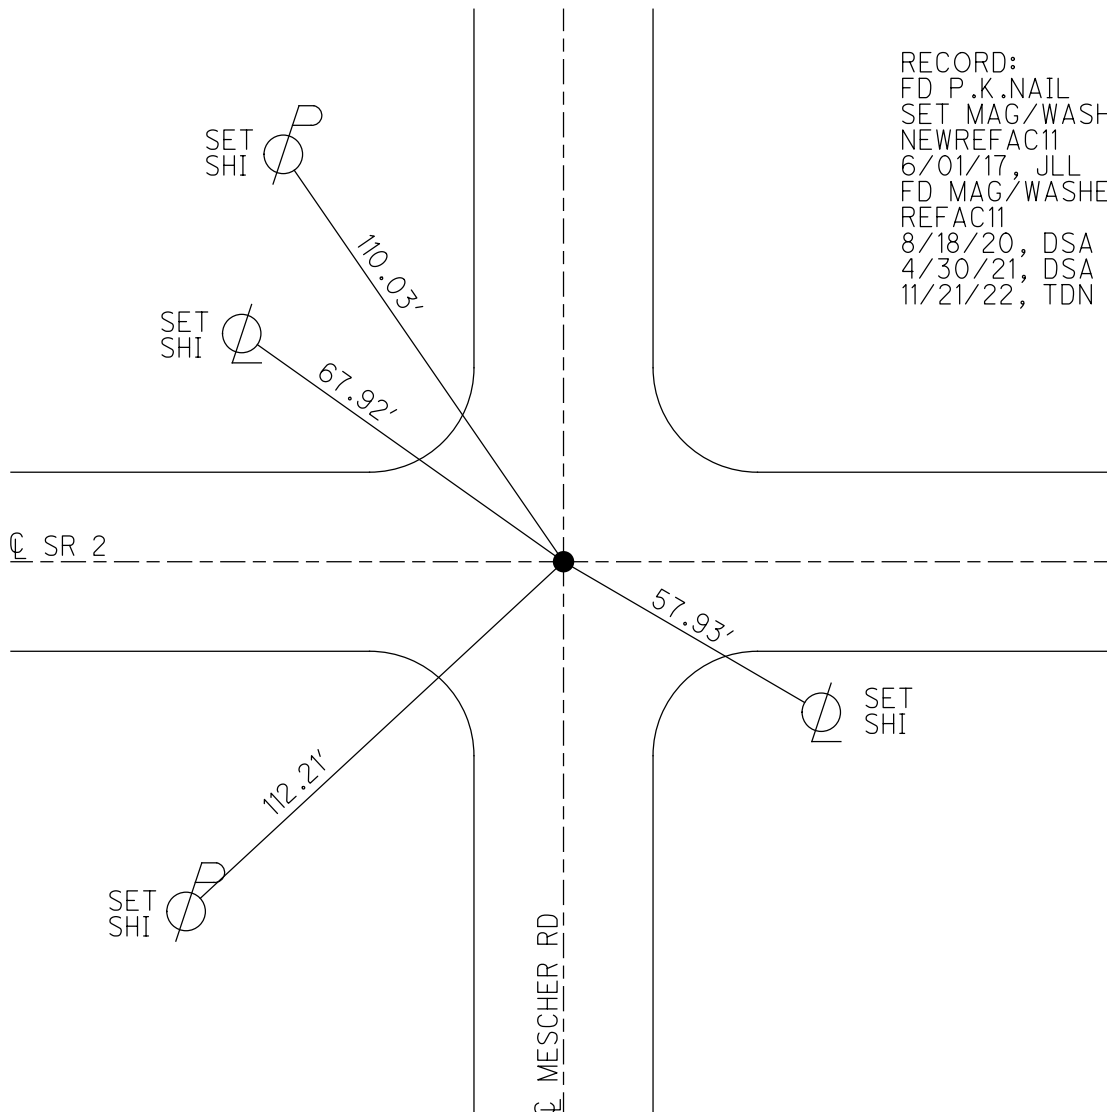

O.D.O.T. DISTRICT 2 SURVEY OFFICE (USE ONLY)

PERSONNEL

REFERENCE NO. 11 B

SHEET 18 OF 29

NOTES LOEHRKE

DATE 4/1/94

ROUTE SR 2

H.C. CANTERBURY

WEATHER NICE

COUNTY LUCAS

R.C. VOGEL

TEMP. 52°

TOWNSHIP SPRINGFIELD

DWG BY RHOADES PID 88525

SECTION 36

T 8 N R 9 E

TYPE MONUMENT MONBOX

ON SURFACE - ~~BELOW~~ ON

OFFSET ☉ PAVEMENT ON LT : RT

25.0' TO LT EDGE PAVEMENT


STATION: 307+19.59

HORZ.DATUM: NAD83(2011)


GEOID: NAVD88 2018

GRID: NORTHING: 708671.082

EASTING: 1619394.127

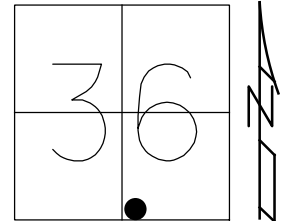

RECORD: P.C.
FD MONBOX
4/1/94, CAL
FD "X" LID
W/ STRATLERS
REFB11
1/28/15, EBW
FD MONBOX
W/ 1" IPIN
REFB11
8/18/20
4/30/21, DSA
11/21/22, TDN

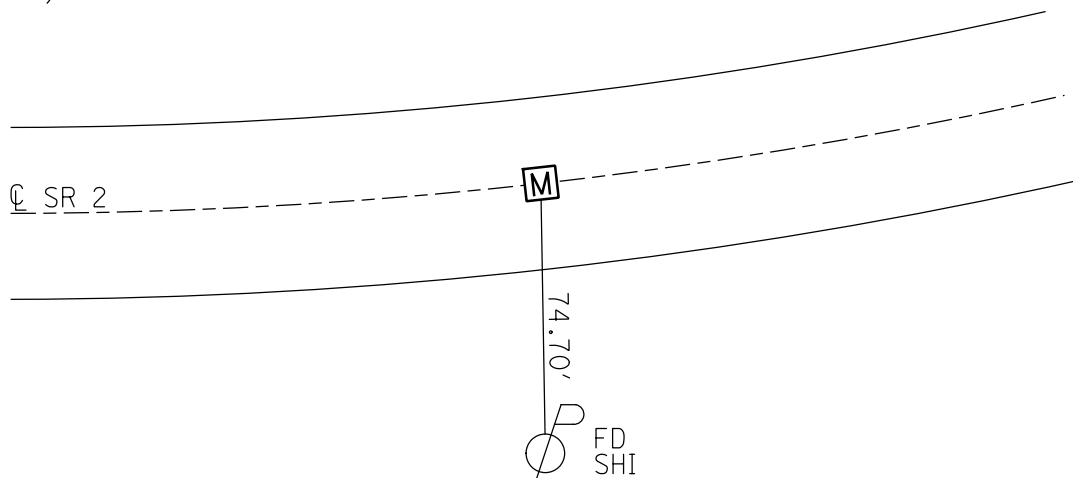

O.D.O.T. DISTRICT 2 SURVEY OFFICE (USE ONLY)

PERSONNEL

REFERENCE NO. 11 C

SHEET 19 OF 29

NOTES LOEHRKE

DATE 3/29/94

ROUTE SR 2

H.C. CANTERBURY

WEATHER NICE

COUNTY LUCAS

R.C. VOGEL

TEMP. 50°

TOWNSHIP SPRINGFIELD

DWG BY RHOADES PID 88525

SECTION 36

T 8 N R 9 E

TYPE MONUMENT MONBOX

ON SURFACE - ~~BELOW~~ ON

OFFSET CL PAVEMENT 10.0' ~~LT~~ : RT

15.0' TO RT EDGE PAVEMENT


STATION: 311+04.98

HORZ.DATUM: NAD83(2011)


GEOID: NAVD88 2018

GRID: NORTHING: 708691.126

EASTING: 1619767.908

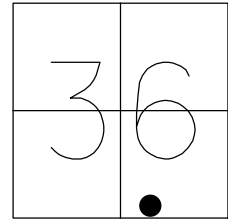

RECORD: P.I.
FD MONBOX
3/29/94, CL
FD MONBOX
W/ 1" IPIN
REFC11
1/27/15, EBW
8/31/20
4/30/21, DSA
11/21/22, TDN

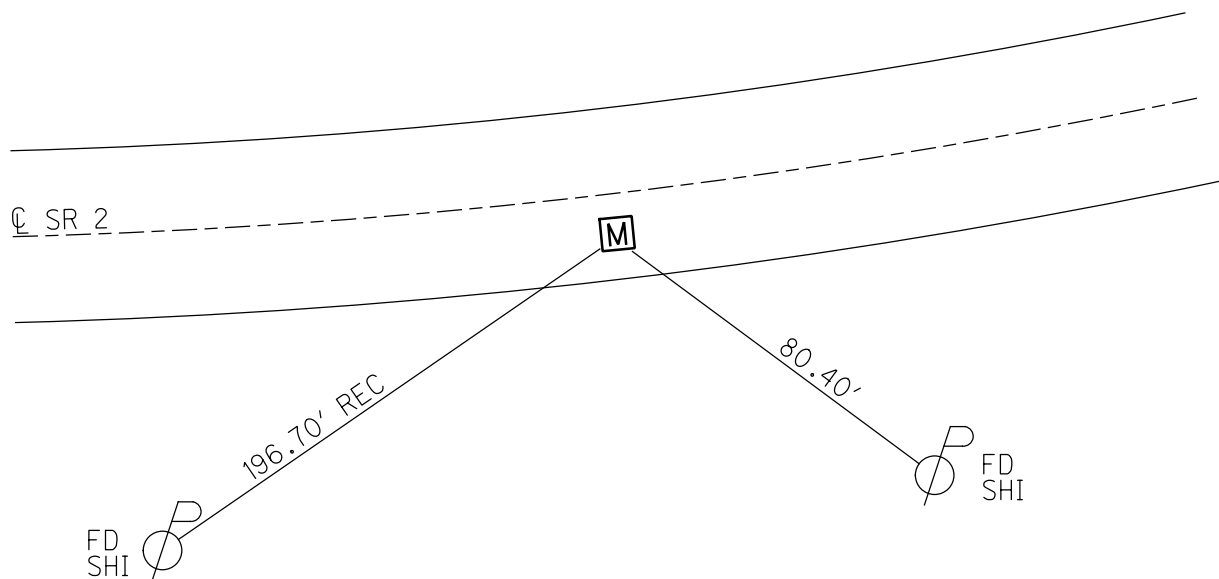

O.D.O.T. DISTRICT 2 SURVEY OFFICE (USE ONLY)

PERSONNEL

REFERENCE NO. 11 D

SHEET 20 OF 29

NOTES LOEHRKE

DATE 3/29/94

ROUTE SR 2

H.C. CANTERBURY

WEATHER NICE

COUNTY LUCAS

R.C. VOGEL

TEMP. 48°

TOWNSHIP SPRINGFIELD

SECTION 36

DWG BY RHOADES PID 88525

T 8 N R 9 E

TYPE MONUMENT MONBOX

ON SURFACE - ~~BELOW~~ ON

OFFSET ℄ PAVEMENT ON LT : RT

15.0' TO RT EDGE PAVEMENT


STATION: 314+69.88

HORZ.DATUM: NAD83(2011)


GEOID: NAVD88 2018

GRID: NORTHING: 708764.403

EASTING: 1620134.977

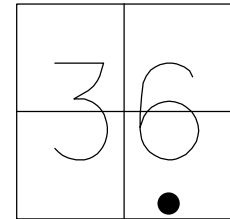

RECORD: S.T.
FD MONBOX
3/29/94, CAL
FD MONBOX
W/ 1" IPIN
REFD11
1/28/15, EBW
FD MONBOX
W/ 1" IPIN
REFD11
8/18/20
4/30/21, DSA
11/21/22, TDN

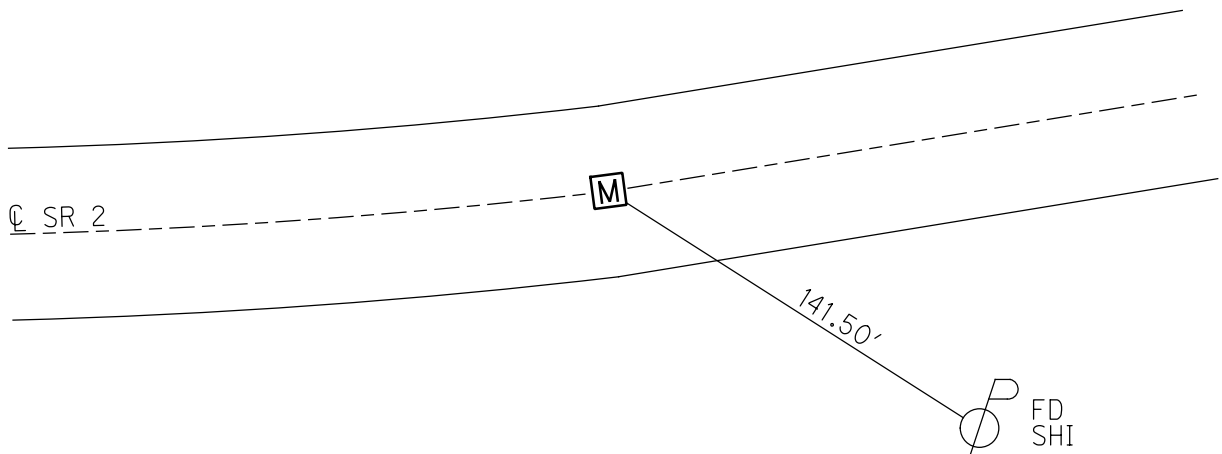

O.D.O.T. DISTRICT 2 SURVEY OFFICE (USE ONLY)

PERSONNEL

REFERENCE NO. 11 E

SHEET 21 OF 29

NOTES LOEHRKE

DATE 3/29/94

ROUTE SR 2

H.C. CANTERBURY

WEATHER NICE

COUNTY LUCAS

R.C. VOGEL

TEMP. 48°

TOWNSHIP SPRINGFIELD

DWG BY RHOADES

PID 88525

SECTION 31

T 8 N R 10 E

TYPE MONUMENT MONBOX

ON SURFACE - ~~BELOW~~ ON

OFFSET 0 PAVEMENT ON LT : RT

25.0' TO RT EDGE PAVEMENT


STATION: 341+45.68

HORZ.DATUM: NAD83(2011)


GEOID: NAVD88 2018

GRID: NORTHING: 709288.328

EASTING: 1622758.977

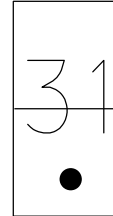

RECORD: T.S.
FD MONBOX
3/29/94, CAL
FD MONBOX
W/ "X" ON LID
REFE11
1/28/15, EBW
FD MONBOX
W/ 1" IPIN
REFE11
8/18/20
4/30/21, DSA
11/21/22, TDN

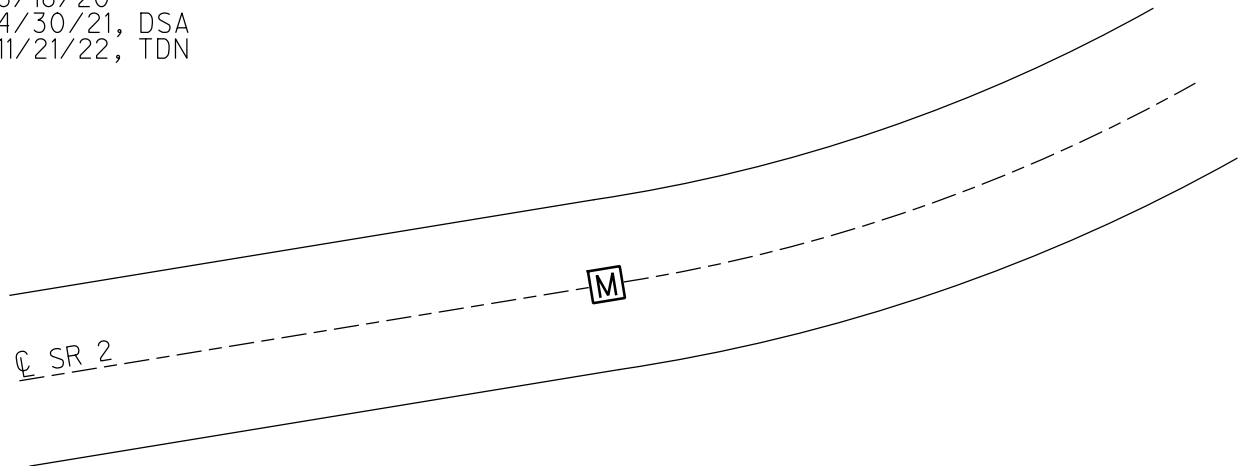

O.D.O.T. DISTRICT 2 SURVEY OFFICE (USE ONLY)

PERSONNEL

REFERENCE NO. 11 F

SHEET 22 OF 29

NOTES LOEHRKE

DATE 3/29/94

ROUTE SR 2

H.C. CANTERBURY

WEATHER NICE

COUNTY LUCAS

R.C. VOGEL

TEMP. 50°

TOWNSHIP SPRINGFIELD

DWG BY RHOADES

PID 88525

SECTION 31

T 8 N R 10 E

TYPE MONUMENT MONBOX

ON SURFACE - ~~BELOW~~ ON

OFFSET CL PAVEMENT 8.0' ~~LT~~ : RT

16.0' TO RT EDGE PAVEMENT


STATION: 345+12.34

HORZ.DATUM: NAD83(2011)


GEOID: NAVD88 2018

GRID: NORTHING: 709358.310

EASTING: 1623109.373

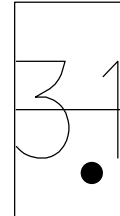

RECORD: P.I.
FD MONBOX
3/29/94, CAL
FD 1" IPIN
REFF11
2/27/15, EBW
FD MONBOX
W/ 1" IPIN
REFF11
8/31/20
4/30/21, DSA
11/21/22, TDN

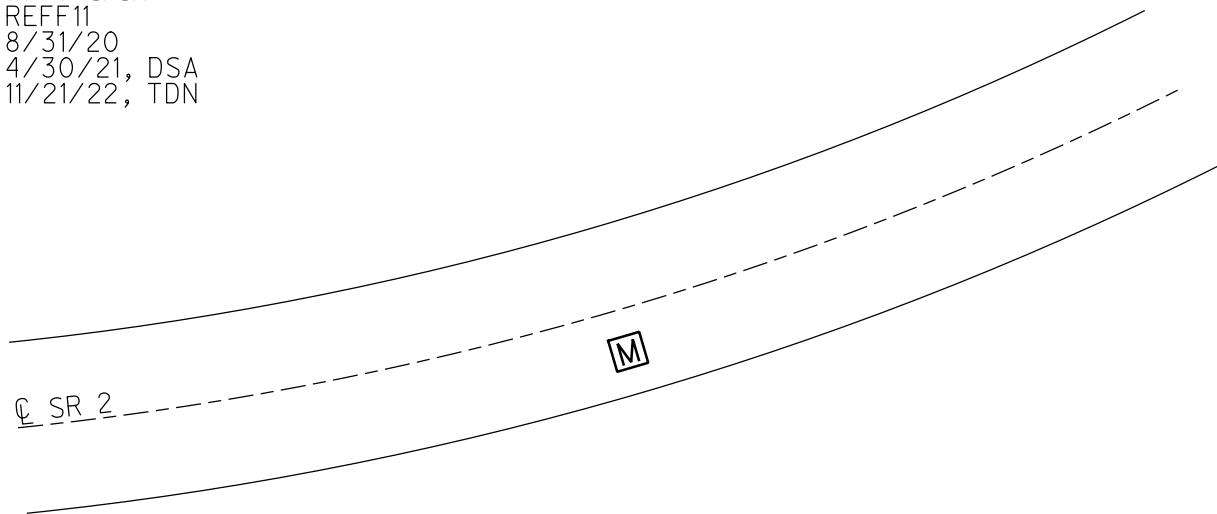

O.D.O.T. DISTRICT 2 SURVEY OFFICE (USE ONLY)

PERSONNEL

REFERENCE NO. 12

SHEET 23 OF 29

NOTES LOEHRKE

DATE 3/29/94

ROUTE SR 2

H.C. CANTERBURY

WEATHER NICE

COUNTY LUCAS

R.C. VOGEL

TEMP. 50°

TOWNSHIP SPRINGFIELD

DWG BY RHOADES PID 88525

SECTION 31

T 8 N R 10 E

TYPE MONUMENT MONBOX

ON SURFACE - ~~BELOW~~ ON

OFFSET Q PAVEMENT ON LT : RT

25.0' TO RT EDGE PAVEMENT


STATION: 348+59.11

HORZ.DATUM: NAD83(2011)


GEOID: NAVD88 2018

GRID: NORTHING: 709474.321

EASTING: 1623446.929

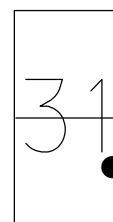

RECORD: S.T.
FD MONBOX
3/29/94, CAL
FD 1" IPIN
REF12
2/27/15, EBW
FD MONBOX
W/ 1" IPIN
REF12
8/31/20
4/30/21, DSA
11/21/22, TDN

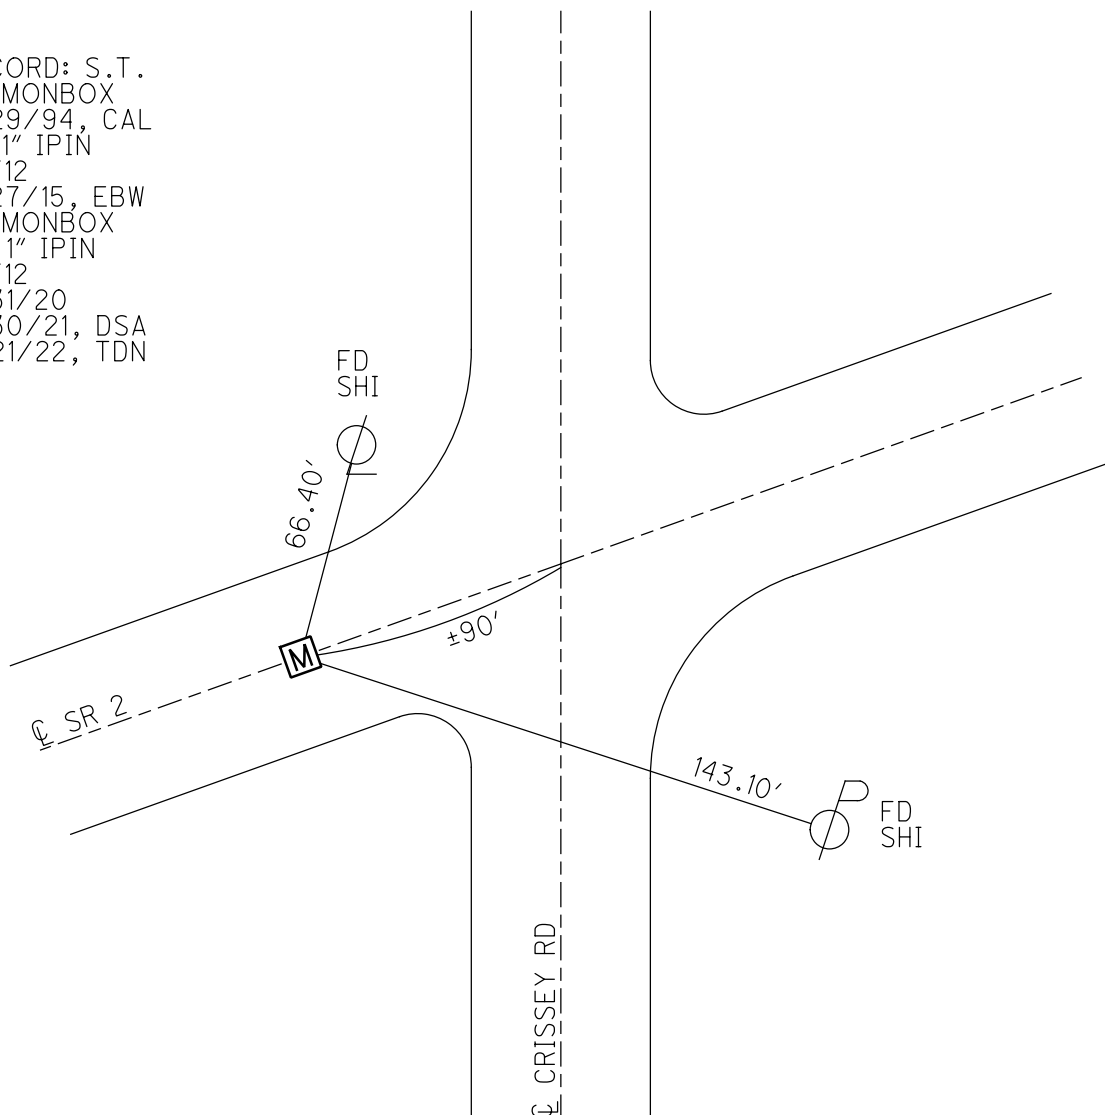

O.D.O.T. DISTRICT 2 SURVEY OFFICE (USE ONLY)

PERSONNEL

REFERENCE NO. 13

SHEET 24 OF 29

NOTES LOEHRKE

DATE 3/29/94

ROUTE SR 2

H.C. CANTERBURY

WEATHER NICE

COUNTY LUCAS

R.C. VOGEL

TEMP. 39°

TOWNSHIP SPRINGFIELD

DWG BY RHOADES PID 88525

SECTION 19

T 7 N R 10 E

TYPE MONUMENT MONBOX

ON SURFACE - ~~BELOW~~ ON

OFFSET CL PAVEMENT ON LT : RT

25' TO RT EDGE PAVEMENT


STATION: 376+97.44

HORZ.DATUM: NAD83 2011


GEOID: NAVD88 2012A

GRID: NORTHING: 710399.126

EASTING: 1626130.369

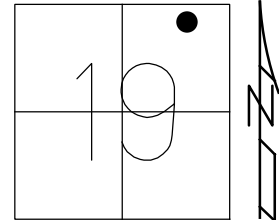

RECORD: T.S.
FD 1" IPIN
REF13
1/30/15, EWB
FD MONBOX
11/21/22, TDN

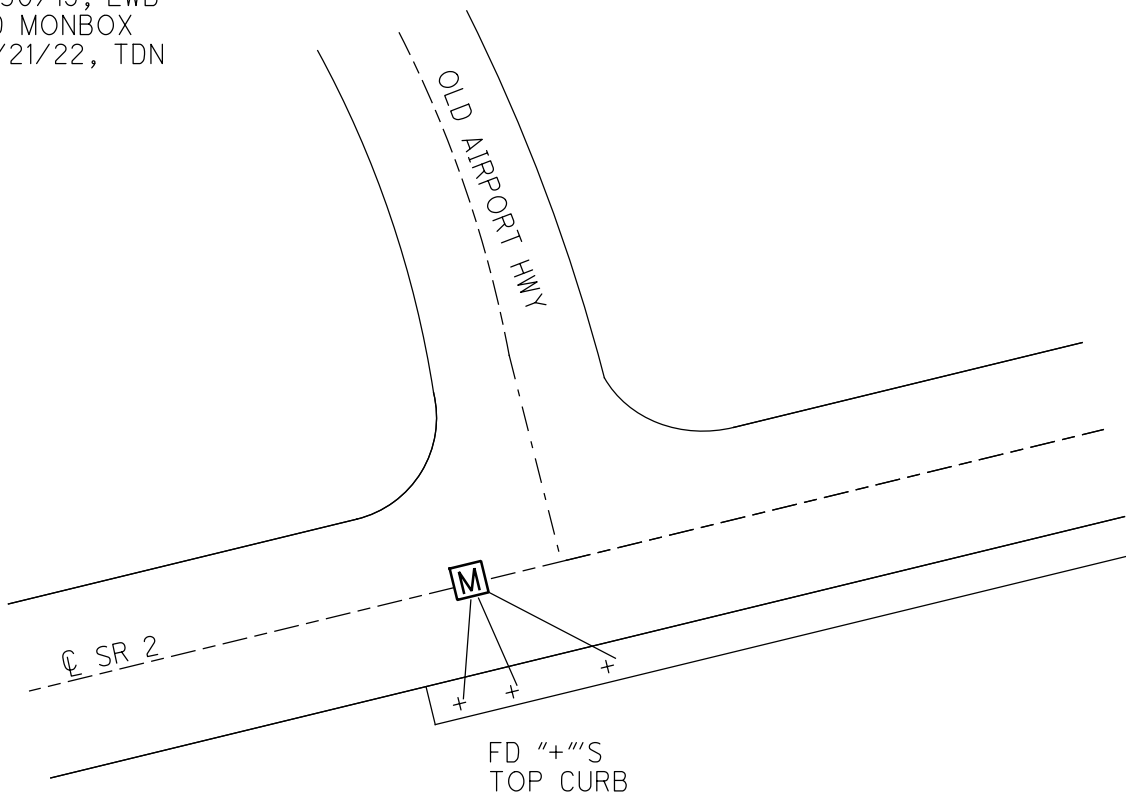

O.D.O.T. DISTRICT 2 SURVEY OFFICE (USE ONLY)

PERSONNEL

REFERENCE NO. 14

SHEET 25 OF 29

NOTES LOEHRKE

DATE 3/29/94

ROUTE SR 2

H.C. CANTERBURY

WEATHER NICE

COUNTY LUCAS

R.C. VOGEL

TEMP. 40°

TOWNSHIP SPRINGFIELD

DWG BY RHOADES

PID 88525

SECTION 19

T 7 N R 10 E

TYPE MONUMENT CMON

ON SURFACE - ~~BELOW~~ ON

OFFSET Q PAVEMENT 30±' LT : ~~RT~~

4.5' LT TO LT EDGE PAVEMENT


STATION: 381+95.86

HORZ.DATUM: NAD83 2011


GEOID: NAVD88 2012A

GRID: NORTHING: 710562.620

EASTING: 1626604.503

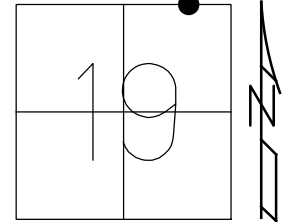

RECORD: P.I.
FD CMON
3/29/94, CL
FD CMON
0.3' DOWN
REF14
1/30/15, EWB

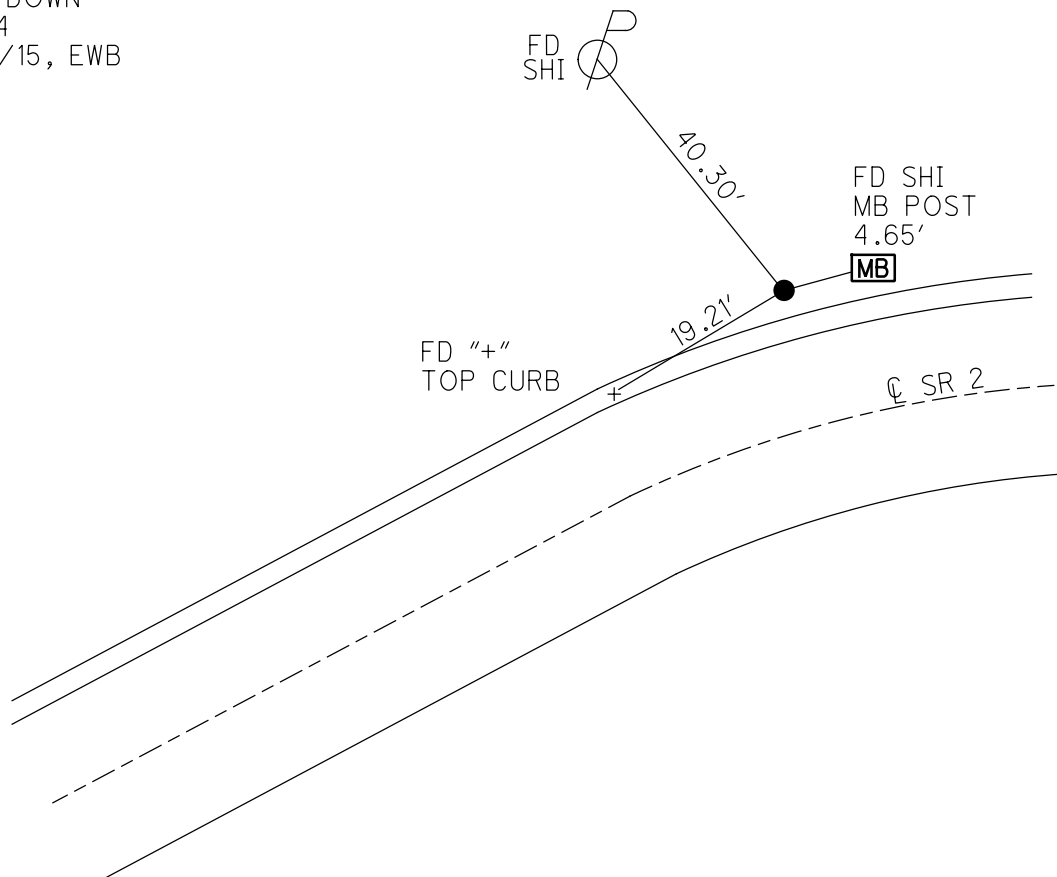

O.D.O.T. DISTRICT 2 SURVEY OFFICE (USE ONLY)

PERSONNEL

REFERENCE NO. 14 A

SHEET 26 OF 29

NOTES LOEHRKE

DATE 3/29/94

ROUTE SR 2

H.C. CANTERBURY

WEATHER NICE

COUNTY LUCAS

R.C. VOGEL

TEMP. 41°

TOWNSHIP SPRINGFIELD

DWG BY RHOADES PID 88525

SECTION 19

T 7 N R 10 E

TYPE MONUMENT MONBOX W/1" IPIN

ON SURFACE - ~~BELOW~~ ON

OFFSET Q PAVEMENT ON LT : RT

25' TO RT EDGE PAVEMENT


STATION: 386+89.01

HORZ.DATUM: NAD83 2011


GEOID: NAVD88 2012A

GRID: NORTHING: 710562.090

EASTING: 1627100.690

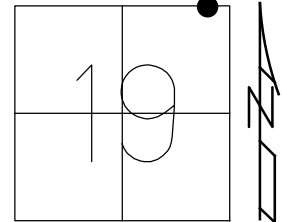

RECORD: ST
FD MONBOX
W/1" IPIN
3/29/94, CL
REFA14
1/30/15, EWB

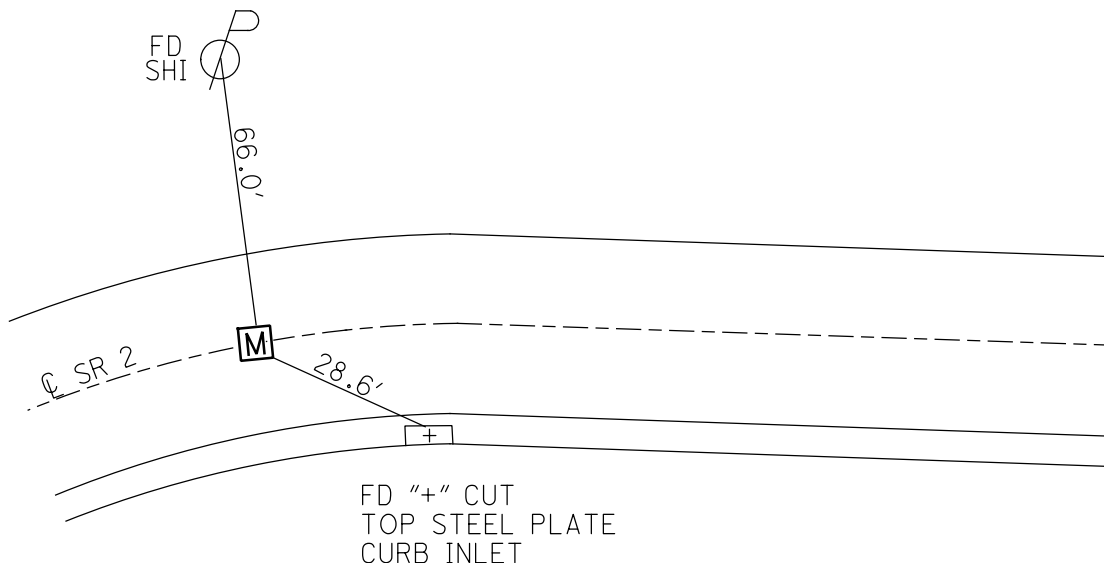

O.D.O.T. DISTRICT 2 SURVEY OFFICE (USE ONLY)

PERSONNEL

REFERENCE NO. 15

SHEET 27 OF 29

NOTES LOEHRKE

DATE 3/30/94

ROUTE SR 2

H.C. CANTERBURY

WEATHER NICE

COUNTY LUCAS

R.C. VOGEL

TEMP. 45°

TOWNSHIP SPRINGFIELD

DWG BY RHOADES

PID 88525

SECTION 19

T 7 N R 10 E

TYPE MONUMENT MONBOX

ON SURFACE - ~~BELOW~~ ON

OFFSET CL PAVEMENT ON LT : RT

25' TO RT EDGE PAVEMENT


STATION: 403+76.74

HORZ.DATUM: NAD83 2011


GEOID: NAVD88 2012A

GRID: NORTHING: 710560.946

EASTING: 1628788.422

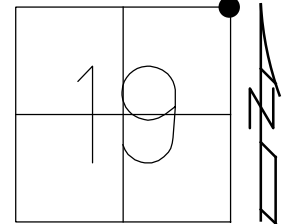

RECORD: P.I.
STA.404+32.58
FD MONBOX
W/ 1" IPIN
3/30/94, CL
REF15
2/3/15, EWB

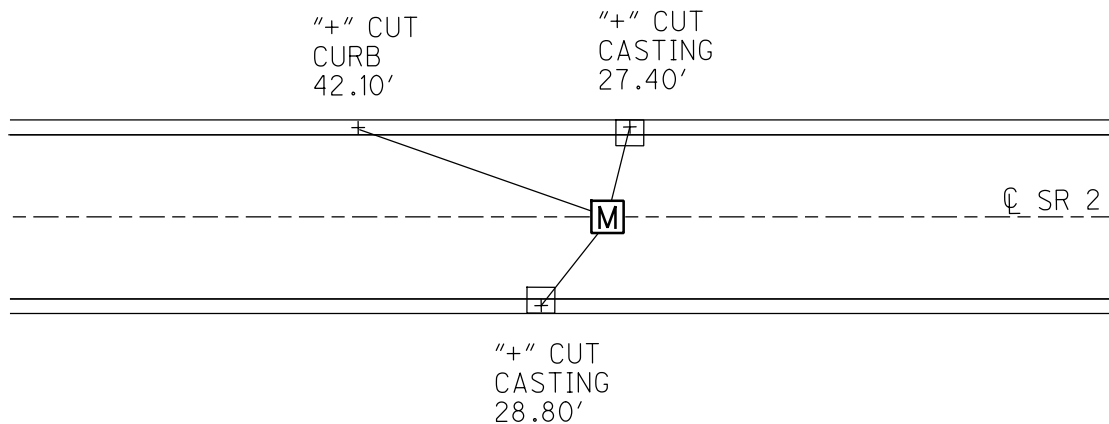

O.D.O.T. DISTRICT 2 SURVEY OFFICE (USE ONLY)

PERSONNEL

REFERENCE NO. 16

SHEET 28 OF 29

NOTES LOEHRKE

DATE 3/30/94

ROUTE SR 2

H.C. CANTERBURY

WEATHER NICE

COUNTY LUCAS

R.C. VOGEL

TEMP. 45°

TOWNSHIP SPRINGFIELD

DWG BY RHOADES

PID 88525

SECTION 20

T 7 N R 10 E

TYPE MONUMENT MONBOX W/1" IPIN

ON SURFACE - ~~BELOW~~ ON

OFFSET CL PAVEMENT ON LT : RT

- TO - EDGE PAVEMENT


STATION: 417+21.42

HORIZ.DATUM: NAD83 2011


GEOID: NAVD88 2012A

GRID: NORTHING: 710546.871

EASTING: 1630133.031

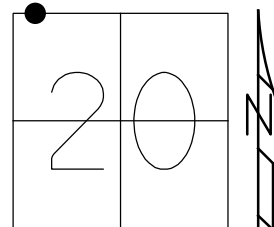

RECORD:
STA. 417+77.23
FD MONBOX
W/1" IPIN
3/30/94, CL
REF16
2/3/15, EBW

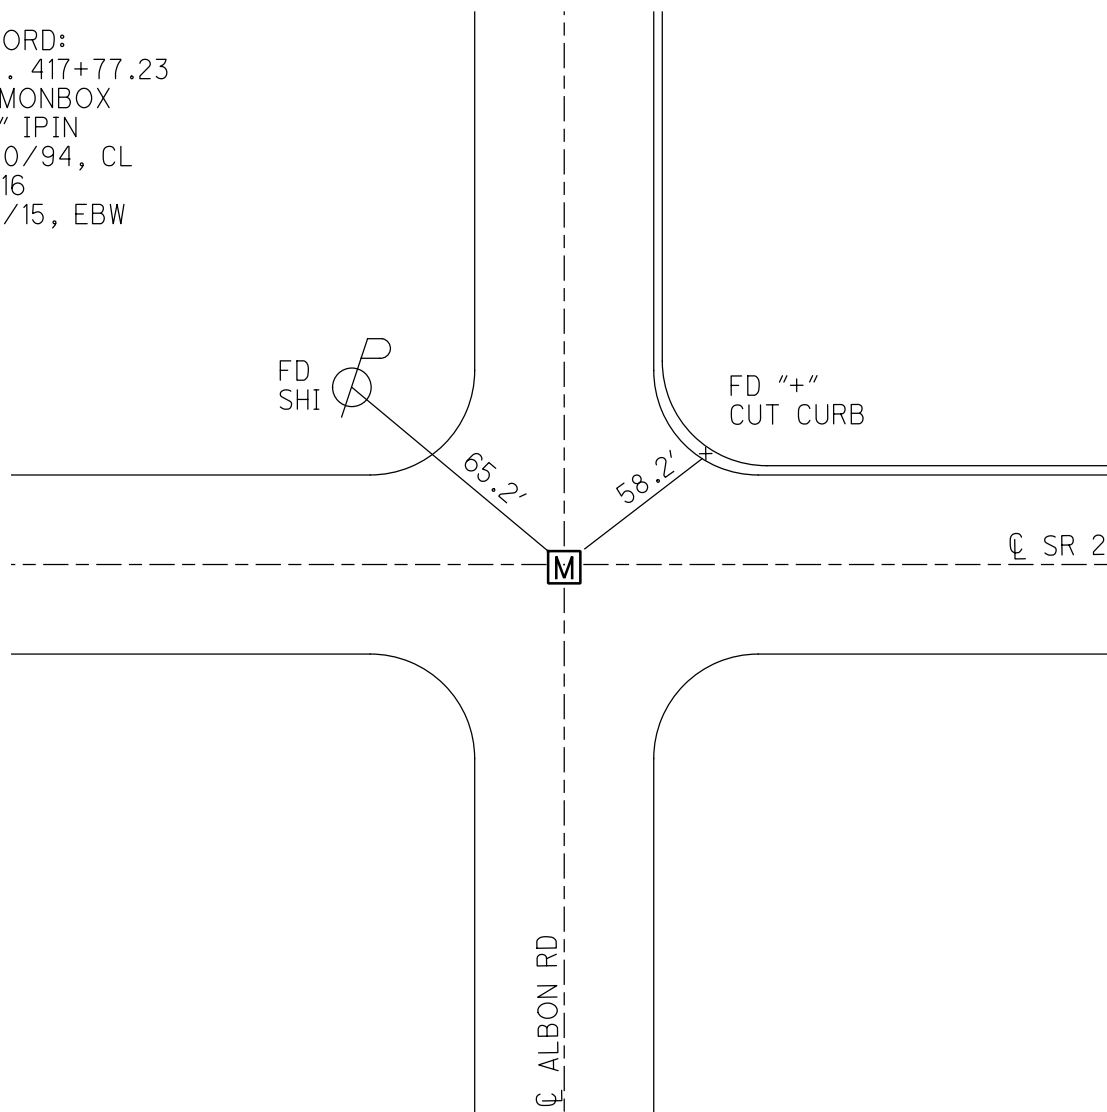

O.D.O.T. DISTRICT 2 SURVEY OFFICE (USE ONLY)

PERSONNEL

REFERENCE NO. 16 A

SHEET 29 OF 29

NOTES LOEHRKE
H.C. CANTERBURY
R.C. VOGEL

DATE 4/1/94
WEATHER NICE
TEMP. 48°

ROUTE SR 2
COUNTY LUCAS
TOWNSHIP SPRINGFIELD
SECTION 20
T 7 N R 10 E

DWG BY RHOADES PID 88525

TYPE MONUMENT MONBOX W/1" IPIN

ON SURFACE - ~~BELOW~~ ON

OFFSET CL PAVEMENT ON LT : RT
25' TO RT EDGE PAVEMENT


STATION: 430+49.34

HORIZ.DATUM: NAD83 2011


GEOID: NAVD88 2012A

GRID: NORTHING: 710533.207

EASTING: 1631460.882

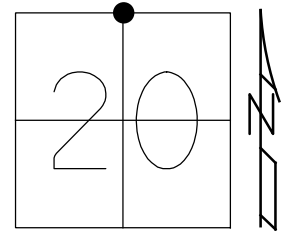

RECORD: P.I.
STA. 431+05.10
FD MONBOW
W/ 1" IPIN
4/1/94, CL
REFA16
2/11/15, EBW

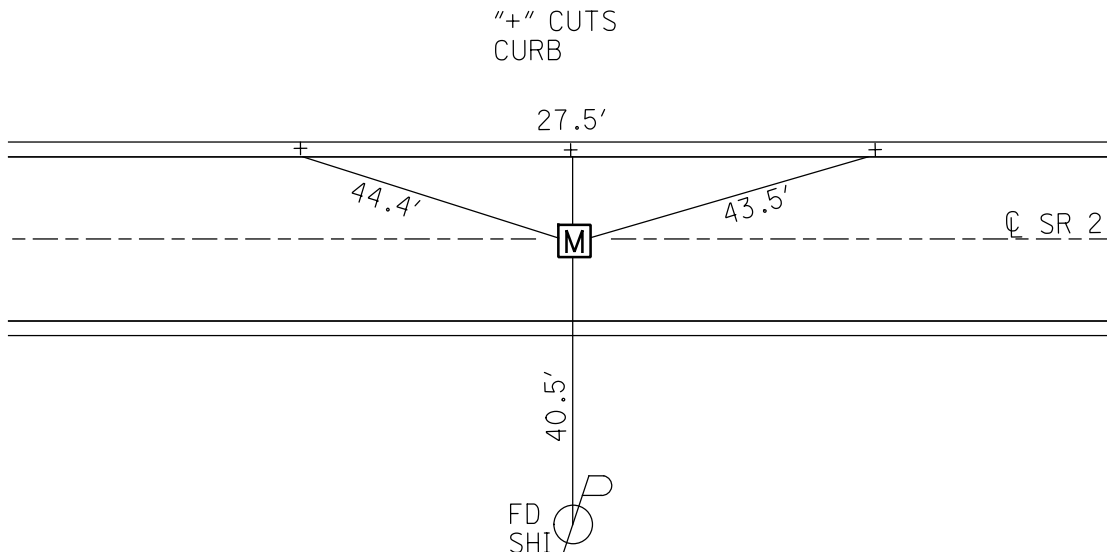

O.D.O.T. DISTRICT 2 SURVEY OFFICE (USE ONLY)

PERSONNEL

REFERENCE NO. 17

SHEET 1 OF 18

NOTES LOEHRKE

DATE 3-30-94

ROUTE SR 2

H.C. CANTERBURY

WEATHER NICE

COUNTY LUCAS

R.C. VOGEL

TEMP. 48°

TOWNSHIP SPRINGFIELD

DWG BY JAMES

PID 95717

SECTION 20

T 7 N R 10 E

TYPE MONUMENT MONBOX W/3/4" IPIN

ON SURFACE - ~~BELOW~~ ON

OFFSET CL PAVEMENT ON LT : RT

25' TO LT EDGE PAVEMENT


STATION: 456+98.62

HORZ.DATUM: NAD83 2011

GEOID: NAVD88 2012A


GRID: NORTHING: 710468.385

EASTING: 1634109.371

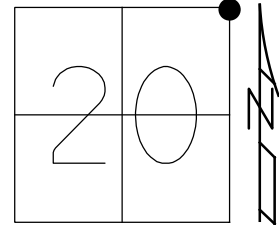

RECORD: P.I.
STA 457+54.39
FD MONBOX
6/14/71, IRS
3-30-94, CL
FD MONBOX
W/ 3/4" IPIN
REF17
2/11/15, EBW
6-23-16, JFO

CUT "+S
IN CASTING

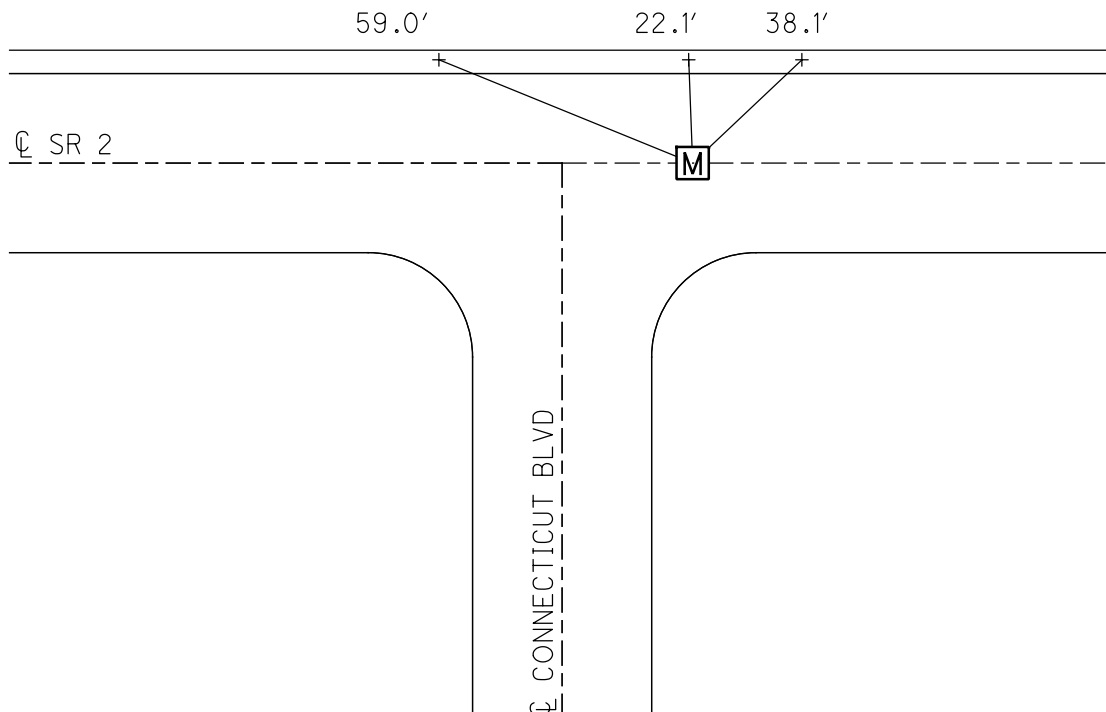

O.D.O.T. DISTRICT 2 SURVEY OFFICE (USE ONLY)

PERSONNEL

REFERENCE NO. 18

SHEET 2 OF 18

NOTES LOEHRKE

DATE 3/30/94

ROUTE SR 2

H.C. CANTERBURY

WEATHER NICE

COUNTY LUCAS

R.C. VOGEL

TEMP. 44°

TOWNSHIP SPRINGFIELD

DWG BY JAMES PID 95717

SECTION 21

T 7 N R 10 E

TYPE MONUMENT MONBOX W/1" IPIN

ON SURFACE - ~~BELOW~~ ON

OFFSET Q PAVEMENT ON LT : RT

- TO - EDGE PAVEMENT


STATION: 483+22.51

HORZ.DATUM: NAD83 2011


GEOID: NAVD88 2012A

GRID: NORTHING: 710423.869

EASTING: 1636732.925

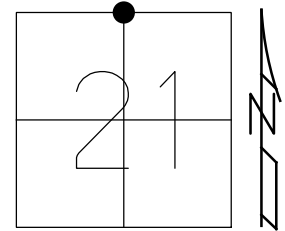

RECORD:
STA. 483+78.28
FD MONBOX
6/14/71, IRS
3-30-94, CL
FD MONBOX
W/ 1" IPIN
REF18
2/11/15, EBW
6-23-16, JFO

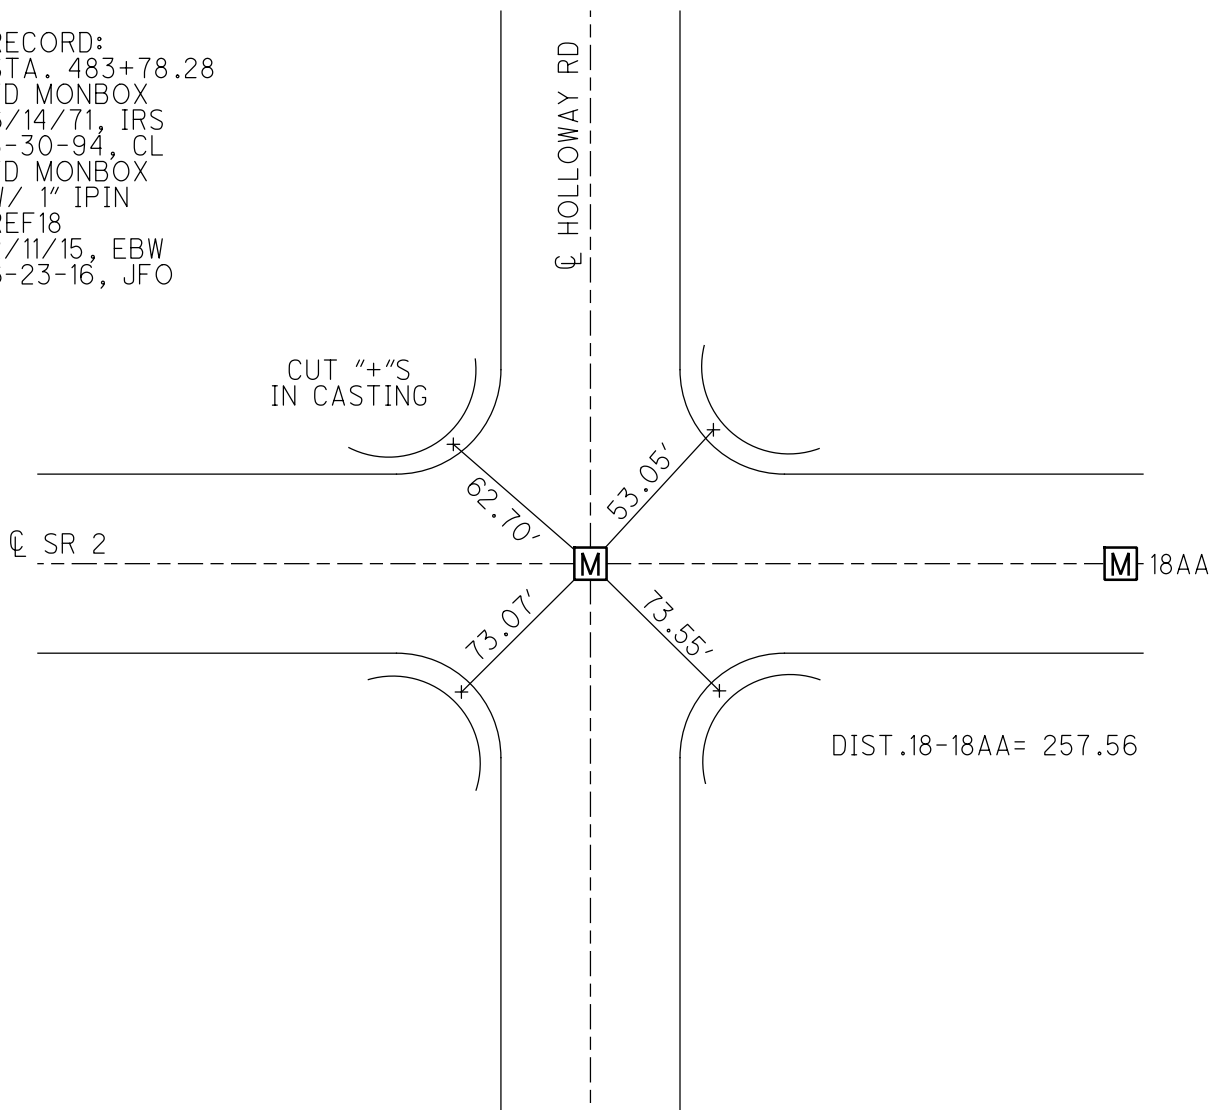

O.D.O.T. DISTRICT 2 SURVEY OFFICE (USE ONLY)

PERSONNEL

REFERENCE NO. 18 AA

SHEET 3 OF 18

NOTES O'DONNELL

DATE 6-23-16

ROUTE SR 2

H.C.

WEATHER

COUNTY LUCAS

R.C.

TEMP.

TOWNSHIP SPRINGFIELD

SECTION 21

DWG BY JAMES

PID 95717

T 7 N R 10 E

TYPE MONUMENT MONBOX W/ 1" IPIN

ON SURFACE - ~~BELOW~~ ON

OFFSET CL PAVEMENT ON LT : RT

 TO EDGE PAVEMENT


STATION: 485+52 ±

HORIZ.DATUM: NAD83 2011

GEOID: NAVD88 2012A

GRID: NORTHING: 710419.886

EASTING: 1636990.491

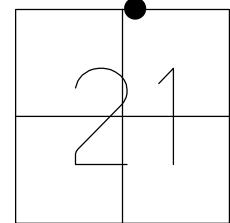

RECORD:
FD MONBOX
W/ 1" IPIN
REFAA18
6-23-16, JFO

CL HOLLOWAY RD

CL SR 2

M

18

M

DIST 18 - 18AA = 257 ±

O.D.O.T. DISTRICT 2 SURVEY OFFICE (USE ONLY)

PERSONNEL

REFERENCE NO. 18 A

SHEET 4 OF 18

NOTES LOEHRKE

DATE 4-1-94

ROUTE SR 2

H.C. CANTERBURY

WEATHER NICE

COUNTY LUCAS

R.C. VOGEL

TEMP. 46°

TOWNSHIP SPRINGFIELD

SECTION 16

DWG BY JAMES PID 95717

T 8 N R 10 E

TYPE MONUMENT MONBOX

ON SURFACE - ~~BELOW~~ ON

OFFSET CL PAVEMENT ON LT : RT

28' TO RT EDGE PAVEMENT


STATION: 495+95

HORZ.DATUM: NAD83 2011


GEOID: NAVD88 2012A

GRID: NORTHING: 710592.059

EASTING: 1638013.350

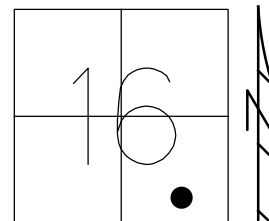

RECORD: P.T.
FD MONBOX
4-1-94, CL
FD MONBOX
W/ 1" IPIN
REFA18
6-23-16, JFO

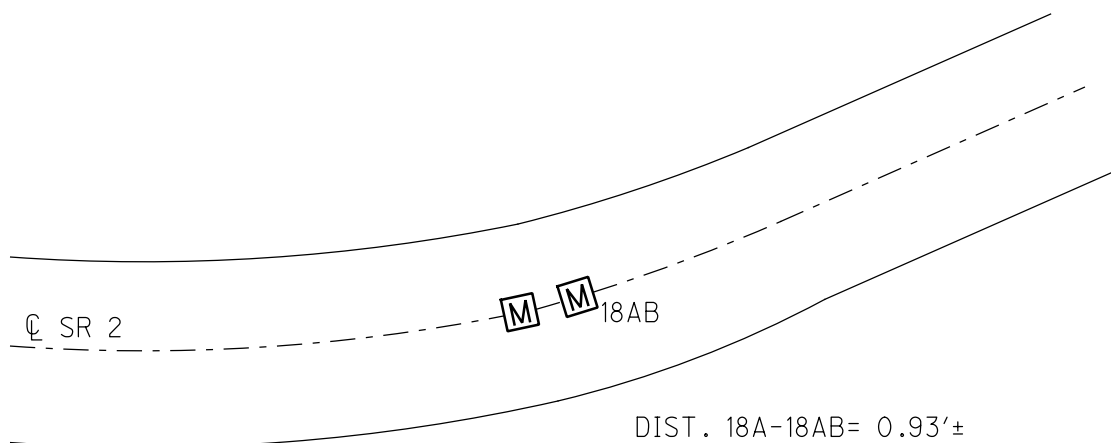

O.D.O.T. DISTRICT 2 SURVEY OFFICE (USE ONLY)

PERSONNEL

REFERENCE NO. 18 AB

SHEET 5 OF 18

NOTES O'DONNELL

DATE 6-23-16

ROUTE SR 2

H.C.

WEATHER

COUNTY LUCAS

R.C.

TEMP.

TOWNSHIP SPRINGFIELD

SECTION 16

DWG BY JAMES

PID 95717

T 8 N R 10 E

TYPE MONUMENT MONBOX W/ 1" IPIN

ON SURFACE - ~~BELOW~~ ON

OFFSET CL PAVEMENT ON LT : RT

- TO - EDGE PAVEMENT


STATION: 495+96±

HORZ.DATUM: NAD83 2011


GEOID: NAVD88 2012A

GRID: NORTHING: 710592.3505

EASTING: 1638014.2880

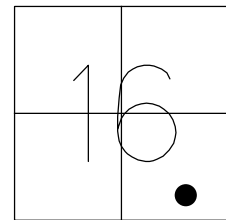

RECORD:
FD MONBOX
W/ 1" IPIN
REFAB18
6-23-16, JFO

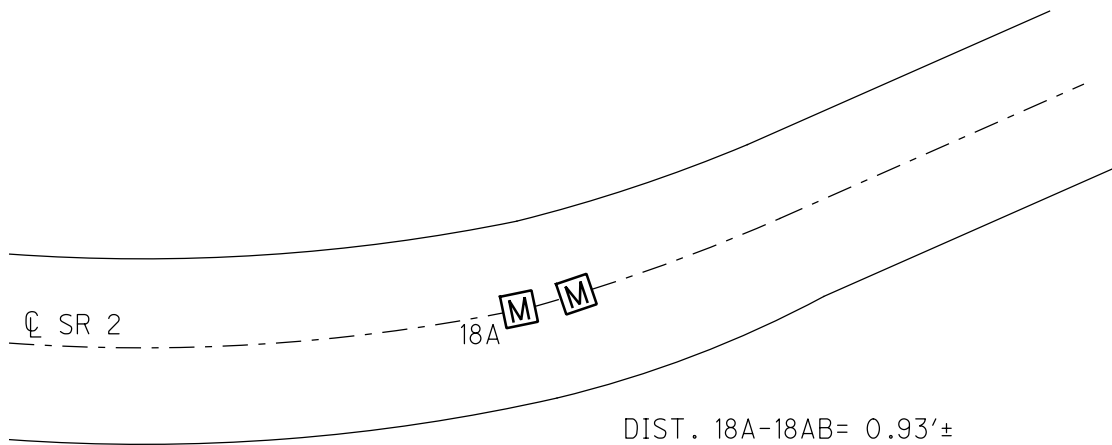

O.D.O.T. DISTRICT 2 SURVEY OFFICE (USE ONLY)

PERSONNEL

REFERENCE NO. 18 B

SHEET 6 OF 18

NOTES LOEHRKE

DATE 4/1/94

ROUTE SR 2

H.C. CANTERBURY

WEATHER NICE

COUNTY LUCAS

R.C. VOGEL

TEMP. 45°

TOWNSHIP SPRINGFIELD

SECTION 16

DWG BY JAMES PID 95717

T 8 N R 10 E

TYPE MONUMENT MONBOX

ON SURFACE - ~~BELOW~~ ON

OFFSET CL PAVEMENT ON LT : RT

28' TO RT EDGE PAVEMENT


STATION: 502+06

HORIZ.DATUM: -


GEOID: -

GRID: NORTHING: -

EASTING: -

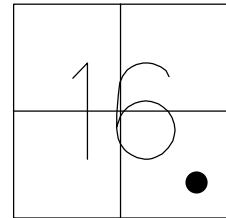

RECORD: P.C.
FD MONBOX
4-1-94, CL
DNF
6-23-16, JFO

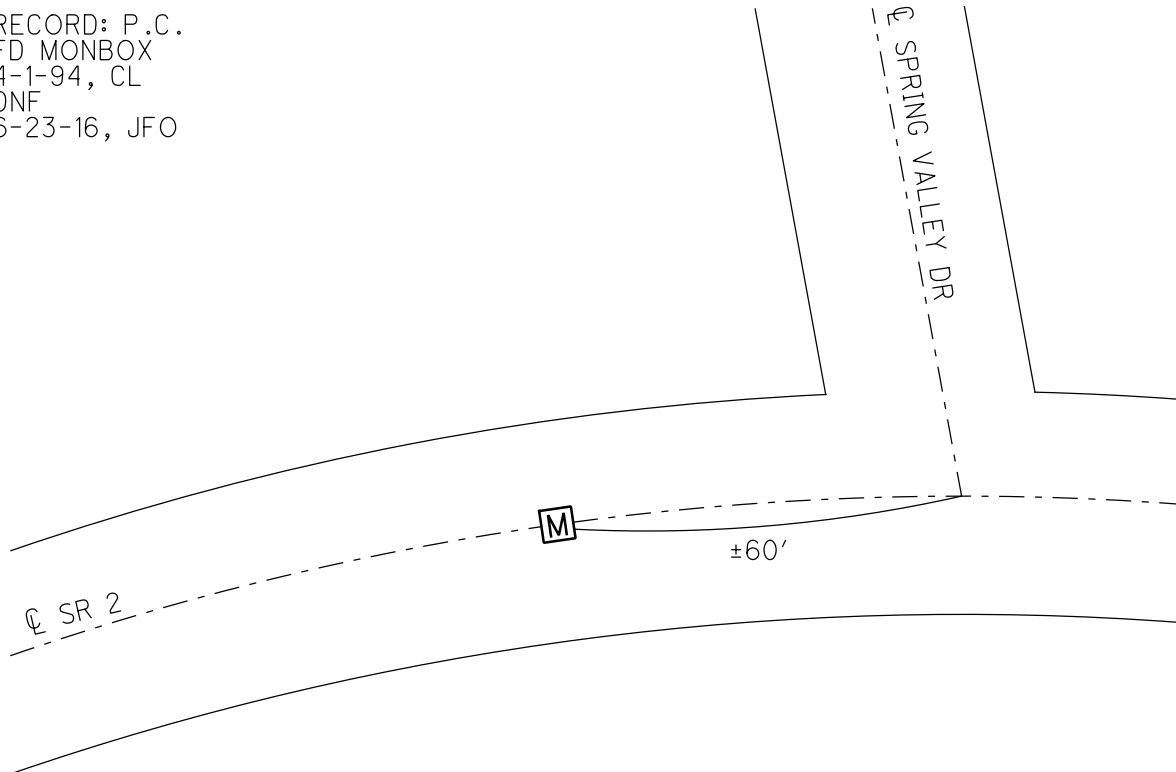

O.D.O.T. DISTRICT 2 SURVEY OFFICE (USE ONLY)

PERSONNEL

REFERENCE NO. 18 C

SHEET 7 OF 18

NOTES LOEHRKE

DATE 4-1-94

ROUTE SR 2

H.C. CANTERBURY

WEATHER NICE

COUNTY LUCAS

R.C. VOGEL

TEMP. 48°

TOWNSHIP SPRINGFIELD

DWG BY JAMES PID 95717

SECTION 16

T 8 N R 10 E

TYPE MONUMENT MONBOX

ON SURFACE - ~~BELOW~~ ON

OFFSET CL PAVEMENT 15.7' LT : ~~RT~~

12.6' TO LT EDGE PAVEMENT


STATION: 506+12

HORIZ.DATUM: NAD83 2011


GEOID: NAVD88 2012A

GRID: NORTHING: 710939.982

EASTING: 1638968.286

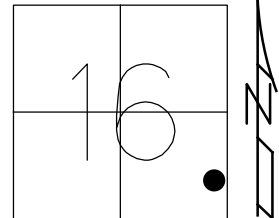

RECORD: P.I.
FD MONBOX
4-1-94, CL
FD MONBOX
W/ 1" IPIN
REFC18
6-23-16, JFO

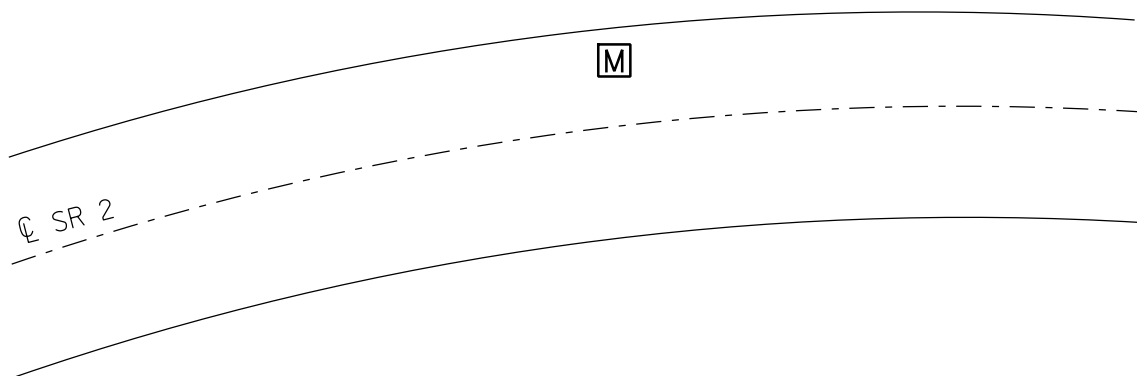

O.D.O.T. DISTRICT 2 SURVEY OFFICE (USE ONLY)

PERSONNEL

REFERENCE NO. 19

SHEET 8 OF 18

NOTES LOEHRKE

DATE 3-30-94

ROUTE SR 2

H.C. CANTERBURY

WEATHER NICE

COUNTY LUCAS

R.C. VOGEL

TEMP. 44°

TOWNSHIP SPRINGFIELD

DWG BY JAMES PID 95717

SECTION 16

T 8 N R 10 E

TYPE MONUMENT MONBOX

ON SURFACE - ~~BELOW~~ ON

OFFSET Q PAVEMENT ON LT : RT

- TO - EDGE PAVEMENT


STATION: 510+29.83

HORIZ.DATUM: NAD83 2011


GEOID: NAVD88 2012A

GRID: NORTHING: 710990.324

EASTING: 1639423.400

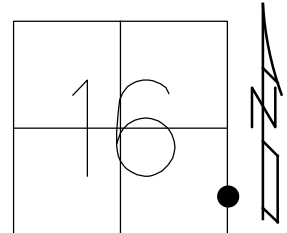

RECORD:
STA. 510+66
FD MONBOX
3/30/94, CL
FD MONBOX
CNPT1
4/18/16, DCH
REF19
6-23-16, JFO

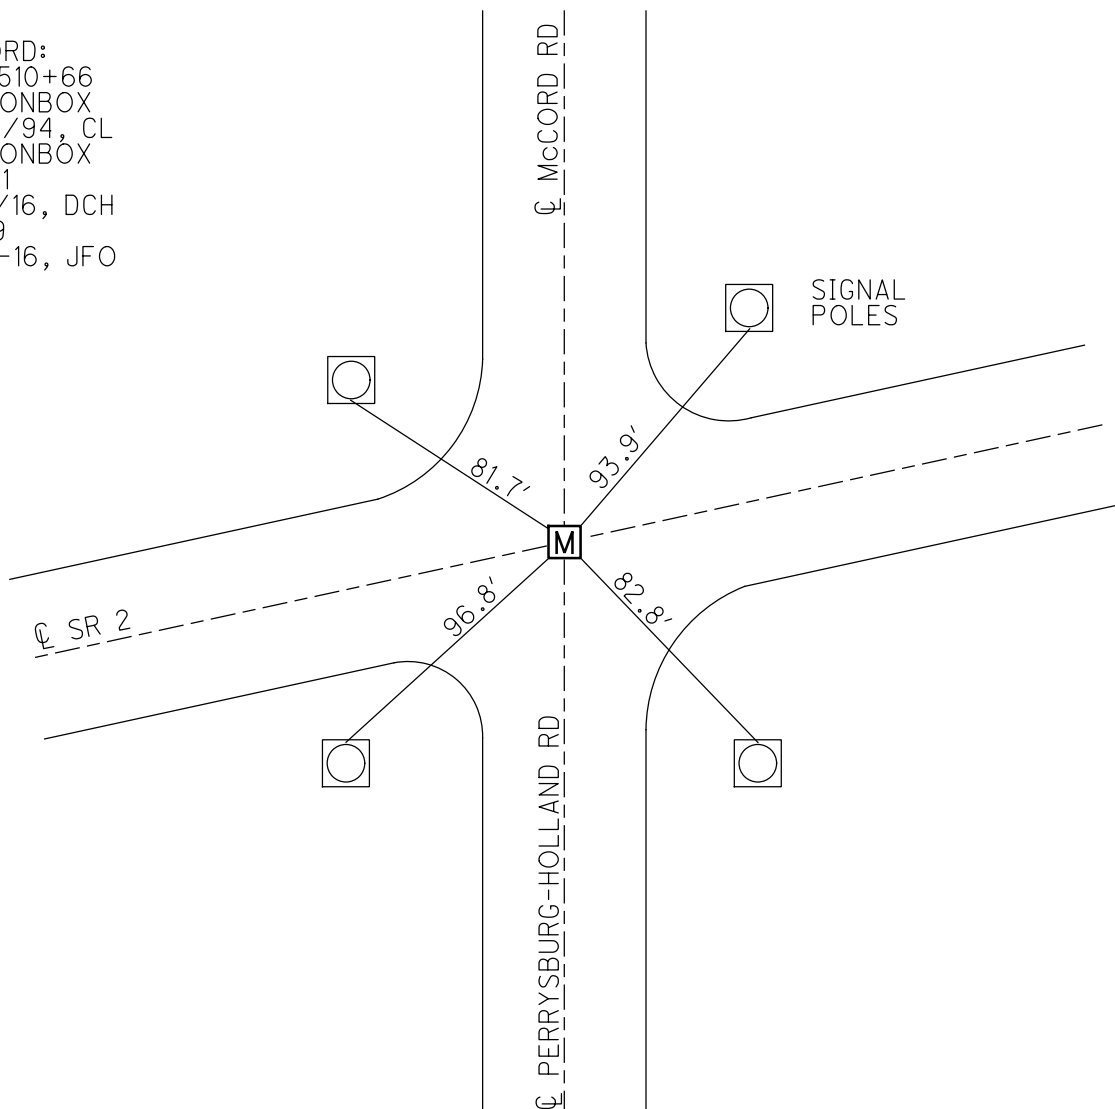

O.D.O.T. DISTRICT 2 SURVEY OFFICE (USE ONLY)

PERSONNEL

REFERENCE NO. 19 AA

SHEET 9 OF 18

NOTES LOEHRKE

DATE 4/1/94

ROUTE SR 2

H.C. CANTERBURY

WEATHER NICE

COUNTY LUCAS

R.C. VOGEL

TEMP. 48°

TOWNSHIP SPRINGFIELD

SECTION 15

DWG BY RHOADES PID -

T 2 USR

TYPE MONUMENT P.K.NAIL

ON SURFACE - ~~BELOW~~ ON

OFFSET CL PAVEMENT ON LT : RT

26.9' TO RT EDGE PAVEMENT


STATION: 520+87

HORIZ.DATUM: _____


GEOID: _____

GRID: NORTHING: _____

EASTING: _____

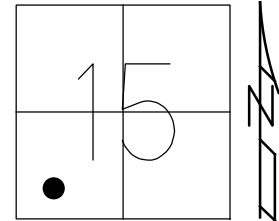

RECORD:
STA. 519+71.2
FD P.K.NAIL
4/1/94, CL
SET P.K./WASHER
5/9/94, CL

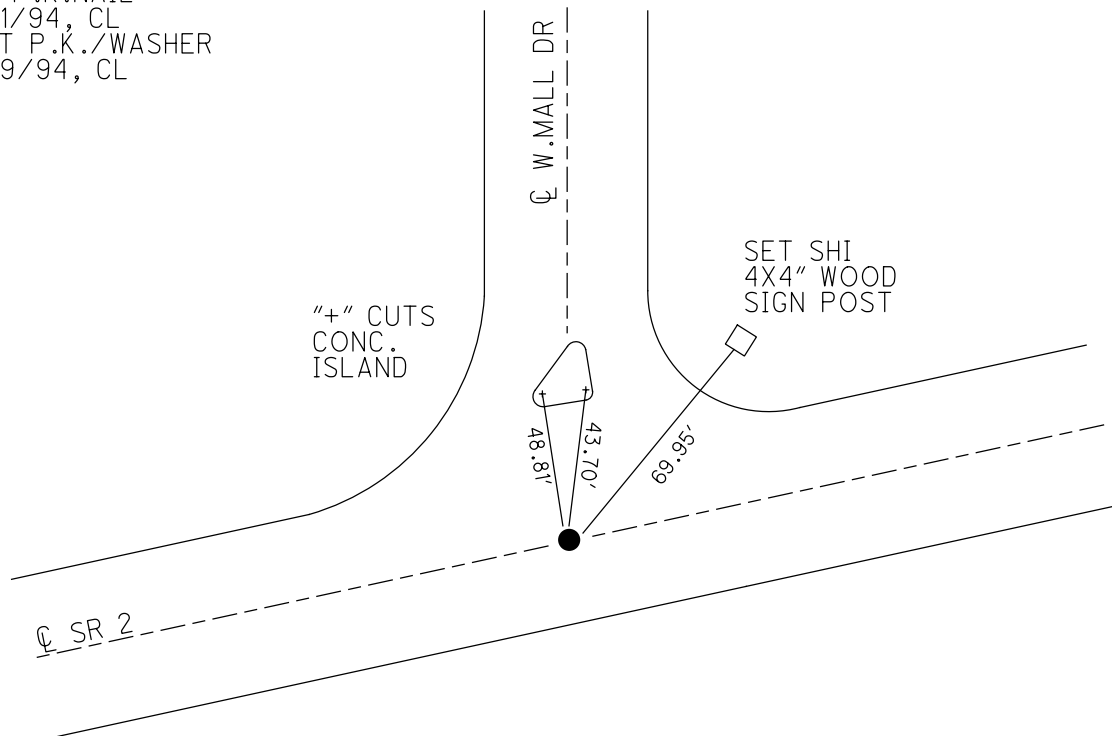

O.D.O.T. DISTRICT 2 SURVEY OFFICE (USE ONLY)

PERSONNEL

REFERENCE NO. 19 AB

SHEET 10 OF 18

NOTES LOEHRKE

DATE 4/1/94

ROUTE SR 2

H.C. CANTERBURY

WEATHER NICR

COUNTY LUCAS

R.C. VOGEL

TEMP. 48°

TOWNSHIP SPRINGFIELD

SECTION 15

DWG BY RHOADES

PID -

T 2 USR

TYPE MONUMENT P.K.NAIL

ON SURFACE - ~~BELOW~~ ON

OFFSET CL PAVEMENT ON LT : RT

27' TO RT EDGE PAVEMENT


STATION: 527+76

HORZ.DATUM: _____


GEOID: _____

GRID: NORTHING: _____

EASTING: _____

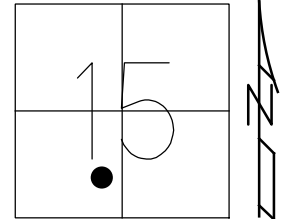

RECORD:
STA. 526+60
FD P.K.NAIL
4/1/94, CL
SET P.K./WASHER
5/9/94, CL

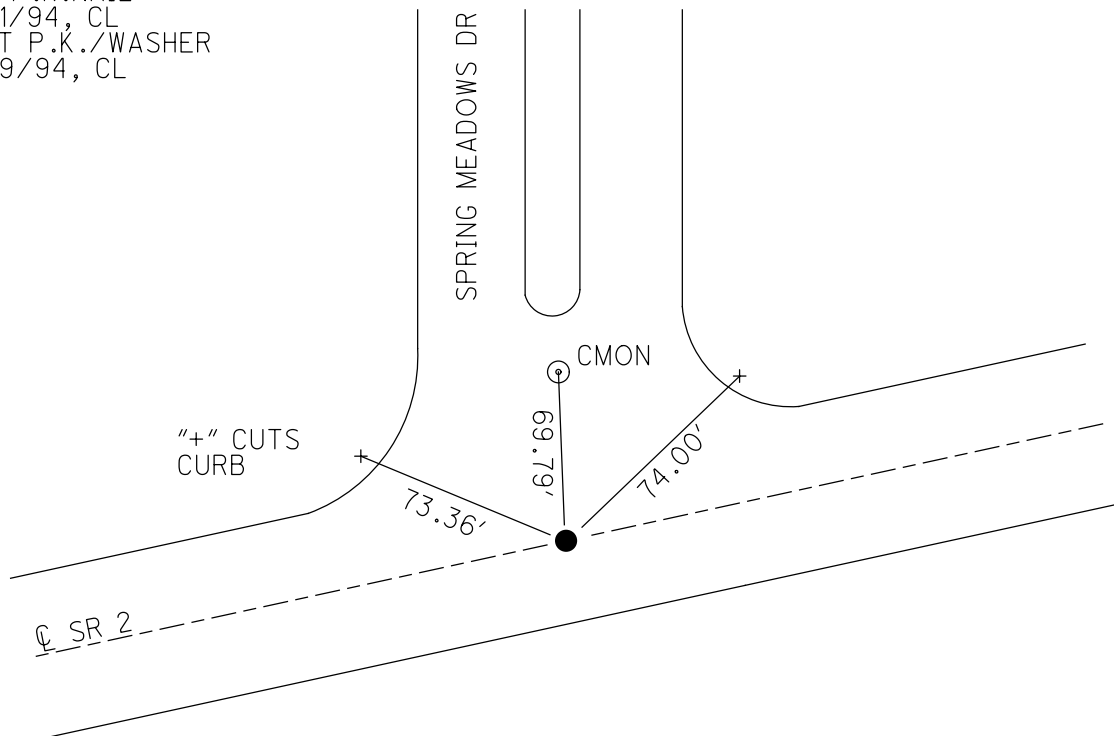

O.D.O.T. DISTRICT 2 SURVEY OFFICE (USE ONLY)

PERSONNEL

REFERENCE NO. 19 A

SHEET 11 OF 18

NOTES HOMAN
H.C. ROUSOS
R.C. HOUDSHELL
VIETH

DATE 8-8-07
WEATHER SUNNY
TEMP. 85°

ROUTE SR 2
COUNTY LUCAS
TOWNSHIP SPRINGFIELD
SECTION 15

DWG BY JAMES PID 95717

T 8 N R 10 E

TYPE MONUMENT P.K. SHANK

ON SURFACE - ~~BELOW~~ ON

OFFSET Q PAVEMENT ON LT : RT

- TO - EDGE PAVEMENT


STATION: 563+36±

HORZ.DATUM: NAD83 2011


GEOID: NAVD88 2012A

GRID: NORTHING: 711569.827

EASTING: 1644698.442

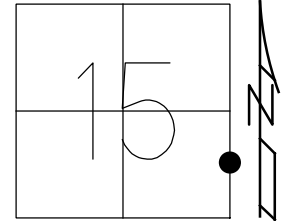

RECORD:
FD CMON
3/30/94
SET P.K./WASHER
5/9/94, CL
FD P.K.SHANK
8/8/07
SET MAG/WASHER
11/13/07, SAH
FD MAG/WASHER
REFA19
6-23-16, JFO
SET DRILL "+"
W/ COORDS.
1-2-19, JFO

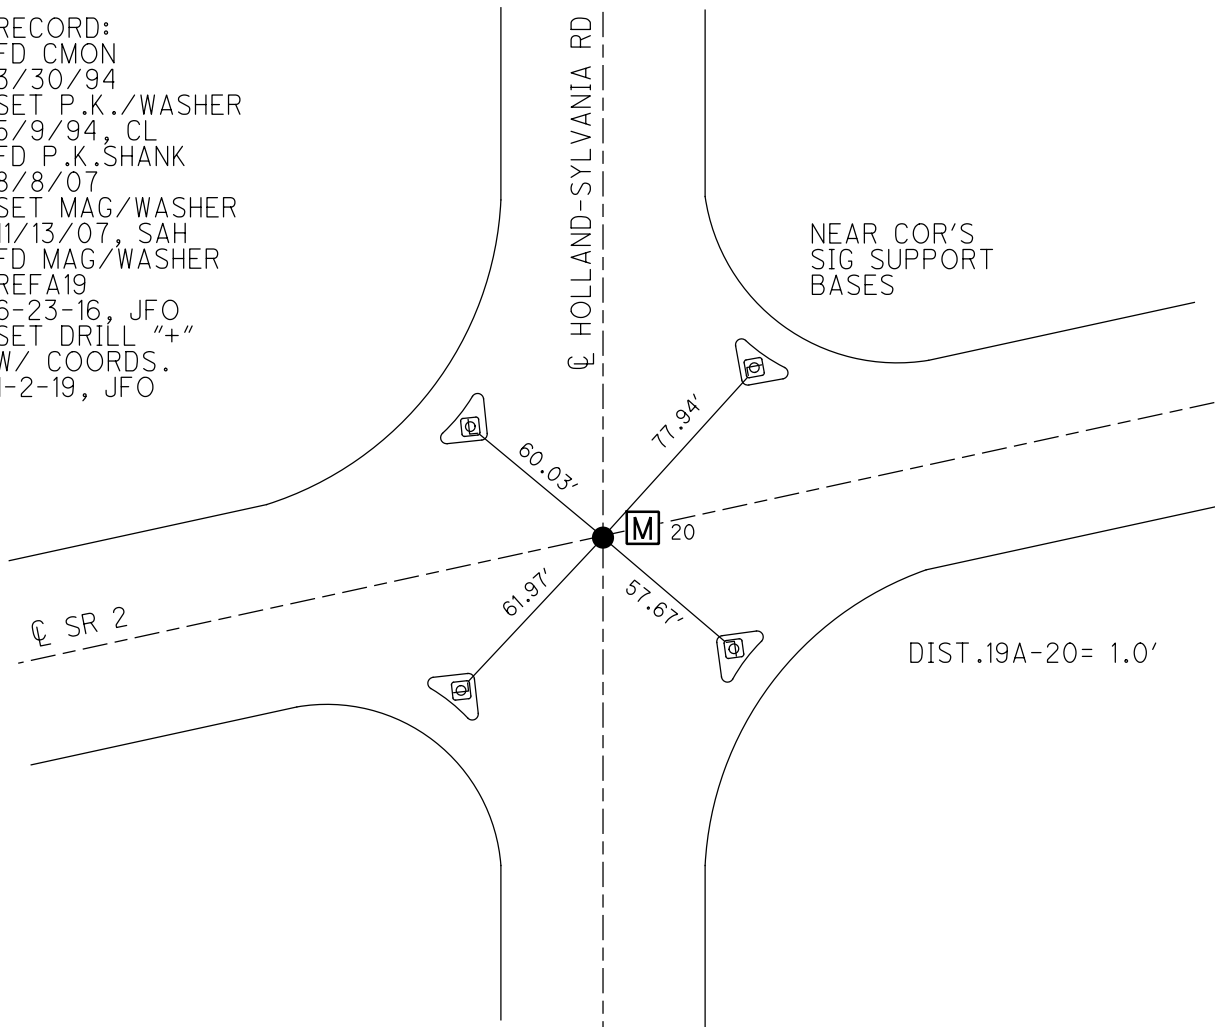

O.D.O.T. DISTRICT 2 SURVEY OFFICE (USE ONLY)

PERSONNEL

REFERENCE NO. 20

SHEET 12 OF 18

NOTES HOMAN

DATE 8-8-07

ROUTE SR 2

H.C. ROUSOS

WEATHER SUNNY

COUNTY LUCAS

R.C. HOUDSHELL

TEMP. 85°

TOWNSHIP SPRINGFIELD

VIETH

SECTION 15

DWG BY JAMES

PID 95717

T 8 N R 10 E

TYPE MONUMENT MONBOX W/ 1" IPIN

ON SURFACE - ~~BELOW~~ ON

OFFSET CL PAVEMENT ON LT : RT

- TO - EDGE PAVEMENT


STATION: 563+37.60

HORIZ.DATUM: NAD83 2011


GEOID: NAVD88 2012A

GRID: NORTHING: 711570.001

EASTING: 1644699.422

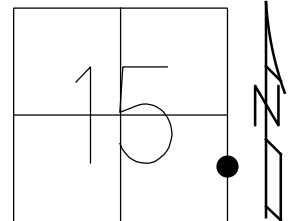

RECORD:
STA.563+43
FD MONBOX
3-30-94, CL
SV9
8-8-07, DCH
FD MONBOX
CNPT2
4-18-16, DCH
FD MONBOX
W/ 1" IPIN
REF20
6-23-16, JFO

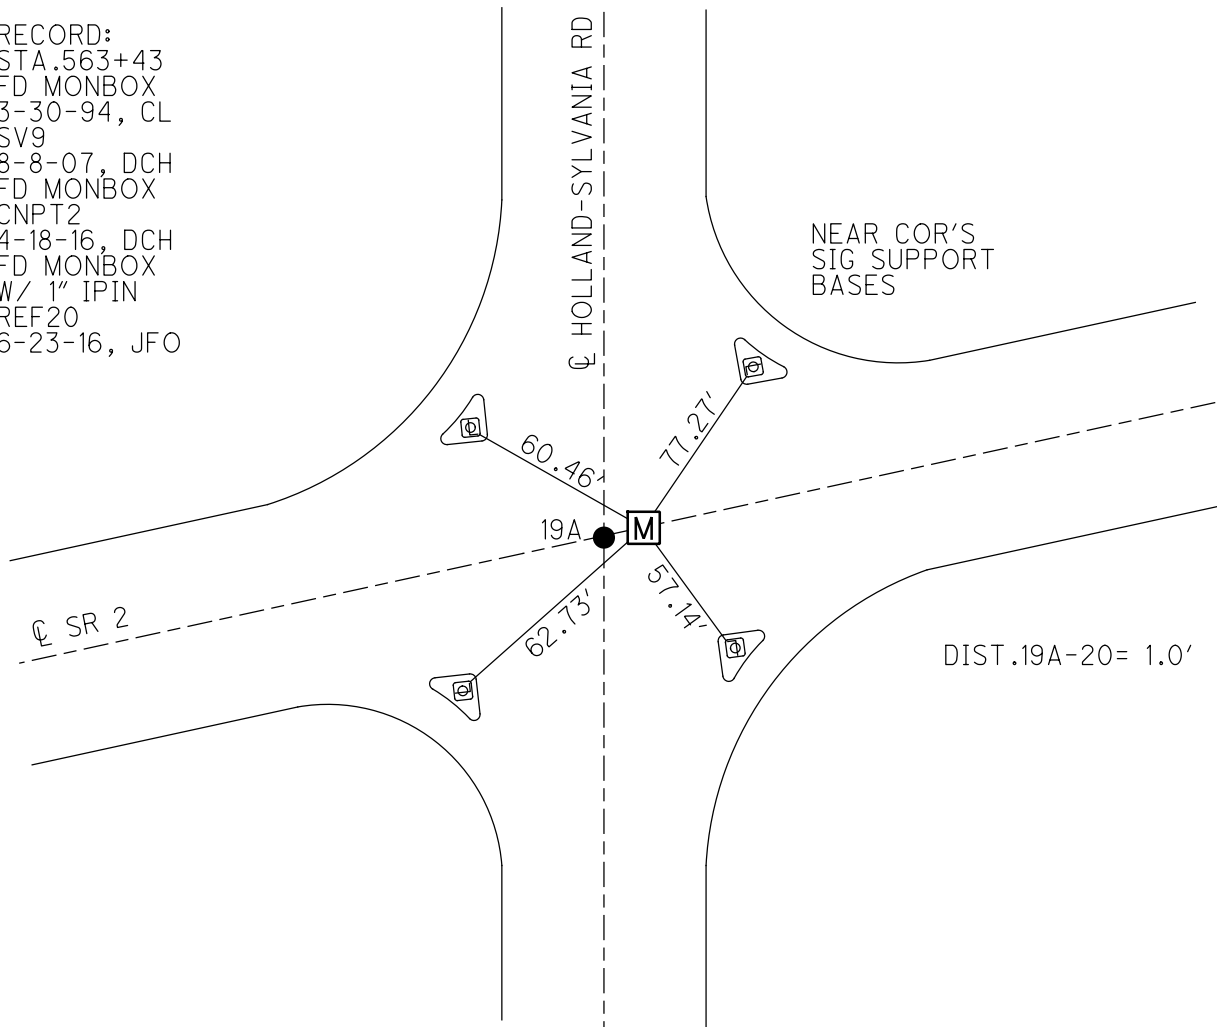

O.D.O.T. DISTRICT 2 SURVEY OFFICE (USE ONLY)

PERSONNEL

REFERENCE NO. 20 A

SHEET 13 OF 18

NOTES HOMAN DATE 8/8/07
H.C. ROUSOS WEATHER SUNNY
R.C. HOUDESHELL TEMP. 85°

ROUTE SR 2
COUNTY LUCAS
TOWNSHIP _____
SECTION 14
T 2 USR

DWG BY RHOADES PID 94724

TYPE MONUMENT MONBOX W/IPIN

ON SURFACE - ~~BELOW~~ ON

OFFSET Q PAVEMENT - LT : RT
- TO - EDGE PAVEMENT


STATION: 578+89.25

HORZ.DATUM: NAD83 2011


GEOID: NAVD88 2012A

GRID: NORTHING: 711906.284

EASTING: 1646057.682

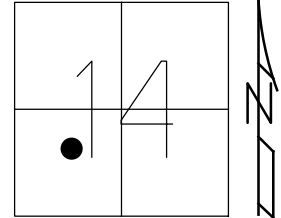

RECORD: P.I.
STA. 578+89.9
FD MONBOX
W/IPIN
6/15/71, I.S.
SV8
8/8/07, DCH
FD MONBOX
W/IPIN
CNPT3
4/18/16, DCH

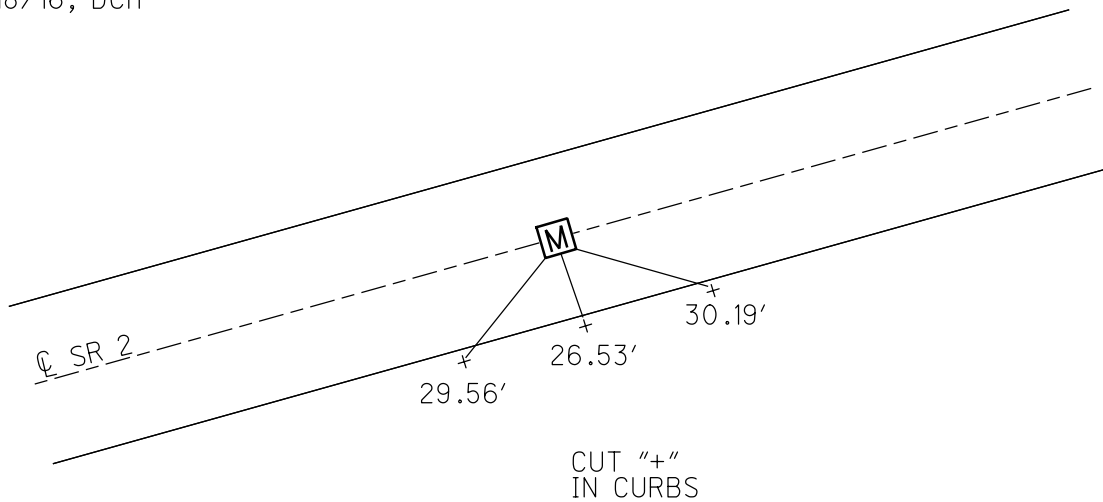

O.D.O.T. DISTRICT 2 SURVEY OFFICE (USE ONLY)

PERSONNEL

REFERENCE NO. 20 B

SHEET 14 OF 18

NOTES HOMAN

DATE 8/8/07

ROUTE SR 2

H.C. ROUSOS

WEATHER SUNNY

COUNTY LUCAS

R.C. HOUDESHELL

TEMP. 85°

TOWNSHIP

VIETH

SECTION 14

DWG BY RHOADES

PID -

T 2 USR

TYPE MONUMENT MONBOX W/IPIN

ON SURFACE - ~~BELOW~~ ON

OFFSET Q PAVEMENT ON LT : RT

- TO - EDGE PAVEMENT


STATION: 598+91

HORZ.DATUM: -


GEOID: -

GRID: NORTHING: 712438.783

EASTING: 1647987.308

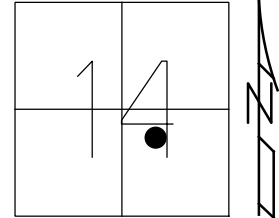

RECORD: T.S.
STA. 598+91.69
FD MONBOX
W/IPIN
6/15/71, I.S.
SV849
8/8/07, DCH

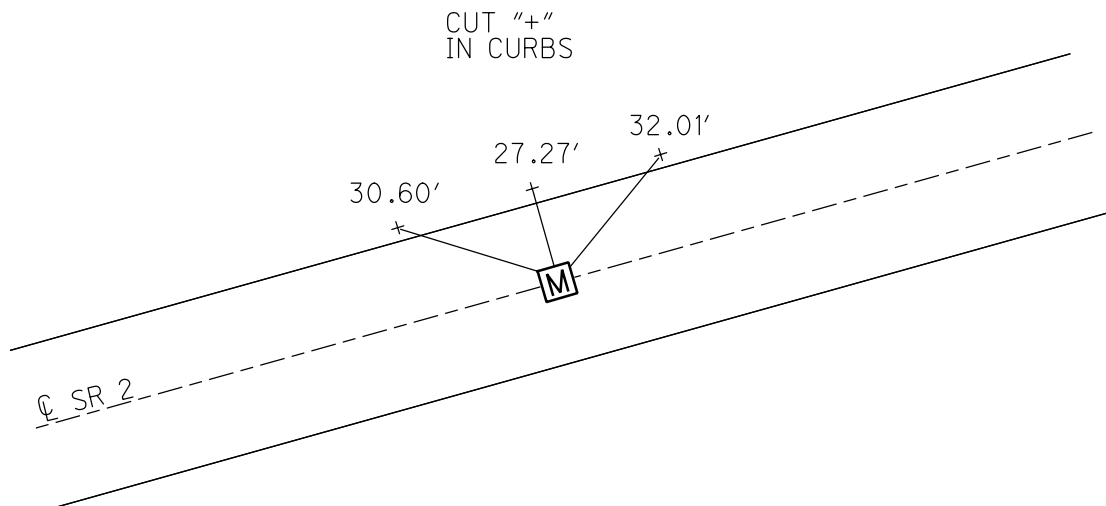

O.D.O.T. DISTRICT 2 SURVEY OFFICE (USE ONLY)

PERSONNEL

REFERENCE NO. 20 C

SHEET 15 OF 18

NOTES HOMAN

DATE 8/8/07

ROUTE SR 2

H.C. ROUSOS

WEATHER SUNNY

COUNTY LUCAS

R.C. HOUDSHELL

TEMP. 85°

TOWNSHIP

VIETH

SECTION 14

DWG BY RHOADES

PID 94724

T 2 USR

TYPE MONUMENT MONBOX W/IPIN

ON SURFACE - ~~BELOW~~ ON

OFFSET Q PAVEMENT - LT : RT

5.5' TO LT EDGE PAVEMENT


STATION: 603+23

HORZ.DATUM: -

GEOID: -


GRID: NORTHING: 712553.518

EASTING: 1648402.876

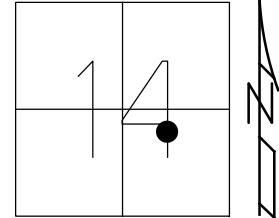

RECORD: P.I.
STA.603+22.94
FD MONBOX
W/IPIN
6/15/71, I.S.
SV848
8/8/07, DCH

CUT "+"
IN CURBS

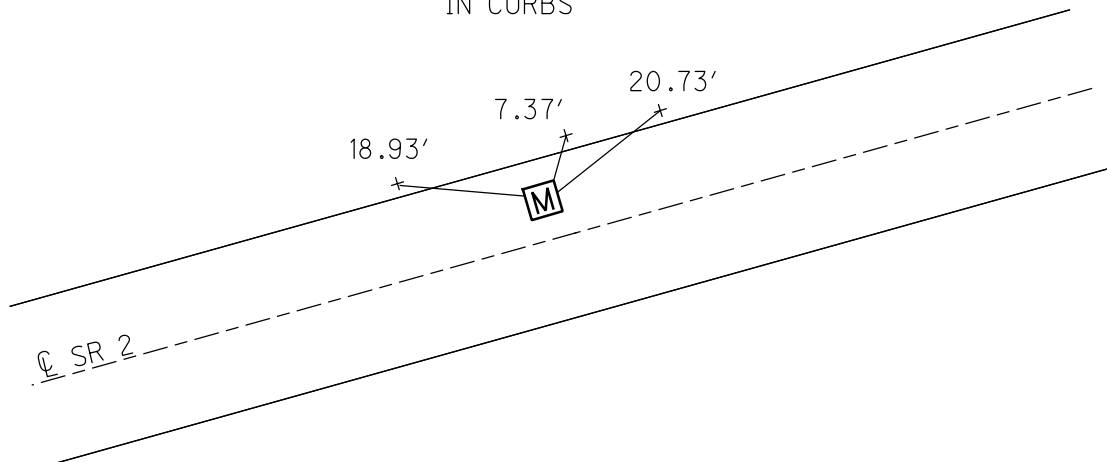

O.D.O.T. DISTRICT 2 SURVEY OFFICE (USE ONLY)

PERSONNEL

REFERENCE NO. 20 D

SHEET 16 OF 18

NOTES HOMAN

DATE 8/8/07

ROUTE SR 2

H.C. ROUSOS

WEATHER SUNNY

COUNTY LUCAS

R.C. HOUDESHELL

TEMP. 85°

TOWNSHIP

VIETH

SECTION 14

DWG BY RHOADES

PID 94724

T 2 USR

TYPE MONUMENT MONBOX W/IPIN

ON SURFACE - ~~BELOW~~ ON

OFFSET Q PAVEMENT ON LT : RT

- TO - EDGE PAVEMENT


STATION: 607+49.79

HORZ.DATUM: NAD83 2011

GEOID: NAVD88 2012A


GRID: NORTHING: 712554.668

EASTING: 1648834.111

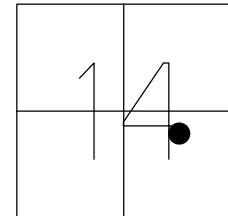

RECORD: S.T.
STA.607+50.56
FD MONBOX
W/IPIN
6/15/71, I.S.
SV847
8/8/07, DCH
FD MONBOX
W/IPIN
CNPT1
4/18/16, DCH

CUT "+"
IN CURBS

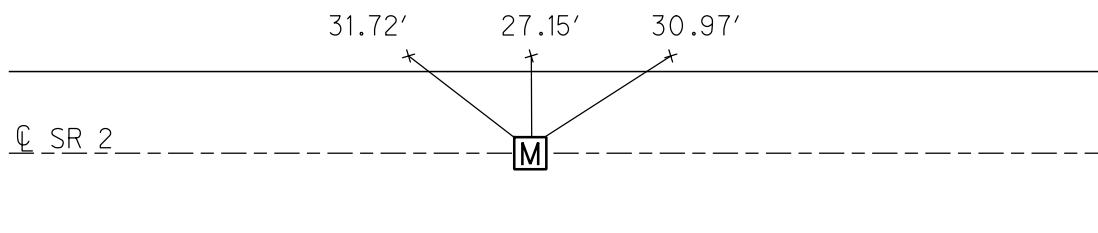

O.D.O.T. DISTRICT 2 SURVEY OFFICE (USE ONLY)

PERSONNEL

REFERENCE NO. 21

SHEET 17 OF 18

NOTES CURTIS

DATE 8/12/71

ROUTE SR 2

H.C. STEVENS

WEATHER SUNNY

COUNTY LUCAS

R.C. BRANNAN

TEMP. 75°

TOWNSHIP

SECTION 14

DWG BY RHOADES PID 94724

T 2 USR

TYPE MONUMENT BRASS MOBORA

ON SURFACE - ~~BELOW~~ ON

OFFSET Q PAVEMENT ON LT : RT

- TO - EDGE PAVEMENT


STATION: 619+88.74

HORIZ.DATUM: NAD83 2011

GEOID: NAVD88 2012A


GRID: NORTHING: 712557.708

EASTING: 1650070.901

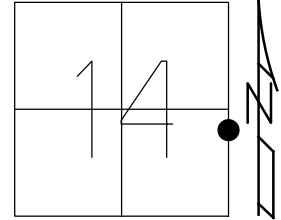

RECORD: P.I.
FD BRASS MOBORA
8/12/71, CURTIS
 $\Delta = 0^\circ 00' 28''$ RT
FD MONBOX
W/IPIN
CNPT2
4/18/16, DCH

NOTE: US 20 REF 75

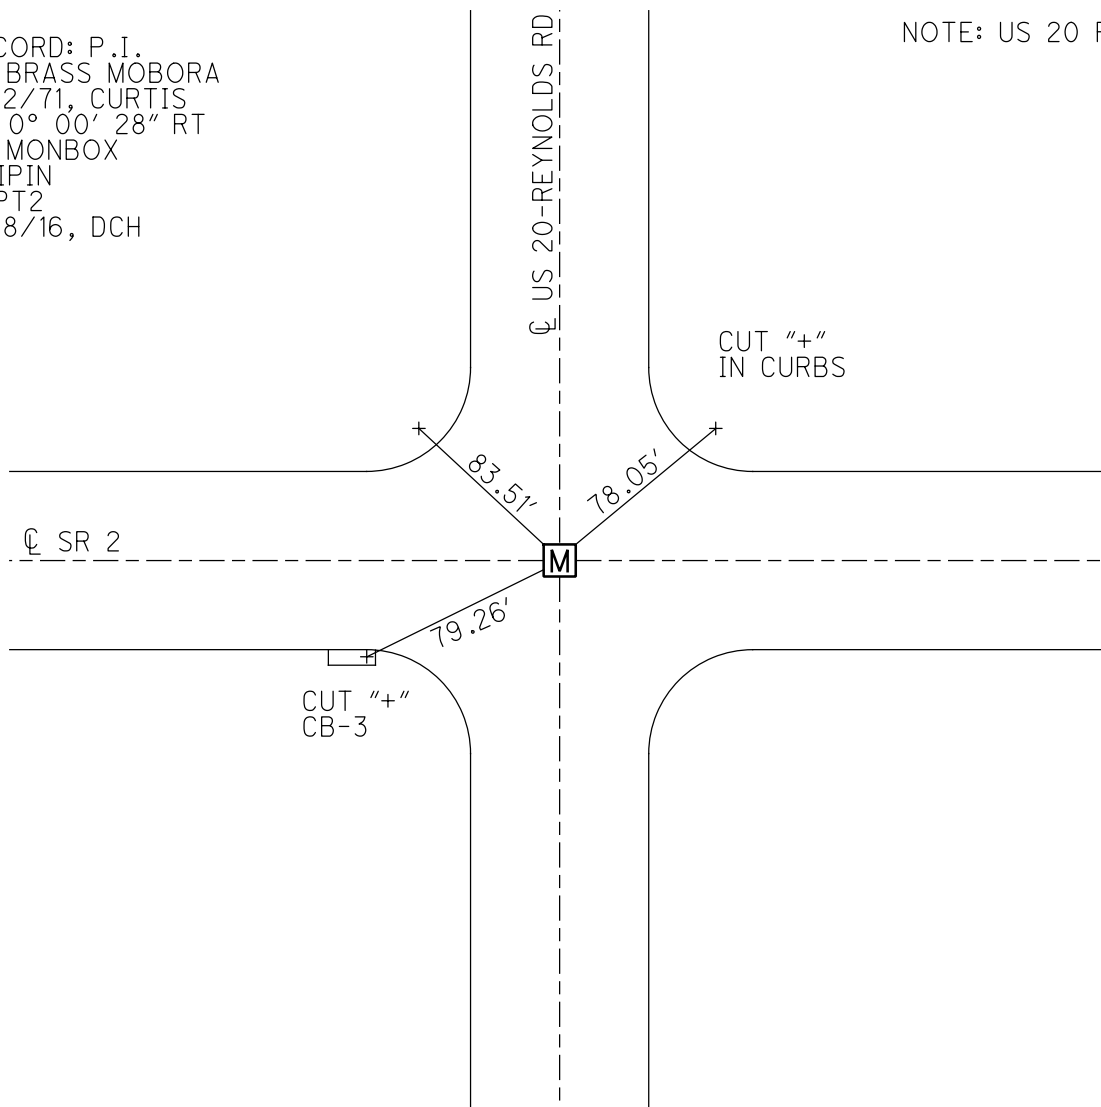

O.D.O.T. DISTRICT 2 SURVEY OFFICE (USE ONLY)

PERSONNEL

REFERENCE NO. 22

SHEET 18 OF 18

NOTES MIKLOVIC

DATE 5/9/06

ROUTE SR 2

H.C. HANKE

WEATHER SUNNY

COUNTY LUCAS

R.C. HUSS

TEMP. 70°

TOWNSHIP

HOUDSHELL, NUHFER

SECTION 13

DWG BY RHOADES

PID 94724

T 2 USR

TYPE MONUMENT P.K./WASHER

ON SURFACE - BELOW ON

OFFSET Q PAVEMENT ON LT : RT

- TO - EDGE PAVEMENT


STATION: 627+96.22

HORZ.DATUM: NAD83 2011


GEOID: NAVD88 2012A


GRID: NORTHING: 712559.578

EASTING: 1650878.339

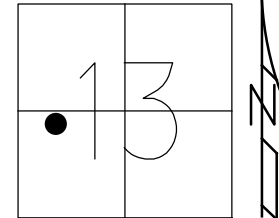

RECORD: P.O.T.
STA.626+41
FD P.K.NAIL
7/24/93, BC
SET P.K./WASHER
8/11/93, BC
FD P.K./WASHER
6/14/02
5/9/06, SAH
FD MONBOX
W/IPIN
CNPT3
4/18/16, DCH

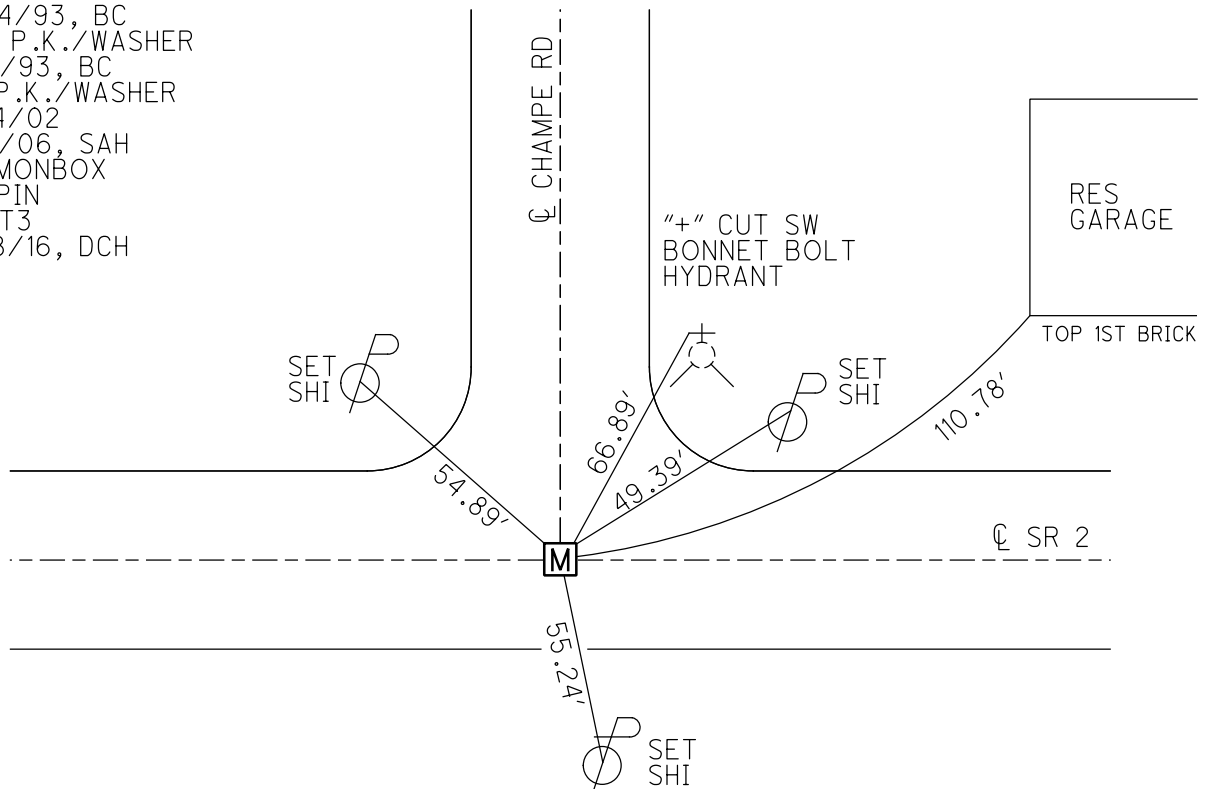

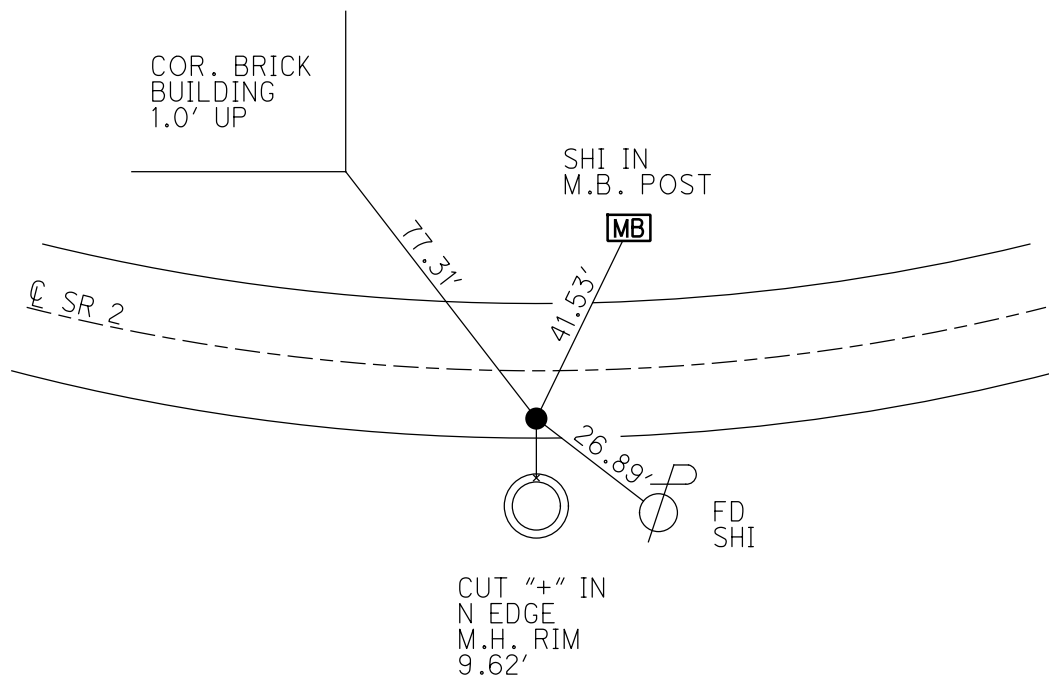

O.D.O.T. DISTRICT 2 SURVEY OFFICE (USE ONLY)

PERSONNEL

REFERENCE NO. 24

SHEET 2 OF 13

NOTES CORDES

DATE 4/24/93

ROUTE SR 2

H.C. KUSZ

WEATHER NICE

COUNTY LUCAS

R.C. OTTO

TEMP. 80°

TOWNSHIP ADAMS

BARNHISEL

SECTION 13

DWG BY NIESE PID _____

T 2 US R E

TYPE MONUMENT MONBOX

ON SURFACE - ~~BELOW~~ ON


OFFSET Q PAVEMENT ON LT : RT

- TO - EDGE PAVEMENT


STATION: 636+33

HORIZ.DATUM: _____ GEOID: _____

GRID: NORTHING: _____ EASTING: _____

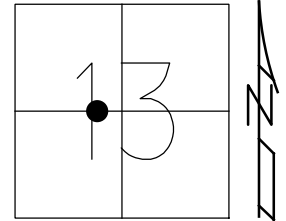

RECORD:
FD MONBOX
4/24/93, MB

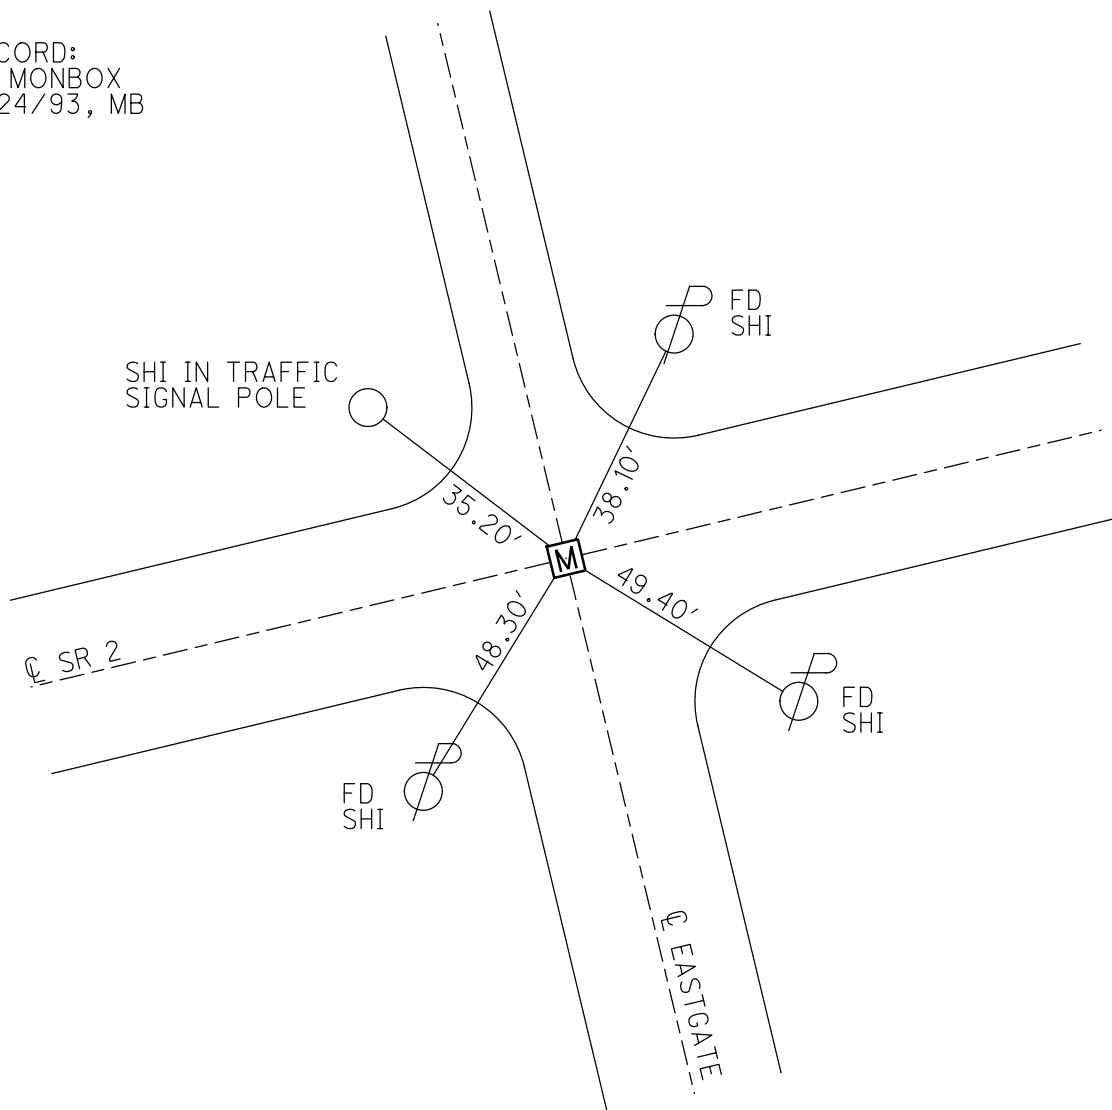

O.D.O.T. DISTRICT 2 SURVEY OFFICE (USE ONLY)

PERSONNEL

REFERENCE NO. 25

SHEET 3 OF 13

NOTES _____

DATE 4/24/93

ROUTE _____ SR 2

H.C. KUSZ

WEATHER NICE

COUNTY LUCAS

R.C. OTTC

TEMP. 80°

TOWNSHIP ADAMS

BARNHISEL

DWG BY NIESE

PID _____

T_2US R__E

TYPE MONUMENT P.K. NAIL

ON SURFACE - ~~BELOW~~ _____ ON

OFFSET @ PAVEMENT _____ ON _____ LT : RT

15.2' TO RT EDGE PAVEMENT

STATION: 640+53


HORZ.DATUM: _____

GEOID: _____

GRID: NORTHING: _____

EASTING: _____

RECORD:
FD P.K. NAIL
4/24/93, MRC
SET P.K./WASHER
8/11/93, MB

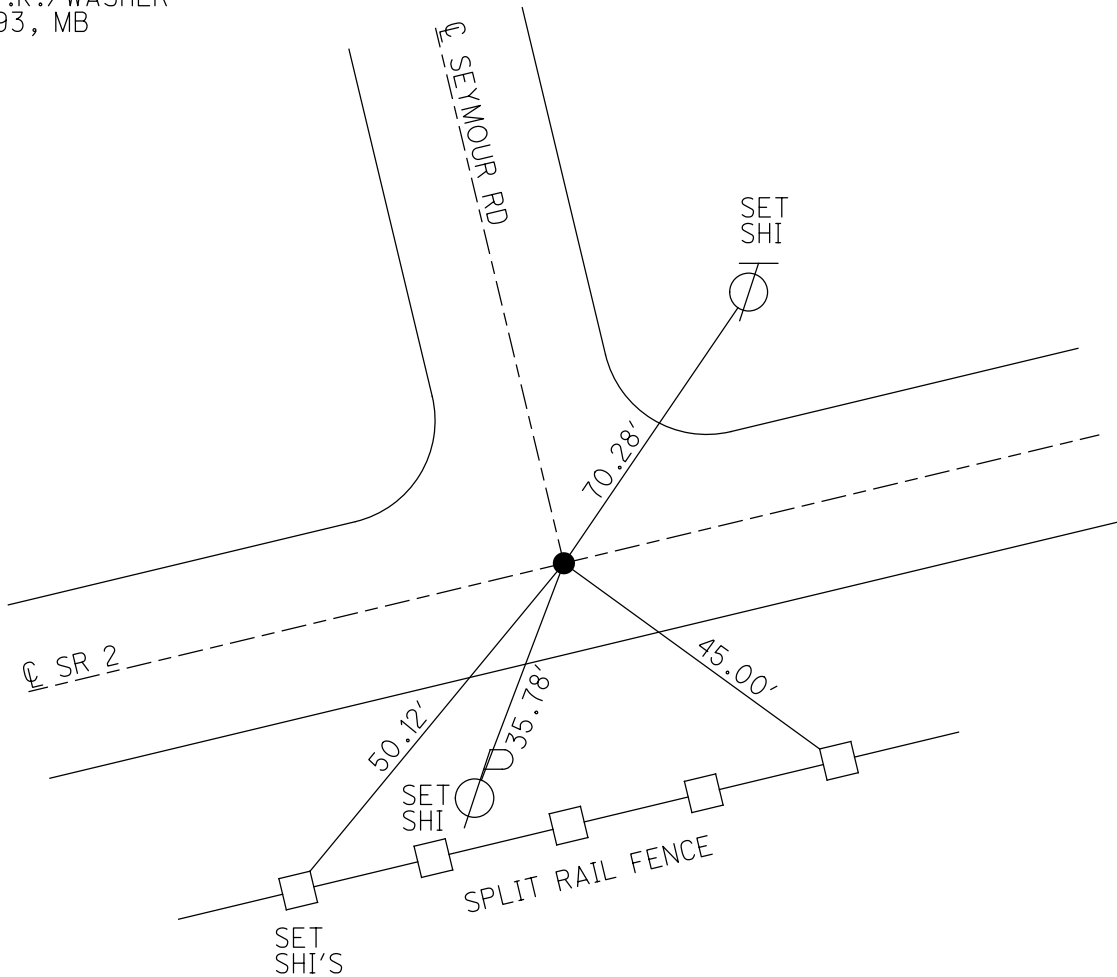

O.D.O.T. DISTRICT 2 SURVEY OFFICE (USE ONLY)

PERSONNEL

REFERENCE NO. 26

SHEET 4 OF 13

NOTES CORDES

DATE 4/24/93

ROUTE SR 2

H.C. KUSZ

WEATHER PARTLY CLOUDY

COUNTY LUCAS

R.C. OTTO

TEMP. 75°

TOWNSHIP ADAMS

BARNHISEL

SECTION 13

DWG BY NIESE PID

T 2 US R E

TYPE MONUMENT P.K./WASHER

ON SURFACE - ~~BELOW~~ ON


OFFSET CL PAVEMENT ON LT : RT

15.2' TO RT EDGE PAVEMENT


STATION: 655+72

HORIZ.DATUM: GEOID:

GRID: NORTHING: EASTING:

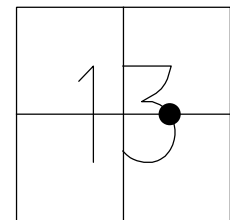

RECORD:
FD P.K./WASHER
4/24/93, MRC
SET P.K./WASHER
8/11/93, MB

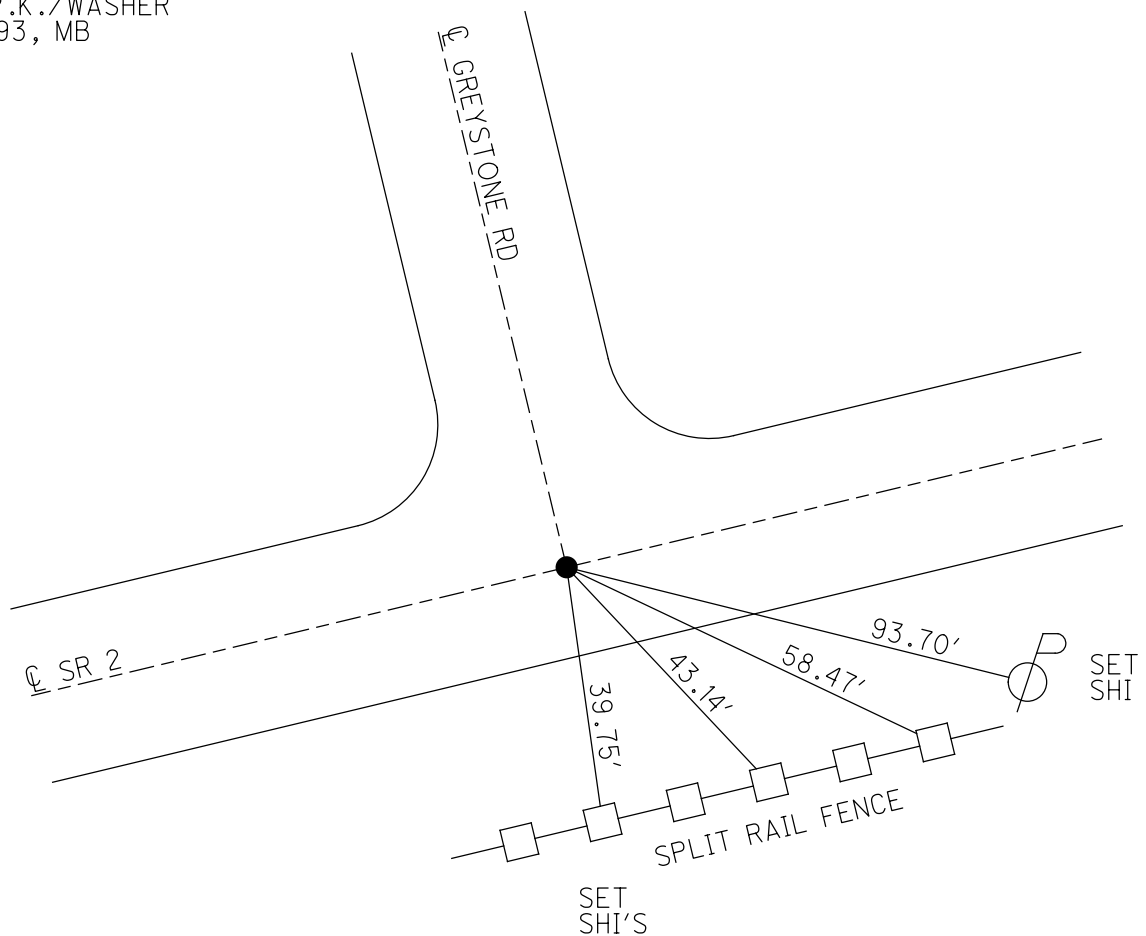

O.D.O.T. DISTRICT 2 SURVEY OFFICE (USE ONLY)

PERSONNEL

REFERENCE NO. 27

SHEET 5 OF 13

NOTES CORDES

DATE 7/16/93

ROUTE SR 2

H.C. KUSZ

WEATHER PARTLY CLOUDY

COUNTY LUCAS

R.C. OTTO

TEMP. 78°

TOWNSHIP ADAMS

BARNHISEL

SECTION 13

DWG BY NIESE PID

T 2 US R E

TYPE MONUMENT P.K./WASHER

ON SURFACE - ~~BELOW~~ ON


OFFSET Q PAVEMENT ON LT : RT

14.8' TO RT EDGE PAVEMENT


STATION: 677+18


HORZ.DATUM: GEOID:

GRID: NORTHING: EASTING:

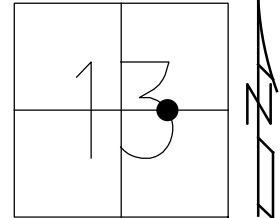

RECORD:
FD P.K./WASHER
7/16/93, MRC
SET P.K./WASHER
8/11/93, MB

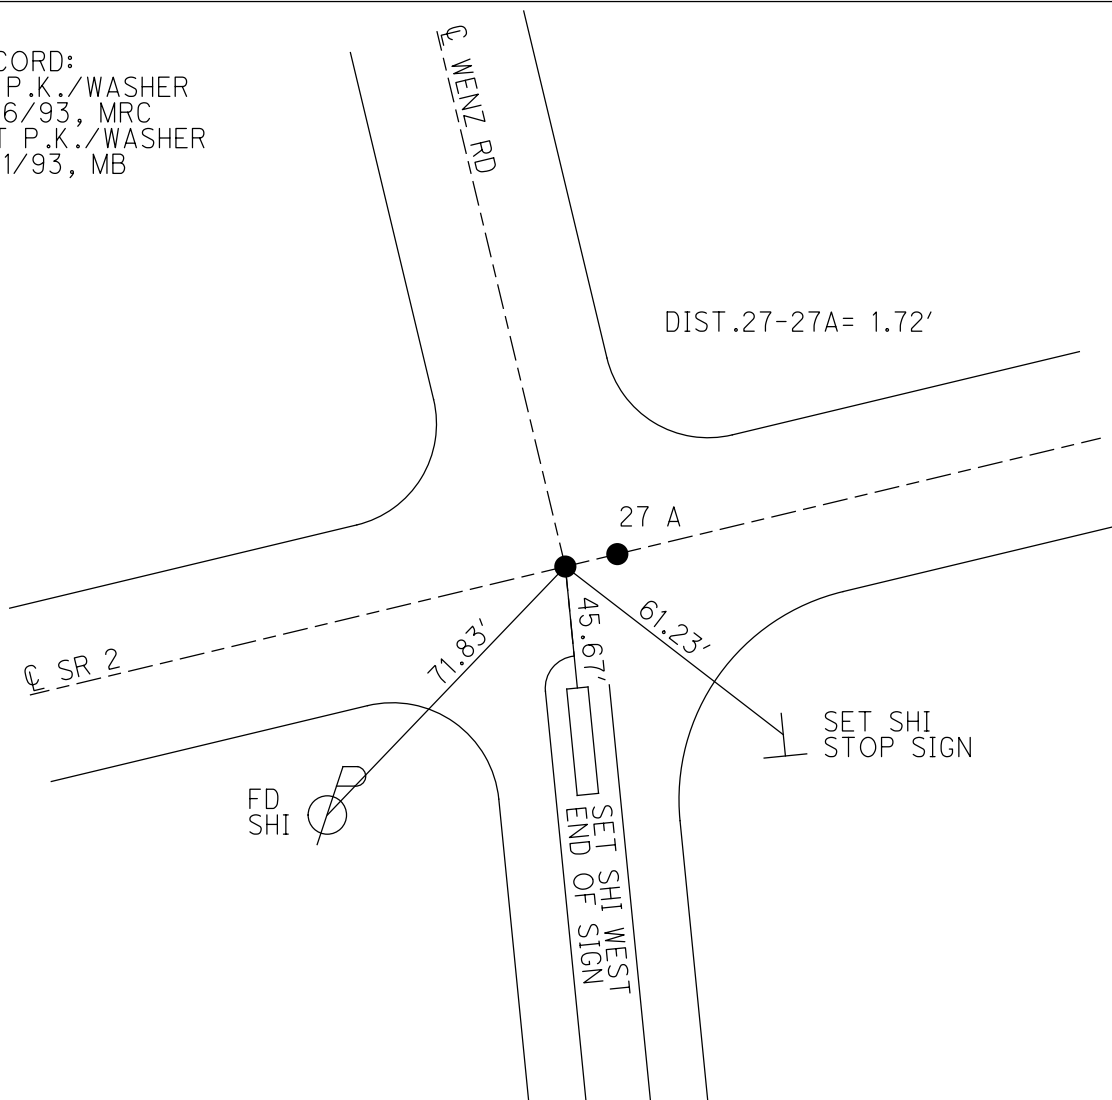

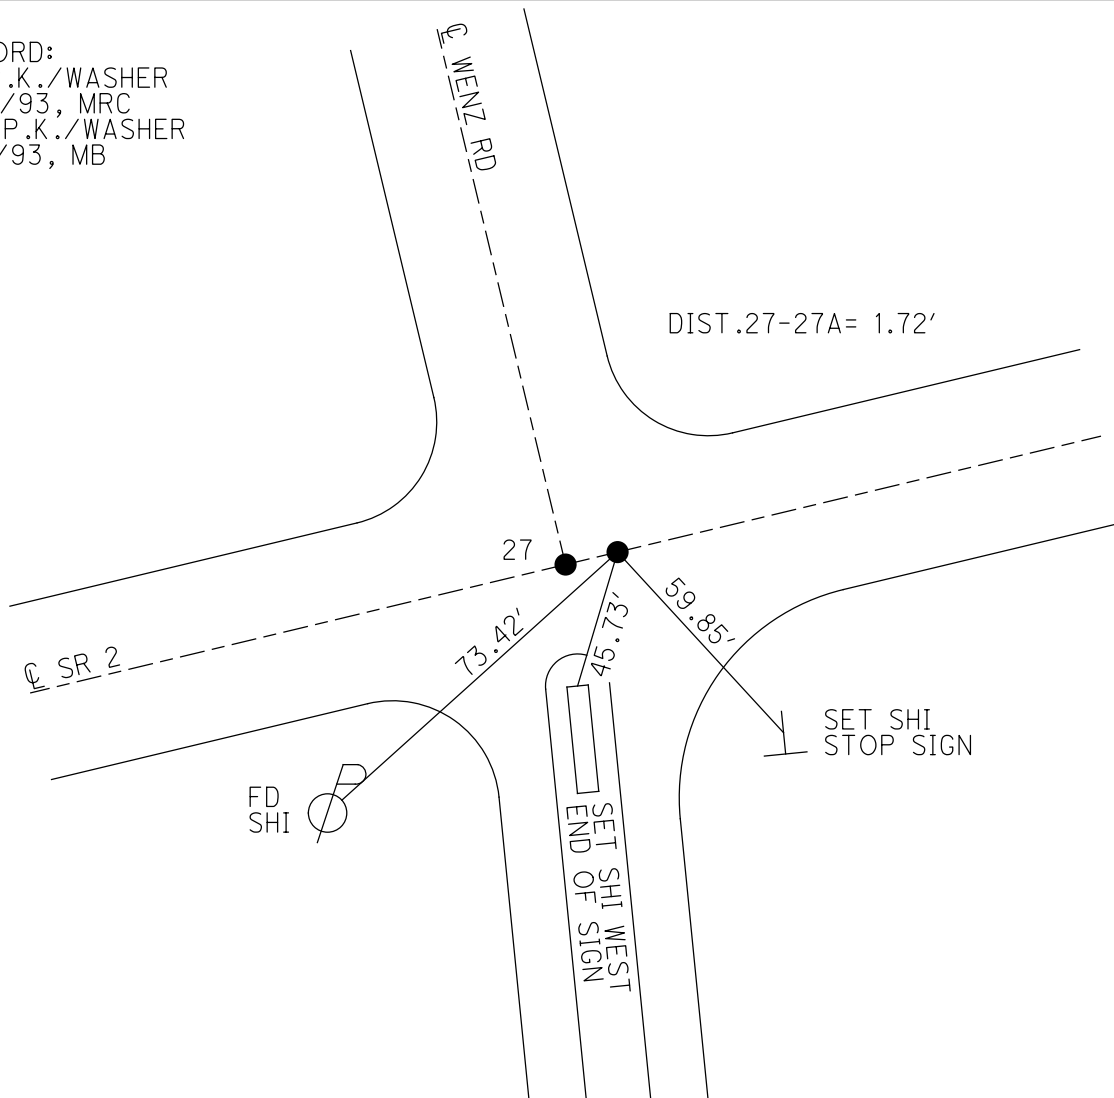

O.D.O.T. DISTRICT 2 SURVEY OFFICE (USE ONLY)

PERSONNEL

REFERENCE NO. 27B

SHEET 7 OF 13

NOTES NIESE

DATE 2/24/23

ROUTE SR 2

H.C. NIESE

WEATHER SUNNY

COUNTY LUCAS

R.C. AUBLE

TEMP. 78°

TOWNSHIP AMBOY

DWG BY BARRIERE

PID 108465

SECTION 11

T 2 N R E

TYPE MONUMENT MONBOX W/ 3/4" IPIN

ON SURFACE - BELOW ON

OFFSET Q PAVEMENT ON LT : RT

TO EDGE PAVEMENT

STATION:

HORIZ.DATUM: NAD83 (2011)


GEOID: NAVD88 2012B

GRID: NORTHING: 713967.349

EASTING: 1656643.870

LDP: NORTHING:

EASTING:

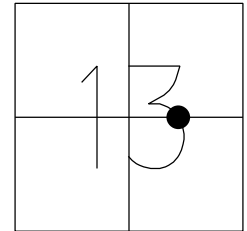

RECORD:
FD P.K./WASHER
7/16/93, MRC
SET P.K./WASHER
8/11/93, MB
FD MONBOX
W/ 3/4" IPIN
REF27B
2/24/23, TDN

CONC
DRIVE

Q SR 2
WB



Q SR 2
EB

SET SHI
STOP SIGN

O.D.O.T. DISTRICT 2 SURVEY OFFICE (USE ONLY)

PERSONNEL

REFERENCE NO. 28

SHEET 7 OF 13

NOTES MILLER

DATE 2/24/23

ROUTE SR 2

H.C. NIESE

WEATHER SUNNY

COUNTY LUCAS

R.C.

TEMP. 78°

TOWNSHIP AMBOY

DWG BY BARRIERE

PID 108465

SECTION 11

T 2 N R E

TYPE MONUMENT P.K./WASHER

ON SURFACE - BELOW ON

OFFSET Q PAVEMENT ON LT : RT

15.2' TO RT EDGE PAVEMENT

STATION:

HORZ.DATUM:


GEOID:

GRID: NORTHING:


EASTING:

LDP: NORTHING:

EASTING:

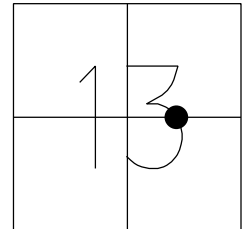

RECORD:
FD P.K./WASHER
7/16/93, MRC
SET P.K./WASHER
8/11/93, MB
DID NOT FIND
2/24/23, TDN

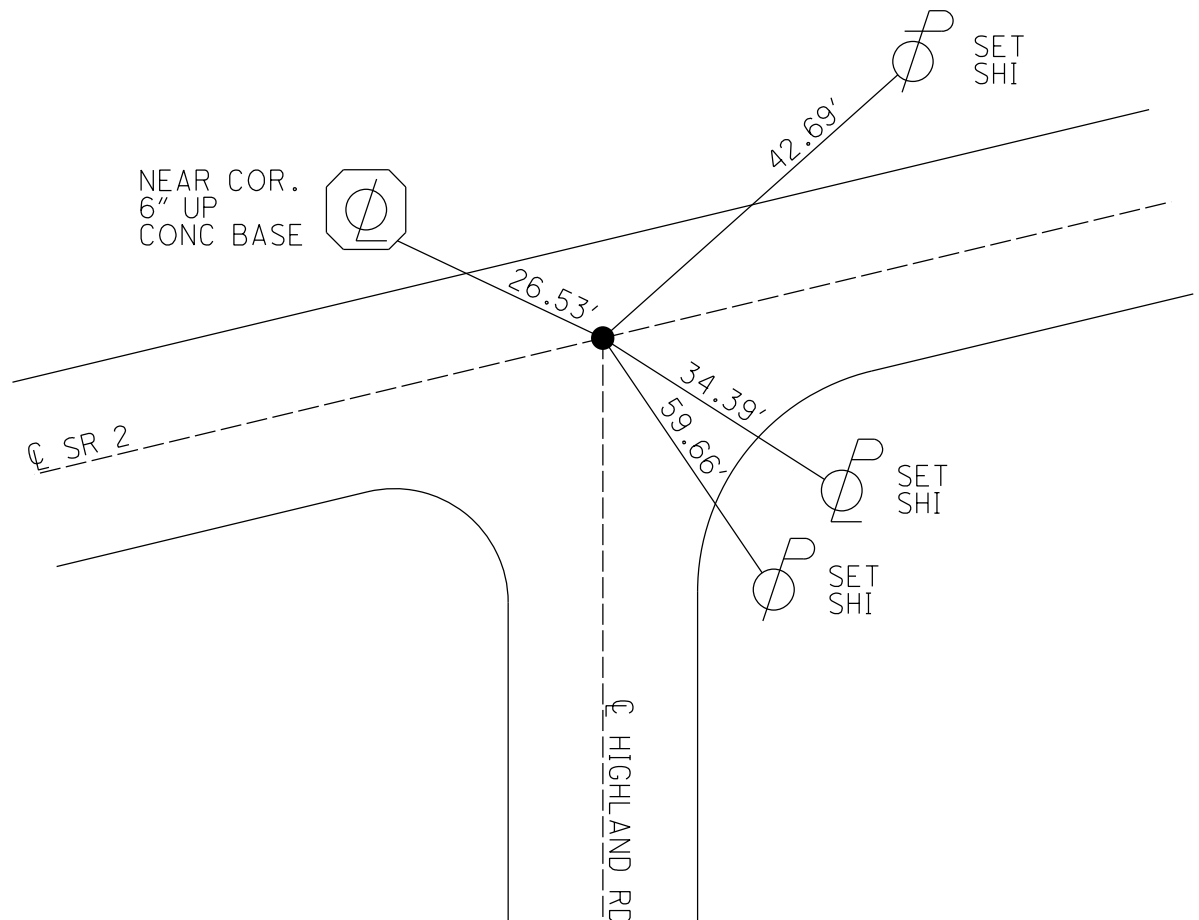

O.D.O.T. DISTRICT 2 SURVEY OFFICE (USE ONLY)

PERSONNEL

REFERENCE NO. 28A

SHEET 7 OF 13

NOTES MILLER

DATE 2/24/23

ROUTE SR 2

H.C. NIESE

WEATHER SUNNY

COUNTY LUCAS

R.C. _____

TEMP. 78°

TOWNSHIP AMBOY

DWG BY BARRIERE

PID 108465

SECTION 11

T 2 N R E

TYPE MONUMENT MONBOX W/ 3/4" IPIN

ON SURFACE - BELOW ON

OFFSET Q PAVEMENT ON LT : RT

_____ TO _____ EDGE PAVEMENT

STATION: 720+54.98

HORZ.DATUM: NAD83 (2011)


GEOID: NAVD88 2012B

GRID: NORTHING: 714931.016


EASTING: 1659814.879

LDP: NORTHING: _____

EASTING: _____

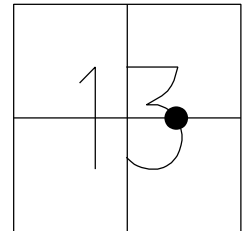

RECORD:
FD BRASS PLATE
9/8/60
FD MONBOX
W/ 3/4" IPIN
REF28A
2/24/23, TDN

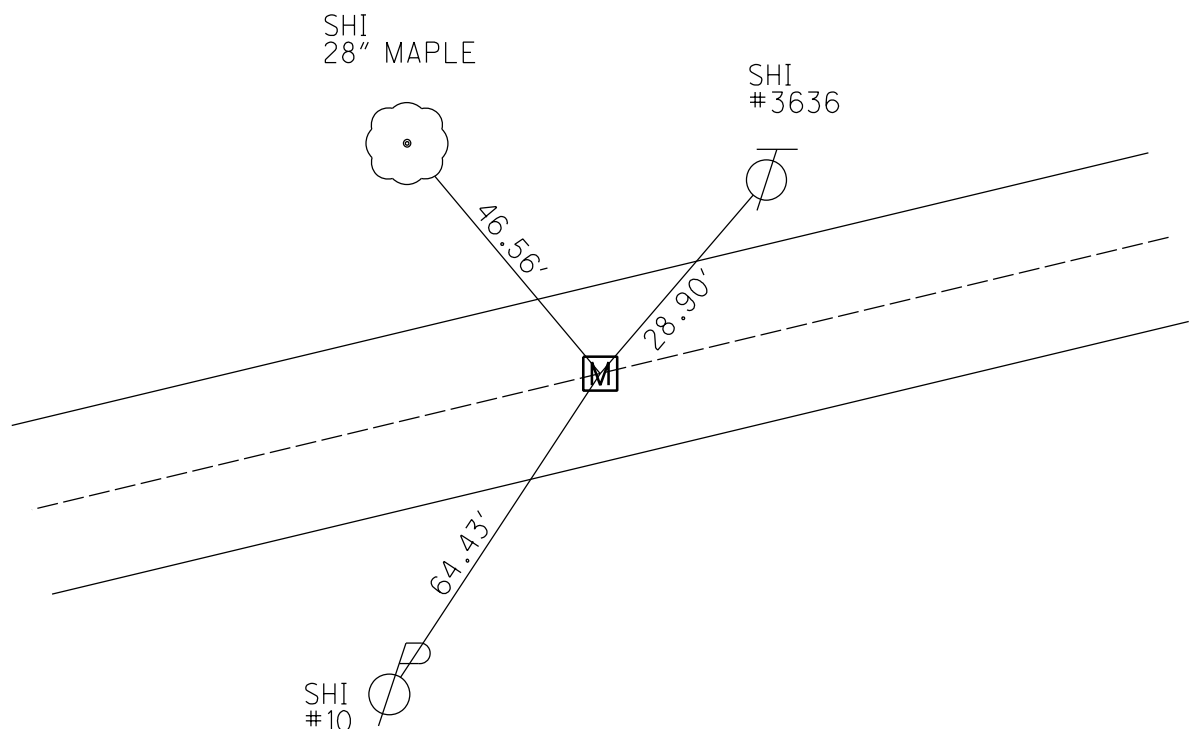

O.D.O.T. DISTRICT 2 SURVEY OFFICE (USE ONLY)

PERSONNEL

REFERENCE NO. 28 B

SHEET 8 OF 13

NOTES MILLER

DATE 2/24/23

ROUTE SR 2

H.C. NIESE

WEATHER SUNNY

COUNTY LUCAS

R.C.

TEMP. 78°

TOWNSHIP AMBOY

SECTION 13

DWG BY BARRIERE

PID 108465

T 2 N R E

TYPE MONUMENT "+" IN BRICK

ON SURFACE - BELOW ON

OFFSET Q PAVEMENT ON LT : RT

TO EDGE PAVEMENT

STATION: 723+98.58

HORZ.DATUM:


GEOID:

GRID: NORTHING:


EASTING:

LDP: NORTHING:

EASTING:

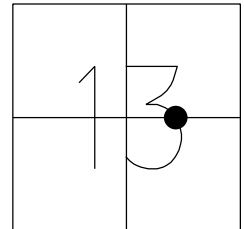

RECORD:
FD "+" IN BRICK
9/8/60
DID NOT FIND
2/23/24, TDN

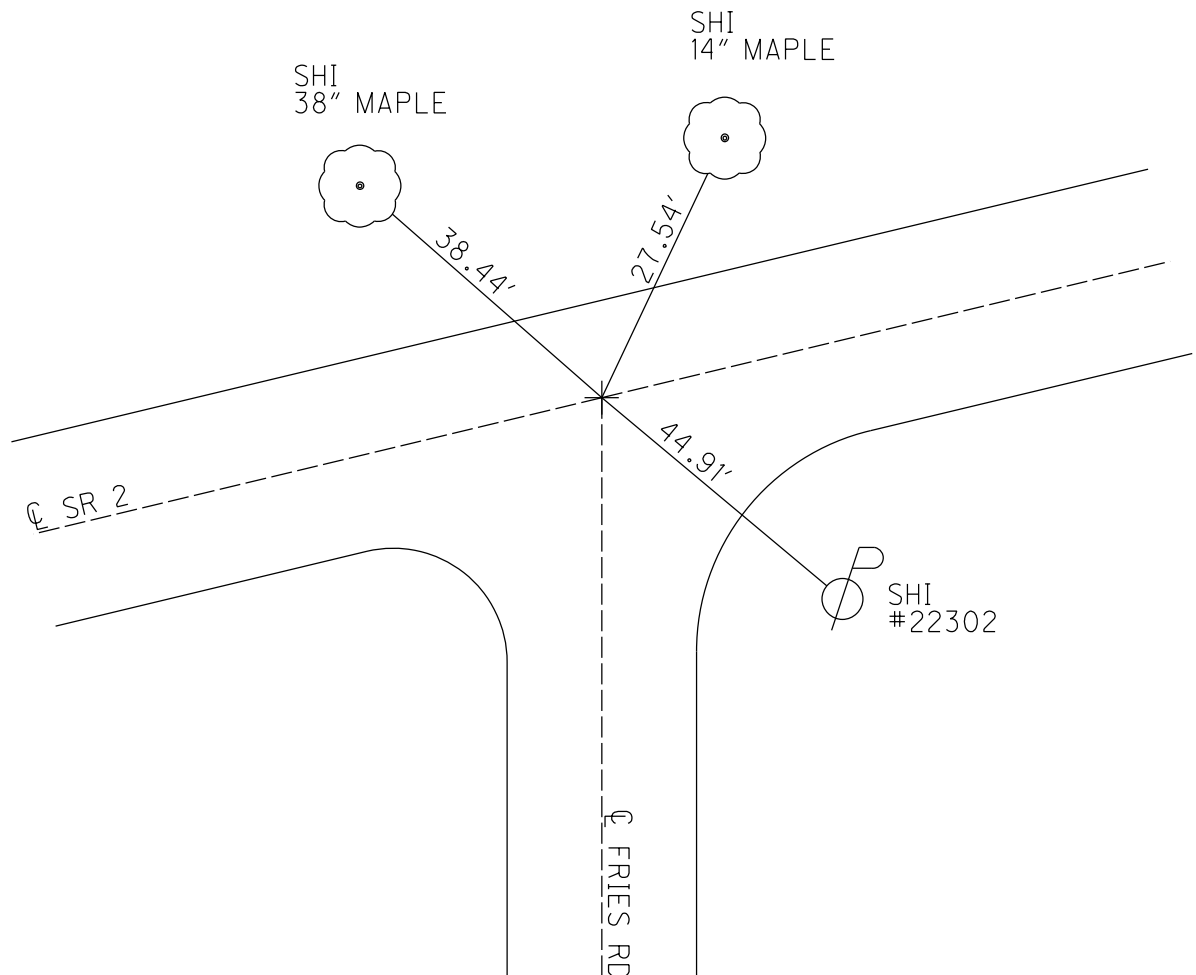

O.D.O.T. DISTRICT 2 SURVEY OFFICE (USE ONLY)

PERSONNEL

REFERENCE NO. 28 C

SHEET 11 OF 15

NOTES MILLER

DATE 2/24/23

ROUTE SR 2

H.C. NIESE

WEATHER SUNNY

COUNTY LUCAS

R.C.

TEMP. 78°

TOWNSHIP AMBOY

DWG BY BARRIERE

PID 108465

SECTION 13

T 2 N R E

TYPE MONUMENT MONBOX W/ 1" IPIN

ON SURFACE - BELOW ON

OFFSET $\varnothing$ PAVEMENT ON LT : RT

TO EDGE PAVEMENT

STATION: 720+54.98

HORIZ.DATUM: NAD83 (2011)


GEOID: NAVD88 2012B

GRID: NORTHING: 715196.705


EASTING: 1660689.873

LDP: NORTHING:

EASTING:

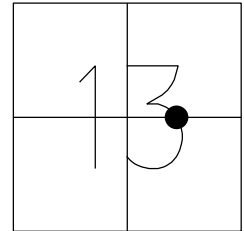

RECORD:
FD BRASS PLATE
9/8/60
FD MONBOX
W/ 1" IPIN
REFC28
2/24/23, TDN

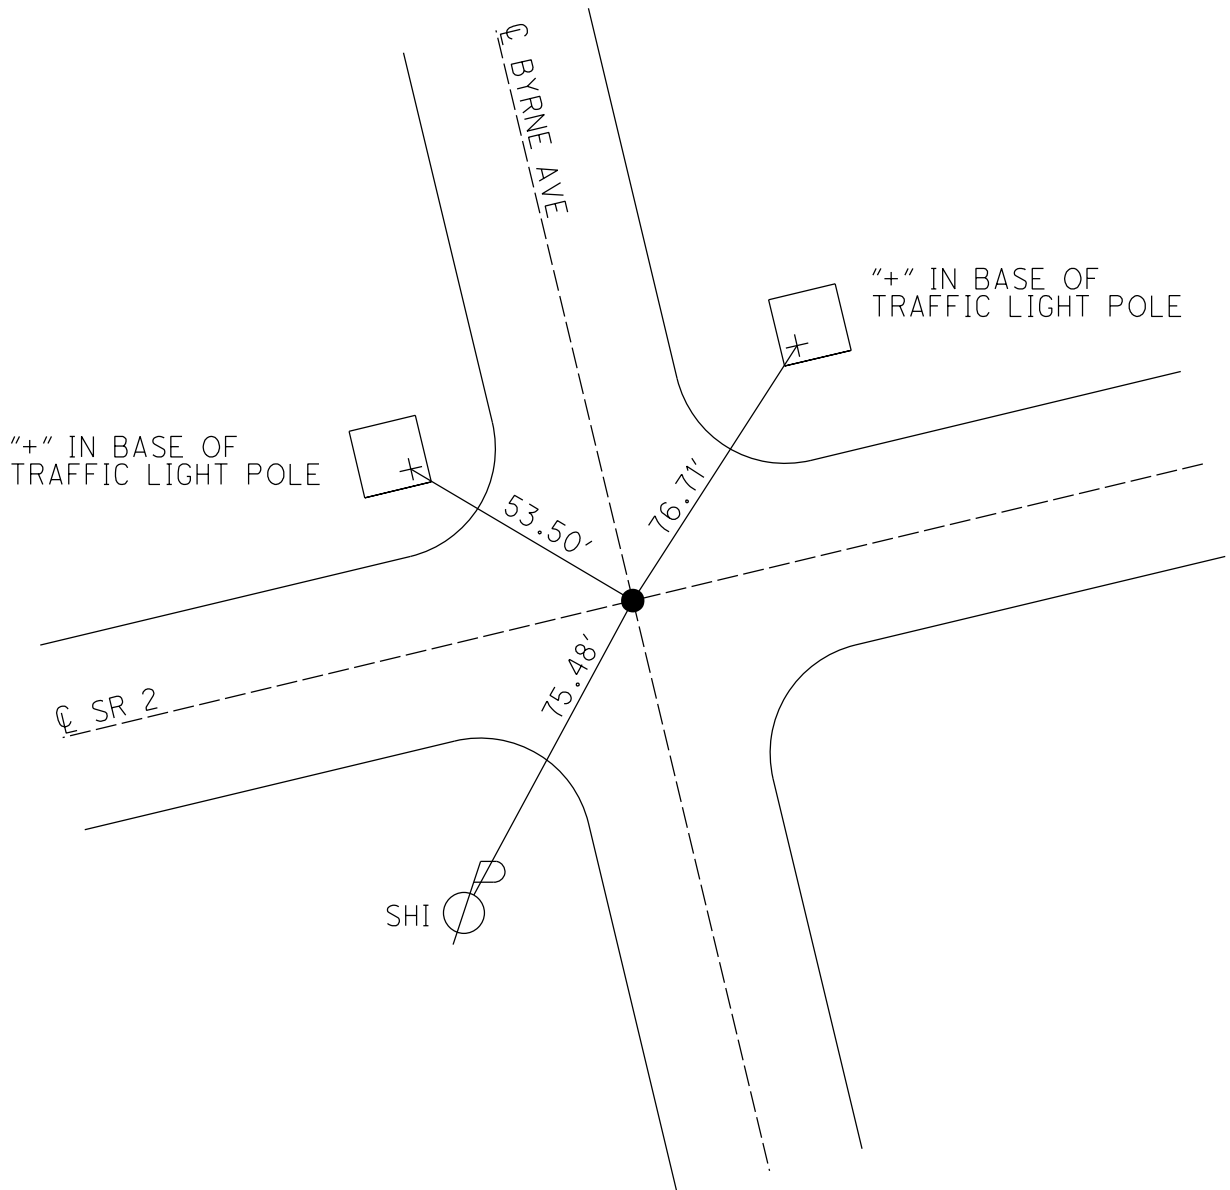

O.D.O.T. DISTRICT 2 SURVEY OFFICE (USE ONLY)

PERSONNEL

REFERENCE NO. 28 D

SHEET 11 OF 13

NOTES MILLER

DATE 2/24/23

ROUTE SR 2

H.C. NIESE

WEATHER SUNNY

COUNTY LUCAS

R.C.

TEMP. 78°

TOWNSHIP AMBOY

DWG BY BARRIERE

PID 108465

SECTION 13

T 2 N R E

TYPE MONUMENT "+" IN PAVEMENT

ON SURFACE - BELOW ON

OFFSET Q PAVEMENT ON LT : RT

TO EDGE PAVEMENT

STATION: 735+06.38

HORZ.DATUM:


GEOID:

GRID: NORTHING:


EASTING:

LDP: NORTHING:

EASTING:

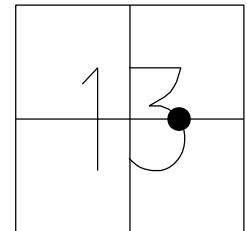

RECORD:
FD BRASS PLATE
9/8/60
DID NOT FIND
2/23/24, TDN

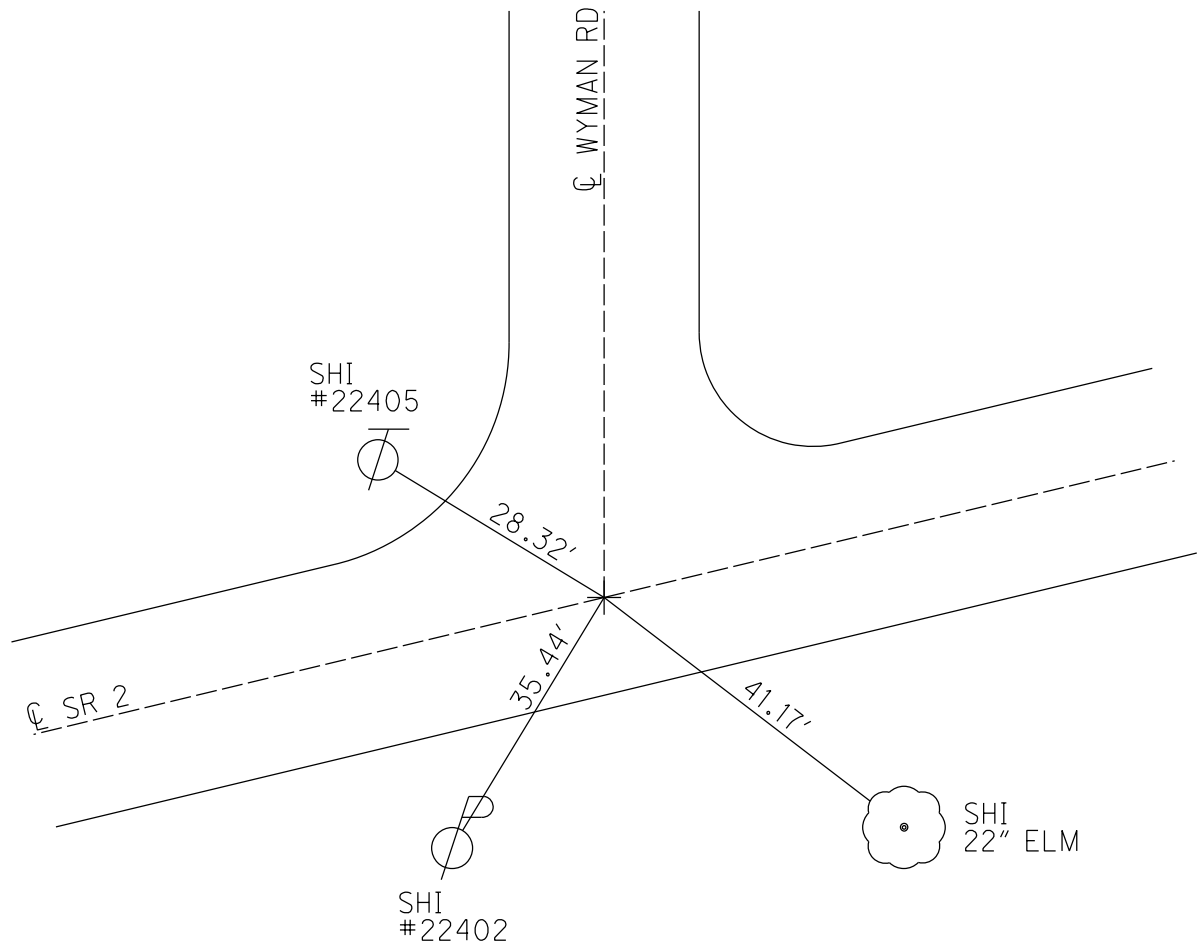

O.D.O.T. DISTRICT 2 SURVEY OFFICE (USE ONLY)

PERSONNEL

REFERENCE NO. 28 E

SHEET 12 OF 13

NOTES MILLER

DATE 2/24/23

ROUTE SR 2

H.C. NIESE

WEATHER SUNNY

COUNTY LUCAS

R.C.

TEMP. 78°

TOWNSHIP AMBOY

DWG BY BARRIERE

PID 108465

SECTION 13

T 2 N R E

TYPE MONUMENT ROOFING NAIL

ON SURFACE - BELOW ON

OFFSET $\varnothing$ PAVEMENT ON LT : RT

TO EDGE PAVEMENT

STATION: 739+25.62

HORIZ.DATUM:


GEOID:

GRID: NORTHING:


EASTING:

LDP: NORTHING:

EASTING:

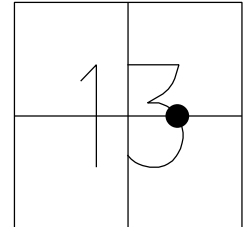

RECORD:
FD ROOFING NAIL
9/8/60
DID NOT FIND
2/23/24, TDN

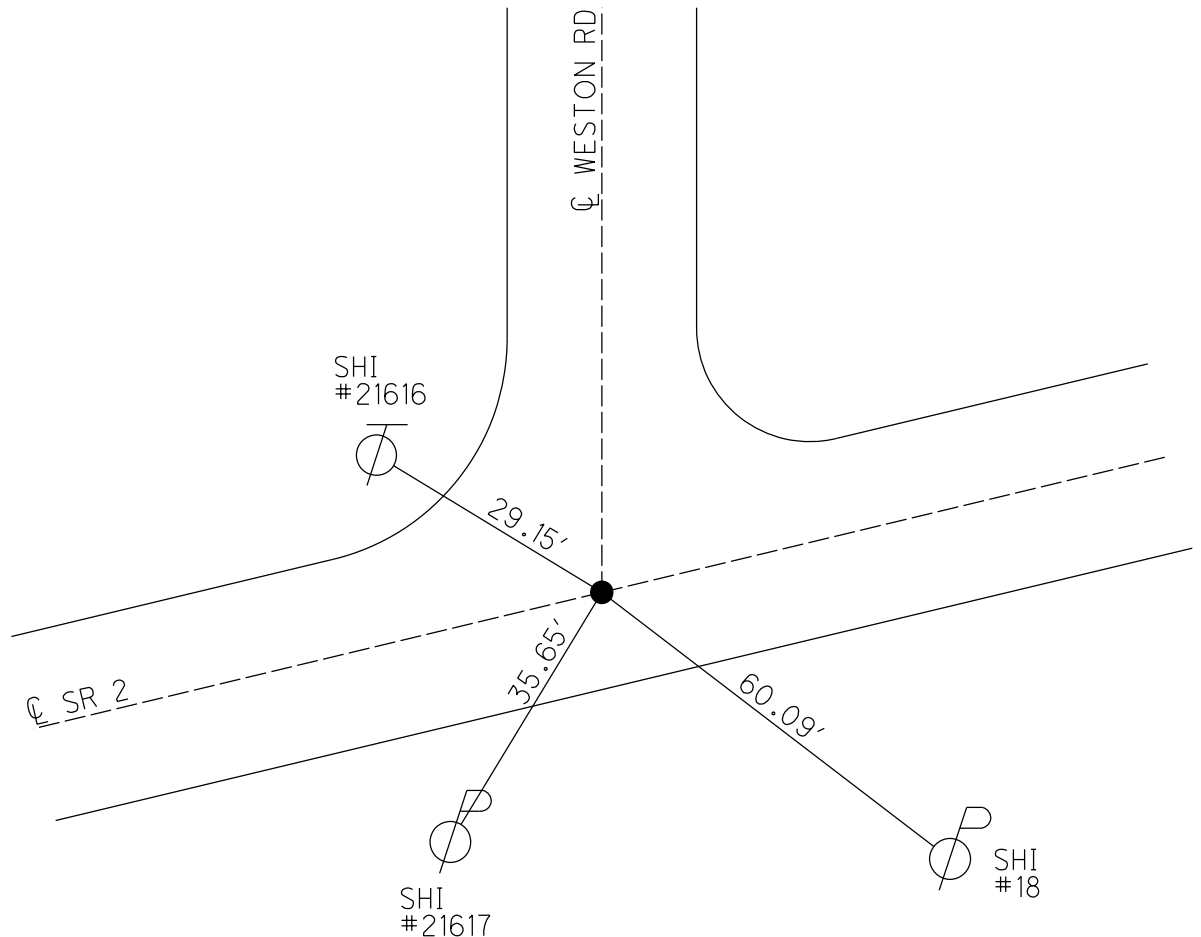

O.D.O.T. DISTRICT 2 SURVEY OFFICE (USE ONLY)

PERSONNEL

REFERENCE NO. 28 F

SHEET 12 OF 13

NOTES MILLER

DATE 2/24/23

ROUTE SR 2

H.C. NIESE

WEATHER SUNNY

COUNTY LUCAS

R.C. _____

TEMP. 78°

TOWNSHIP _____

DWG BY BARRIERE

PID 108465

SECTION 13

T 2 N R E

TYPE MONUMENT MONBOX W/ 1" IPIN

ON SURFACE - BELOW ON

OFFSET Q PAVEMENT ON LT : RT

_____ TO _____ EDGE PAVEMENT

STATION: _____

HORZ.DATUM: NAD83 (2011)


GEOID: NAVD88 2012B

GRID: NORTHING: 715992.611


EASTING: 1663309.388

LDP: NORTHING: _____

EASTING: _____

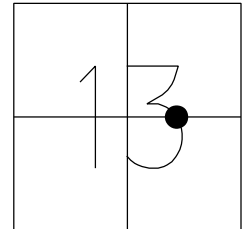

RECORD:
FD ROOFING NAIL
9/8/60
FD MONBOX
W/ 1" IPIN
REFF28
2/23/24, TDN

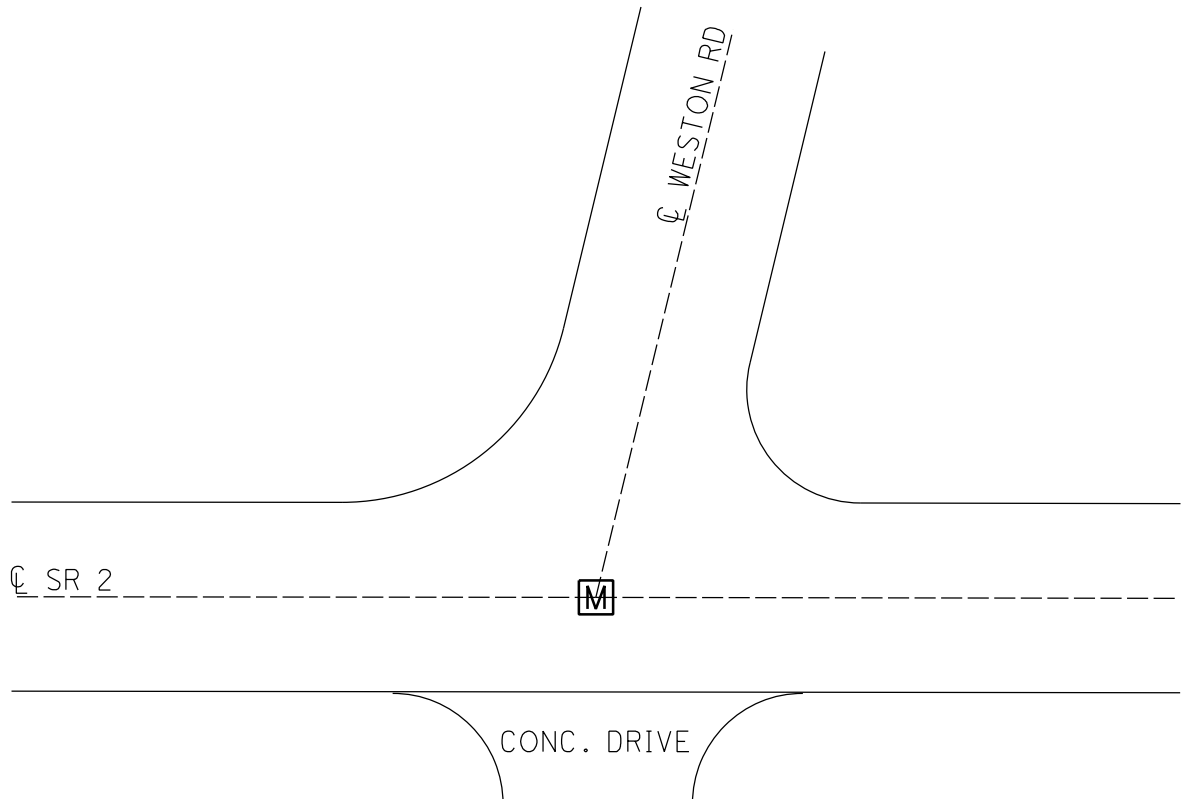

O.D.O.T. DISTRICT 2 SURVEY OFFICE (USE ONLY)

PERSONNEL

REFERENCE NO. 28 E

SHEET 13 OF 13

NOTES MILLER

DATE 2/24/23

ROUTE SR 2

H.C. NIESE

WEATHER SUNNY

COUNTY LUCAS

R.C. _____

TEMP. 78°

TOWNSHIP _____

DWG BY BARRIERE

PID 108465

SECTION 7

T 2 N R E

TYPE MONUMENT 1" IPIN IN CONCRETE

ON ~~SURFACE~~ - BELOW 4"

OFFSET ϕ PAVEMENT ON LT : RT

TO EDGE PAVEMENT

STATION: 1081+88

HORZ.DATUM: _____


GEOID: _____

GRID: NORTHING: _____


EASTING: _____

LDP: NORTHING: _____

EASTING: _____

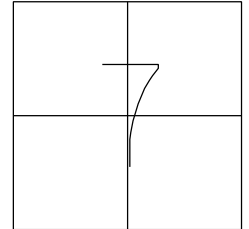

RECORD:
FD 1" IPIN
IN CONC.
4" DOWN
5/26/88
SET SM R.R.SPIKE
7/8/98, IRS
DID NOT FIND
2/23/24, TDN

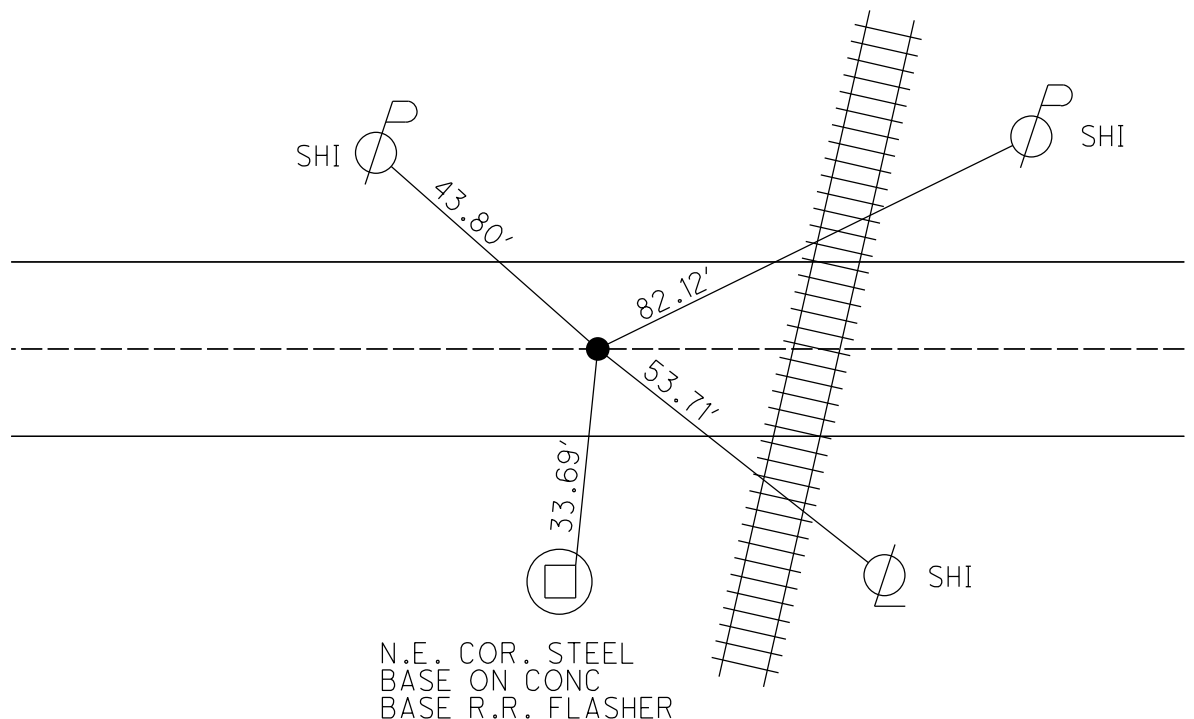

O.D.O.T. DISTRICT 2 SURVEY OFFICE (USE ONLY)

PERSONNEL

REFERENCE NO. 29 A

SHEET 1 OF 3

NOTES RHOADES

DATE 8/21/20

ROUTE SR 2

H.C. AUBLE

WEATHER SUNNY

COUNTY LUCAS

R.C. RHOADES

TEMP. 70°

TOWNSHIP CITY OF OREGON

SECTION 8

DWG BY RHOADES

PID 108421

T 10 S R 8 E

TYPE MONUMENT MAG NAIL

ON SURFACE - ~~BELOW~~ ON

OFFSET Q PAVEMENT ON LT : RT

- TO - EDGE PAVEMENT


STATION: 1113+01.54

HORZ.DATUM: NAD83 2011


GEOID: 2012A

GRID: NORTHING: 719251.083

EASTING: 1696573.321

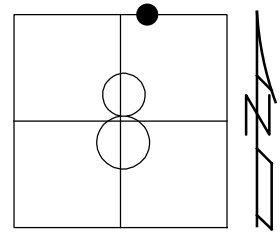

RECORD:
FD MAG NAIL
STA1113
10/7/19, DSA

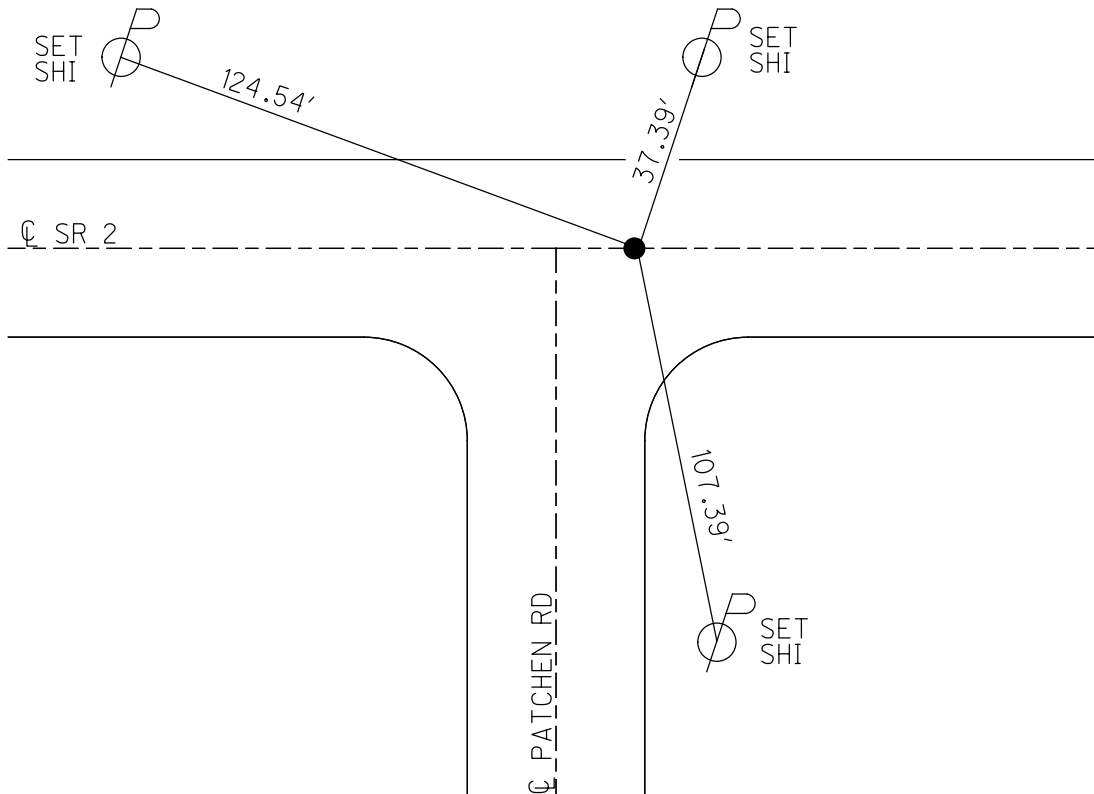

O.D.O.T. DISTRICT 2 SURVEY OFFICE (USE ONLY)

PERSONNEL

REFERENCE NO. 30

SHEET 2 OF 3

NOTES CURTIS

DATE 6/1/88

ROUTE SR 2

H.C. HOUSEHOLDE

WEATHER WARM

COUNTY LUCAS

R.C. _____

TEMP. 90°

TOWNSHIP CITY OF OREGON

DWG BY RHOADES

PID _____

SECTION 8

T 10 S R 8 E

TYPE MONUMENT MONBOX W/ 1" IPIN

ON SURFACE - ~~BELOW~~ ON

OFFSET CL PAVEMENT ON LT : RT

- TO - EDGE PAVEMENT


STATION: 1128+16.17

HORZ.DATUM: _____


GEOID: _____

GRID: NORTHING: _____

EASTING: _____

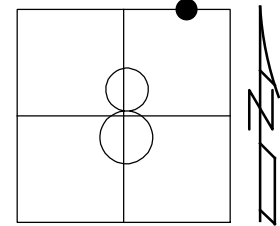

RECORD:
FD MONBOX
W/1" IPIN
6/1/88, DC

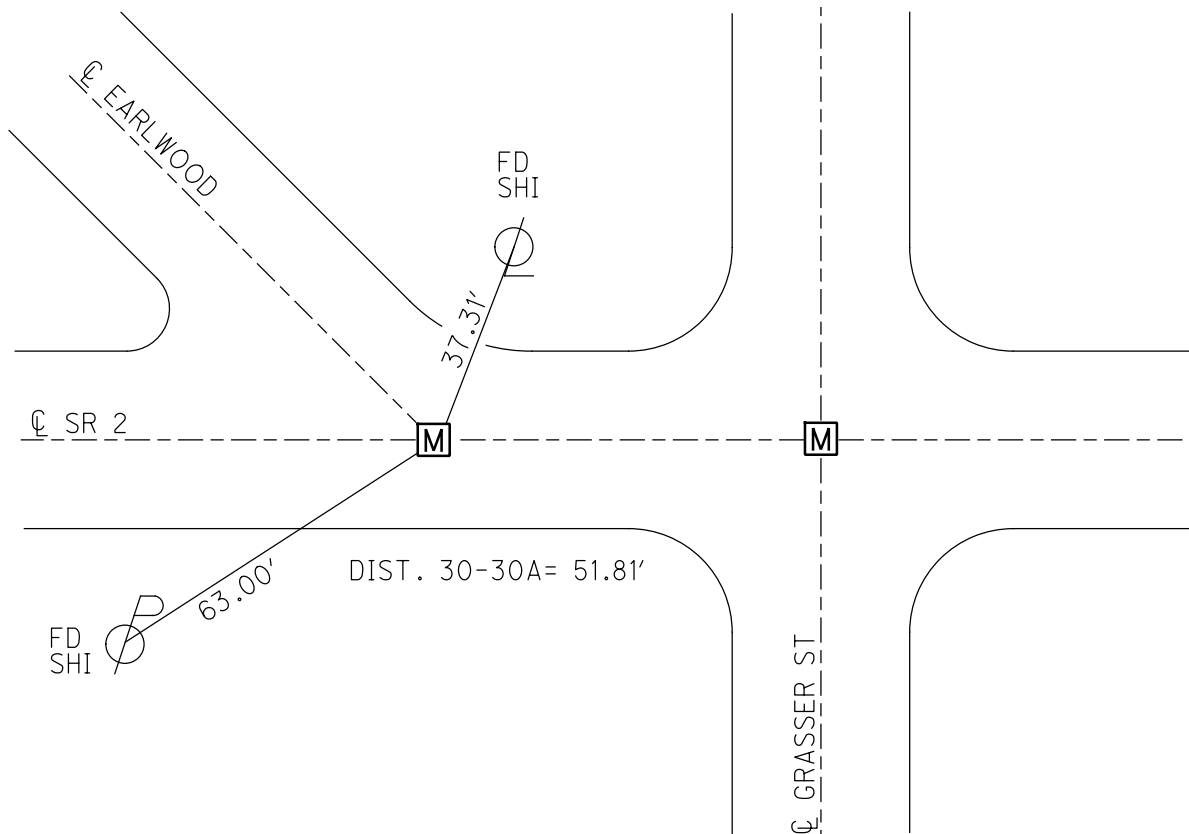

O.D.O.T. DISTRICT 2 SURVEY OFFICE (USE ONLY)

PERSONNEL

REFERENCE NO. 30 A

SHEET 3 OF 3

NOTES CURTIS

DATE 6/1/88

ROUTE SR 2

H.C. HOUSEHOLDE

WEATHER WARM

COUNTY LUCAS

R.C. _____

TEMP. 90°

TOWNSHIP CITY OF OREGON

DWG BY RHOADES PID 108421

SECTION 8

T 10 S R 8 E

TYPE MONUMENT MONBOX W/ 1" IPIN

ON SURFACE - ~~BELOW~~ ON

OFFSET Q PAVEMENT ON LT : RT

- TO - EDGE PAVEMENT


STATION: 1128+67.98

HORZ. DATUM: NAD83 2011


GEOID: 2012A

GRID: NORTHING: 719255.321

EASTING: 1698139.755

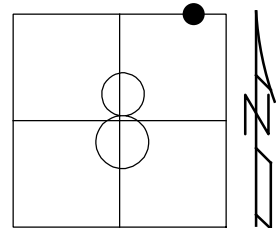

RECORD:
FD MONBOX
W/1" IPIN
6/1/88, DC
STA1128
10/7/19, DSA

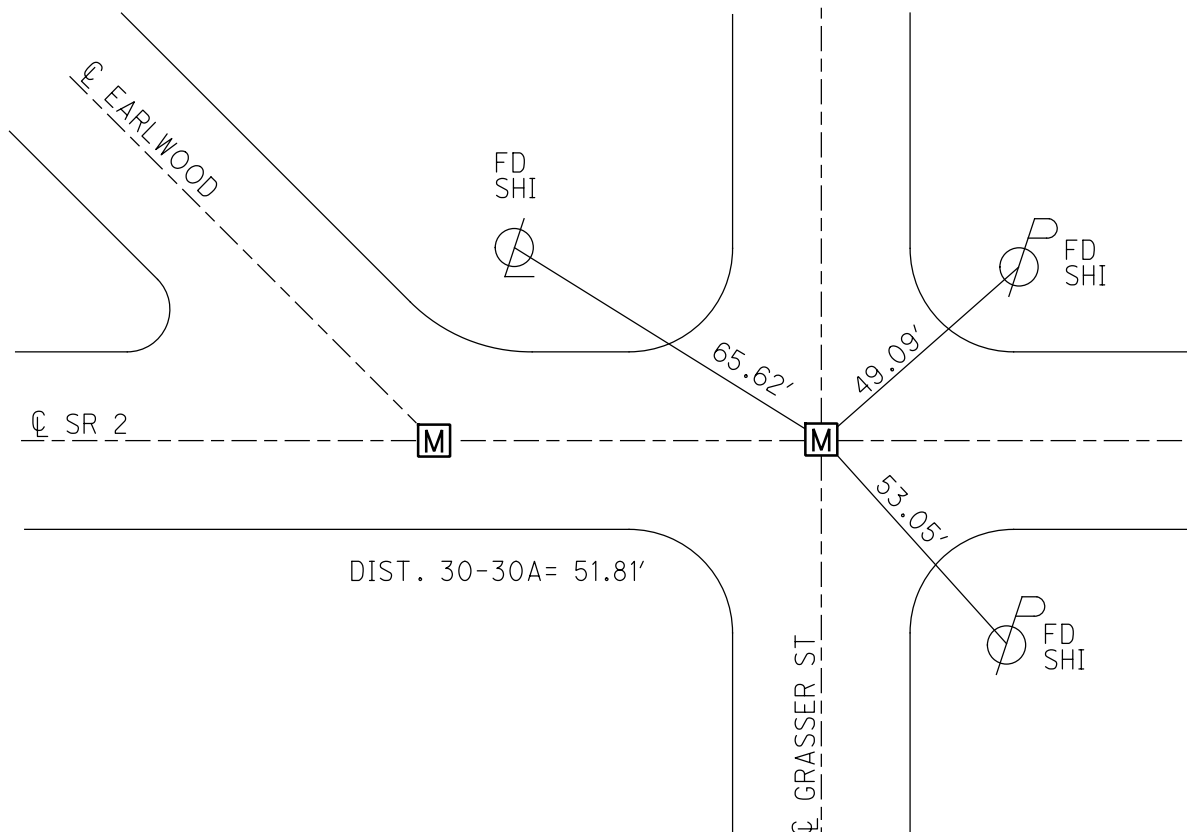

O.D.O.T. DISTRICT 2 SURVEY OFFICE (USE ONLY)

PERSONNEL

REFERENCE NO. 31

SHEET 4 OF 18

NOTES CURTIS

DATE 6/1/88

ROUTE SR 2

H.C. HOUSEHOLDER

WEATHER WARM

COUNTY LUCAS

R.C. _____

TEMP. 90°

TOWNSHIP CITY OF OREGON

DWG BY NIESE PID _____

SECTION 9

T 10 S R 8 E

TYPE MONUMENT MONBOX W/ 1" IPIN

~~ON SURFACE~~ - BELOW 1"

OFFSET Q PAVEMENT ON LT : RT

- TO - EDGE PAVEMENT


STATION: 1135+00

HORIZ.DATUM: _____


GEOID: _____

GRID: NORTHING: _____

EASTING: _____

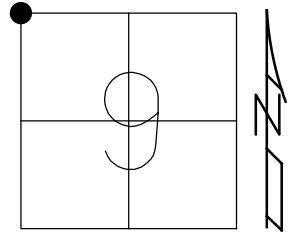

RECORD:
FD MONBOX
W/ 1" IPIN
1" DOWN
6/1/88, CURTIS
7/8/88, IRS

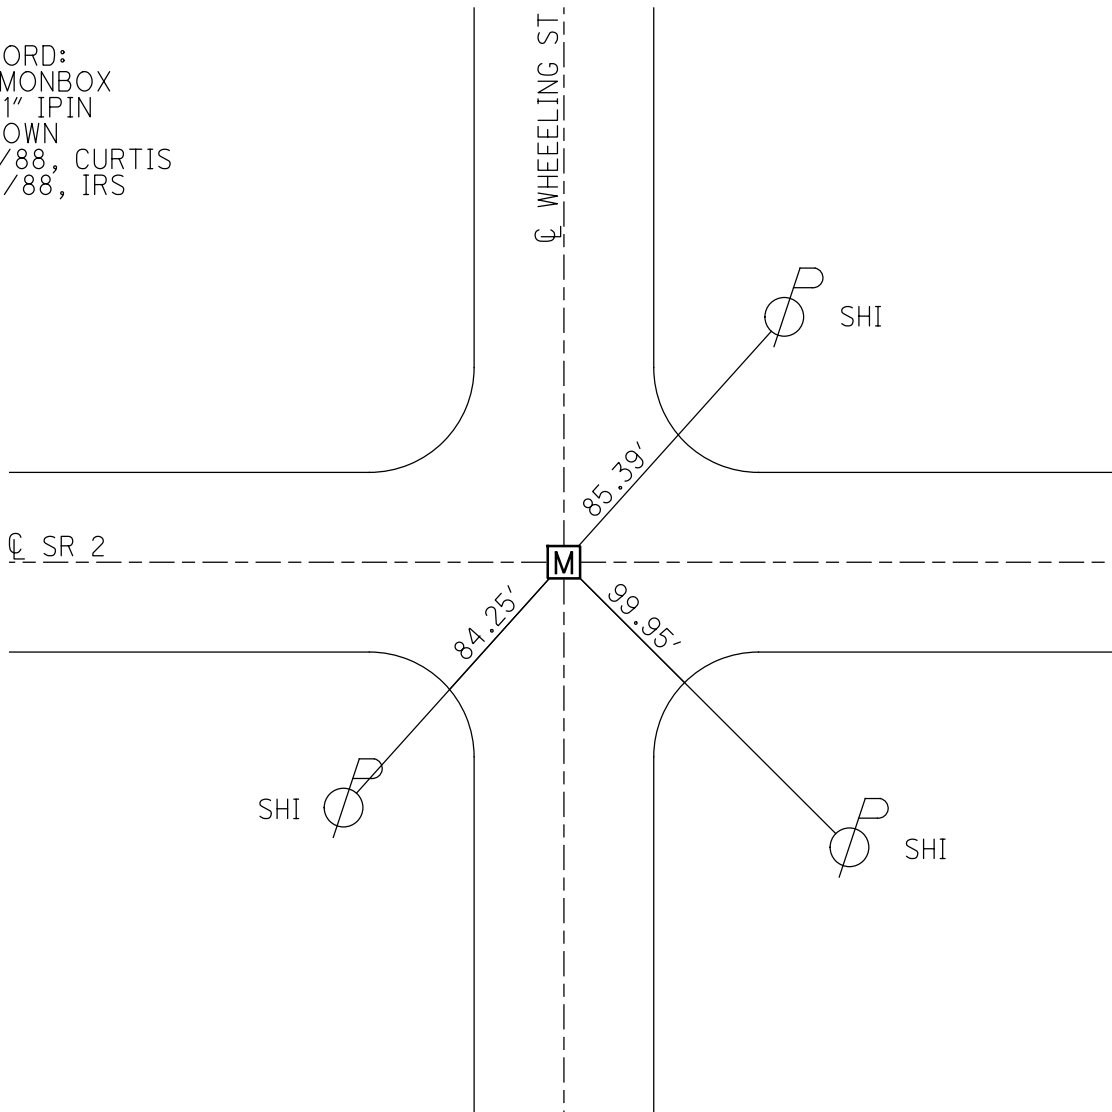

O.D.O.T. DISTRICT 2 SURVEY OFFICE (USE ONLY)

PERSONNEL

REFERENCE NO. 32

SHEET 5 OF 18

NOTES CURTIS

DATE 6/1/88

ROUTE SR 2

H.C. HOUSEHOLDER

WEATHER WARM

COUNTY LUCAS

R.C. _____

TEMP. 90°

TOWNSHIP CITY OF OREGON

DWG BY NIESE PID _____

SECTION 9

T 10 S R 8 E

TYPE MONUMENT MONBOX W/ 1" IPIN

~~ON SURFACE~~ - BELOW 2"

OFFSET Q PAVEMENT _____ ON _____ LT : RT

- TO - EDGE PAVEMENT


STATION: 1161+59

HORZ.DATUM: _____


GEOID: _____

GRID: NORTHING: _____

EASTING: _____

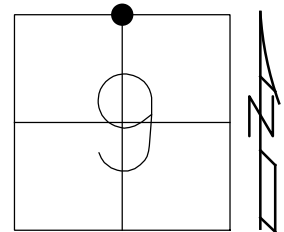

RECORD:
FD MONBOX
W/ 1" IPIN
2" DOWN
6/1/88, CURTIS
7/8/88, IRS

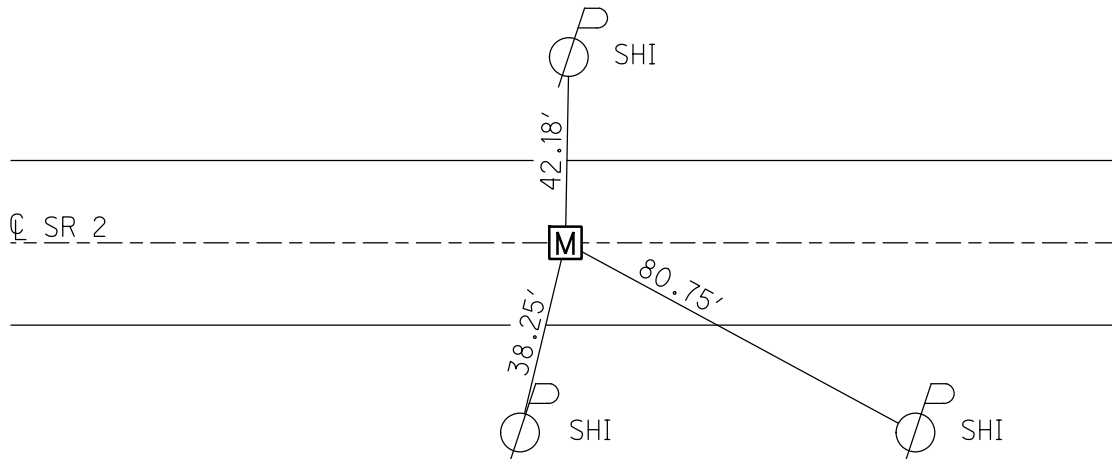

O.D.O.T. DISTRICT 2 SURVEY OFFICE (USE ONLY)

PERSONNEL

REFERENCE NO. 33

SHEET 6 OF 18

NOTES CURTIS

DATE 6/1/88

ROUTE SR 2

H.C. HOUSEHOLDER

WEATHER WARM

COUNTY LUCAS

R.C. _____

TEMP. 90°

TOWNSHIP CITY OF OREGON

SECTION 9

DWG BY NIESE

PID _____

T 10 S R 8 E

TYPE MONUMENT MONBOX W/ 1" IPIN

~~ON SURFACE~~ - BELOW 2"

OFFSET Q PAVEMENT _____ ON _____ LT : RT

- TO - EDGE PAVEMENT


STATION: 1188+11

HORZ.DATUM: _____


GEOID: _____

GRID: NORTHING: _____

EASTING: _____

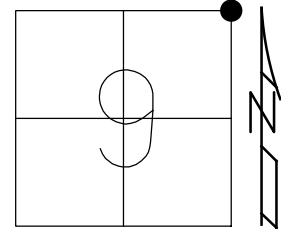

RECORD:
FD MONBOX
W/ 1" IPIN
2" DOWN
6/1/88, CURTIS
7/8/88, IRS

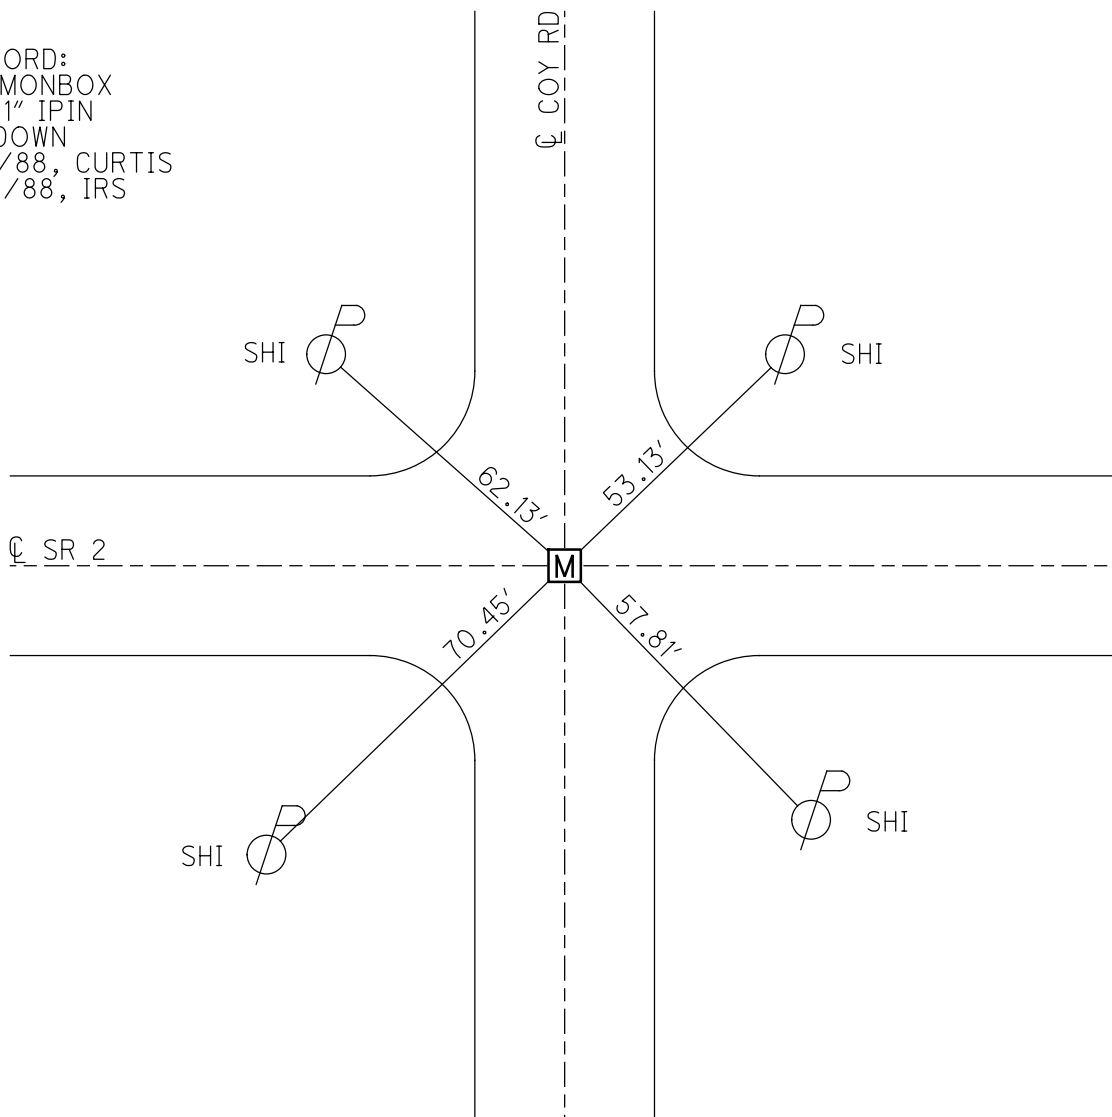

O.D.O.T. DISTRICT 2 SURVEY OFFICE (USE ONLY)

PERSONNEL

REFERENCE NO. 33 A

SHEET 7 OF 18

NOTES STONE

DATE 6/19/85

ROUTE SR 2

H.C. CURTIS

WEATHER SUNNY

COUNTY LUCAS

R.C. MICHALAK
HOUSEHOLDER

TEMP. 60°

TOWNSHIP CITY OF OREGON

DWG BY NIESE

PID

SECTION 10

T 10 S R 8 E

TYPE MONUMENT P.K. NAIL

ON SURFACE - ~~BELOW~~ ON

OFFSET CL PAVEMENT ON LT : RT

- TO - EDGE PAVEMENT


STATION: 1208+85

HORIZ.DATUM:


GEOID:

GRID: NORTHING:

EASTING:

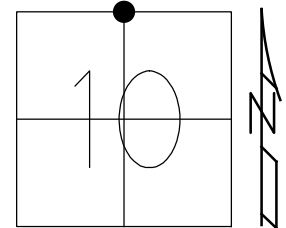

RECORD:
FD P.K. NAIL
6/19/85, IRS
SET P.K. NAIL
11/1/85

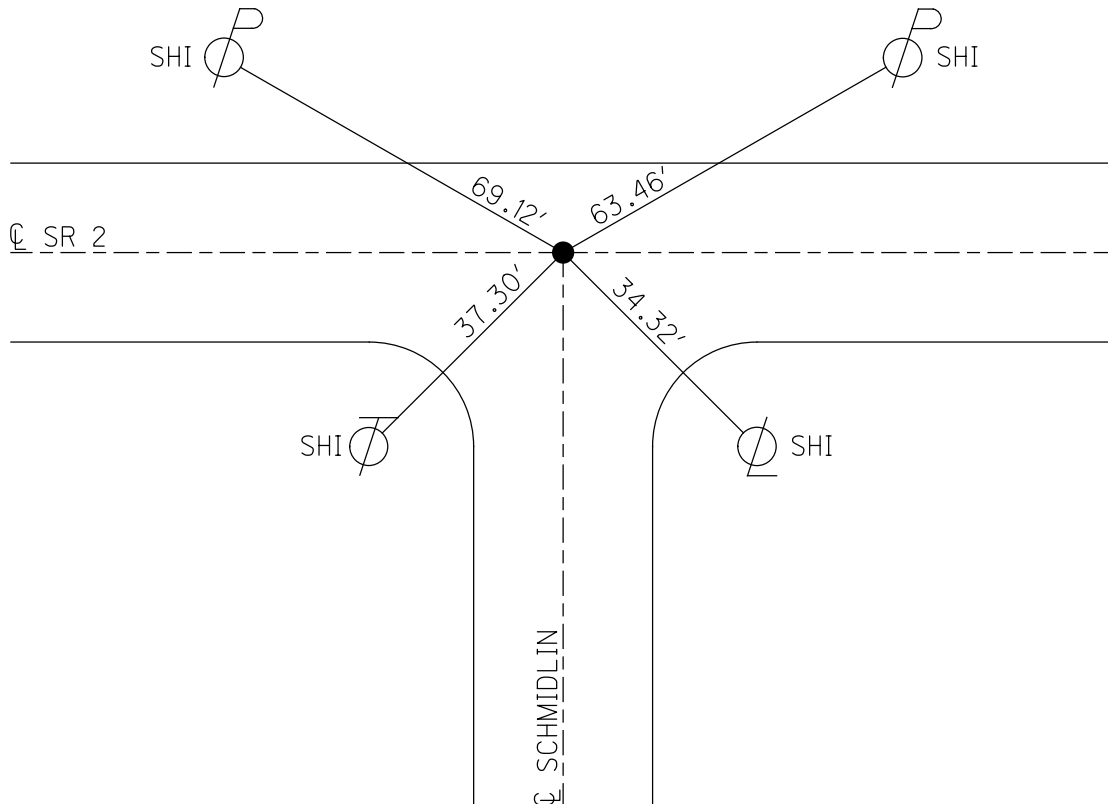

O.D.O.T. DISTRICT 2 SURVEY OFFICE (USE ONLY)

PERSONNEL

REFERENCE NO. 34

SHEET 8 OF 18

NOTES STONE

DATE 6/19/85

ROUTE SR 2

H.C. CURTIS

WEATHER SUNNY

COUNTY LUCAS

R.C. MICHALAK

TEMP. 60°

TOWNSHIP CITY OF OREGON

HOUSEHOLDER

SECTION 10

DWG BY NIESE PID

T 10 S R 8 E

TYPE MONUMENT SM.SPIKE

ON SURFACE - ~~BELOW~~ ON


OFFSET ℄ PAVEMENT ON LT : RT

- TO - EDGE PAVEMENT


STATION: 1219+00

HORIZ.DATUM: GEOID:

GRID: NORTHING: EASTING:

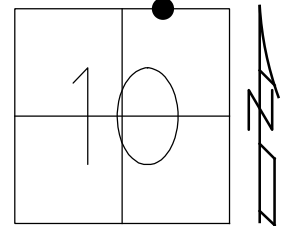

RECORD:
FD SM.SPIKE
6/19/85, IRS
SET P.K. NAIL
11/1/85

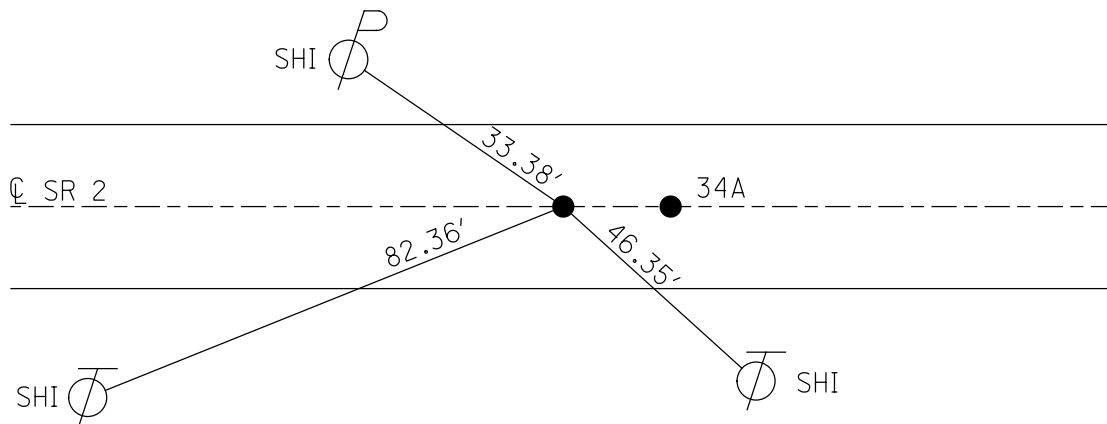

O.D.O.T. DISTRICT 2 SURVEY OFFICE (USE ONLY)

PERSONNEL

REFERENCE NO. 34 A

SHEET 9 OF 18

NOTES STONE DATE 6/19/85

H.C. CURTIS WEATHER SUNNY

R.C. MICHALAK TEMP. 60°

HOUSEHOLDER

ROUTE SR 2

COUNTY LUCAS

TOWNSHIP CITY OF OREGON

SECTION 10

DWG BY NIESE PID _____

T 10 S R 8 E

TYPE MONUMENT P.K. NAIL

ON SURFACE - ~~BELOW~~ ON


OFFSET Q PAVEMENT ON LT : RT

- TO - EDGE PAVEMENT


STATION: 1219+00

HORIZ.DATUM: _____ GEOID: _____

GRID: NORTHING: _____ EASTING: _____

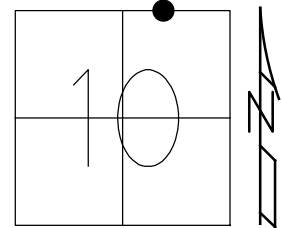

RECORD:
FD P.K. NAIL
6/19/85, IRS
SET P.K. NAIL
11/1/85

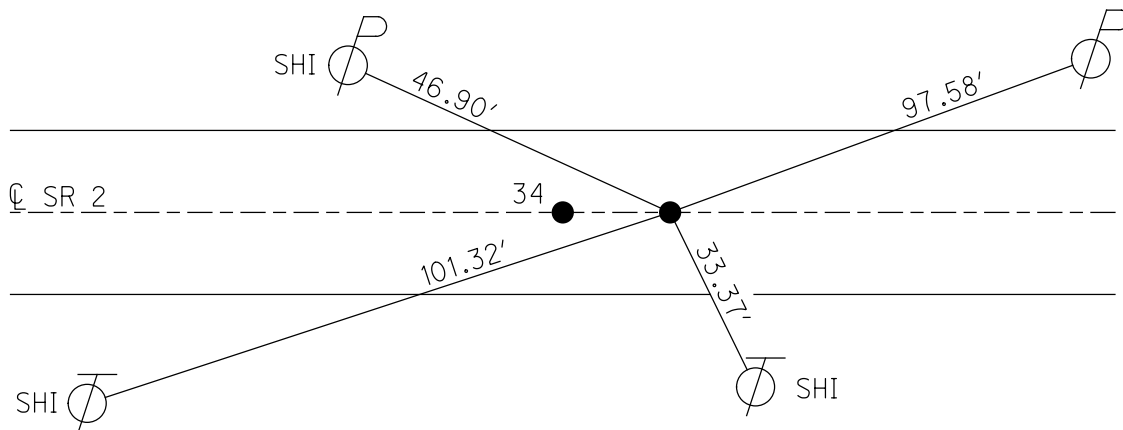

O.D.O.T. DISTRICT 2 SURVEY OFFICE (USE ONLY)

PERSONNEL

REFERENCE NO. 35

SHEET 10 OF 18

NOTES STONE

DATE 6/19/85

ROUTE SR 2

H.C. CURTIS

WEATHER SUNNY

COUNTY LUCAS

R.C. MICHALAK

TEMP. 60°

TOWNSHIP CITY OF OREGON

HOUSEHOLDER

SECTION 10

DWG BY NIESE PID

T 10 S R 8 E

TYPE MONUMENT IPIN IN CONC

~~ON SURFACE~~ - BELOW 4"


OFFSET CL PAVEMENT ON LT : RT

- TO - EDGE PAVEMENT


STATION: 1241+85

HORIZ.DATUM: GEOID:

GRID: NORTHING: EASTING:

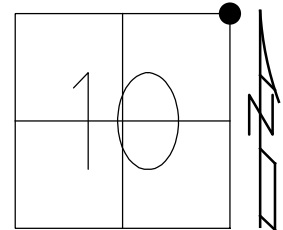

FD IPIN IN CONC
4" DOWN
6/19/85, IRS
FD 1" IPIN
4" DOWN
11/1/85

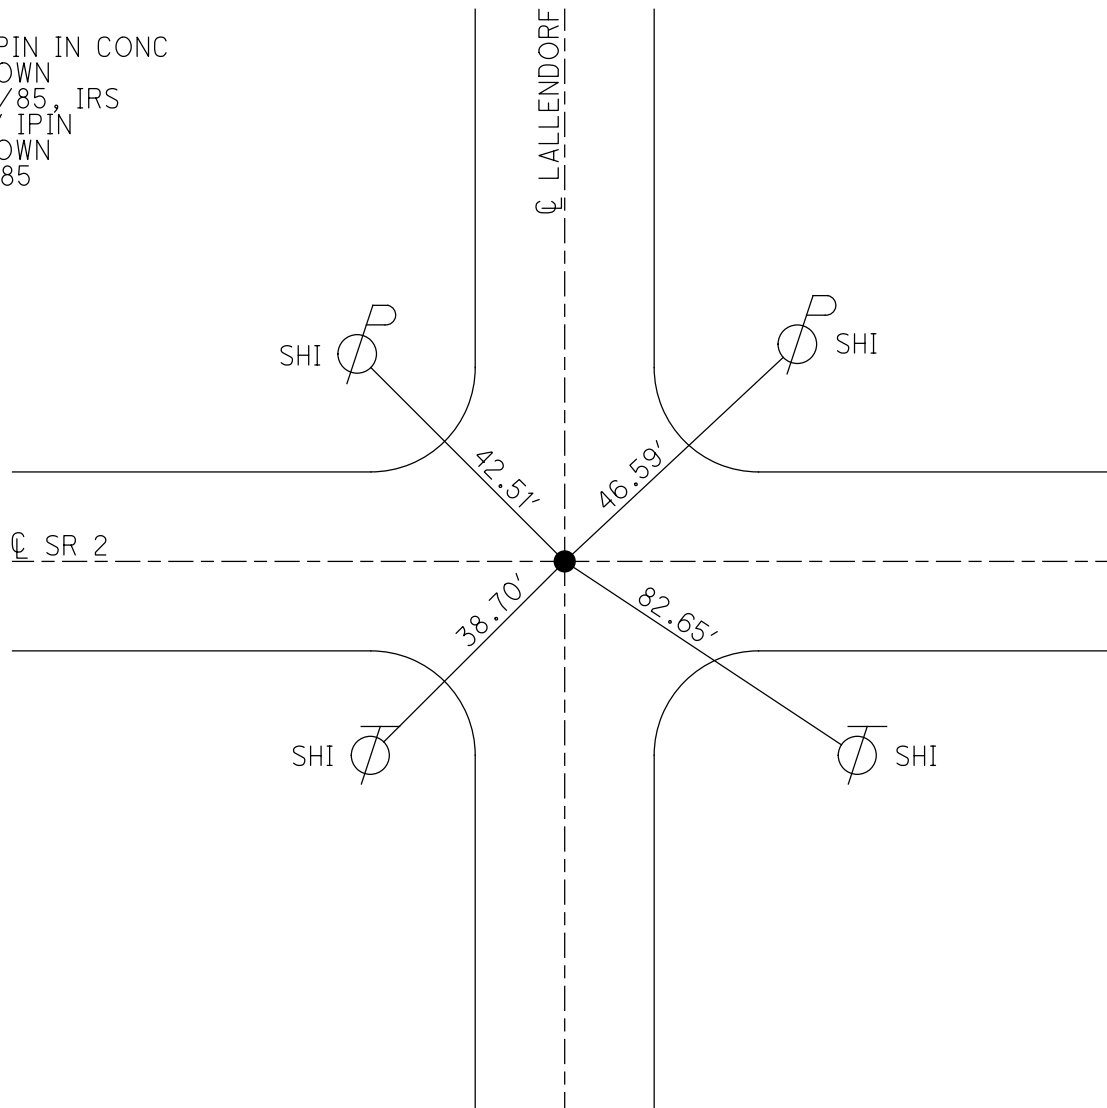

O.D.O.T. DISTRICT 2 SURVEY OFFICE (USE ONLY)

PERSONNEL

REFERENCE NO. 36

SHEET 11 OF 18

NOTES STONE

DATE 6/19/85

ROUTE SR 2

H.C. CURTIS

WEATHER SUNNY

COUNTY LUCAS

R.C. MICHALAK

TEMP. 60°

TOWNSHIP CITY OF OREGON

HOUSEHOLDER

SECTION 11

DWG BY NIESE PID

T 10 S R 8 E

TYPE MONUMENT R.R. SPIKE

ON SURFACE - ~~BELOW~~ ON


OFFSET CL PAVEMENT ON LT : RT

- TO - EDGE PAVEMENT


STATION: 1271+85

HORZ.DATUM: GEOID:

GRID: NORTHING: EASTING:

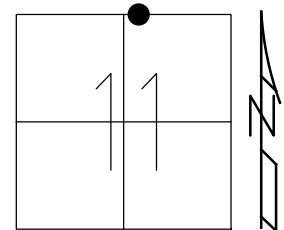

RECORD:
FD R.R. SPIKE
6/19/85, IRS
FD R.R. SPIKE
3" DOWN
11/1/85

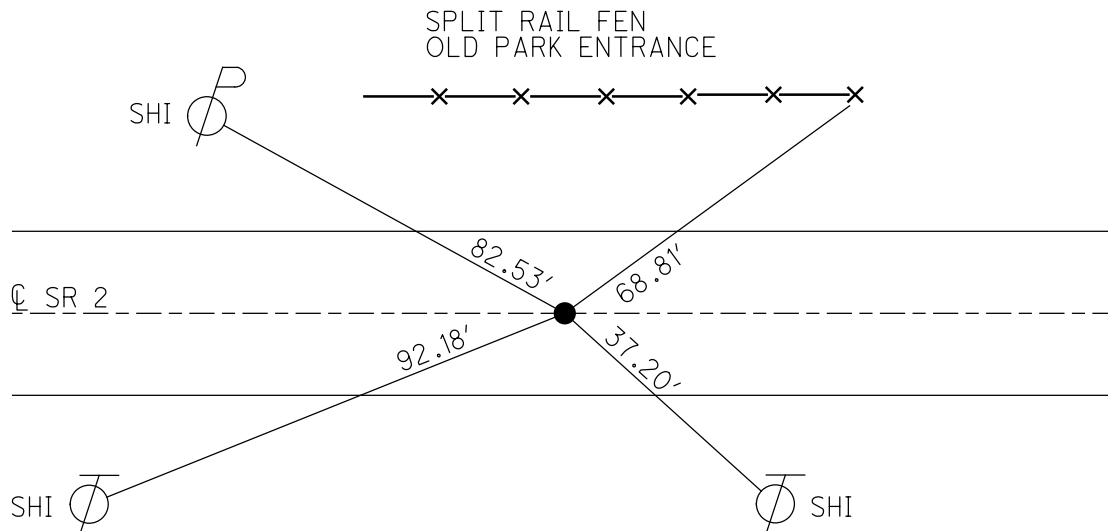

O.D.O.T. DISTRICT 2 SURVEY OFFICE (USE ONLY)

PERSONNEL

REFERENCE NO. 37

SHEET 12 OF 18

NOTES STONE

DATE 6/19/85

ROUTE SR 2

H.C. CURTIS

WEATHER SUNNY

COUNTY LUCAS

R.C. MICHALAK

TEMP. 60°

TOWNSHIP CITY OF OREGON

HOUSEHOLDER

SECTION 11

DWG BY NIESE PID

T 10 S R 8 E

TYPE MONUMENT SQUARE BOLT

ON SURFACE - ~~BELOW~~ ON

OFFSET ℄ PAVEMENT ON LT : RT

 TO EDGE PAVEMENT


STATION: 1295+18

HORZ.DATUM:


GEOID:

GRID: NORTHING:

EASTING:

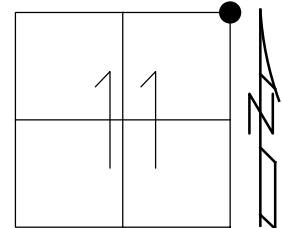

RECORD:
FD SQUARE BOLT
6/19/85, IRS
FD SQUARE BOLT
2" DOWN
11/1/85

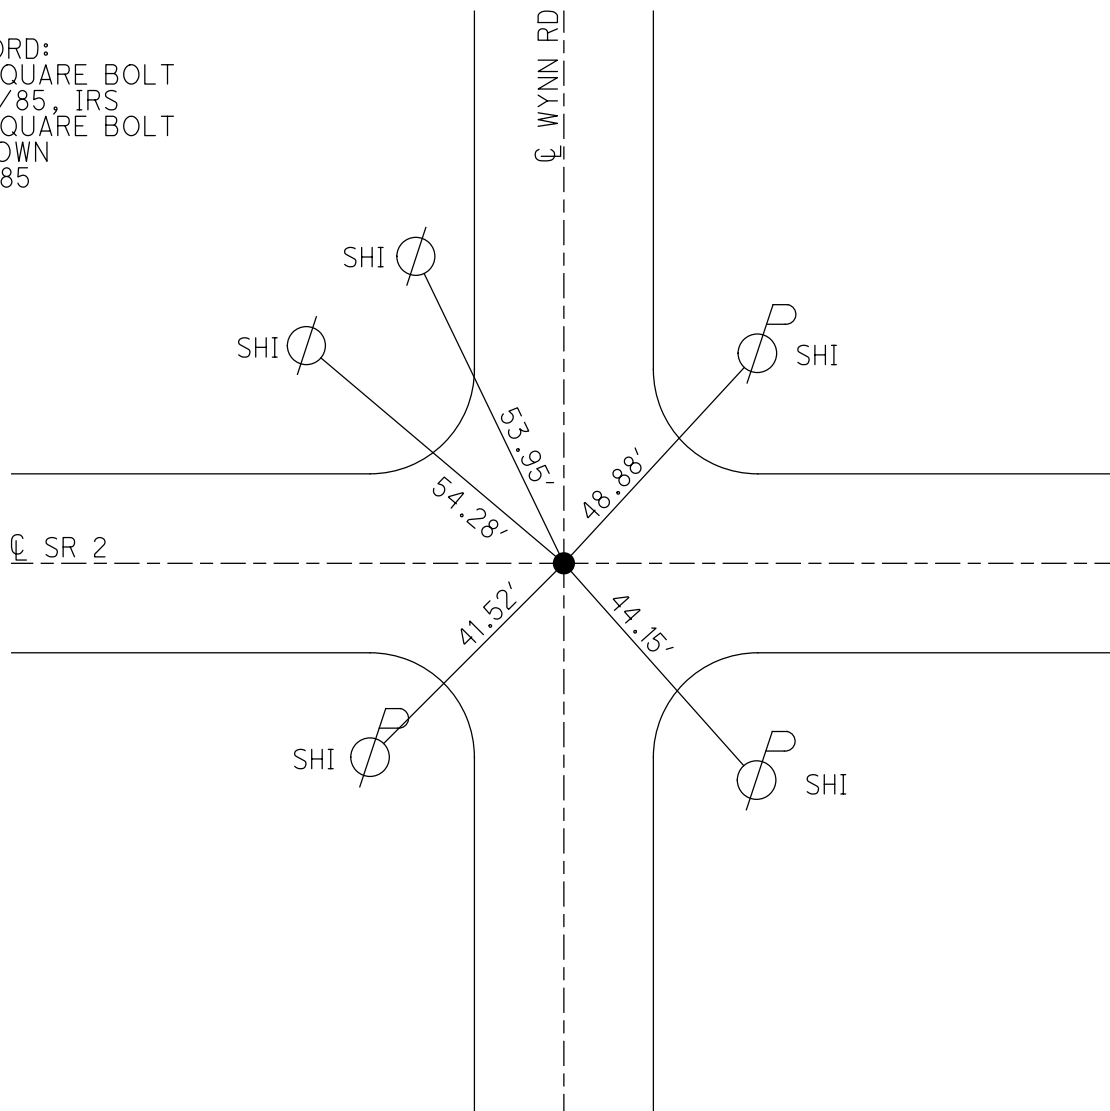

O.D.O.T. DISTRICT 2 SURVEY OFFICE (USE ONLY)

PERSONNEL

REFERENCE NO. 38

SHEET 13 OF 18

NOTES STONE

DATE 6/19/85

ROUTE SR 2

H.C. CURTIS

WEATHER FAIR

COUNTY LUCAS

R.C. MICHALAK

TEMP. 60°

TOWNSHIP CITY OF OREGON

HOUSEHOLDER

SECTION 12

DWG BY NIESE

PID _____

T 10 S R 8 E

TYPE MONUMENT R.R. SPIKE

ON SURFACE - ~~BELOW~~ ON

OFFSET ℄ PAVEMENT ON LT : RT

- TO - EDGE PAVEMENT


STATION: 1324+81

HORZ.DATUM: _____


GEOID: _____

GRID: NORTHING: _____

EASTING: _____

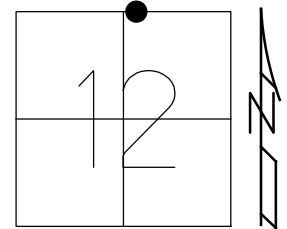

RECORD;
FD R.R. SPIKE
6/19/85, IRS
FD R.R. SPIKE
3" DOWN
11/1/85

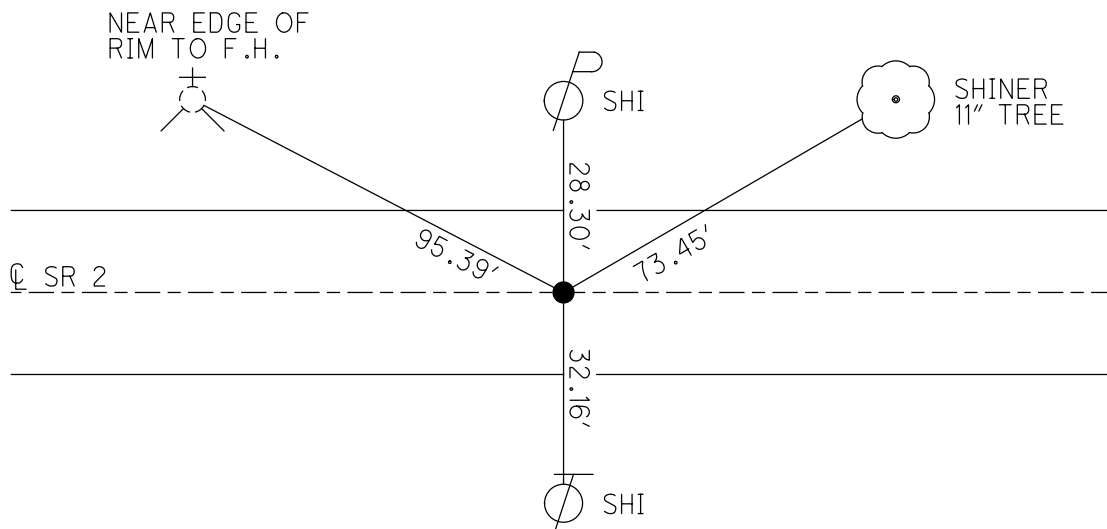

O.D.O.T. DISTRICT 2 SURVEY OFFICE (USE ONLY)

PERSONNEL

REFERENCE NO. 39

SHEET 14 OF 18

NOTES STONE

DATE 6/21/85

ROUTE SR 2

H.C. CURTIS

WEATHER SUNNY

COUNTY LUCAS

R.C. MICHALAK
HOUSEHOLDER

TEMP. 64°

TOWNSHIP CITY OF OREGON

DWG BY NIESE PID

SECTION 12

T 10 S R 8 E

TYPE MONUMENT MONBOX

ON SURFACE - ~~BELOW~~ ON

OFFSET CL PAVEMENT ON LT : RT

- TO - EDGE PAVEMENT


STATION: 1350+10

HORZ.DATUM:


GEOID:

GRID: NORTHING:

EASTING:

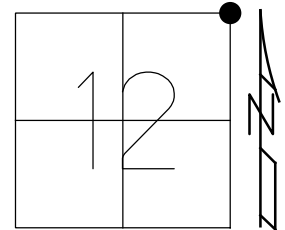

RECORD:
FD MONBOX
6/21/85, IRS
FD MONBOX
11/1/85

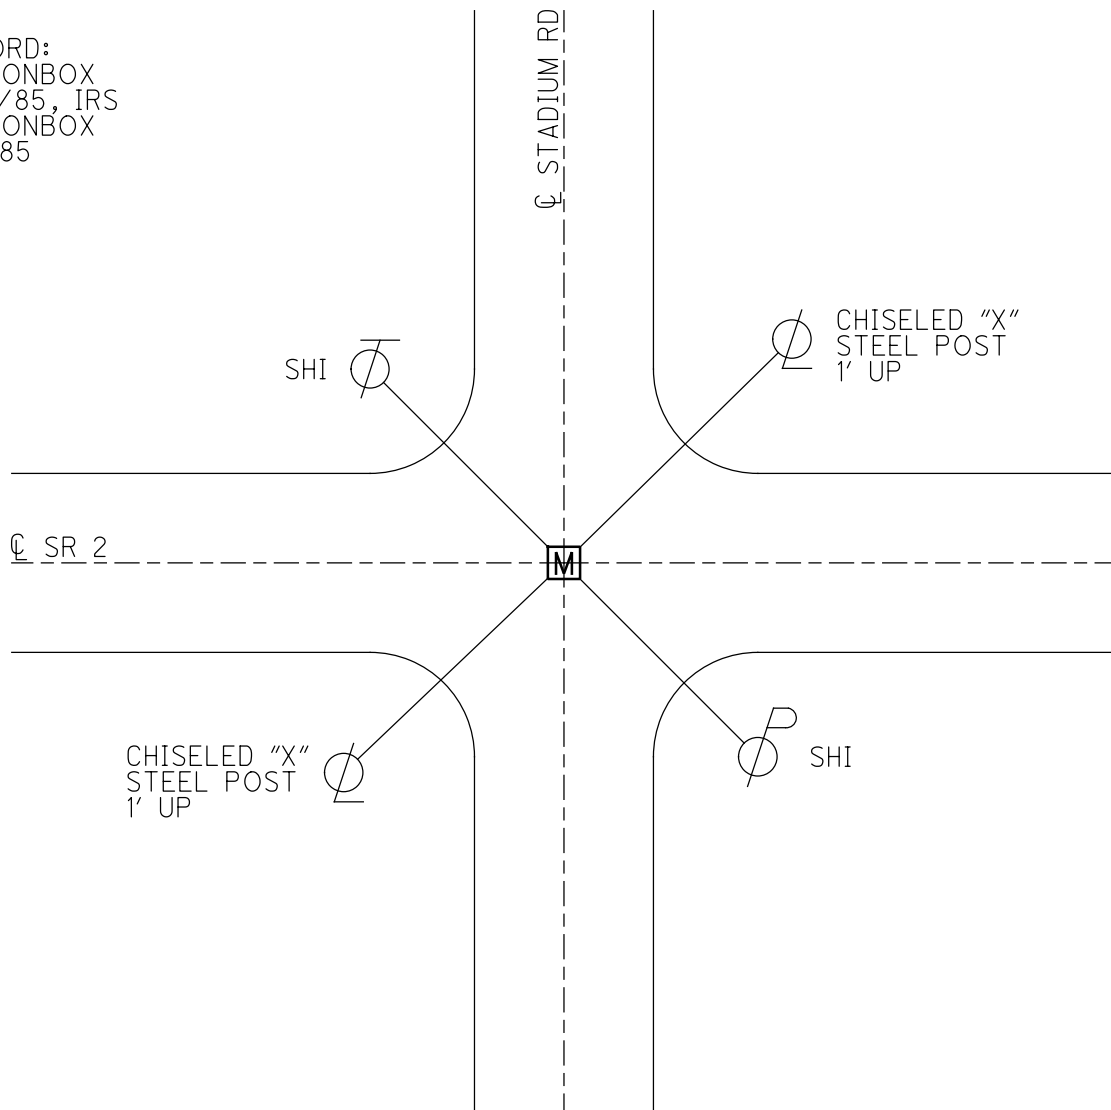

O.D.O.T. DISTRICT 2 SURVEY OFFICE (USE ONLY)

PERSONNEL

REFERENCE NO. 40

SHEET 15 OF 18

NOTES STONE
H.C. CURTIS
R.C. MICHALAK
HOUSEHOLDER

DATE 6/20/85
WEATHER SUNNY
TEMP. 64°

ROUTE SR 2
COUNTY LUCAS
TOWNSHIP CITY OF OREGON
SECTION 7
T 10 S R 9 E

DWG BY NIESE PID

TYPE MONUMENT P.K. NAIL


ON SURFACE - ~~BELOW~~ ON

OFFSET CL PAVEMENT ON LT : RT
- TO - EDGE PAVEMENT


STATION: 1376+76

HORZ.DATUM: GEOID:

GRID: NORTHING: EASTING:

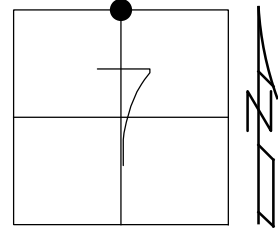

FD P.K. NAIL
6/20/85, IRS
SET P.K. NAIL
11/1/85

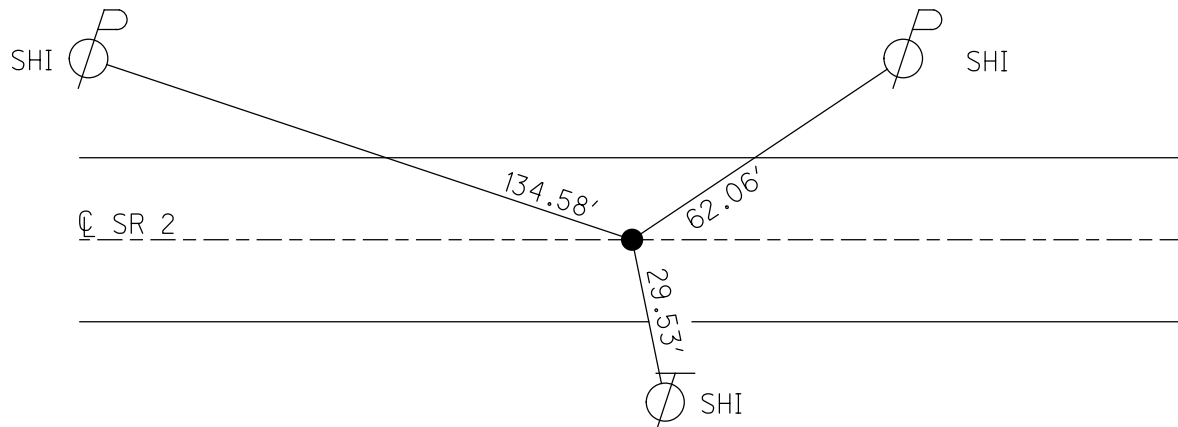

O.D.O.T. DISTRICT 2 SURVEY OFFICE (USE ONLY)

PERSONNEL

REFERENCE NO. 41

SHEET 16 OF 18

NOTES STONE

DATE 6/20/85

ROUTE SR 2

H.C. CURTIS

WEATHER SUNNY

COUNTY LUCAS

R.C. MICHALAK

TEMP. 65°

TOWNSHIP CITY OF OREGON

HOUSEHOLDER

SECTION 7

DWG BY NIESE PID

T 10 S R 9 E

TYPE MONUMENT P.K. NAIL

ON SURFACE - ~~BELOW~~ ON


OFFSET CL PAVEMENT ON LT : RT

- TO - EDGE PAVEMENT


STATION: 1390+06

HORZ.DATUM: GEOID:

GRID: NORTHING: EASTING:

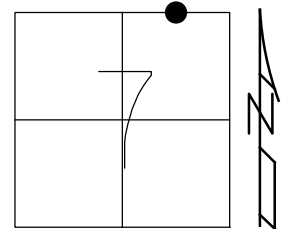

RECORD:
FD P.K. NAIL
6/20/85, IRS
SET P.K. NAIL
11/1/85

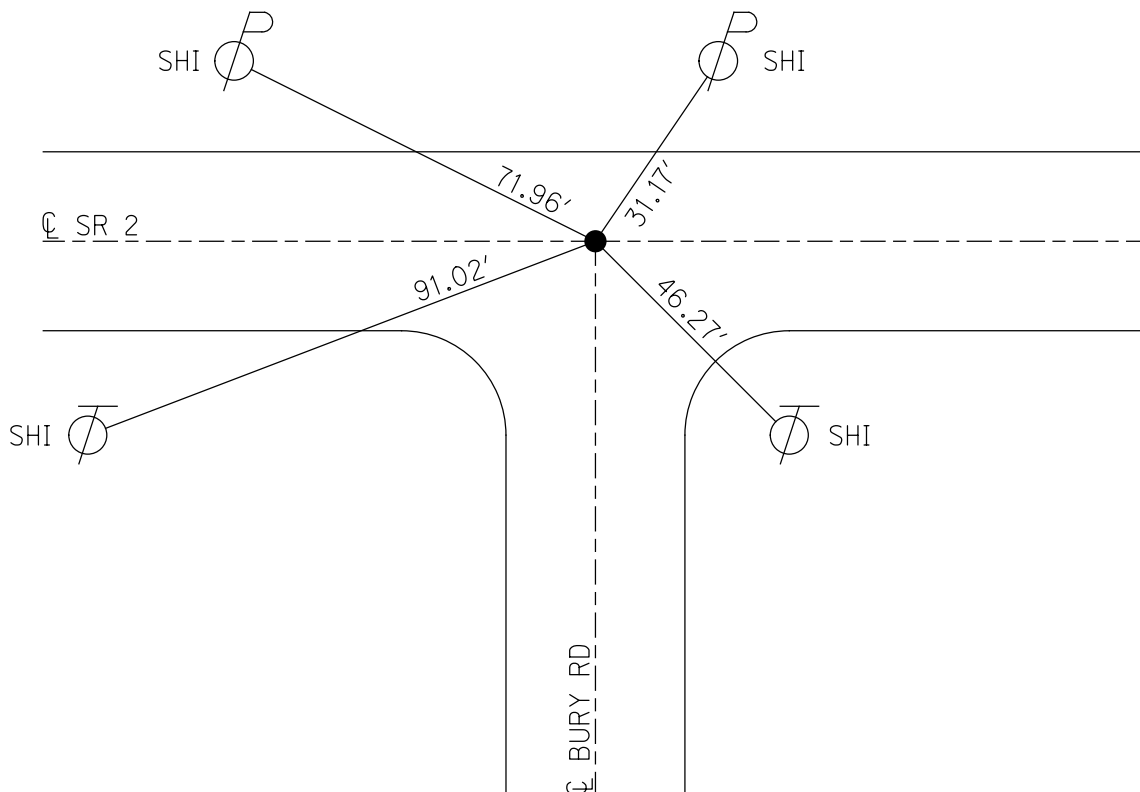

O.D.O.T. DISTRICT 2 SURVEY OFFICE (USE ONLY)

PERSONNEL

REFERENCE NO. 42

SHEET 17 OF 18

NOTES STONE

DATE 6/20/85

ROUTE SR 2

H.C. CURTIS

WEATHER SUNNY

COUNTY LUCAS

R.C. MICHALAK
HOUSEHOLDER

TEMP. 65°

TOWNSHIP CITY OF OREGON

DWG BY NIESE PID

SECTION 7

T 10 S R 9 E

TYPE MONUMENT MOBORA

~~ON SURFACE~~ - BELOW 2"

OFFSET CL PAVEMENT ON LT : RT

- TO - EDGE PAVEMENT


STATION: 1404+40

HORZ.DATUM:


GEOID:

GRID: NORTHING:

EASTING:

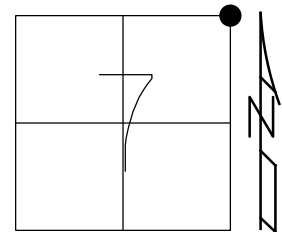

RECORD:
FD MOBORA
2" DOWN
6/20/85, IRS
FD MOBORA
4" DOWN
11/1/85

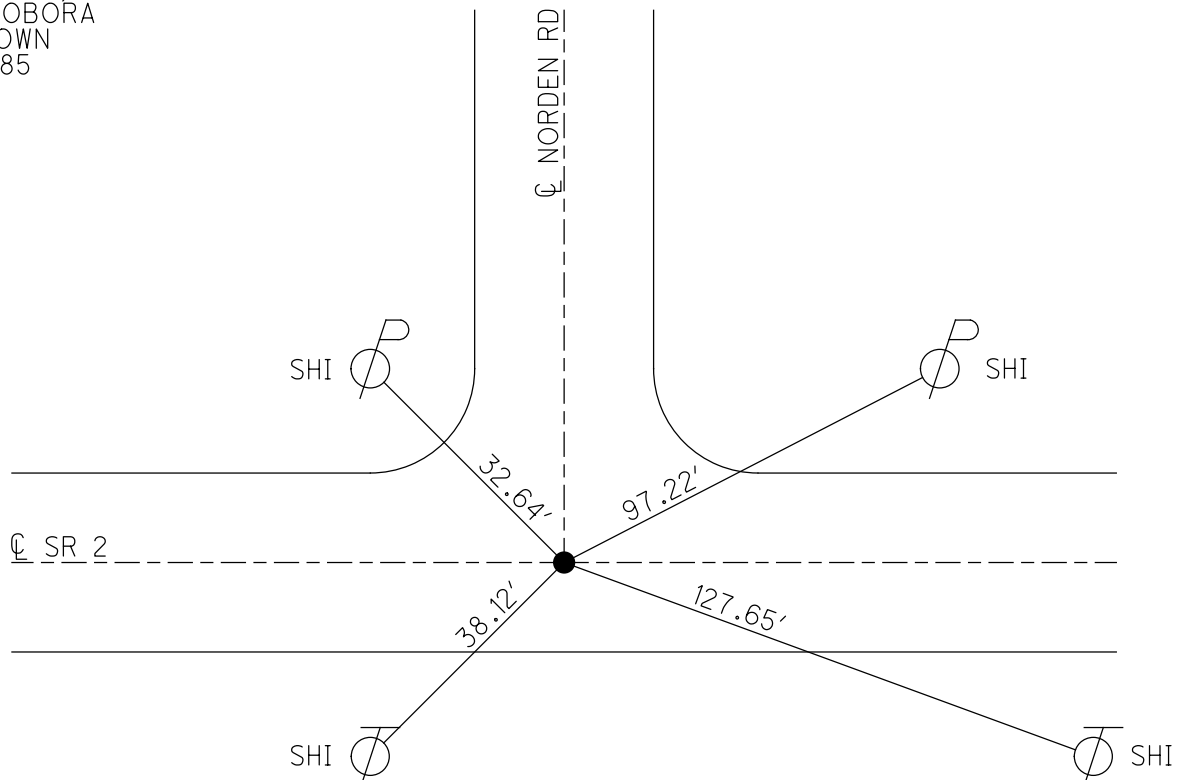

O.D.O.T. DISTRICT 2 SURVEY OFFICE (USE ONLY)

PERSONNEL

REFERENCE NO. 43

SHEET 18 OF 18

NOTES STONE

DATE 6/20/85

ROUTE SR 2

H.C. CURTIS

WEATHER SUNNY

COUNTY LUCAS

R.C. MICHALAK

TEMP. 66°

TOWNSHIP CITY OF OREGON

HOUSEHOLDER

SECTION 8

DWG BY NIESE PID

T 10 S R 9 E

TYPE MONUMENT P.K. NAIL

ON SURFACE - ~~BELOW~~ ON

OFFSET CL PAVEMENT ON LT : RT

- TO - EDGE PAVEMENT


STATION: 1429+91

HORIZ.DATUM:


GEOID:

GRID: NORTHING:

EASTING:

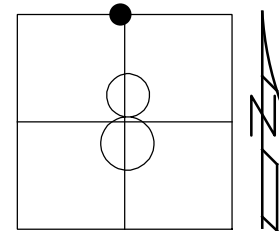

RECORD:
FD P.K. NAIL
6/220/85, IRS
SET P.K. NAIL
11/1/85

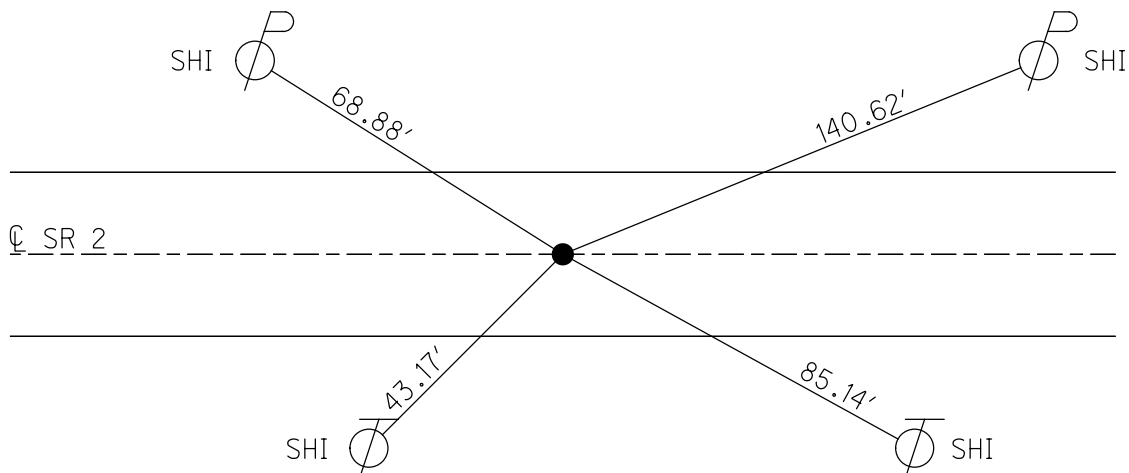


O.D.O.T. DISTRICT 2 SURVEY OFFICE (USE ONLY)


PERSONNEL	REFERENCE NO. <u>44</u>	SHEET <u>1</u> OF <u>20</u>
NOTES <u>LOEHRKE</u>	DATE <u>8/14/96</u>	ROUTE <u>2</u>
H.C. <u>ROUSOS</u>	WEATHER <u>NICE</u>	COUNTY <u>LUCAS</u>
R.C. <u>CANTERBURY</u>	TEMP. <u>84°</u>	TOWNSHIP <u>JERUSALEM</u>
		SECTION <u>4</u>
		T <u>10</u> S R <u>9</u> E

TYPE MONUMENT MONBOX W/DISK AND "+"
 ON SURFACE - BELOW ON
 LEFT - CL PAV'T - RIGHT ON
- TO - EDGE PAVEMENT
 S.L.M. 1452+48.36

GRID: NORTHING: 719494.494 EASTING: 1730515.553

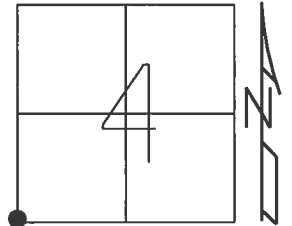


RECORD:
 MONBOX IS ON CL OF
 WEST, SOUTH AND EAST
 FD P.K.NAIL
 REF44
 3/16/15, JFO

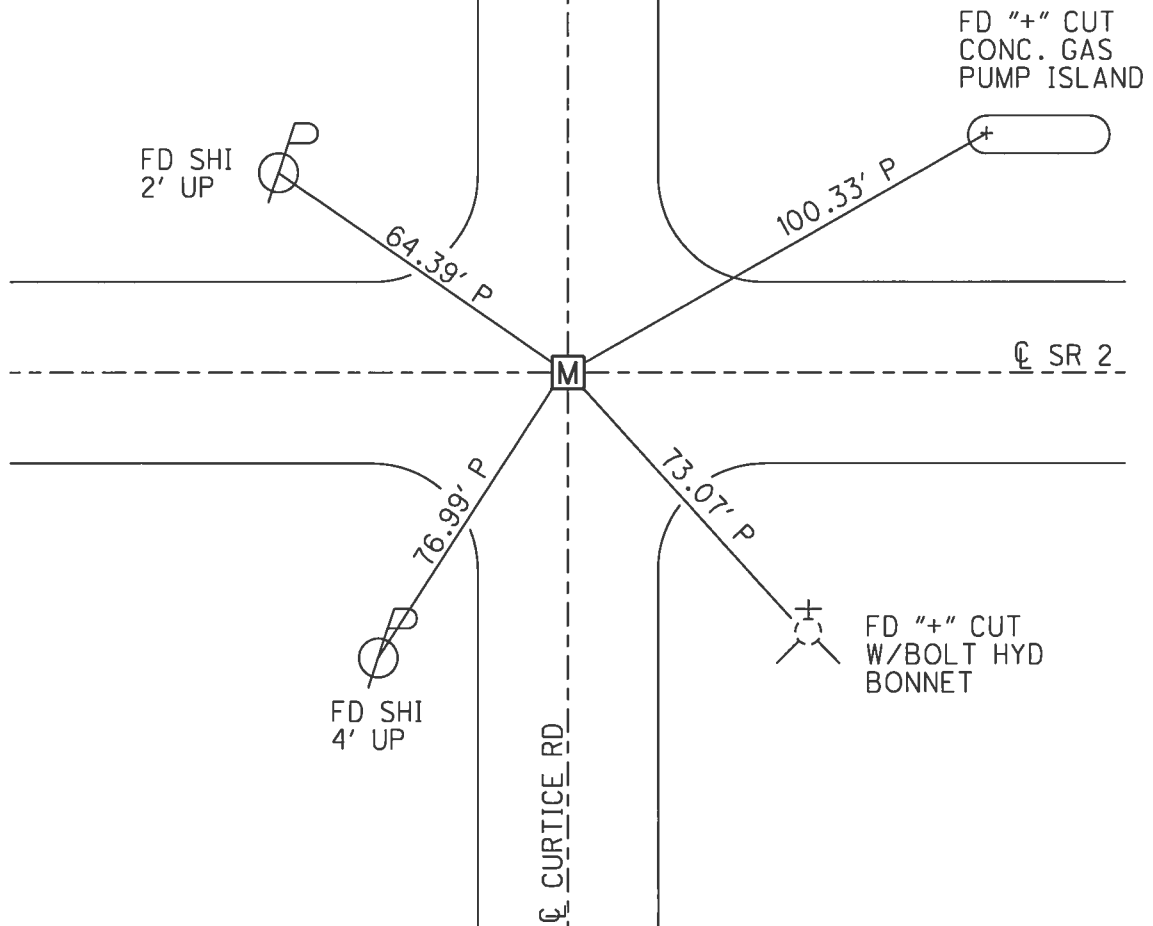


O.D.O.T. DISTRICT 2 SURVEY OFFICE (USE ONLY)

PERSONNEL _____ REFERENCE NO. 45 SHEET 2 OF 20
 NOTES LEU DATE 8/16/2016 ROUTE 2
 H.C. HOMAN WEATHER CLOUDY, WIND COUNTY LUCAS
 R.C. RHOADES TEMP. 74° TOWNSHIP JERUSALEM
 SECTION 4
 T 10 S R 9 E

TYPE MONUMENT P.K./WASHER
 ON SURFACE - ~~BELOW~~ ON _____
 LEFT - CL PAV'T - RIGHT ON _____
12.1 TO LT EDGE PAVEMENT
 S.L.M. 1479+09.51
 GRID: NORTHING: 719487.805 EASTING: 1733176.697

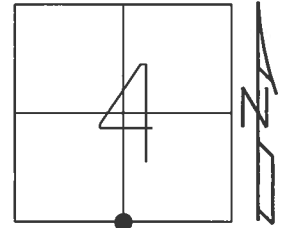


RECORD:
 FD P.K.NAIL
 3/28/96, MB
 SET P.K./WASHER
 7/22/96, MB
 FD P.K./WASHER
 REF45
 3/16/15, EBW
 SET MAG/WASHER
 8/24/17, DCH

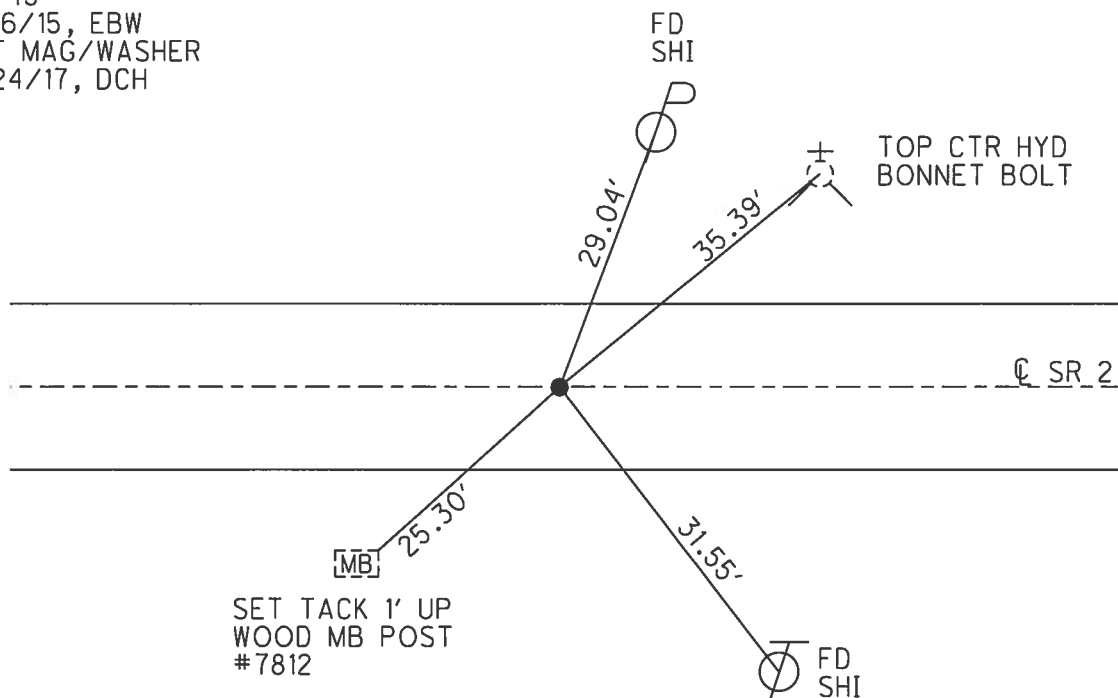


O.D.O.T. DISTRICT 2 SURVEY OFFICE (USE ONLY)

PERSONNEL _____ REFERENCE NO. 46 SHEET 3 OF 20
 NOTES LEU DATE 8/16/16 ROUTE 2
 H.C. HOMAN WEATHER CLOUDY, WIND COUNTY LUCAS
 R.C. RHOADES TEMP. 74° TOWNSHIP JERUSALEM
 SECTION 3
 T 10 S R 9 E

TYPE MONUMENT MAG/WASHER
 ON SURFACE - ~~BELOW~~ ON
 LEFT - ℄ PAV'T - RIGHT ON, 8.1' W OF ℄ S
- TO - EDGE PAVEMENT
 S.L.M. 1505+70.99
 GRID: NORTHING: 719481.347 EASTING: 1735838.171

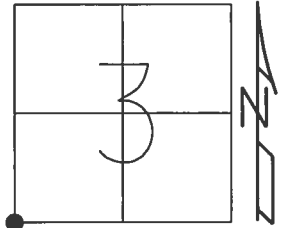


RECORD:
 FD P.K.NAIL
 3/28/96, MB
 SET P.K./WASHER
 7/22/96, MB
 DNF P.K.NAIL
 SET MAG/WASHER
 REF46
 3/16/15, EBW
 SET MAG/WASHER
 8/24/17, DCH

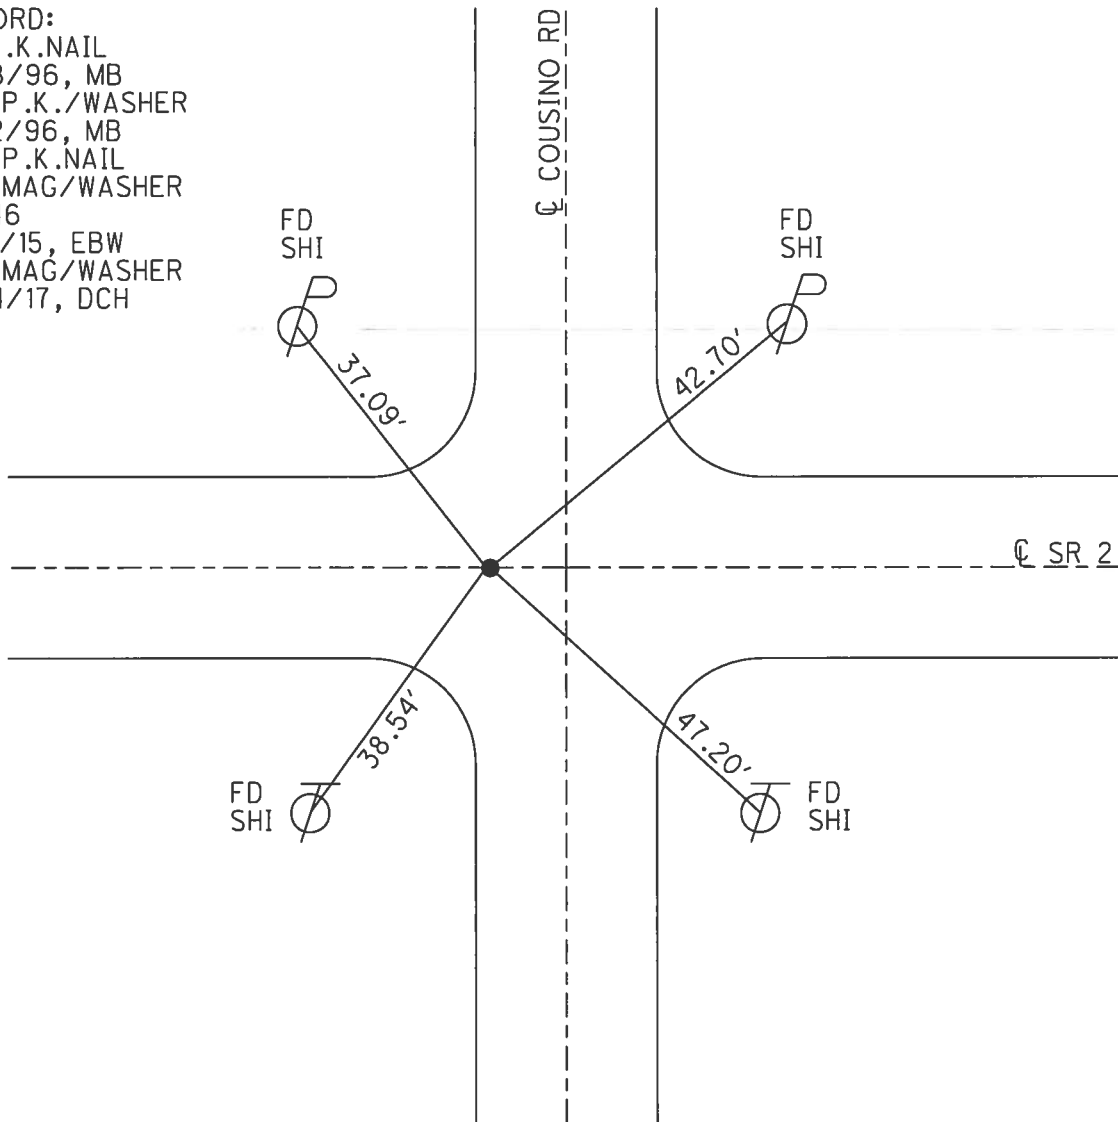


O.D.O.T. DISTRICT 2 SURVEY OFFICE (USE ONLY)

PERSONNEL	REFERENCE NO. <u>47</u>	SHEET <u>4</u> OF <u>20</u>
NOTES	DATE <u>3/16/15</u>	ROUTE <u>2</u>
H.C. <u>WESTFALL</u>	WEATHER <u>CLOUDY</u>	COUNTY <u>LUCAS</u>
R.C. <u>RHOADES</u>	TEMP. <u>57°</u>	TOWNSHIP <u>JERUSALEM</u>
		SECTION <u>3</u>
		T <u>10</u> S R <u>9</u> E

TYPE MONUMENT P.K./WASHER
 ON SURFACE - ~~BELOW~~ ON
 LEFT - CL PAV'T - RIGHT ON
- TO - EDGE PAVEMENT
 S.L.M. 1532+18.75
 GRID: NORTHING: 719483.119 EASTING: 1738485.922

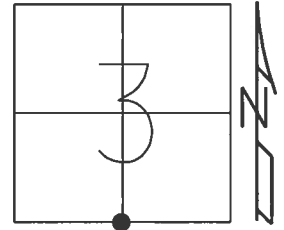

RECORD:
 FD P.K.NAIL
 3/28/96, MB
 SET P.K./WASHER
 7/22/96, MB
 FD P.K.NAIL
 SET MAG/WASHER
 REF47
 8/24/17, DCH
 SET MAG/WASHER
 8/24/17, DCH

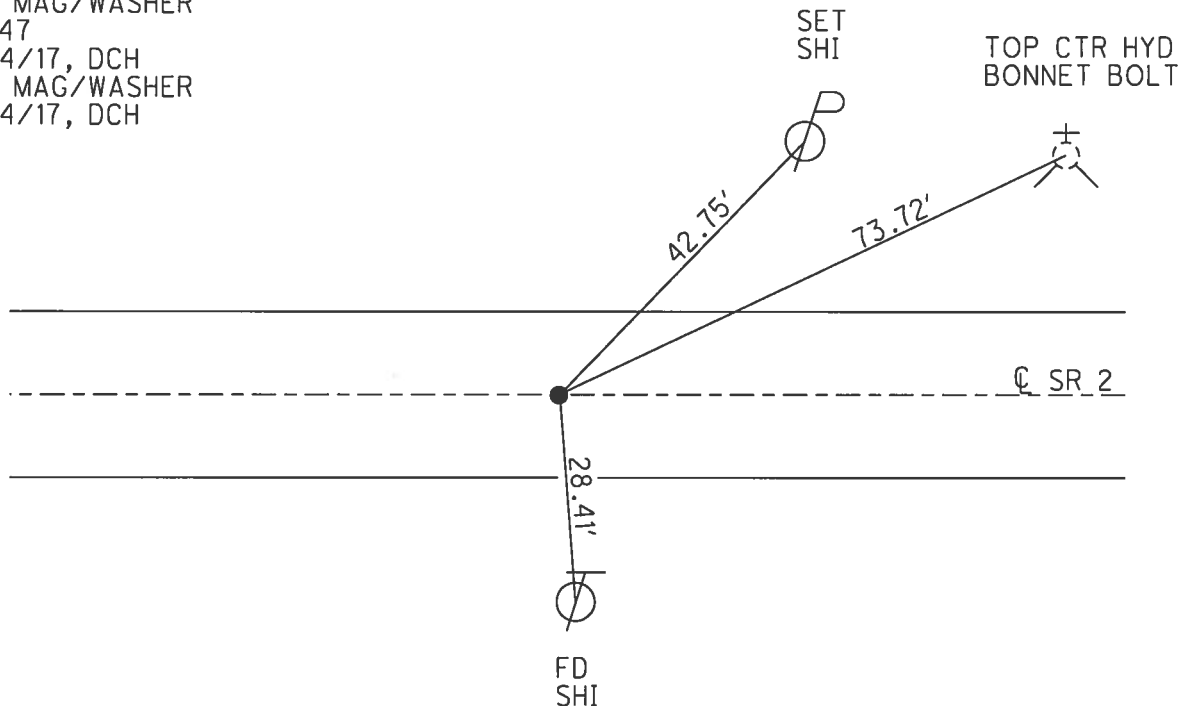


O.D.O.T. DISTRICT 2 SURVEY OFFICE (USE ONLY)


PERSONNEL _____ REFERENCE NO. 48 SHEET 5 OF 20
 NOTES LEU DATE 8/16/16 ROUTE 2
 H.C. HOMAN WEATHER CLOUDY, WIND COUNTY LUCAS
 R.C. RHOADES TEMP. 76° TOWNSHIP JERUSALEM
 _____ SECTION 2
 _____ T 10 S R 9 E

TYPE MONUMENT P.K.NAIL
 ON SURFACE - ~~BELOW~~ ON _____
 LEFT - Q PAV'T - RIGHT ON _____
 _____ TO _____ EDGE PAVEMENT
 S.L.M. 1558+67.24

GRID: NORTHING: 719485.306 EASTING: 1741134.413

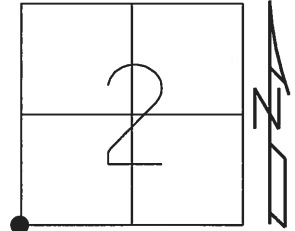


RECORD:
 FD P.K.NAIL
 3/28/96, MB
 SET P.K./WASHER
 7/22/96, MB
 FD P.K.NAIL
 REF48
 3/16/15, EBW
 SET MAG/WASHER
 8/24/17, DCH

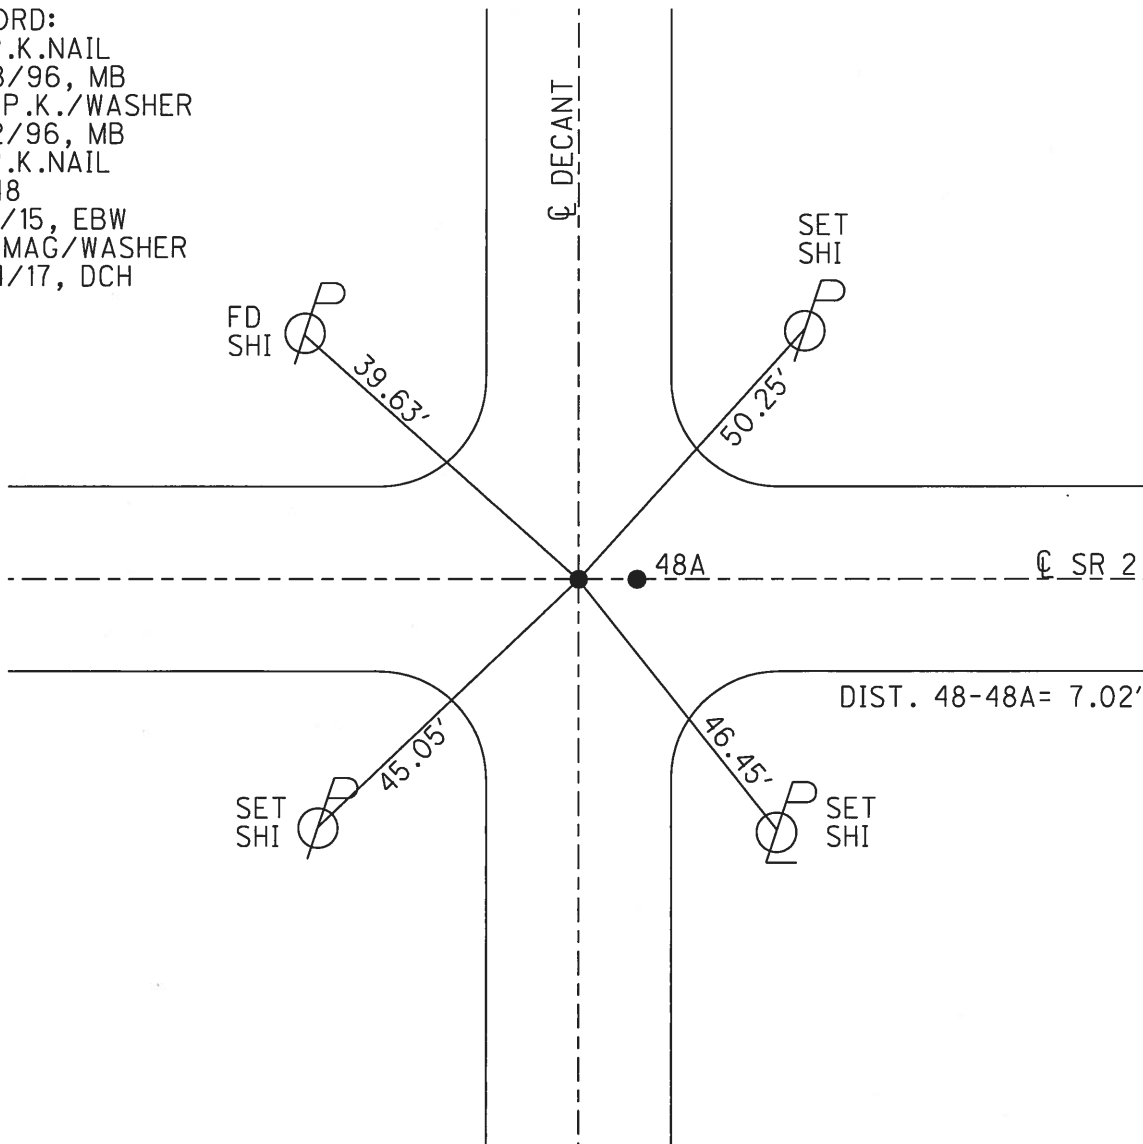


O.D.O.T. DISTRICT 2 SURVEY OFFICE (USE ONLY)

PERSONNEL	REFERENCE NO. <u>48 A</u>	SHEET <u>6</u> OF <u>20</u>
NOTES	DATE <u>3/16/15</u>	ROUTE <u>2</u>
H.C. <u>O'DONNELL</u>	WEATHER <u>CLOUDY</u>	COUNTY <u>LUCAS</u>
R.C. <u>WESTFALL</u>	TEMP. <u>57°</u>	TOWNSHIP <u>JERUSALEM</u>
		SECTION <u>2</u>
		T <u>10</u> S R <u>9</u> E

TYPE MONUMENT MAG NAIL
 ON SURFACE - ~~BELOW~~ ON
 LEFT - CL PAV'T - RIGHT ON
- TO - EDGE PAVEMENT
 S.L.M. 1558+74.25
 GRID: NORTHING: 719485.281 EASTING: 1741141.428

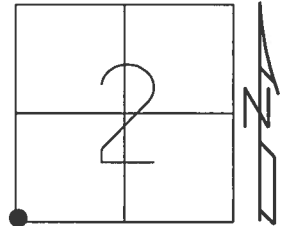

RECORD:
 FD MAG NAIL
 REFA48
 3/16/15, EBW
 DID NOT RESET
 UNKNOWN ORIGIN
 8/24/17, DCH

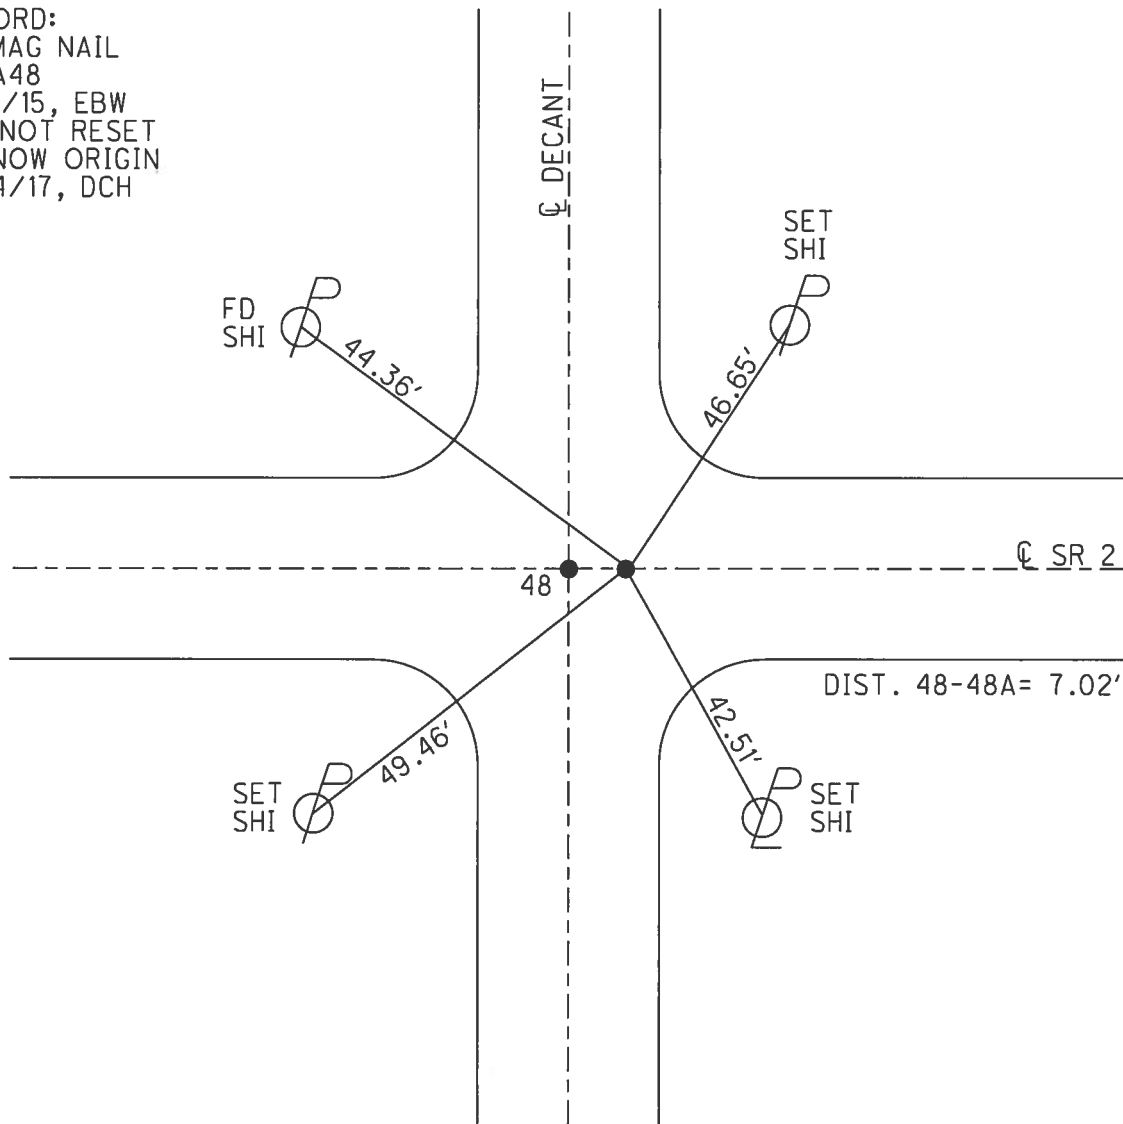

O.D.O.T. DISTRICT 2 SURVEY OFFICE (USE ONLY)

PERSONNEL

REFERENCE NO. 48 B

SHEET 7 OF 20

NOTES LEU

DATE 8/17/16

ROUTE 2

H.C. HOMAN

WEATHER PARTLY CLOUDY

COUNTY LUCAS

R.C. RHOADES

TEMP. 72°

TOWNSHIP JERUSALEM

DATUM NAD83 (2011)

SECTION 2

T 10 S R 9 E

TYPE MONUMENT SM.P.K.NAIL


~~ON SURFACE~~ - BELOW 4"

~~LEFT - C~~ PAV'T - ~~RIGHT~~ ON


12 TO LT EDGE PAVEMENT

S.L.M. 1585+43.15

GRID: NORTHING: 719484.684 EASTING: 1743808.789

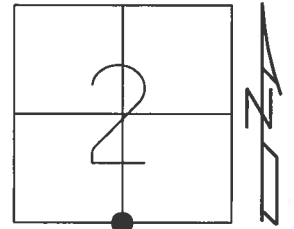

RECORD:
SET P.K./WASHER
7/22/96, MB
FD SM.P.K.NAIL
4" DOWN
REFB48
8/28/15, DCH
SET MAG/WASHER
8/24/17, DCH

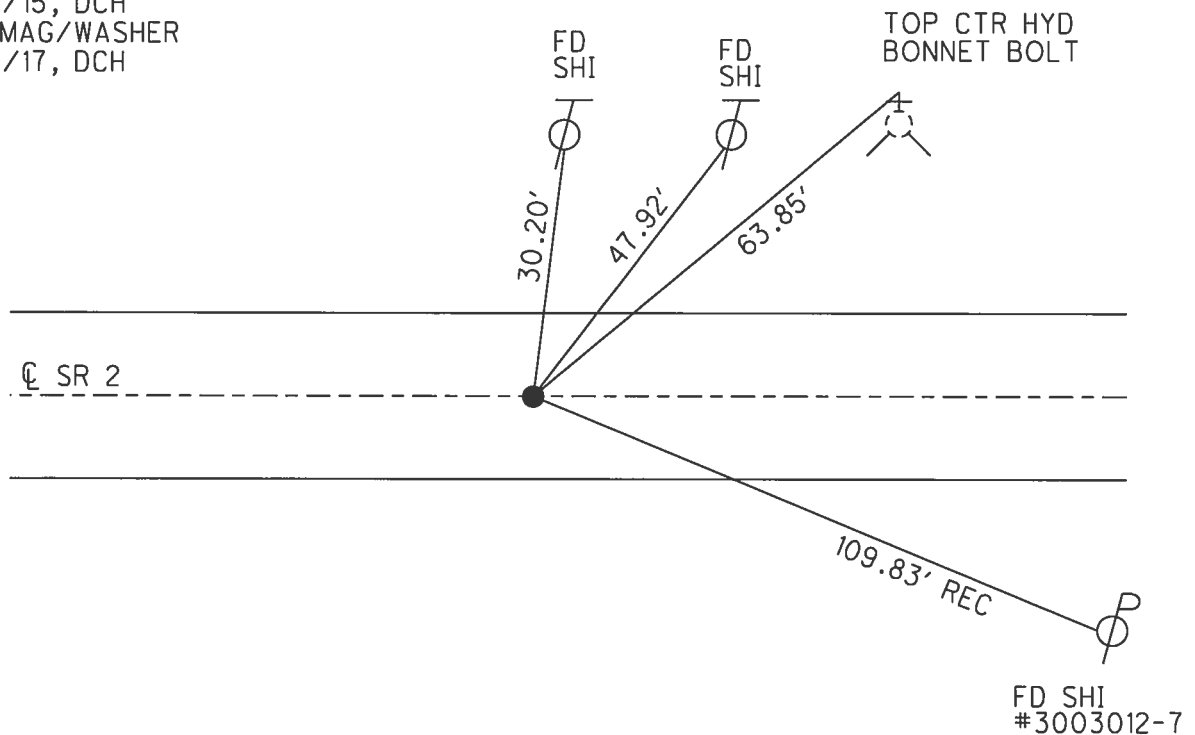

O.D.O.T. DISTRICT 2 SURVEY OFFICE (USE ONLY)

PERSONNEL	REFERENCE NO. <u>49</u>	SHEET <u>8</u> OF <u>20</u>
NOTES	DATE <u>3/28/96</u>	ROUTE <u>2</u>
H.C. <u>BARNHISEL</u>	WEATHER <u>CLOUDY</u>	COUNTY <u>LUCAS</u>
R.C. <u>CORDES</u>	TEMP. <u>35°</u>	TOWNSHIP <u>JERUSALEM</u>
		SECTION <u>1</u>
		T <u>10</u> S R <u>9</u> E

TYPE MONUMENT BRASS MON.


~~ON SURFACE~~ - BELOW 4"

LEFT - ℄ PAV'T - RIGHT ON


- TO - EDGE PAVEMENT

S.L.M. 1612+15.88

GRID: NORTHING: 719484.711 EASTING: 1746483.055

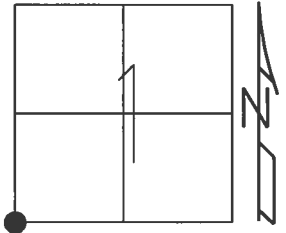

RECORD:
FD BRASS MON.
4" DOWN
3/28/96, MB
FD MONBOX W/"+"
ON BRASS MON. REF 49
3/16/15, JFO

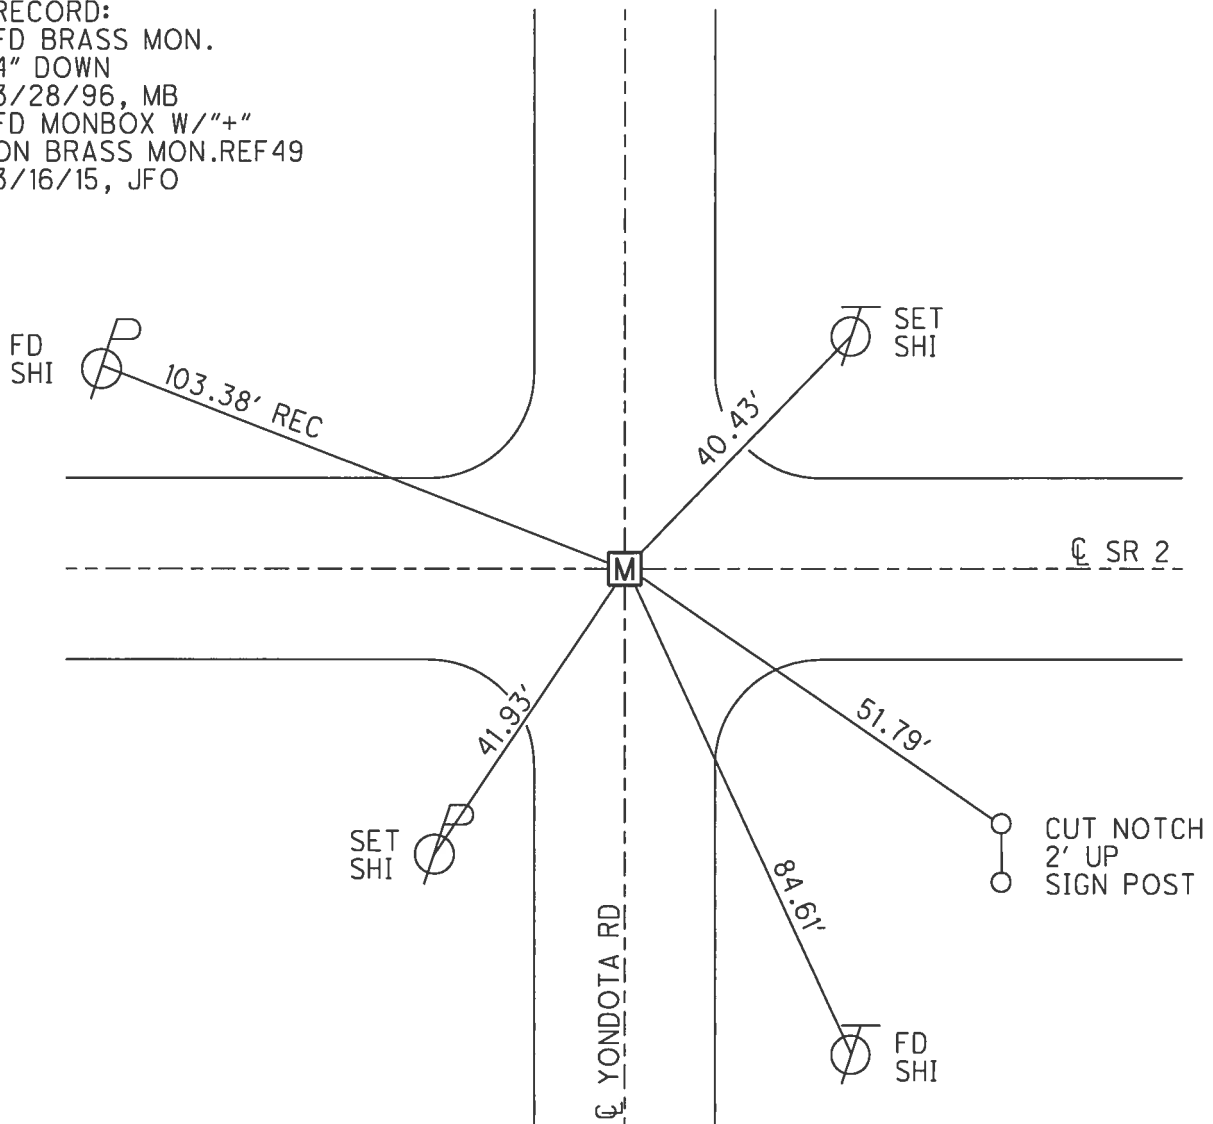

O.D.O.T. DISTRICT 2 SURVEY OFFICE (USE ONLY)

PERSONNEL

REFERENCE NO.

50

SHEET

9

OF 20

NOTES

LEU

DATE

8/17/16

ROUTE

2

H.C.

HOMAN

WEATHER

CLOUDY

COUNTY

LUCAS

R.C.

RHOADES

TEMP.

72°

TOWNSHIP

JERUSALEM

SECTION

1

T 10 S

R 9 E

TYPE MONUMENT

P.K.SHANK

ON SURFACE - ~~BELOW~~

ON

~~LEFT~~ - $\odot$ PAV'T - RIGHT 1.5'

13.6' TO LT EDGE PAVEMENT


S.L.M. 1638+66.68

GRID: NORTHING:

719474.018

EASTING:

17449133.998

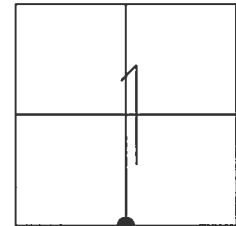

RECORD:

FD P.K.NAIL

3/28/96, MB

SET P.K./WASHER

7/22/96, MB


FD P.K.SHANK

REF50

3/16/15, EBW

SET MAG/WASHER


8/24/17, DCH

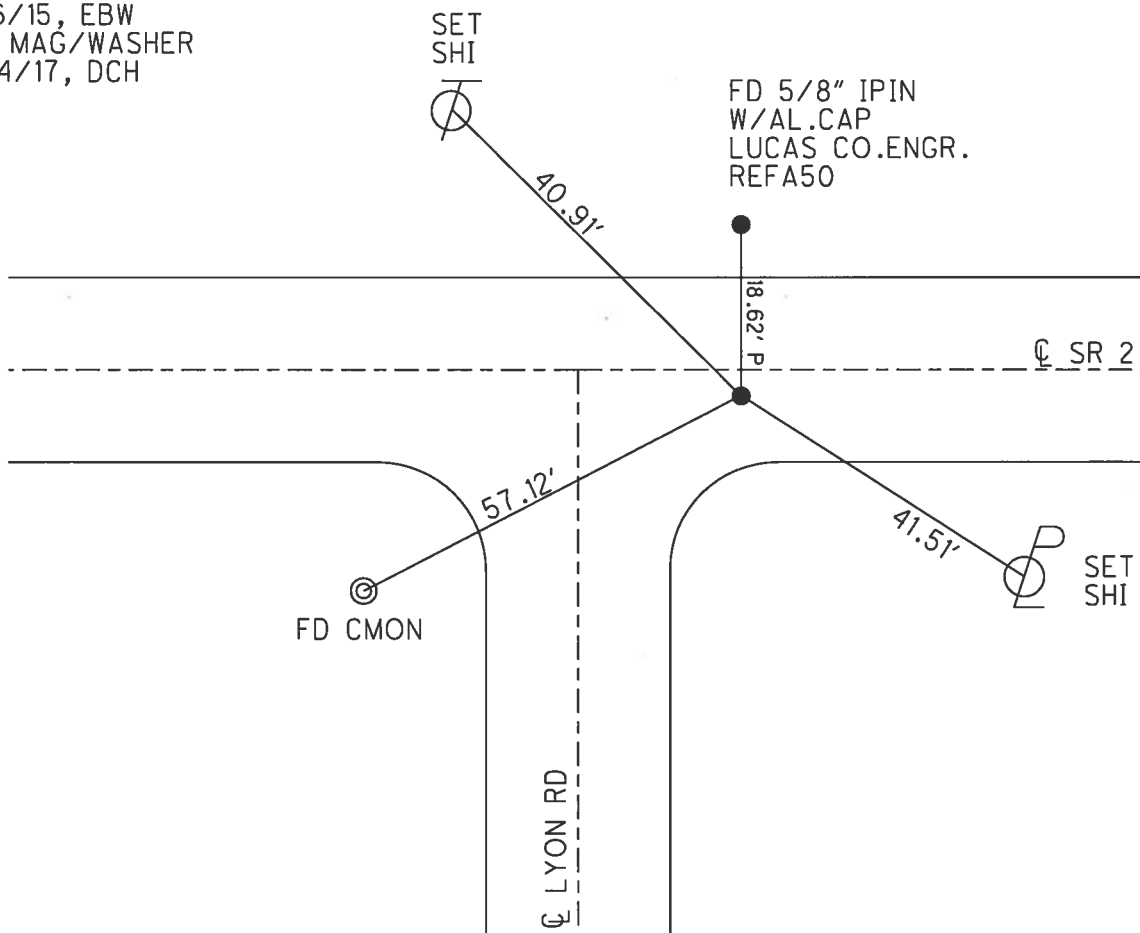


O.D.O.T. DISTRICT 2 SURVEY OFFICE (USE ONLY)

PERSONNEL	REFERENCE NO. <u>51</u>	SHEET <u>10</u> OF <u>20</u>
NOTES	DATE <u>11/22/82</u>	ROUTE <u>2</u>
H.C. <u>CRONIN</u>	WEATHER <u>SUNNY</u>	COUNTY <u>LUCAS</u>
R.C. <u>RIPPLE</u>	TEMP. <u>50°</u>	TOWNSHIP <u>JERUSALEM</u>
<u>GEYMAN</u>		SECTION <u>6</u>
<u>MOSSER</u>		T <u>10</u> S R <u>10</u> E
<u>BARBOUR</u>		

TYPE MONUMENT P.K.NAIL
 ON SURFACE - ~~BELOW~~ ON
 LEFT - ℄ PAV'T - RIGHT -
- TO - EDGE PAVEMENT
 S.L.M. 1665+42.06
 GRID: NORTHING: 719502.126 EASTING: 1751809.087

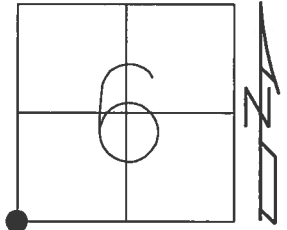


RECORD:
 FD P.K.NAIL
 11/22/82, CRONIN
 FD MONBOX
 REF51
 12/9/14, EBW
 FD MONBOX "X" TOP LID
 NO MONUMENT INSIDE
 STRATS LOCATED @ 4/SIDE
 REF51
 3/17/15, EBW
 SET 3/4" IPIN
 8/17/16, DCH

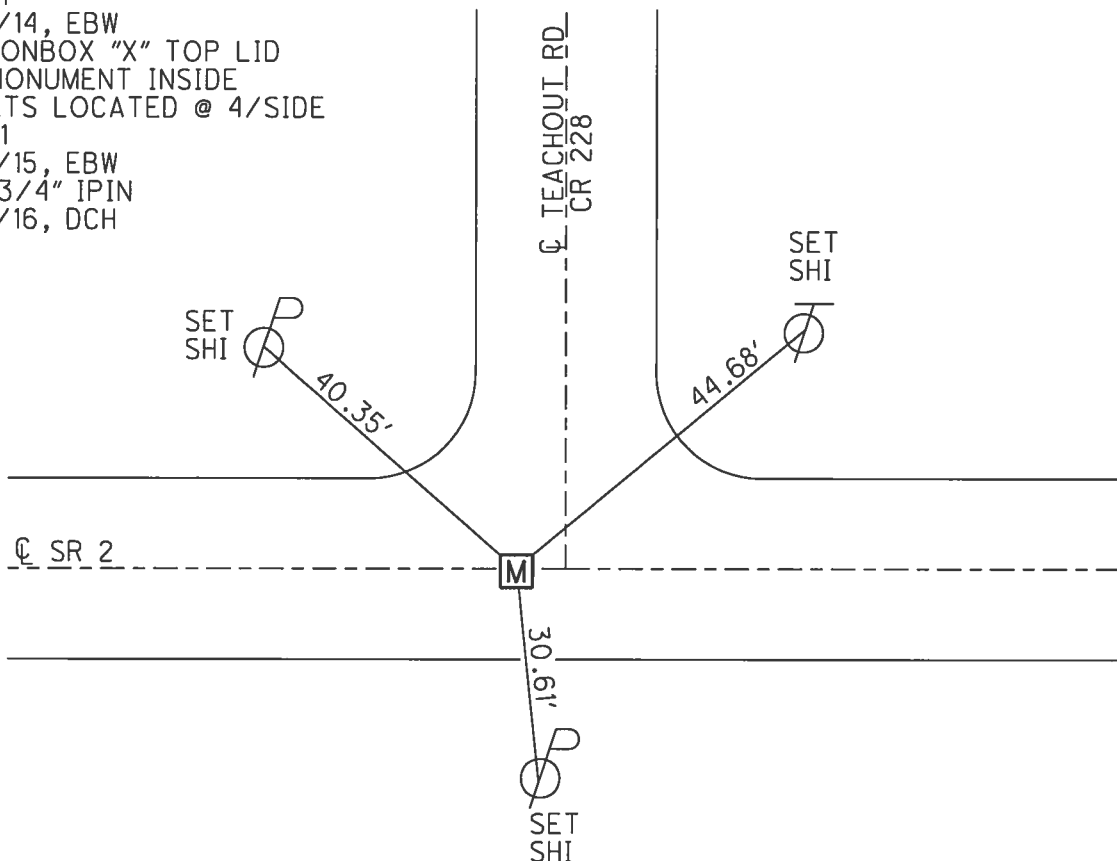


O.D.O.T. DISTRICT 2 SURVEY OFFICE (USE ONLY)

PERSONNEL _____ REFERENCE NO. 52 SHEET 11 OF 20
 NOTES LEU DATE 8/17/16 ROUTE 2
 H.C. HOMAN WEATHER CLOUDY COUNTY LUCAS
 R.C. RHOADES TEMP. 72° TOWNSHIP JERUSALEM
 SECTION 6
 T 10 S R 10 E

TYPE MONUMENT P.K.NAIL
 ON SURFACE - ~~BELOW~~ ON _____
 LEFT - CL PAV'T - ~~RIGHT~~ 1', 23.5' W OF CL N
 - TO - EDGE PAVEMENT
 S.L.M. 1684+67.27
 GRID: NORTHING: 719470.127 EASTING: 1753734.039

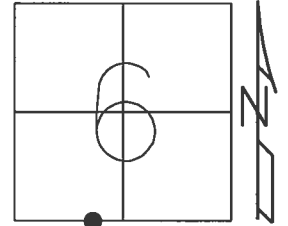


RECORD:
 SET P.K.NAIL ATOP
 P.K.NAIL
 11/22/82, CRONIN
 FD P.K.NAIL
 REF52
 12/9/14, EBW
 SET MAG/WASHER
 8/24/17, DCH

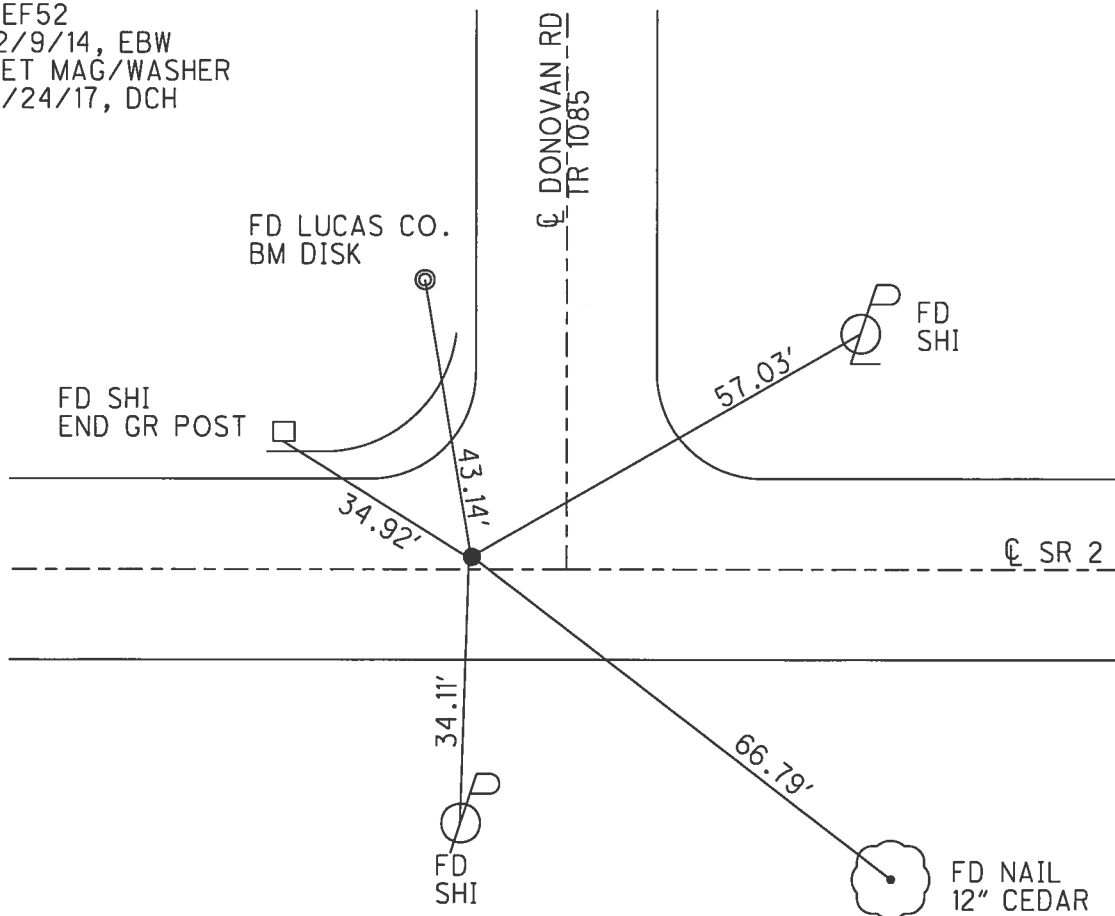


O.D.O.T. DISTRICT 2 SURVEY OFFICE (USE ONLY)

PERSONNEL	REFERENCE NO. <u>53</u>	SHEET <u>12</u> OF <u>20</u>
NOTES	DATE <u>11/22/82</u>	ROUTE <u>2</u>
H.C. <u>CRONIN</u>	WEATHER <u>SUNNY</u>	COUNTY <u>LUCAS</u>
R.C. <u>GEYMAN</u>	TEMP. <u>50°</u>	TOWNSHIP <u>JERUSALEM</u>
<u>MOSSER</u>		SECTION <u>8</u>
<u>BARBOUR</u>		T <u>10</u> S R <u>10</u> E

TYPE MONUMENT P.K.NAIL
 ON SURFACE - ~~BELOW~~ ON
 LEFT - Q PAV'T - RIGHT ON
- TO - EDGE PAVEMENT
 S.L.M. 1718+88.09
 GRID: NORTHING: 719383.328 EASTING: 1757153.731

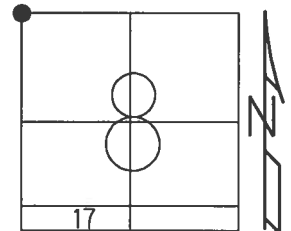

RECORD:
 SET P.K.NAIL ATOP
 P.K.NAIL
 11/22/82, CRONIN
 FD MONBOX
 W/ 2" IPIN IN BRICK
 REF53
 3/6/15, JFO

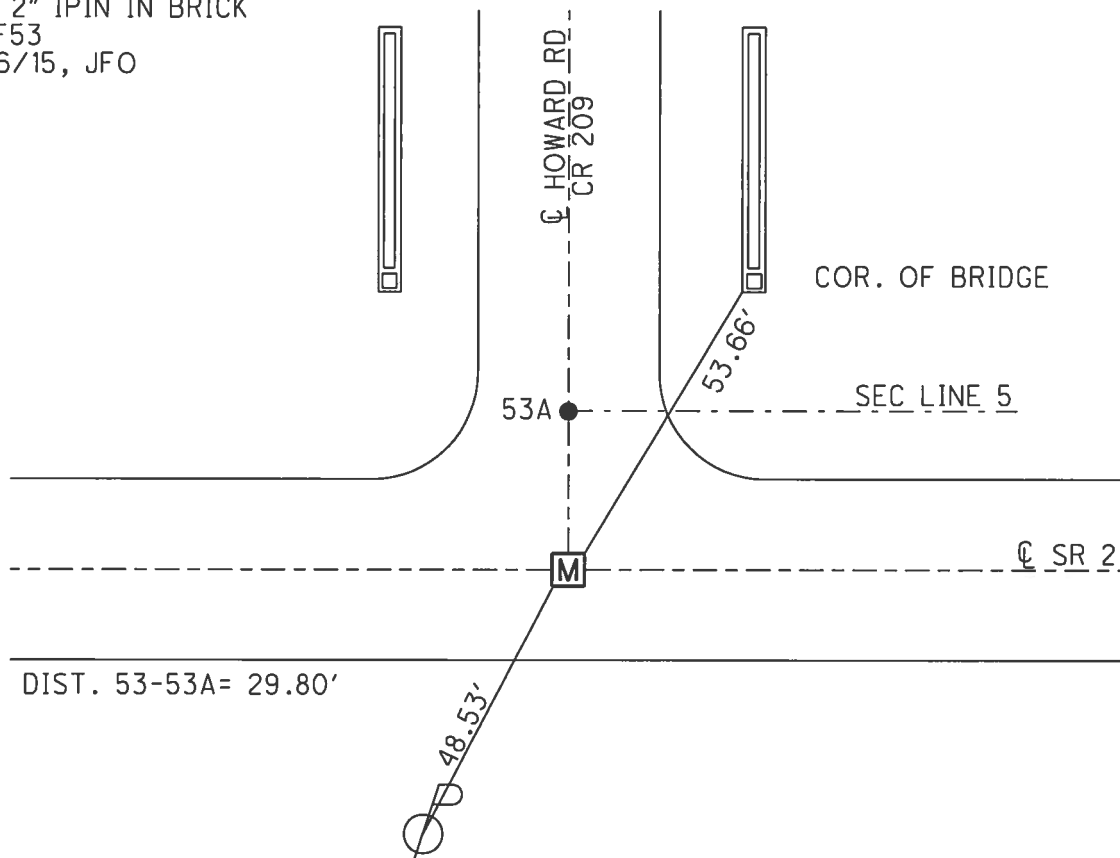

O.D.O.T. DISTRICT 2 SURVEY OFFICE (USE ONLY)

PERSONNEL

REFERENCE NO. 53 A

SHEET 13 OF 20

NOTES

CRONIN

DATE

11/22/82

ROUTE

2

H.C.

RIPPLE

WEATHER

SUNNY

COUNTY

LUCAS

R.C.

GEYMAN

TEMP.

50°

TOWNSHIP

JERUSALEM

MOSSER

SECTION

8

BARBOOUR

T 10 S R 10 E

TYPE MONUMENT ADJ. BRASS MON.


ON SURFACE - ~~BELOW~~ ON

LEFT - Q PAV'T - ~~RIGHT~~ 29.80'

- TO - EDGE PAVEMENT

S.L.M. 1718+88.09

GRID: NORTHING: 719413.271 EASTING: 1757153.531

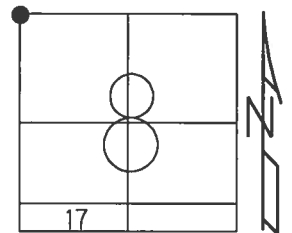

RECORD:

FD ADJ. BRASS MON.


ON SURFACE

11/22/82, CRONIN

FD MAG NAIL

REFA53


3/6/15, JFO

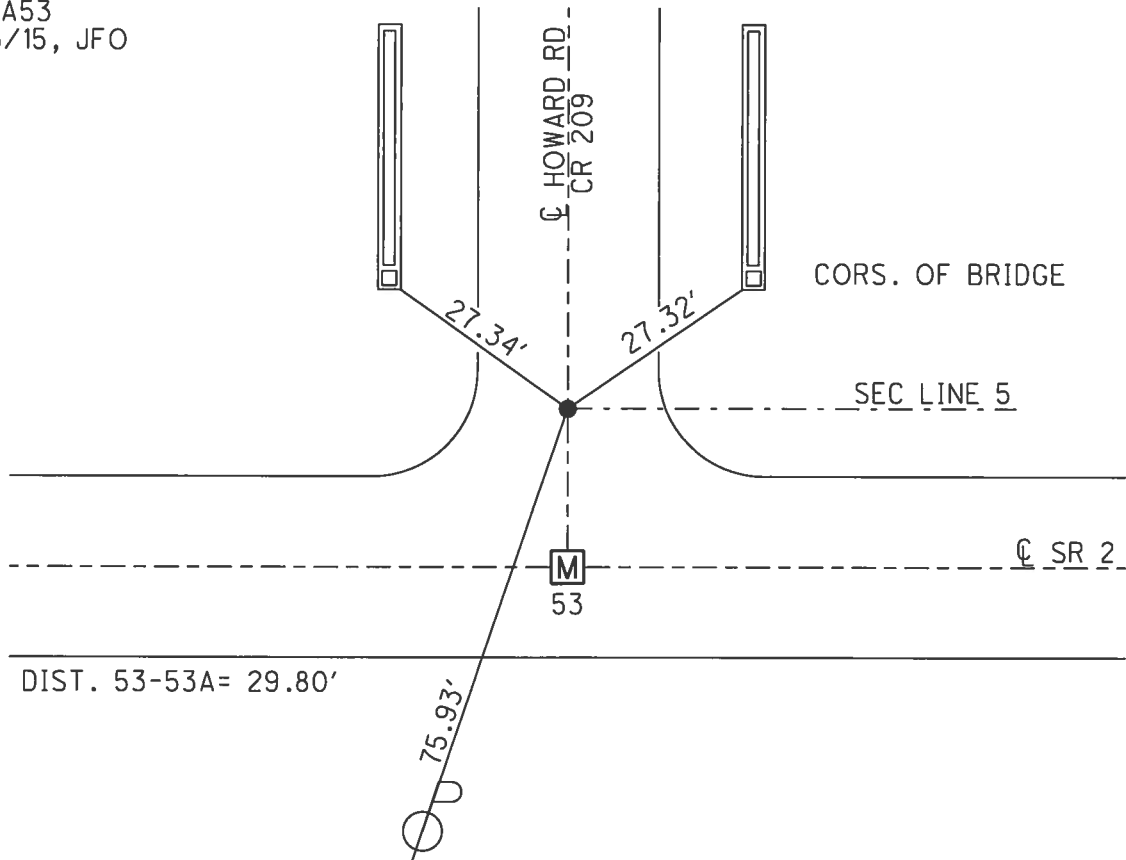


O.D.O.T. DISTRICT 2 SURVEY OFFICE (USE ONLY)

PERSONNEL _____ REFERENCE NO. 54 SHEET 14 OF 20
 NOTES WESTFALL DATE 3/17/15 ROUTE 2
 H.C. WESTFALL WEATHER FAIR COUNTY LUCAS
 R.C. LEU TEMP. 47° TOWNSHIP JERUSALEM
 _____ SECTION 8
 _____ T 10 S R 10 E

TYPE MONUMENT MONBOX W/1" IPIN
 ON SURFACE - ~~BELOW~~ ON
 LEFT - ℄ PAV'T - RIGHT ON
- TO - EDGE PAVEMENT
 S.L.M. 1732+17.74
 GRID: NORTHING: 719389.145 EASTING: 1758483.367

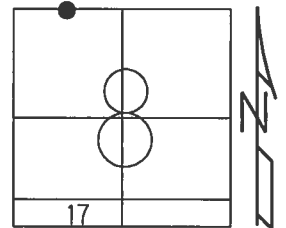

RECORD:
 FD MONBOX W/1" IPIN
 REF54
 3/17/15, EBW

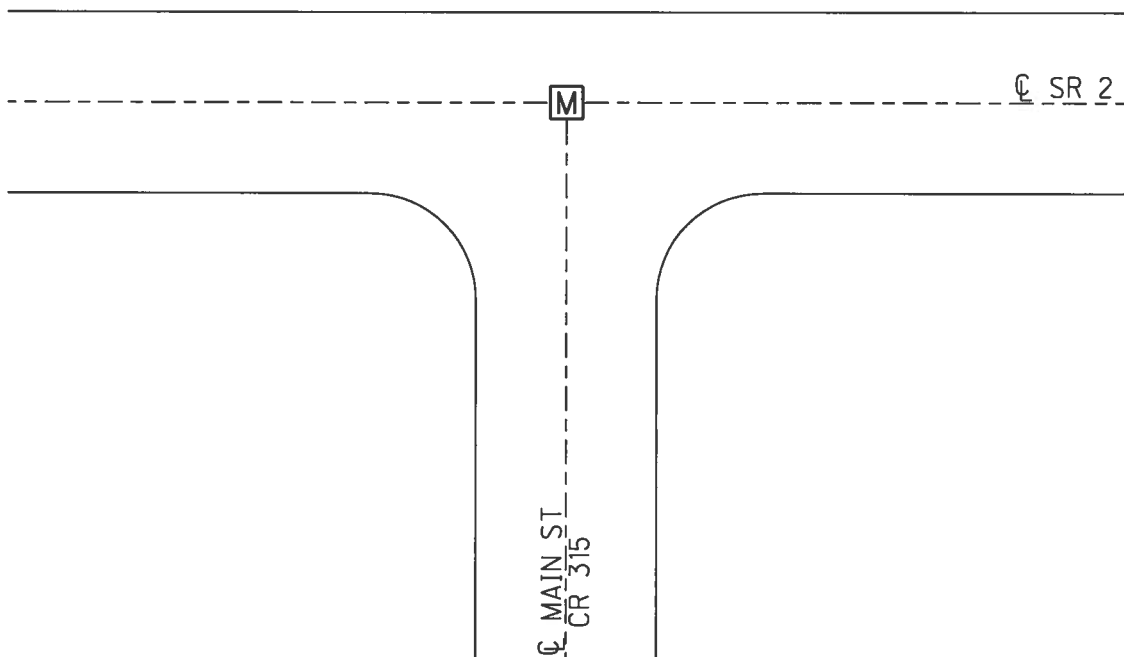

O.D.O.T. DISTRICT 2 SURVEY OFFICE (USE ONLY)

PERSONNEL

REFERENCE NO.

54 A

SHEET

15

OF 20

NOTES

WESTFALL

DATE

3/17/15

ROUTE

2

H.C.

WESTFALL

WEATHER

FAIR

COUNTY

LUCAS

R.C.

LEU

TEMP.

47°

TOWNSHIP

JERUSALEM

SECTION

8

T 10 S

R 10 E

TYPE MONUMENT

MONBOX W/ 1" IPIN


ON SURFACE - ~~BELOW~~ ON

LEFT - ℄ PAV'T - RIGHT ON

- TO - EDGE PAVEMENT

S.L.M. 1740+29.43

GRID: NORTHING: 719392.625 EASTING: 1759295.053

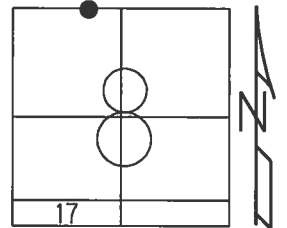


RECORD: P.C.

FD MONBOX W/1" IPIN

REFA54

3/17/15, EBW

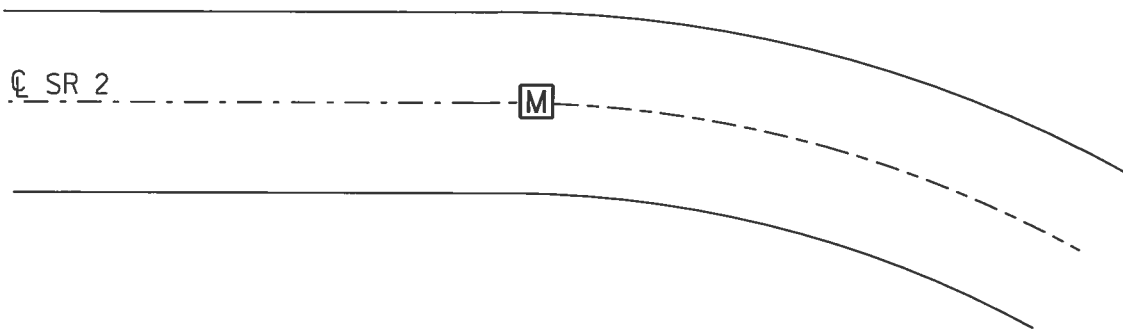

O.D.O.T. DISTRICT 2 SURVEY OFFICE (USE ONLY)

PERSONNEL

REFERENCE NO.

54 B

SHEET

16

OF 20

NOTES WESTFALL

DATE 3/17/15

ROUTE 2

H.C. WESTFALL

WEATHER FAIR

COUNTY LUCAS

R.C. LEU

TEMP. 47°

TOWNSHIP JERUSALEM

SECTION 8

T 10 S R 10 E

TYPE MONUMENT MONBOX W/ 1" IPIN


ON SURFACE - ~~BELOW~~ ON

LEFT - C PAV'T - RIGHT ON


- TO - EDGE PAVEMENT

S.L.M. 1742+96.15

GRID: NORTHING: 719375.179 EASTING: 1759560.977

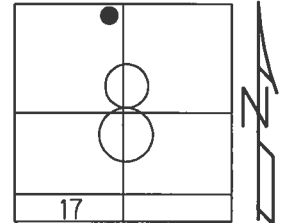

RECORD: P.C.C.
FD MONBOX W/1" IPIN
REFB54
3/17/15, EBW

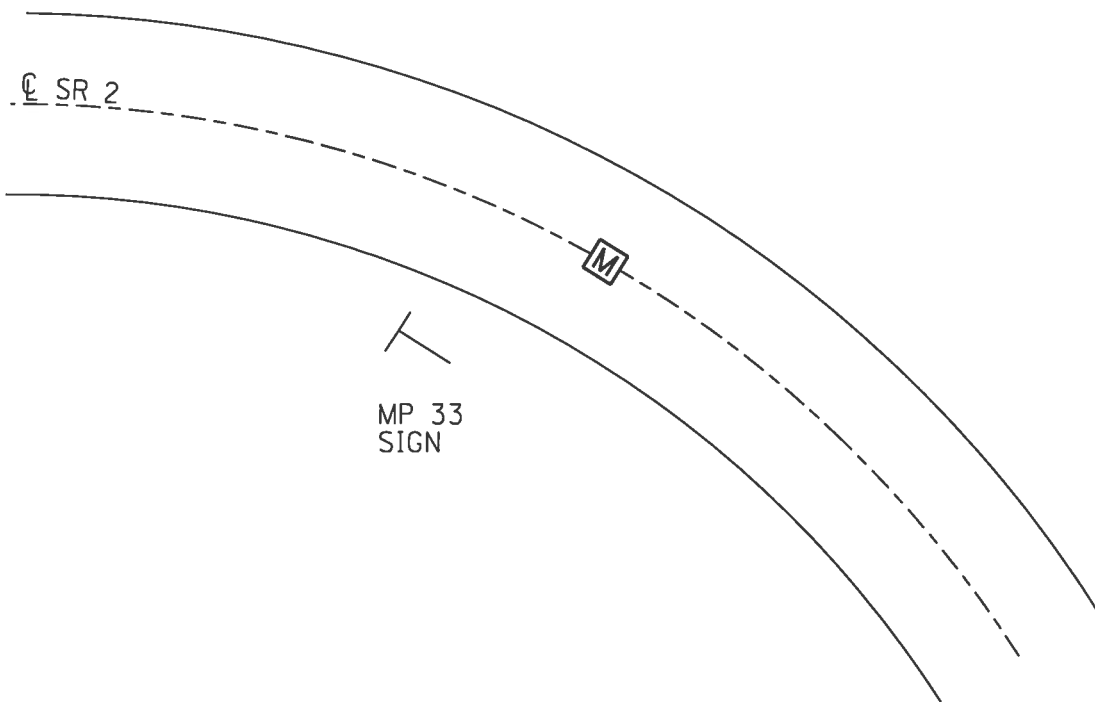

O.D.O.T. DISTRICT 2 SURVEY OFFICE (USE ONLY)

PERSONNEL

REFERENCE NO.

54 C

SHEET

17

OF 20

NOTES

WESTFALL

DATE

3/17/15

ROUTE

2

H.C.

WESTFALL

WEATHER

FAIR

COUNTY

LUCAS

R.C.

LEU

TEMP.

47°

TOWNSHIP

JERUSALEM

SECTION

8

T 10 S

R 10 E

TYPE MONUMENT

MONBOX W/ 1" IPIN

ON SURFACE - ~~BELOW~~

ON

LEFT - C PAV'T - RIGHT ON

-

TO

EDGE PAVEMENT

S.L.M.


1761+68.85

GRID: NORTHING:


718138.773

EASTING:

1760788.333

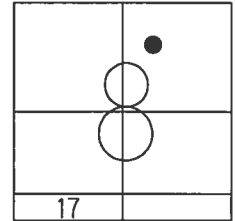


RECORD: P.C.C.
FD MONBOX W/1" IPIN
REFC54
3/17/15, EBW

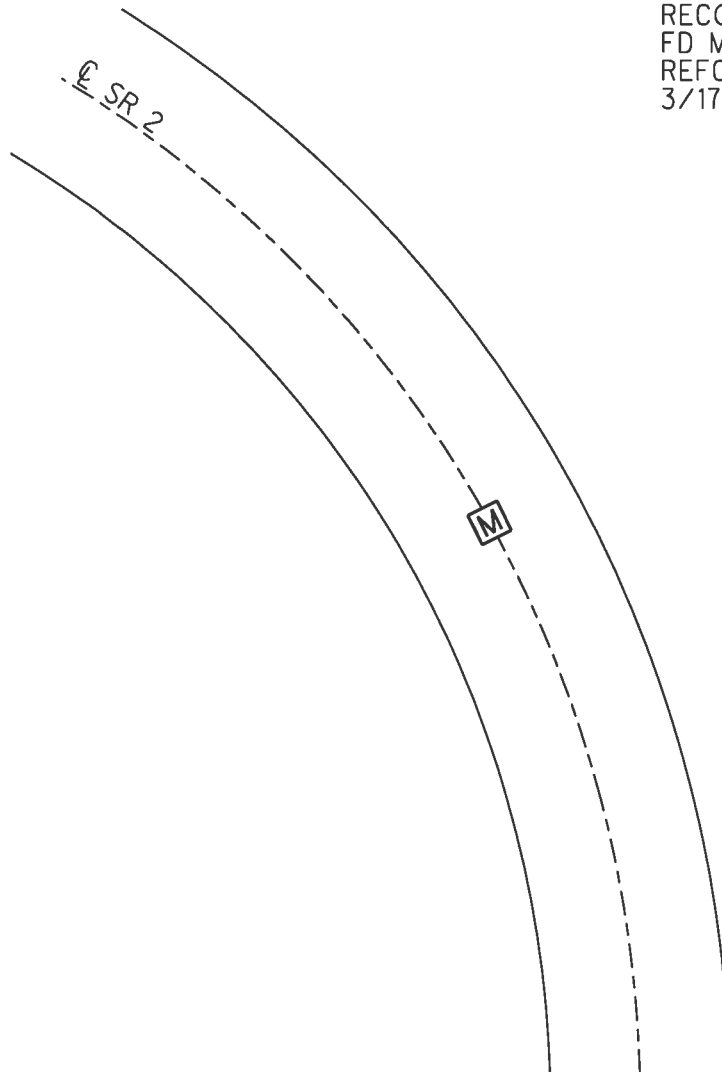


O.D.O.T. DISTRICT 2 SURVEY OFFICE (USE ONLY)

PERSONNEL _____ REFERENCE NO. 54 D SHEET 18 OF 20
 NOTES WESTFALL DATE 3/17/15 ROUTE 2
 H.C. WESTFALL WEATHER FAIR COUNTY LUCAS
 R.C. LEU TEMP. 47° TOWNSHIP JERUSALEM
 _____ SECTION 8
 _____ T 10 S R 10 E

TYPE MONUMENT MONBOX W/ 1" IPIN
 ON SURFACE - ~~BELOW~~ ON
 LEFT - Q PAV'T - RIGHT ON
 - TO - EDGE PAVEMENT
 S.L.M. 1764+35.55
 GRID: NORTHING: 717872.748 EASTING: 1760803.915

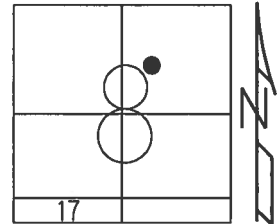



RECORD: P.T.
 FD MONBOX W/1" IPIN
 REFD54
 3/17/15, EBW

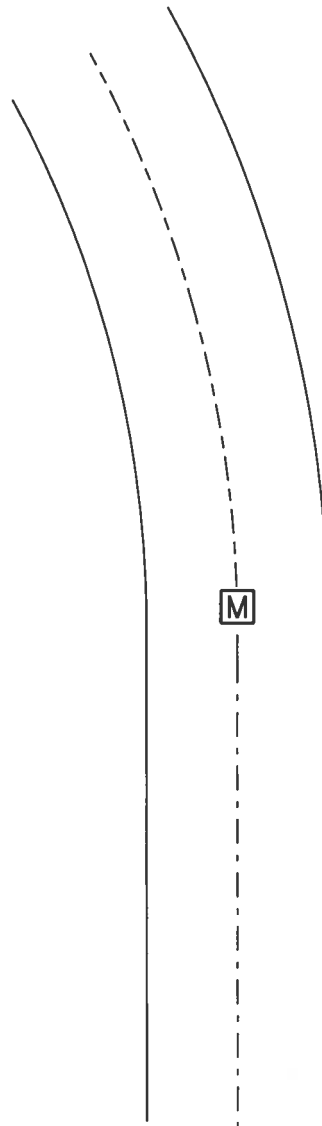

O.D.O.T. DISTRICT 2 SURVEY OFFICE (USE ONLY)

PERSONNEL _____ REFERENCE NO. 55 SHEET 19 OF 20
 NOTES FINGER _____ DATE 6/21/11 ROUTE 2
 H.C. ROUSOS _____ WEATHER SUNNY COUNTY LUCAS
 R.C. FINGER _____ TEMP. 80° TOWNSHIP JERUSALEM
 _____ SECTION 8
 T 10 S R 10 E

TYPE MONUMENT MONBOX W/ 1" IPIN
 ON SURFACE - ~~BELOW~~ ON
 LEFT - ℄ PAV'T - RIGHT ON, 9' S OF ℄ W
- TO - EDGE PAVEMENT
 S.L.M. 1775+42.43
 GRID: NORTHING: 716765.943 EASTING: 1760791.027

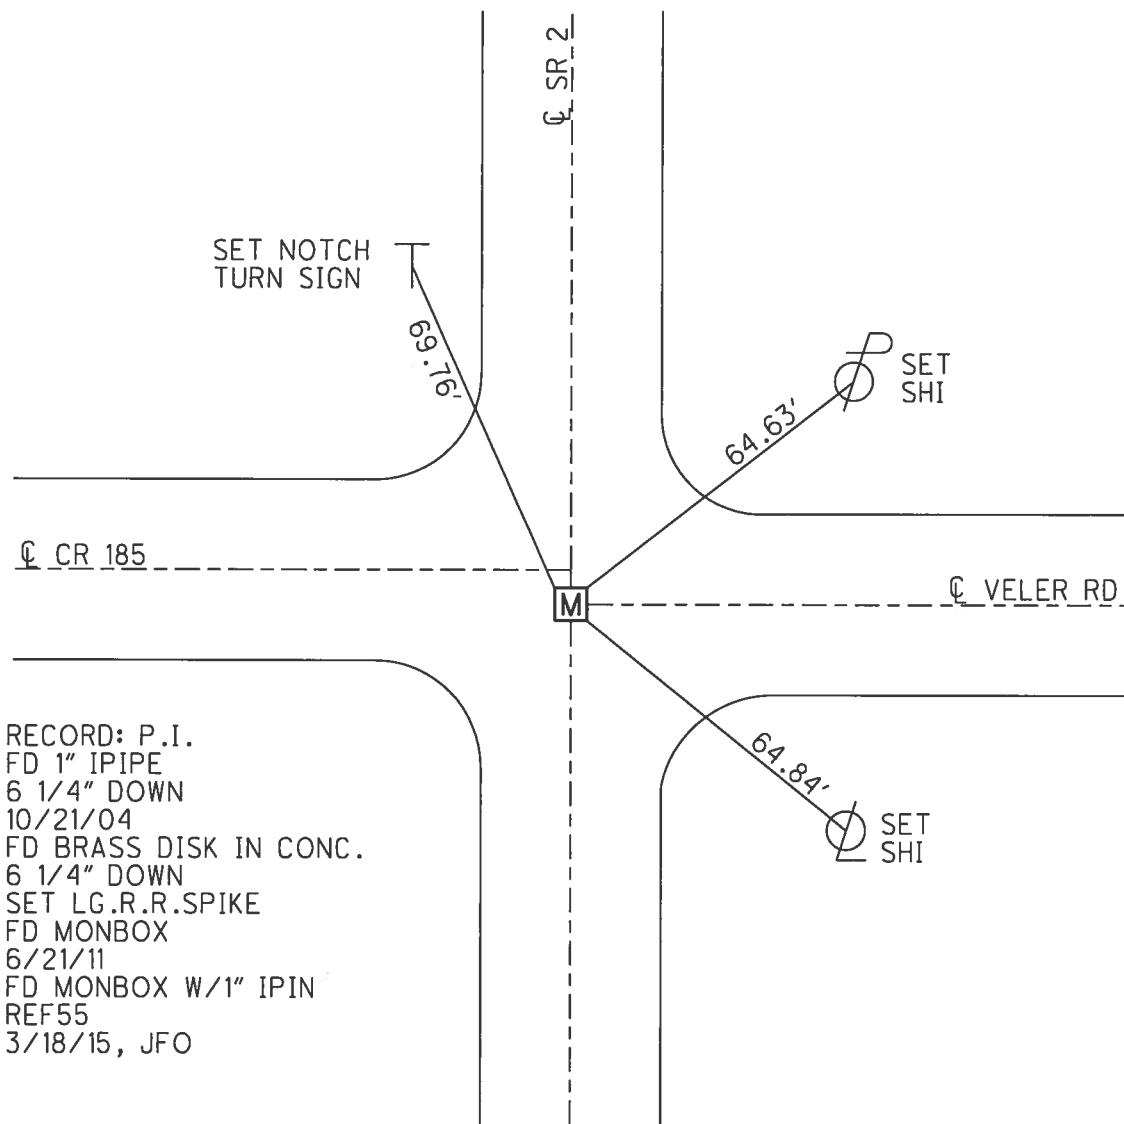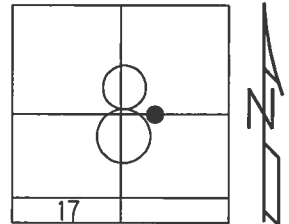


RECORD: P.I.
 FD 1" IPIPE
 6 1/4" DOWN
 10/21/04
 FD BRASS DISK IN CONC.
 6 1/4" DOWN
 SET LG.R.R.SPIKE
 FD MONBOX
 6/21/11
 FD MONBOX W/1" IPIN
 REF55
 3/18/15, JFO

O.D.O.T. DISTRICT 2 SURVEY OFFICE (USE ONLY)

PERSONNEL	REFERENCE NO. <u>56</u>	SHEET <u>20</u> OF <u>20</u>	
NOTES	DATE <u>6/24/15</u>	ROUTE <u>SR 2</u>	
H.C. <u>RHOADES</u>	WEATHER <u>FAIR</u>	COUNTY <u>LUCAS</u>	
R.C. <u>RHOADES</u>	TEMP. <u>70°</u>	TOWNSHIP <u>JERUSALEM</u>	
		SECTION <u>17</u>	
		T <u>10</u> N R <u>10</u> E	


TYPE MONUMENT MONBOX
 ON SURFACE - ~~BELOW~~ ON
 LEFT - ℄ PAV'T - RIGHT ON
- TO - EDGE PAVEMENT
 S.L.M. 1806+79.83

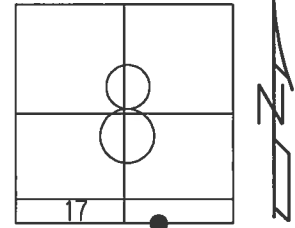

GRID: NORTHING: 713628.751 EASTING: 1760754.762

RECORD:
 SET P.K./WASHER
 ATOP ADJ.BRASS MON.
 1/4/83, CRONIN
 FD. BRASS DISC
 IN CONC. 7" DOWN
 PLACED LG.R.R.SPIKE
 ON SURFACE
 10/21/04, MB
 FD MAG/WASHER
 GPS, REF1
 11/22/11, SAH
 FD P.K.NAIL
 4/17/13, SDC
 FD MONBOX
 W/ 1" IPIN
 REF56
 3/18/15, EBW
 FD MONBOX
 W/ 1" IPIN
 GPS, NEWREF1
 6/24/15, JFO

NOTE: REF 1 OTT CO.

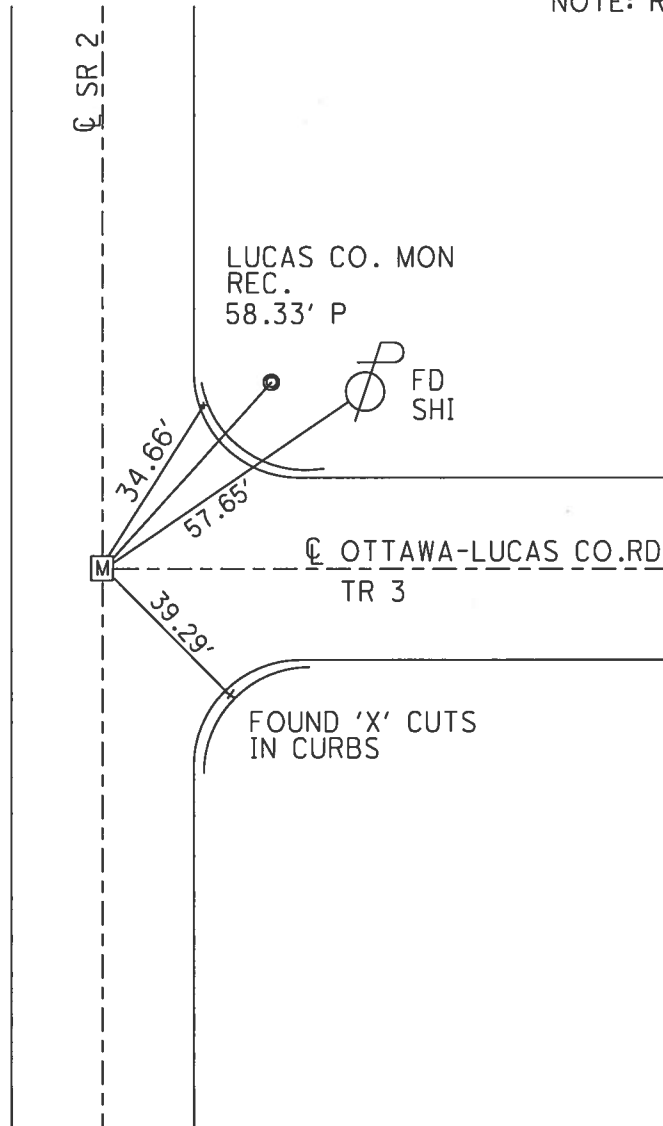

State of Ohio, Department of Transportation

CENTERLINE SURVEY PLAT


State of Ohio, Department of Transportation

LUC-2-27.25

LIVING IN SECTIONS 1,2,3,4,5,8,9,10,11,12 TOWN 10 SOUTH, RANGE 9 EAST AND SECTIONS 5,6,7,8,17 TOWN 10 SOUTH, RANGE 10 EAST, JERUSALEM TOWNSHIP LUCAS COUNTY, OHIO AND SECTIONS 28 AND 29, TOWN 8 NORTH, RANGE 14 EAST, BENTON TOWNSHIP, OTTAWA COUNTY, OHIO

SHEET 1 OF 5

CALC	LUCAS COUNTY LUC-2-27.25	OHIO
BY DATE		
CHKD		
BY DATE		
		FWMA REGION 5

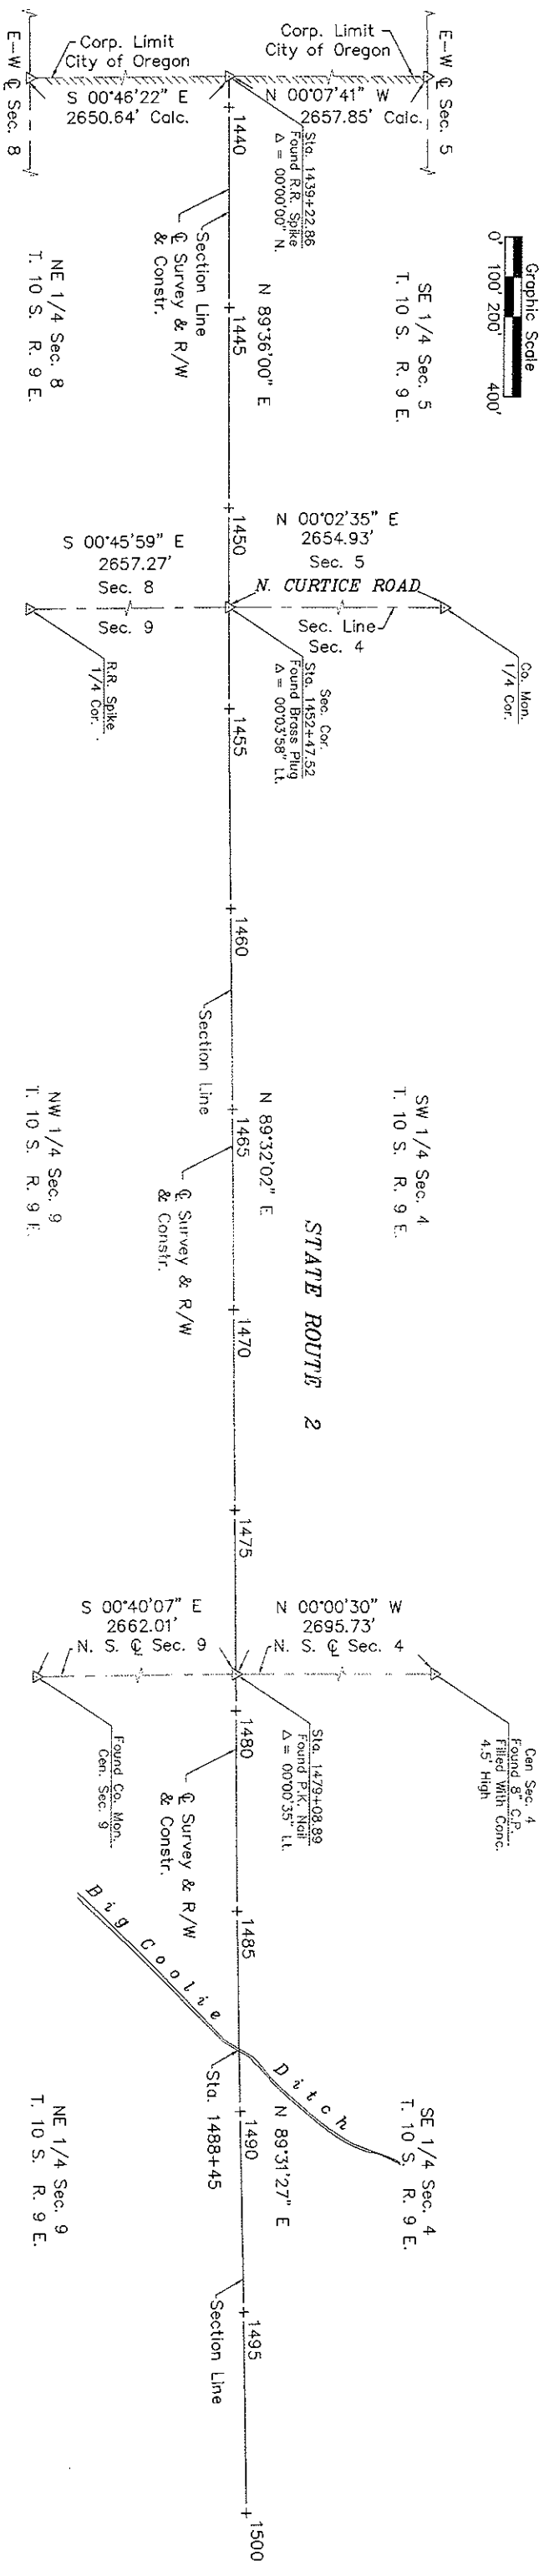

SE 1/4 Sec. 4
T. 10 S. R. 9 E.

N 89°31'27" E
1500

Section Line
Sec. 9
N 00°32'39" W
2666.71'
Sec. 9

Section Line
Sec. 10
Found Con. Mon.
1/4 Cor.

Found L. Pipe
1/4 Cor.

Sec. 3
Cousino Road

Sec. Cor.
Sta. 1505+70.34
Found P.K. Nail
Δ = 00°10'18" Lt.

SW 1/4 Sec. 3
T. 10 S. R. 9 E.

N 89°21'09" E
1510
1515
1520
1525

Section Line
Sec. 10
N 01°01'32" E
2666.49'
Sec. 10

Found L. 1 1/2" L. Pipe
Con. Sec. 10

Found L. Pipe
Con. Sec. 3

N 00°22'04" W
2657.46'
Sec. 3

Sta. 1532+18.31
Found P.K. Nail
Δ = 00°00'37" Lt.

Section Line
Sec. 10
N 01°23'33" E
2669.12'
Sec. 10

Found L. Bolt
1/4 Cor.

Found L. Pipe
w/ Drill Hole
1/4 Cor.

Sec. Cor.
Sta. 1558+66.84
Found P.K. Nail
Δ = 00°03'42" Rt.

NE 1/4 Sec. 10
T. 10 S. R. 9 E.

N 89°20'32" E
1540
1545
1550
1555

Section Line
Sec. 11
Decant Rd.

Sec. 2

N 00°44'48" W
2657.63'
Sec. 2

SE 1/4 Sec. 3
T. 10 S. R. 9 E.

NE 1/4 Sec. 3
T. 10 S. R. 9 E.

STATE ROUTE 2

This plat prepared by Mannrik-Smith
for the 4-lane upgrade of SR 2.
Project Cancelled - Not Built
For survey notes, see file: LUC - 172

Received: _____ At: _____
Recorded: _____
Plat Book: _____ Page: _____
Signed: _____ Fee: _____



I hereby certify that this plot is a true delineation of a centerline survey made for the Ohio Department Of Transportation in 1992.

Date _____

Professional Surveyor No. _____

Revision	Date	Description	
CENTERLINE SURVEY PLAT			
Drawn	Checked	Date	Type Funds

OTTAWA COUNTY, OHIO

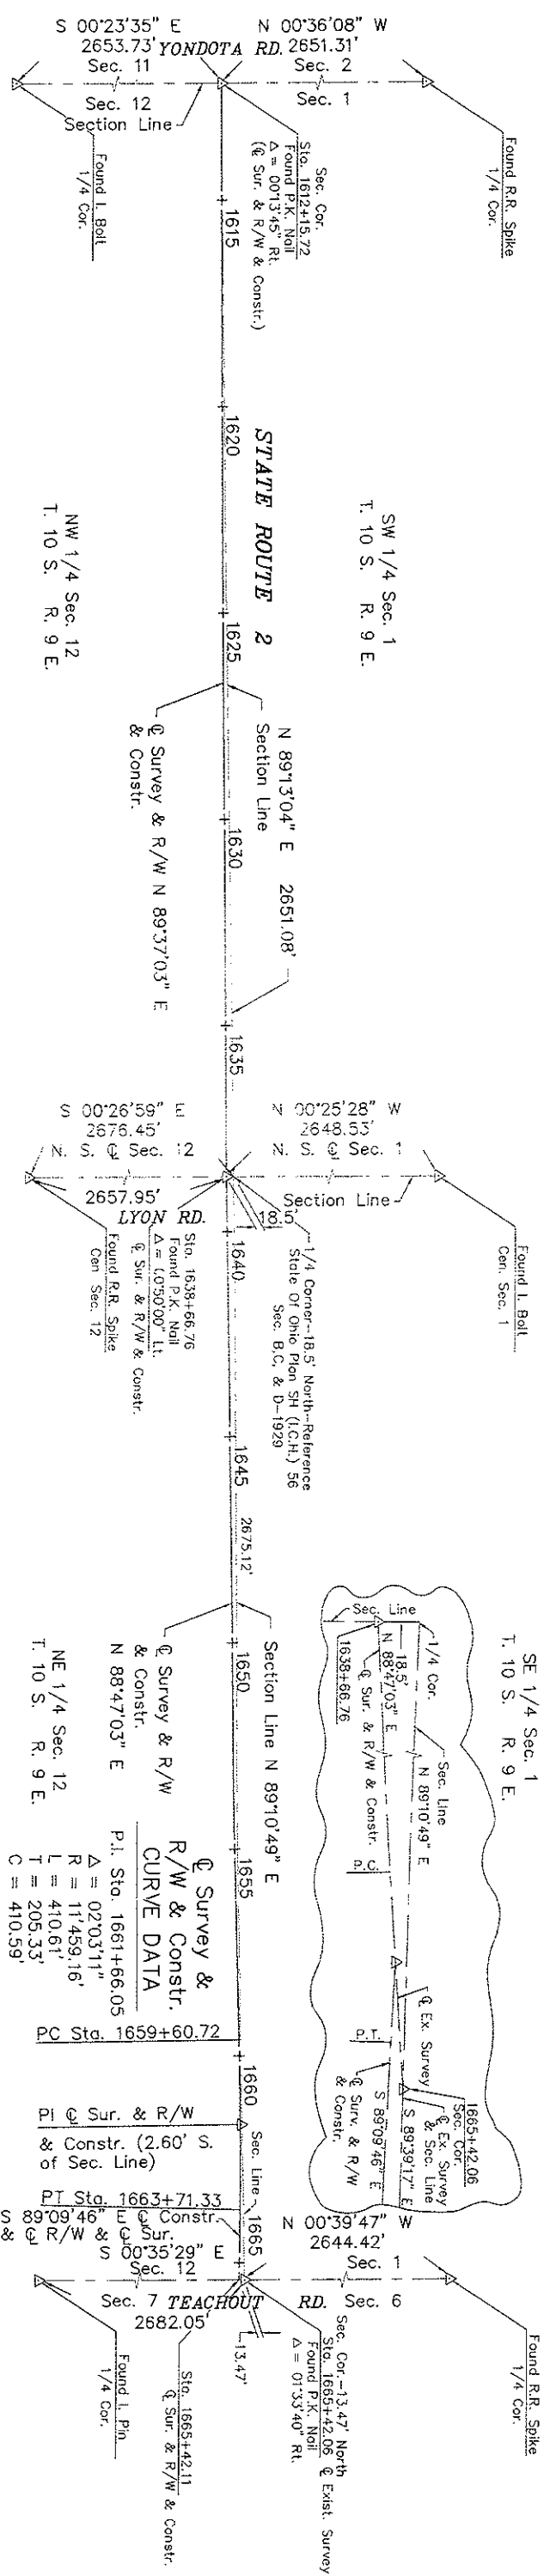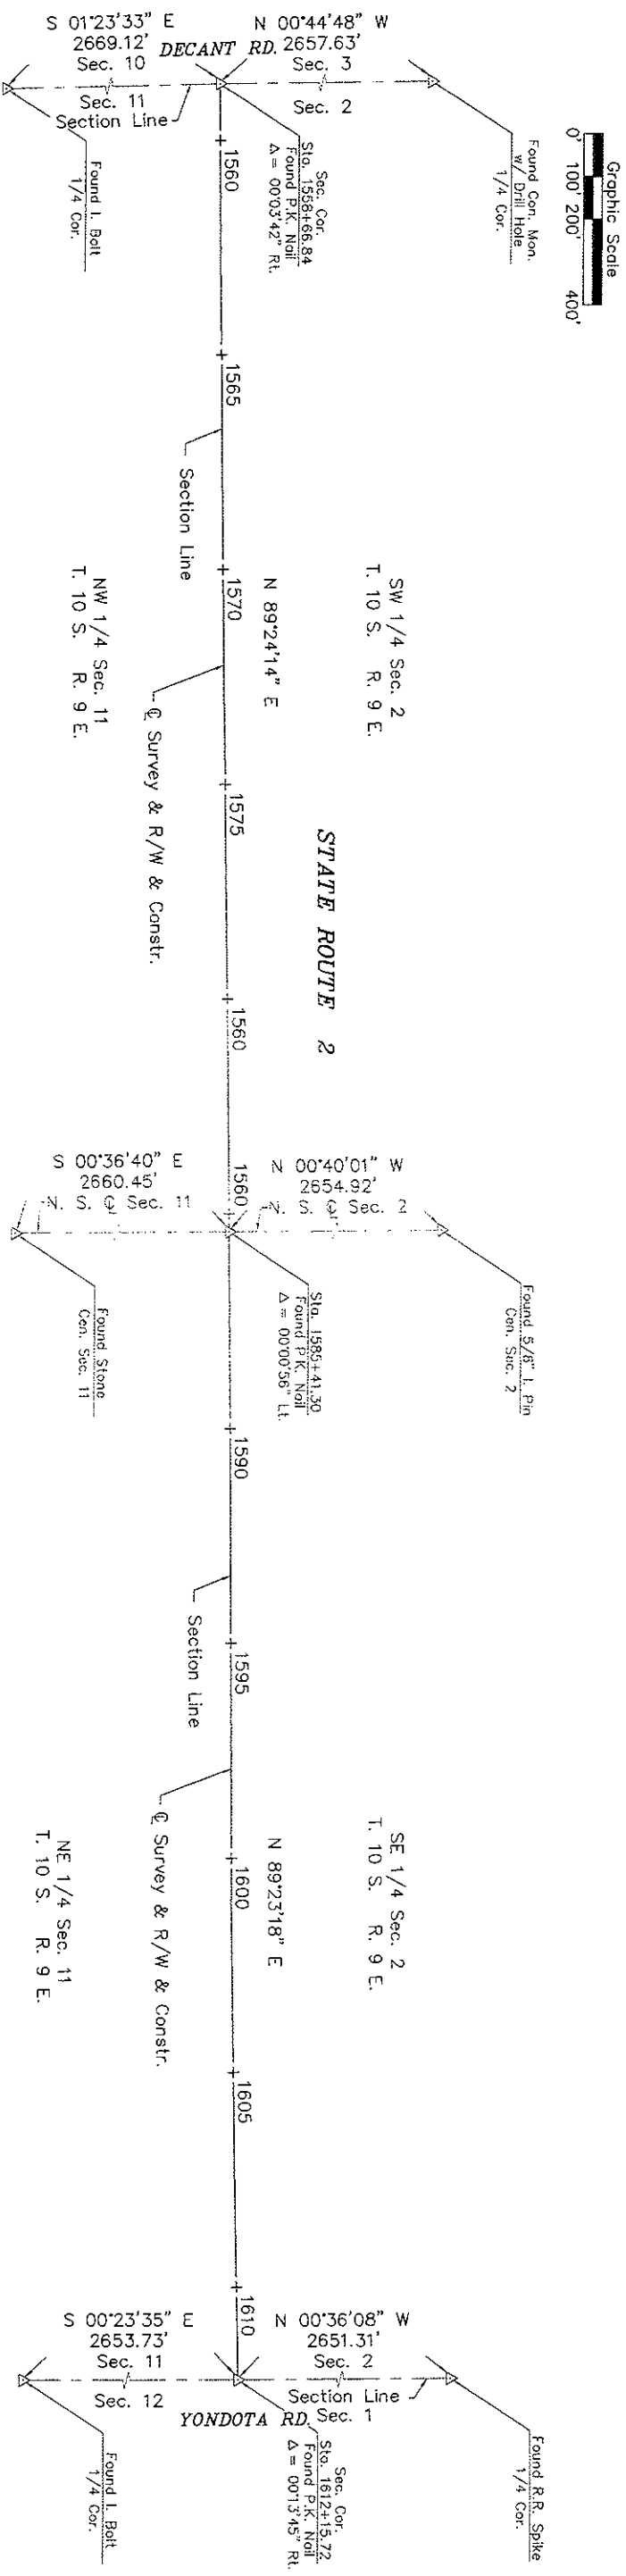

This plat prepared by Mannik-Smith
for the 4-iane upgrade of SR 2.
Project Cancelled - Not Built
For survey notes, see file: LUC - 172


STATE ROUTE 2: CENTERLINE SURVEY PLAT

CALC	LUCAS COUNTY LUCAS-2-27.25	OHIO
BY DATE		
CHKD		FWWA 5
BT DATE		REGION


Revision	Date	Description	
CENTERLINE SURVEY PLAT			
Drawn	Checked	Date	Type Fund

SHEET 3 OF 5

OTTAWA COUNTY, OHIO

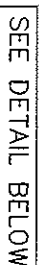

 P.I. = 1716+84.83
 Δ = 01'56".59"
R = 11459.16'
L = 389.94'
T = 194.99'
C = 389.93'



For survey notes, see file: LUC - 172

[illegible]

State of Ohio, Department of Transportation
C E N T E R L I N E S U R V E Y P L A T


LUC-2-27.25

LYING IN SECTIONS 1,2,3,4,5,8,9,10,11,12 TOWN 10 SOUTH, RANGE 9 EAST AND
SECTIONS 5,6,7,8,17 TOWN 10 SOUTH, RANGE 10 EAST, JERUSALEM TOWNSHIP
LUCAS COUNTY, OHIO AND
SECTIONS 28 AND 29, TOWN 8 NORTH, RANGE 14 EAST, BENTON TOWNSHIP,
OTTAWA COUNTY, OHIO

SHEET 4 OF 5

LUCAS COUNTY
LUC-2-27.25

OHIO
FHWA
REGION 5

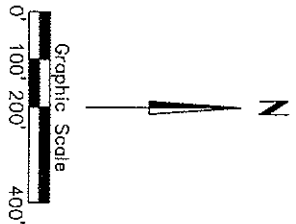


EXISTING $\mathcal{Q}$ SURVEY
CURVE DATA

$\Delta = 90^{\circ}55'04''$
 $D = 4'00'00''$
 $Ls = 400'$
 $Ts = 1660.12'$
 $Es = 616.37'$
 $\mathcal{O}s = 8'00'00''$
 $P = 4.65'$
 $K = 199.87'$
 $Xc = 399.22'$
 $Yc = 18.59'$
 $LT = 266.94'$
 $ST = 133.58'$
 $LC = 399.65'$
 $R = 1432.40'$
 $Lc = 1872.95'$
 $\Delta c = 74^{\circ}55'04''$

PROPOSED $\mathcal{Q}$ SURVEY
& R/W & CONSTR.
CURVE DATA

$\Delta = 90^{\circ}55'04''$
 $D = 03'30'00''$
 $Ls = 500'$
 $Ts = 1919.72'$
 $Es = 705.91'$
 $\mathcal{O}s = 8'45'00''$
 $P = 6.36'$
 $K = 249.80'$
 $Xc = 498.84'$
 $Yc = 25.41'$
 $LT = 333.74'$
 $ST = 167.04'$
 $LC = 499.48'$
 $R = 1637.02'$
 $Lc = 2097.65'$
 $\Delta c = 73^{\circ}25'04''$

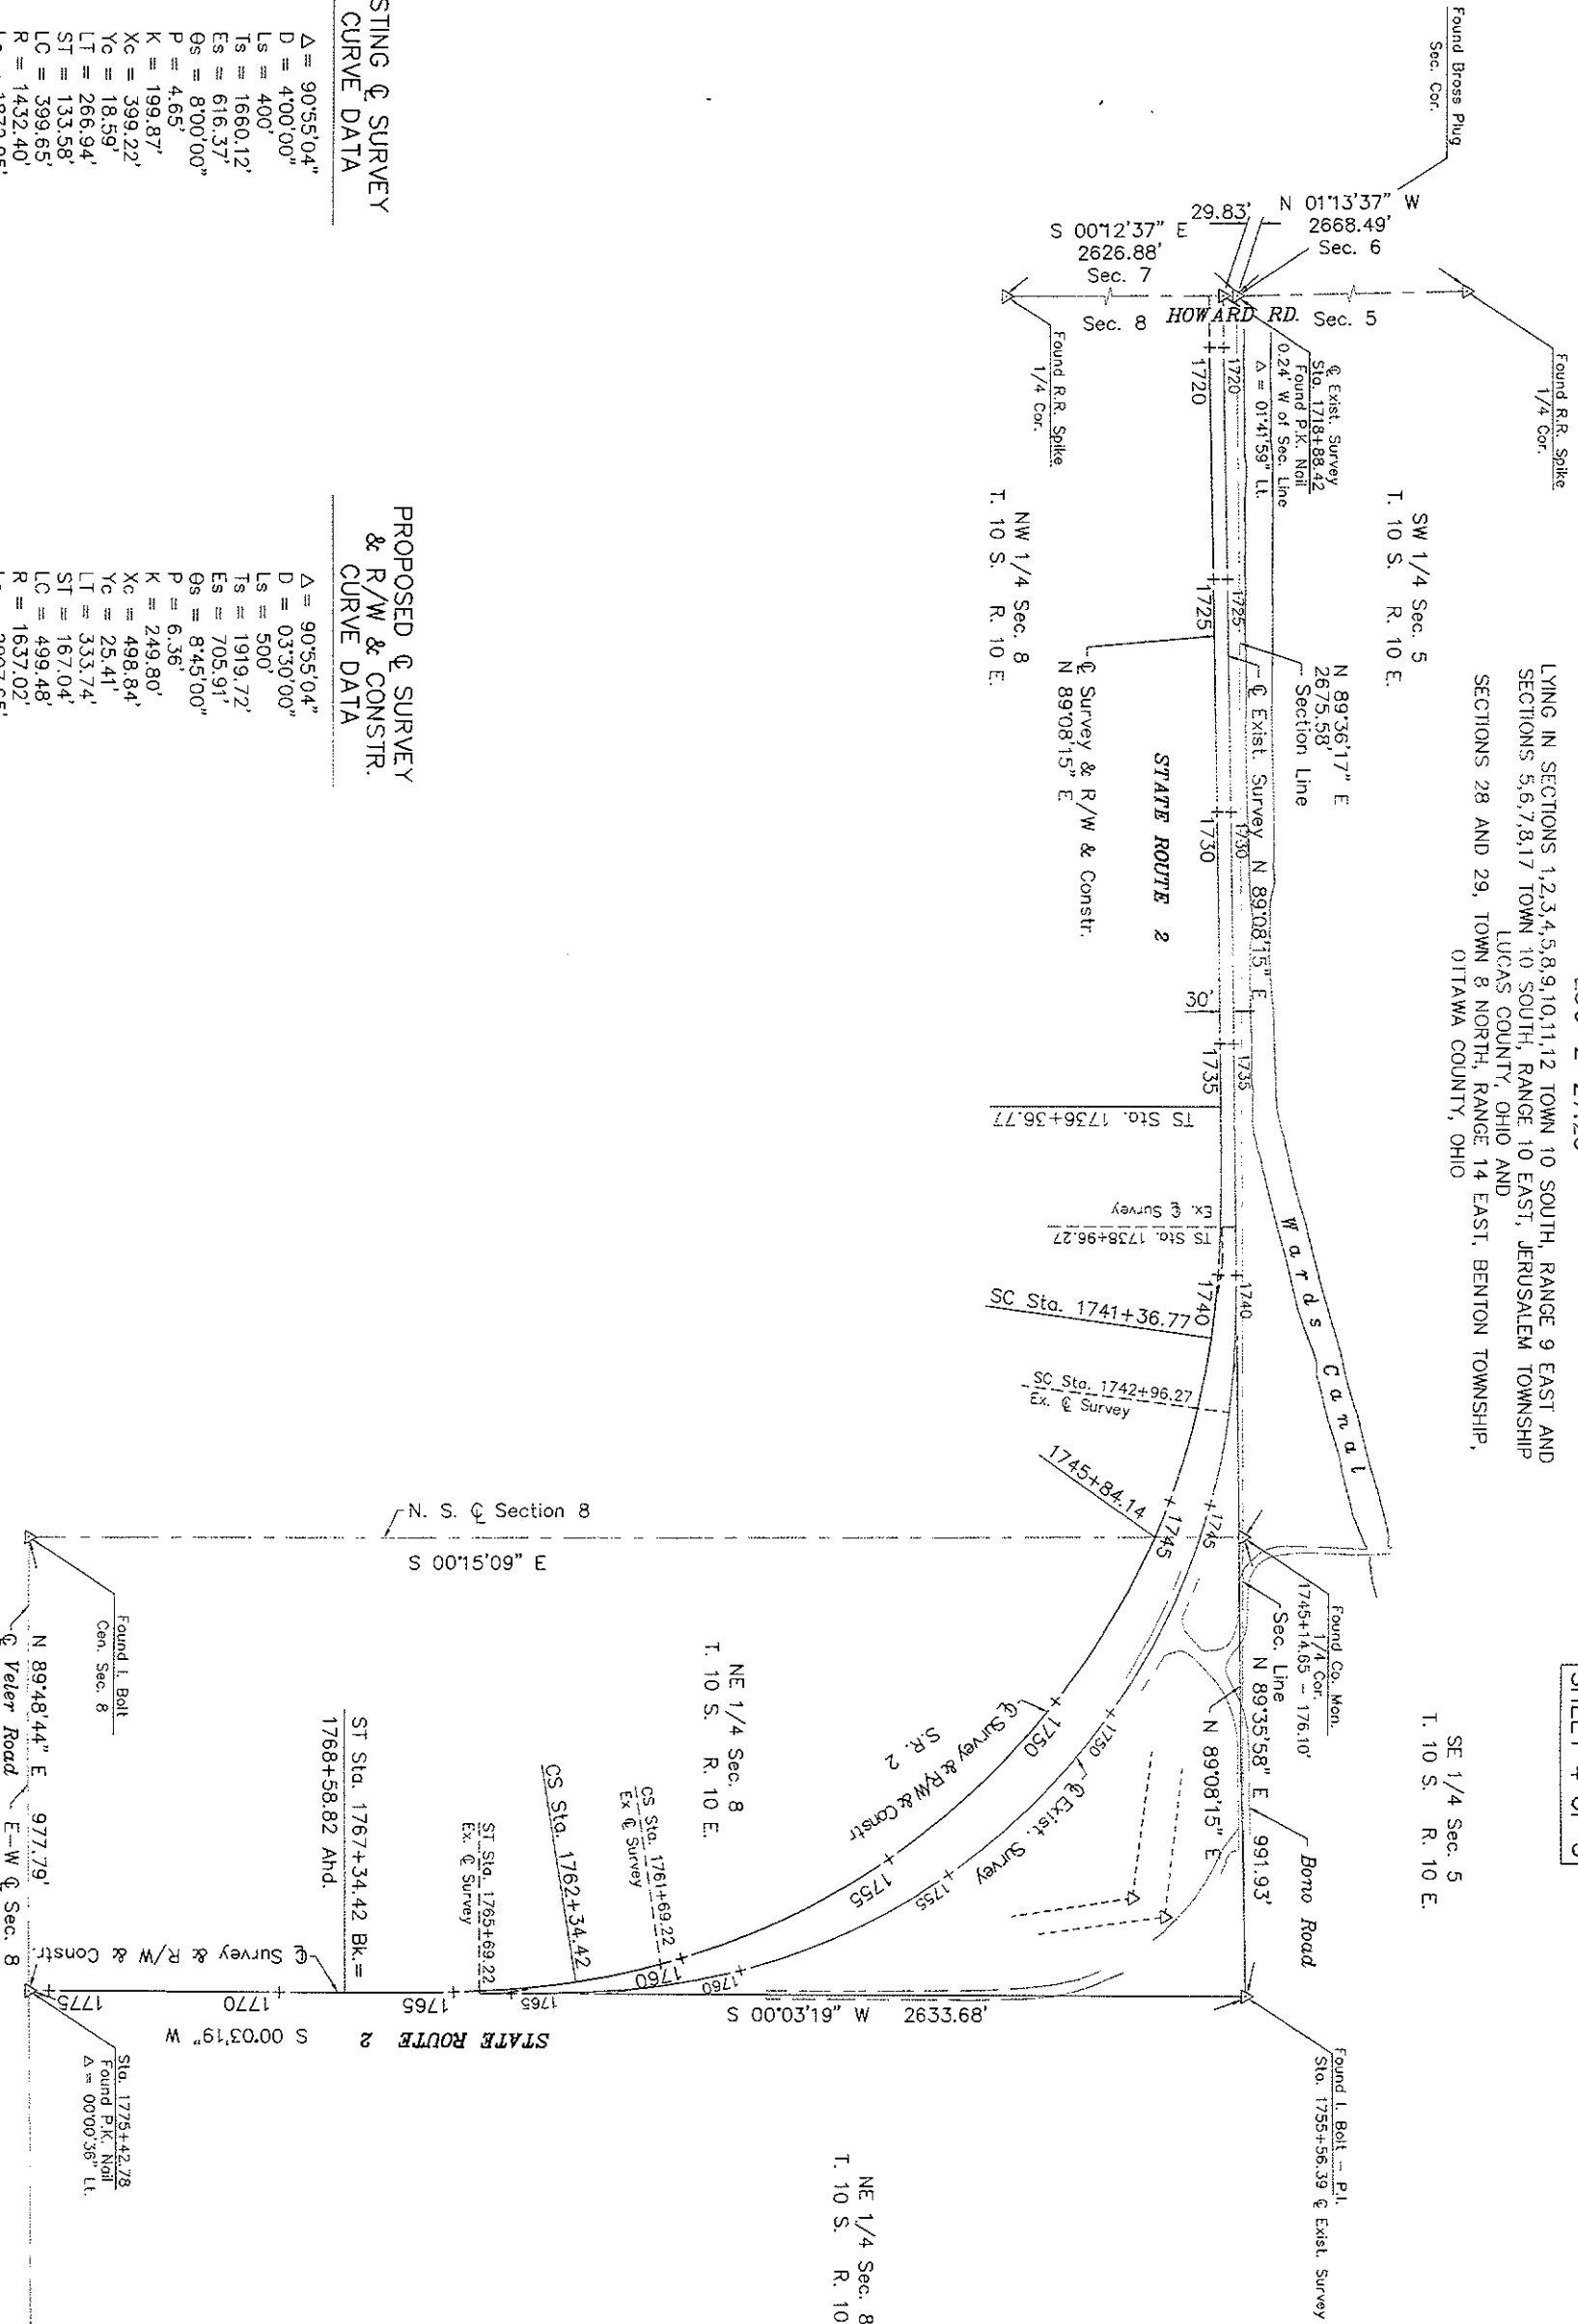

This plat prepared by Mannik-Smith
for the 4-lane upgrade of SR 2.
Project Cancelled - Not Built
For survey notes, see file: LUC - 172

STATE ROUTE 2: CENTERLINE SURVEY PLAT

Revision		Description	
	Date		
CENTERLINE SURVEY PLAT			
Drawn	Checked	Date	Type Funds

State of Ohio, Department of Transportation

CENTERLINE SURVEY PLAT

State of Ohio, Department of Transportation



LUC-2-27.25

LIVING IN SECTIONS 1,2,3,4,5,8,9,10,11,12 TOWN 10 SOUTH, RANGE 9 EAST AND SECTIONS 5,6,7,8,17 TOWN 10 SOUTH, RANGE 10 EAST, JERUSALEM TOWNSHIP LUCAS COUNTY, OHIO AND SECTIONS 28 AND 29, TOWN 8 NORTH, RANGE 14 EAST, BENTON TOWNSHIP, OTTAWA COUNTY, OHIO

SHEET 5 OF 5

CALC	OHIO	
BY DATE		
CHKO		
BY DATE	5	

LUCAS COUNTY
LUC-2-27.25

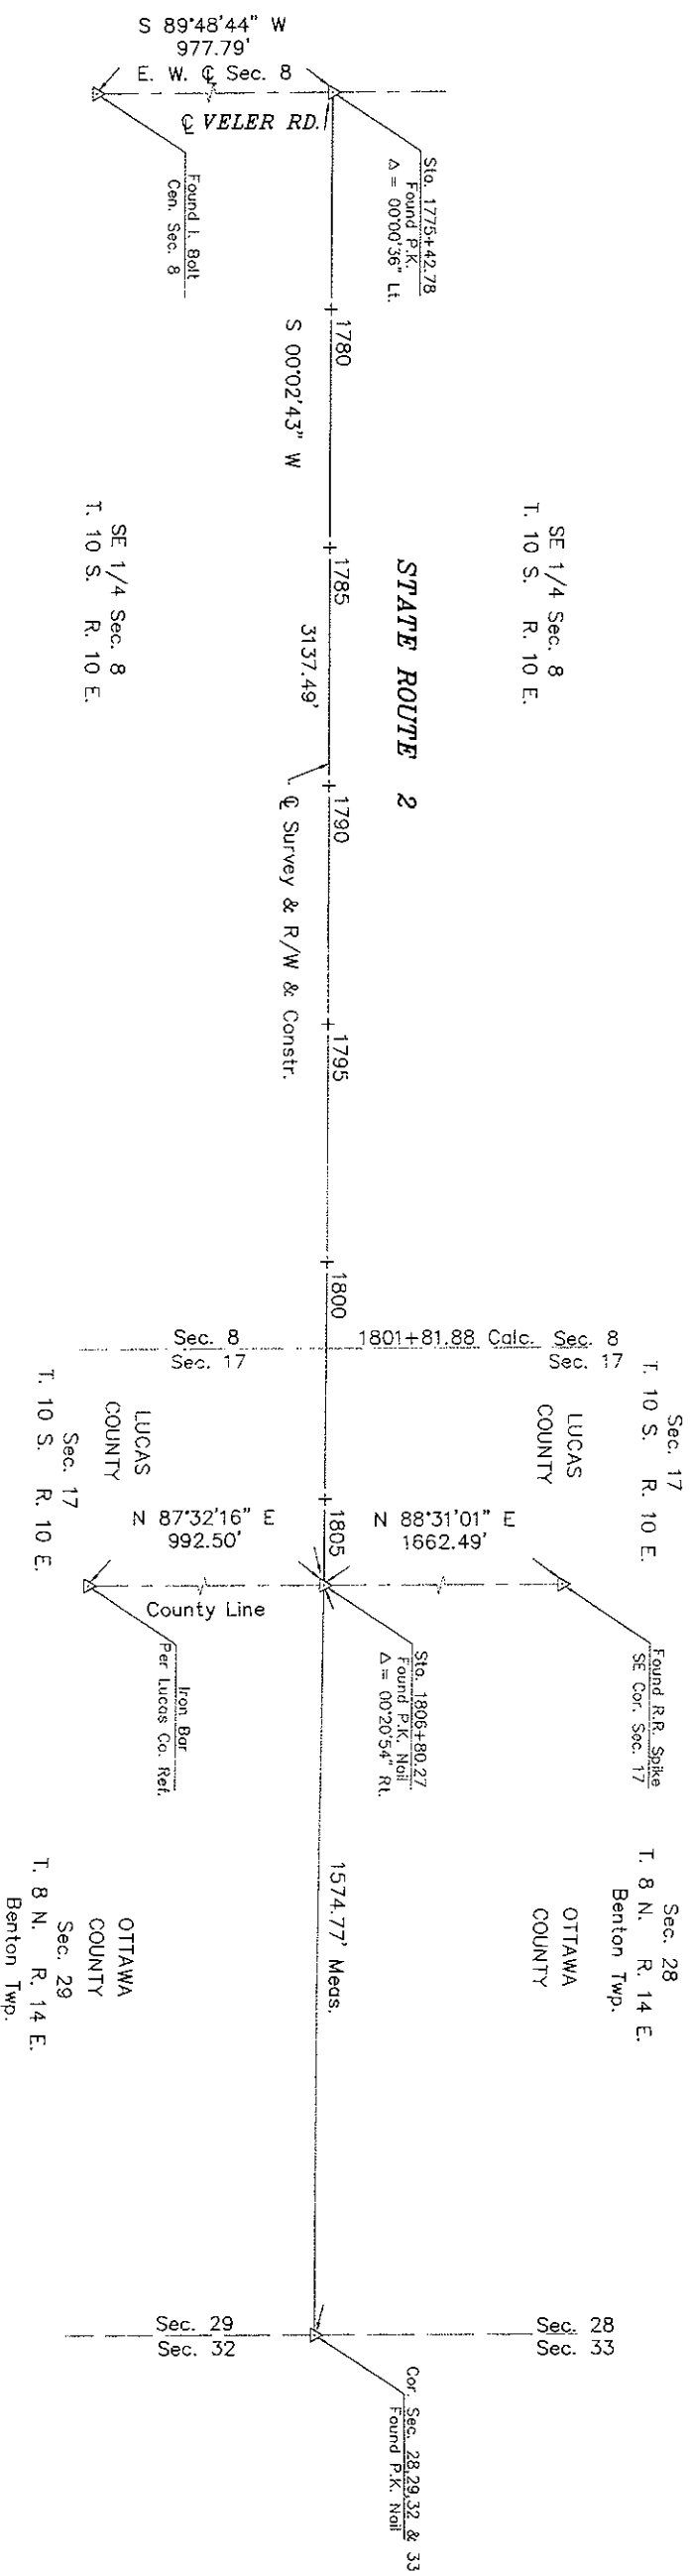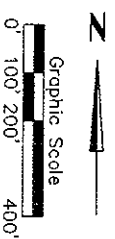

This plat prepared by Mannik-Smith
for the 4-lane upgrade of SR 2.
Project Cancelled - Not Built
For survey notes, see file: LUC - 172

[illegible]