

O.D.O.T. DISTRICT 2 SURVEY OFFICE (USE ONLY)

PERSONNEL

REFERENCE NO. 28A

SHEET 7 OF 13

NOTES MILLER

DATE 2/24/23

ROUTE SR 2

H.C. NIESE

WEATHER SUNNY

COUNTY LUCAS

R.C.

TEMP. 78°

TOWNSHIP AMBOY

DWG BY BARRIERE

PID 108465

SECTION 11

T 2 N R E

TYPE MONUMENT MONBOX W/ 3/4" IPIN

ON SURFACE - BELOW ON

OFFSET Q PAVEMENT ON LT : RT

TO EDGE PAVEMENT

STATION: 720+54.98

HORZ.DATUM: NAD83 (2011)


GEOID: NAVD88 2012B

GRID: NORTHING: 714931.016


EASTING: 1659814.879

LDP: NORTHING:

EASTING:

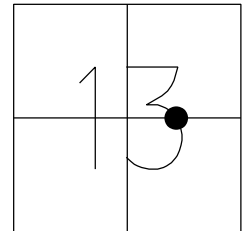

RECORD:
FD BRASS PLATE
9/8/60
FD MONBOX
W/ 3/4" IPIN
REF28A
2/24/23, TDN

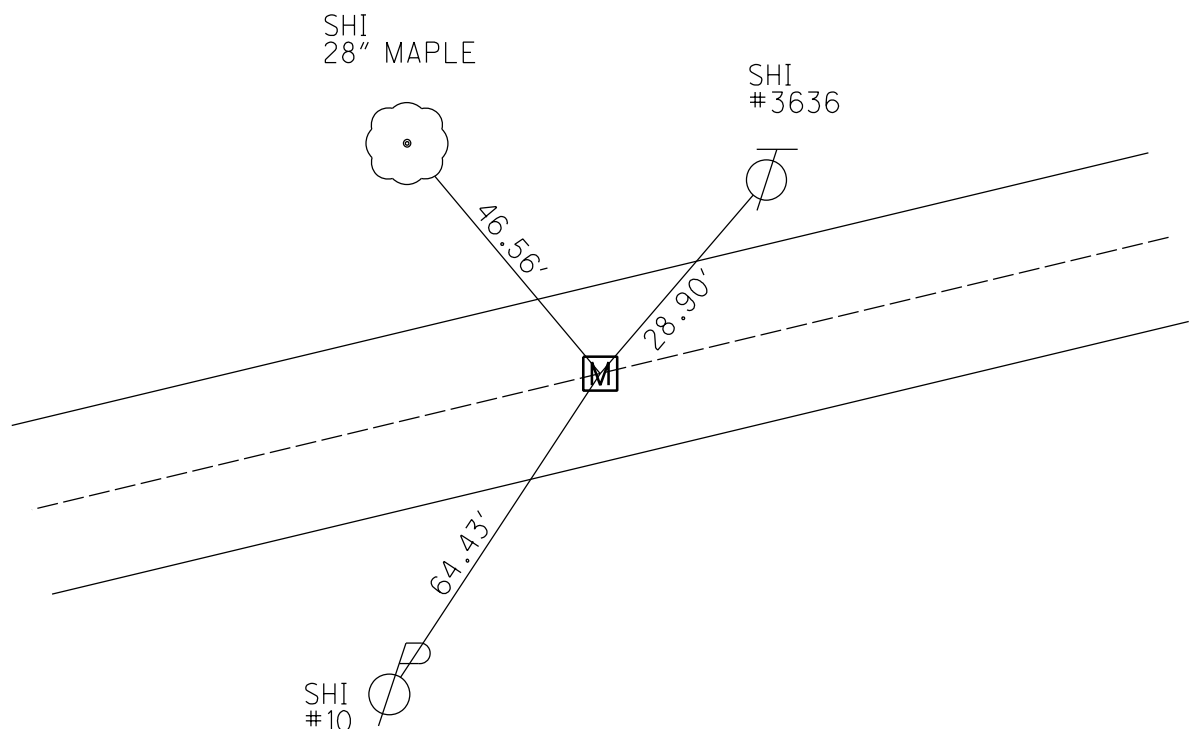

O.D.O.T. DISTRICT 2 SURVEY OFFICE (USE ONLY)

PERSONNEL

REFERENCE NO. 28 A

SHEET 8 OF 13

NOTES TOMSIK

DATE 9/8/60

ROUTE SR 2

H.C. DRAUR

WEATHER CLEAR-HOT

COUNTY LUCAS

R.C. CHOPPURESS

TEMP. 90°

TOWNSHIP ADAMS

ORLOK/NORRIS

SECTION 13

DWG BY NIESE PID

T 2 US R E

TYPE MONUMENT BRASS PLATE

ON SURFACE - ~~BELOW~~ ON


OFFSET Q PAVEMENT LT : RT

 TO EDGE PAVEMENT

STATION: 720+54.98

HORIZ.DATUM: GEOID:

GRID: NORTHING: EASTING:

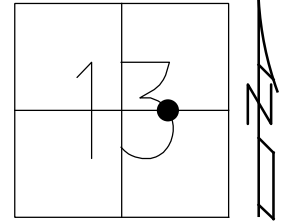

RECORD:
FD BRASS PLATE
9/8/60

