

O.D.O.T. DISTRICT 2 SURVEY OFFICE (USE ONLY)

PERSONNEL

REFERENCE NO. 28 C

SHEET 11 OF 15

NOTES MILLER

DATE 2/24/23

ROUTE SR 2

H.C. NIESE

WEATHER SUNNY

COUNTY LUCAS

R.C.

TEMP. 78°

TOWNSHIP AMBOY

DWG BY BARRIERE

PID 108465

SECTION 13

T 2 N R E

TYPE MONUMENT MONBOX W/ 1" IPIN

ON SURFACE - BELOW ON

OFFSET $\varnothing$ PAVEMENT ON LT : RT

TO EDGE PAVEMENT

STATION: 720+54.98

HORZ.DATUM: NAD83 (2011)


GEOID: NAVD88 2012B

GRID: NORTHING: 715196.705


EASTING: 1660689.873

LDP: NORTHING:

EASTING:

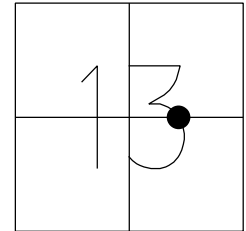

RECORD:
FD BRASS PLATE
9/8/60
FD MONBOX
W/ 1" IPIN
REFC28
2/24/23, TDN

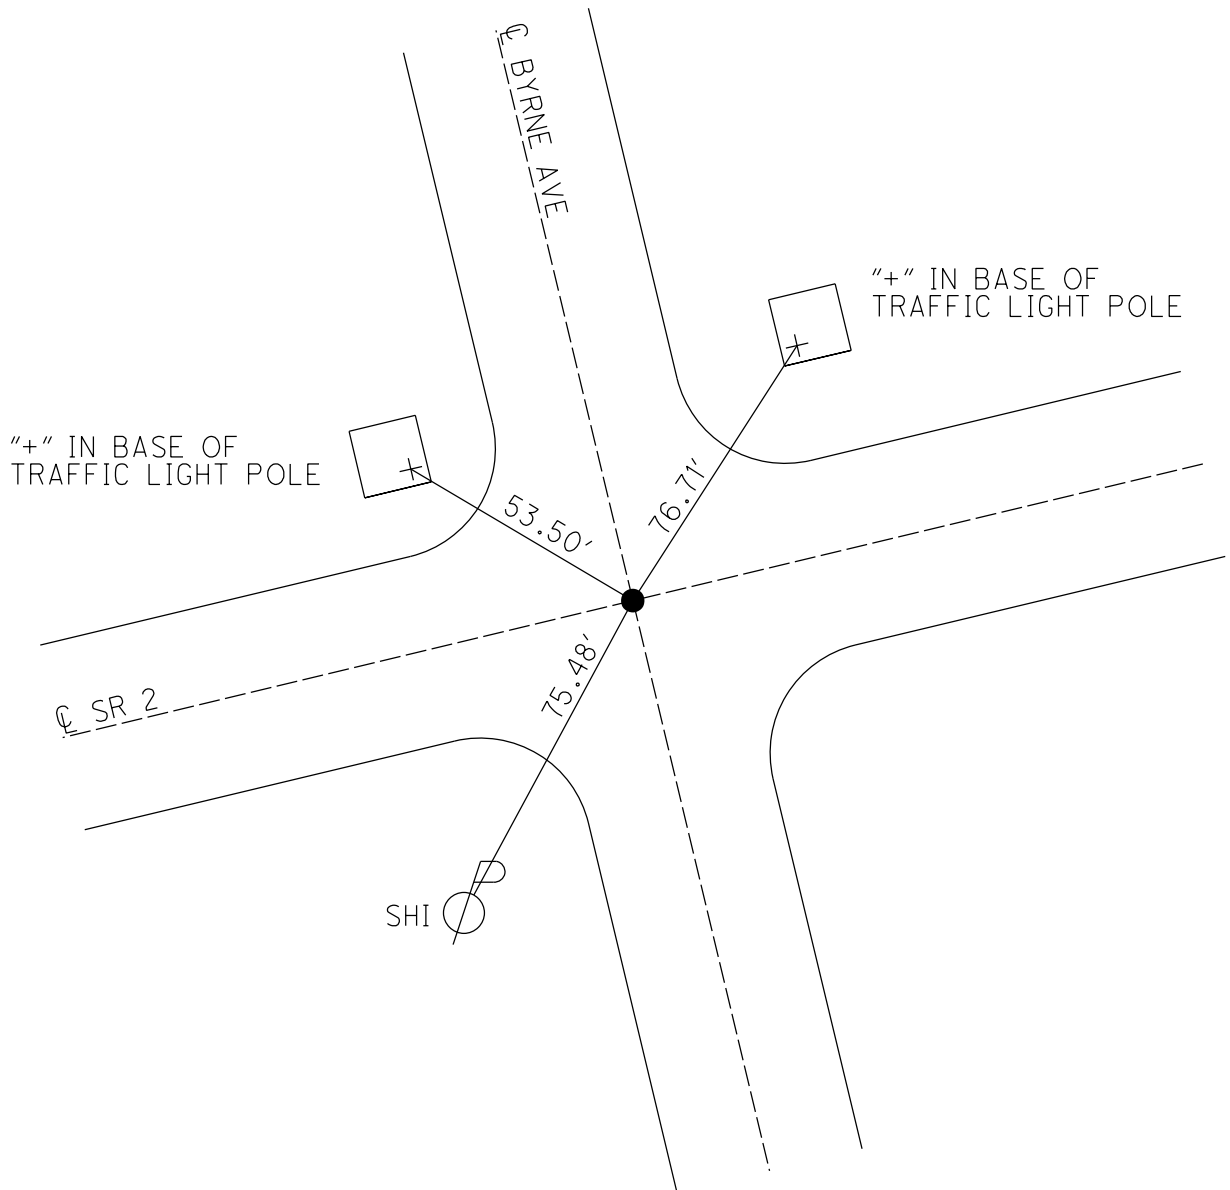

O.D.O.T. DISTRICT 2 SURVEY OFFICE (USE ONLY)

PERSONNEL

REFERENCE NO. 28 C

SHEET 10 OF 13

NOTES TOMSIC
H.C. DRAUR
R.C. CHOPPURESS
ORLOK/NORRIS

DATE 9/8/60
WEATHER CLEAR-HOT
TEMP. 90°

ROUTE SR 2
COUNTY LUCAS
TOWNSHIP ADAMS
SECTION 13
T 2 US R E

DWG BY NIESE PID

TYPE MONUMENT BRASS PLATE


ON SURFACE - ~~BELOW~~ ON

OFFSET Q PAVEMENT LT : RT
 TO EDGE PAVEMENT

STATION: 729+69.60

HORZ. DATUM: GEOID:

GRID: NORTHING: EASTING:

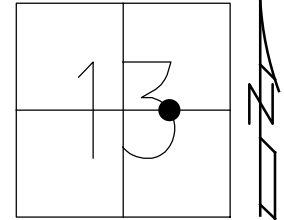

RECORD:
FD BRASS PLATE
9/8/60

