

O.D.O.T. DISTRICT 2 SURVEY OFFICE (USE ONLY)

PERSONNEL

REFERENCE NO. 29

SHEET 15 OF 15

NOTES MILLER

DATE 2/24/23

ROUTE SR 2

H.C. NIESE

WEATHER SUNNY

COUNTY LUCAS

R.C.

TEMP. 78°

TOWNSHIP

DWG BY BARRIERE

PID 108465

SECTION 7

T 2 N R E

TYPE MONUMENT 1" IPIN IN CONCRETE

ON ~~SURFACE~~ - BELOW 4"

OFFSET $\oslash$ PAVEMENT ON LT : RT

TO EDGE PAVEMENT

STATION: 1081+88

HORZ.DATUM:


GEOID:

GRID: NORTHING:


EASTING:

LDP: NORTHING:

EASTING:

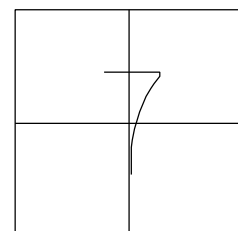

RECORD:
FD 1" IPIN
IN CONC.
4" DOWN
5/26/88
SET SM R.R.SPIKE
7/8/98, IRS
DID NOT FIND
2/23/24, TDN

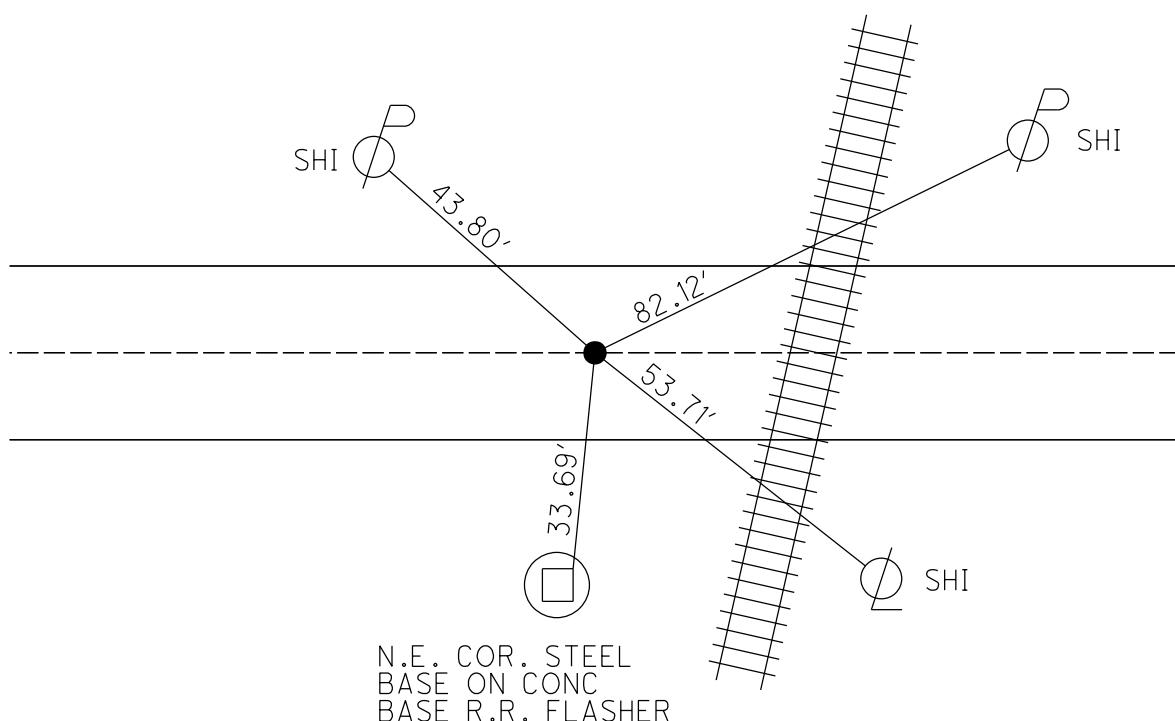

O.D.O.T. DISTRICT 2 SURVEY OFFICE (USE ONLY)

PERSONNEL

REFERENCE NO. 29

SHEET 13 OF 13

NOTES CURTIS
H.C. HOUSEHOLDER
R.C. _____

DATE 5/26/88
WEATHER MILD
TEMP. 70°

ROUTE SR 2
COUNTY LUCAS
TOWNSHIP _____
SECTION 7
T N R E

DWG BY NIESE PID _____

TYPE MONUMENT 1" IPIN IN CONCRETE


~~ON SURFACE~~ - BELOW 4"

OFFSET $\odot$ PAVEMENT ON LT : RT
 - TO - EDGE PAVEMENT


STATION: 1081+88

HORZ.DATUM: _____ GEOID: _____

GRID: NORTHING: _____ EASTING: _____

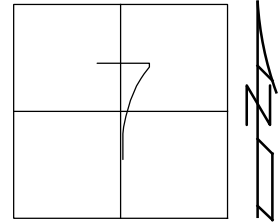

RECORD:
FD 1" IPIN
IN CONC.
4" DOWN
5/26/88
SET SM R.R.SPIKE
7/8/98, IRS

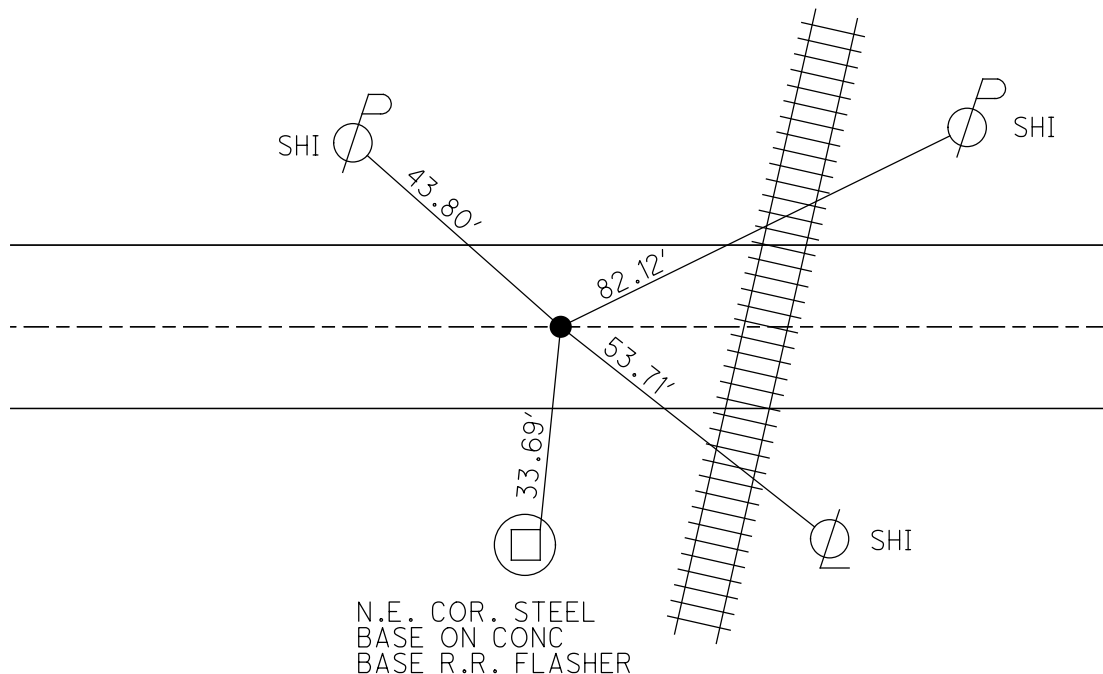

O.D.O.T. DISTRICT 2 SURVEY OFFICE

PERSONNEL

REFERENCE NO. 29

SHEET 1 OF 5

NOTES D. CURTIS

H.C. J. HOUSEHOLDER

R.C. _____

DATE 5-26-88

WEATHER MILD

TEMP. 70° ±

ROUTE S.R. #2

COUNTY LUCAS

TOWNSHIP _____

SECTION _____

T _____ R _____


TYPE MONUMENT 1" I. PIN IN CONC.

ON SURFACE - BELOW 4" BELOW SURFACE

LEFT- & PAV'T. - RIGHT & PAV'T

TO _____ EDGE PAVEMENT

S.L.M. 1081 + 88

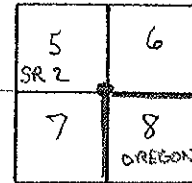

Z _____

Set Small RR Spk 7/8/98 K.S.

