

O.D.O.T. DISTRICT 2 SURVEY OFFICE (USE ONLY)

PERSONNEL _____

REFERENCE NO. 78 D

SHEET 12 OF 18

NOTES HOHENBERGER DATE 10/31/77

ROUTE US 24

H.C. WILLIAMS WEATHER _____

COUNTY LUCAS

R.C. GERDZINSKI TEMP. _____

TOWNSHIP USR

SECTION 27

DWG BY RHOADES PID _____

T 9 N R 7 E

TYPE MONUMENT MONBOX

ON SURFACE - ~~BELOW~~ ON _____



OFFSET \odot PAVEMENT ON _____ LT : RT

_____ TO _____ EDGE PAVEMENT

STATION: 1334+25

HORZ.DATUM: _____ GEOID: _____

GRID: NORTHING: _____ EASTING: _____

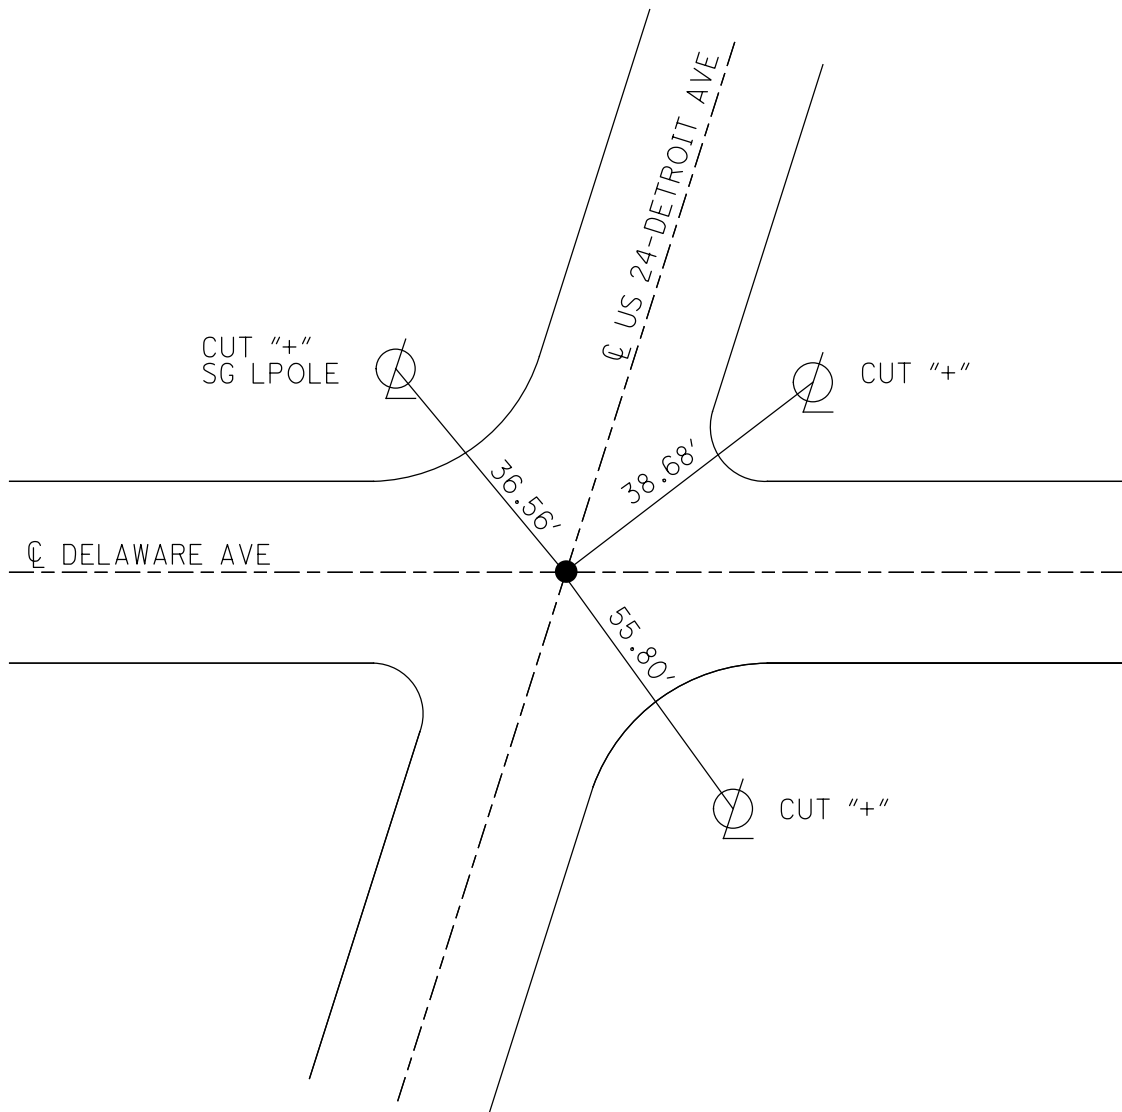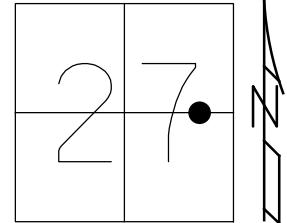

PERSONNEL TITLE PERSONNEL TITLE

PROJECT _____ DATE _____

PROJECT LIMITS _____ WEATHER _____

FROM STA. _____ TO STA. _____ TEMP _____

DESCRIPTION REF. MON. DETROIT AVE RESURF. CAMSON TO CENTRA

