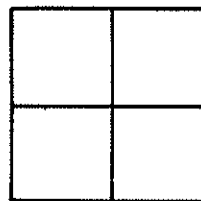
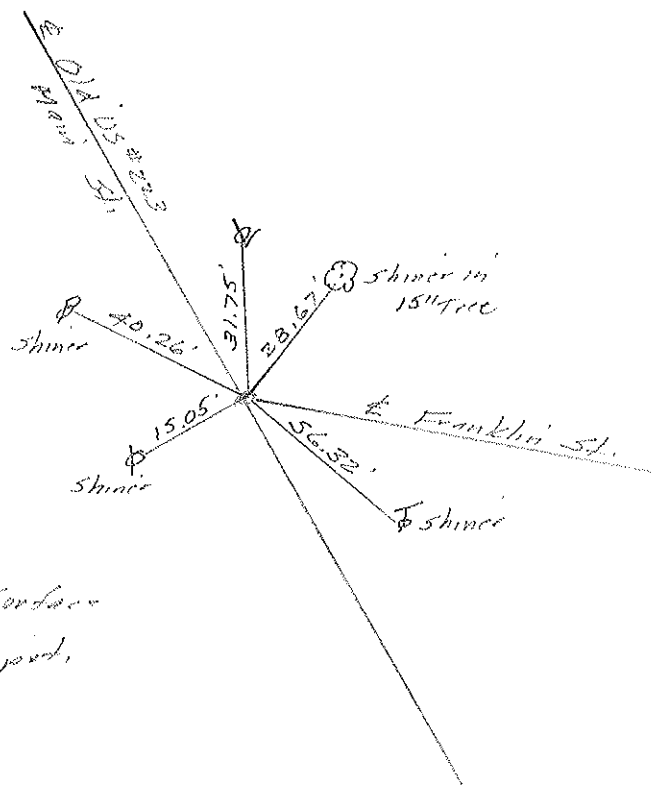


County Lucas S.R. 05 223Date 10 May 1979Township 54/0 21/19Weather Wet onSection 0.00Temp. 75°T N, R EPersonnel L. StoneR. MichalekP. NeuserD. CurtisD. GranatoREF. NO. 3

Ed. R.R. Sple. To Surface
11.7' to W. edge pcd.