

O.D.O.T. DISTRICT 2 SURVEY OFFICE (USE ONLY)

PERSONNEL

REFERENCE NO. 7

SHEET 7 OF 45

NOTES PRESTON-COLVIN

H.C. PRESTON-COLVIN

R.C. NEISE

DATE 10-2-24

WEATHER SUNNY

TEMP. 70°

ROUTE SR 295

COUNTY LUCAS

TOWNSHIP PROVIDENCE

SECTION 22

DWG BY PRESTON-COLVIN PID PAVING TRAIN

T 6 N R 9 E

TYPE MONUMENT MAG/WASHER

ON SURFACE - ~~BELOW~~ ON

OFFSET $\angle$ PAVEMENT 1.5" ~~LT~~ : RT

9.5' TO RT EDGE PAVEMENT

STATION: 244+67.65

HORIZ.DATUM: NAD83(2011)


GEOID: NAVD88 2018

GRID: NORTHING: 658448.237


EASTING: 1605118.492

LDP: NORTHING: 279441.552

EASTING: 115822.002

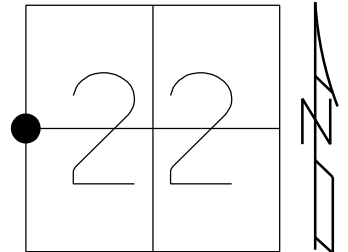

RECORD:
FD 3/4" IPIN
11/2/84
8/29/02, DCH
SET MAG/WASHER
11/25/02, DCH
FD MAG NAIL
REF27
12/4/15, JLL
SET MAG/WASHER
7/17/17, DCH
FD MAG/WASHER
REF7
12/6/21, JFO
FD MAG/WASHER
REF7
5-3-23, TDN
9-29-23, JAM
FD MAG/W
6/17/24, JAM
10/2/24, TDN

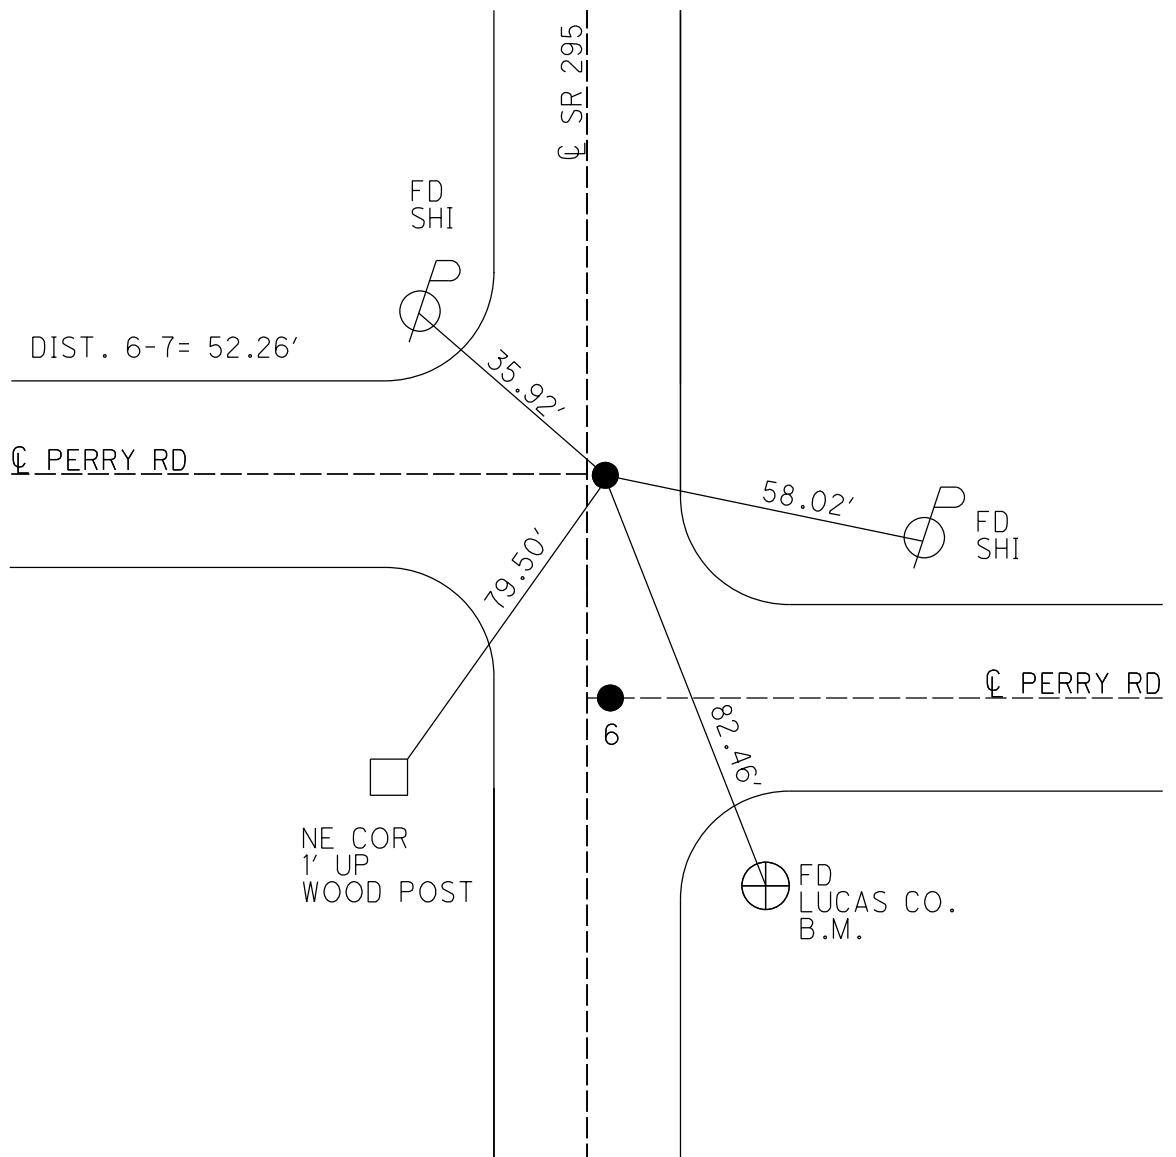

O.D.O.T. DISTRICT 2 SURVEY OFFICE (USE ONLY)

PERSONNEL

REFERENCE NO. 7

SHEET 7 OF 45

NOTES AUBLE

DATE 5-3-23

ROUTE SR 295

H.C. NIESE

WEATHER WINDY

COUNTY LUCAS

R.C. MILLER

TEMP. 53°

TOWNSHIP PROVIDENCE

DWG BY ASTON

PID CHIP SEAL

SECTION 22

T 6 N R 9 E

TYPE MONUMENT MAG/WASHER

ON SURFACE - ~~BELOW~~ ON

OFFSET Q PAVEMENT 1.5" ~~LT~~ : RT

9.5' TO RT EDGE PAVEMENT


STATION: 244+67.65

HORIZ.DATUM: NAD83(2011)


GEOID: NAVD88 2018

GRID: NORTHING: 658448.237

EASTING: 1605118.492

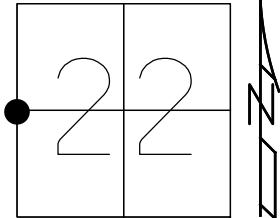

RECORD:
FD 3/4" IPIN
11/2/84
8/29/02, DCH
SET MAG/WASHER
11/25/02, DCH
FD MAG NAIL
REF27
12/4/15, JLL
SET MAG/WASHER
7/17/17, DCH
FD MAG/WASHER
REF7
12/6/21, JFO
FD MAG/WASHER
REF7
5-3-23, TDN
9-29-23, JAM

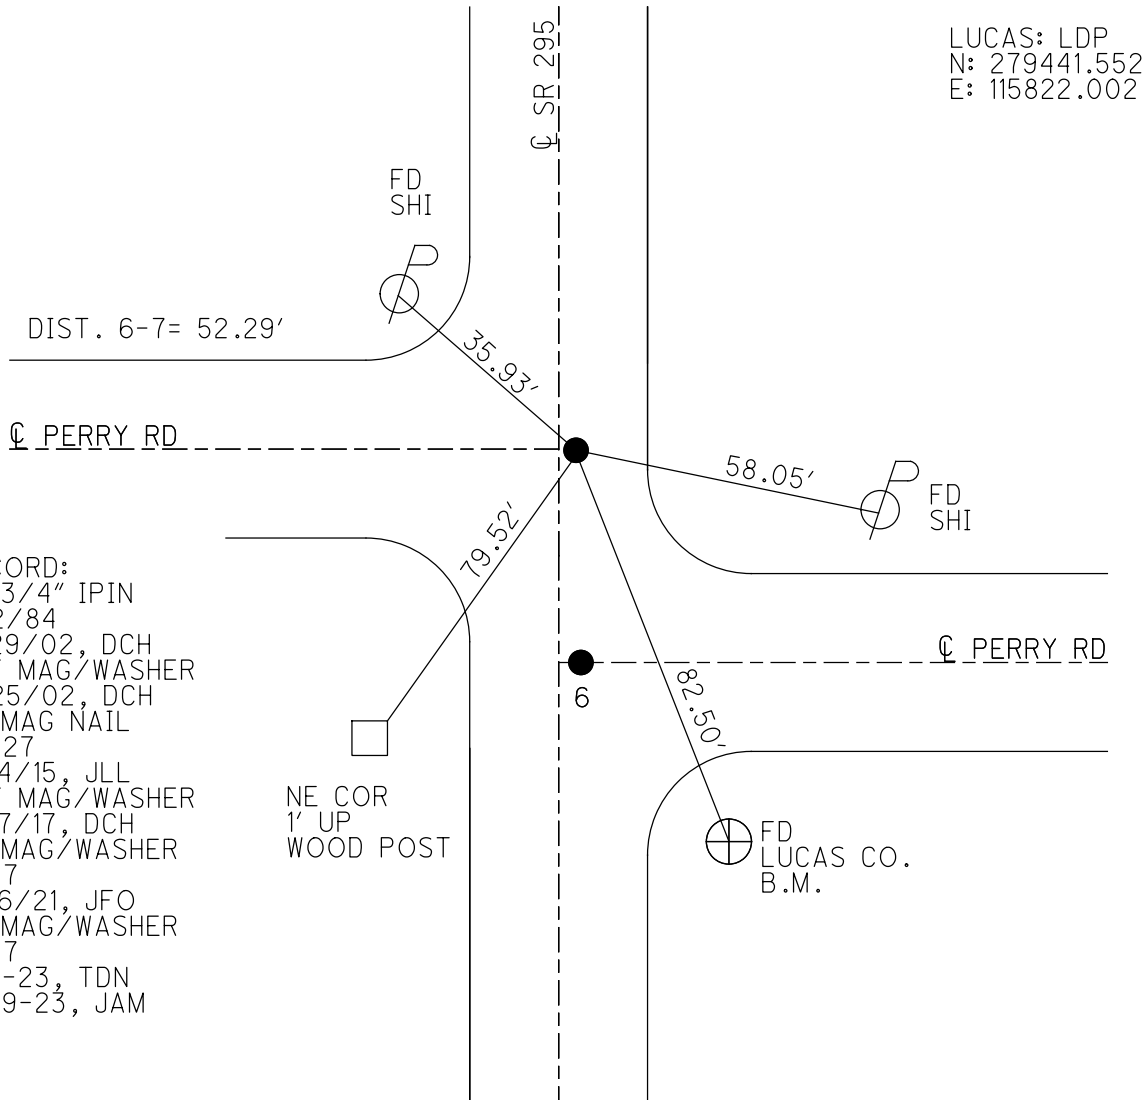

LUCAS: LDP
N: 279441.552
E: 115822.002

O.D.O.T. DISTRICT 2 SURVEY OFFICE (USE ONLY)

PERSONNEL _____ REFERENCE NO. 7 SHEET 7 OF 45

NOTES HOMAN DATE 3/17/17 ROUTE SR 295

H.C. HOMAN WEATHER CLOUDY COUNTY LUCAS

R.C. HELDMAN TEMP. 33° TOWNSHIP PROVIDENCE

SECTION 22

T 6 N R 9 E

TYPE MONUMENT MAG NAIL



ON SURFACE - ~~BELOW~~ ON

~~LEFT~~ - Q PAV'T - RIGHT 1.5'

9.5' TO RT EDGE PAVEMENT

S.L.M. 244+67.65

GRID: NORTHING: 658448.237 EASTING: 1605118.492

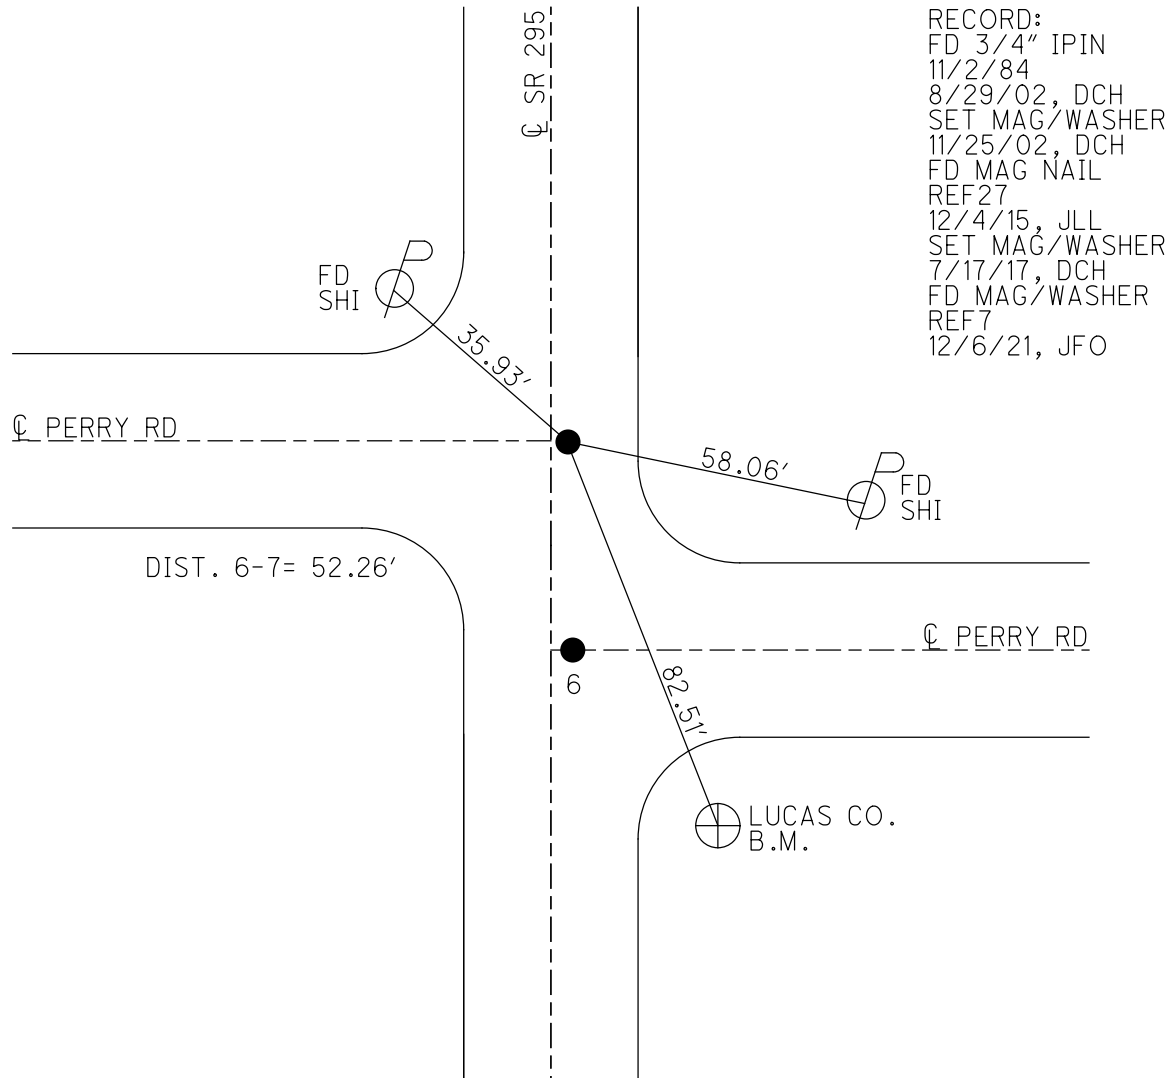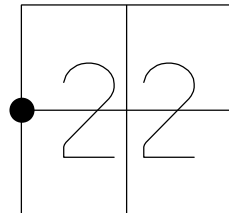


RECORD:
FD 3/4" IPIN
11/2/84
8/29/02, DCH
SET MAG/WASHER
11/25/02, DCH
FD MAG NAIL
REF27
12/4/15, JLL
SET MAG/WASHER
7/17/17, DCH
FD MAG/WASHER
REF7
12/6/21, JFO

O.D.O.T. DISTRICT 2 SURVEY OFFICE (USE ONLY)


PERSONNEL	REFERENCE NO. <u>7</u>	SHEET <u>7</u> OF <u>45</u>
NOTES	DATE <u>3/17/17</u>	ROUTE <u>SR 295</u>
H.C. <u>HOMAN</u>	WEATHER <u>CLOUDY</u>	COUNTY <u>LUCAS</u>
R.C. <u>HELDMAN</u>	TEMP. <u>33°</u>	TOWNSHIP <u>PROVIDENCE</u>
		SECTION <u>22</u>
		<u>T 6 N R 9 E</u>

TYPE MONUMENT MAG NAIL
 ON SURFACE - ~~BELOW~~ ON
~~LEFT~~ - CL PAV'T - RIGHT 1.5'
9.5' TO RT EDGE PAVEMENT
 S.L.M. 244+67.65

GRID: NORTHING: 658448.256 EASTING: 1605118.501

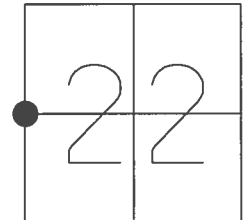

RECORD:
 FD 3/4" IPIN
 11/2/84
 FD 3/4" IPIN
 8/29/02, DCH
 SET MAG/WASHER
 11/25/02, DCH
 FD MAG ANIL
 REF27
 12/4/15, JLL
 SET MAG/WASHER
 7/17/17, DCH

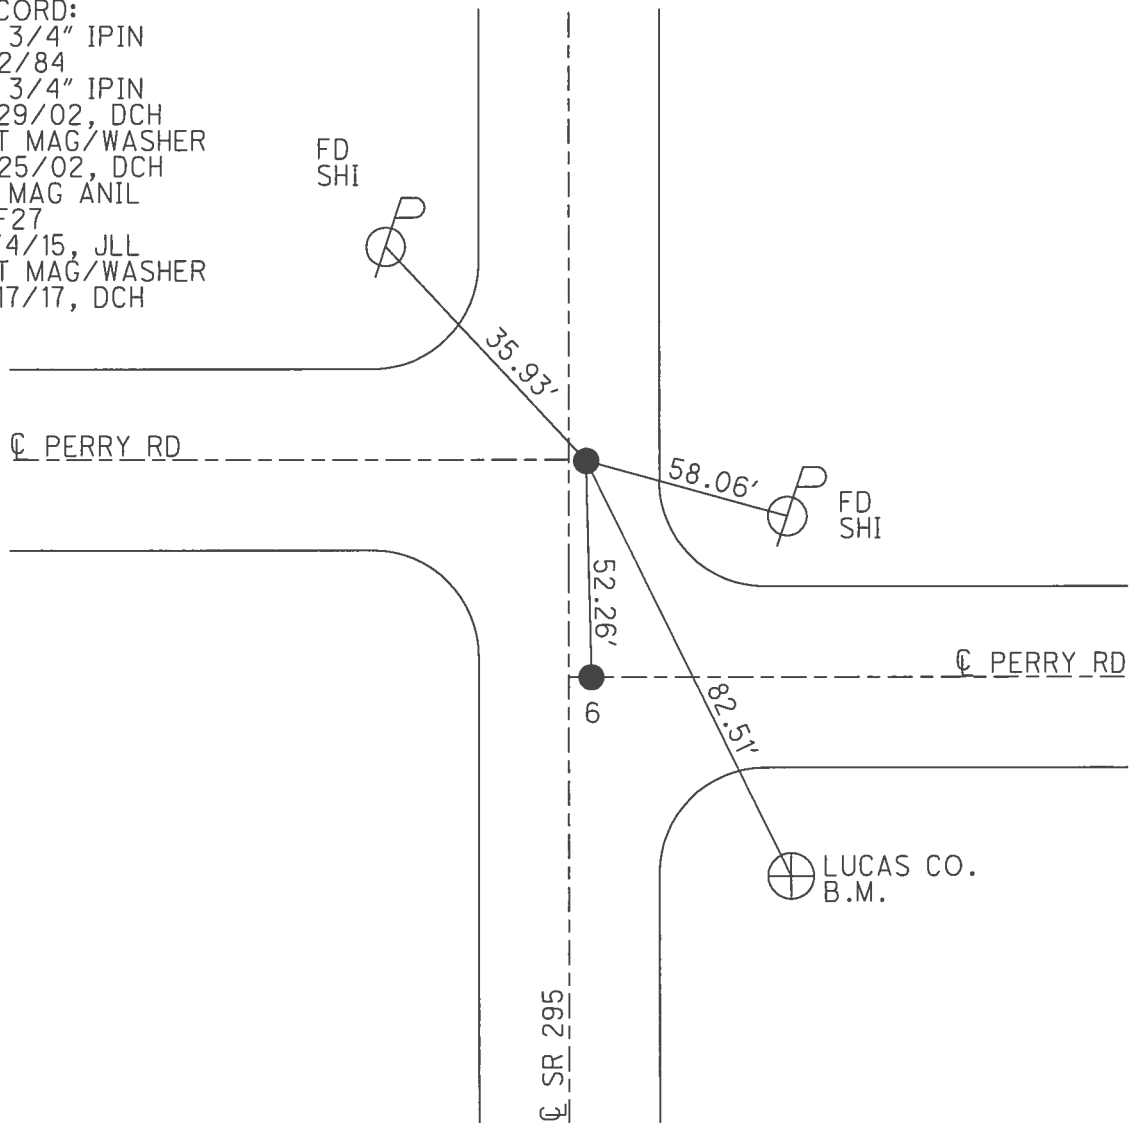

O.D.O.T. DISTRICT 2 SURVEY OFFICE

PERSONNEL

REFERENCE NO. 7

SHEET 7 OF 45

NOTES BEAUMONT

DATE 8-29-02

ROUTE S.R. 295

H.C. HOMAN

WEATHER CLOUDY

COUNTY LUCAS

R.C. BEAUMONT

TEMP. 78°

TOWNSHIP PROVIDENCE

SECTION 22

T 6 N R 9 E


TYPE MONUMENT 3/4" IRON PIN

ON SURFACE - ~~BELOW~~ ON

~~LEFT~~ - Q PAV'T - RIGHT 2"


9.5' TO RT. EDGE PAVEMENT

S.L.M. 114+52

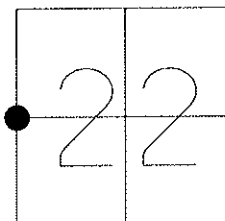

RECORD:
FD. 3/4" I. PINS
AT BOTH POINTS
11-2-84

SET MAG/
WASHER
11-25-02
DCH

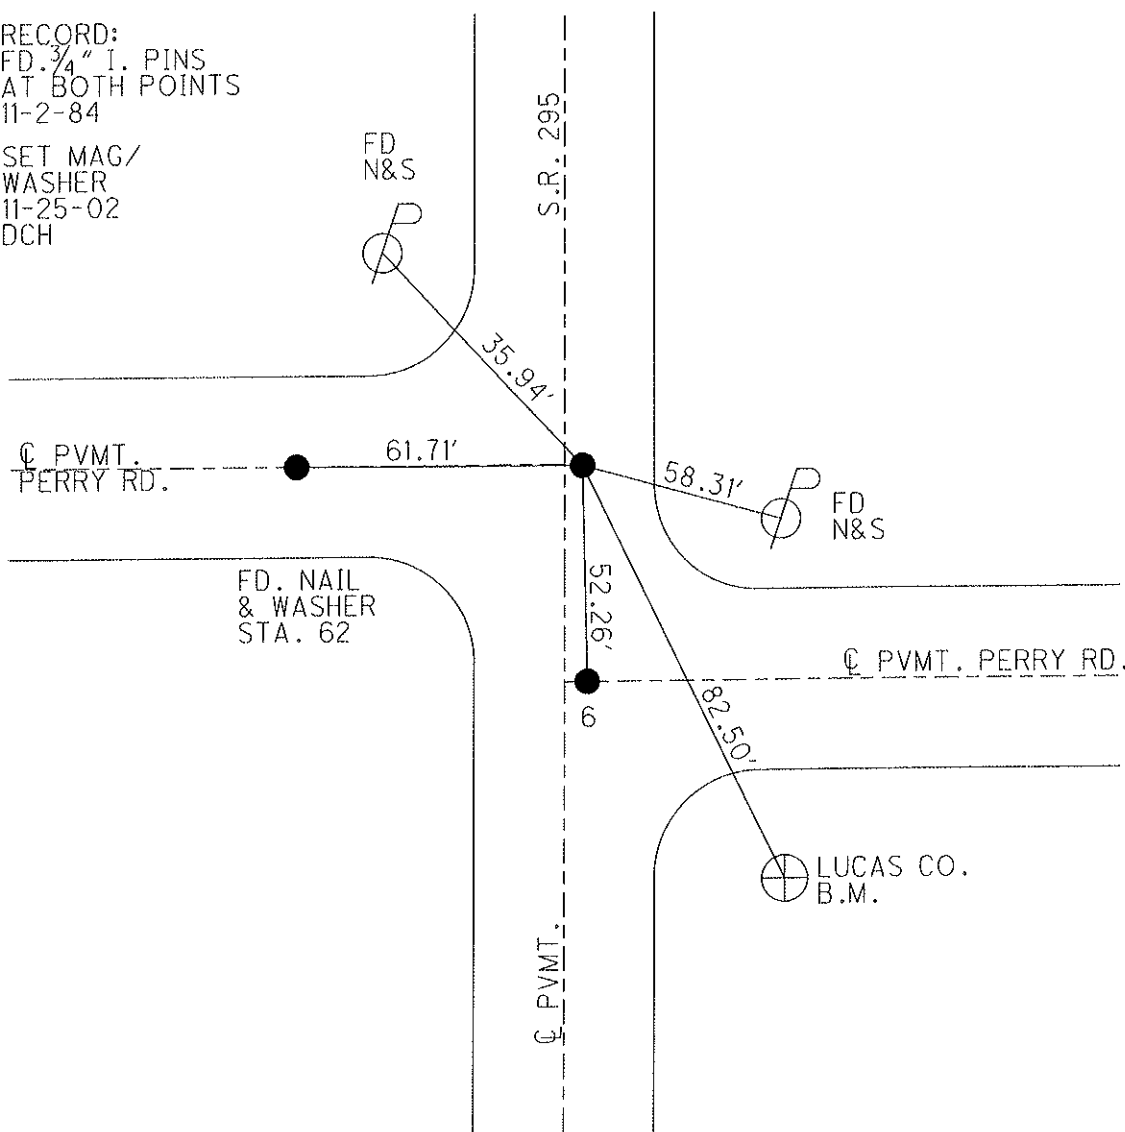

O.D.O.T. DISTRICT 2 SURVEY OFFICE

PERSONNEL

REFERENCE NO. 6&7

SHEET 6 OF 40

NOTES HOMAN

DATE 8-29-02

ROUTE S.R. 295

H.C. HOMAN

WEATHER CLOUDY

COUNTY LUCAS

R.C. BEAUMONT

TEMP. 78°

TOWNSHIP PROVIDENCE

SECTION 22

T 6 N R 9 E


TYPE MONUMENT 3/4" I. PIN & PK NAIL

ON SURFACE - BELOW ON SURFACE

LEFT - Q PAV'T - RIGHT 2' RIGHT


9.5' TO RT. EDGE PAVEMENT

S.L.M. 113+71 & 114+52

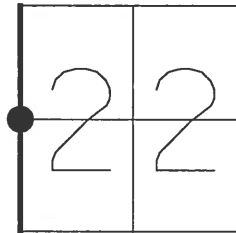

SET MAGS &
WASHERS
11-25-02
DCH

RECORD: FD. 3/4" I. PINS
AT BOTH POINTS
11-2-84

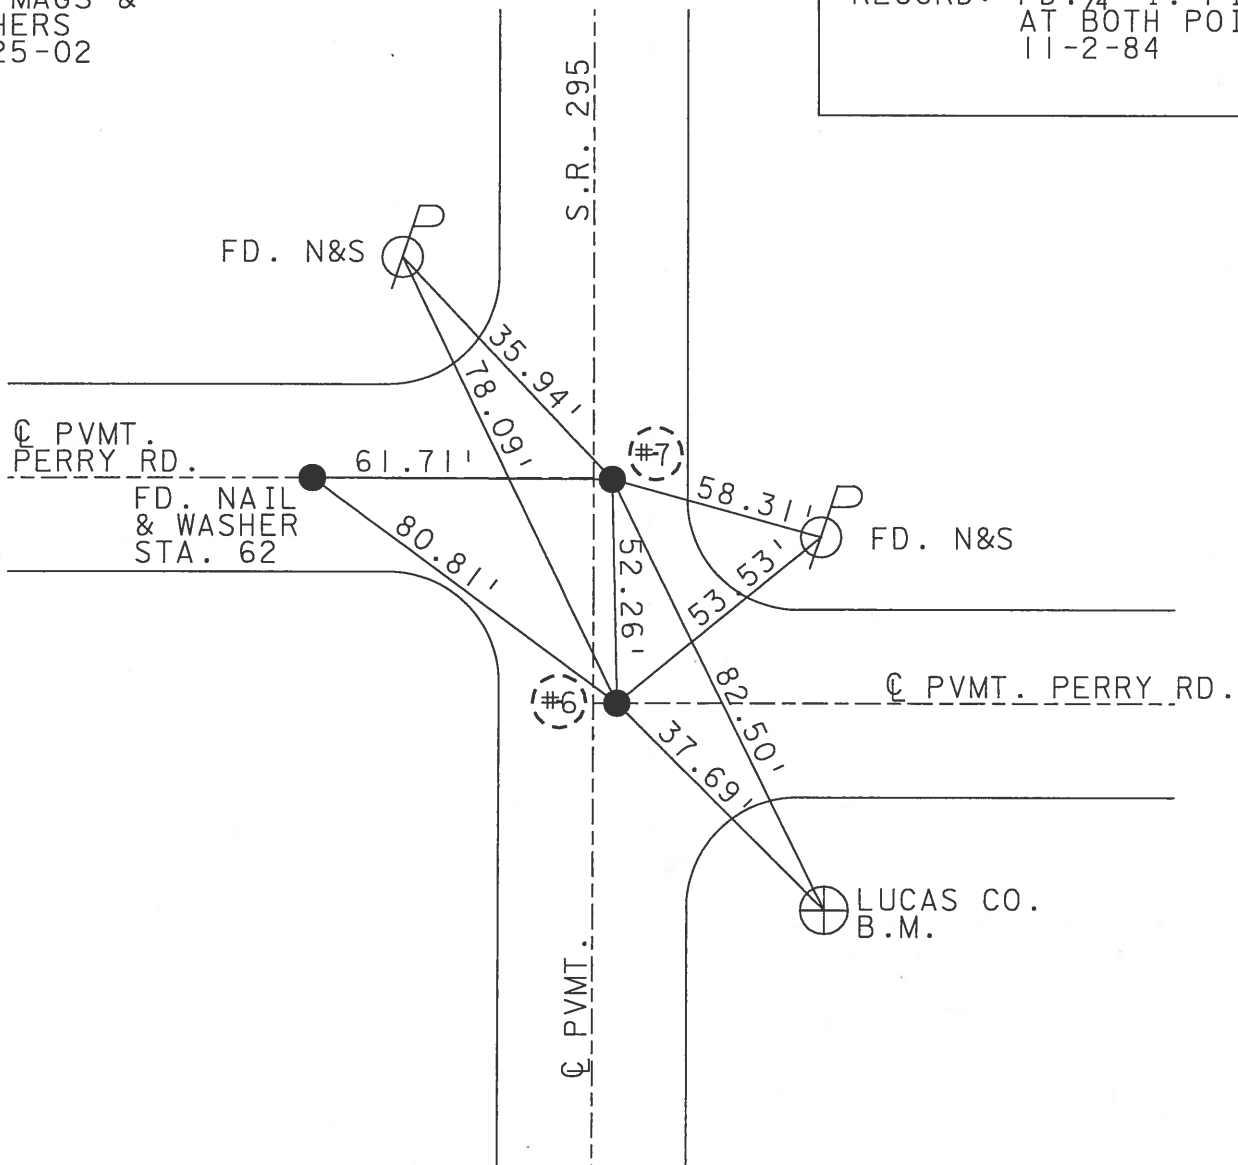

Q.D.O.T. DISTRICT 2 SURVEY OFFICE

SHEET 5 OF

County Lucas S.R. 295

Township Providence

Section 22

T.N., R.E

Personnel I. Stone


P. Neuse

D. Curtis


Date 3 April 84

Weather Cloudy

Temp. 45°

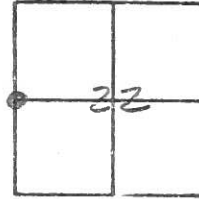

Ref. No. 6 & 7

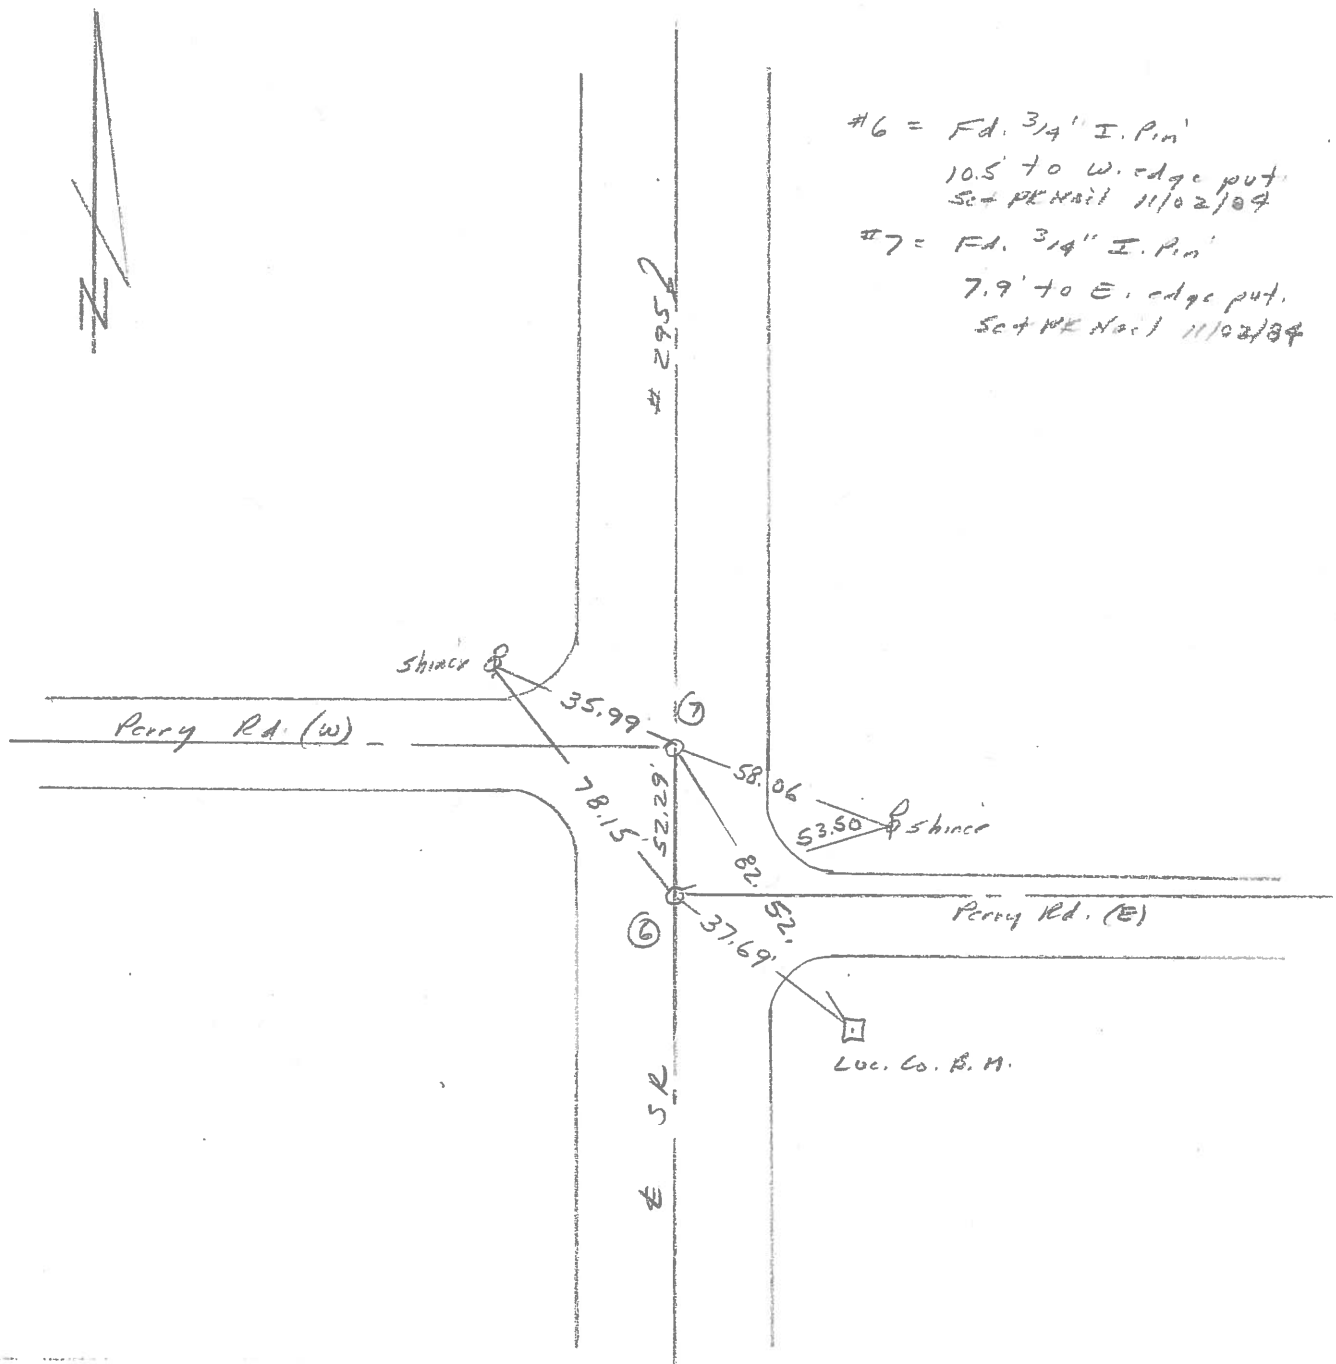

PERSONNEL TITLE PERSONNEL TITLE

W. DENNO

COUNTY LUCAS

DATE JULY 13, 1971

D. CURTIS

S. R. #295

WEATHER CLOUDY

D. STEVENS

SEC.

TEMP. 70 ±

R. BRANNAN

DESCRIPTION REFERENCES TO CONTROL POINTS

JOB NO.

LEFT

CENTER LINE

RIGHT

5



SHINER

IN 48" TREE



21.85 (D)

31.40 (D)

CORNER OF ROAD POST

BAILEY RD.

41.38 (D)

SHINER



S.R. #295

FD. PK NAIL TO SURFACE
8.75' TO E. EDGE PVT
7.40' TO W. EDGE PVT

6



SHINER



37.05 (D)

79.29 (D)

PERRY RD. WEST

FD. RR SPIKE TO SURFACE
PERRY RD. WEST
10.5' TO W. EDGE PVT.
7.6' TO E. EDGE PVT.

52.29

82.52 (D)

57 (D)

SHINER

PERRY RD. EAST

37.71 (D)

LU. CO. BM

FD. RR SPIKE TO SURFACE
PERRY RD. EAST
10.2' TO W. EDGE PVT.
7.6' TO E. EDGE PVT.

S.R. #295

7

PERSONNEL	TITLE	PERSONNEL	TITLE	COUNTY	DATE	WEATHER	TEMP.
Stone	Notes			Lucas	6 June 68	Hot	87°
Beck	Tap			S. R. # 235			
Michaelak	Tap			SEC			

DESCRIPTION References to Control Points JOB NO. _____

