

O.D.O.T. DISTRICT 2 SURVEY OFFICE (USE ONLY)

PERSONNEL

REFERENCE NO. 8

SHEET 8 OF 45

NOTES PRESTON-COLVIN

DATE 10-2-24

ROUTE SR 295

H.C. PRESTON-COLVIN

WEATHER SUNNY

COUNTY LUCAS

R.C. NEISE

TEMP. 70°

TOWNSHIP PROVIDENCE

DWG BY PRESTON-COLVIN

PID PAVING TRAIN

SECTION 22

T 6 N R 9 E

TYPE MONUMENT MAG/WASHER

ON SURFACE - ~~BELOW~~ ON

OFFSET Q PAVEMENT 5' LT : ~~RT~~

6' TO LT EDGE PAVEMENT

STATION: 271+22.15

HORIZ.DATUM: NAD83(2011)


GEOID: NAVD88 2018

GRID: NORTHING: 661102.719


EASTING: 1605103.667

LDP: NORTHING: 282095.730

EASTING: 115772.207

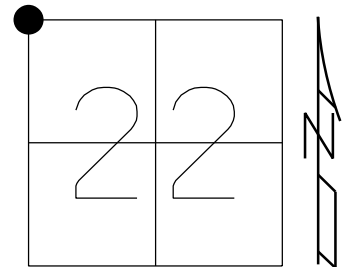

RECORD:
FD STONE
SET P.K.NAIL
1/13/97, KAUFMAN
FD P.K.NAIL
8/29/02, DCH
SET MAG/WASHER
11/25/02, DCH
FD DRILLHOLE
IN CONCRETE
REF28
12/4/15, JLL
SET MAG/WASHER
7/17/17, DCH
FD MAG/WASHER
REF8
5-3-23, TDN
9-29-23, JAM
FD MAG/W
6/17/24, JAB
10/2/24, TDN

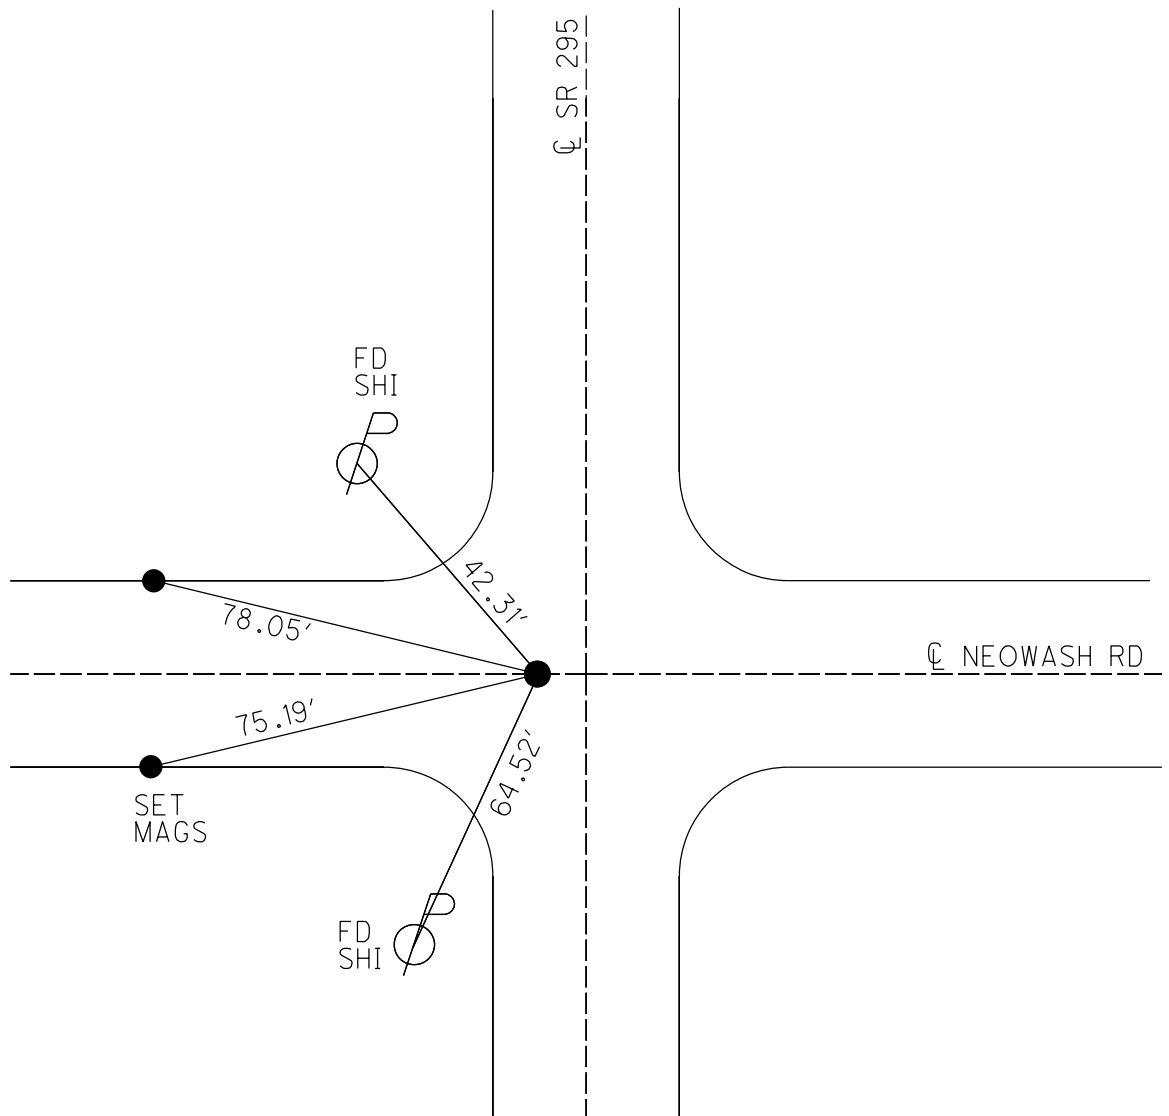

O.D.O.T. DISTRICT 2 SURVEY OFFICE (USE ONLY)

PERSONNEL

REFERENCE NO. 8

SHEET 8 OF 45

NOTES AUBLE

DATE 5-3-23

ROUTE SR 295

H.C. NIESE

WEATHER WINDY

COUNTY LUCAS

R.C. MILLER

TEMP. 49°

TOWNSHIP PROVIDENCE

DWG BY ASTON

PID CHIP SEAL

T 6 N R 9 E

TYPE MONUMENT MAG/WASHER

ON SURFACE - ~~BELOW~~ ON

OFFSET CL PAVEMENT 5' LT : ~~RT~~

6' TO LT EDGE PAVEMENT


STATION: 271+22.15

HORZ.DATUM: NAD83(2011)

GEOID: NAVD88 2018


GRID: NORTHING: 661102.719

EASTING: 1605103.667

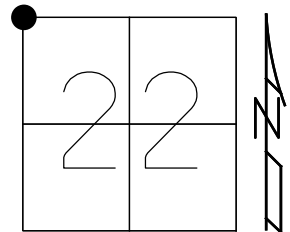

RECORD:
FD STONE
SET P.K.NAIL
1/13/97, KAUFMAN
FD P.K.NAIL
8/29/02, DCH
SET MAG/WASHER
11/25/02, DCH
FD DRILLHOLE
IN CONCRETE
REF28
12/4/15, JLL
SET MAG/WASHER
7/17/17, DCH
FD MAG/WASHER
REF8
5-3-23, TDN
9-29-23, JAM

LUCAS: LDP
N: 282095.730
E: 115772.207

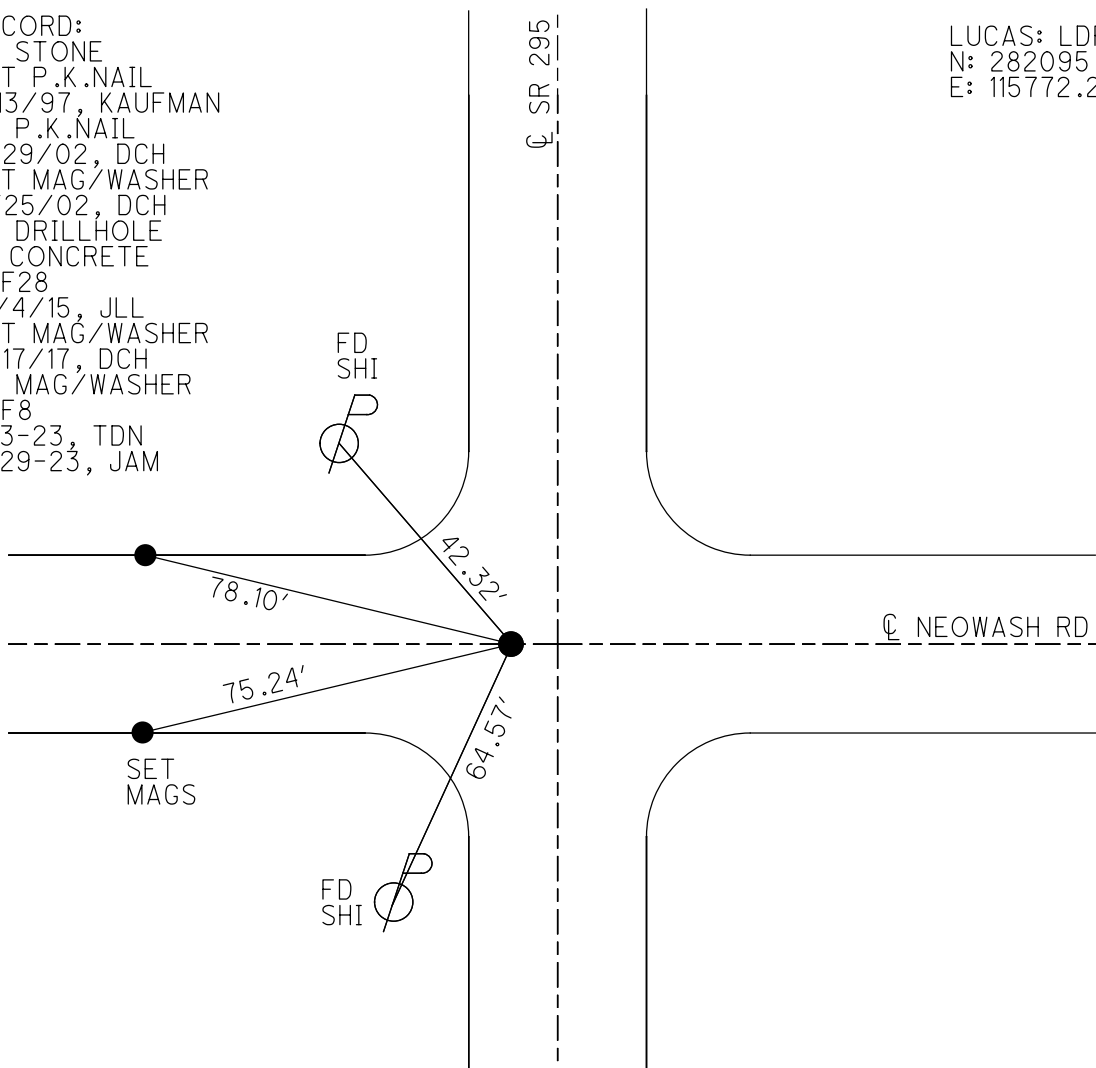

O.D.O.T. DISTRICT 2 SURVEY OFFICE (USE ONLY)

PERSONNEL _____ REFERENCE NO. 8 SHEET 8 OF 45

NOTES HOMAN DATE 3/17/17 ROUTE SR 295

H.C. HOMAN WEATHER CLOUDY COUNTY LUCAS

R.C. HELDMAN TEMP. 33° TOWNSHIP PROVIDENCE

SECTION 22

T 6 N R 9 E

TYPE MONUMENT DRILLH IN CONCRETE


~~ON SURFACE~~ - BELOW 9"

LEFT - Q PAV'T - ~~RIGHT~~ 5'


6' TO LT EDGE PAVEMENT

S.L.M. 271+22.15

GRID: NORTHING: 661102.719 EASTING: 1605103.667

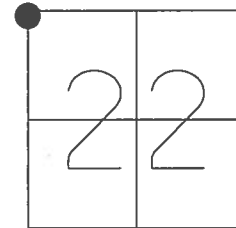

RECORD:
FD STONE
SET P.K.NAIL
1/13/97, KAUFMAN
FD P.K.NAIL
8/29/02, DCH
SET MAG/WASHER
11/25/02, DCH
FD DRILLHOLE
IN CONCRETE
REF28
12/4/15, JLL
SET MAG/WASHER
7/17/17, DCH

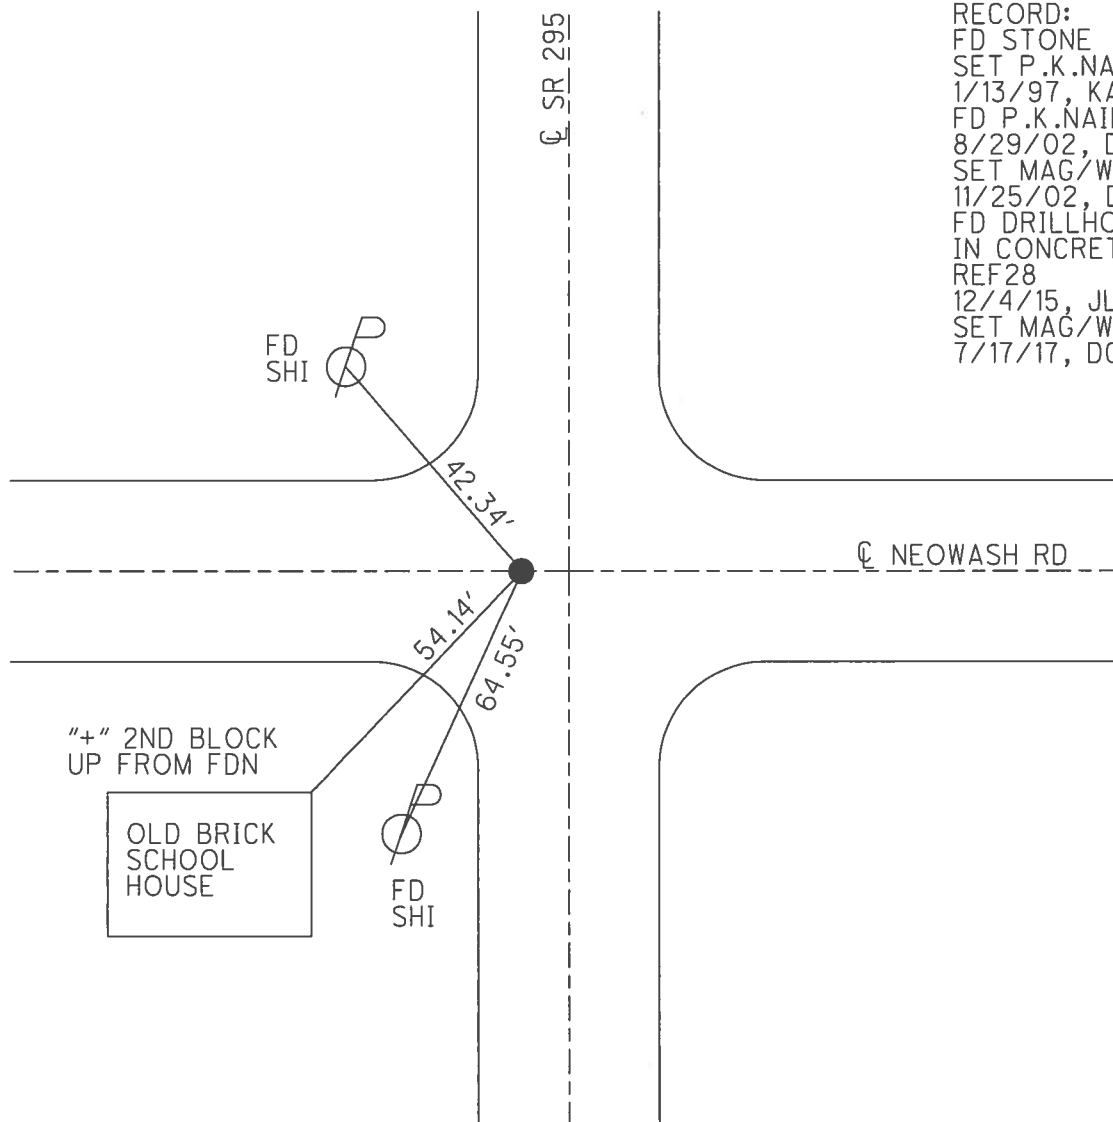

O.D.O.T. DISTRICT 2 SURVEY OFFICE

PERSONNEL

REFERENCE NO. 8

SHEET 8 OF 45

NOTES BEAUMONT

DATE 8-29-02

ROUTE S.R. 295

H.C. HOMAN

WEATHER CLOUDY

COUNTY LUCAS

R.C. BEAUMONT

TEMP. 78°

TOWNSHIP PROVIDENCE

SECTION 22

T 6 N R 9 E


TYPE MONUMENT PK NAIL

ON SURFACE - ~~BELOW~~ ON


LEFT - Q PAV'T - ~~RIGHT~~ 5'

6' TO LT. EDGE PAVEMENT

S.L.M. 140+82

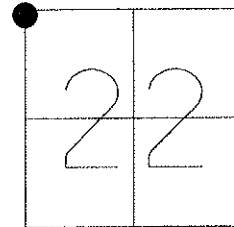

SET MAG &
WASHER
11-25-02
DCH

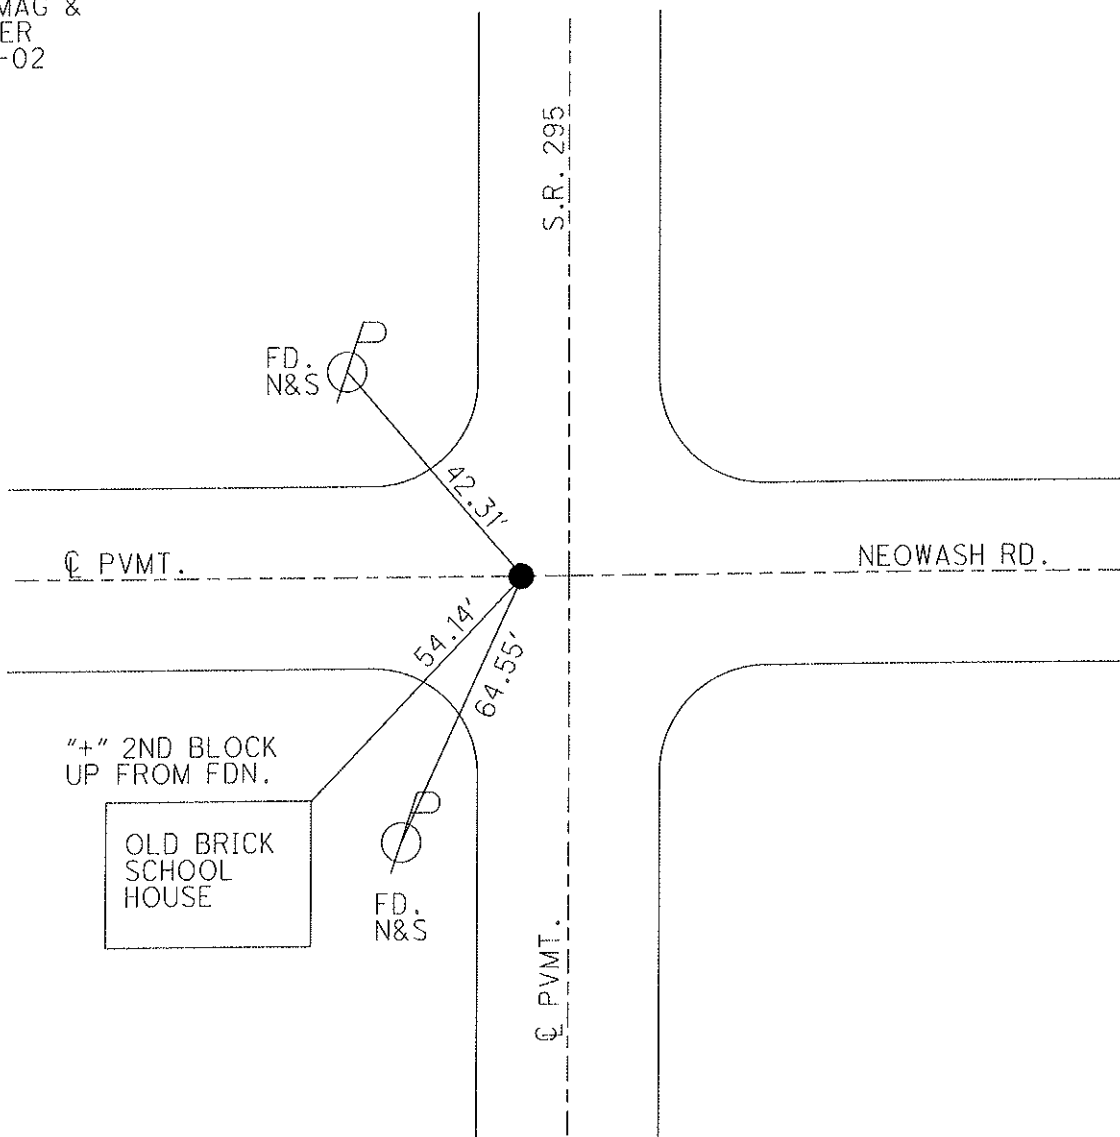

O.D.O.T. DISTRICT 2 SURVEY OFFICE

PERSONNEL

REFERENCE NO. 8

SHEET 6 OF 35

NOTES LOENRKE

H.C. STONE

R.C. CURTIS

DATE 8-16-91

WEATHER CLEAR

TEMP. +78

ROUTE S.R. 295

COUNTY LUCAS

TOWNSHIP PROVIDENCE

SECTION 22

T. 6 N. R. 9 E.



TYPE MONUMENT P.K. Nail.

ON SURFACE - BELLO YES

LEFT-E PAV'T. - RIGHT 5.0 Lt

TO EDGE PAVEMENT

S.L.M. 140+82

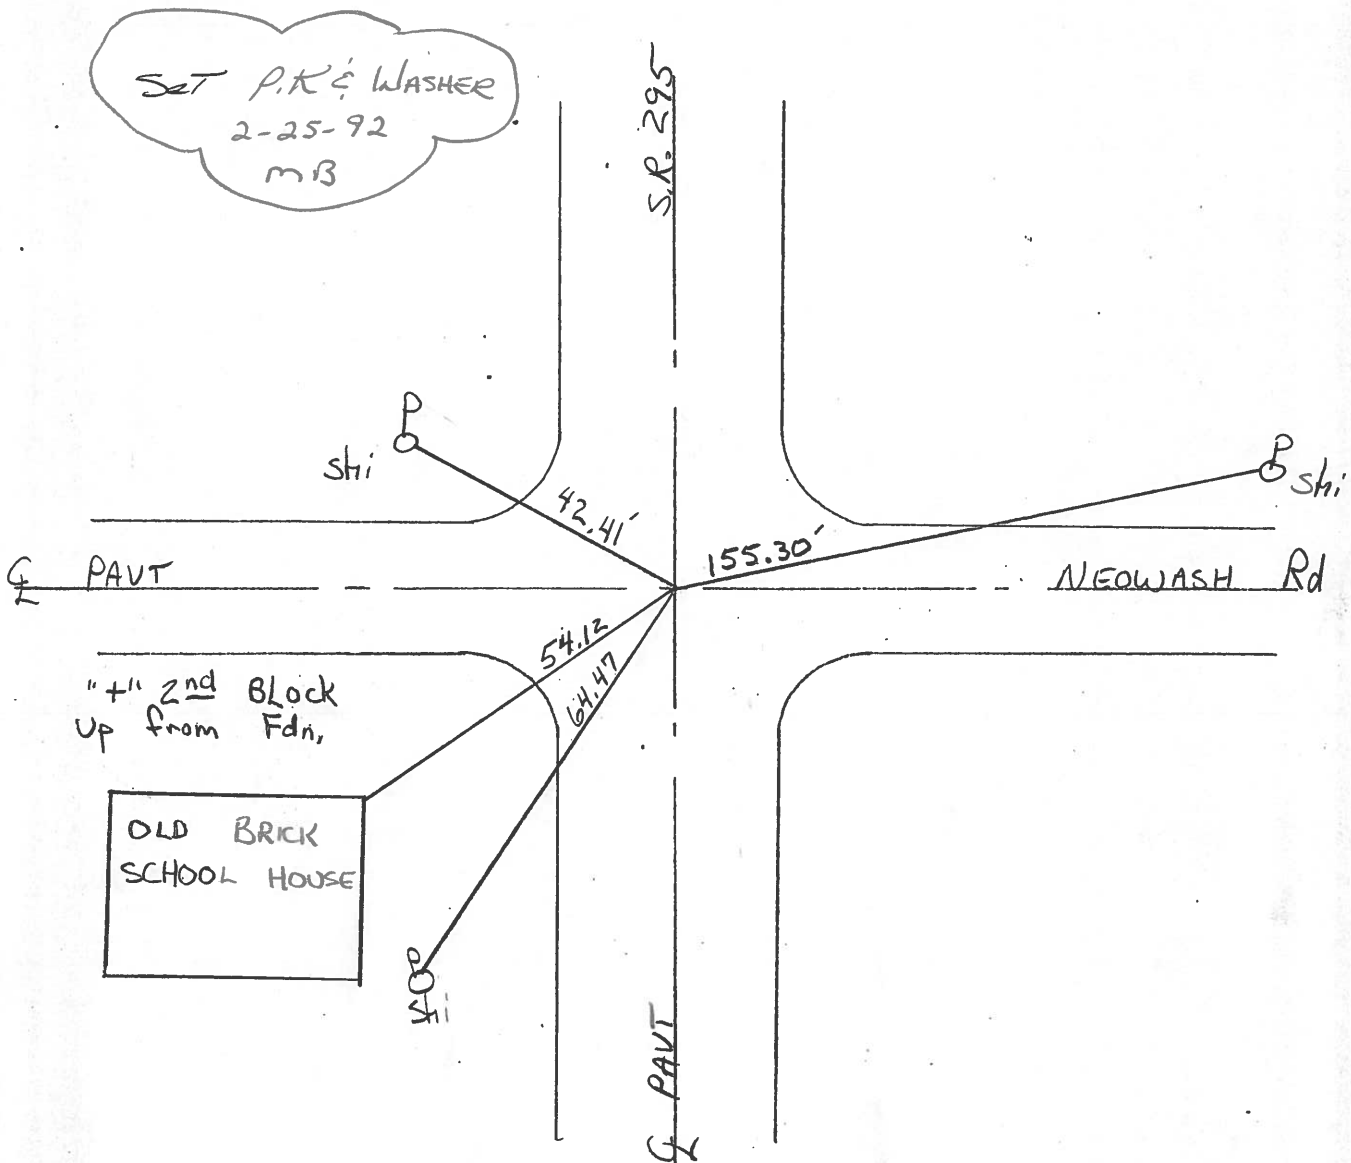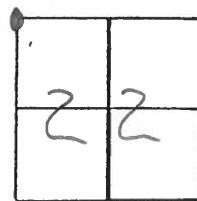

O.D.O.T. DISTRICT 2 SURVEY OFFICE

PERSONNEL

REFERENCE NO. 8

SHEET 1 OF

NOTES 1. Stone

H.C. D. Curtis

R.C. T. Household

DATE 31 May 89

WEATHER Cloudy

TEMP. 80°

ROUTE SR # 295

COUNTY Lucas

TOWNSHIP Providence

SECTION 15-16-21-22

T R

TYPE MONUMENT PK Nail


ON SURFACE - BELOW Surface

LEFT - & PAV'T. - RIGHT

 TO EDGE PAVEMENT

S.L.M.

16	15
21	22

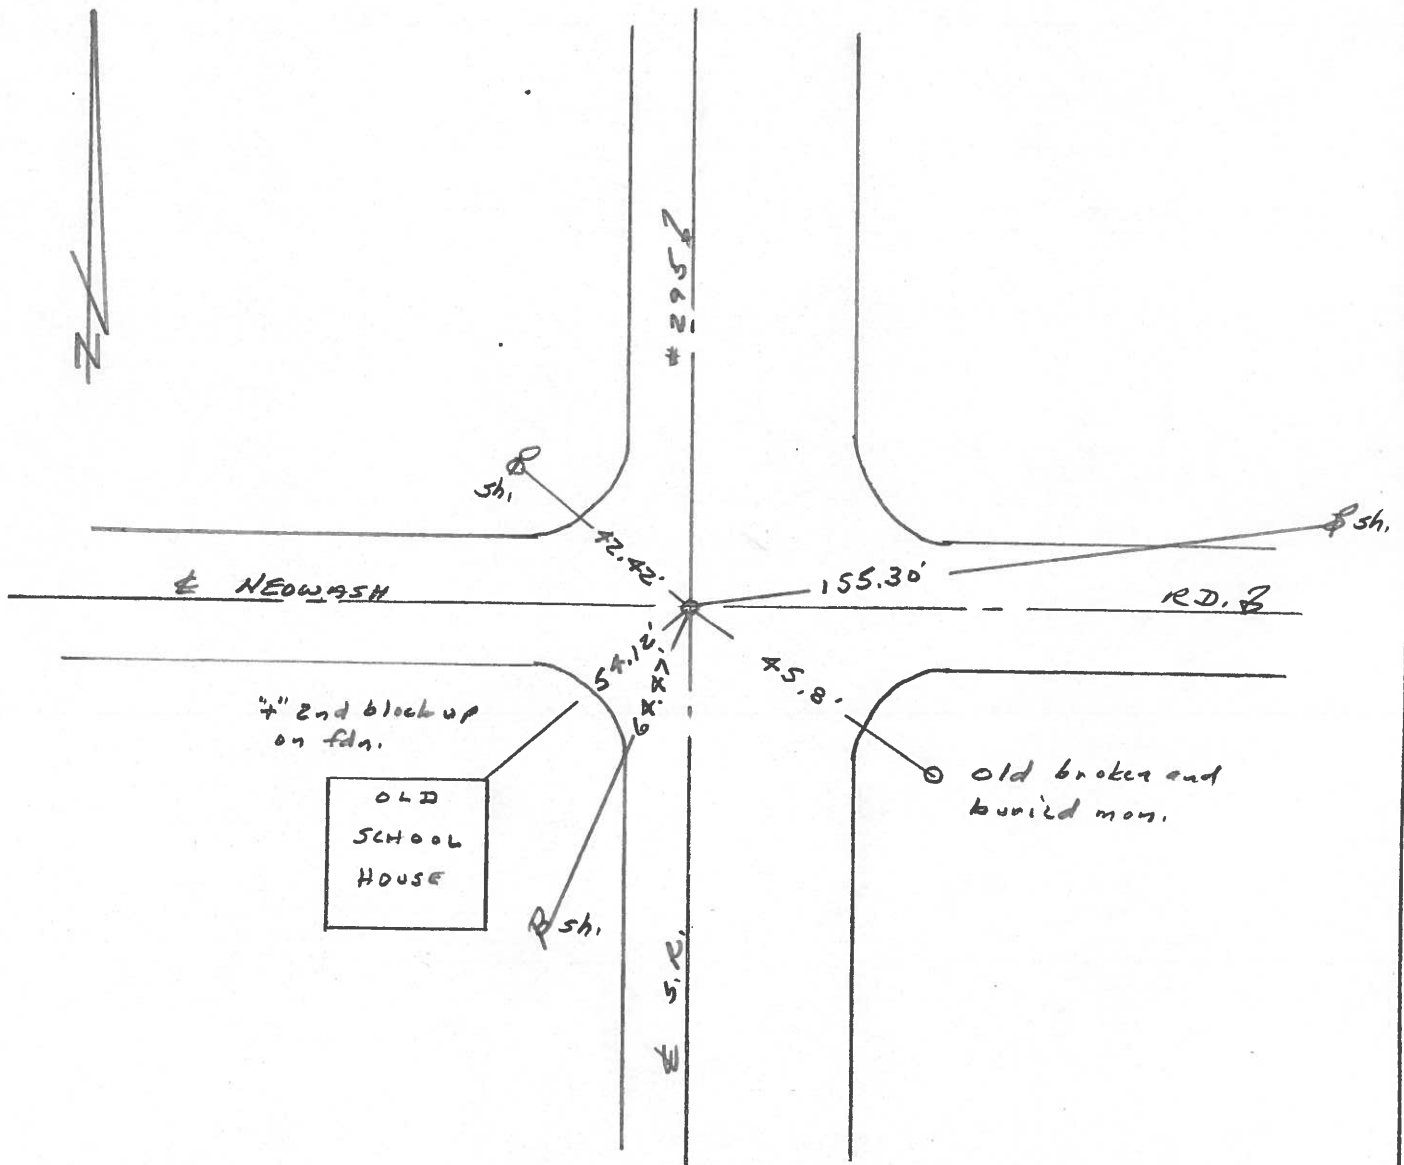

ODOT DISTRICT 2 SURVEY OFFICE

SHEET 1 OF 2


County Lucas S.R. 295
 Township Providence
 Section 15-16-21-22
 T N, R E
 Personnel L. Stone
P. Neuse
D. Curtis

Date 14 April 82
 Weather Sunny
 Temp. 53°

16	15
21	22



REF. NO. 8

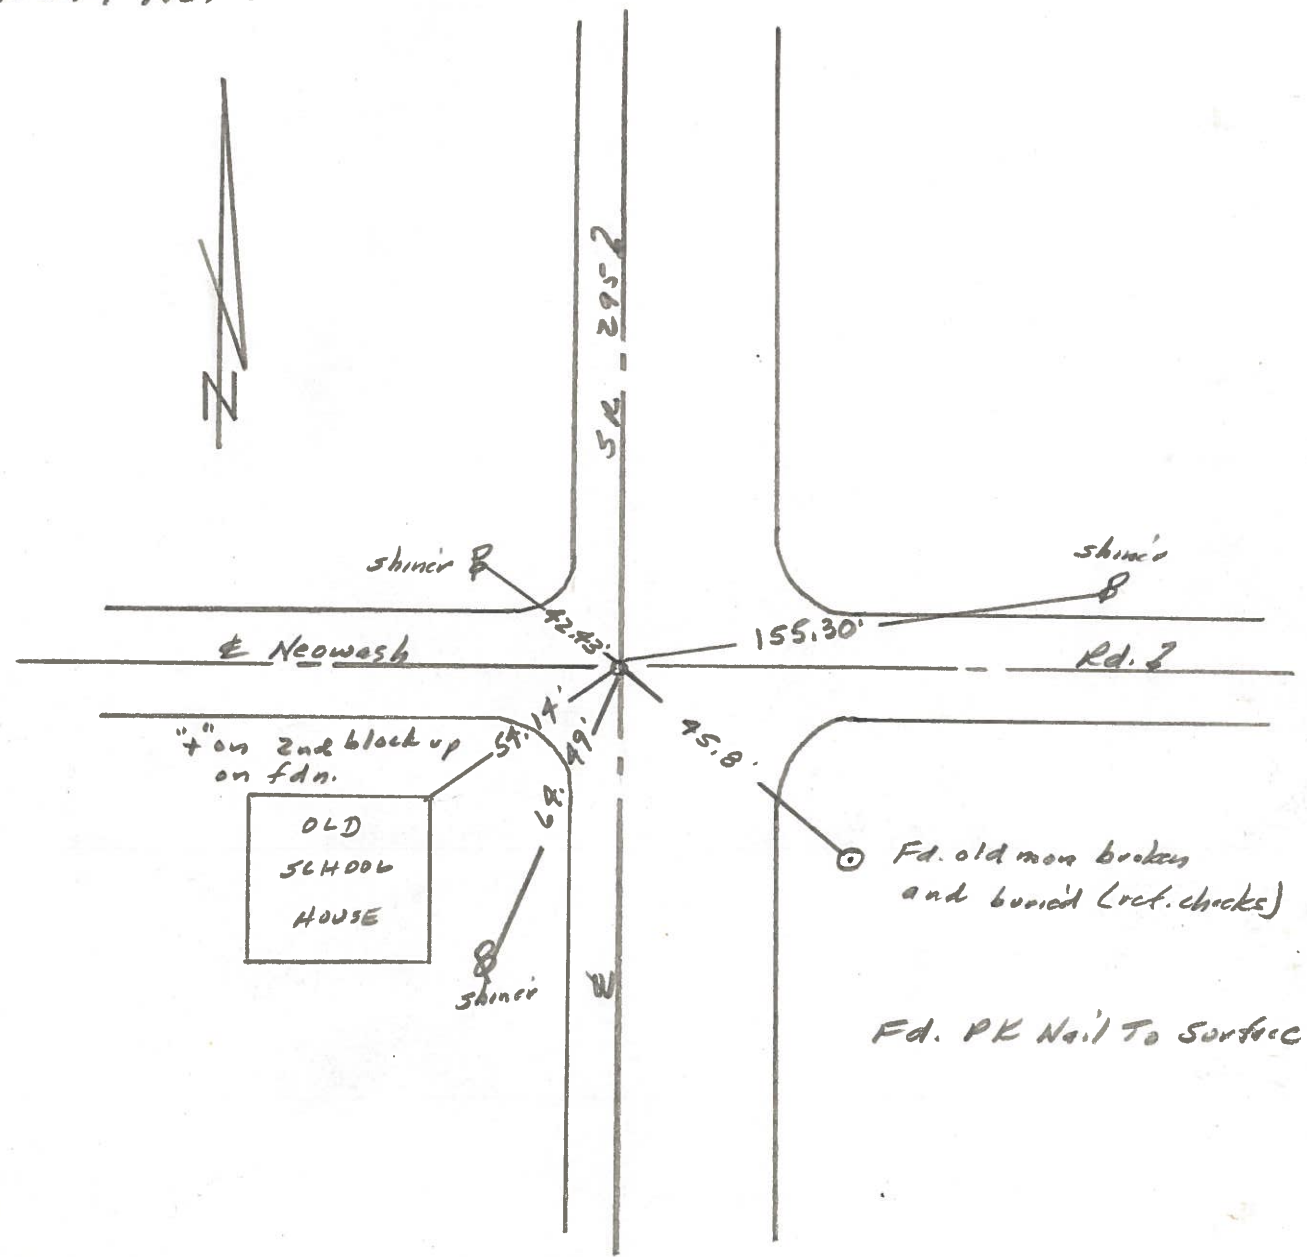

PERSONNEL	TITLE	PERSONNEL	TITLE
Stone	Notes		
Beck	Tape		
Michael	Tape		

COUNTY LucasDATE 6 June 68S. R. # 295WEATHER Hot

SEC. _____

TEMP. 87°

DESCRIPTION

References to Control Points

LEFT CENTER LINE RIGHT

JOB NO. _____

