

O.D.O.T. DISTRICT 2 SURVEY OFFICE (USE ONLY)

PERSONNEL

REFERENCE NO. 9

SHEET 9 OF 45

NOTES PRESTON-COLVIN

DATE 10-2-24

ROUTE SR 295

H.C. PRESTON-COLVIN

WEATHER SUNNY

COUNTY LUCAS

R.C. NEISE

TEMP. 70°

TOWNSHIP PROVIDENCE

DWG BY PRESTON-COLVIN

PID PAVING TRAIN

SECTION 15

T 6 N R 9 E

TYPE MONUMENT MAG/WASHER

ON SURFACE - ~~BELOW~~ ON

OFFSET CL PAVEMENT 4.5' LT : ~~RT~~

6' TO LT EDGE PAVEMENT

STATION: 295+75.45

HORIZ.DATUM: NAD83(2011)


GEOID: NAVD88 2018

GRID: NORTHING: 663755.994


EASTING: 1605092.744

LDP: NORTHING: 284748.936

EASTING: 115726.419

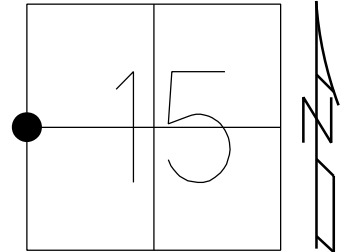

RECORD:
FD P.K.NAIL
8/29/02, DCH
SET MAG/WASHER
11/25/02, DCH
FD MAG NAIL
REF29
12/4/15, JLL
SET MAG/WASHER
7/17/17, DCH
FD MAG/WASHER
REF9
5-3-23, TDN
9-29-23, JAM
FD MAG/WASHER
6/17/24, JAB
10/2/24, TDN

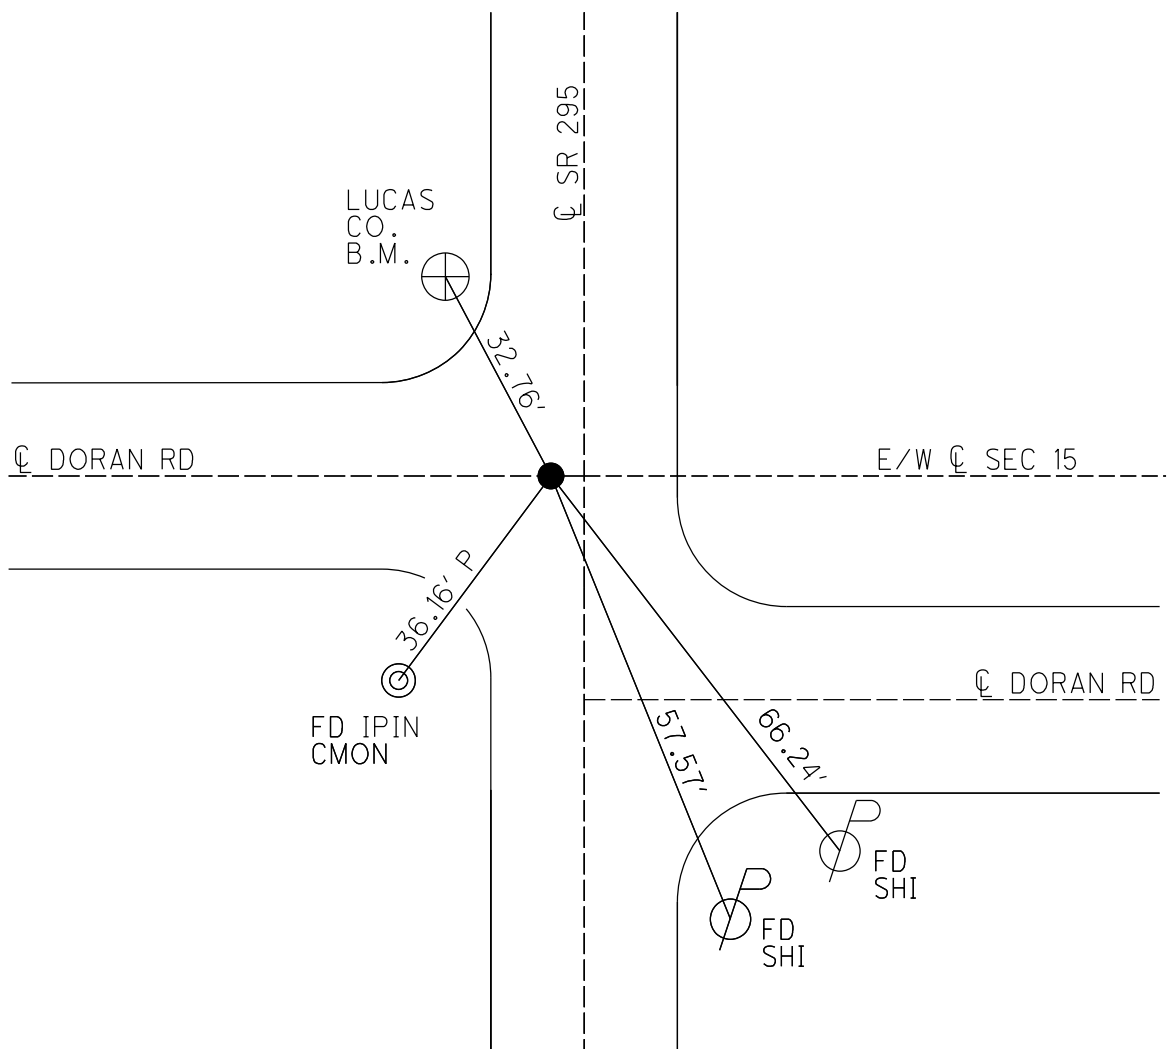

O.D.O.T. DISTRICT 2 SURVEY OFFICE (USE ONLY)

PERSONNEL

REFERENCE NO. 9

SHEET 9 OF 45

NOTES AUBLE

DATE 5-3-23

ROUTE SR 295

H.C. NIESE

WEATHER WINDY

COUNTY LUCAS

R.C. MILLER

TEMP. 49°

TOWNSHIP PROVIDENCE

DWG BY ASTON

PID CHIP SEAL

SECTION 15

T 6 N R 9 E

TYPE MONUMENT MAG/WASHER

ON SURFACE - ~~BELOW~~ ON

OFFSET ¢ PAVEMENT 4.5' LT : ~~RT~~

TO EDGE PAVEMENT


STATION: 297+75.45

HORIZ.DATUM: NAD83(2011)

GEOID: NAVD88 2018


GRID: NORTHING: 663755.994

EASTING: 1605092.744

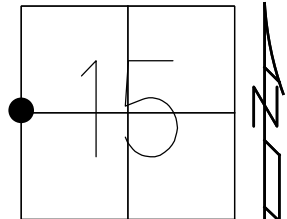

RECORD:
FD P.K.NAIL
8/29/02, DCH
SET MAG/WASHER
11/25/02, DCH
FD MAG NAIL
REF29
12/4/15, JLL
SET MAG/WASHER
7/17/17, DCH
FD MAG/WASHER
REF9
5-3-23, TDN
9-29-23, JAM


LUCAS: LDP
N: 284748.936
E: 115726.419

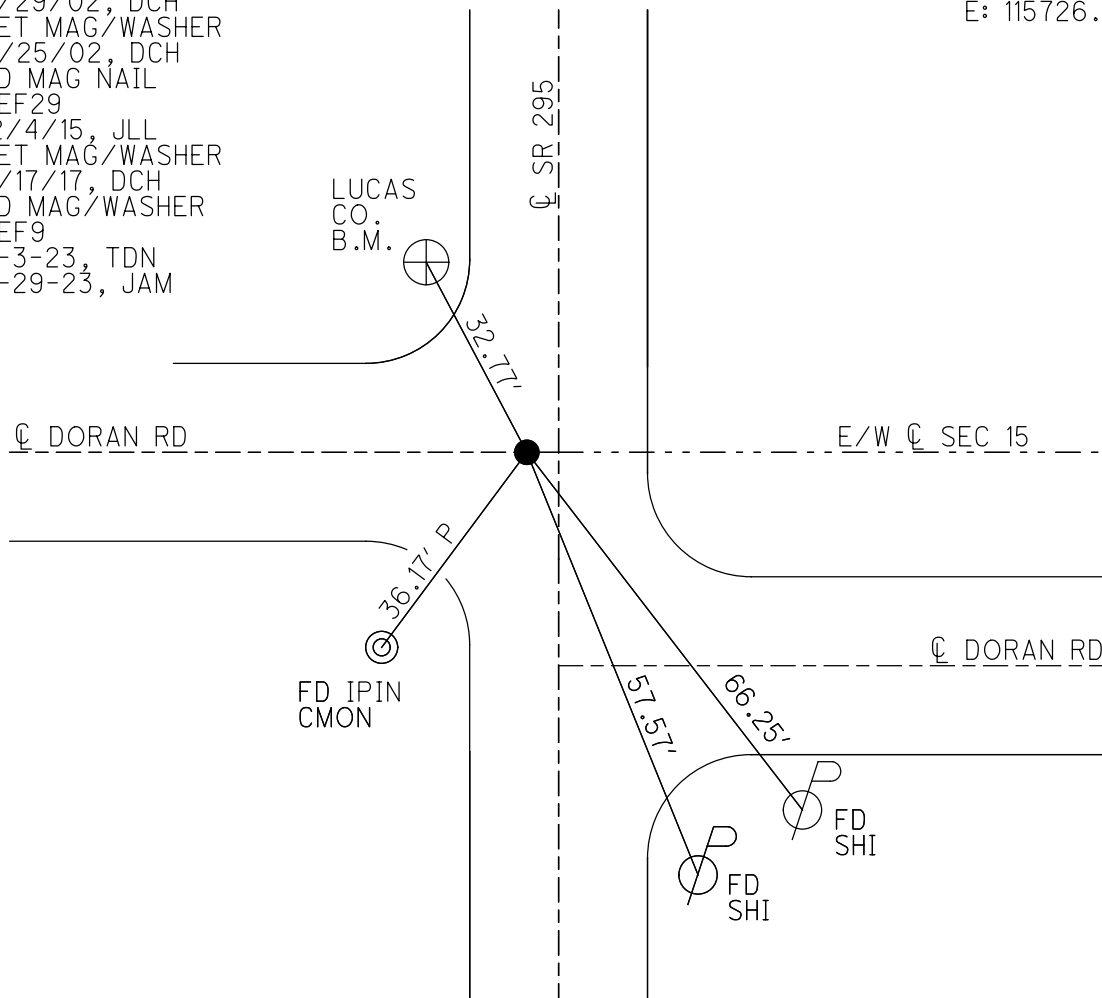


PERSONNEL		REFERENCE NO.	9	SHEET	9	OF	45
NOTES	HOMAN	DATE	3/17/17	ROUTE	SR 295		
H.C.	HOMAN	WEATHER	CLOUDY	COUNTY	LUCAS		
R.C.	HELDMAN	TEMP.	33°	TOWNSHIP	PROVIDENCE		
				SECTION	15		
				T	6	N	R 9 E

TYPE MONUMENT MAG NAIL
ON SURFACE - ~~BELOW~~ ON
LEFT - C PAV'T - ~~RIGHT~~ 4.5'
- TO - EDGE PAVEMENT
S.L.M. 297+75.45

GRID: NORTHING: 663755.994 EASTING: 1605092.744

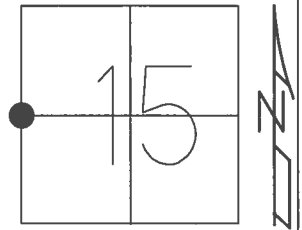

RECORD:
FD P.K.NAIL
8/29/02, DCH
SET MAG/WASHER
11/25/02, DCH
FD MAG NAIL
REF29
12/4/15, JLL
SET MAG/WASHER
7/17/17, DCH

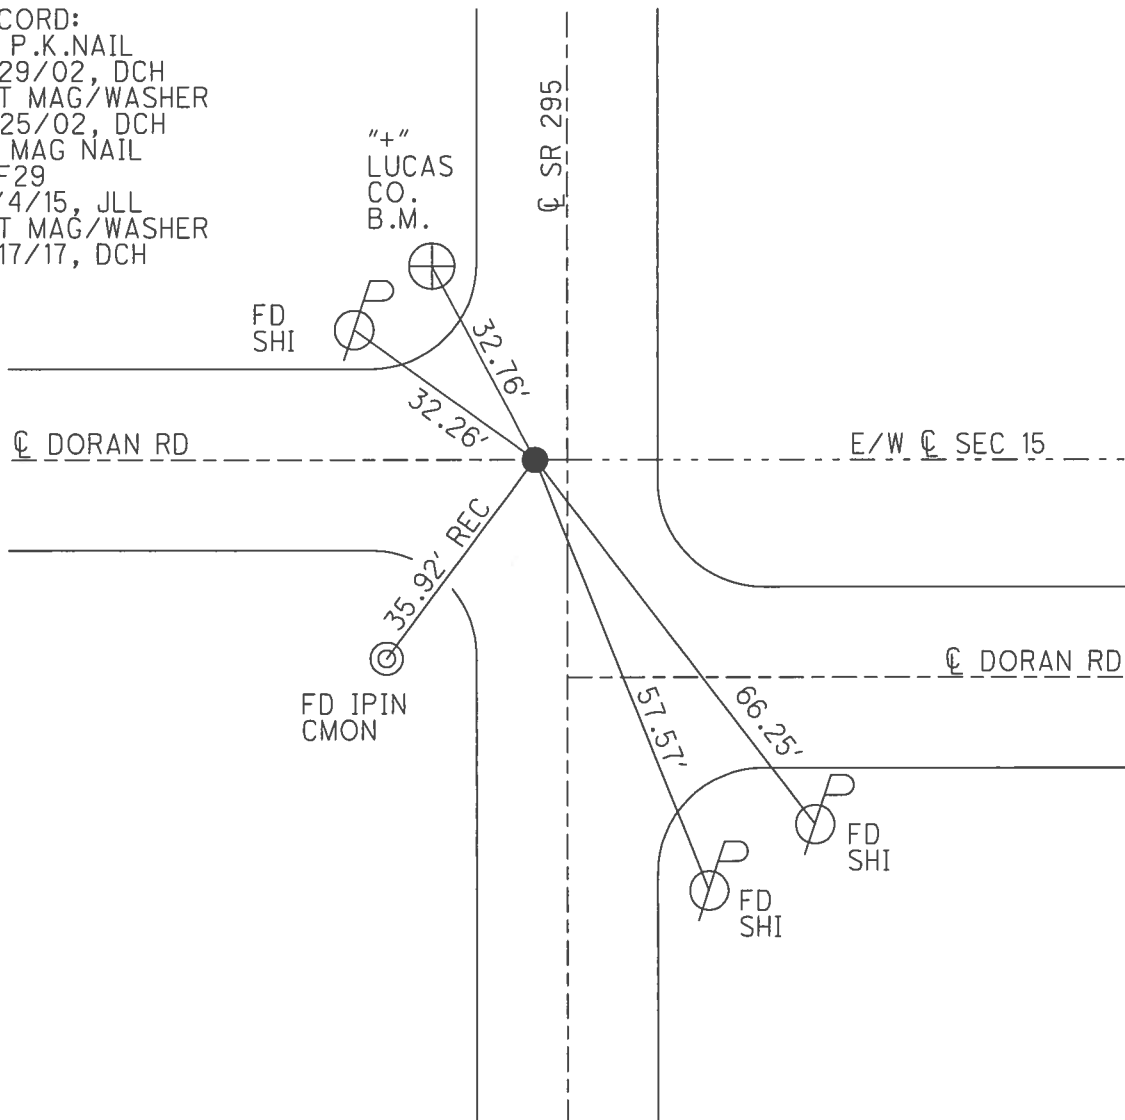

O.D.O.T. DISTRICT 2 SURVEY OFFICE

PERSONNEL

REFERENCE NO. 9

SHEET 9 OF 45

NOTES BEAUMONT

DATE 8-29-02

ROUTE S.R. 295

H.C. HOMAN

WEATHER CLOUDY

COUNTY LUCAS

R.C. BEAUMONT

TEMP. 79°

TOWNSHIP PROVIDENCE

SECTION 15

T 6 N R 9 E


TYPE MONUMENT P.K NAIL

ON SURFACE - ~~BELOW~~ ON


LEFT - Q PAV'T - ~~RIGHT~~ 4.5'

TO EDGE PAVEMENT

S.L.M. 167+38

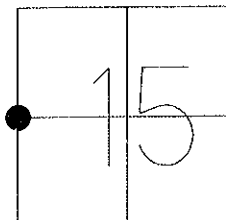

SET MAG &
WASHER
11-25-02
DCH

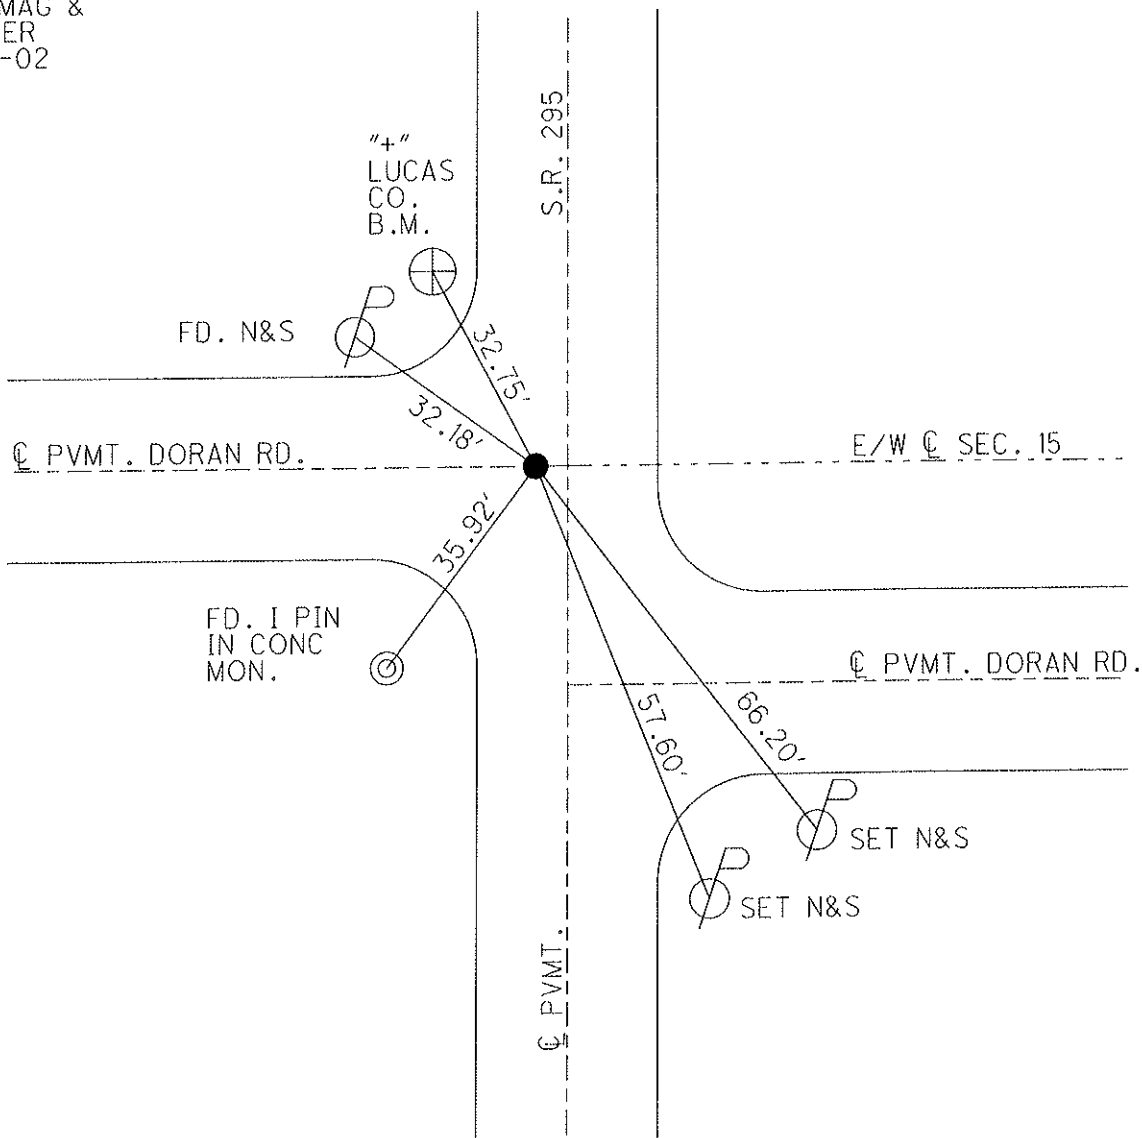

O.D.O.T. DISTRICT 2 SURVEY OFFICE

PERSONNEL

REFERENCE NO. 9

SHEET 7 OF 35

NOTES LOEHRKE

H.C. STONE

R.C. CURTIS

DATE 8-16-91

WEATHER CLEAR

TEMP. +80

ROUTE S.R. 295

COUNTY LUCAS

TOWNSHIP PROVIDENCE

SECTION 15

T6 N R 9 E


TYPE MONUMENT P.K. Nail

ON SURFACE - BELOW YES

LEFT- C PAV'T. - RIGHT

TO EDGE PAVEMENT

S.L.M. 167+38

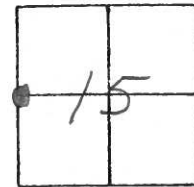

Set P.K. & WASHER
2-25-92
mB

"+" Lucas Co.
B.M.

Shi

32.73'

32.07'

35.89'

48.01'

67.28'

I, PIN in
CONC. MON.

Shi

"+" CONC. MON. (3' from guy wire)

E PAV'T DORAN Rd

E/W E Sec. 15

E PAV'T DORAN Rd

O.D.O.T. DISTRICT 2 SURVEY OFFICE

PERSONNEL

REFERENCE NO. 9

SHEET 2 OF

NOTES 1. Stone

H.C. D. Curtis

R.C. J. Hirschfelder

DATE 31 May 89

WEATHER Cloudy

TEMP. 800

ROUTE SR # 295

COUNTY Lucas

TOWNSHIP Providence

SECTION 15

T. R.



TYPE MONUMENT PK Nail

ON SURFACE - BELOW Surface

LEFT- & PAW'T. - RIGHT

TO EDGE PAVEMENT

S.L.M.

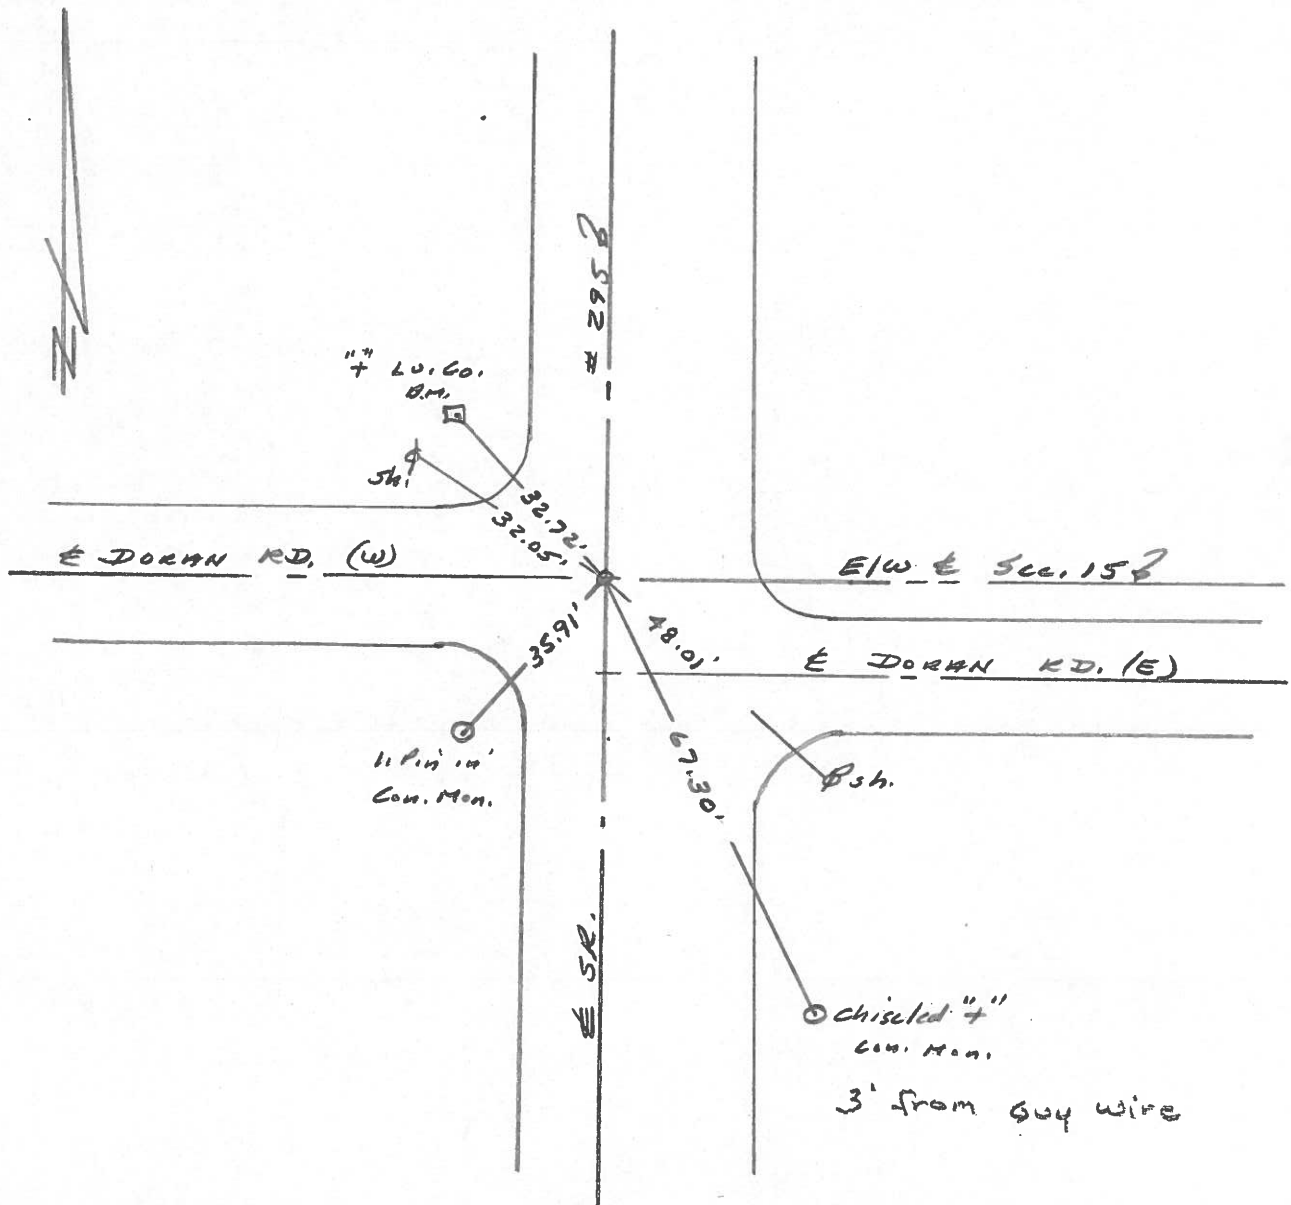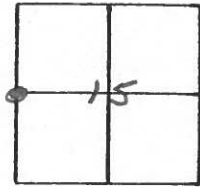

O.D.O.T. DISTRICT 2 SURVEY OFFICE

SHEET 2 OF 2

County Lucas S.R. 295

Date 14 April 82

Township Providence


Weather Sunny

Section 15

Temp. 53°

T N, R E


Personnel I. Stone

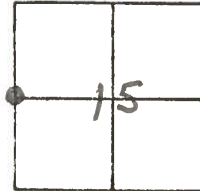

P. Neuse

D. Curtis

REF. NO. 9

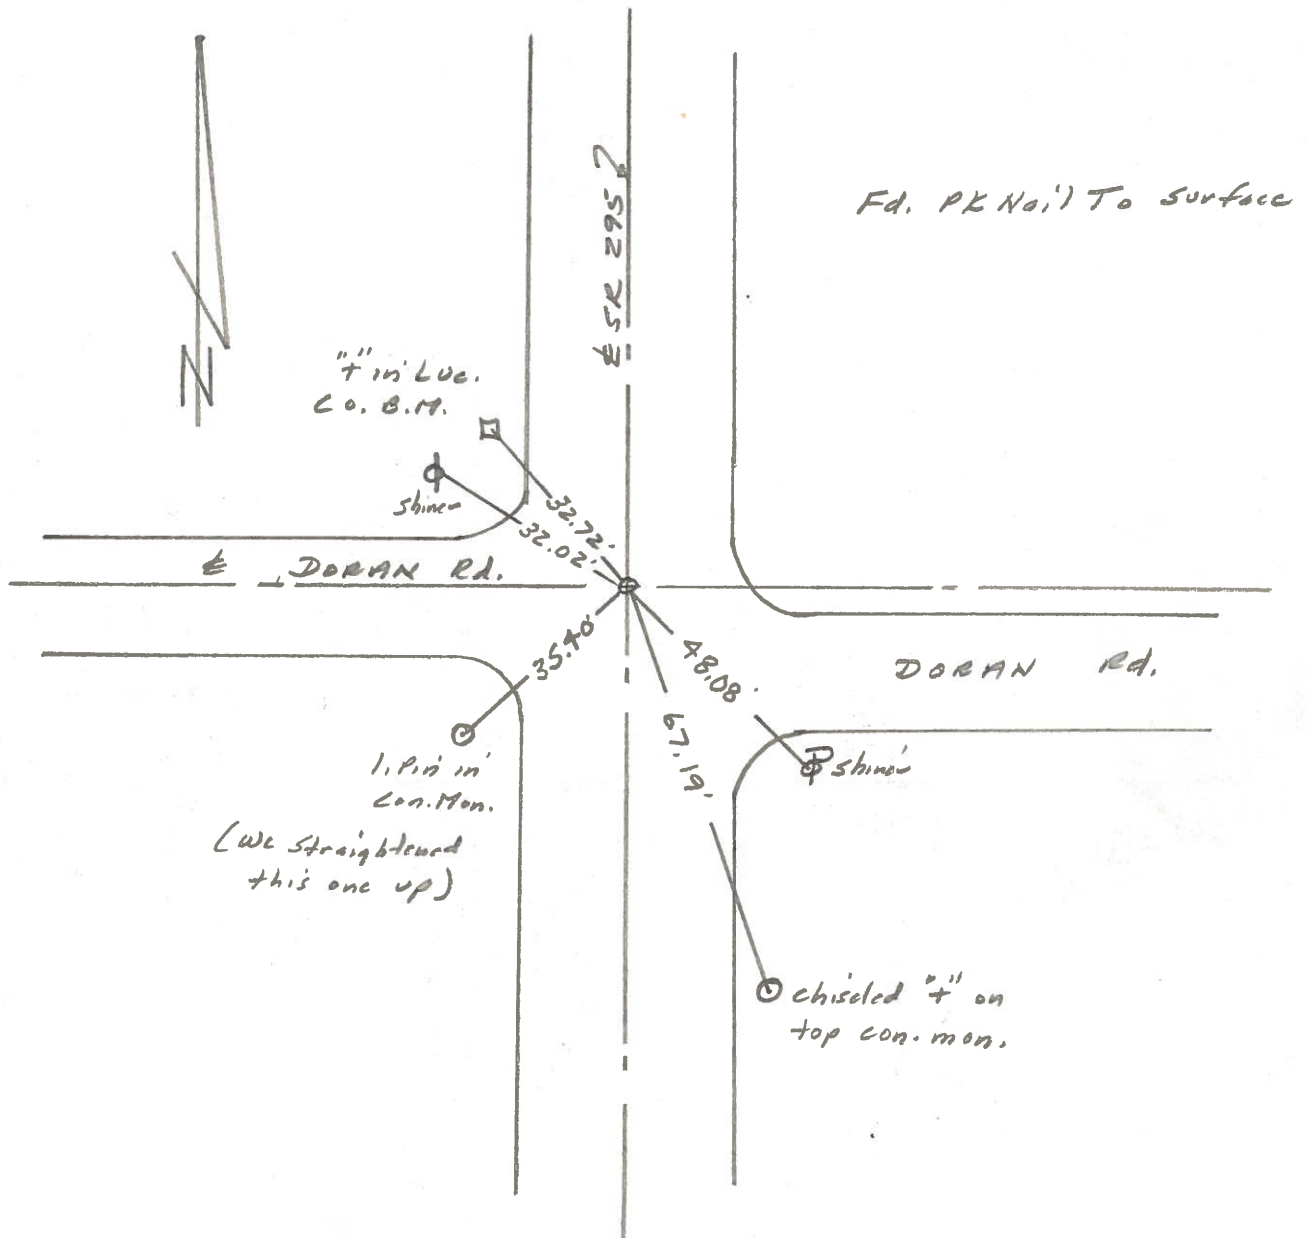

PERSONNEL	TITLE	PERSONNEL	TITLE
Stone	Notes		
Beck	Tape		
Michalok	Tape		

COUNTY Lucas DATE 6 June 68

S. R. # 295 WEATHER Hot

SEC. _____ TEMP. 88°

DESCRIPTION References to Control Points JOB NO. _____

LEFT CENTER LINE RIGHT

