


O.D.O.T. DISTRICT 2 SURVEY OFFICE (USE ONLY)


PERSONNEL	REFERENCE NO. <u>14</u>	SHEET <u>15</u> OF <u>45</u>
NOTES <u>BARRIERE</u>	DATE <u>6/10/24</u>	ROUTE <u>SR 295</u>
H.C. <u>MILLER</u>	WEATHER <u>CLOUDY</u>	COUNTY <u>LUCAS</u>
R.C. <u>BARRIERE</u>	TEMP. <u>56</u>	TOWNSHIP <u>WATERVILLE</u>
		SECTION <u>3</u>
DWG BY <u>BLUBAUGH</u>	PID <u> </u>	T <u>6</u> N R <u>9</u> E

TYPE MONUMENT MAG NAIL
 ON SURFACE - ~~BELOW~~ ON
 OFFSET Q PAVEMENT 1' LT : ~~RT~~
10' TO LT EDGE PAVEMENT
 STATION: 403+90.23

HORZ.DATUM: <u>NAD83 (11)</u>	GEOID: <u>18</u>
GRID: NORTHING: <u>674370.582</u>	EASTING: <u>1605031.224</u>
LDP: NORTHING: <u>295362.325</u>	EASTING: <u>115525.175</u>

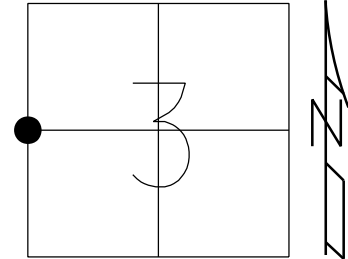


RECORD:
 FD P.K.NAIL
 9/3/02, DCH
 SET MAG/WASHER
 11/21/02, DCH
 FD MAG NAIL
 REF34
 12/4/15, JLL
 SET MAG/WASHER
 7/17/17, DCH
 FD MAG/WASHER
 REF 14
 6/10/24, JAM

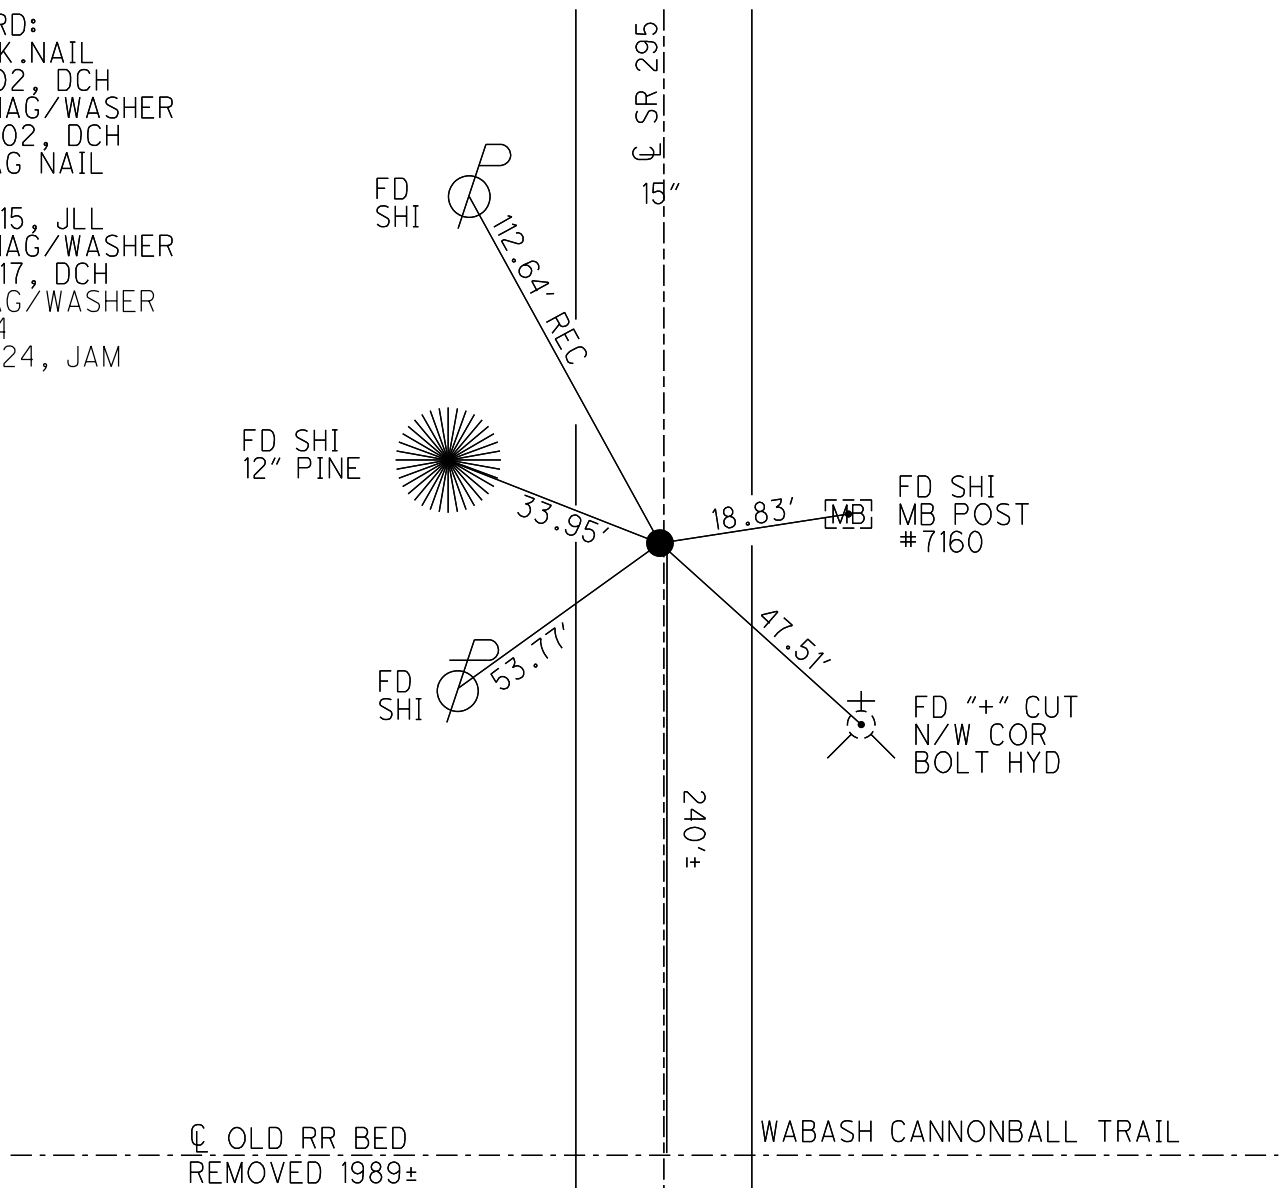

O.D.O.T. DISTRICT 2 SURVEY OFFICE (USE ONLY)


PERSONNEL _____ REFERENCE NO. 14 SHEET 15 OF 45
 NOTES HOMAN DATE 3/22/17 ROUTE SR 295
 H.C. HOMAN WEATHER SUNNY COUNTY LUCAS
 R.C. HELDMAN TEMP. 23° TOWNSHIP WATERVILLE
 _____ SECTION 3
 _____ T 6 N R 9 E

TYPE MONUMENT MAG NAIL
 ON SURFACE - ~~BELOW~~ ON _____
 LEFT - Q PAV'T - ~~RIGHT~~ 1'
10' TO LT EDGE PAVEMENT
 S.L.M. 403+90.23

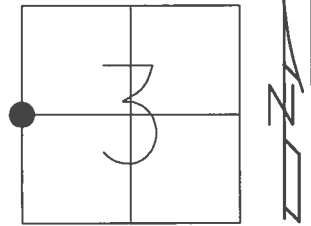

GRID: NORTHING: 674370.582 EASTING: 1605031.224

RECORD:
 FD P.K.NAIL
 9/3/02, DCH
 SET MAG/WASHER
 11/21/02, DCH
 FD MAG NAIL
 REF34
 12/4/15, JLL
 SET MAG/WASHER
 7/17/17, DCH

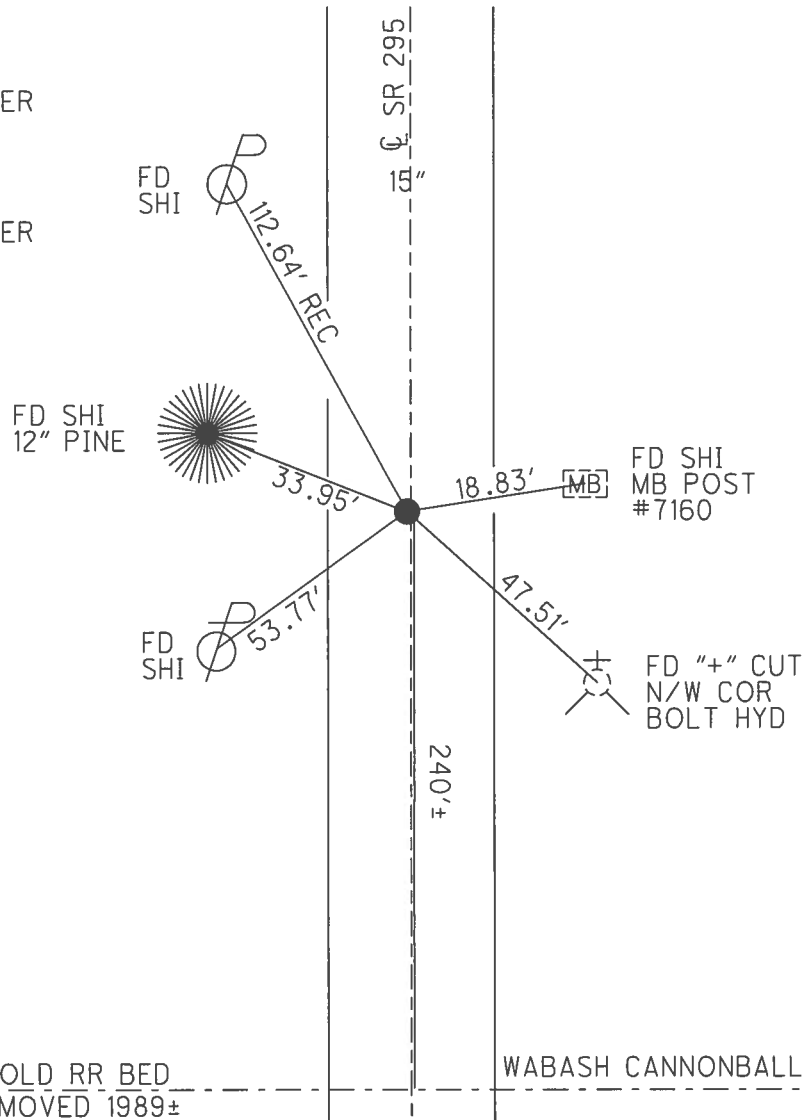

O.D.O.T. DISTRICT 2 SURVEY OFFICE

PERSONNEL

REFERENCE NO. 14

SHEET 15 OF 45

NOTES BEAUMONT

DATE 9-3-02

ROUTE S.R. 295

H.C. HOMAN

WEATHER P. CLOUDY

COUNTY LUCAS

R.C. BEAUMONT

TEMP. 80°

TOWNSHIP WATERVILLE

SECTION 3

T 6 N R 9 E



TYPE MONUMENT P.K. NAIL

ON SURFACE - ~~BELOW~~ ON


LEFT - ℄ PAV'T - ~~RIGHT~~ 1'

10' TO LT. EDGE PAVEMENT

S.L.M. 273+54

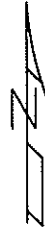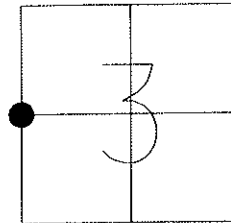

SET MAG &
WASHER
11-25-02
DCH

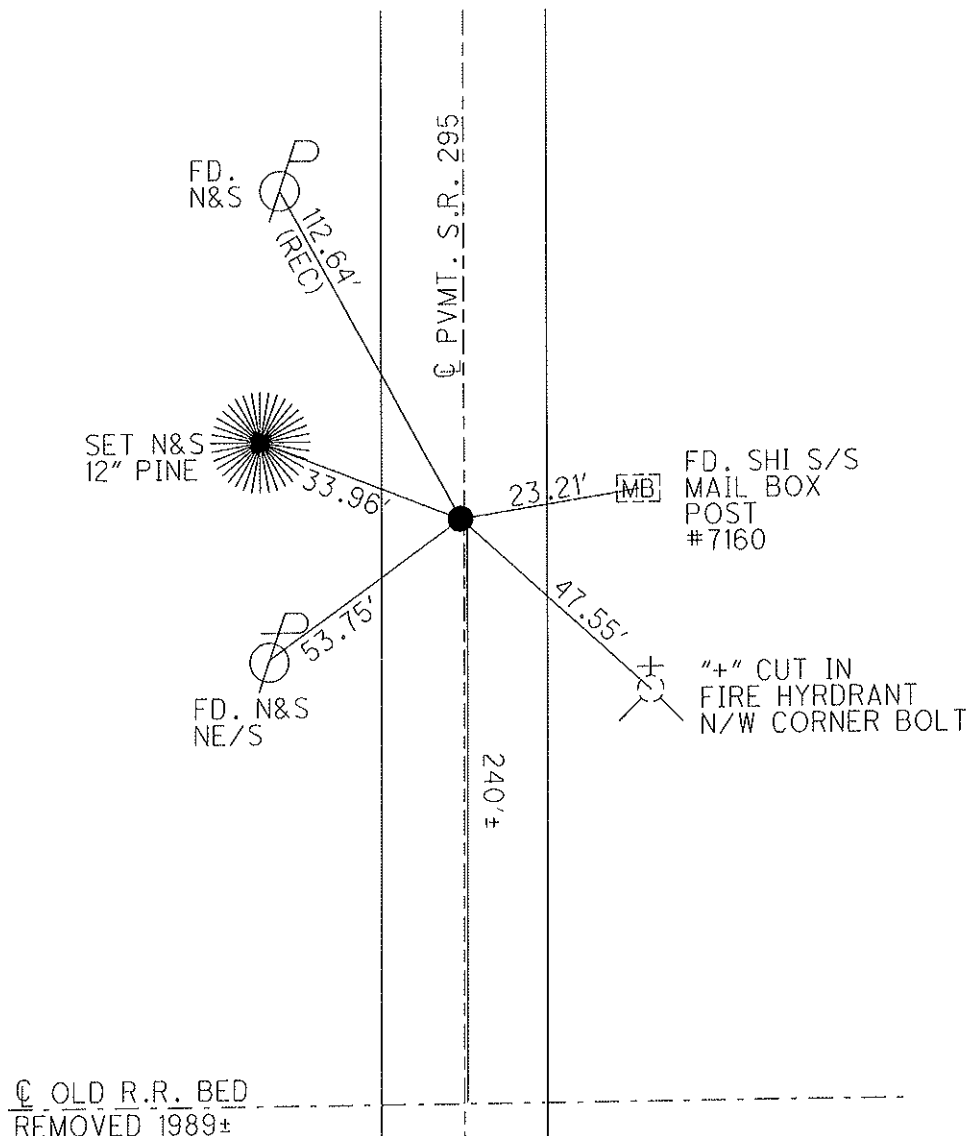

O.D.O.T. DISTRICT 2 SURVEY OFFICE

15

PERSONNEL

REFERENCE NO. 14

SHEET 13 OF 40

NOTES BEAUMONT

DATE 9-3-02

ROUTE S.R. 295

H.C. HOMAN

WEATHER P. CLOUDY

COUNTY LUCAS

R.C. BEAUMONT

TEMP. 80°

TOWNSHIP WATERVILLE

SECTION 3

T 6 N R 9 E


TYPE MONUMENT P.K. NAIL

ON SURFACE - BELOW ON SURFACE


LEFT - Q PAV'T - RIGHT 1.0' LT

10' TO LT EDGE PAVEMENT

S.L.M. 273+54

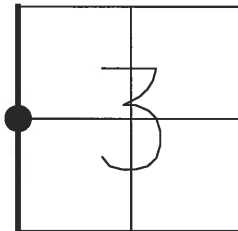

SET MAG &
WASHER
11-25-02
DCH

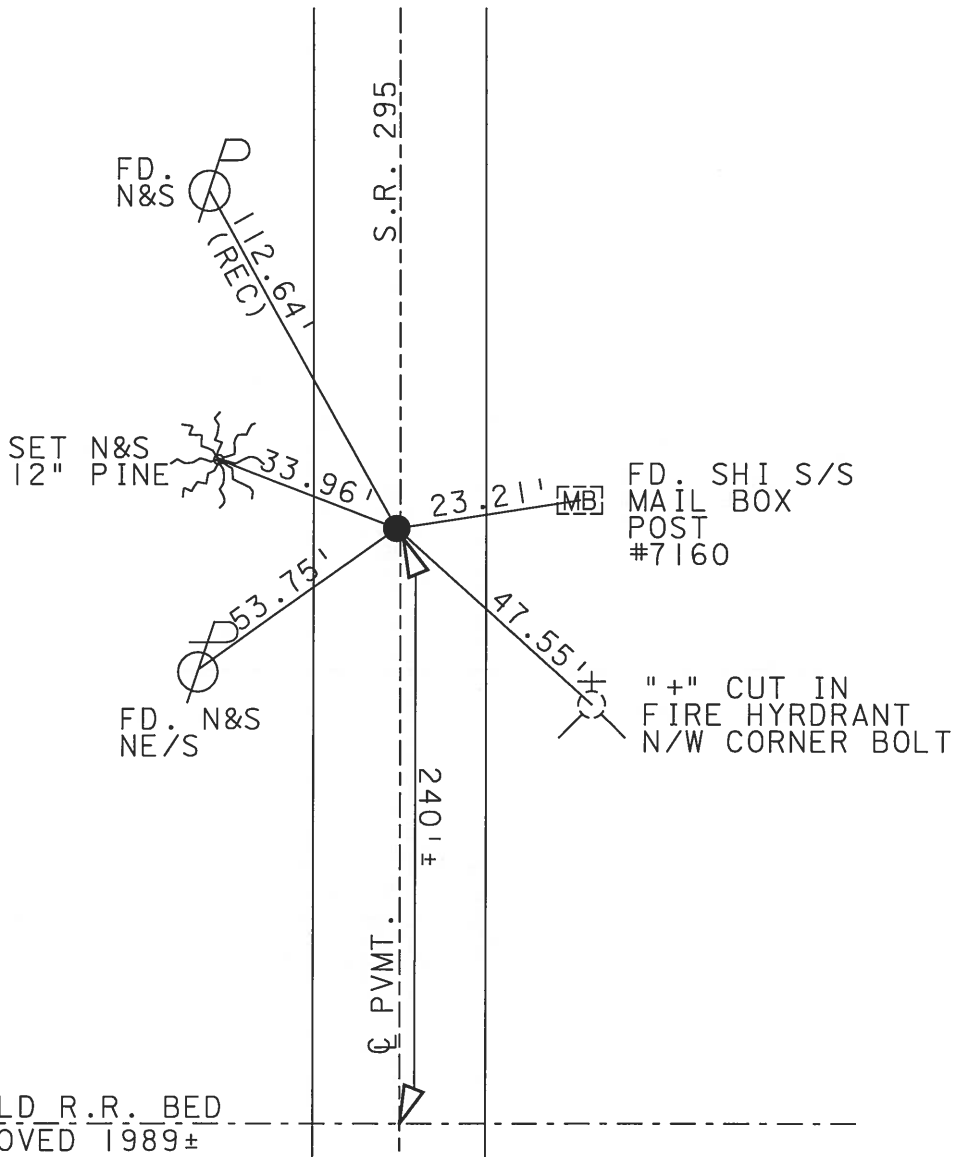

Q OLD R.R. BED
REMOVED 1989±

O.D.O.T. DISTRICT 2 SURVEY OFFICE

PERSONNEL

REFERENCE NO. 14

SHEET 12 OF 35

NOTES LOEHRKE

H.C. STONE

R.C. CURTIS

DATE 8-17-91

WEATHER CLEAR

TEMP. +80

ROUTE S.R. 295

COUNTY LUCAS

TOWNSHIP WATERVILLE

SECTION 3

Set. P.K. / WASHER
3-24-92

T 6 N R 9 E



TYPE MONUMENT P.K. Nail

ON SURFACE - BELOW YES

LEFT- & PAV'T. - RIGHT 1.7'

1.7 TO Lt. EDGE PAVEMENT


S.L.M. 273 + 54

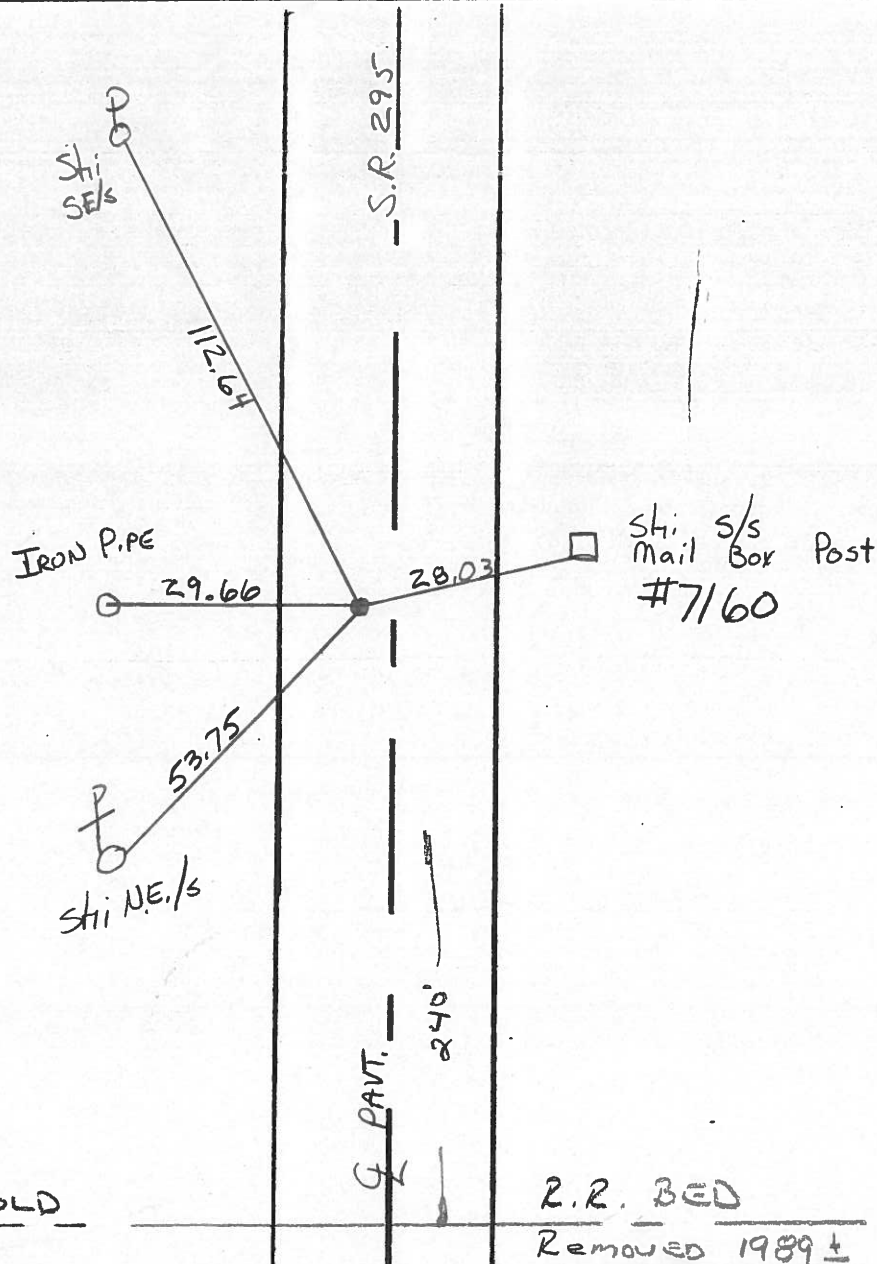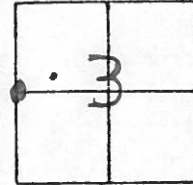


O.D.O.T. DISTRICT 2 SURVEY OFFICE

SHEET

OF

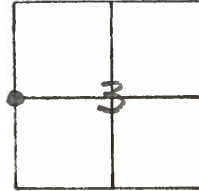County Lucas S.R. 295Township WatervilleSection 3-4T N, R EPersonnel L. StoneR. MichalakD. CurtisDate 23 April 82Weather SunnyTemp. 57°

REF. No. 14

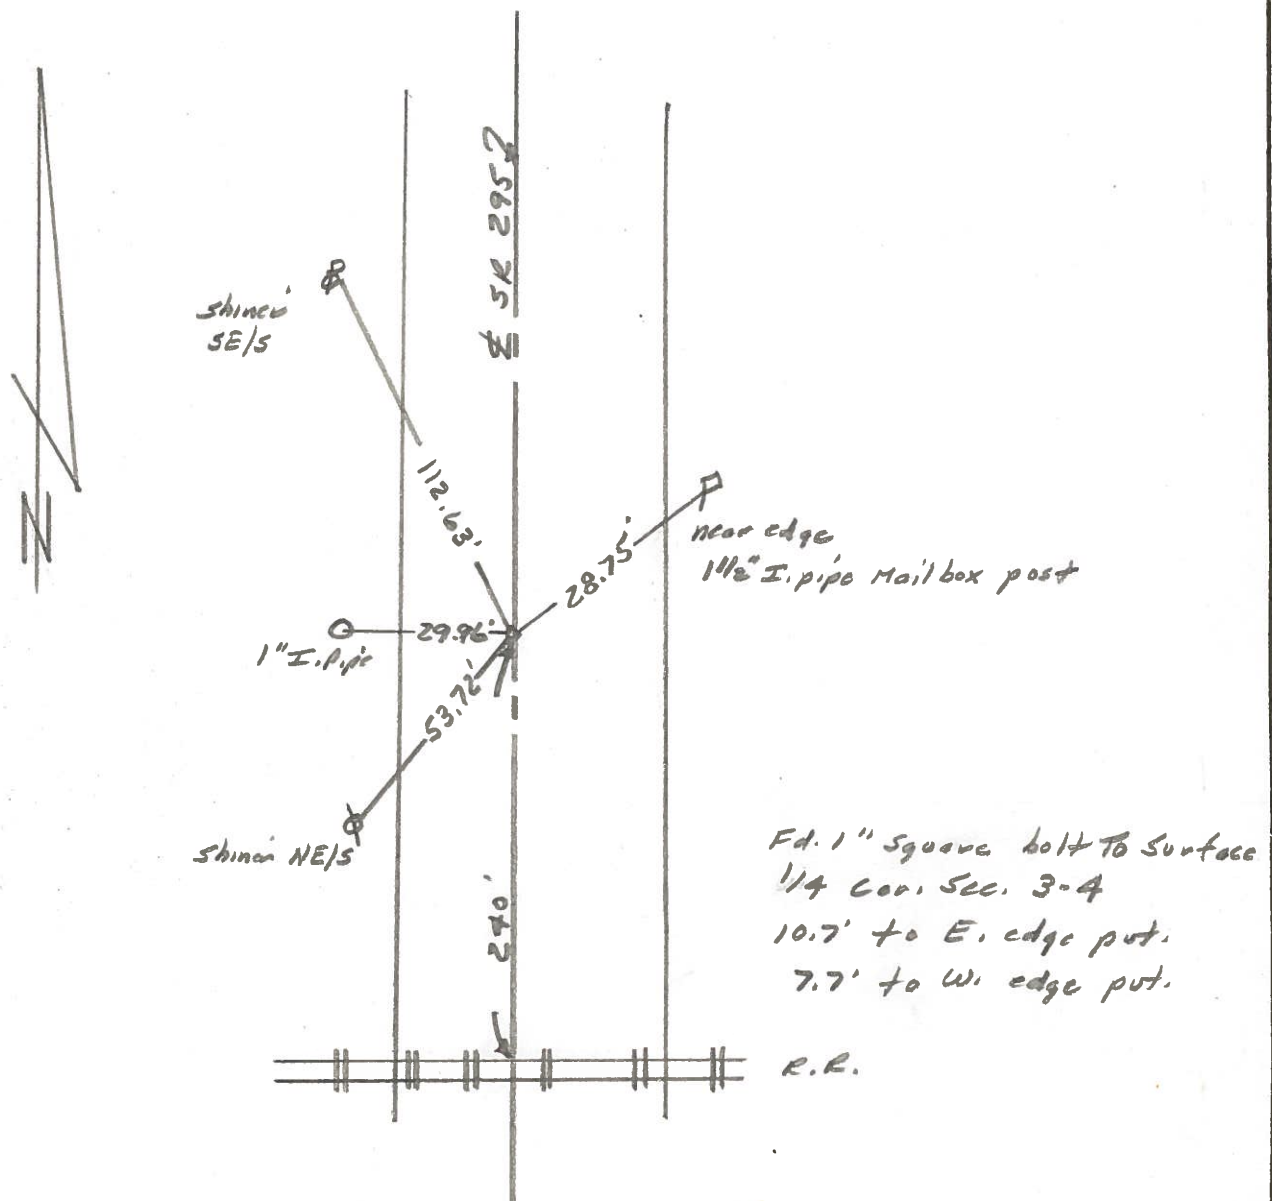

PERSONNEL	TITLE	PERSONNEL	TITLE
Stone	Notes		
Beck	Type		
Michaelok	Type		

COUNTY Lucas DATE 7 June 68

S. R. # 295 WEATHER Hot

SEC. TEMP. 85°

DESCRIPTION References to Control Points JOB NO.

LEFT CENTER LINE RIGHT

