


O.D.O.T. DISTRICT 2 SURVEY OFFICE (USE ONLY)


PERSONNEL	REFERENCE NO. <u>15</u>	SHEET <u>15</u> OF <u>45</u>
NOTES <u>MILLER</u>	DATE <u>6/10/24</u>	ROUTE <u>SR 295</u>
H.C. <u>MILLER</u>	WEATHER <u>CLOUDY</u>	COUNTY <u>LUCAS</u>
R.C. <u>BARRIERE</u>	TEMP. <u>54</u>	TOWNSHIP <u>WATERVILLE</u>
		SECTION <u>3</u>
DWG BY <u>BLUBAUGH</u>	PID <u> </u>	T <u>6</u> N R <u>9</u> E

TYPE MONUMENT MAG NAIL
 ON SURFACE - ~~BELOW~~ ON
 OFFSET Q PAVEMENT 2' LT : ~~RT~~
- TO - EDGE PAVEMENT
 STATION: 426+81.91

HORZ.DATUM: <u>NAD83 (11)</u>	GEOID: <u>18</u>
GRID: NORTHING: <u>676662.204</u>	EASTING: <u>1605015.237</u>
LDP: NORTHING: <u>297653.734</u>	EASTING: <u>115478.965</u>

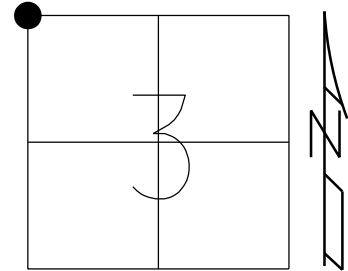

RECORD:
 FD 1" SQ.BOLT
 8/17/91
 FD P.K.NAIL
 9/3/02, DCH
 SET MAG/WASHER
 11/25/02, DCH
 FD MAG NAIL
 REF35
 12/4/15, JLL
 SET MAG/WASHER
 8/4/17, DCH
 FD MAG/WASHER
 REF15
 6/10/24, JAM

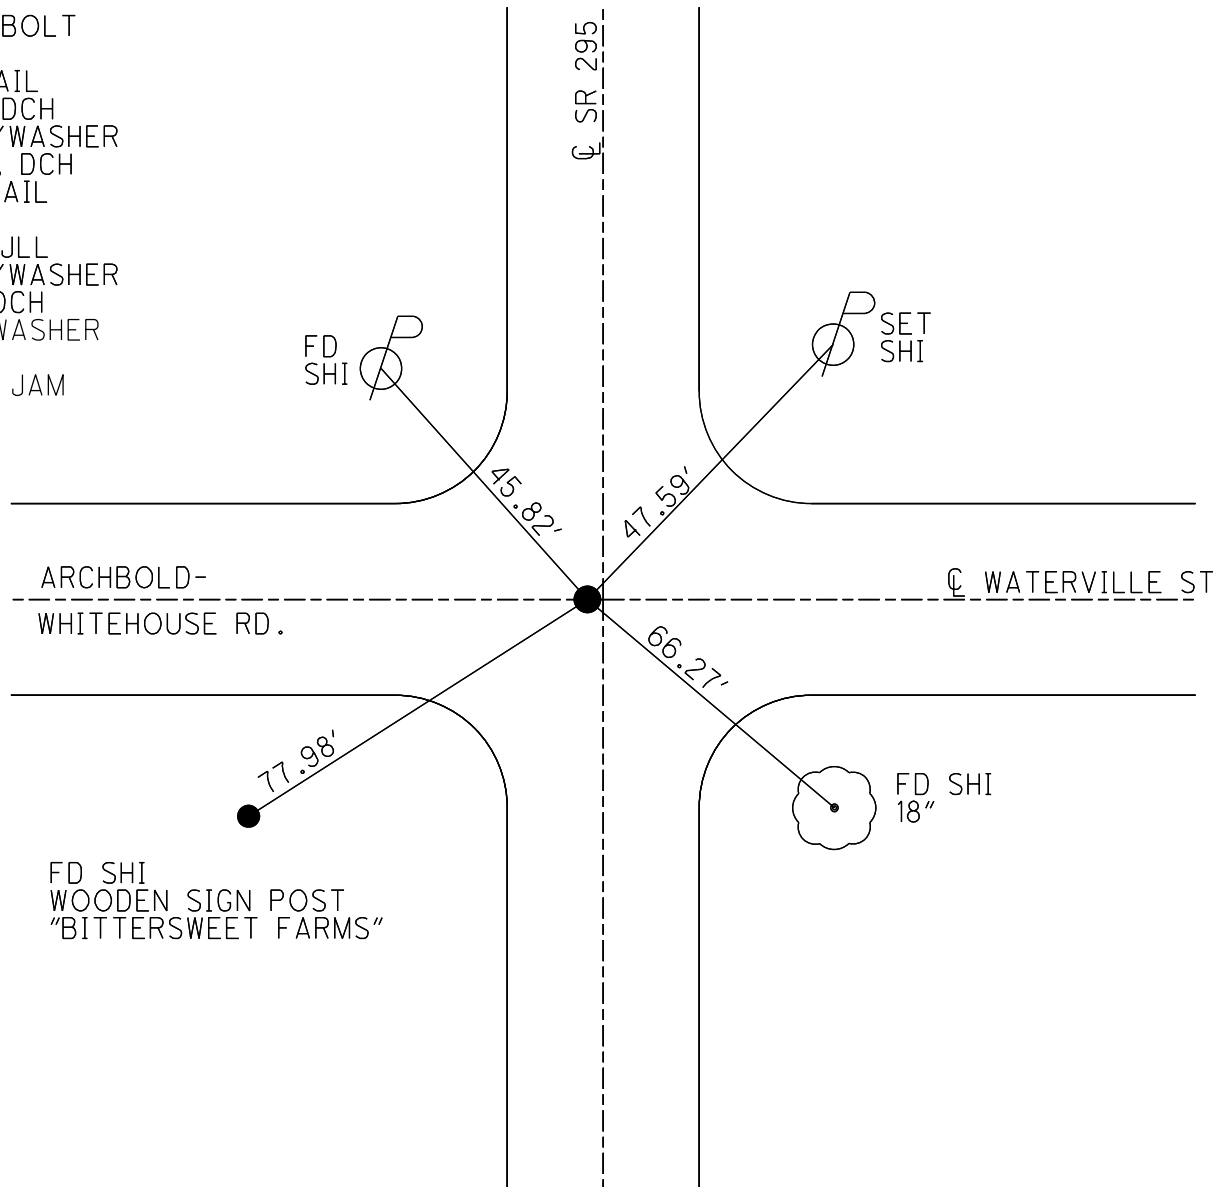

O.D.O.T. DISTRICT 2 SURVEY OFFICE (USE ONLY)

PERSONNEL _____ REFERENCE NO. 15 SHEET 16 OF 45

NOTES HOMAN DATE 3/22/17 ROUTE SR 295
H.C. HOMAN WEATHER SUNNY COUNTY LUCAS
R.C. HELDMAN TEMP. 23° TOWNSHIP WATERVILLE

SECTION 3
T 6 N R 9 E

TYPE MONUMENT MAG NAIL


ON SURFACE - ~~BELOW~~ ON

LEFT - Q PAV'T - ~~RIGHT~~ 2'


- TO - EDGE PAVEMENT

S.L.M. 426+81.91

GRID: NORTHING: 676662.204 EASTING: 1605015.237

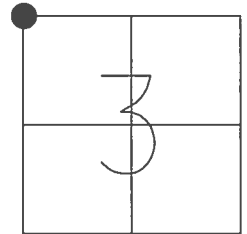

RECORD:
FD 1" SQ.BOLT
8/17/91
FD P.K.NAIL
9/3/02, DCH
SET MAG/WASHER
11/25/02, DCH
FD MAG NAIL
REF35
12/4/15, JLL
SET MAG/WASHER
8/4/17, DCH

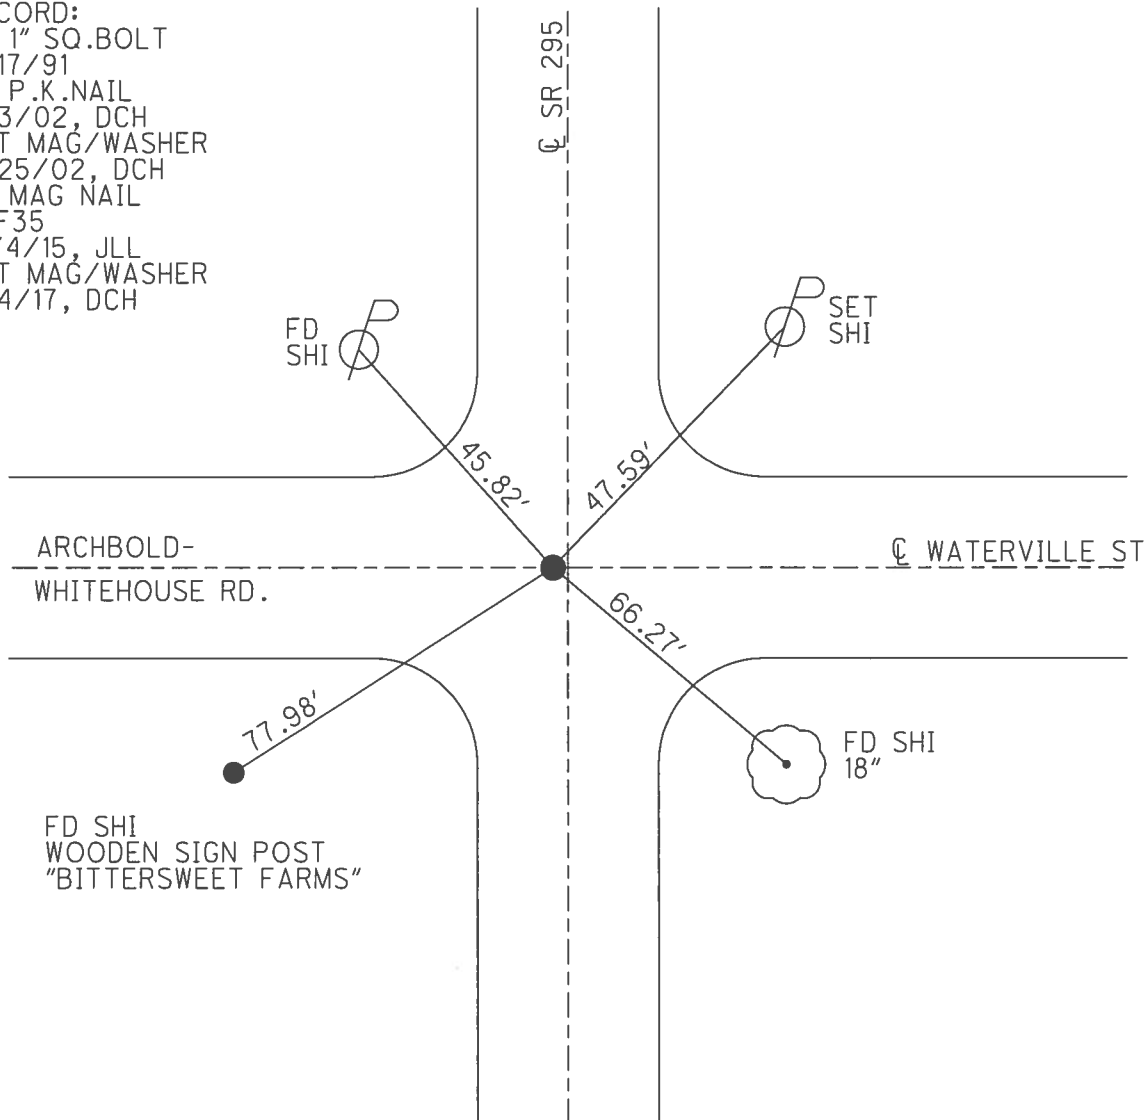

O.D.O.T. DISTRICT 2 SURVEY OFFICE

PERSONNEL

REFERENCE NO. 15

SHEET 16 OF 45

NOTES BEAUMONT

DATE 9-3-02

ROUTE S.R. 295

H.C. HOMAN

WEATHER P. CLOUDY

COUNTY LUCAS

R.C. BEAUMONT

TEMP. 80°

TOWNSHIP WATERVILLE

SECTION 3

T 6 N R 9 E


TYPE MONUMENT P.K. NAIL

ON SURFACE - ~~BELOW~~ ON

LEFT - Q PAV'T - ~~RIGHT~~ 2'


TO EDGE PAVEMENT

S.L.M. 296+46

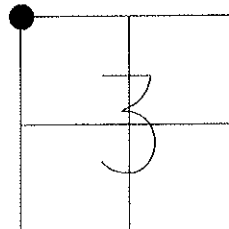

RECORD:
FOUND $1\frac{1}{2}$ "
SQ BOLT
8-17-91

SET MAG &
WASHER
11-25-02
DCH

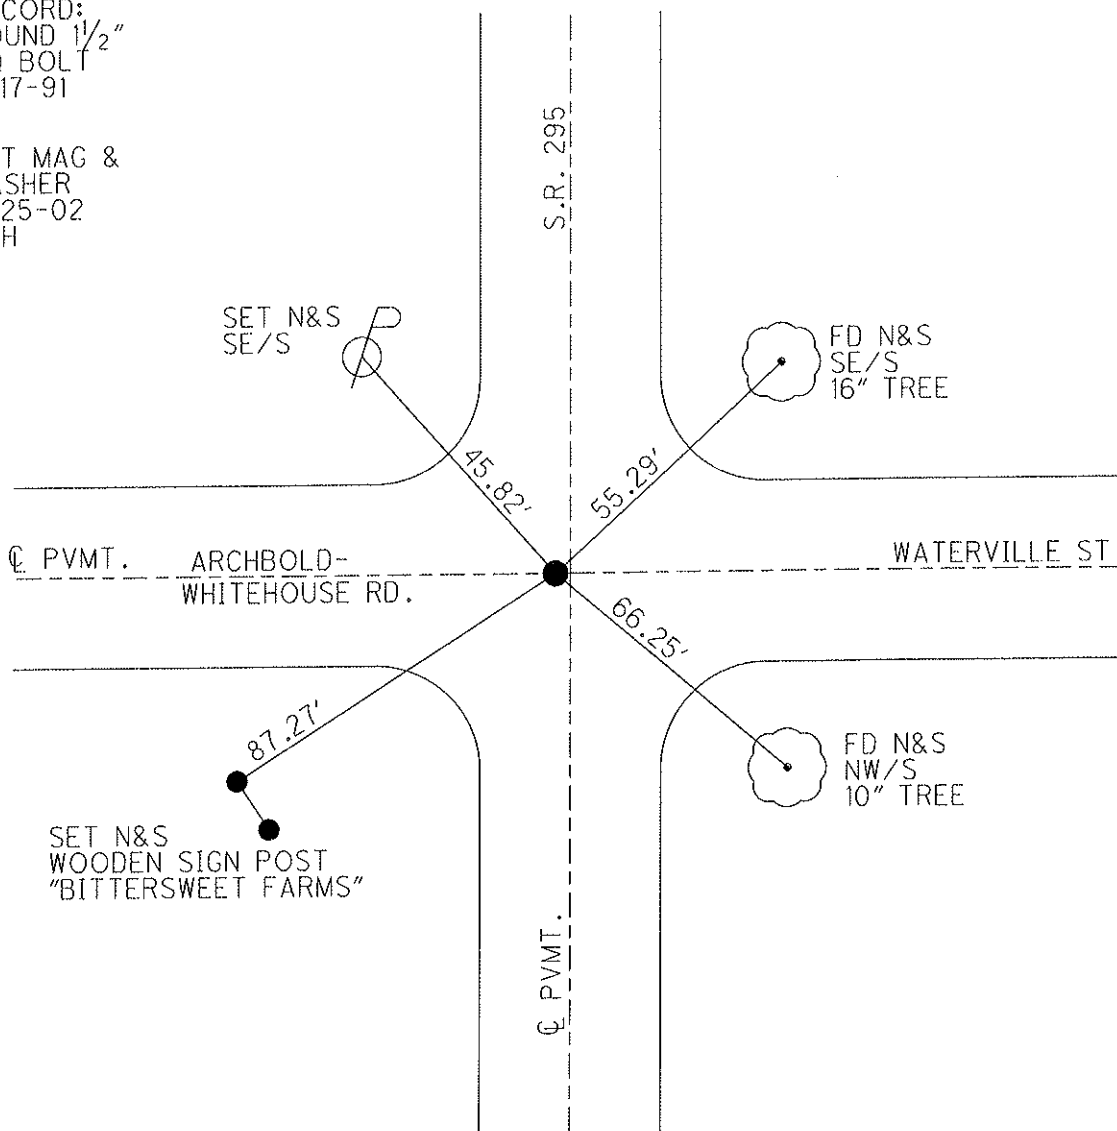

O.D.O.T. DISTRICT 2 SURVEY OFFICE

PERSONNEL

REFERENCE NO. 15

SHEET 13 OF 35

NOTES LOEHRKE

H.C. STONE

R.C. CURTIS

DATE 8-17-91

WEATHER CLEAR

TEMP. +80°

ROUTE S.R. 295

COUNTY LUCAS

TOWNSHIP WATERVILLE

SECTION 3

T6 NR 9 E



TYPE MONUMENT 1 1/2" Sq. Bolt

ON SURFACE - BELOW YES

LEFT- & PAV'T. - RIGHT 3.3'

TO EDGE PAVEMENT

S.L.M. 296 +46

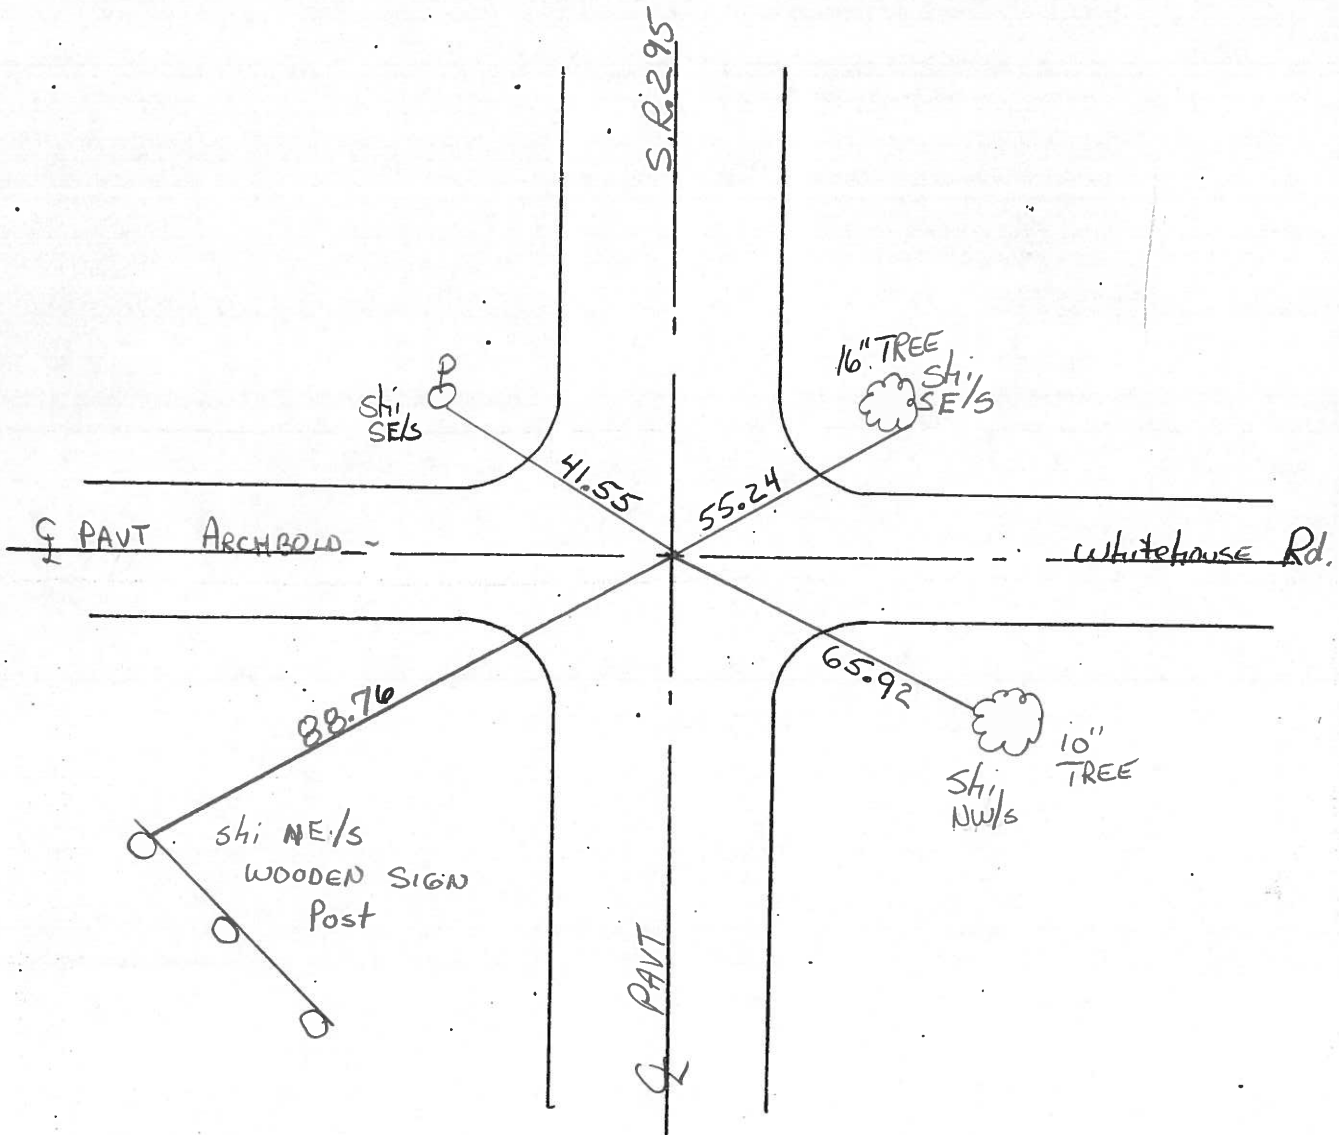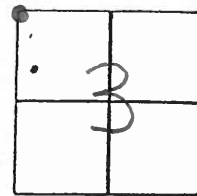

O.D.O.T. DISTRICT 2 SURVEY OFFICE

SHEET

OF

County Lucas S.R. 295

Township Waterville

Section 3-4

T N, R E

Personnel L. Stone


R. Michalak

D. Curtis


Date 23 April 82

Weather Sunny

Temp. 57°

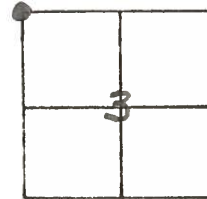


REF. NO. 15

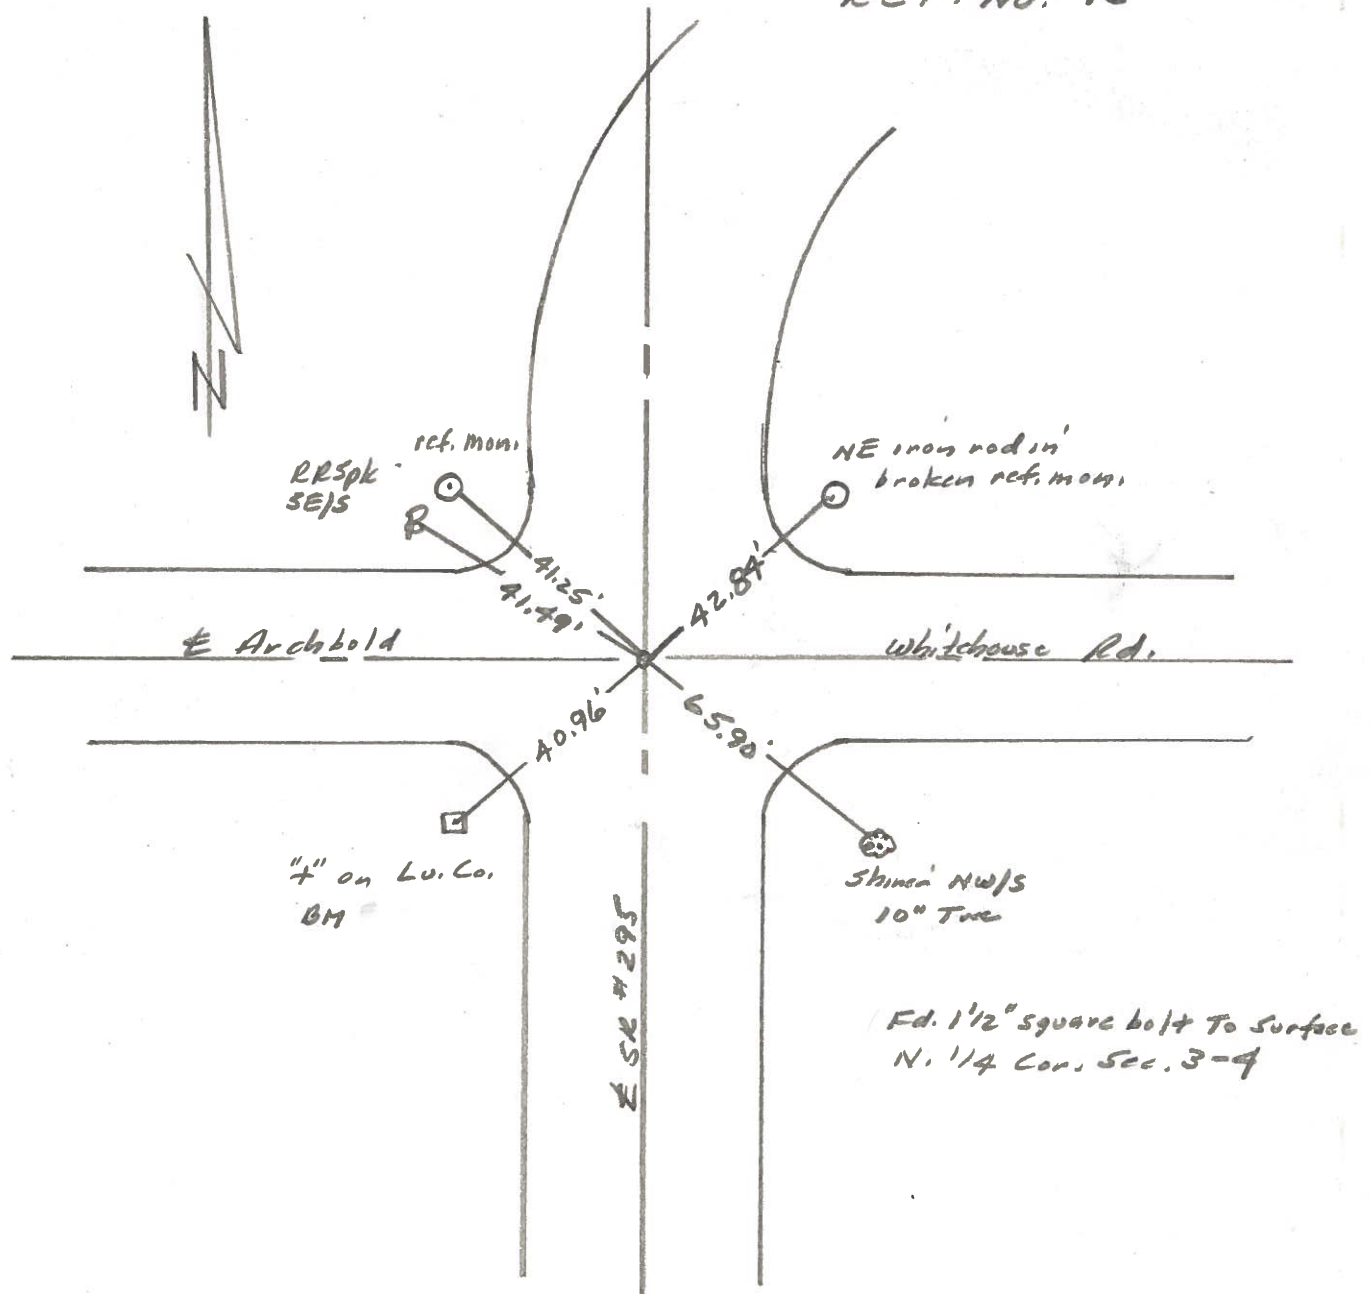

PERSONNEL	TITLE	PERSONNEL	TITLE	COUNTY	DATE	WEATHER	TEMP.
Stone				Lucas	14 April 76	Warm	72°
Curtis				S. R.	295		
Neuser				SEC.	5.80 ±		
Granata							

DESCRIPTION	LEFT	CENTER LINE	RIGHT	JOB NO.
		Alignment		

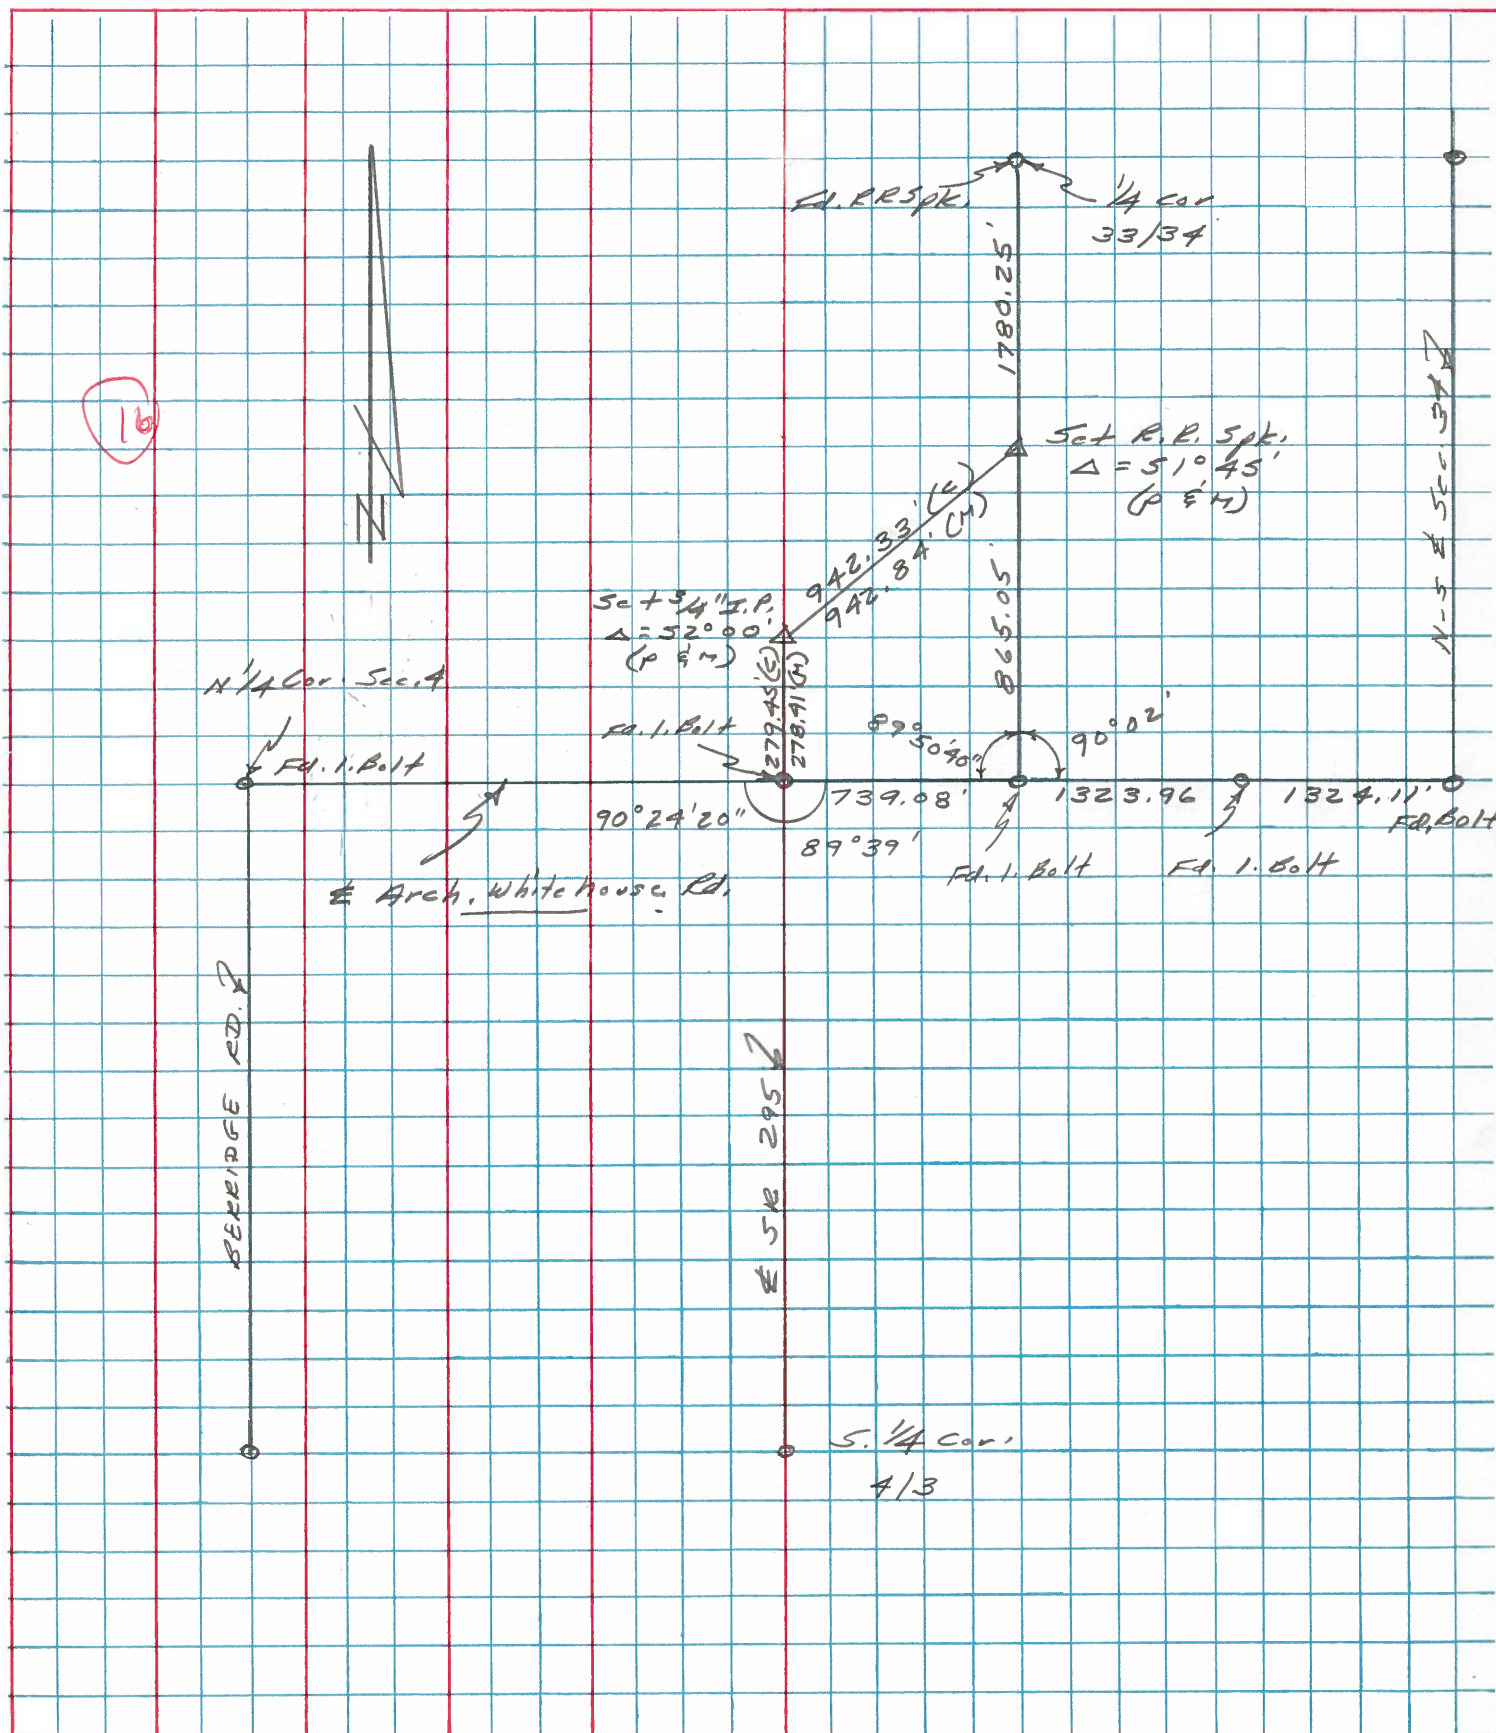

PERSONNEL	TITLE	PERSONNEL	TITLE
Stene	Notes		
Beck	Tape		
Michalak	Tape		

COUNTY Lucas DATE 7 June 68

S. R. #295 WEATHER Hot

SEC. _____ TEMP. 89°

DESCRIPTION References to Control Points JOB NO. _____

LEFT CENTER LINE RIGHT

