

O.D.O.T. DISTRICT 2 SURVEY OFFICE (USE ONLY)

PERSONNEL

REFERENCE NO. 16 A

SHEET 18 OF 45

NOTES BARRIERE
H.C. MILLER
R.C. BARRIERE

DATE 6/10/24
WEATHER CLOUDY
TEMP. 56

ROUTE SR 295
COUNTY LUCAS
TOWNSHIP WATERVILLE
SECTION 33
T 7 N R 9 E

DWG BY BLUBAUGH PID

TYPE MONUMENT MAG/WASHER

ON SURFACE - BELOW ON

OFFSET $\odot$ PAVEMENT - LT : RT

- TO - EDGE PAVEMENT

STATION: 438+64.6

HORZ.DATUM: NAD83 (11)


GEOID: 18

GRID: NORTHING: 677526.395


EASTING: 1605752.328

LDP: NORTHING: 298527.557

EASTING: 116204.600

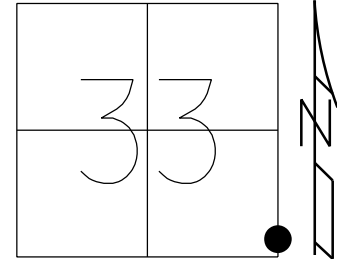

RECORD: P.I.
SET R.R.SPIKE
4/14/76
FD P.K.NAIL
REF38
3/22/17, DCH
FD PK NAIL (REPLACED)
RECREP16A
SET MAG/WASHER
REF16A
6/10/24, JAM

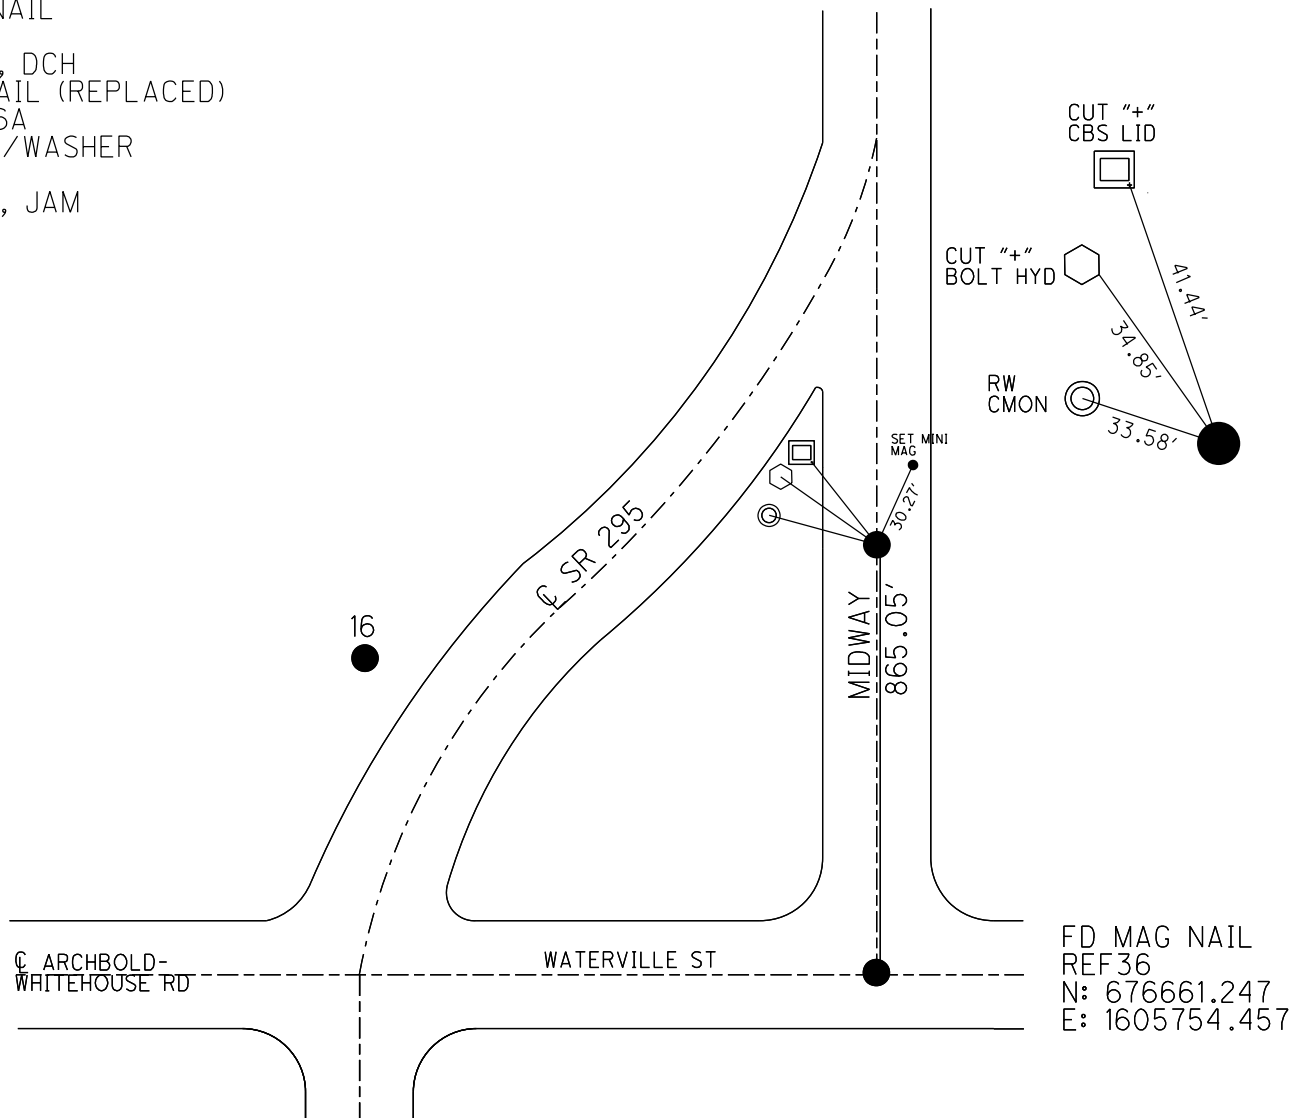


O.D.O.T. DISTRICT 2 SURVEY OFFICE (USE ONLY)


PERSONNEL	REFERENCE NO.	<u>16 A</u>	SHEET	<u>18</u>	OF	<u>45</u>
NOTES	<u>HOMAN</u>	DATE	<u>3/22/17</u>	ROUTE	<u>SR 295</u>	
H.C.	<u>HOMAN</u>	WEATHER	<u>SUNNY</u>	COUNTY	<u>LUCAS</u>	
R.C.	<u>HELDMAN</u>	TEMP.	<u>26°</u>	TOWNSHIP	<u>WATERVILLE</u>	
				SECTION	<u>33</u>	
				T	<u>7</u>	N
				R	<u>9</u>	E


TYPE MONUMENT P.K.NAIL
ON SURFACE - BELOW ON
LEFT - ℄ PAV'T - RIGHT -
- TO - EDGE PAVEMENT
S.L.M. 438+64.6

GRID: NORTHING: 677526.395 EASTING: 1605752.328

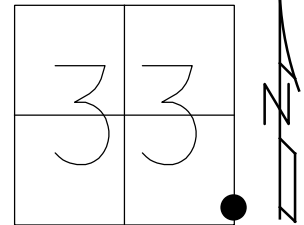

RECORD: P.I.
SET R.R.SPIKE
4/14/76
FD P.K.NAIL
REF38
3/22/17, DCH

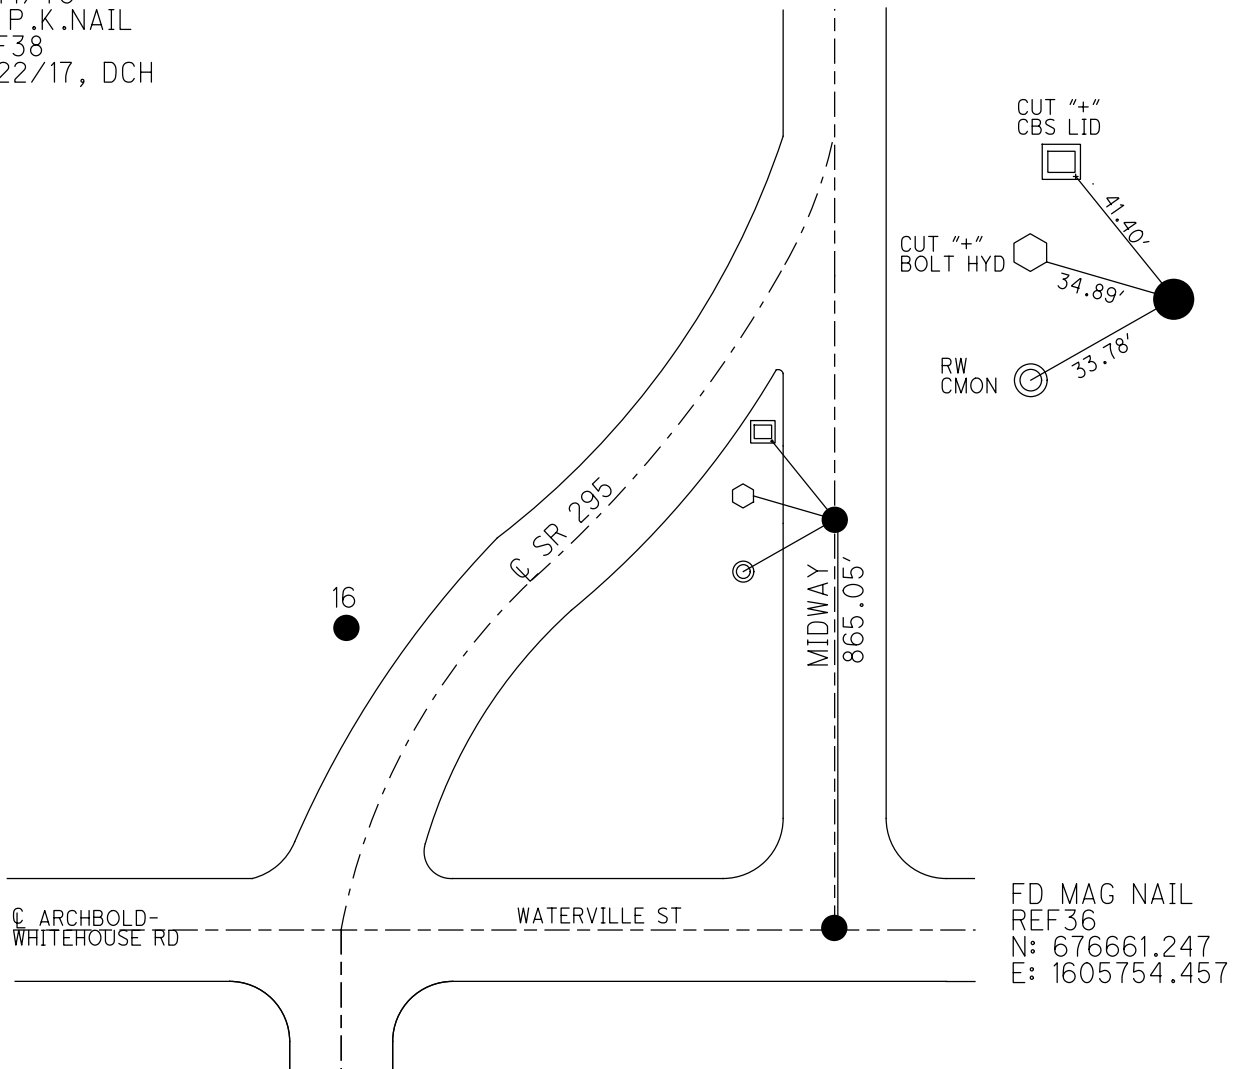

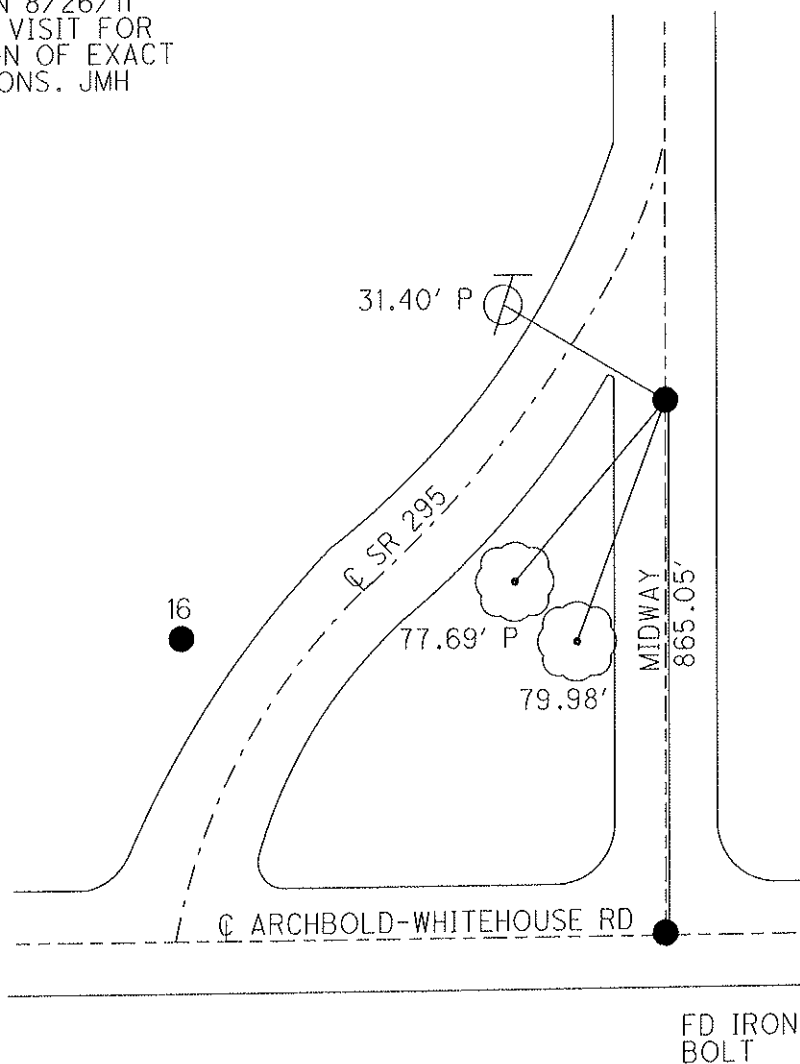

PERSONNEL	TITLE	PERSONNEL	TITLE
-----------	-------	-----------	-------

54.2

Cont'd.

Answer

6. Answer

COUNTY Lucas

DATE 14 Apr '76

S. R. 275

WEATHER *Warm*

SEC. 5,80

TEMP. 74°

DESCRIPTION

References to Control Points

LEFT	CENTER LINE	RIGHT
1	1	1
2	2	2
3	3	3
100	100	100

JOB NO.

LEFT




CENTER LINE

RIGHT

TWP 7N

RNG 9E

33 QUAD. SE SEC

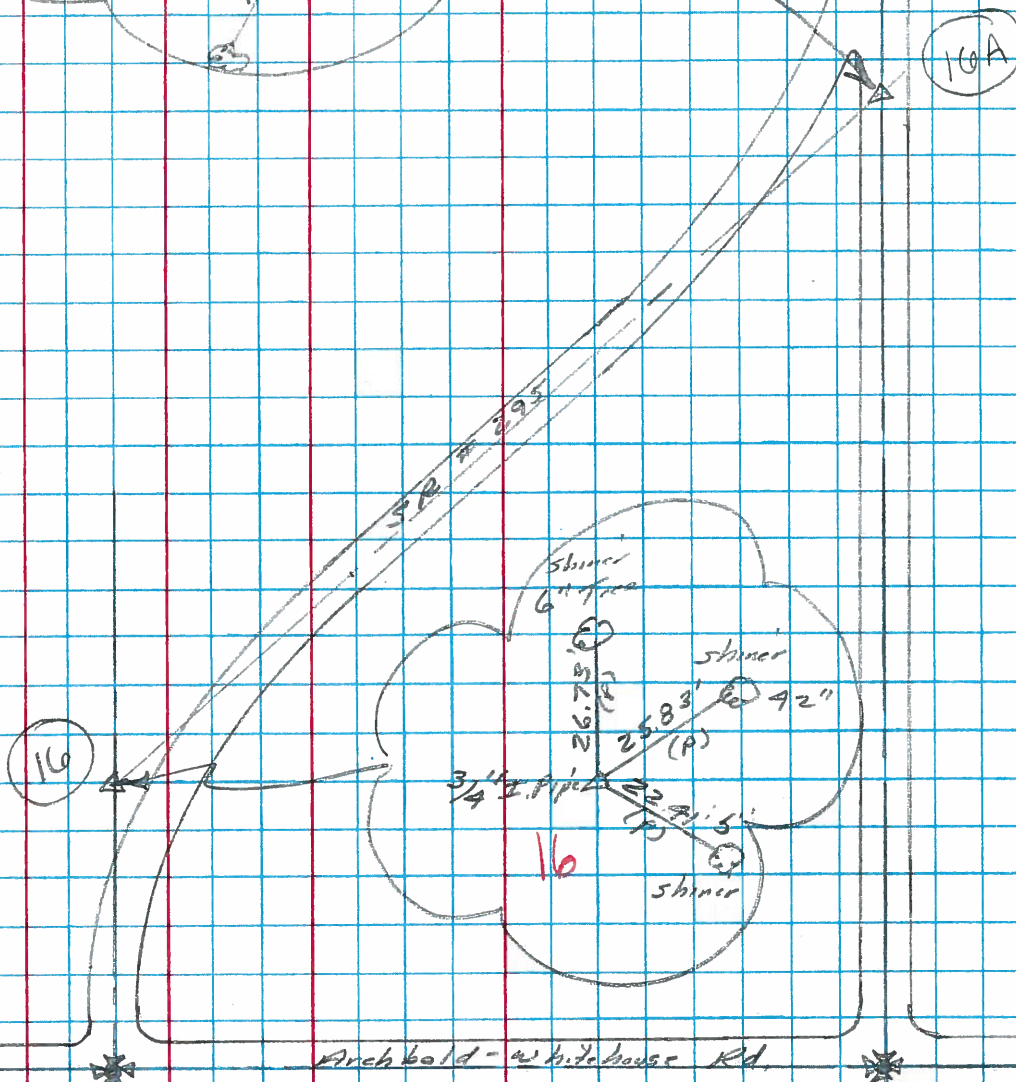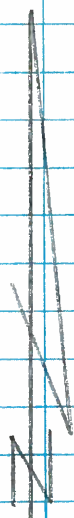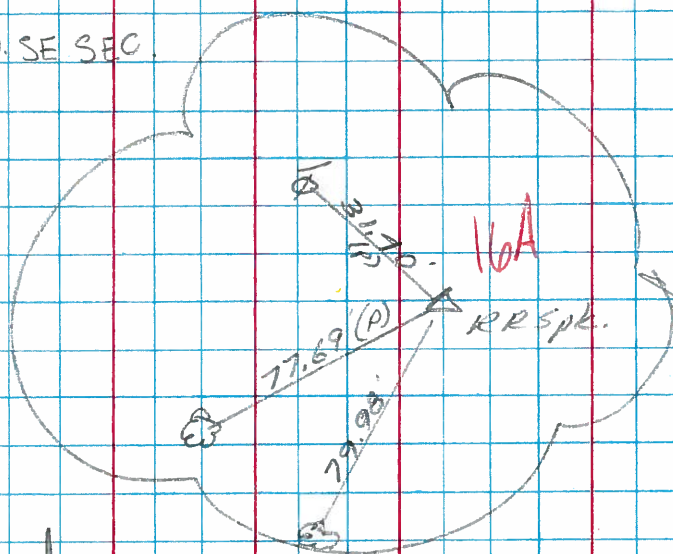

PERSONNEL	TITLE	PERSONNEL	TITLE	COUNTY	DATE	WEATHER	TEMP.
Stone				Lucas	14 April 76	Warm	72°
Curtis				S. R.	295		
Neuser				SEC.	5.80 ±		
Granata							

DESCRIPTION

LEFT

CENTER LINE

RIGHT

JOB NO.

