

O.D.O.T. DISTRICT 2 SURVEY OFFICE (USE ONLY)

PERSONNEL

REFERENCE NO. 17

SHEET 19 OF 45

NOTES BARRIERE
H.C. MILLER
R.C. BARRIERE

DATE 6/10/24
WEATHER CLOUDY
TEMP. 54

ROUTE SR 295
COUNTY LUCAS
TOWNSHIP WATERVILLE
SECTION 33
T 7 N R 9 E

DWG BY BLUBAUGH PID

TYPE MONUMENT MAG/WASHER

ON SURFACE - ~~BELOW~~ ON

OFFSET Q PAVEMENT 3.6' LT : ~~RT~~

6.2' TO LT EDGE PAVEMENT

STATION: 456+06.55

HORZ.DATUM: NAD83 (11)


GEOID: 18

GRID: NORTHING: 679306.632

EASTING: 1605747.909


LDP: NORTHING: 300307.745

EASTING: 116176.681

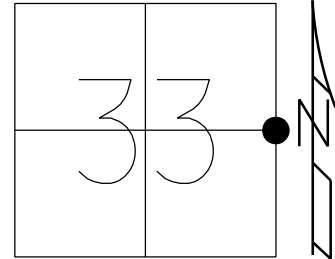

RECORD:
FD P.K.NAIL
9/3/02, DCH
SET MAG/WASHER
11/25/02, DCH
SET MAG/WASHER
8/4/17, DCH
FD MAG/WASHER
REF 17
6/10/24, JAM


RECORD:
P.K.NAIL
SV1
6/10/24, JAM
N: 300306.170
E: 116176.670

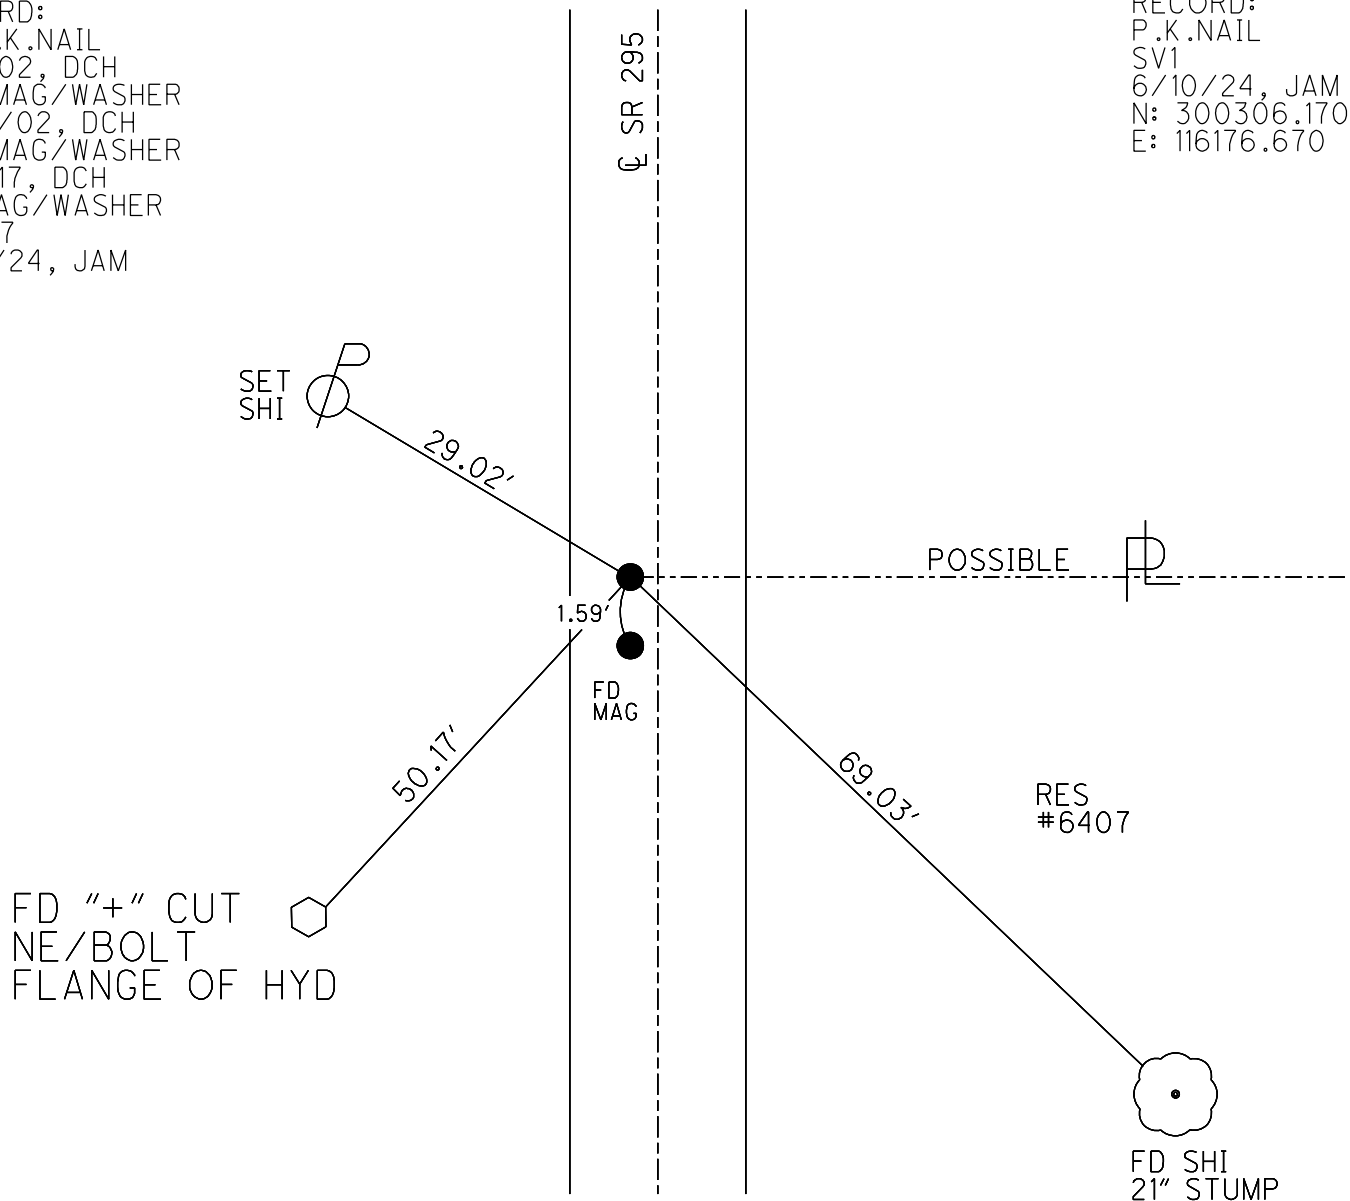

O.D.O.T. DISTRICT 2 SURVEY OFFICE (USE ONLY)


PERSONNEL	REFERENCE NO. <u>17</u>	SHEET <u>19</u> OF <u>45</u>
NOTES	DATE <u>3/22/17</u>	ROUTE <u>SR 295</u>
H.C. <u>HOMAN</u>	WEATHER <u>SUNNY</u>	COUNTY <u>LUCAS</u>
R.C. <u>HELDMAN</u>	TEMP. <u>26°</u>	TOWNSHIP <u>WATERVILLE</u>
		SECTION <u>33</u>
		T <u>7</u> N R <u>9</u> E

TYPE MONUMENT MAG/WASHER
 ON SURFACE - ~~BELOW~~ ON
 LEFT - CL PAV'T - ~~RIGHT~~ 3.6'
6.2' TO LT EDGE PAVEMENT
 S.L.M. 456+06.55

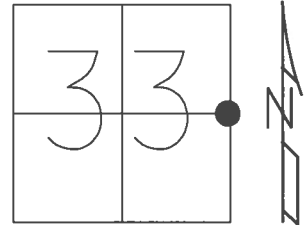

GRID: NORTHING: 679306.632 EASTING: 1605747.909

RECORD:
 FD P.K.NAIL
 9/3/02, DCH
 SET MAG/WASHER
 11/25/02, DCH
 SET MAG/WASHER
 8/4/17, DCH

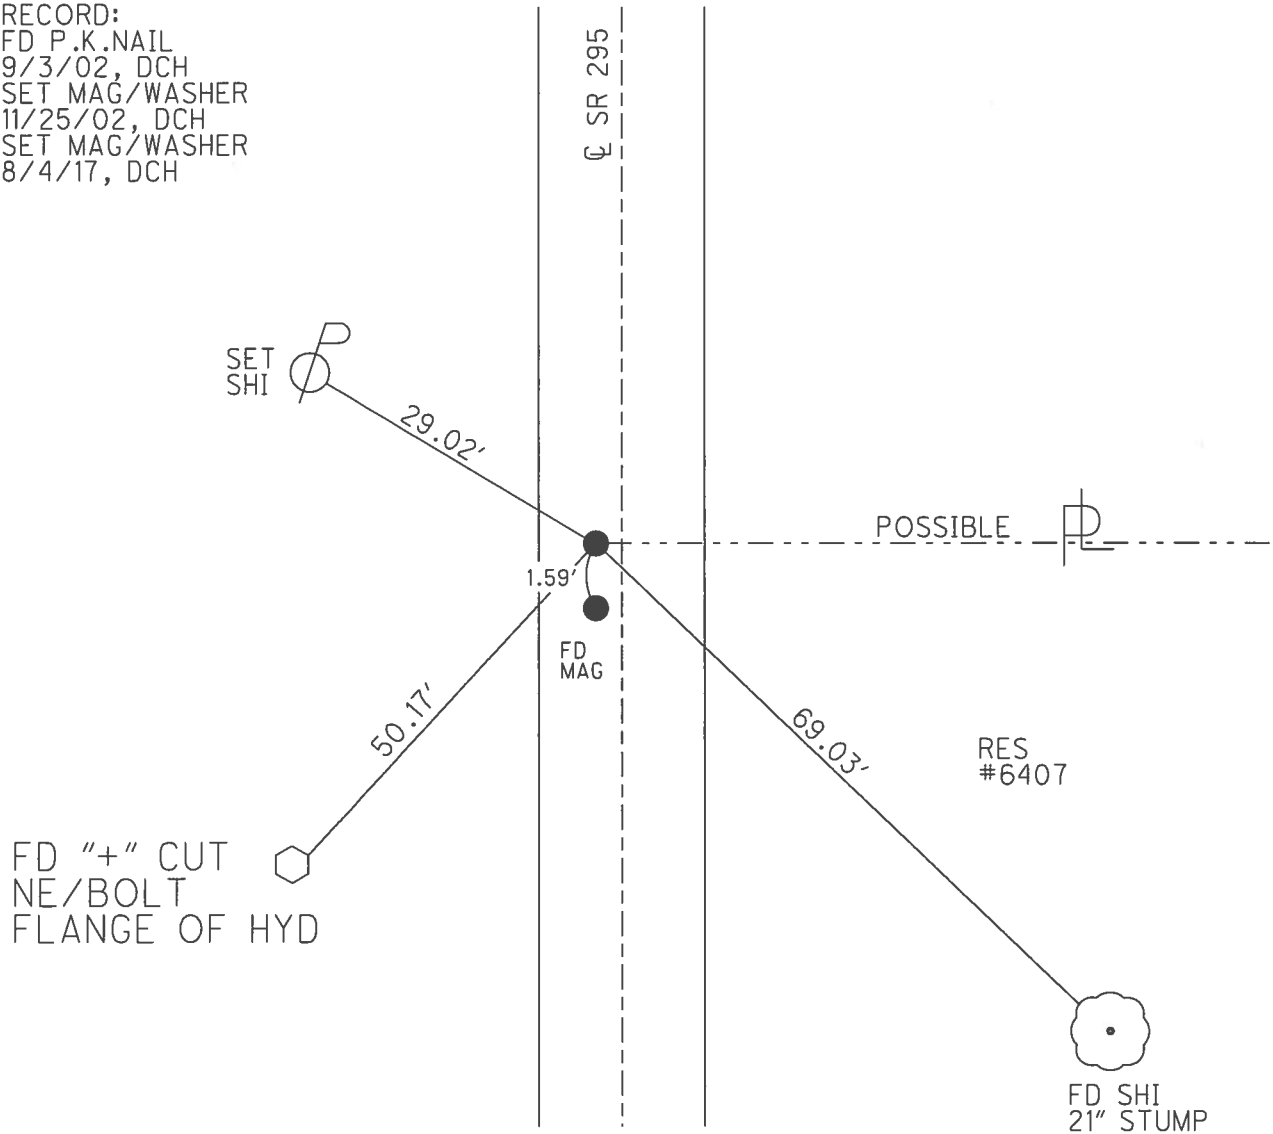

O.D.O.T. DISTRICT 2 SURVEY OFFICE

PERSONNEL

REFERENCE NO. 17

SHEET 19 OF 45

NOTES BEAUMONT

DATE 9-3-02

ROUTE S.R. 295

H.C. HOMAN

WEATHER P. CLOUDY

COUNTY LUCAS

R.C. BEAUMONT

TEMP. 80

TOWNSHIP WATERVILLE

SECTION 33

T 7 N R 9 E


TYPE MONUMENT PK NAIL

ON SURFACE - ~~BELOW~~ ON


LEFT - Q PAV'T - ~~RIGHT~~ 3.6'

6.2 TO LT EDGE PAVEMENT

S.L.M. 325+70

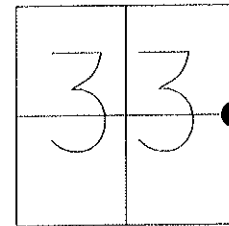

SET MAG NAIL
& WASHER
11-25-02
D.C.H.

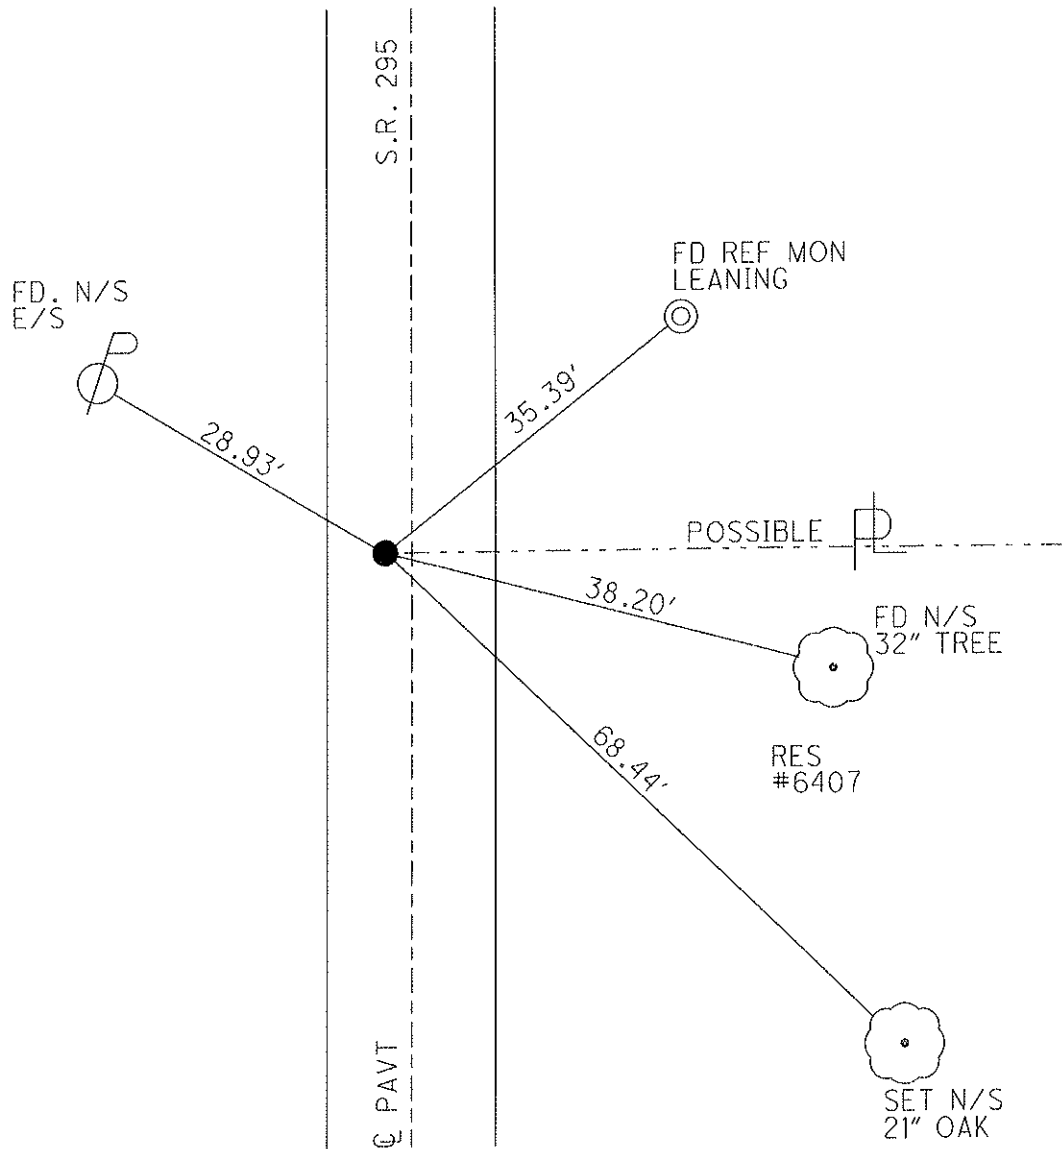

O.D.O.T. DISTRICT 2 SURVEY OFFICE

PERSONNEL

REFERENCE NO. 17

SHEET 14 OF 35

NOTES LOEHRKE

H.C. STONE

R.C. CURTIS

DATE 8-17-91

WEATHER CLEAR

TEMP. +80°

ROUTE S.R. 295

COUNTY LUCAS

TOWNSHIP WATERVILLE

SECTION 34

T 7 N R 9 E

TYPE MONUMENT R.R. SPIKE



ON SURFACE - BELOW YES

LEFT - C PAV'T. - RIGHT 3.6'

6.2 TO Lt. EDGE PAVEMENT

S.L.M. _____

Set P.K./WASHER

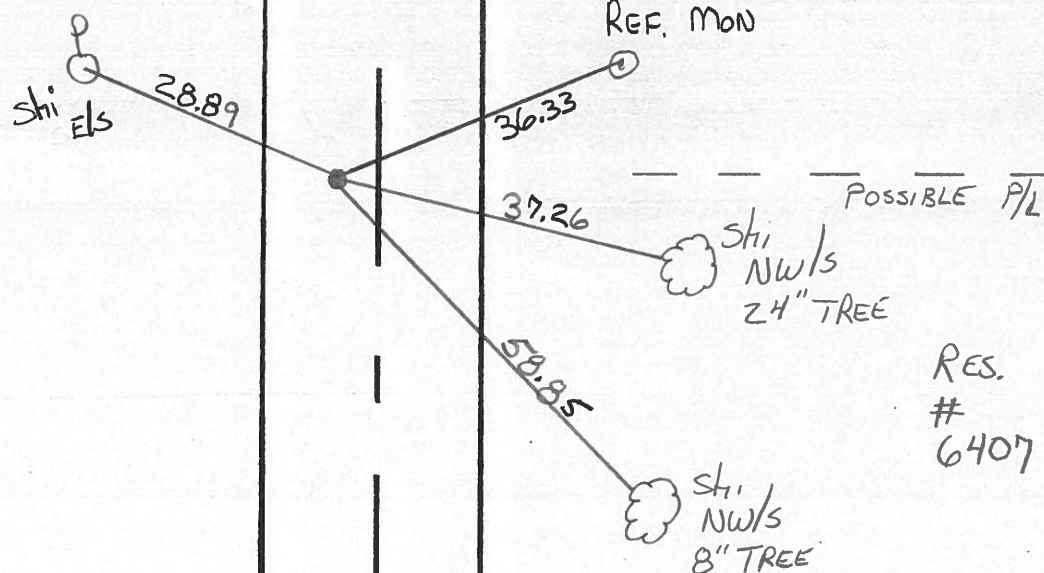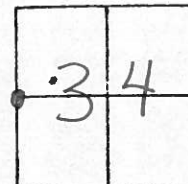

RES.

6407

O.D.O.T. DISTRICT 2 SURVEY OFFICE

SHEET

OF

County Lucas S.R. 295

Date 23 April 82

Township Waterville

Weather Sunny

Section 33-34


Temp. 58°

T N, R E


Personnel J. Stone

R. Michalak

D. Curtis

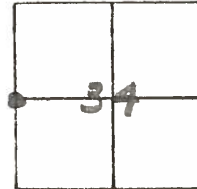

REF. NO. 17

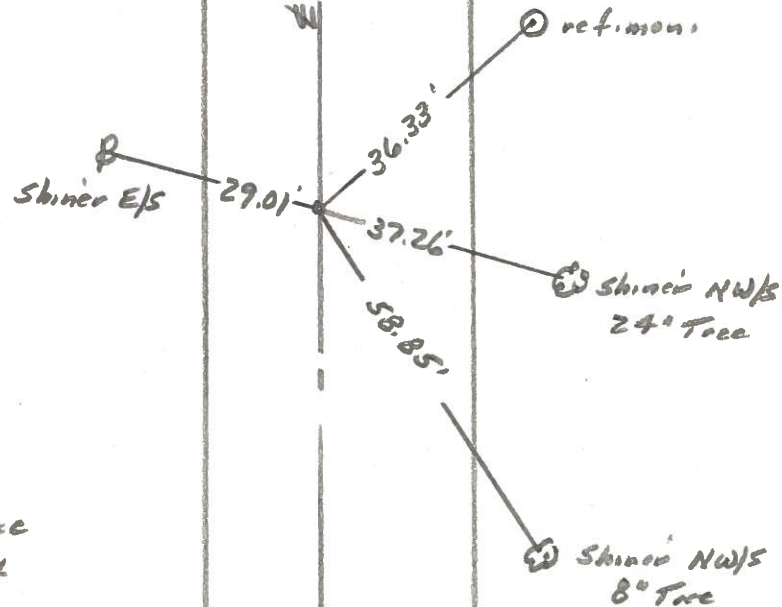

Fd. RR Spk. To Surface
 1/4 Cor. Sec. 33-34
 6.2' to W. edge put.
 12.4' to E. edge put.


PERSONNEL	TITLE	PERSONNEL	TITLE
Stone			
Curtis			
Neuser			
Granata			

COUNTY Lucas DATE 14 April 76

S. R. 295 WEATHER Warm

SEC. 5.80 ± TEMP. 72°

DESCRIPTION Alignment LEFT CENTER LINE RIGHT JOB NO.

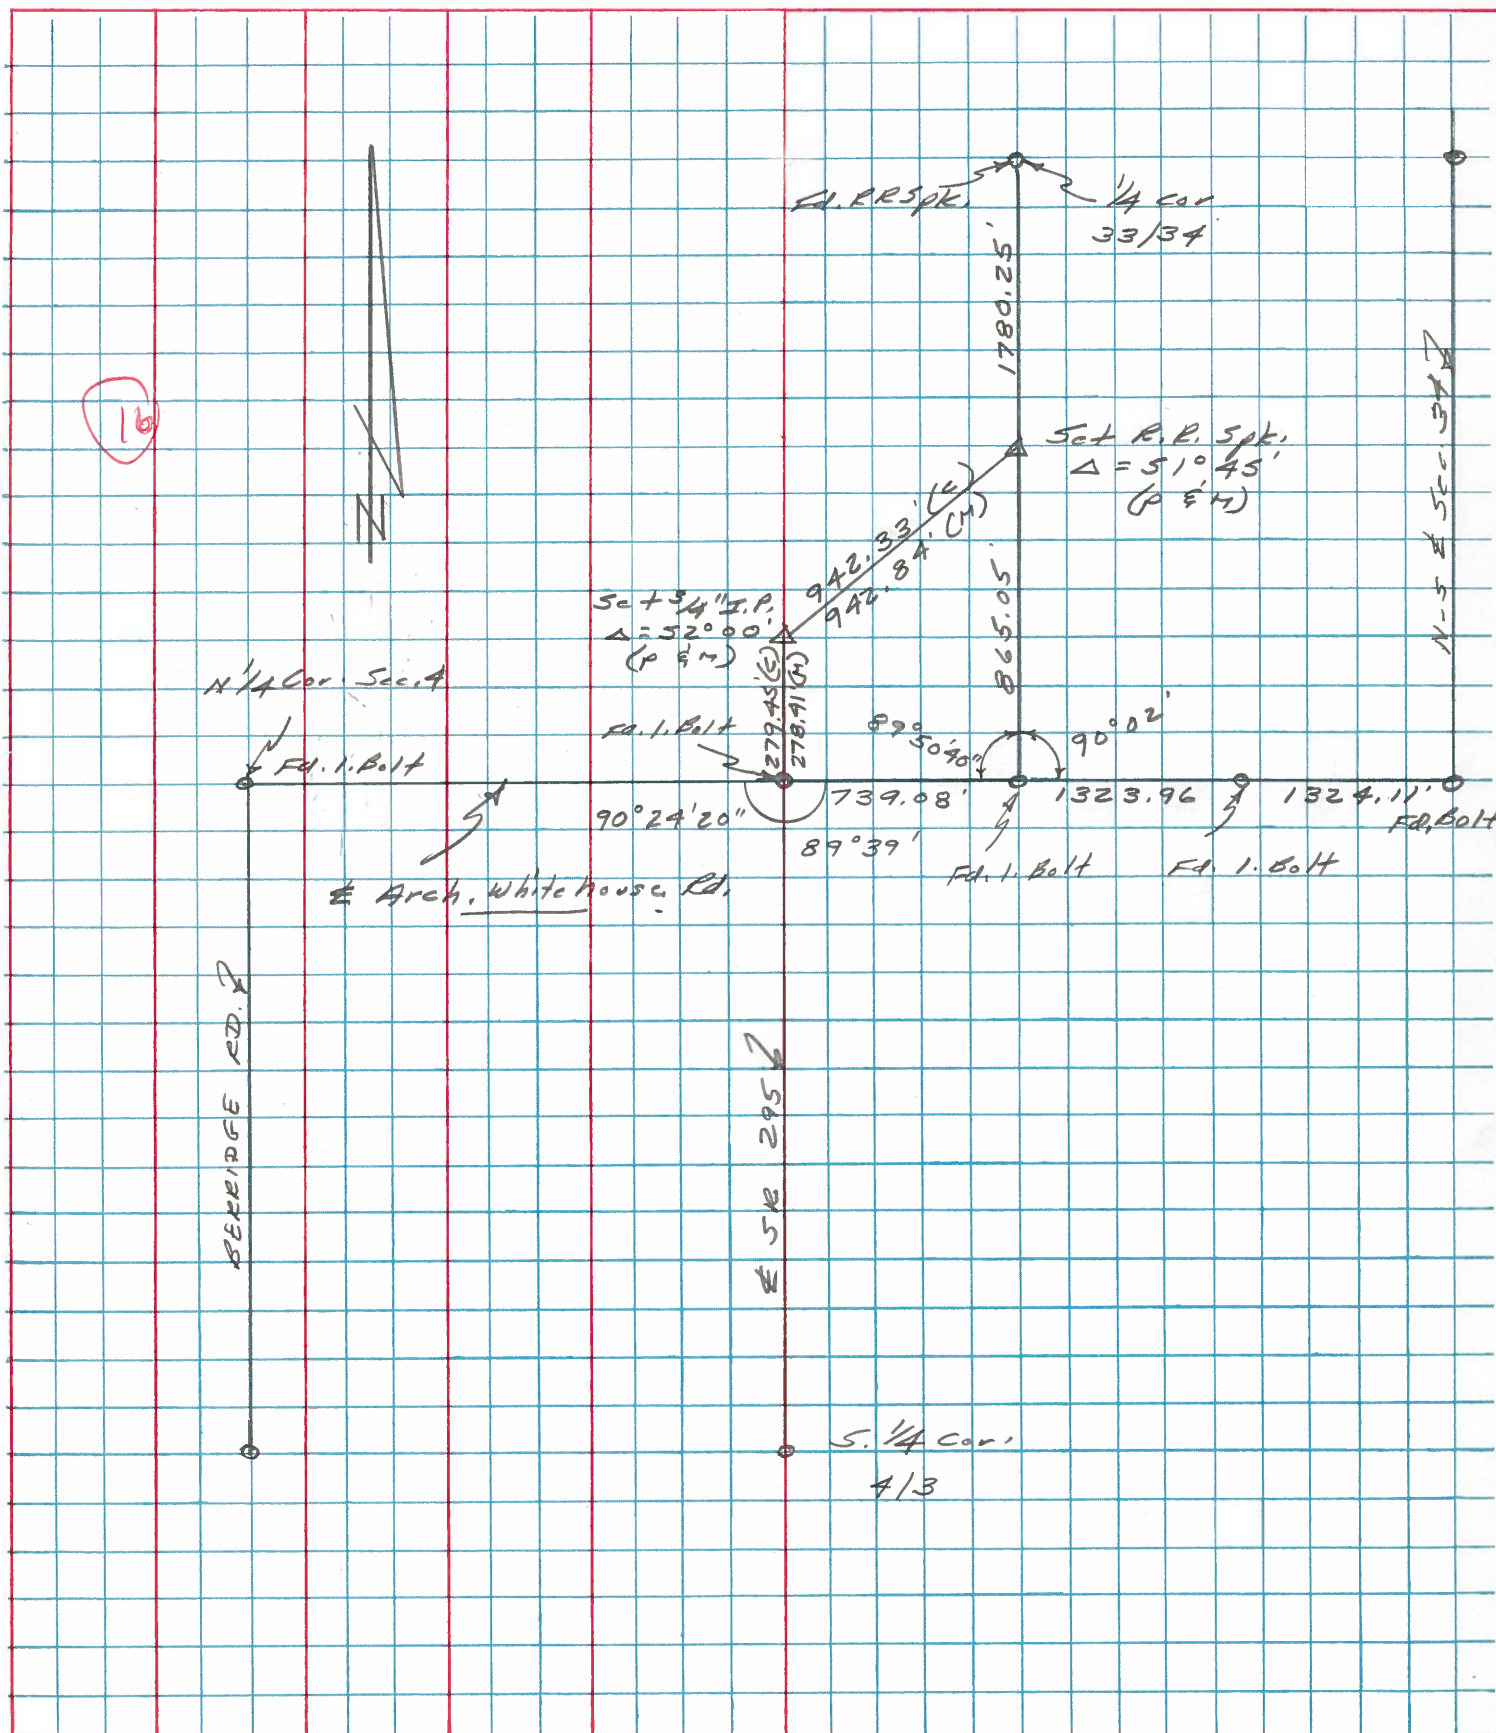

PERSONNEL	TITLE	PERSONNEL	TITLE
Stene	Notes		
Brak	Tape		
Michalak	Tape		

COUNTY Lucas DATE 7 June 68

S. R. #295 WEATHER Hot

SEC. TEMP. 89°

DESCRIPTION References to Control Points JOB NO.

LEFT CENTER LINE RIGHT

