

O.D.O.T. DISTRICT 2 SURVEY OFFICE (USE ONLY)

PERSONNEL

REFERENCE NO. 18 A

SHEET 21 OF 45

NOTES BARRIERE
H.C. MILLER
R.C. BARRIERE

DATE 6/10/24
WEATHER CLOUDY
TEMP. 54

ROUTE SR 295
COUNTY LUCAS
TOWNSHIP SWANTON
SECTION 33
T 7 N R 5 E

DWG BY BLUBAUGH PID

TYPE MONUMENT MAG/WASHER

ON SURFACE - ~~BELOW~~ ON

OFFSET Q PAVEMENT 5.67' LT : ~~RT~~

11.6" TO RT EDGE PAVEMENT

STATION: 336+90

HORZ.DATUM: NAD83 (11)


GEOID: 18

GRID: NORTHING: 680701.188


EASTING: 1605733.149

LDP: NORTHING: 301702.067

EASTING: 116143.610

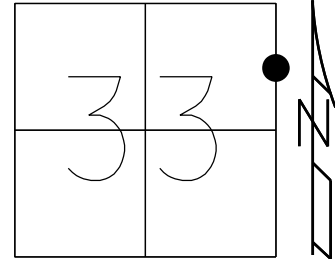

RECORD:
SET MAG/WASHER
12/13/02, DCH
FD MAG/WASHER
REFA18
6/20/16, JFO
6/10/24, JAM

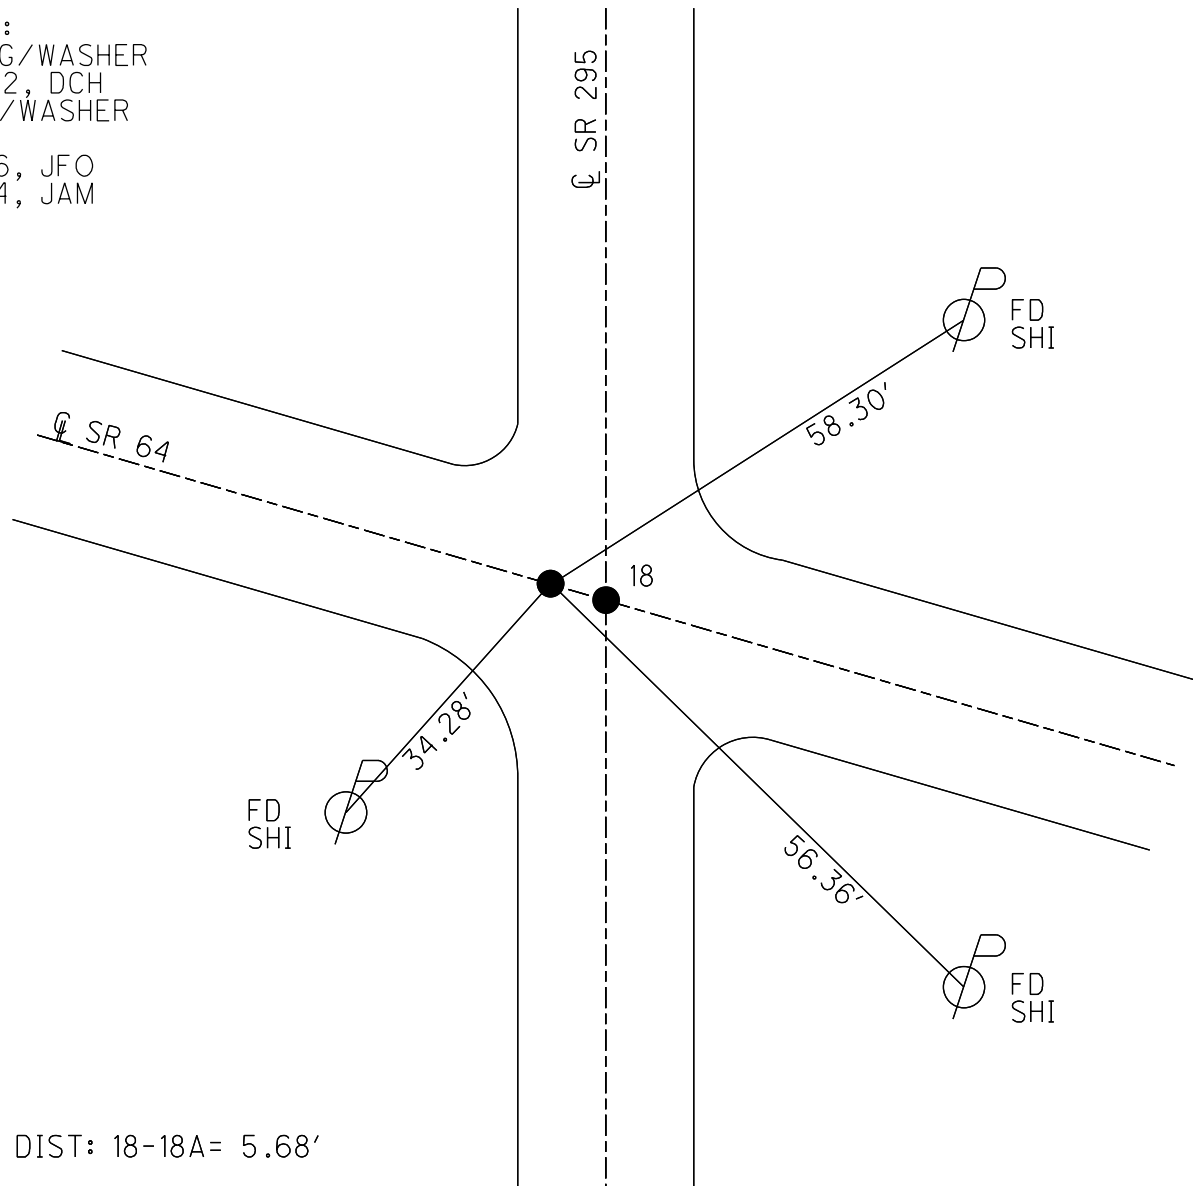

DIST: 18-18A= 5.68'

O.D.O.T. DISTRICT 2 SURVEY OFFICE (USE ONLY)

PERSONNEL

REFERENCE NO.

18 A

SHEET

21

OF

45

NOTES

ROUSOS

DATE

5/22/02

ROUTE

SR 295

H.C.

HOMAN

WEATHER

SUNNY

COUNTY

LUCAS

R.C.

MICHALAK

TEMP.

52°

TOWNSHIP

SWANTON

SECTION

33

T 7 N R 5 E

TYPE MONUMENT

RR SPIKE

ON SURFACE - ~~BELOW~~

ON

LEFT - ~~Q~~ PAV'T - ~~RIGHT~~

5.67'


11.6' TO RT EDGE PAVEMENT

S.L.M.


336+90

GRID: NORTHING: 680701.188

EASTING: 1605733.149

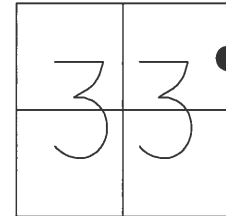

RECORD:
SET MAG/WASHER
12/13/02, DCH
FD MAG/WASHER
REFA18
6/20/16, JFO

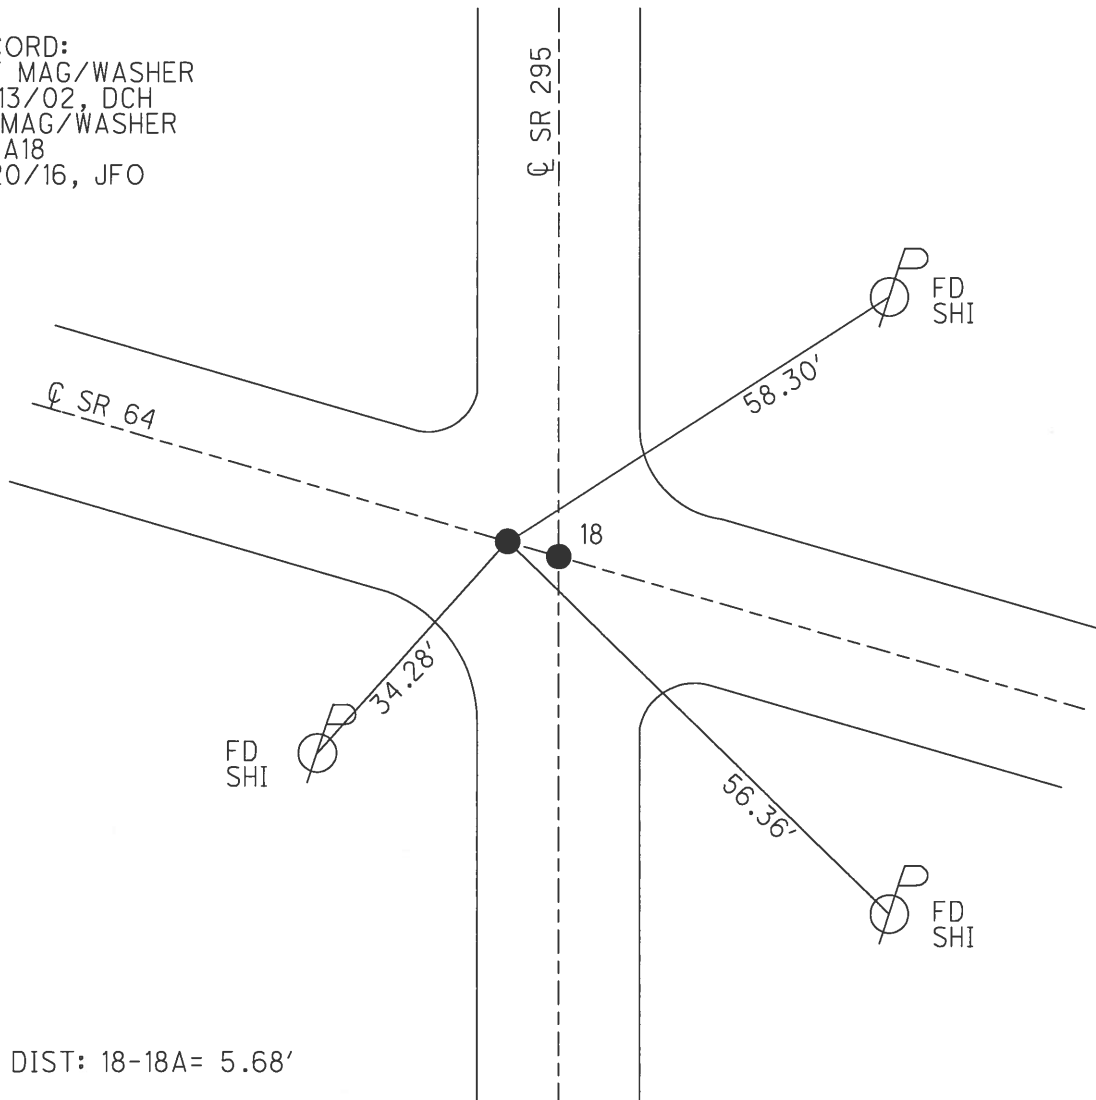

O.D.O.T. DISTRICT 2 SURVEY OFFICE

PERSONNEL

NOTES ROUSOS
H.C. HOMAN
R.C. MICHALAK

REFERENCE NO. 4118A

DATE 5-22-02
WEATHER SUNNY
TEMP. 52

18 on SR 295

SHEET 18 OF 40

ROUTE S.R. 64
COUNTY LUCAS
TOWNSHIP SWANTON
SECTION 33
T 7 N R 5 E

TYPE MONUMENT ¹⁸ A=SQ BOLT ^{18A} B=RR SPIKE

ON SURFACE - ~~BELOW~~ YES


~~LEFT~~ - ~~Q~~ PAVT - ~~RIGHT~~ YES

11.6' TO RT. EDGE PAVEMENT


S.L.M. A=336+84 B=336+90

18

18A

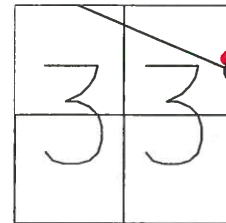

SET MAG NAILS
& WASHERS
12-13-02
D.C.H.

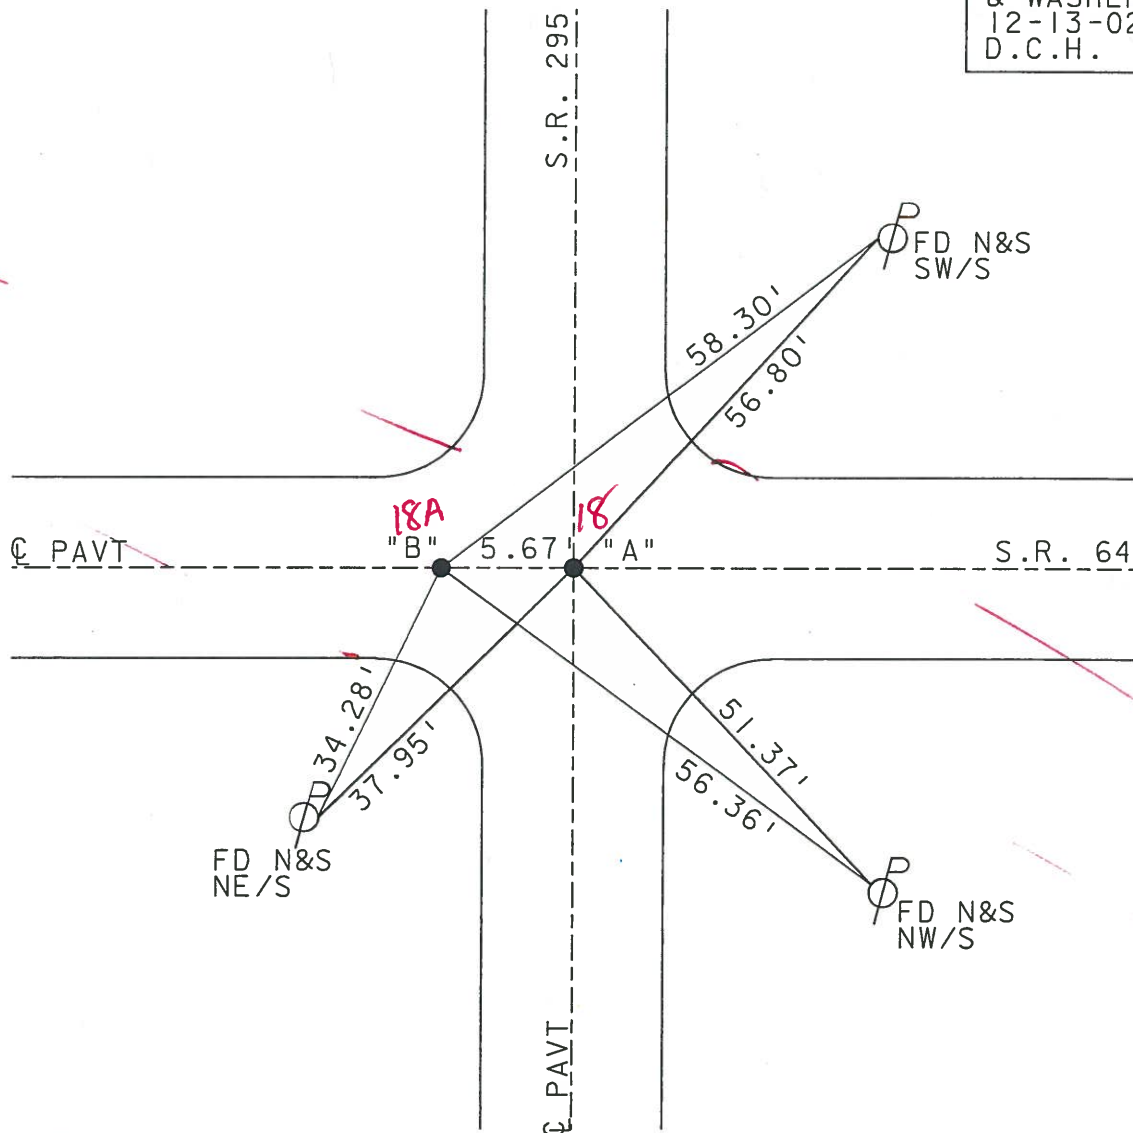

O.D.O.T. DISTRICT 2 SURVEY OFFICE

PERSONNEL

REFERENCE NO. 18

SHEET 15 OF 35

NOTES LOSHRKE

H.C. CURTIS

R.C. Luce

DATE 8-7-91

WEATHER Nice

TEMP. +80

ROUTE S.R. 295

COUNTY LUCAS

TOWNSHIP WATERVILLE

SECTION

T 7 N R 9 E

TYPE MONUMENT "A" Bolt "B" Sm. R.R. Spike


ON SURFACE - BELOW Yes

LEFT - & PAV'T. - RIGHT Yes

TO EDGE PAVEMENT

S.L.M. 339+64

Set P.K. / WASHER

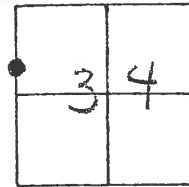

5.66' Between Pts

