

O.D.O.T. DISTRICT 2 SURVEY OFFICE (USE ONLY)

PERSONNEL

REFERENCE NO. 49

SHEET 15 OF 45

NOTES RHOADES

DATE 1/28/21

ROUTE SR 2

H.C. AUBLE

WEATHER CLOUDY

COUNTY OTTAWA

R.C. _____

TEMP. 22°

TOWNSHIP BAY

DWG BY NIESE

PID 107959

SECTION 2

T 6 N R 16 E

TYPE MONUMENT FD 3 1/2" DISK ATOP CBAR

ON SURFACE - ~~BELOW~~ ON

OFFSET CL PAVEMENT ON LT : RT

- TO - EDGE PAVEMENT


STATION: 987+12.78

HORIZ.DATUM: NAD83(2011)


GEOID: NAVD88 2018

GRID: NORTHING: 671606.608

EASTING: 1835510.688

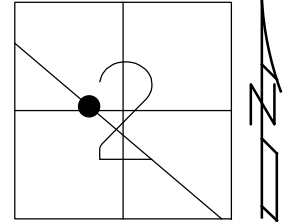

RECORD: P.O.T.
FROM 1963 PLAN
STA 143+00
FD 3 1/2" DISK
ATOP CBAR
CL12
1/28/21, DSA

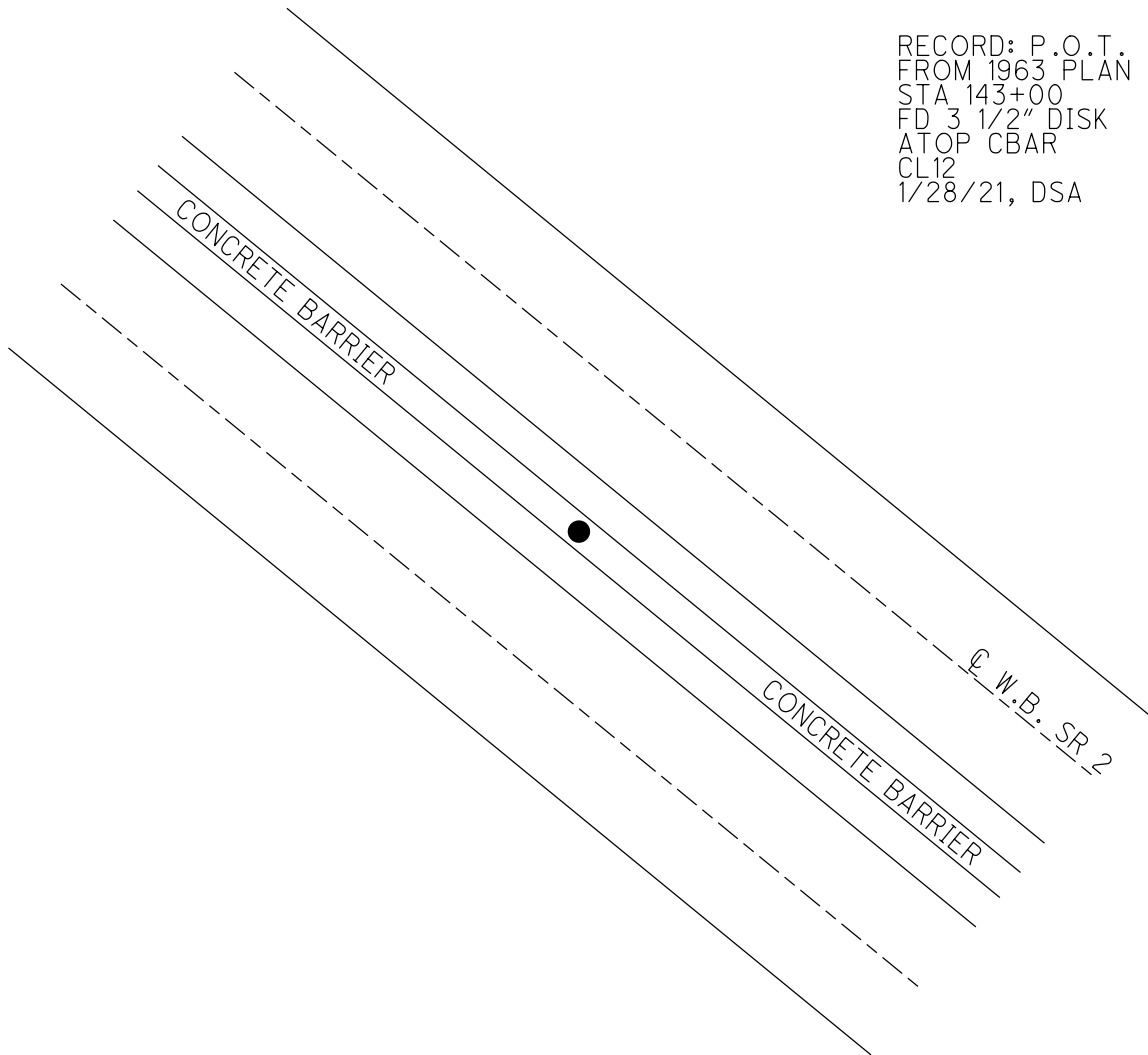

PERSONNEL TITLE PERSONNEL TITLE

SHEET NO. 4

COUNTY Ottawa

DATE 1-3-73

S. R. 2

WEATHER Cold-clear

SEC. 16.48

TEMP. 350

DESCRIPTION SEC-2 Bay Twp.

LEFT

CENTER LINE

RIGHT

JOB NO.

P.O.T.

176+00

Mon. Box set in CONC-

P.O.T.

168+00

Mon. Box set in CONC.

P.O.T.

160+00

Mon. Box set in CONC-

P.O.T.

157+00

Mon. Box set in CONC.

P.O.T.

143+00

Mon. Box set in CONC-

P.O.T.

135+00

Mon. Box set in CONC-

P.O.T.

127+00

Mon. Box set in CONC-

