

O.D.O.T. DISTRICT 2 SURVEY OFFICE (USE ONLY)

PERSONNEL

REFERENCE NO. 17

SHEET OF

NOTES ASTON
H.C. NIESE
R.C. ASTON

DATE 11/1/23
WEATHER BREEZY
TEMP. 35°

ROUTE SR 19
COUNTY OTTAWA
TOWNSHIP SALEM
SECTION 5

DWG BY BARRIERE PID 101239

T 6 N R 15 E

TYPE MONUMENT MAG NAIL/WASHER

ON SURFACE - BELOW ON

OFFSET $\odot$ PAVEMENT 2.8' LT LT : RT

 TO EDGE PAVEMENT

STATION: 175+11.58

HORIZ.DATUM: NAD 83 (2011)


GEOID: 18

GRID: NORTHING: 670672.256

EASTING: 1791810.917

LDP: NORTHING: 330168.690


EASTING: 151692.861

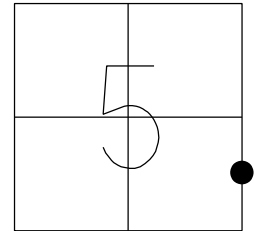

RECORD: P.I.
STA. 173+31.54
1951 PLAN
 $\Delta = 02^\circ 57' \text{ LT}$
R.R.SPIKE BELOW
SURFACE
FD P.K./WASHER
3" DOWN
8/5/96, MB
FD P.K./WASHER
1/9/06, MB
SET P.K./WASHER
5/9/07, RGN
FD MAG NAIL
REFB17
1/28/13, MC
FD MAG/WASHER
6/11/14, DCH
REF17
6/9/23, TDN
SET MAG/WASHER
11/2/23, TDN

NEAR COR.EDGE
PLAQUE
"1993 OAK HARBOR BRIDGE"
47.52'

SET SAW CUTS
FACE OF CURB

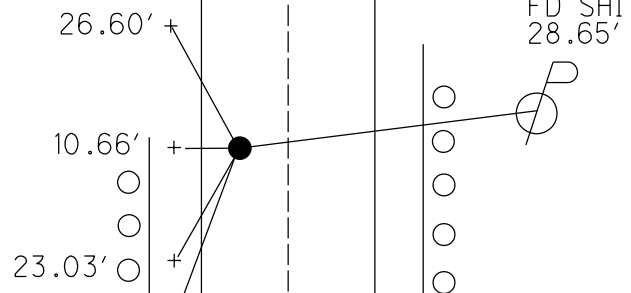


O.D.O.T. DISTRICT 2 SURVEY OFFICE (USE ONLY)

PERSONNEL _____ REFERENCE NO. 17 SHEET 20 OF 23
NOTES _____ DATE 6/11/14 ROUTE SR 19
H.C. WESTFALL WEATHER CLOUDY COUNTY OTTAWA
R.C. LEU TEMP. 70° TOWNSHIP SALEM
SECTION 5
T 6 N R 15 E


TYPE MONUMENT MAG/WASHER
ON SURFACE - ~~BELOW~~ ON
LEFT - C PAV'T - ~~RIGHT~~ 6.0'
4' TO LT EDGE PAVEMENT
S.L.M. 174+88.35

GRID: NORTHING: 670672.256 EASTING: 1791810.917

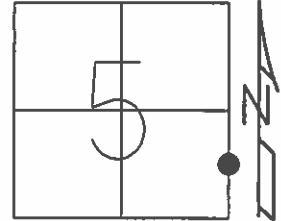

RECORD: P.I.
STA. 173+31.54
1951 PLAN
 $\Delta = 02^\circ 57' \text{ LT}$
R.R.SPIKE BELOW
SURFACE
FD P.K./WASHER
3" BELOW
8/5/96, MB
SET P.K./WASHER
5/9/07, RGN
FD MAG NAIL
GPS, REFB17
1/28/13, MC

NEAR COR.
0.1' UP PLAQUE
"1993 OAK HARBOR BRIDGE"
47.53'

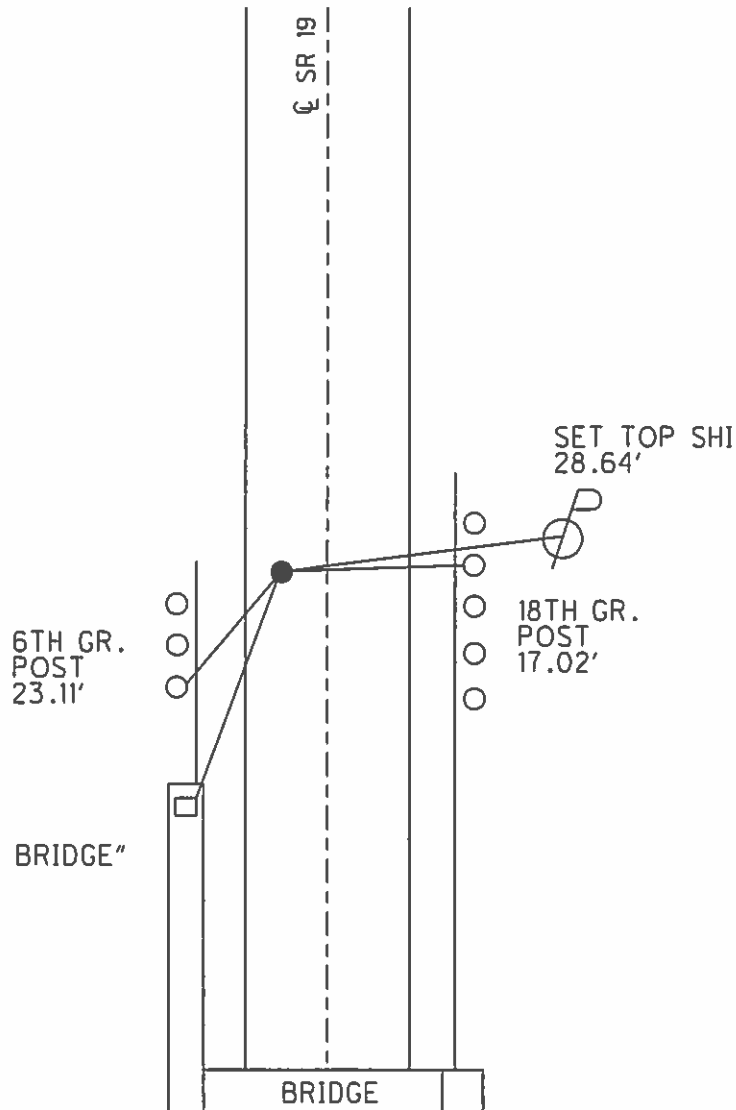

O.D.O.T. DISTRICT 2 SURVEY OFFICE

PERSONNEL

REFERENCE NO. 17

SHEET 16 OF 22

NOTES BARNHISEL

H.C. ROUSOS

R.C. HANES

CORDES II

DATE 8-5-96

WEATHER SUNNY

TEMP. +75°

ROUTE SR 19

COUNTY OTTAWA

TOWNSHIP SALEM

SECTION 5

T 8 N R 15 E

TYPE MONUMENT P.K. / WASHER


~~ON SURFACE~~ - ~~BELOW~~ 3"

~~LEFT - & PAINT - RIGHT~~ 1 1/2"

TO EDGE PAVEMENT

S.L.M. 11 + 33.76 (1931 BRIDGE PLAN)

173 + 31.54 (1951 PLAN)

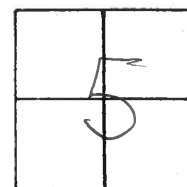

NOTE: OAK HARBOR
CORP LINE

173 + 89.13 (REC)

CORP. LINE

P.I.

Δ = 02° 57' LT (PLAN)

Δ = 02° 58' LT 1931 BRIDGE PLAN

R.R. SPIKE BELOW SURFACE



SR 19

E PAINT



POINT REMOVED

DUE TO NEW BRIDGE

1995 CONSTRUCTION. THIS

POINT NOW LIES ON

NEW BRIDGE

O.D.O.T. DISTRICT 2 SURVEY OFFICE

PERSONNEL

REFERENCE NO. 17

SHEET 27 OF

NOTES

H.C.

R.C.

CRONIN

RIPPLE

GEYMAN

DATE

WEATHER

TEMP.

4/19/89

SUNNY

56°

ROUTE

COUNTY

TOWNSHIP

SECTION

T. G. N. R.

#19

OTTAWA

SALEM-HARBOR ^{OAK}

4

15 E

TYPE MONUMENT

ON SURFACE - BELOW

LEFT- & PAV'T. - RIGHT

TO EDGE PAVEMENT


S.L.M.

P.K.

3"

1 1/2"

11 + 33.76 (1931 BRIDGE PLAN)
173 + 31.54 (1951 PLAN)

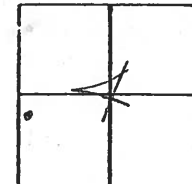

NOTE:
POINT REMOVED
NEW BRIDGE BUILT
1995

173+89.13


C/L

P.I.

A = 02° 57' LT. (PLAN)

D = 02° 58' LT. 1931 BRIDGE PLAN

R.R. SPIKE BELOW SURFACE

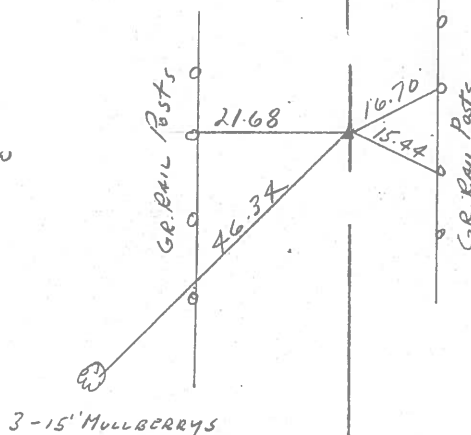

Q.D.O.T. DISTRICT 2 SURVEY OFFICE

SHEET

OF

County OTTAWA S.R. 19

Township SALEM

Section 5

T8N, R15E

Personnel HOFFMAN

Householder


Loehrke

#17

Date 7-27-81

Weather cloudy

Temp. +70°

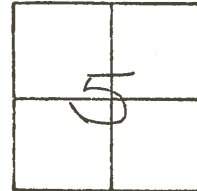


Fd. P.K. Nail & Washer @ surface

13.1' to W. EP.

10.0' to E. EP.

1.5' E. of R. PAUT.

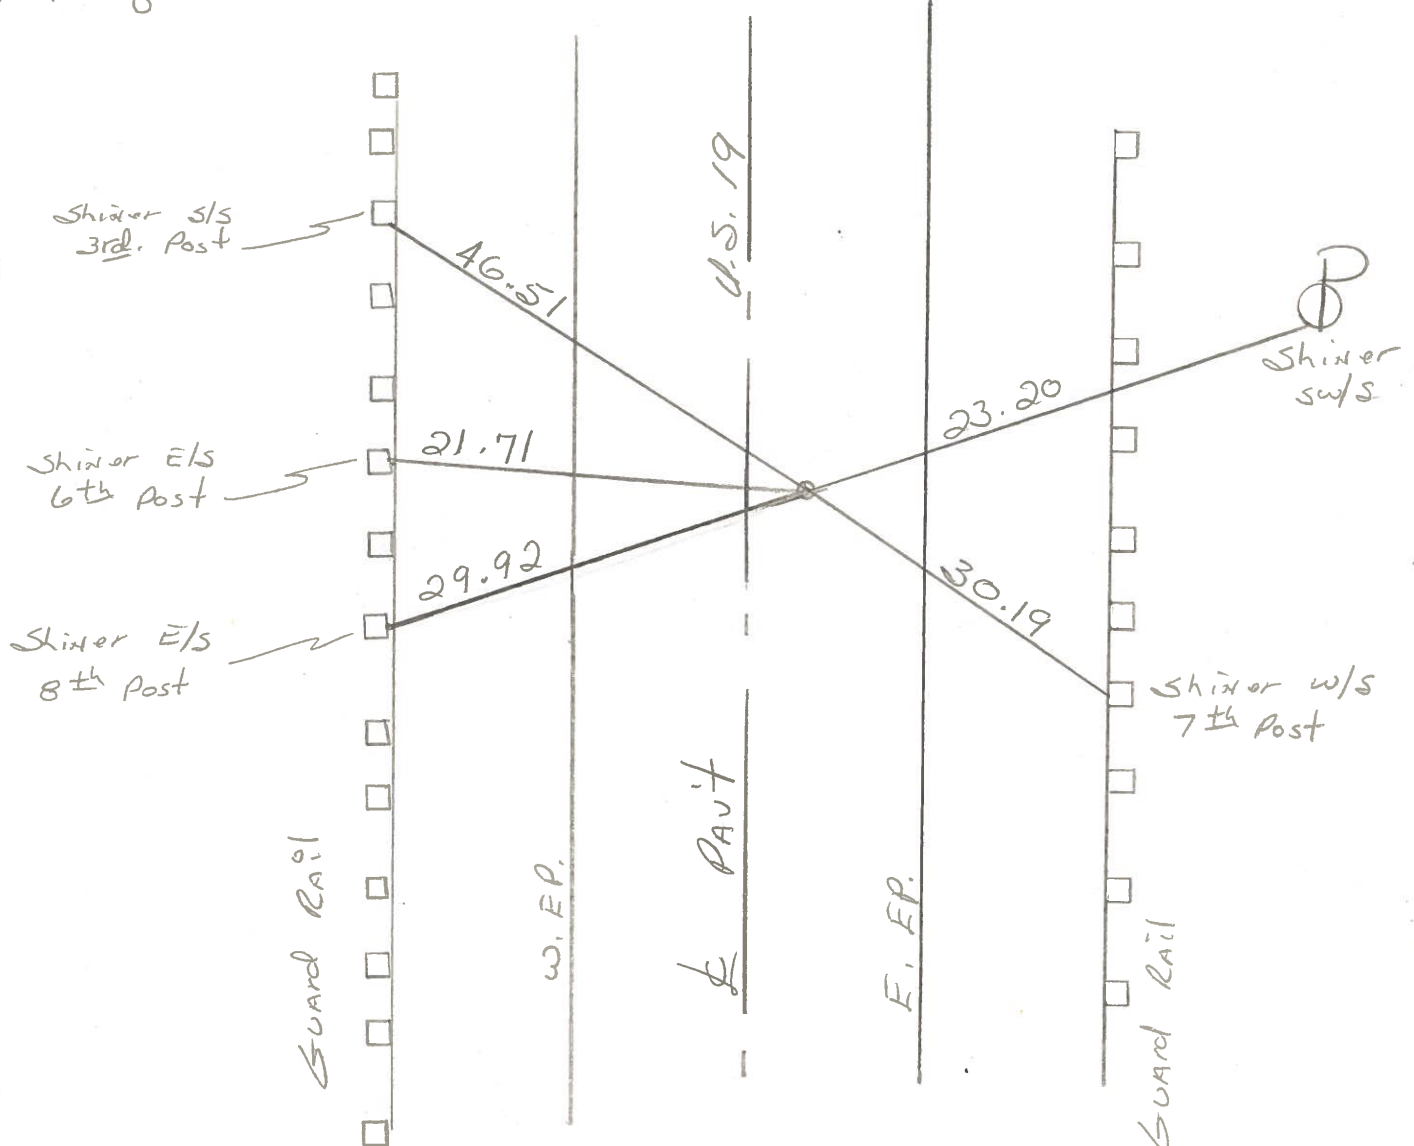

OAK HARBOR CORP. LINE

PERSONNEL	TITLE	PERSONNEL	TITLE
1	2	3	4
5	6	7	8
9	10	11	12
13	14	15	16
17	18	19	20
21	22	23	24
25	26	27	28
29	30	31	32
33	34	35	36
37	38	39	40
41	42	43	44
45	46	47	48
49	50	51	52
53	54	55	56
57	58	59	60
61	62	63	64
65	66	67	68
69	70	71	72
73	74	75	76
77	78	79	80
81	82	83	84
85	86	87	88
89	90	91	92
93	94	95	96
97	98	99	100

COUNTY Ottawa DATE 4-25-78

S. R. 17 WEATHER fair


SEC. 33 TEMP. 33

DESCRIPTION	JOB NO.
Oak Harbor & 1 point south	

LEFT

CENTER LINE

RIGHT

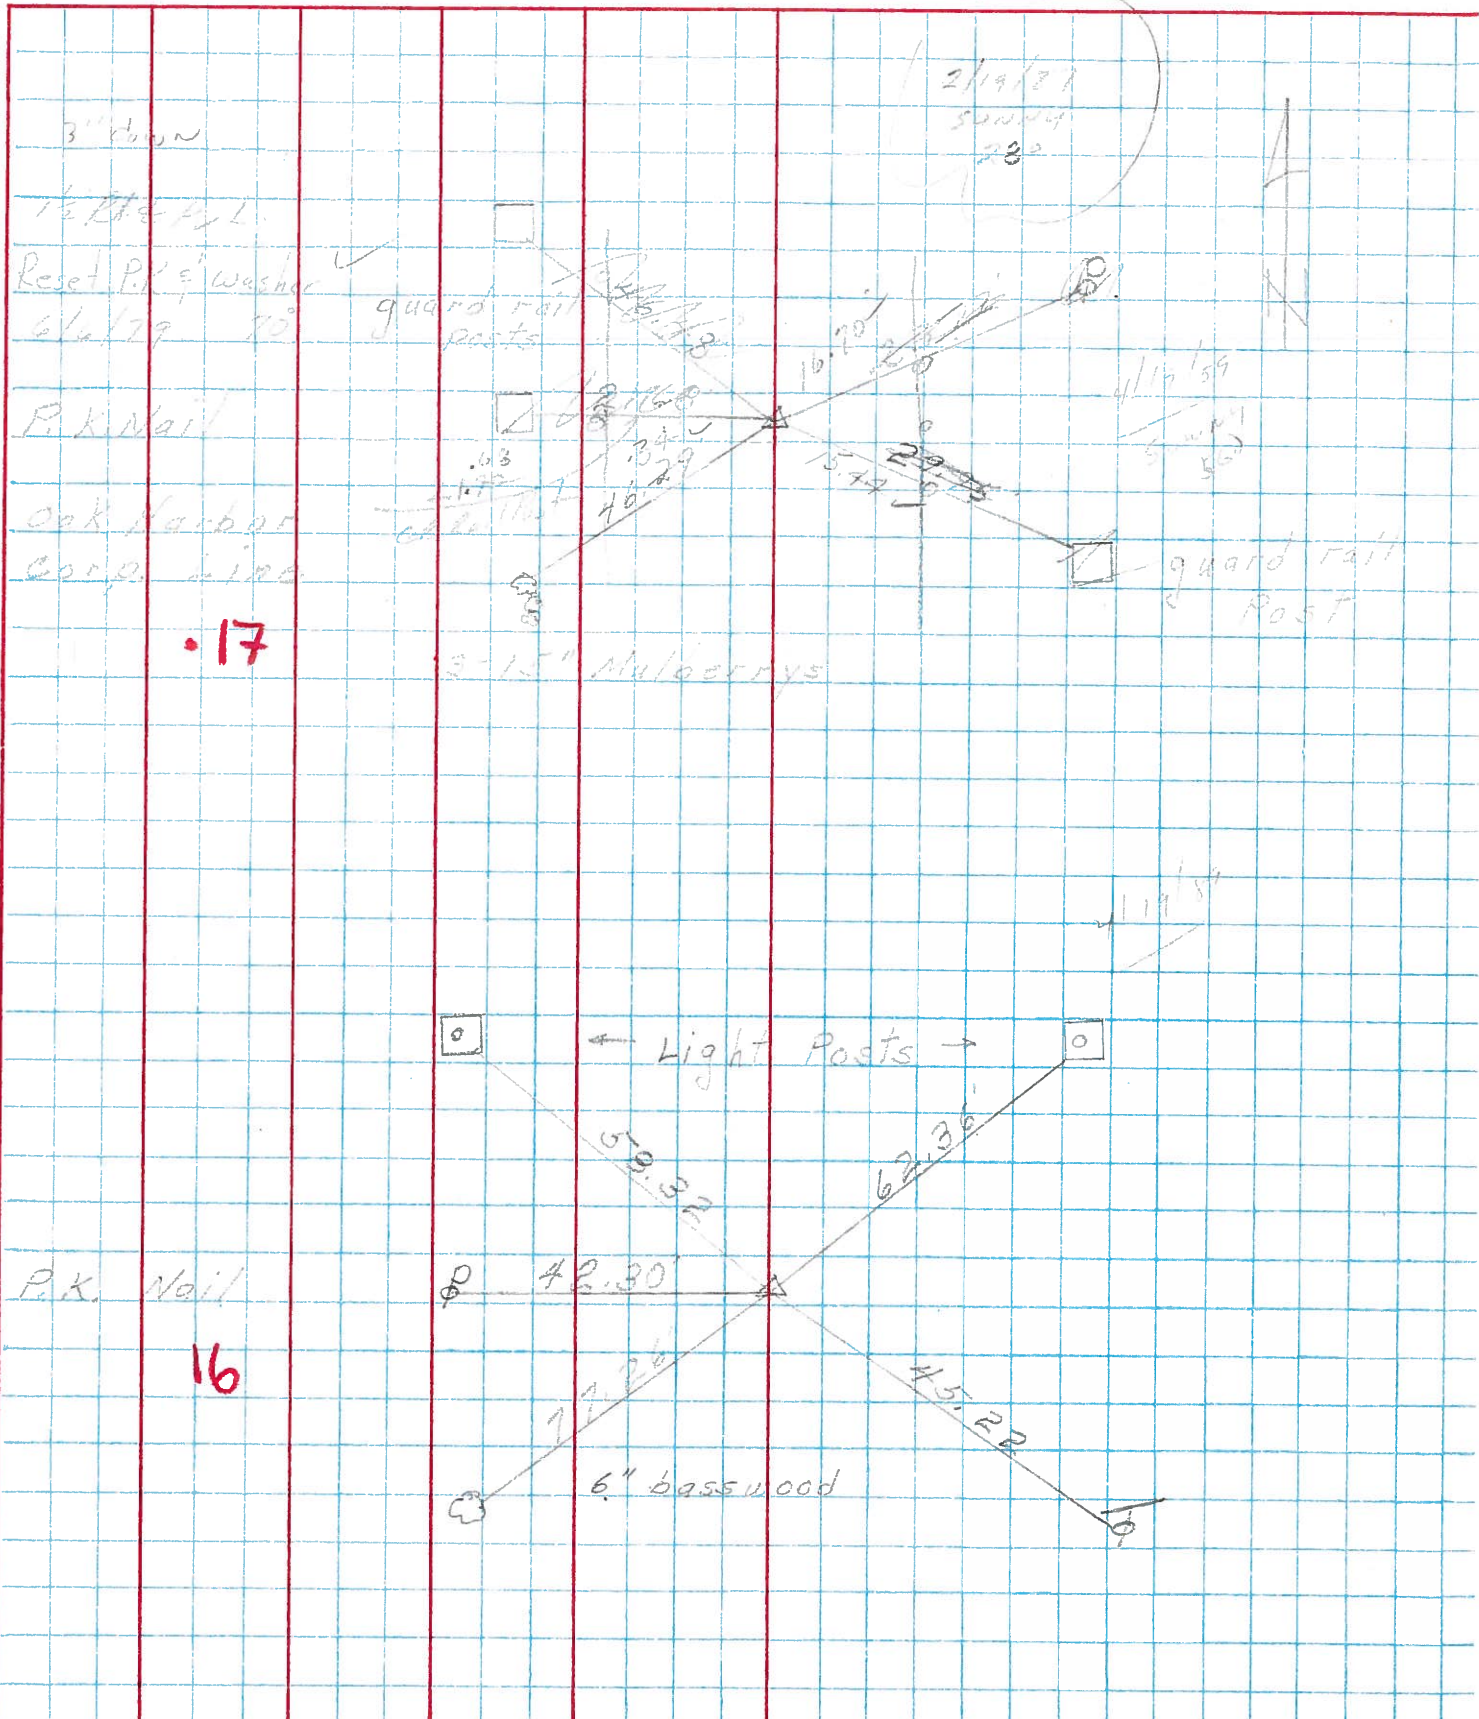


PERSONNEL TITLE PERSONNEL TITLE

COUNTY Ottawa DATE 5-4-71S. R. 19 WEATHERSEC. 5 & 4 TEMP.DESCRIPTION Oak Harbor & 1 point south JOB NO.

LEFT

CENTER LINE

RIGHT

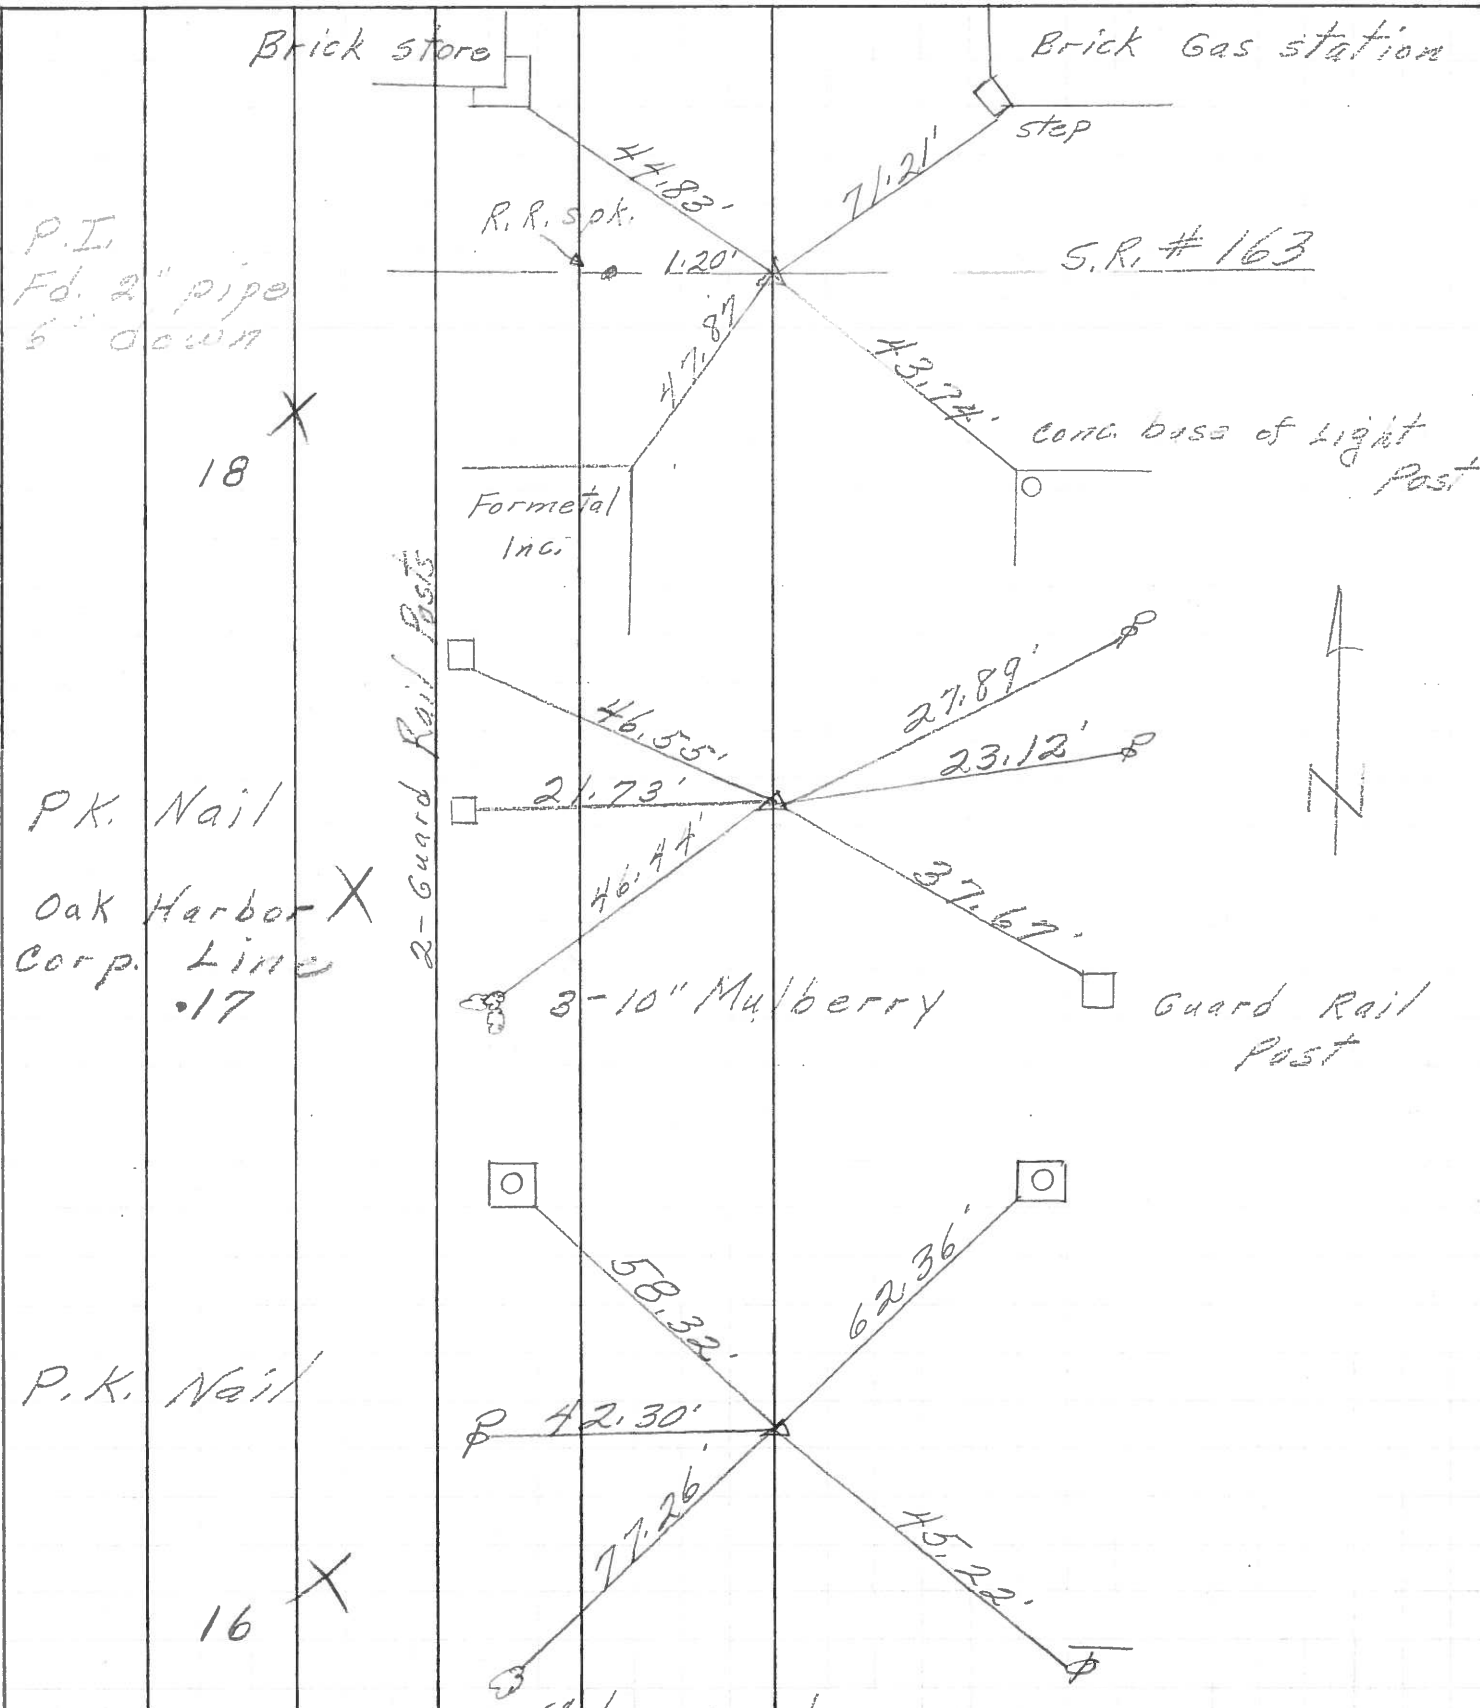

PERSONNEL	TITLE	PERSONNEL	TITLE
Schneider			
Mosser			
Barbour			
Redding			

COUNTY Ottawa DATE 5-13-68S. R. 19 WEATHER FairSEC. San. Co. Line North TEMP. 60'DESCRIPTION Ties for Control Points JOB NO. _____

LEFT

CENTER LINE

RIGHT

