

O.D.O.T. DISTRICT 2 SURVEY OFFICE (USE ONLY)

PERSONNEL

REFERENCE NO. 17 A

SHEET OF

NOTES ASTON

DATE 11/2/23

ROUTE SR 19

H.C. NIESE

WEATHER BREEZY

COUNTY OTTAWA

R.C. ASTON

TEMP. 35°

TOWNSHIP SALEM

DWG BY BARRIERE

PID 101239

SECTION 5

T 6 N R 15 E

TYPE MONUMENT MAG NAIL/WASHER

ON SURFACE - BELOW ON

OFFSET Q PAVEMENT 6.4' LT LT : RT

 TO EDGE PAVEMENT

STATION: 179+97.93

HORIZ.DATUM: NAD 83 (2011)


GEOID: 18

GRID: NORTHING: 670672.256


EASTING: 1791810.917

LDP: NORTHING: 330168.690

EASTING: 151692.861

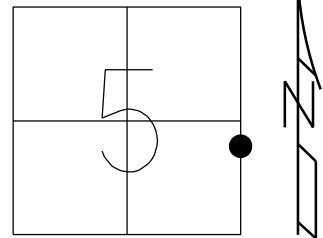


RECORD:
FD MAG/WASHER
2/1/06, RGN
SET MAG/WASHER
11/6/07, SAH
FD MAG/WASHER
REFC17
1/28/13, MC
FD MAG/WASHER
REF17A
6/29/23, TDN
SET MAG/WASHER
11/2/23, TDN

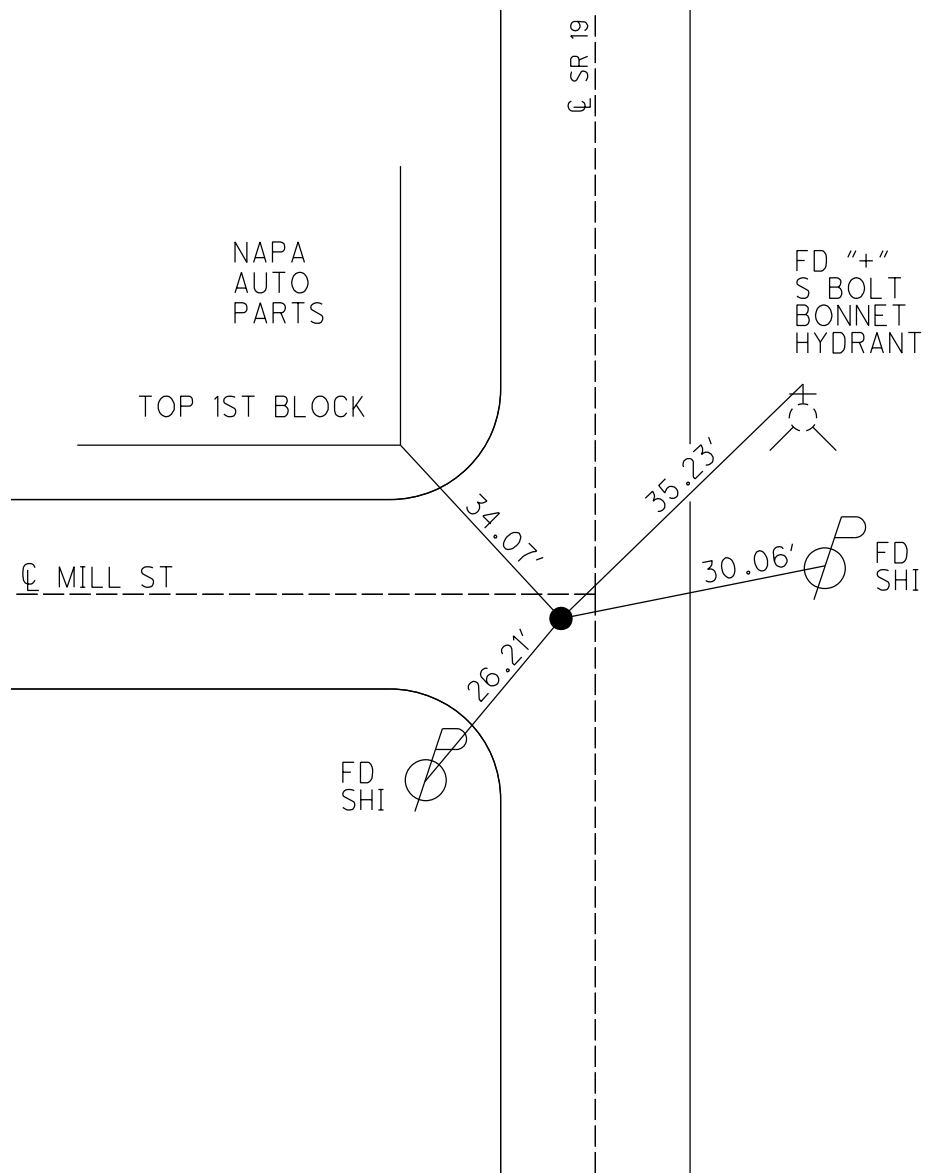

O.D.O.T. DISTRICT 2 SURVEY OFFICE (USE ONLY)


PERSONNEL	REFERENCE NO.	17 A	SHEET	21	OF	23
NOTES	HUSS	DATE	2/1/06	ROUTE	SR 19	
H.C.	NUHFER	WEATHER	PTLY.CLOUDY	COUNTY	OTTAWA	
R.C.	RYAN H.	TEMP.	33°	TOWNSHIP	SALEM	
				SECTION	5	
				T	6 N	R 15 E

TYPE MONUMENT MAG/WASHER
 ON SURFACE - ~~BELOW~~ ON
 LEFT - CL PAV'T - RIGHT ON
13' TO LT EDGE PAVEMENT
 S.L.M. 179+74.69

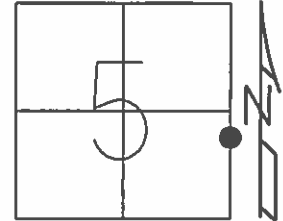

GRID: NORTHING: 671158.394 EASTING: 1791823.836

RECORD:
 FD MAG/WASHER
 GPS, REFC17
 1/28/13, MC

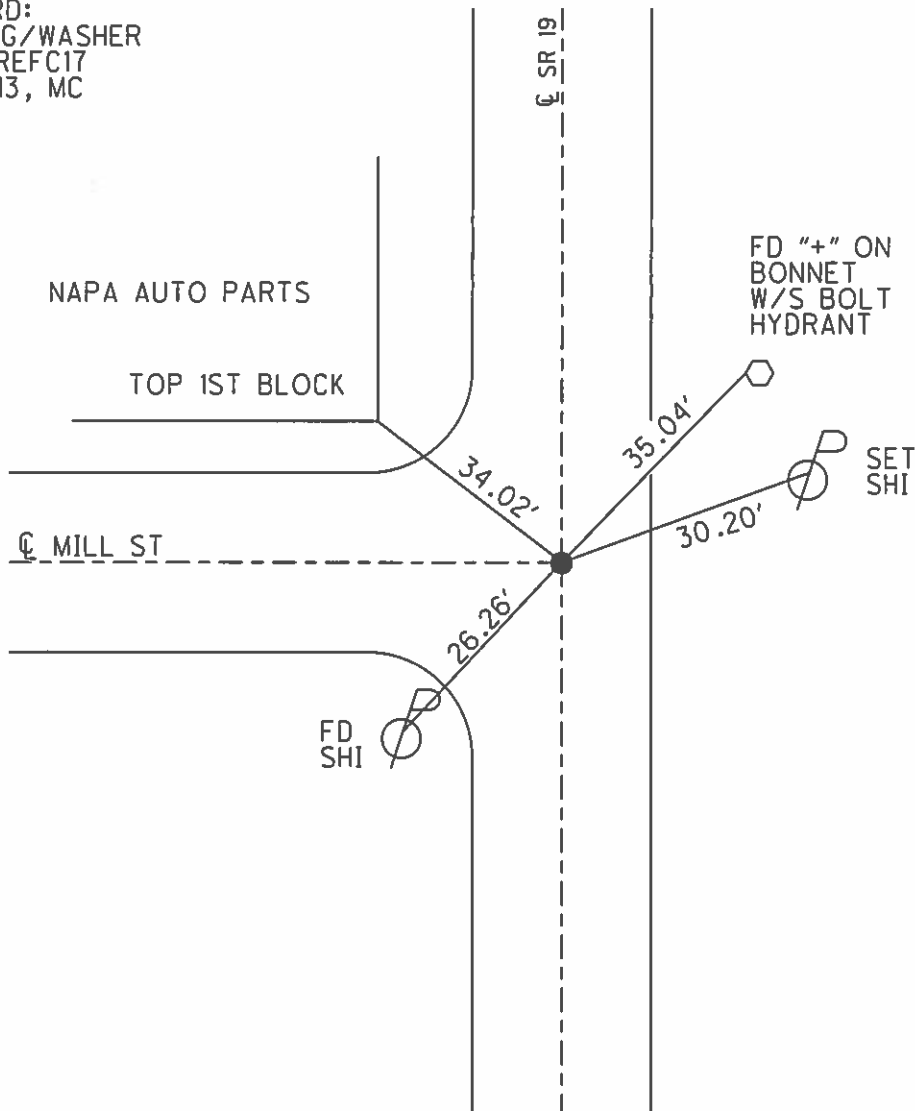

O.D.O.T. DISTRICT 2 SURVEY OFFICE (USE ONLY)

PERSONNEL

REFERENCE NO.

16 A

SHEET

2

OF 33

NOTES

HUSS

DATE

2/1/06

ROUTE

SR 19

H.C.

NUHFER

WEATHER

PTLY.CLOUDY

COUNTY

OTTAWA

R.C.

RYAN H.

TEMP.

33

TOWNSHIP

SALEM

SECTION

5

T 6 N R 15 E

TYPE MONUMENT

MAG / WASHER

ON SURFACE -

~~BELOW~~

ON

LEFT -

Q

PAV'T - RIGHT

ON

13'

TO

W

EDGE PAVEMENT

S.L.M.


179+98

Grid: Northing:

671158.394

Easting:

1791823.836

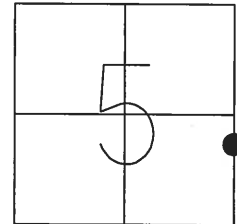

17A

NAPA AUTO PARTS
TOP 1ST BLOCK

Q MILL ST

FD
SHI

FD "+" ON
W/S BONNET
BOLT, HYDRANT

SET
SHI

Q SR 19