

O.D.O.T. DISTRICT 2 SURVEY OFFICE (USE ONLY)

PERSONNEL

REFERENCE NO. 18

SHEET OF

NOTES ASTON
H.C. NIESE
R.C. ASTON

DATE 11/2/23
WEATHER BREEZY
TEMP. 35°

ROUTE SR 19
COUNTY OTTAWA
TOWNSHIP SALEM
SECTION 5
T 6 N R 15 E

DWG BY BARRIERE PID 101239

TYPE MONUMENT MAG NAIL/WASHER

ON SURFACE - BELOW ON

OFFSET $\varnothing$ PAVEMENT ON LT : RT

 TO EDGE PAVEMENT

STATION: 182+15.88

HORIZ.DATUM: NAD 83 (2011)


GEOID: 18

GRID: NORTHING: 671376.281


EASTING: 1791829.712

LDP: NORTHING: 330872.894

EASTING: 151706.871

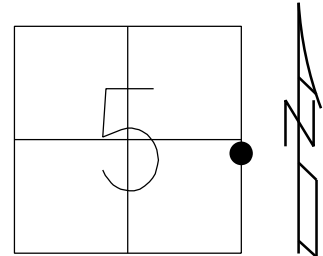

RECORD: P.I.
STA. 180+35.98
 $\Delta = 01^\circ 00' \text{ LT}$
1950 PLANS
1/2" IPIN
2" DOWN
SET P.K./WASHER
11/4/96, MRC
FD P.K./WASHER
1/9/06, MB
FD P.K./WASHER
REF18
1/15/13, MC
FD MAG/WASHER
REF18
6/30/23, TDN
SET MAG/WASHER
11/2/23, TDN

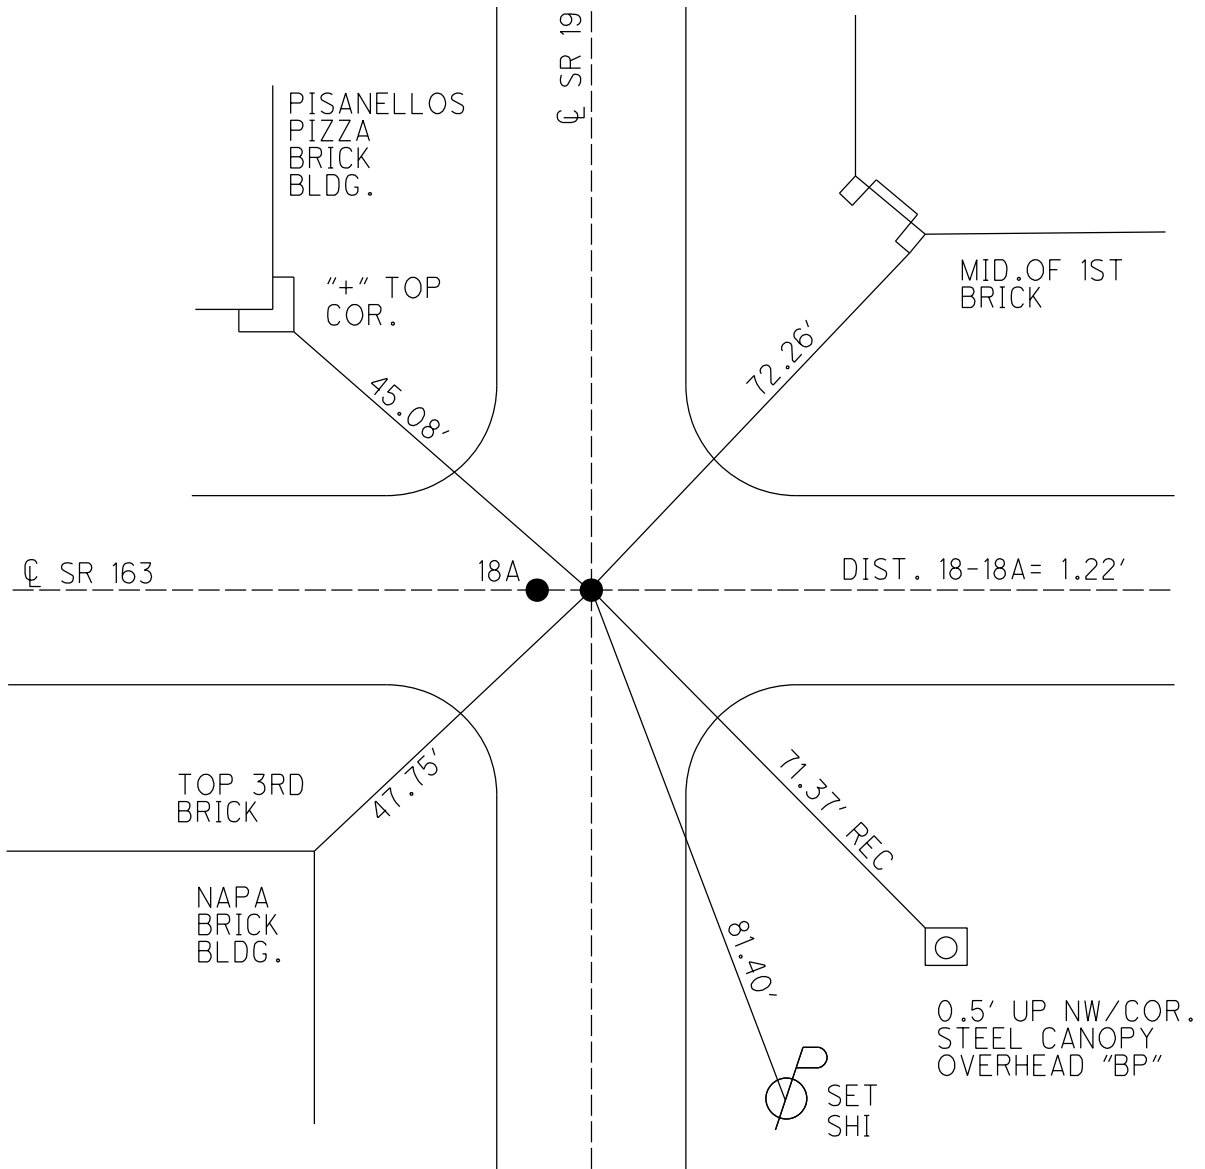

NOTE:
SR 163
STA. 752+40
REF 50C

O.D.O.T. DISTRICT 2 SURVEY OFFICE (USE ONLY)

PERSONNEL

REFERENCE NO.

18

SHEET

22

OF 23

NOTES

NUHFER

DATE

1/9/06

ROUTE

SR 19

H.C.

CANTERBURY

WEATHER

CLOUDY

COUNTY

OTTAWA

R.C.

BARNHISEL

TEMP.

32°

TOWNSHIP

SALEM

SECTION

5

T 6 N

R 15 E

TYPE MONUMENT P.K./WASHER


ON SURFACE - ~~BELOW~~ ON

LEFT - CL PAV'T - RIGHT ON

- TO - EDGE PAVEMENT


S.L.M. 181+92.63

GRID: NORTHING: 671376.281 EASTING: 1791829.712

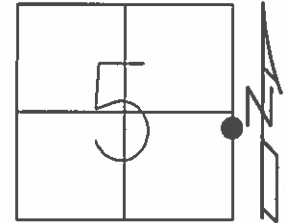

RECORD:

1/2" IPIN 2" BELOW
SET P.K./WASHER
11/4/96, MRC
FD P.K./WASHER
GPS, REF18
1/15/13, MC

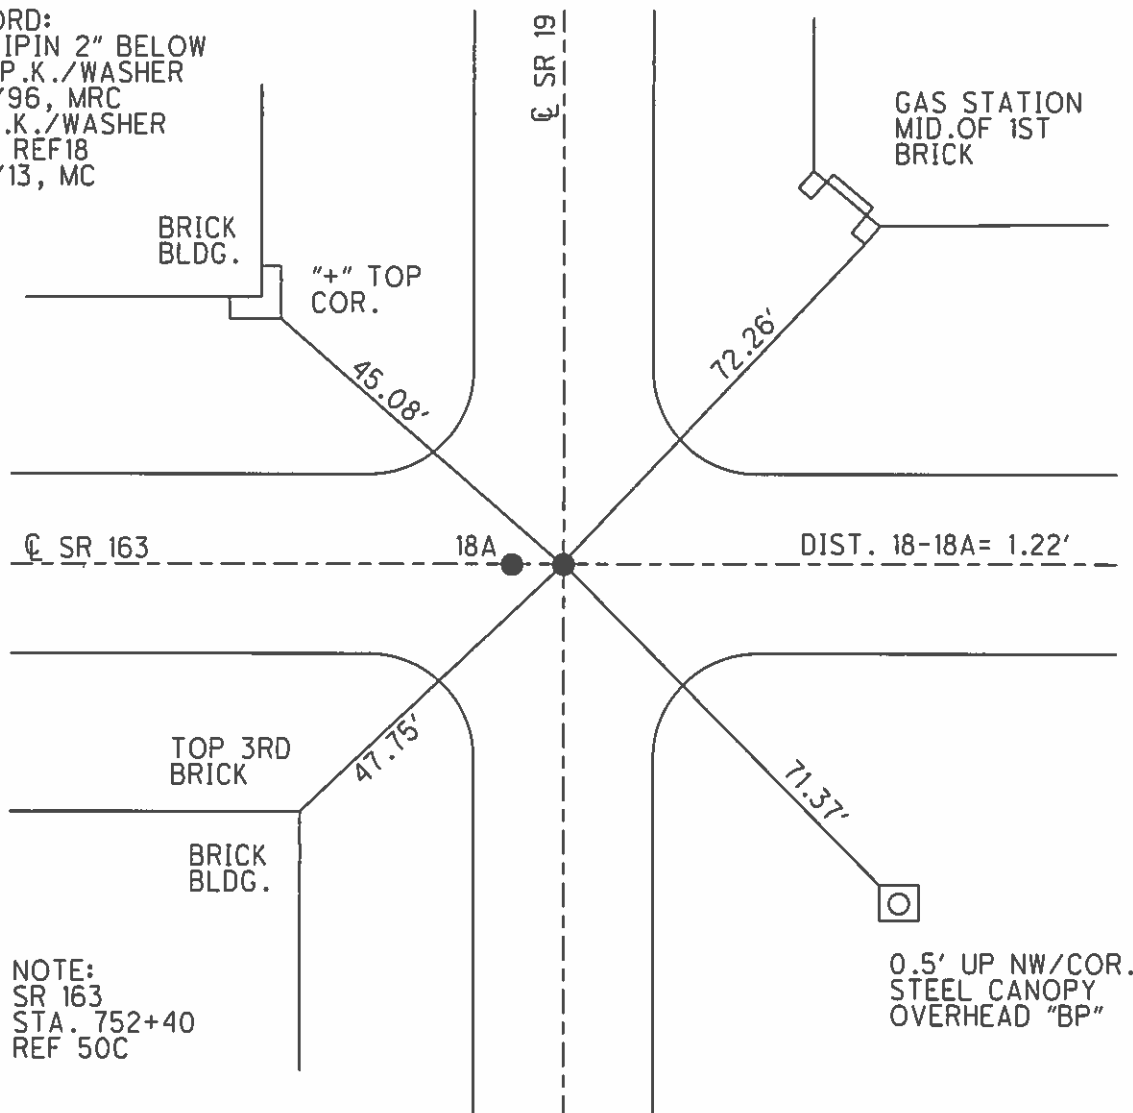

O.D.O.T. DISTRICT 2 SURVEY OFFICE (USE ONLY)

PERSONNEL

REFERENCE NO.

17

SHEET

3

OF 33

NOTES NUHFER

DATE

1/9/06

ROUTE

SR 19

H.C. CANTERBURY

WEATHER

CLOUDY

COUNTY

OTTAWA

R.C. BARNHISEL

TEMP.

32°

TOWNSHIP

SALEM

SECTION

5

T 6 N R 15 E

TYPE MONUMENT P.K./WASHER


ON SURFACE - ~~BELOW~~ ON

LEFT - Q PAV'T - RIGHT ON


- TO - EDGE PAVEMENT

S.L.M. 182+16

Grid: Northing: 671376.343 Easting: 1791829.711

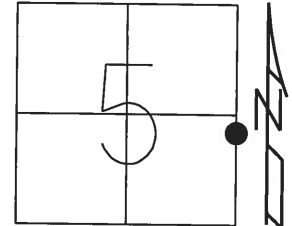

NOTE:
1/2" IPIN 2" BELOW
SURFACE, ORIGIN UNKNOWN.
PT. TO WEST.

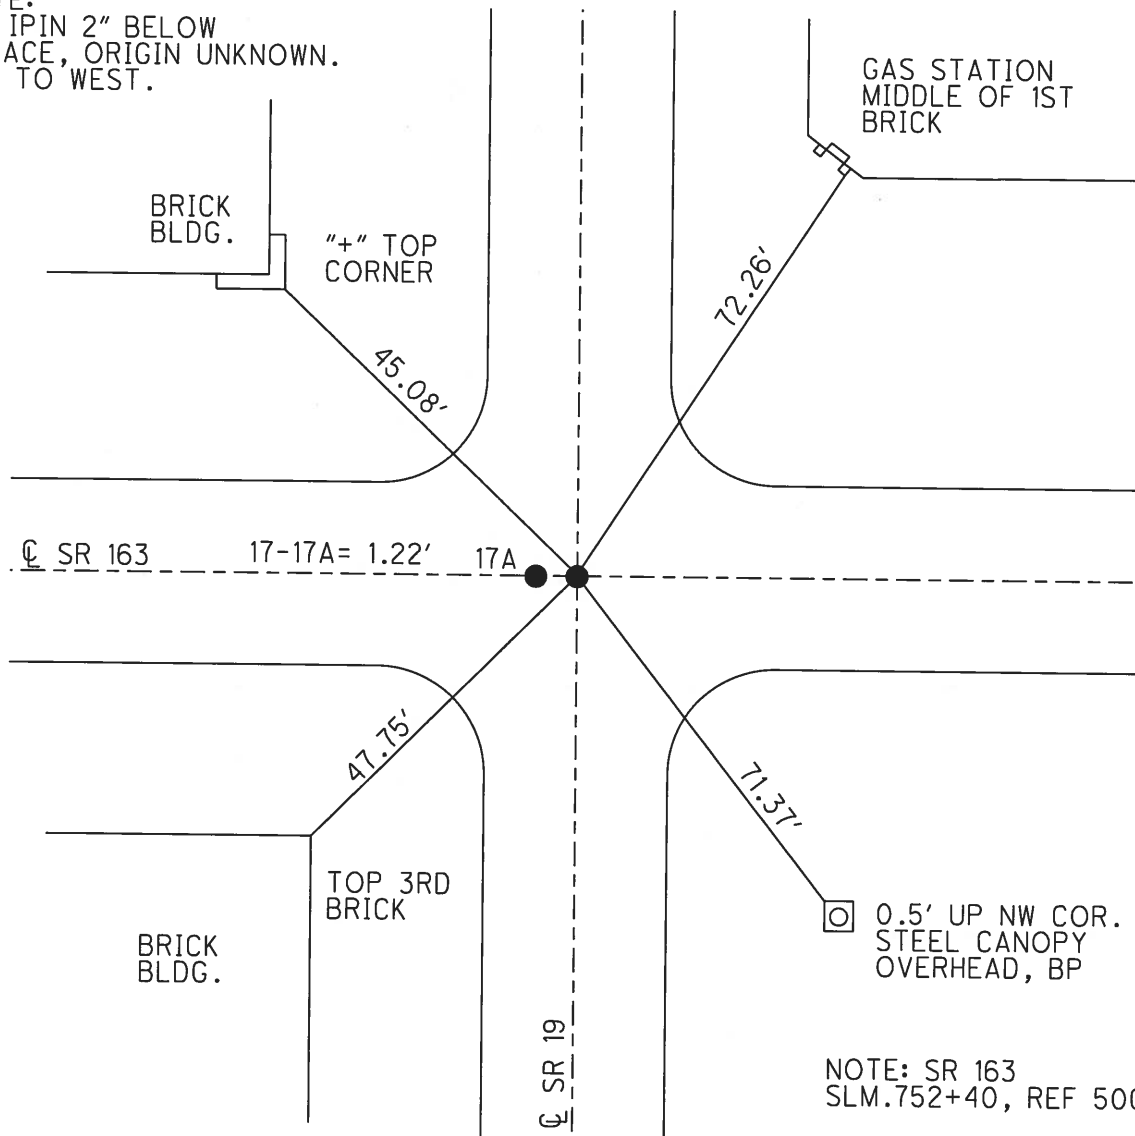

NOTE: SR 163
SLM.752+40, REF 50C

O.D.O.T. DISTRICT 2 SURVEY OFFICE

PERSONNEL

REFERENCE NO. 18#18A

SHEET 17 OF 22

NOTES BARNHISEL

H.C. ROUSOS

R.C. HAINES

CORDES ☒

DATE 11.4.96

WEATHER _____

TEMP. _____

ROUTE 19

COUNTY OTTAWA

TOWNSHIP SALEM OAK HARBOR

SECTION 4

T6 N R 15 E


TYPE MONUMENT PIK + WASHERS EAST & WEST

ON SURFACE - BELOW ON SURFACE

LEFT- & PAV'T. - RIGHT PK ON & SR 163, 163+19


-TO- EDGE PAVEMENT

S.L.M. 182+06 (180+35.98 = 1951 Plans)

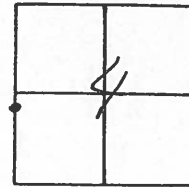

RESET P.K/WASHERS 11/4/96 M.R.C.

1/2" I-PIN 2" Below
Surface
Origin UNKNOWN (Pt. to W.)

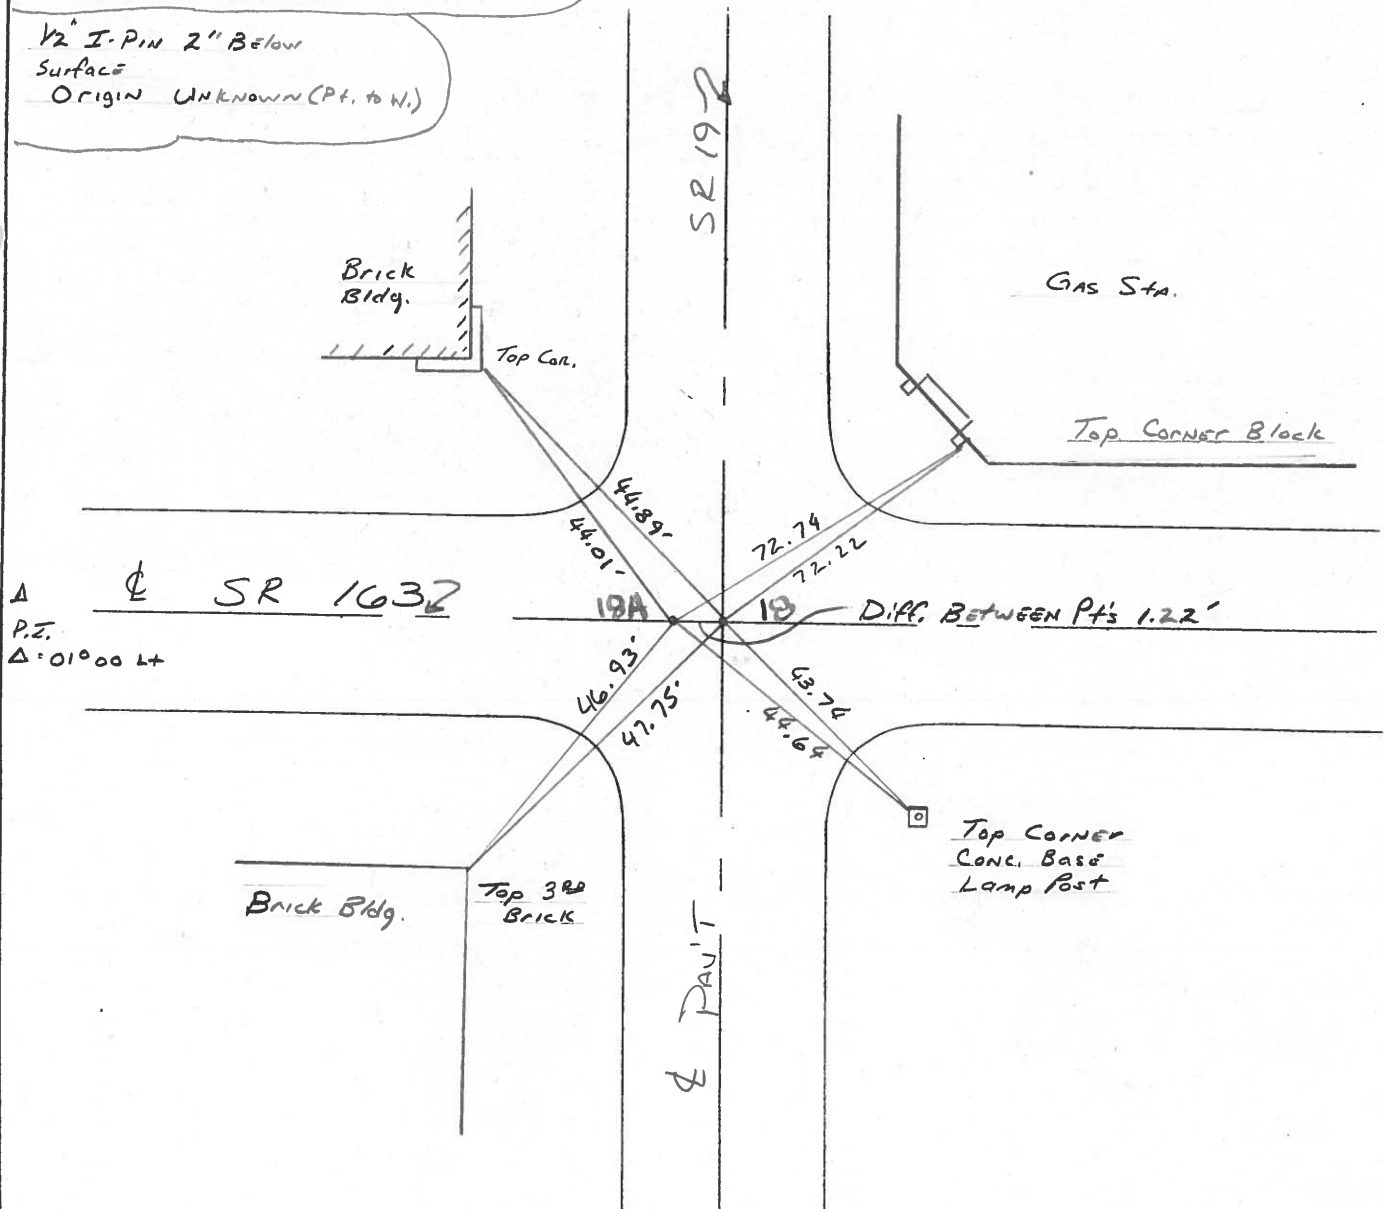

Δ SR 163
P.T.
Δ = 01°00' L+

O.D.O.T. DISTRICT 2 SURVEY OFFICE

PERSONNEL

REFERENCE NO. 18 E 18A SHEET 18 OF

NOTES CRONIN

H.C. RIPPLE

R.C. GEYMAN

DATE 4/20/89

WEATHER SUNNY

TEMP. 52°

ROUTE #19

COUNTY OTTAWA

TOWNSHIP SALEM HARBOR

SECTION 4

T 6 N R 15 E


TYPE MONUMENT 5/8" IRON

ON SURFACE - BELOW 1"


LEFT - PAV'T. - RIGHT

TO EDGE PAVEMENT

S.L.M. 180+3598 (1951 Plans)

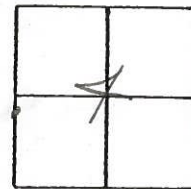

PI
A=0°00'24"

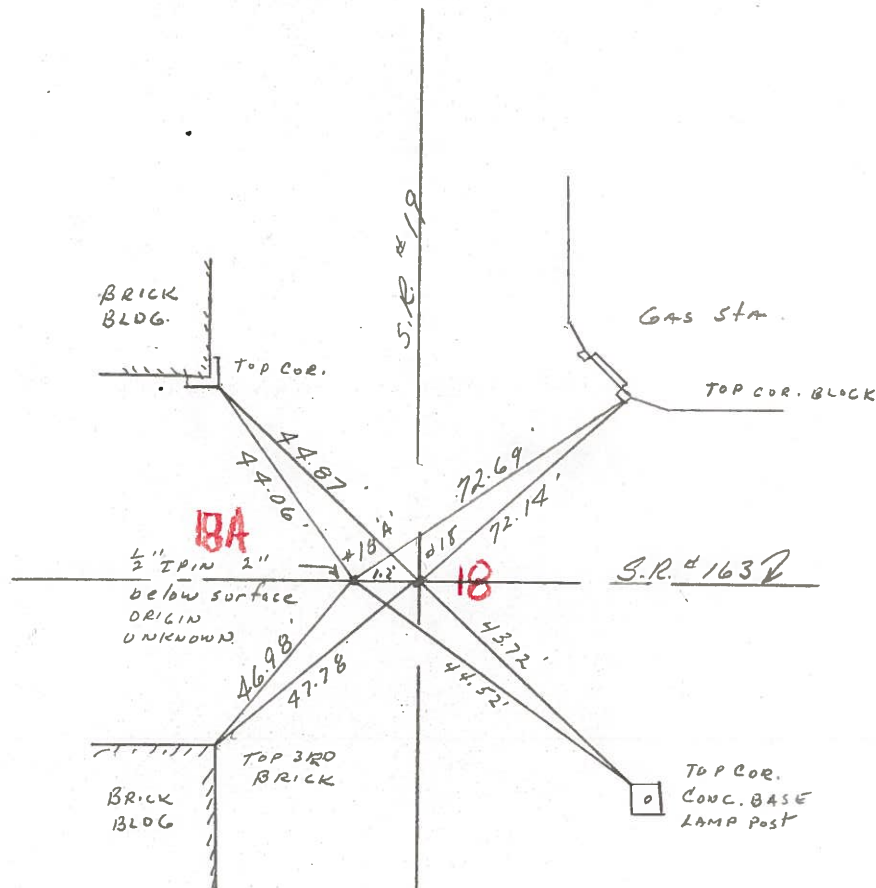

Q.D.O.T. DISTRICT 2 SURVEY OFFICE

SHEET

OF

County OTTAWA S.R. 19

Township SALEM

Section 5

T8N, R15E

Personnel HOFFMAN

Householder


Loehrke

#18

Date 7-27-81


Weather cloudy

Temp. +70°

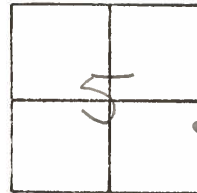

Pt. "A" Fd. 1" IRON Rod 2" below surface. 1971 Notes call for a 2" pipe, 6" down

Pt. "B" Fd R.R. SPK 1" below surface.

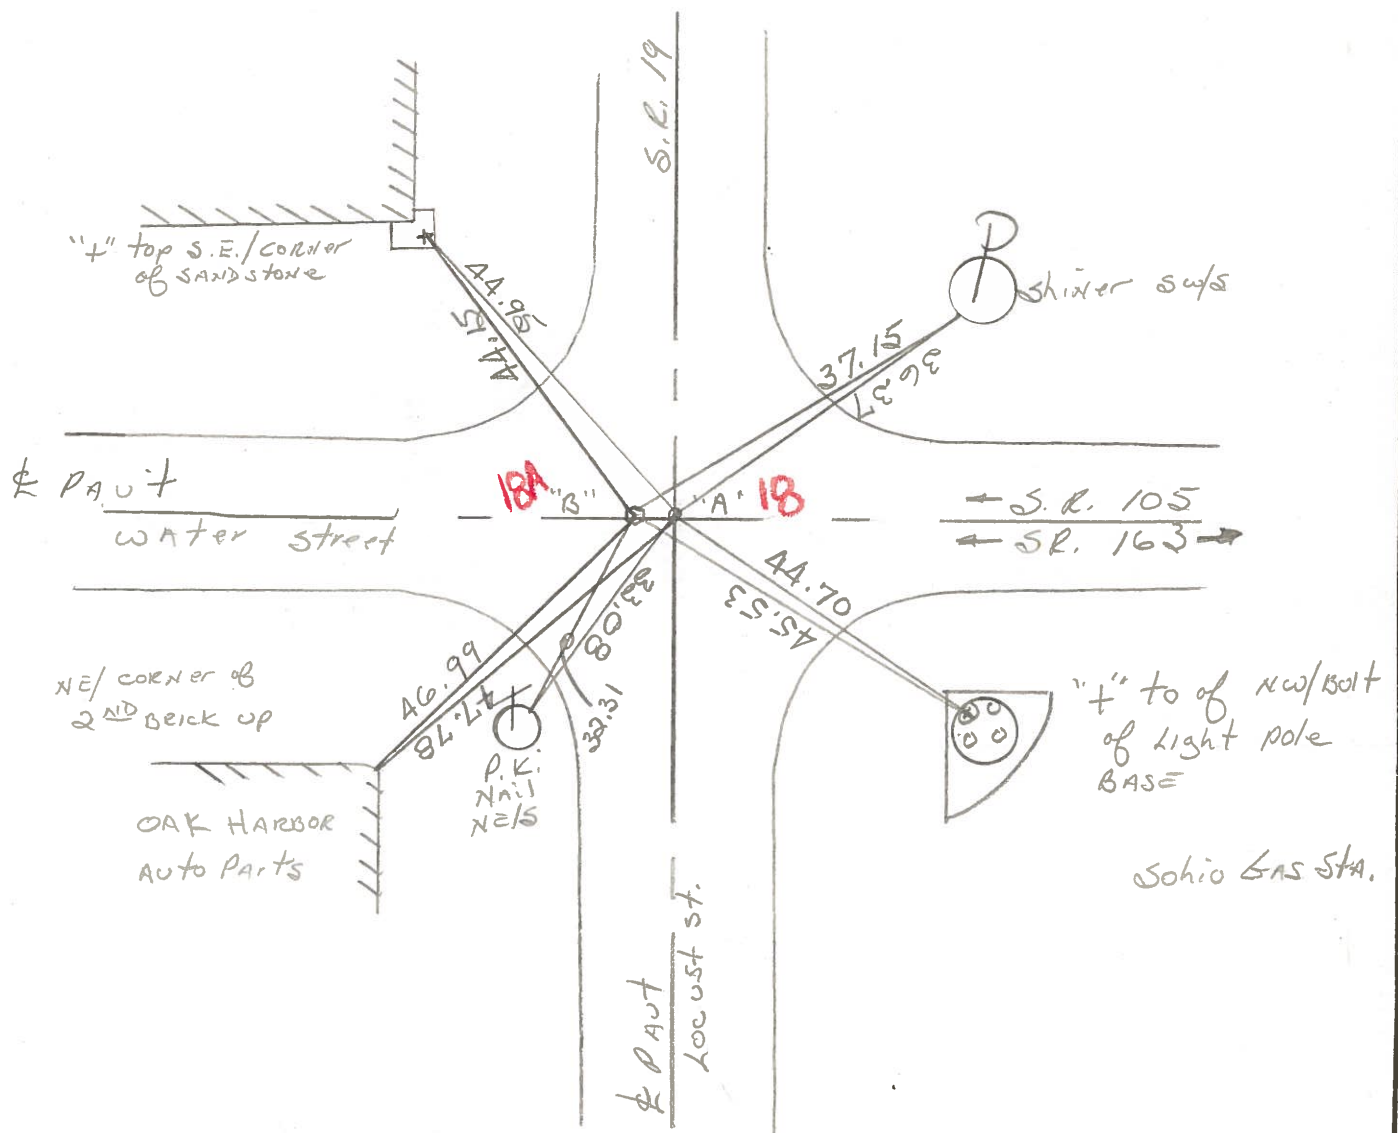

PERSONNEL TITLE PERSONNEL TITLE

COUNTY OttawaDATE 5-4-71S. R. 19

WEATHER

SEC. 5 & 4

TEMP.

DESCRIPTION


Oak Harbor & 1 point south

JOB NO.

LEFT

CENTER LINE


RIGHT

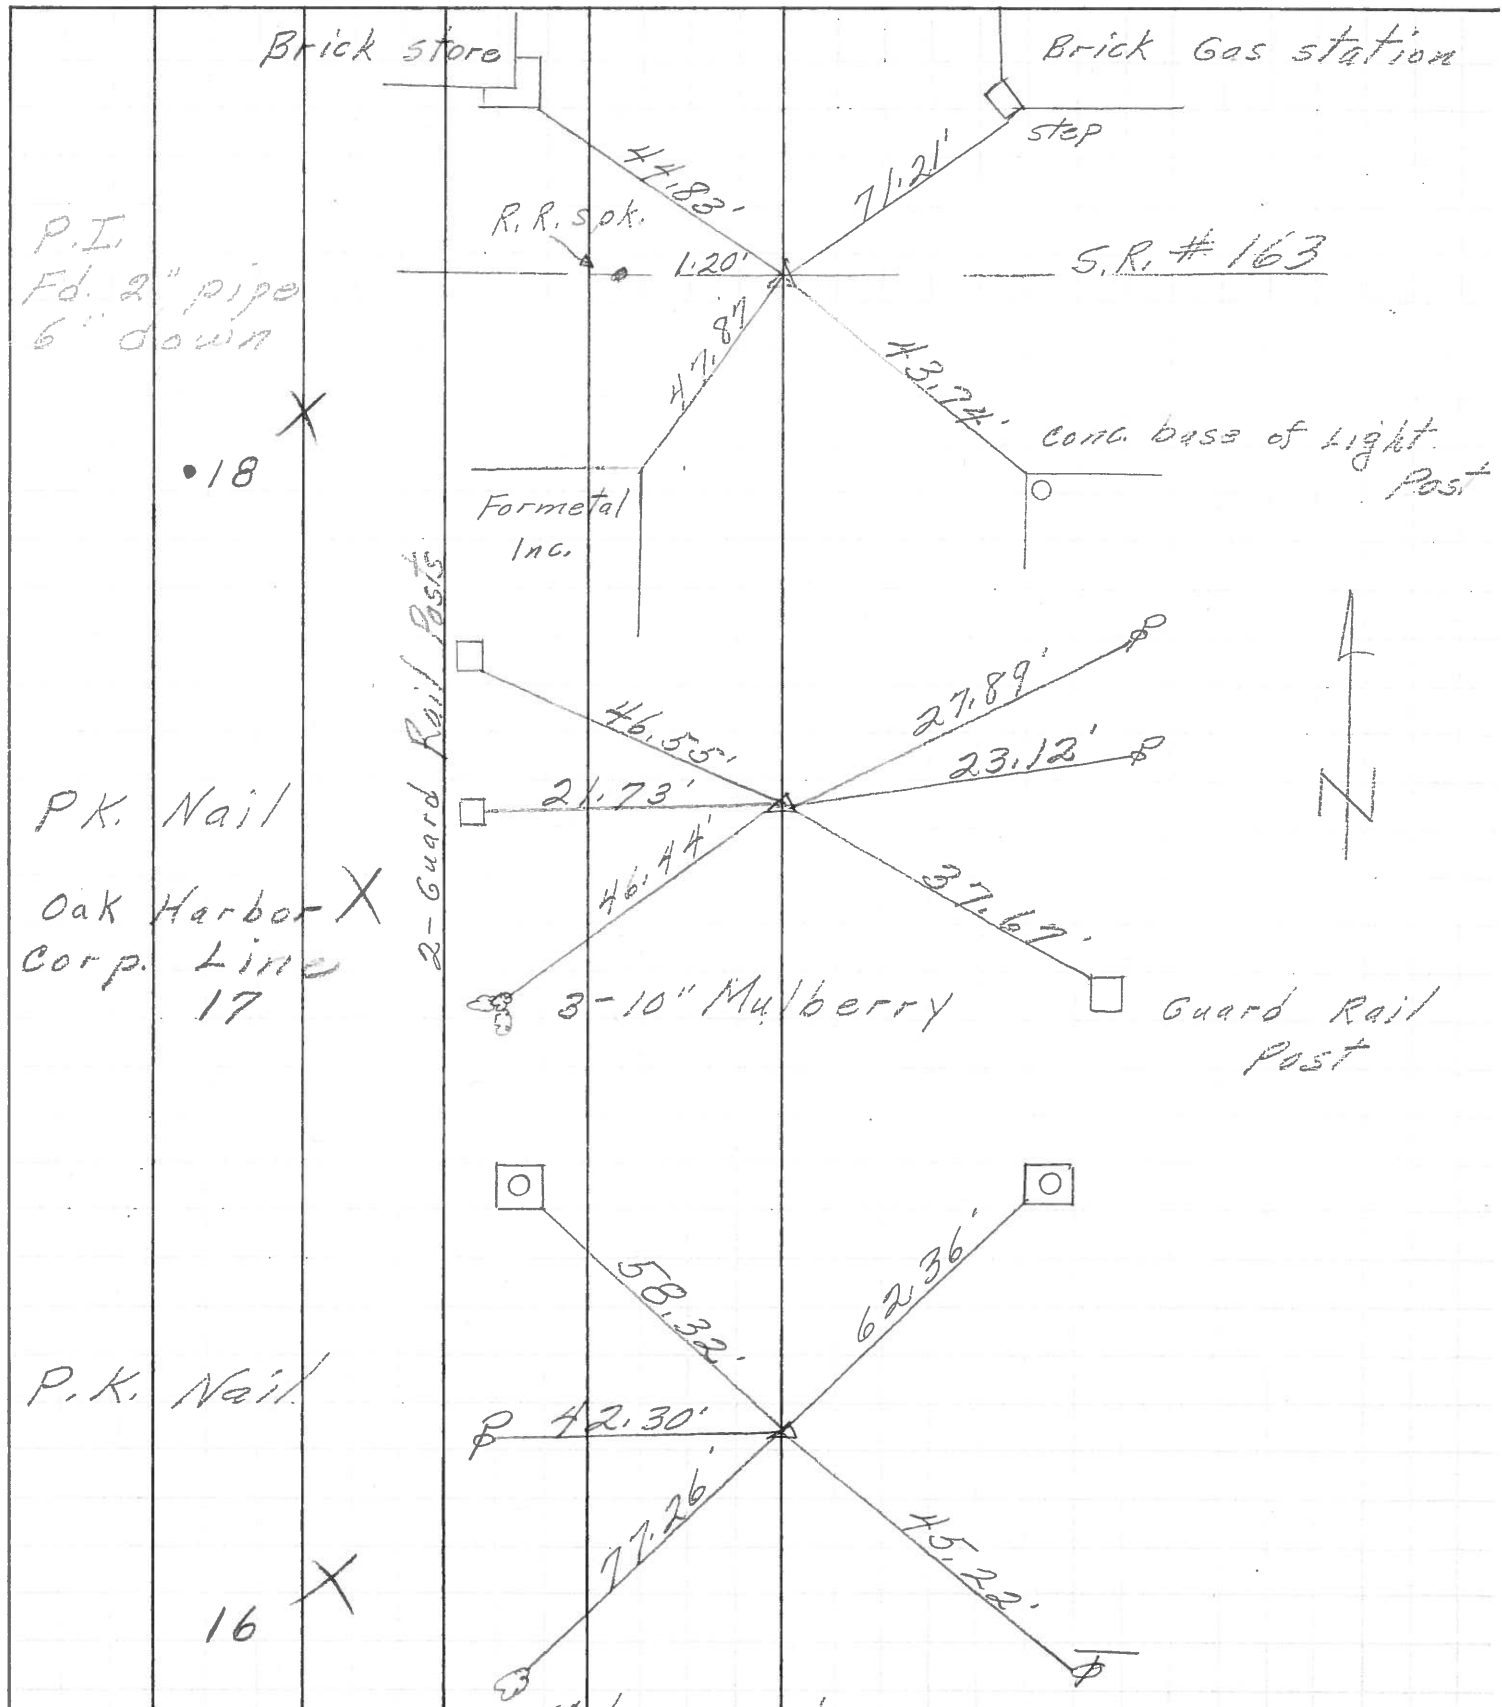

PERSONNEL TITLE PERSONNEL TITLE

COUNTY Ottawa DATE 5-13-68SchneiderMosserBarbourReddingS. R. 19 WEATHER FairSEC. Oak Harbor TEMP. 65°DESCRIPTION Ties for Control Points JOB NO. _____

LEFT CENTER LINE RIGHT

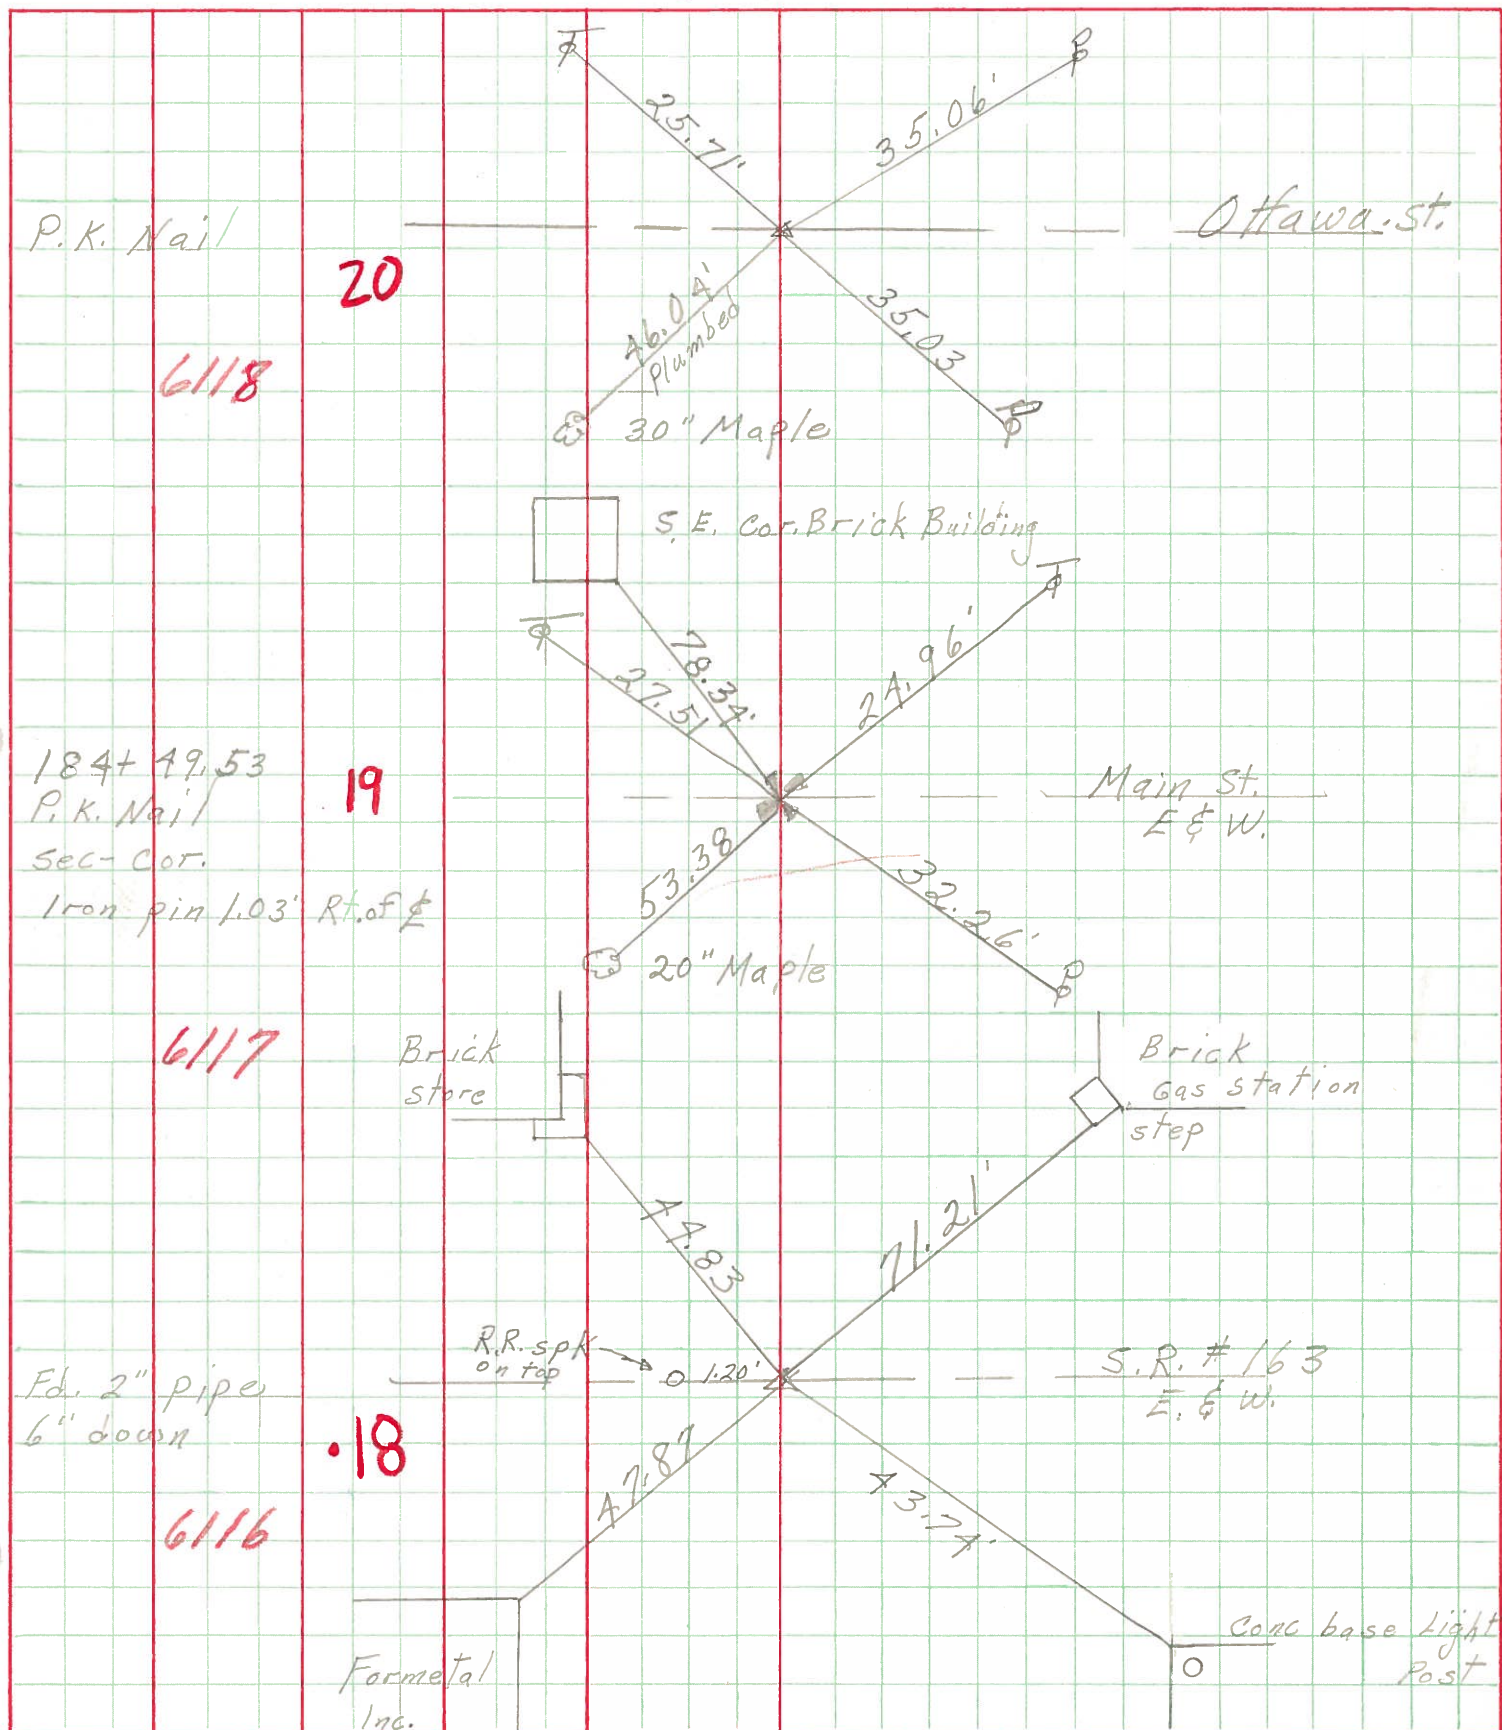

PERSONNEL	TITLE	PERSONNEL	TITLE
Schneider		Schulartz	
Moser			
Komolucki			
Zabur			

COUNTY _____ DATE 3-13-63
S. R. 12 WEATHER Cloudy - Rain
SEC. Sandusky Co. 40 - North TEMP. 35°

DESCRIPTION TIES for Control Points JOB NO. _____

