

O.D.O.T. DISTRICT 2 SURVEY OFFICE (USE ONLY)

PERSONNEL

REFERENCE NO. 18 A

SHEET OF

NOTES ASTON
H.C. NIESE
R.C. ASTON

DATE 11/2/23
WEATHER BREEZY
TEMP. 35°

ROUTE SR 19
COUNTY OTTAWA
TOWNSHIP SALEM
SECTION 5
T 6 N R 15 E

DWG BY BARRIERE PID 101239

TYPE MONUMENT MAG NAIL/WASHER

ON SURFACE - BELOW ON

OFFSET Q PAVEMENT ON LT : RT

 TO EDGE PAVEMENT

STATION: 182+15.88

HORIZ.DATUM: NAD 83 (2011)


GEOID: 18

GRID: NORTHING: 671376.281


EASTING: 1791829.712

LDP: NORTHING: 330872.894

EASTING: 151706.871

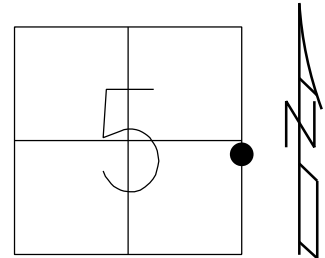

RECORD:
ORIGIN UNKNOWN
SET P.K./WASHER
11/4/96, MRC
FD P.K./WASHER
1/9/06, MB
FD P.K./WASHER
REF18
1/15/13, MC
FD MAG NAIL
REF18A
6/30/23, TDN
SET MAG/WASHER
11/2/23, TDN

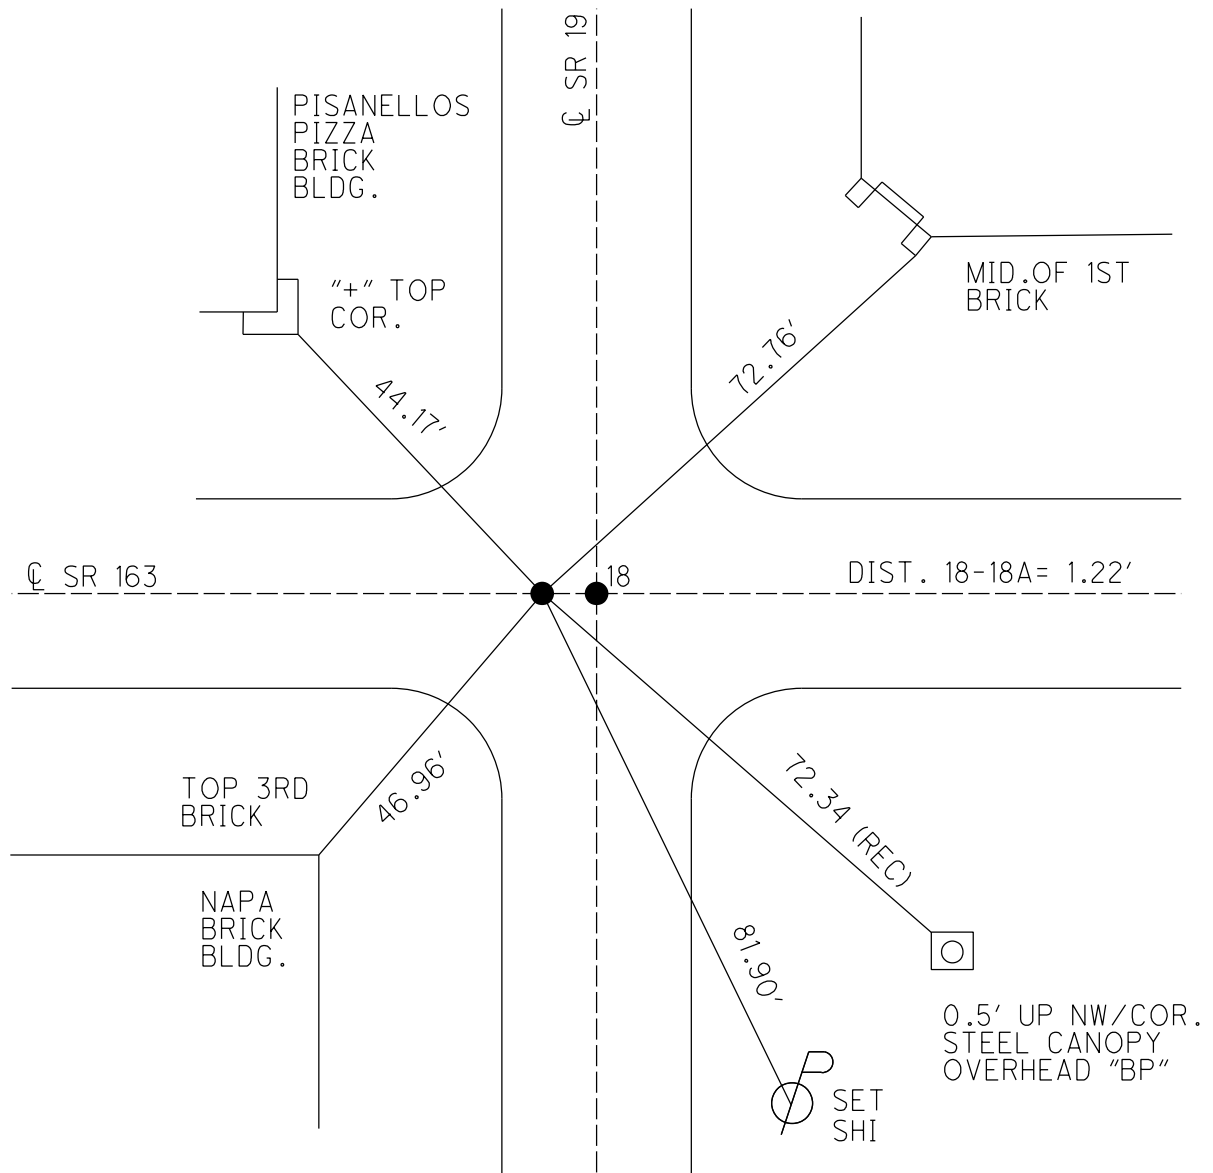

NOTE:
SR 163
STA. 752+39
REF 50B

O.D.O.T. DISTRICT 2 SURVEY OFFICE (USE ONLY)

PERSONNEL

REFERENCE NO.

18 A

SHEET 23 OF 23

NOTES

NUHFER

DATE

1/9/06

ROUTE

SR 19

H.C.

CANTERBURY

WEATHER

CLOUDY

COUNTY

OTTAWA

R.C.

BARNHISEL

TEMP.

32°

TOWNSHIP

SALEM

SECTION

5

T 6 N R 15 E

TYPE MONUMENT P.K./WASHER


ON SURFACE - ~~BELOW~~ ON

LEFT - C PAV'T - ~~RIGHT~~ 1.22'


- TO - EDGE PAVEMENT

S.L.M. 181+92.63

GRID: NORTHING: 671376.472 EASTING: 1791828.481

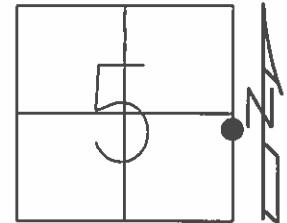

RECORD:
ORIGIN UNKNOWN
SET P.K./WASHER
11/4/96, MRC
FD P.K./WASHER
GPS, REFA18
1/15/13, MC

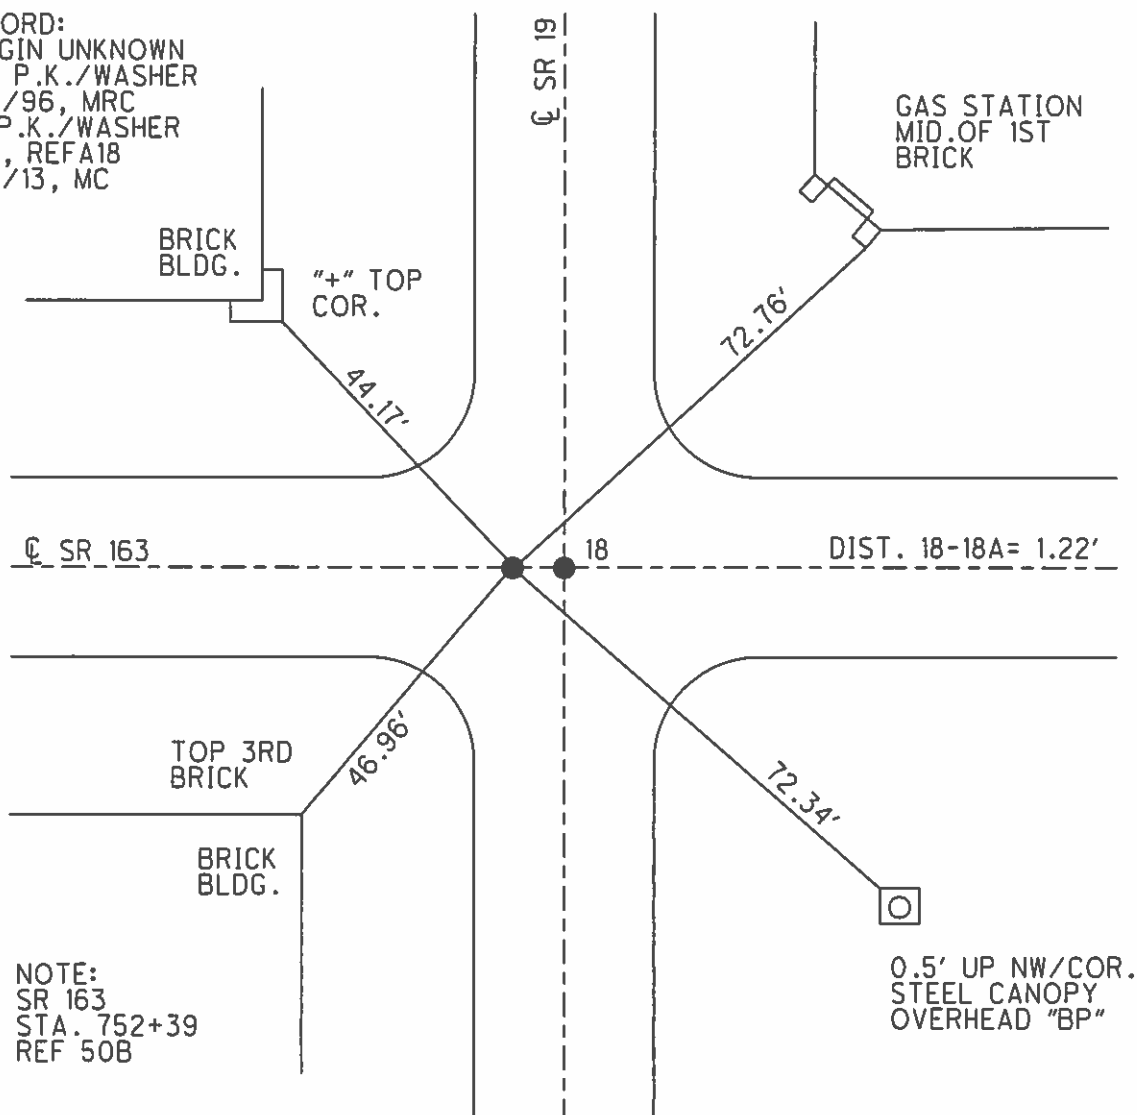

NOTE:
SR 163
STA. 752+39
REF 50B

O.D.O.T. DISTRICT 2 SURVEY OFFICE (USE ONLY)

PERSONNEL

REFERENCE NO.

17 A

SHEET

4

OF 33

NOTES NUHFER

DATE

1/9/06

ROUTE

SR 19

H.C. CANTERBURY

WEATHER

CLOUDY

COUNTY

OTTAWA

R.C. BARNHISEL

TEMP.

32°

TOWNSHIP

SALEM

SECTION

5

T 6 N R 15 E

TYPE MONUMENT P.K./WASHER


ON SURFACE - ~~BELOW~~ ON

~~LEFT~~ - C PAV'T - RIGHT 1.22'


- TO - EDGE PAVEMENT

S.L.M. 182+16

Grid: Northing: 671376.491 Easting: 1791828.487

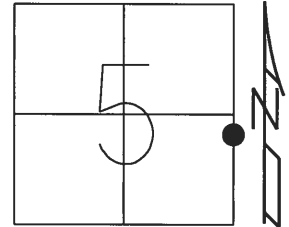

18A

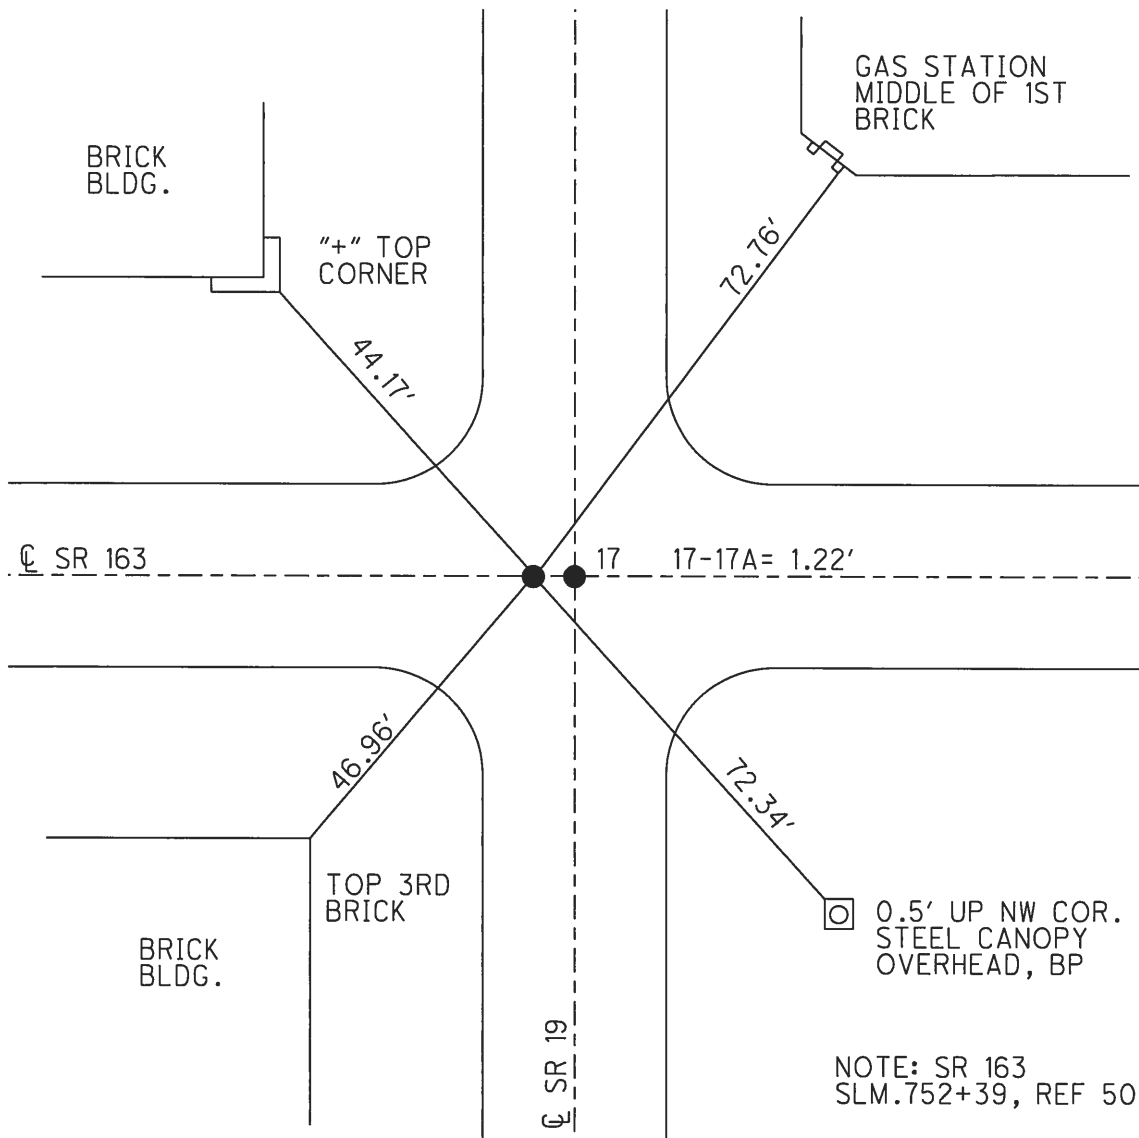

O.D.O.T. DISTRICT 2 SURVEY OFFICE

PERSONNEL

REFERENCE NO. 18#18A

SHEET 17 OF 22

NOTES BARNHISEL

H.C. ROUSOS

R.C. HAINES

CORDES ☐

DATE 11-4-96

WEATHER _____

TEMP. _____

ROUTE 19


COUNTY OTTAWA

TOWNSHIP SALEM OAK HARBOR

SECTION 4


T6 N R 15 E

TYPE MONUMENT PK + WASHERS EAST & WEST
 ON SURFACE - BELOW ON SURFACE
 LEFT- & PAV'T. - RIGHT PK ON & SR 163, 163+19
 -TO- EDGE PAVEMENT
 S.L.M. 182+06 (180+35.98 = 1951 Plans)

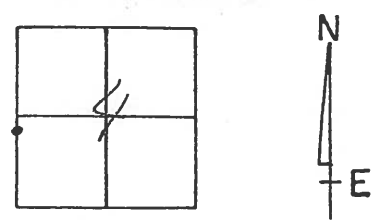

RESET P.K./WASHERS 11/4/96 M.R.C.

1/2" I-PIN 2" Below
Surface
ORIGIN UNKNOWN (Pt. to W.)

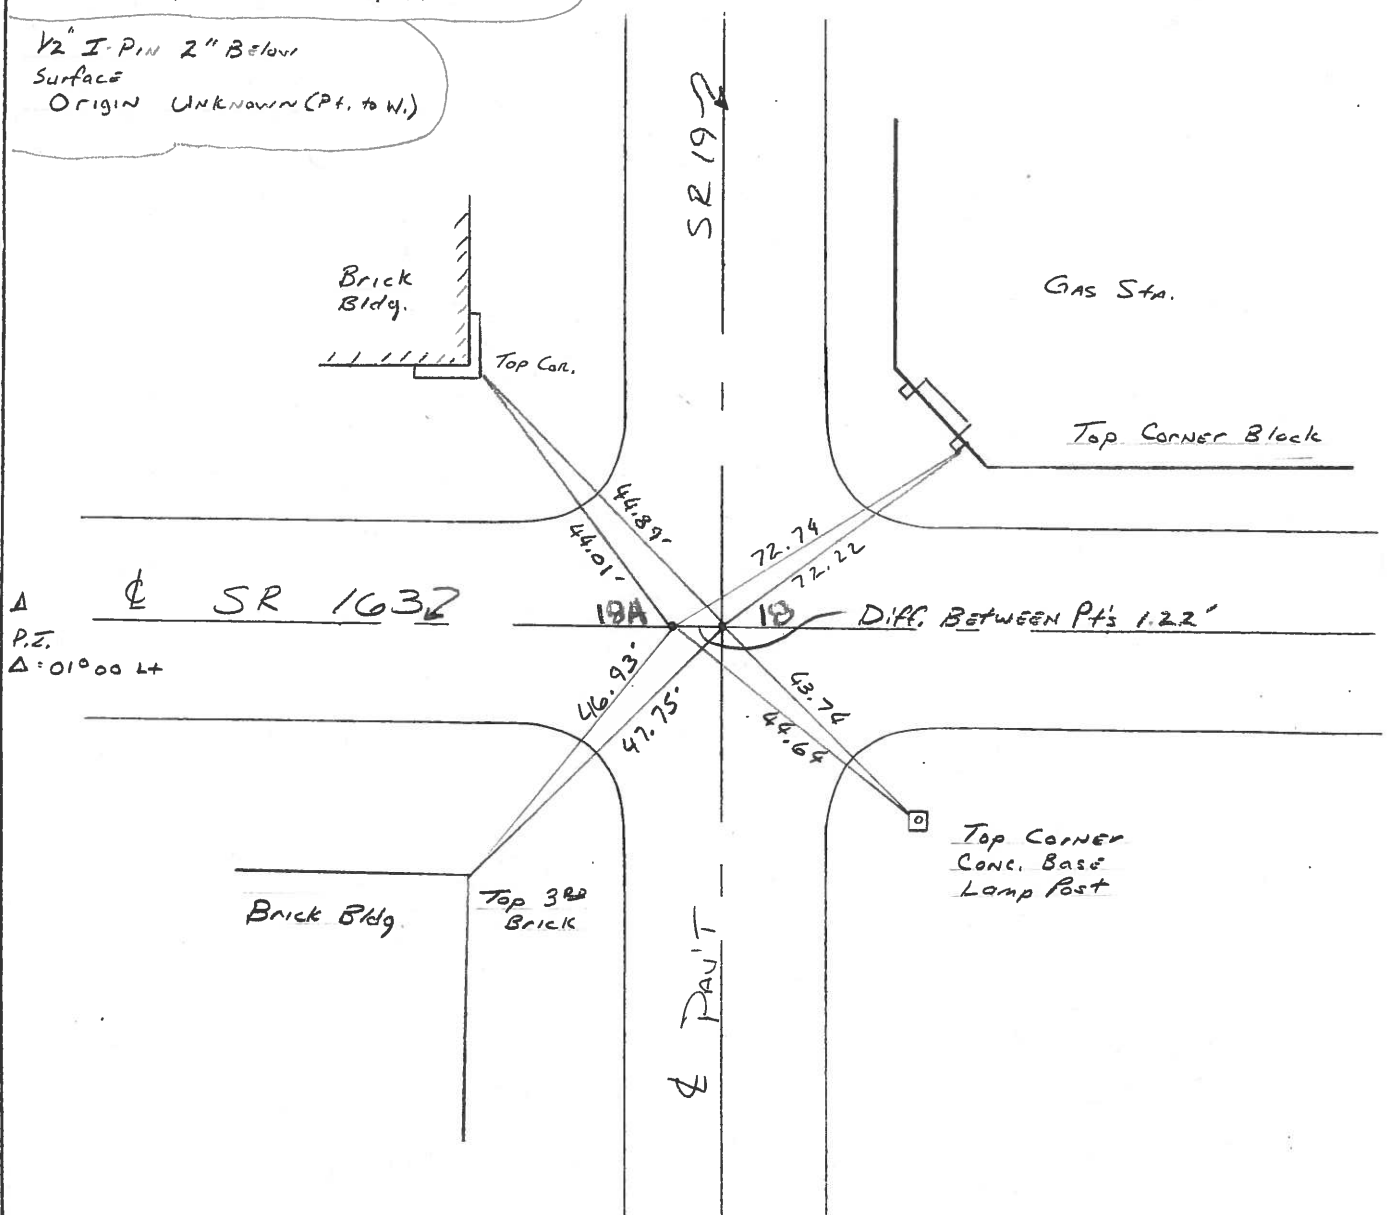

O.D.O.T. DISTRICT 2 SURVEY OFFICE

PERSONNEL

NOTES CRONIN

H.C. RIPPLE

R.C. GEYMAN

REFERENCE NO. 18 & 18A SHEET 18 OF

DATE 4/20/89

WEATHER SUNNY

TEMP. 52°

ROUTE #19

COUNTY OTTAWA

TOWNSHIP SALMON HARBOR

SECTION 4

T 6 N R 15 E


TYPE MONUMENT 5/8" IRON

ON SURFACE - BELOW 1"


LEFT - PAV'T. - RIGHT

TO EDGE PAVEMENT

S.L.M. 180+359.8 (1951 PLANS)

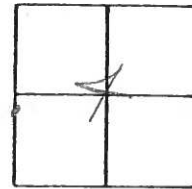

P.I.
Δ = 0° 00' 44"

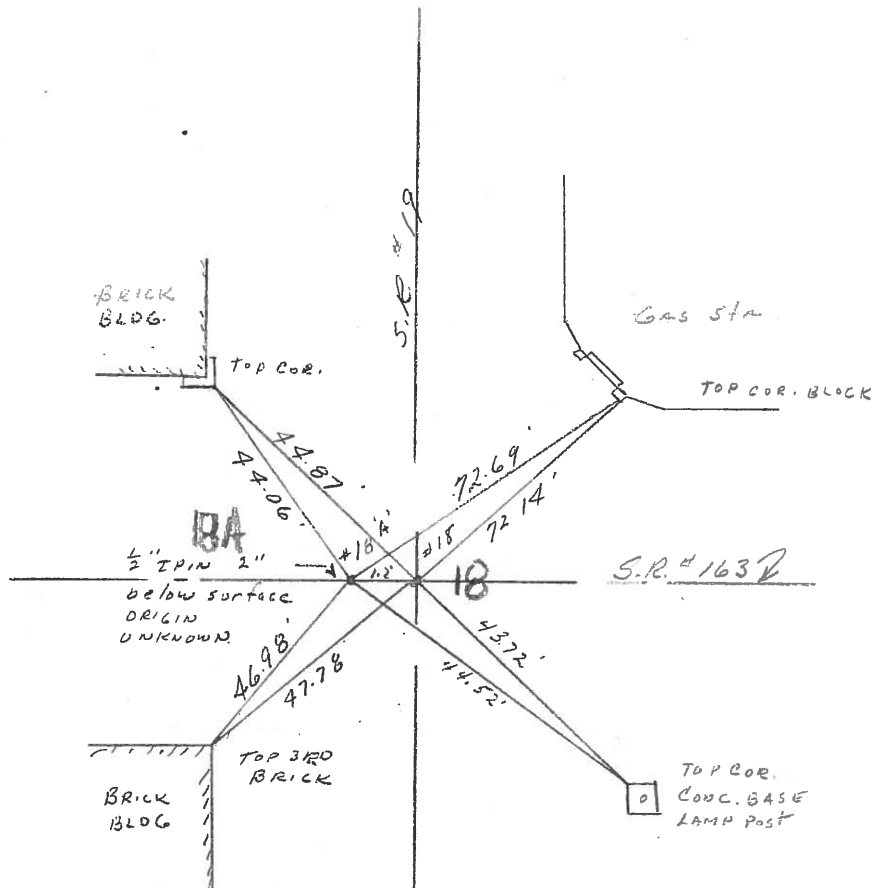

ODOT DISTRICT 2 SURVEY OFFICE

SHEET

OF

County OTTAWA S.R. 19

Township SALEM

Section 5

T8N, R1E

Personnel HOFFMAN


Householder

Loehrke

Date 7-27-81

Weather cloudy

Temp. +70°

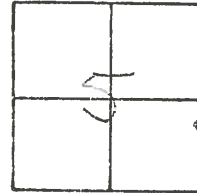

#18

Pt. "A" Fd. 1" Iron Rod 2" below surface. 1971 Notes call for a 2" pipe, 6" down

Pt. "E" Fd. R.R. SPK 1" below surface.

