

O.D.O.T. DISTRICT 2 SURVEY OFFICE (USE ONLY)

PERSONNEL

REFERENCE NO. 19

SHEET OF

NOTES ASTON
H.C. NIESE
R.C. ASTON

DATE 11/2/23
WEATHER CLOUDY
TEMP. 60°

ROUTE SR 19
COUNTY OTTAWA
TOWNSHIP SALEM
SECTION 5
T 6 N R 15 E

DWG BY BARRIERE PID 101239

TYPE MONUMENT MAG NAIL/WASHER

ON SURFACE - BELOW ON

OFFSET $\varnothing$ PAVEMENT 0.8' RT LT : RT

 TO EDGE PAVEMENT

STATION: 186+29.67

HORIZ.DATUM: NAD 83 (2011)


GEOID: 18

GRID: NORTHING: 671790.057


EASTING: 1791833.435

LDP: NORTHING: 331286.674

EASTING: 151707.673

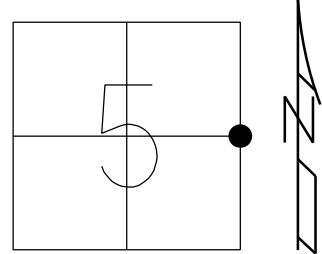

RECORD: P.I.
 $\Delta = 0^\circ 21' \text{ RT}$
1950 PLANS
FD P.K.NAIL
4/25/78
FD P.K./WASHER
4/20/89, CRONIN
8/5/96, MC
3/15/07, RGN
SET MAG/WASHER
11/6/07, MC
SET MAG/WASHER
REF19
6/30/23, TDN
SET MAG/WASHER
10/25/23, TDN

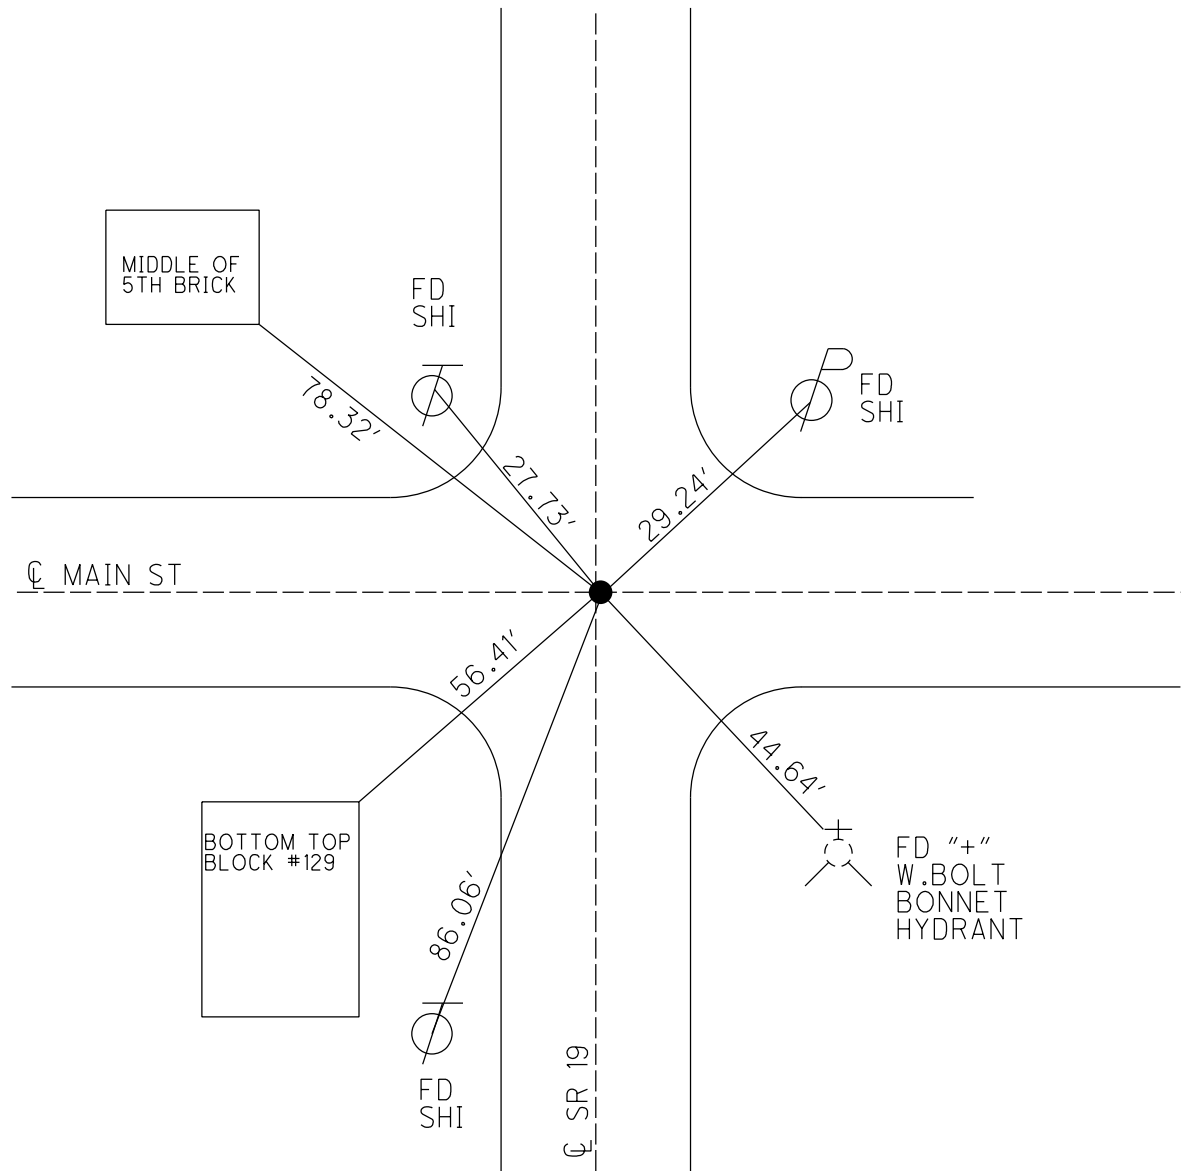

O.D.O.T. DISTRICT 2 SURVEY OFFICE (USE ONLY)

PERSONNEL

REFERENCE NO.

19

SHEET

5

OF 33

NOTES HUSS

DATE

3/15/07

ROUTE

SR 19

H.C. CANTERBURY

WEATHER

FAIR

COUNTY

OTTAWA

R.C. HUSS

TEMP.

55°

TOWNSHIP

SALEM

SECTION

5

T 6 N

R 15 E

TYPE MONUMENT P.K./WASHER

ON SURFACE - ~~BELOW~~ ON



~~LEFT~~ - ℄ PAV'T - RIGHT 0.8'

- TO - EDGE PAVEMENT

S.L.M. 186+29.74

Grid: Northing: 671790.057

Easting: 1791833.435

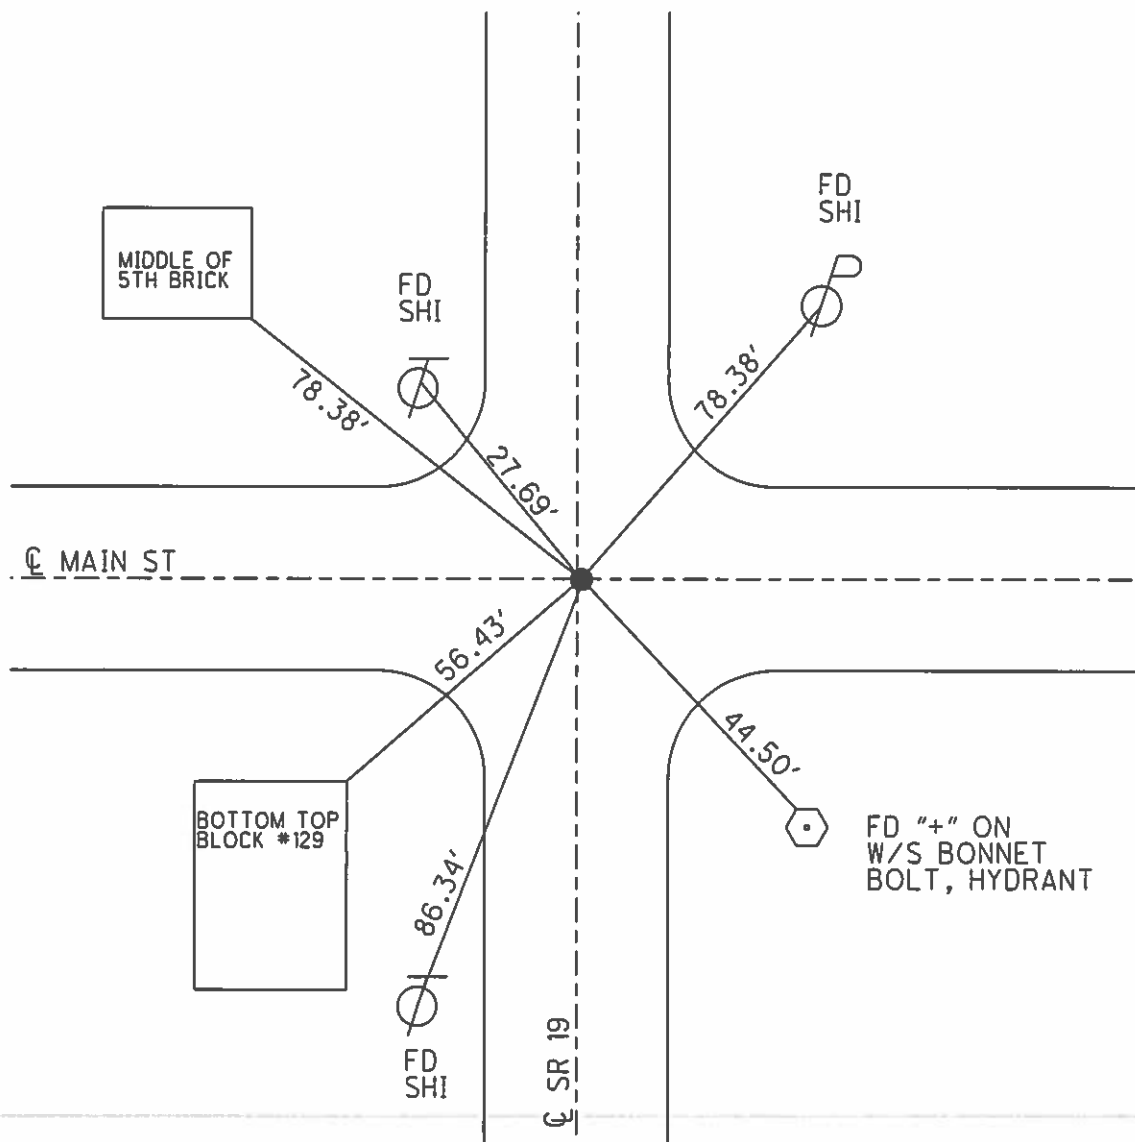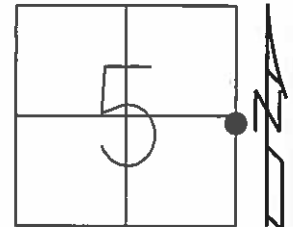

O.D.O.T. DISTRICT 2 SURVEY OFFICE

PERSONNEL

REFERENCE NO. 19

SHEET 18 OF 22

NOTES BARNHISEL

H.C. ROUSOS

R.C. HANES

DATE 8-5-96

WEATHER SUNNY

TEMP. +85°F

ROUTE 19

COUNTY OTTAWA

TOWNSHIP SALEM

SECTION 5

T. 6 N. R. 15 E.


TYPE MONUMENT PK + WASHER

ON SURFACE - YES

~~LEFT~~ - & PAV'T. - ~~RIGHT~~ YES


TO - EDGE PAVEMENT ON E & W

S.L.M. 186 + 23

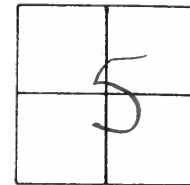

TIES DIDN'T MATCH, DUG UP
NAIL & LEFT EXPOSED..
3-19-97
MB

Sewer Construction
1995-1996 DISTURBED
CONTROL POINTS.

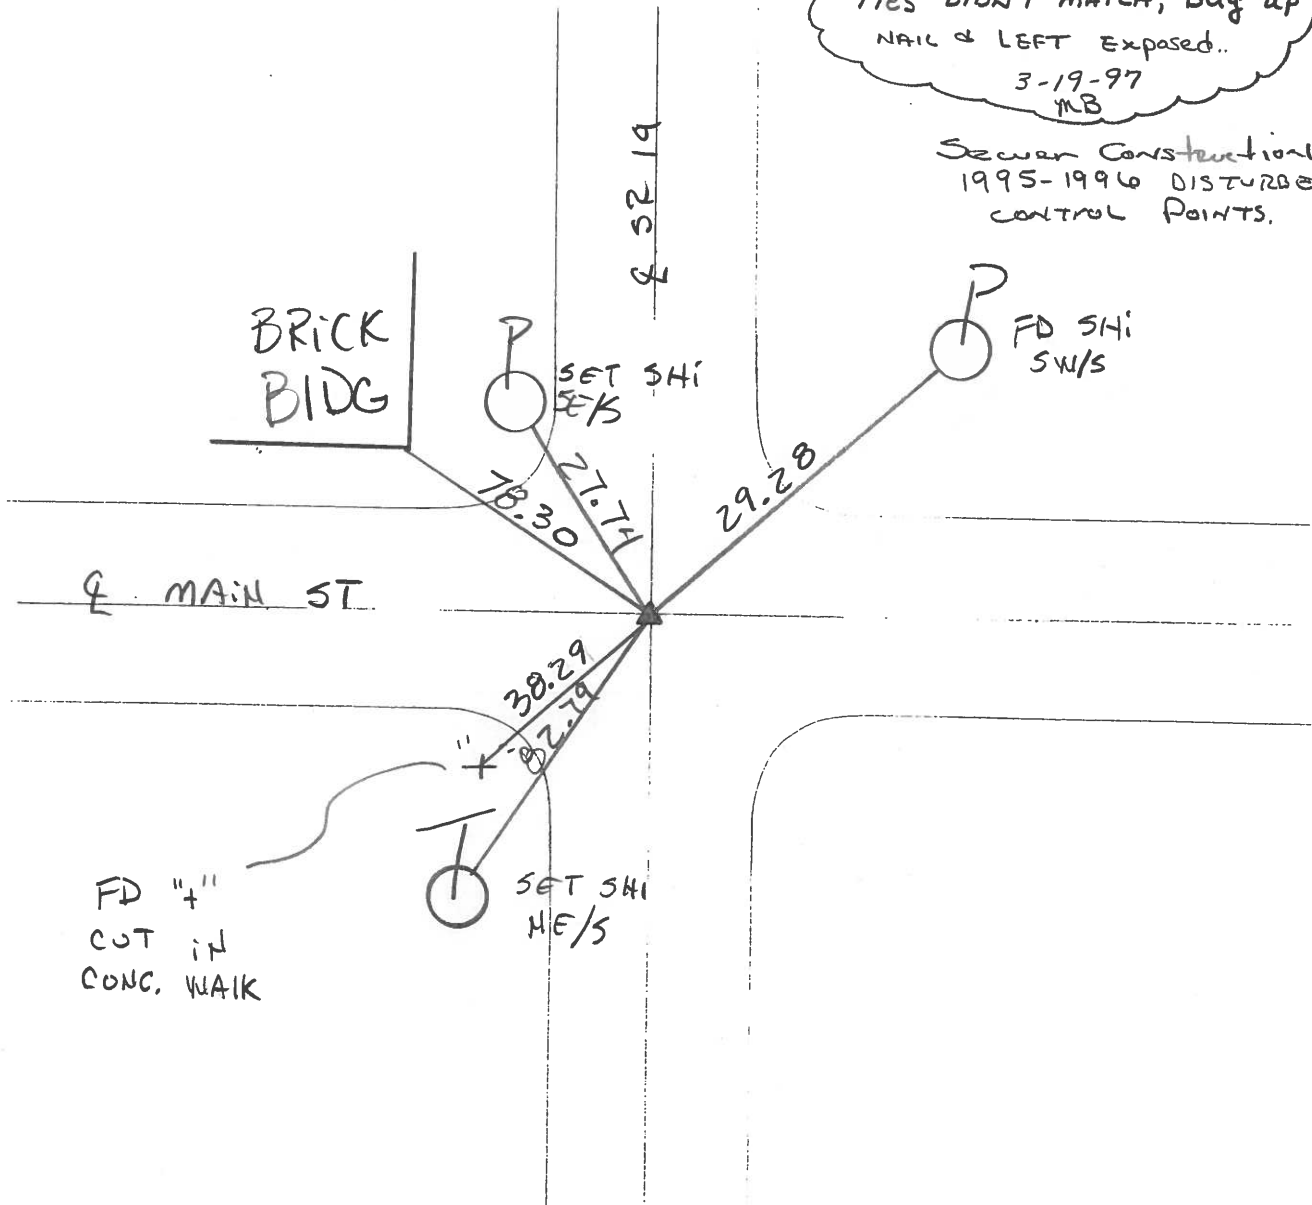

O.D.O.T. DISTRICT 2 SURVEY OFFICE

PERSONNEL

REFERENCE NO. 19

SHEET 19 OF

NOTES

H.C.

R.C.

CRONIN

RIPPLE

GEYMAN

DATE

WEATHER

TEMP.

4/20/89

SUNNY

54°

ROUTE

COUNTY

TOWNSHIP

SECTION

T. 6 N. R. 15 E.

#19

OTTAWA

SALEM HARBOR

4

TYPE MONUMENT

ON SURFACE - BELOW


LEFT - & PAV'T. - RIGHT

TO EDGE PAVEMENT

S.L.M.

184+49.53 (1951 PLANS)

P.K. WASHER

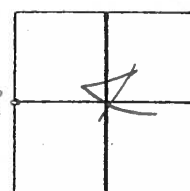

P.I.

A = 00°21' Rt. (PLAN)

BRICK
BLDG

78.34' 27.51'
THIS MEAS DOES NOT
AGREE WITH PLAN

40.26' 29.02'

+ cut in R.M.
OF M.H. 0.98'

I.P.W. ??

MAIN ST.



PERSONNEL

TITLE

PERSONNEL

TITLE

COUNTY OttawaDATE 5-4-71S. R. 19

WEATHER

SEC. 5 & 4

TEMP.

DESCRIPTION


Oak Harbor

LEFT


CENTER LINE

RIGHT

JOB NO.

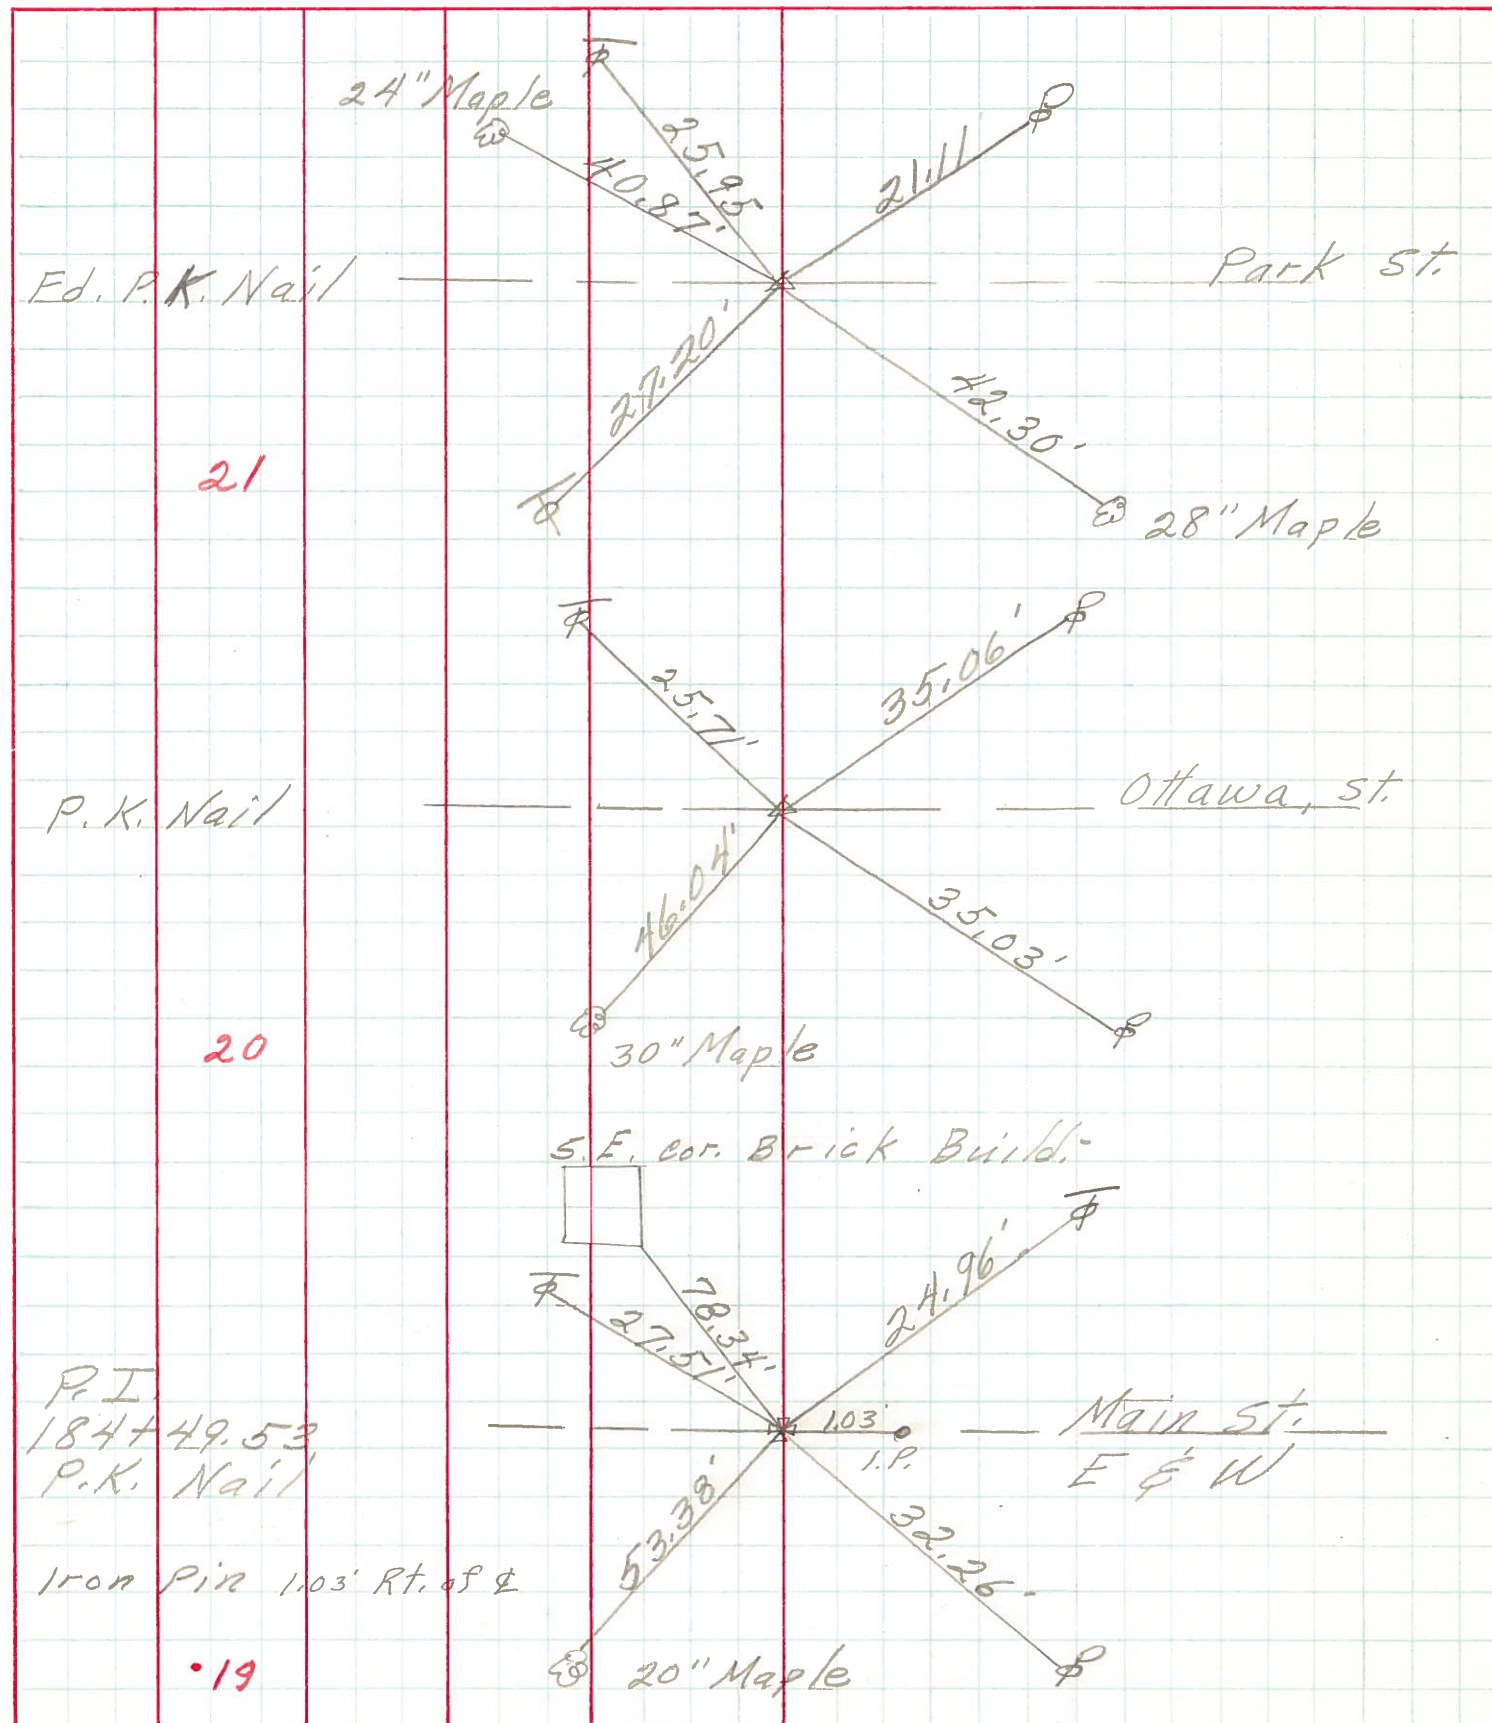

PERSONNEL	TITLE	PERSONNEL	TITLE	COUNTY	DATE	S. R.	WEATHER	SEC.	TEMP.	DESCRIPTION	JOB NO.
Schneider				Ottawa	5-13-68	19	Fair	Oak Harbor	65°	Ties for Control Points	
Mosser											
Barbour											
Redding											

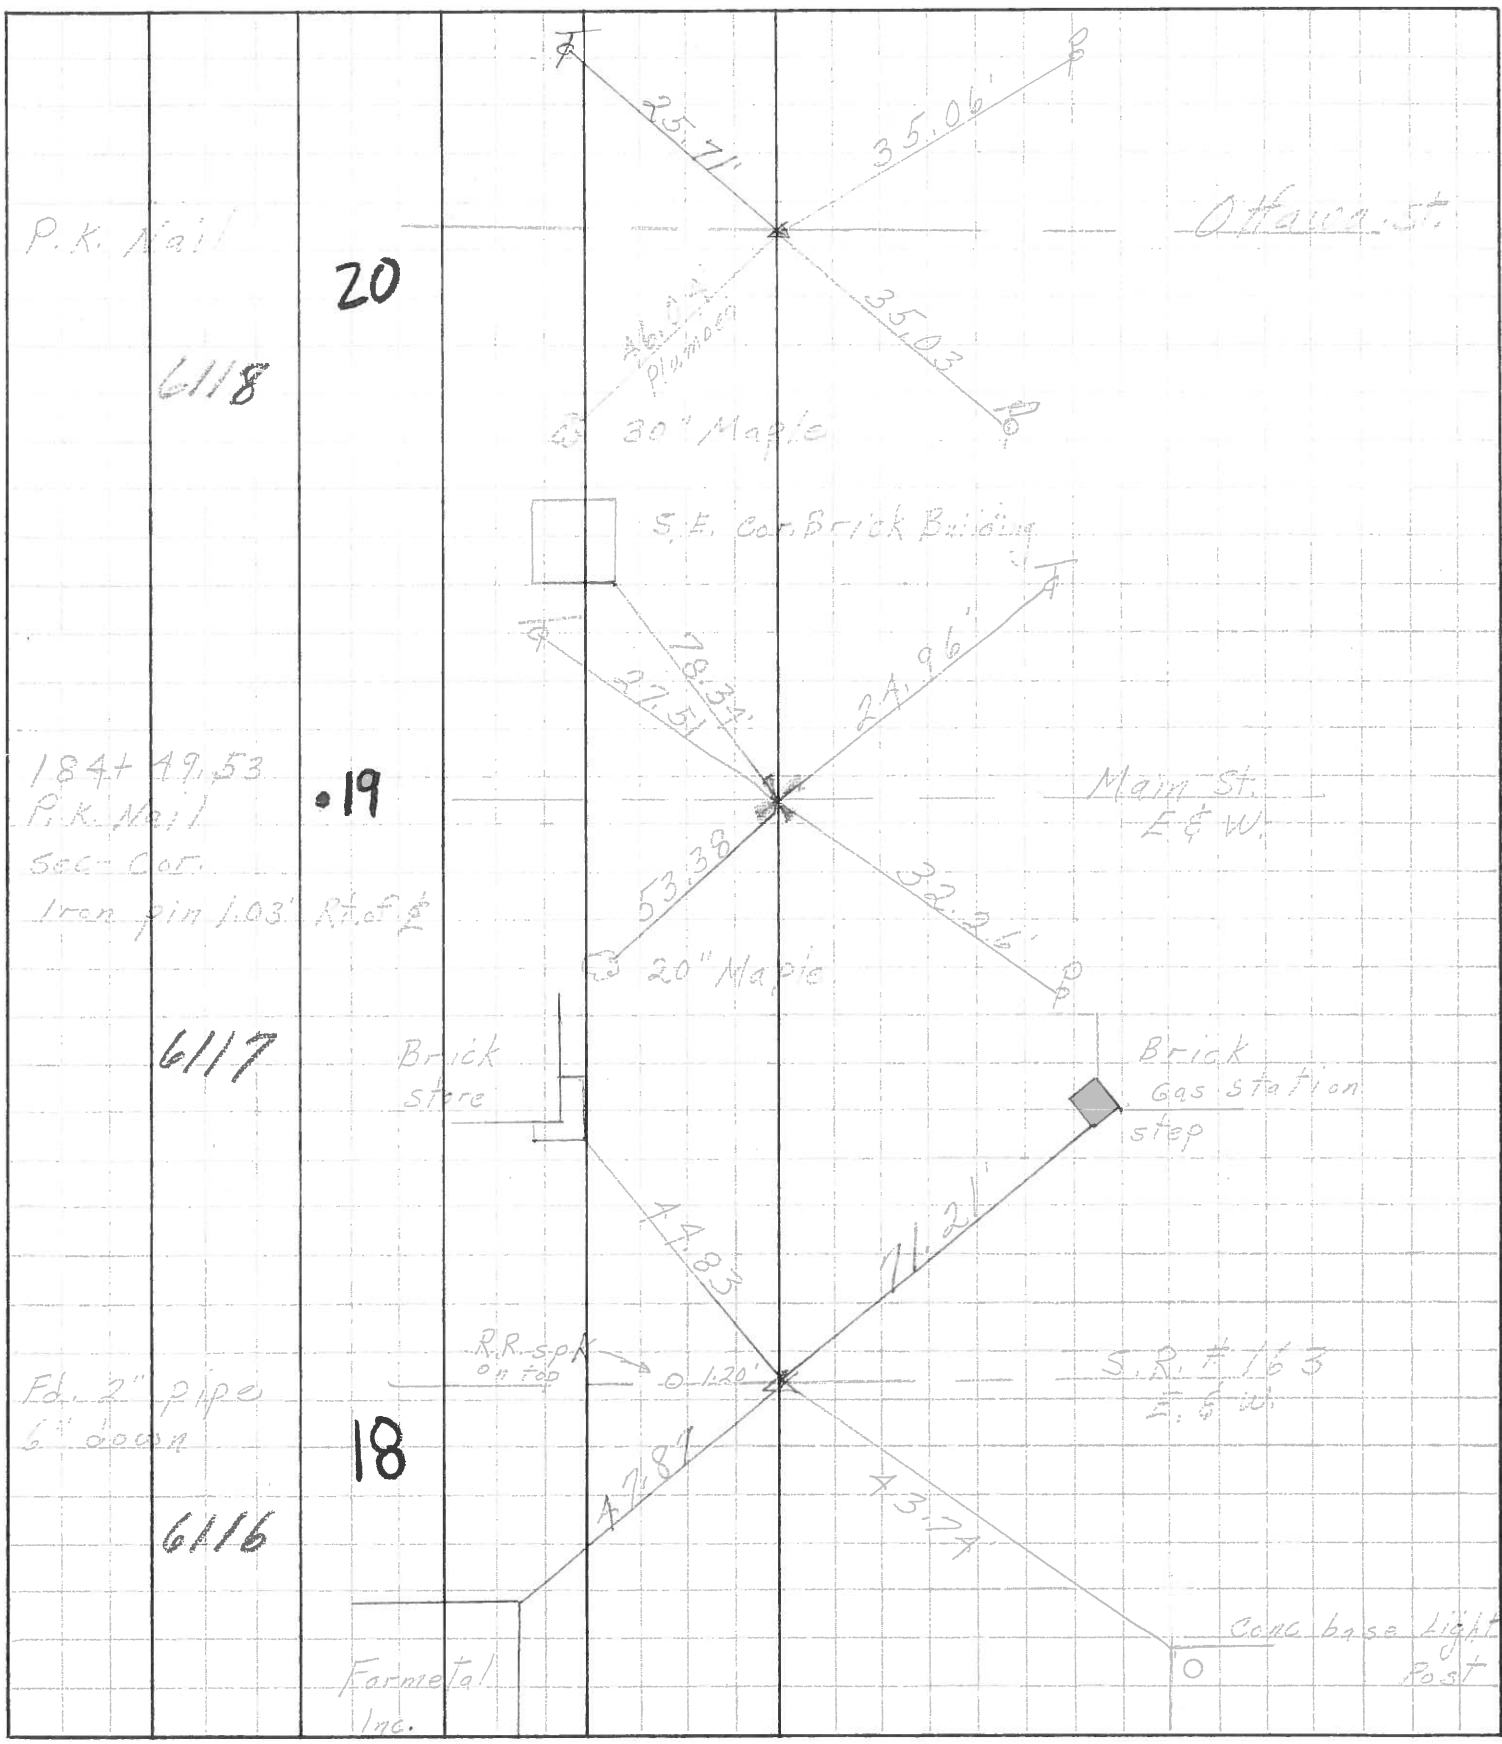

PERSONNEL	TITLE	PERSONNEL	TITLE
Schwider		Schwartz	
Moore			
Connelly			
Zabr			

COUNTY _____ DATE 2-13-13

S. R. _____ WEATHER Cloudy - Rain

SEC. Emulsion 2.4 to 4.0 TEMP. 35°


DESCRIPTION Ties for Control Points JOB NO. _____

LEFT CENTER LINE RIGHT

P. I. **.19**

Found P.K.
Nail
1/4 Sec. Corner

S.E. 1/4 Brick
Bld.

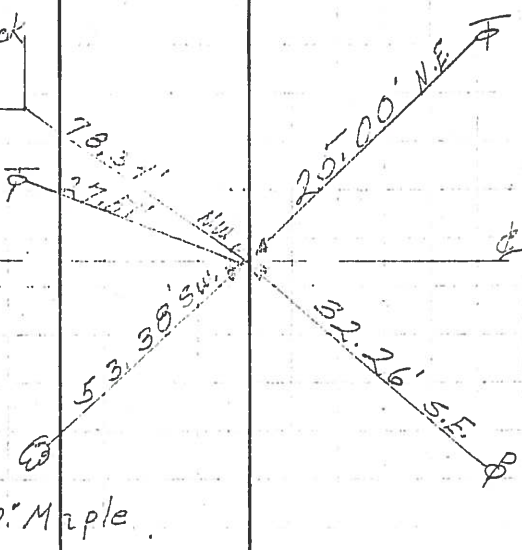


P. I. **18**

Found P.K.
Nail

S.E. 1/4 Bld.

N.E. 1/4 Bld.

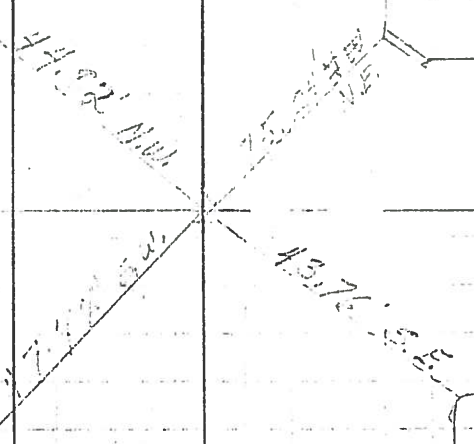

S.R. # 123 E.W.

N.W. 1/4 123-
base 11.5 ft
1st