

O.D.O.T. DISTRICT 2 SURVEY OFFICE (USE ONLY)

PERSONNEL

REFERENCE NO. 20

SHEET OF

NOTES ASTON

DATE 11/2/23

ROUTE SR 19

H.C. NIESE

WEATHER BREEZY

COUNTY OTTAWA

R.C. ASTON

TEMP. 35°

TOWNSHIP SALEM

DWG BY BARRIERE

PID 101239

SECTION 5

T 6 N R 15 E

TYPE MONUMENT MAG NAIL/WASHER

ON SURFACE - BELOW ON

OFFSET Q PAVEMENT 0.6' RT LT : RT

 TO EDGE PAVEMENT

STATION: 190+41.78

HORZ.DATUM: NAD 83 (2011)


GEOID: 18

GRID: NORTHING: 672202.116


EASTING: 1791837.639

LDP: NORTHING: 331698.807

EASTING: 151709.044

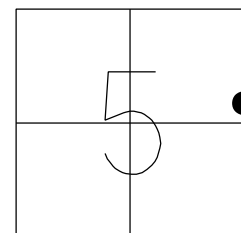

RECORD: P.O.T.
FD P.K.NAIL
4/25/78
SET P.K./WASHER
6/6/79
SET P.K./WASHER
8/5/96, CRONIN
SET P.K./WASHER
3/19/97, MB
FD MAG/WASHER
2/1/06, RGN
SET MAG/WASHER
11/6/07, SAH
D.N.F.
6/29/23, TDN
SET MAG/WASHER
REF 20
11/2/23, TDN

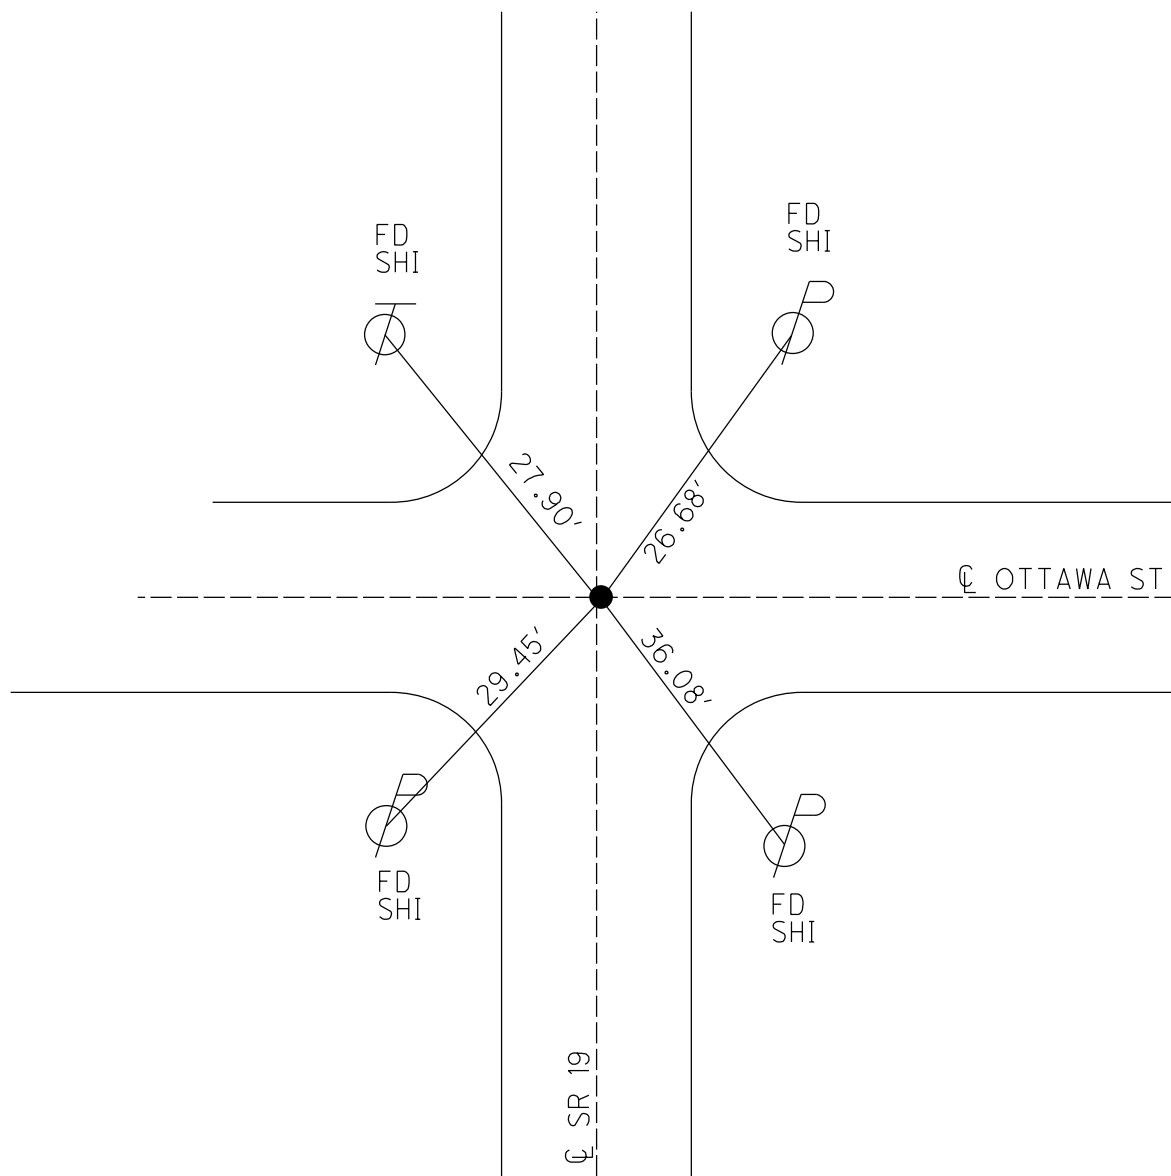

O.D.O.T. DISTRICT 2 SURVEY OFFICE (USE ONLY)

PERSONNEL	REFERENCE NO. <u>20</u>	SHEET <u>6</u> OF <u>33</u>
NOTES <u>HUSS</u>	DATE <u>3/15/07</u>	ROUTE <u>SR 19</u>
H.C. <u>CANTERBURY</u>	WEATHER <u>FAIR</u>	COUNTY <u>OTTAWA</u>
R.C. <u>HUSS</u>	TEMP. <u>55°</u>	TOWNSHIP <u>SALEM</u>
		SECTION <u>5</u>
		T <u>6</u> N R <u>15</u> E

TYPE MONUMENT P.K./WASHER



ON SURFACE - ~~BELOW~~ ON

~~LEFT~~ - CL PAV'T - RIGHT 0.6'

13.4' TO LT EDGE PAVEMENT

S.L.M. 190+41.92

Grid: Northing: 672202.116 Easting: 1791837.639

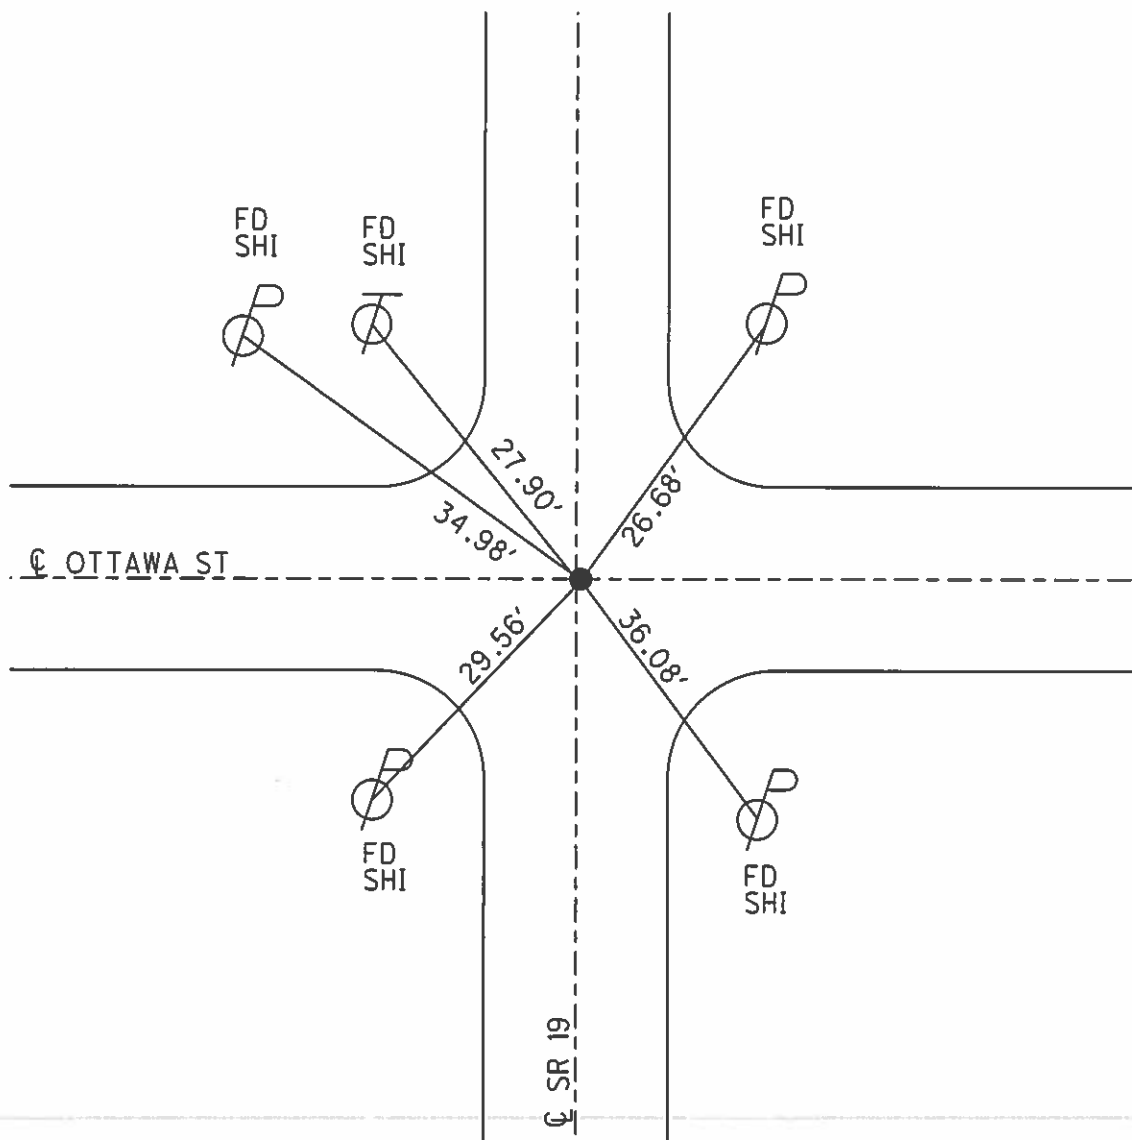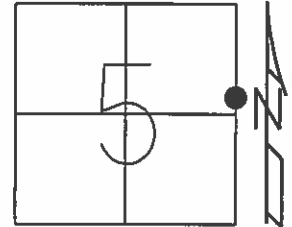

O.D.O.T. DISTRICT 2 SURVEY OFFICE

PERSONNEL

REFERENCE NO. 20

SHEET 20 OF 22

NOTES BARNHISEL

H.C. ROUSOS

R.C. HANES

CORDES M

DATE 8-5-96

WEATHER SUNNY

TEMP. +85°

ROUTE 19

COUNTY OTTAWA

TOWNSHIP SALEM

SECTION 5

T 6 N R 15 E


TYPE MONUMENT Sewer Line Removed

ON SURFACE - BELOW ℄ CONTROL

~~LEFT - ℄ PAV'T. - RIGHT ON ℄ Rmt. West on Ottawa st;~~


13.4' TO LT EDGE PAVEMENT 0.6' R+ ℄ SR 19

S.L.M. 190+34

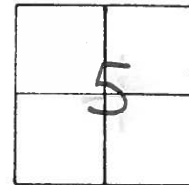

PT. REMOVED by SEWER LINE 8-5-96

PK. & WASHER Reset 3-19-97
from old TIES

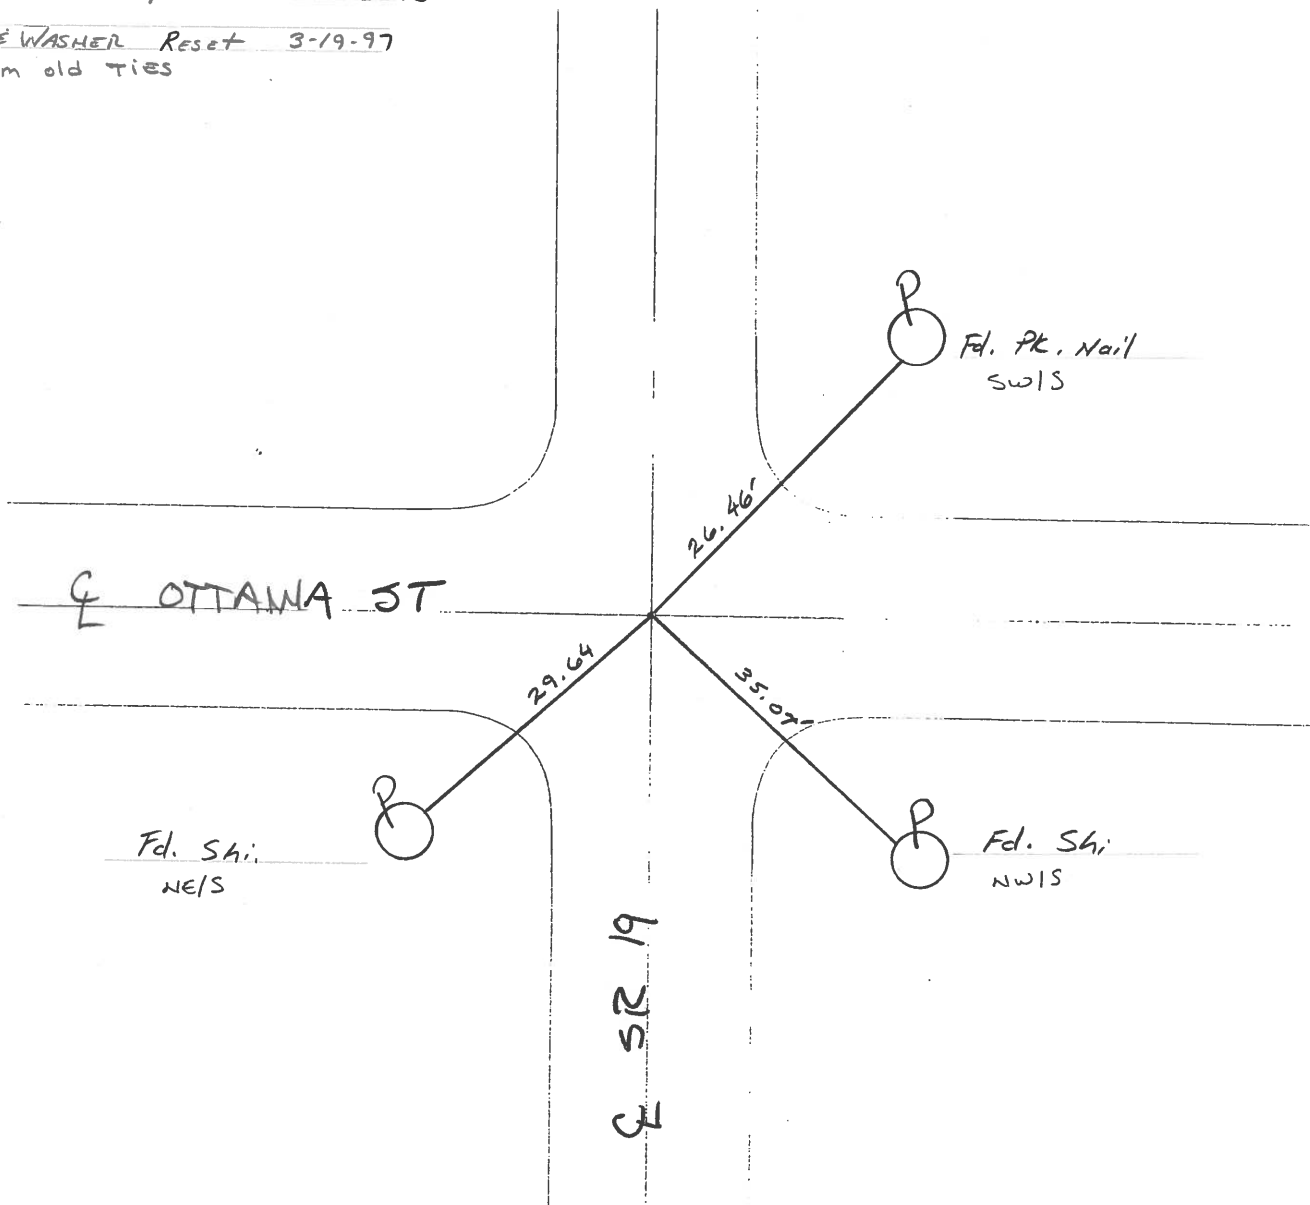

PERSONNEL

TITLE

PERSONNEL

TITLE


DRAWN 4/24/89CRONINCOUNTY OTTAWADATE 4/20/89RIPPLES. R. #19WEATHER SUNNYGEYMANSEC. OAK HARBORTEMP. 63°DESCRIPTION TIES - INTERSECTING STREETS - SET BY OTHERS

JOB NO. _____

LEFT

CENTER LINE

RIGHT

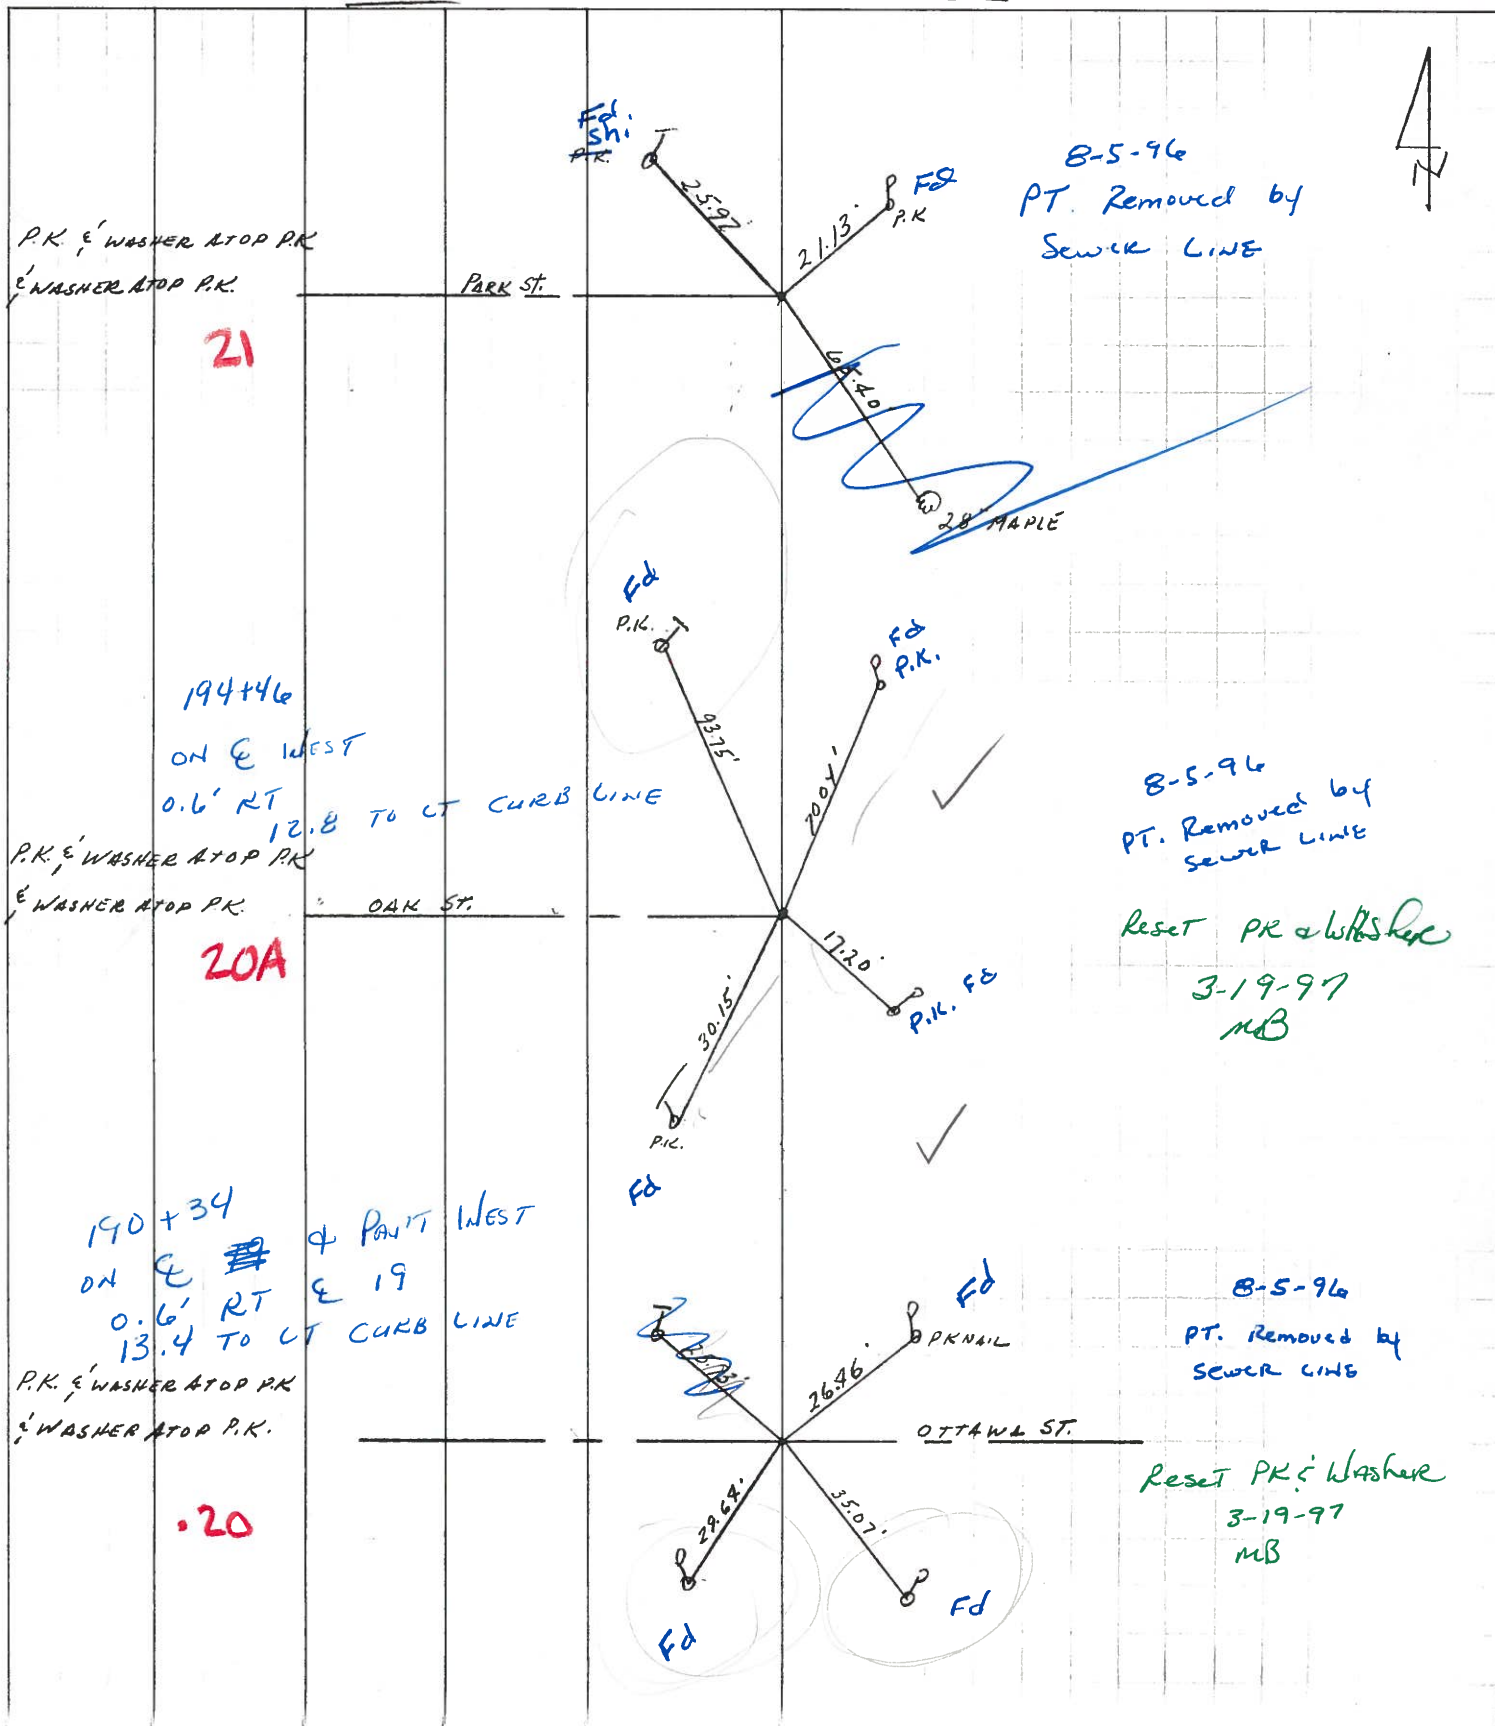

PERSONNEL

TITLE

PERSONNEL

TITLE

COUNTY OTTAWADATE 4/20/89CRONINS. R. #19WEATHER SUNNYRIPPLESEC. OAK HARBORTEMP. 63°DESCRIPTION TIES - INTERSECTING STREETS - SET BY OTHERS

JOB NO. _____

LEFT

CENTER LINE

RIGHT

P.K. & WASHER ATOP P.K.

P.K. & WASHER ATOP P.K.

21

PARK ST.

P.K.

25.92'

21.13'

65.40'

28" MAPLE

P.K. & WASHER ATOP P.K.

P.K. & WASHER ATOP P.K.

20A

OAK ST.

P.K.

23.75'

200.1'

17.20'

30.15'

P.K.

P.K. & WASHER ATOP P.K.

P.K. & WASHER ATOP P.K.

20

OTTAWA ST.

P.K.


25.23'

26.46'

29.68'

35.07'

P.K. NAIL

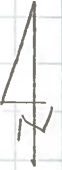


PERSONNEL TITLE PERSONNEL TITLE

COUNTY Ottawa DATE 4-25-78


S. R. 19 WEATHER Fair

SEC. 554 TEMP. 45°

DESCRIPTION Oak Harbor LEFT CENTER LINE RIGHT JOB NO.

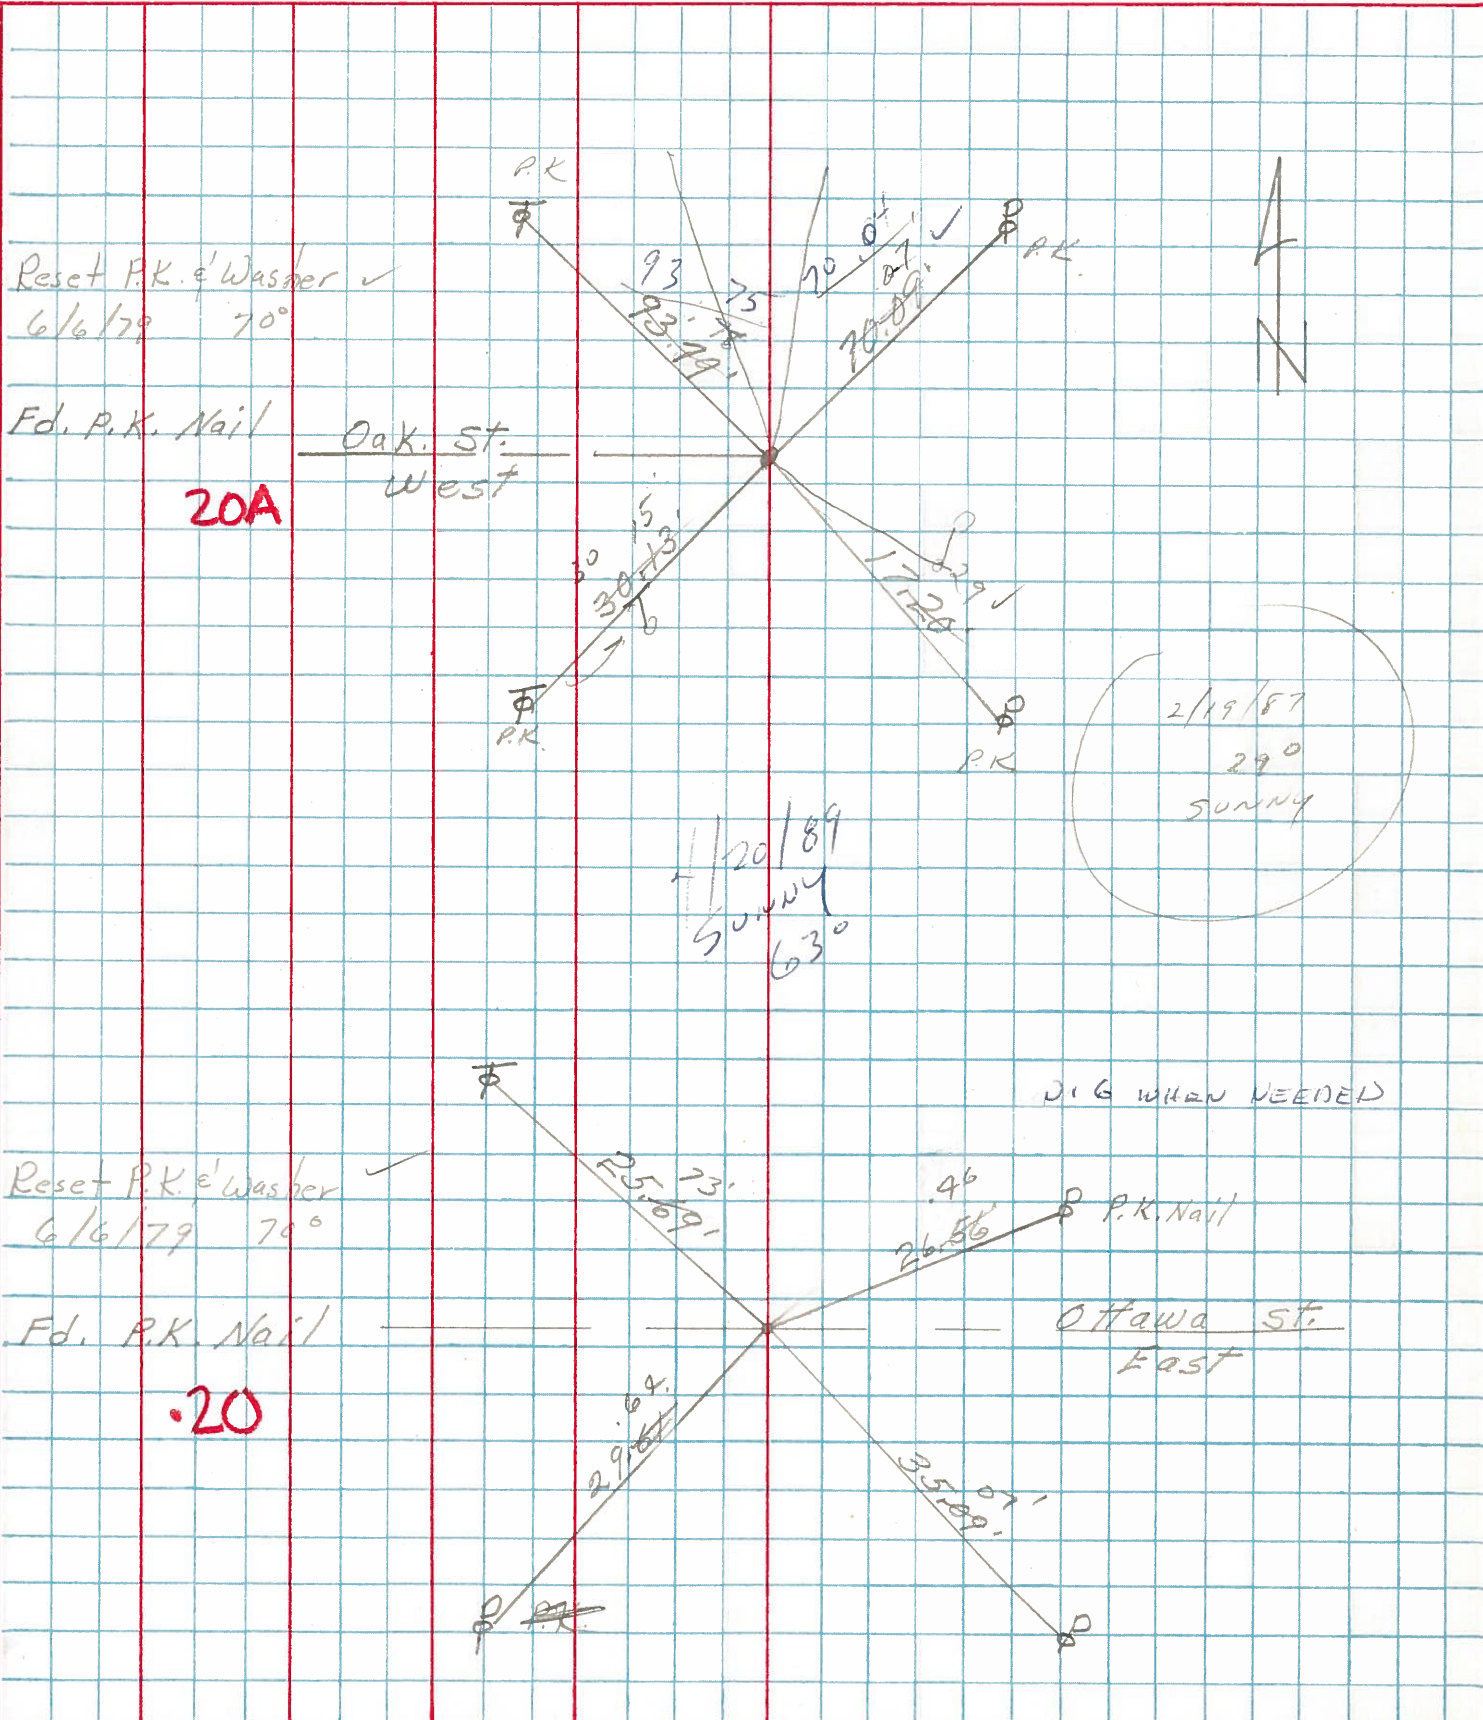

PERSONNEL	TITLE	PERSONNEL	TITLE
_____	_____	_____	_____
_____	_____	_____	_____
_____	_____	_____	_____

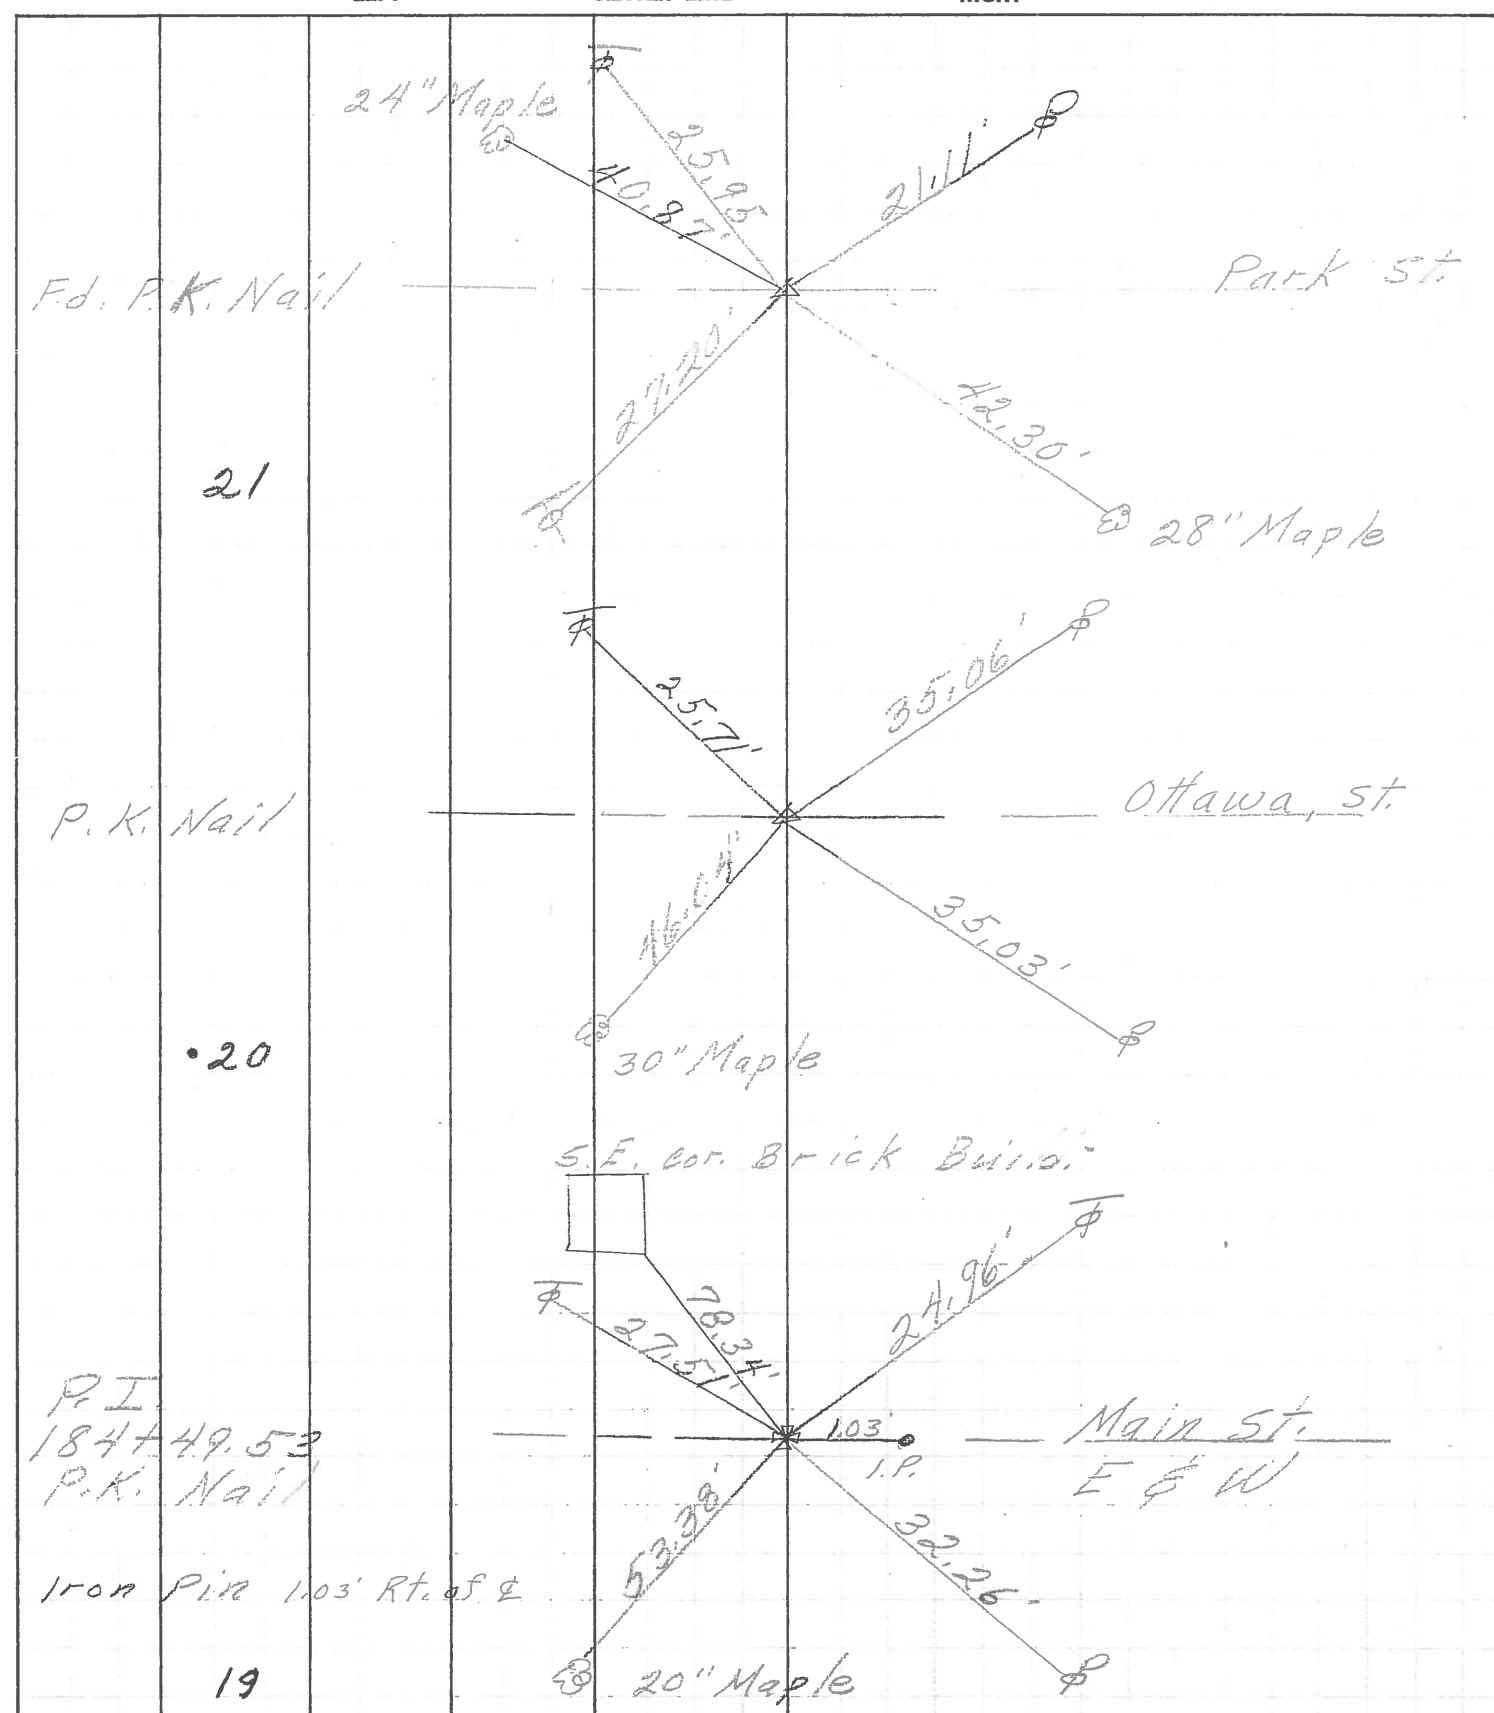COUNTY Ottawa DATE 5-4-71S. R. 19 WEATHER _____SEC. 5 & 4 TEMP. _____DESCRIPTION Oak Harbor JOB NO. _____

PERSONNEL	TITLE	PERSONNEL	TITLE	COUNTY	DATE	S. R.	WEATHER	SEC.	TEMP.	DESCRIPTION	JOB NO.
<u>Schneider</u>				<u>Ottawa</u>	<u>5-13-68</u>	<u>19</u>	<u>Fair</u>	<u>Oak Harbor</u>	<u>65°</u>	<u>Ties for Control Points</u>	
<u>Mosser</u>											
<u>Barbour</u>											
<u>Redding</u>											

