

O.D.O.T. DISTRICT 2 SURVEY OFFICE (USE ONLY)

PERSONNEL

REFERENCE NO. 20A

SHEET OF

NOTES ASTON

DATE 10/25/23

ROUTE SR 19

H.C. NIESE

WEATHER BREEZY

COUNTY OTTAWA

R.C. ASTON

TEMP. 35°

TOWNSHIP SALEM

DWG BY BARRIERE

PID 101239

SECTION 5

T 6 N R 15 E

TYPE MONUMENT MAG NAIL/WASHER

ON SURFACE - BELOW ON

OFFSET $\varnothing$ PAVEMENT 0.6' RT LT : RT

 TO EDGE PAVEMENT

STATION: 194+53.94

HORIZ.DATUM: NAD 83 (2011)


GEOID: 18

GRID: NORTHING: 672614.315


EASTING: 1791841.654

LDP: NORTHING: 332110.988

EASTING: 151710.257

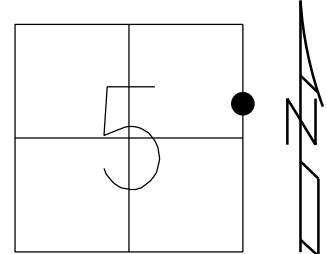

RECORD:
FD PK/WASHER
3/15/07, SHUSS
SET MAG/WASHER
11/6/07, HUSS
FD PK/WASHER
REF20A
10/28/09, HUSS
FD PK SHANK
REF20A
6/29/23, TDN
SET MAG/WASHER
REF20A
10/25/23, TDN

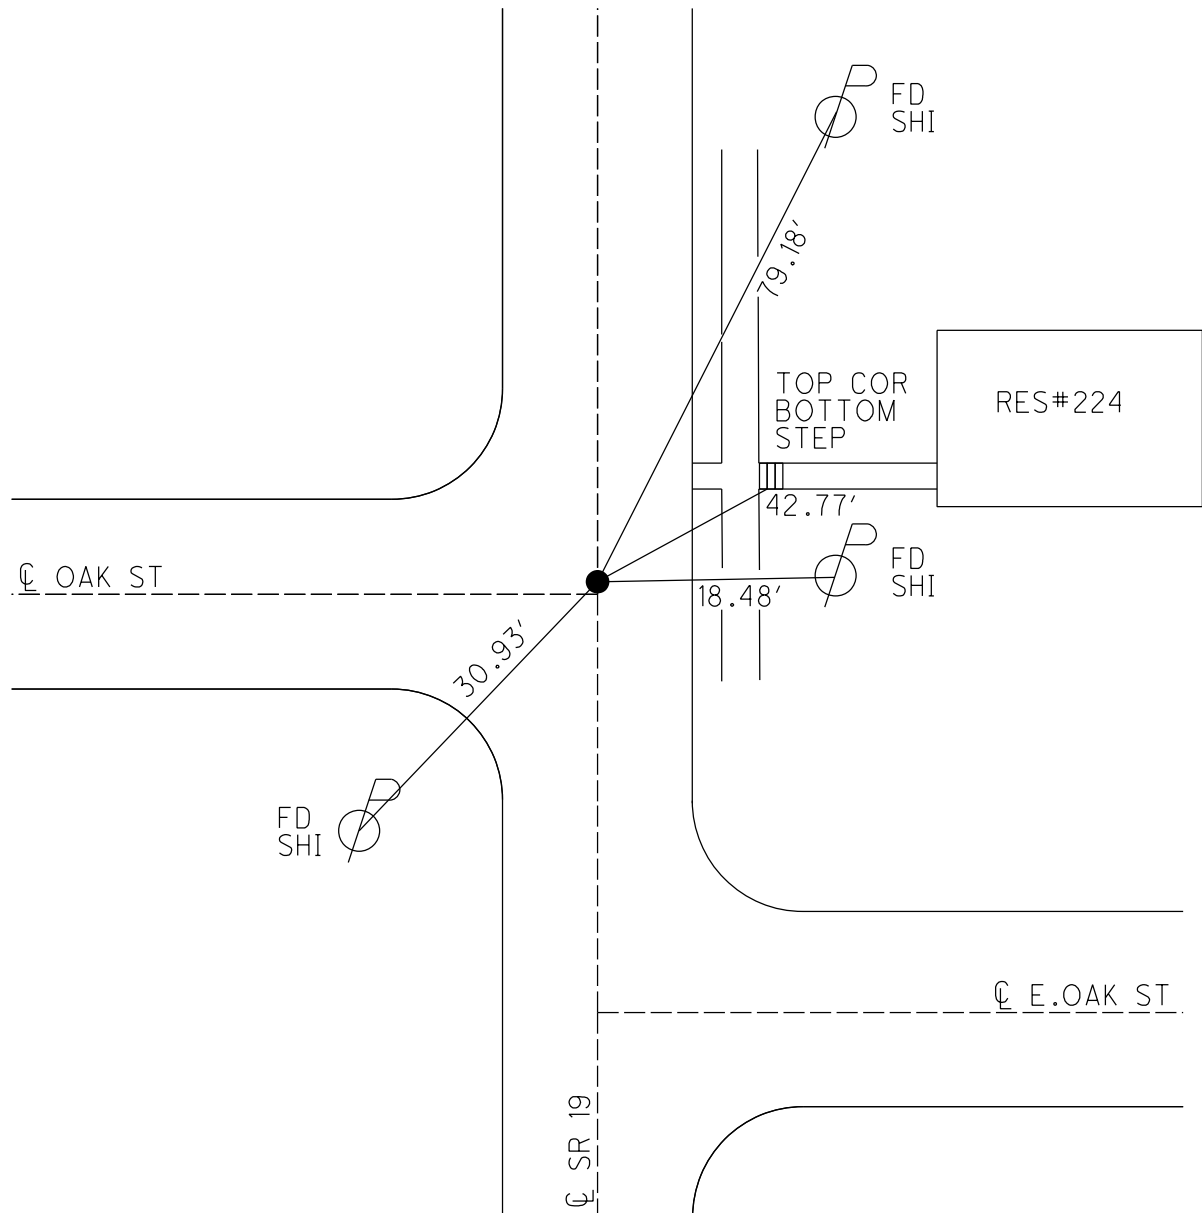

O.D.O.T. DISTRICT 2 SURVEY OFFICE (USE ONLY)

PERSONNEL

REFERENCE NO.

20 A

SHEET

3

OF 29

NOTES HUSS

DATE

10/28/09

ROUTE

SR 19

H.C.

CANTERBURY

WEATHER

FAIR

COUNTY

OTTAWA

R.C.

HUSS

TEMP.

55°

TOWNSHIP

SALEM

SECTION

5

T 6 N

R 15 E

TYPE MONUMENT P.K./WASHER

ON SURFACE ~~-BELOW-~~ ON

~~LEFT~~ - Q PAV'T - RIGHT 0.6'



12.8' TO LT EDGE PAVEMENT

S.L.M. 194+54.14

GRID: NORTHING: 672614.315

EASTING:

1791841.654

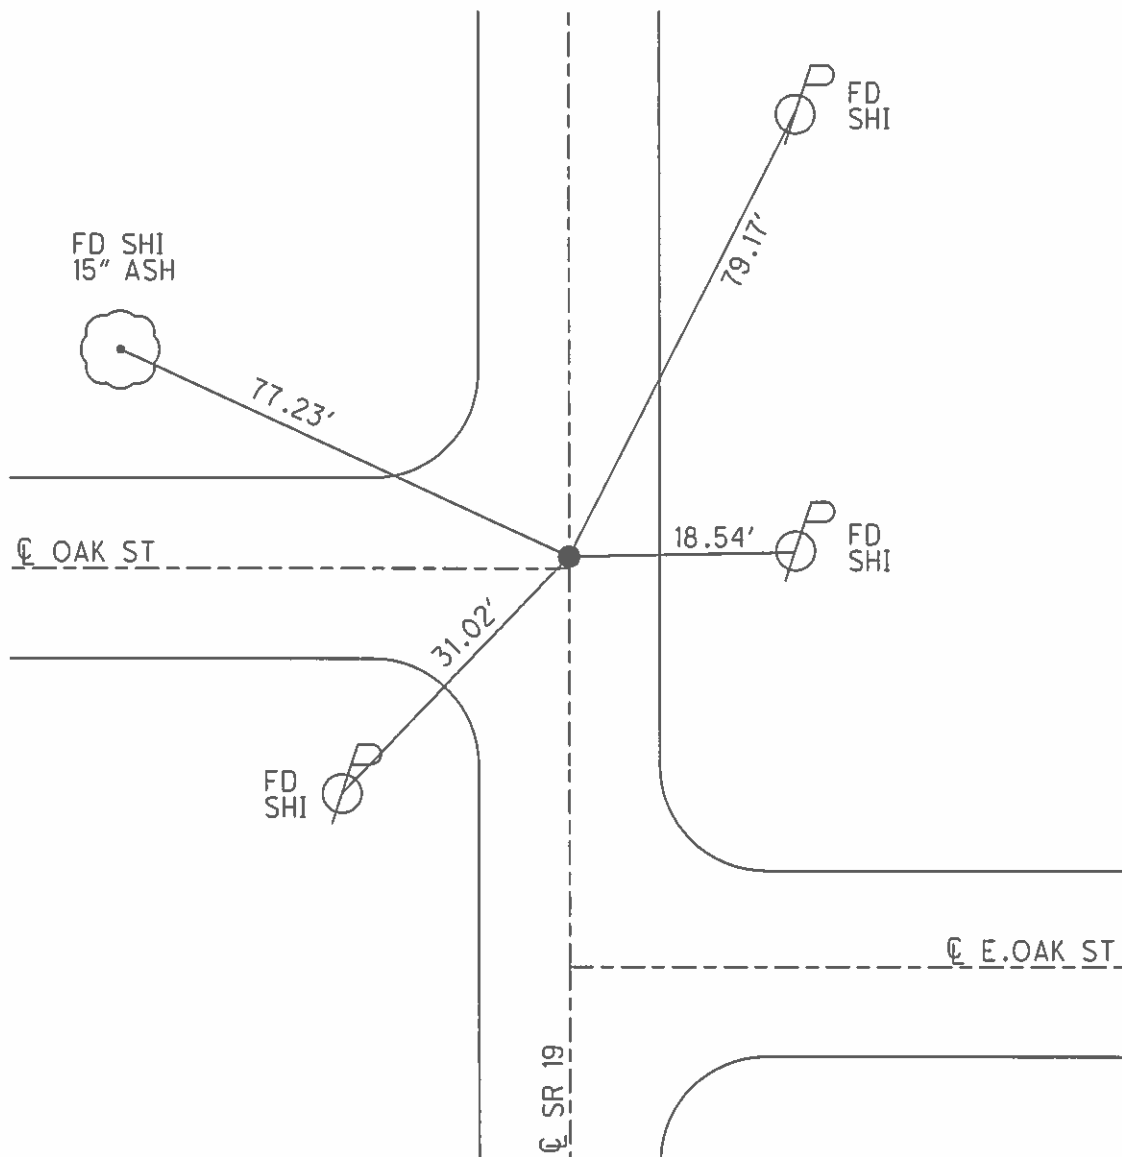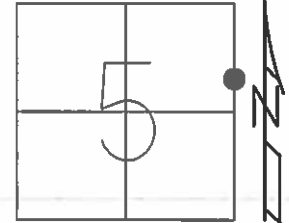

O.D.O.T. DISTRICT 2 SURVEY OFFICE (USE ONLY)

PERSONNEL	REFERENCE NO. <u>20 A</u>	SHEET <u>7</u> OF <u>33</u>
NOTES <u>HUSS</u>	DATE <u>10/28/09</u>	ROUTE <u>SR 19</u>
H.C. <u>CANTERBURY</u>	WEATHER <u>FAIR</u>	COUNTY <u>OTTAWA</u>
R.C. <u>HUSS</u>	TEMP. <u>55°</u>	TOWNSHIP <u>SALEM</u>
		SECTION <u>5</u>
		T <u>6</u> N R <u>15</u> E

TYPE MONUMENT P.K./WASHER



ON SURFACE - ~~BELOW~~ ON

~~LEFT~~ - CL PAV'T - RIGHT 0.6'

12.8' TO LT EDGE PAVEMENT

S.L.M. 194+54.14

Grid: Northing: 672614.315 Easting: 1791841.654

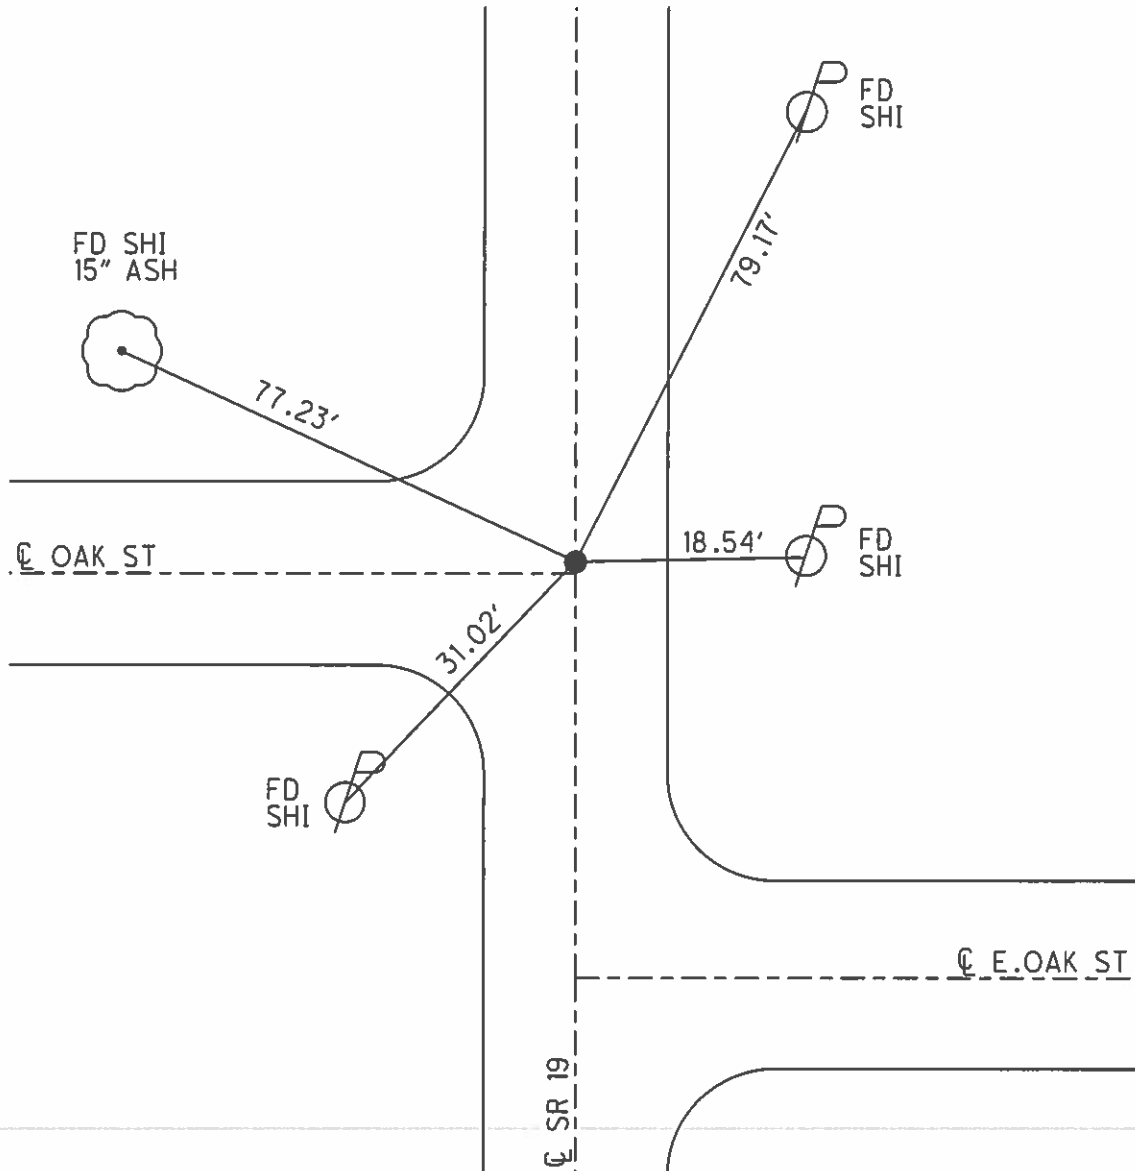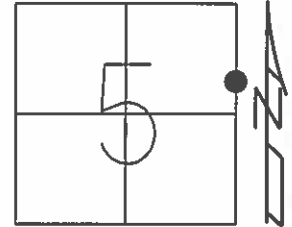

O.D.O.T. DISTRICT 2 SURVEY OFFICE

PERSONNEL

REFERENCE NO. _____

SHEET 21 OF 22

NOTES BARNHISEL

H.C. ROUSOS

R.C. HANES

DATE 8-5-96

WEATHER SUNNY

TEMP. +85°

ROUTE 19

COUNTY OTTAWA

TOWNSHIP SALEM

SECTION 5

T 14 N R 15 E


TYPE MONUMENT NEW SEWER LINE REMOVED

ON SURFACE - BELOW @ CONTROL

~~LEFT-@ PAV'T. - RIGHT~~ ON E of Oak St. to the West;

12.8 TO LT EDGE PAVEMENT 0.6' RT & SR 19


S.L.M. 194+46

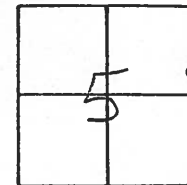

RESET PK+WASHER 3/19/97
FROM OLD TIES,

POINT DISTURBED BY
SEWER LINE CONSTRUCTION 1994

20A

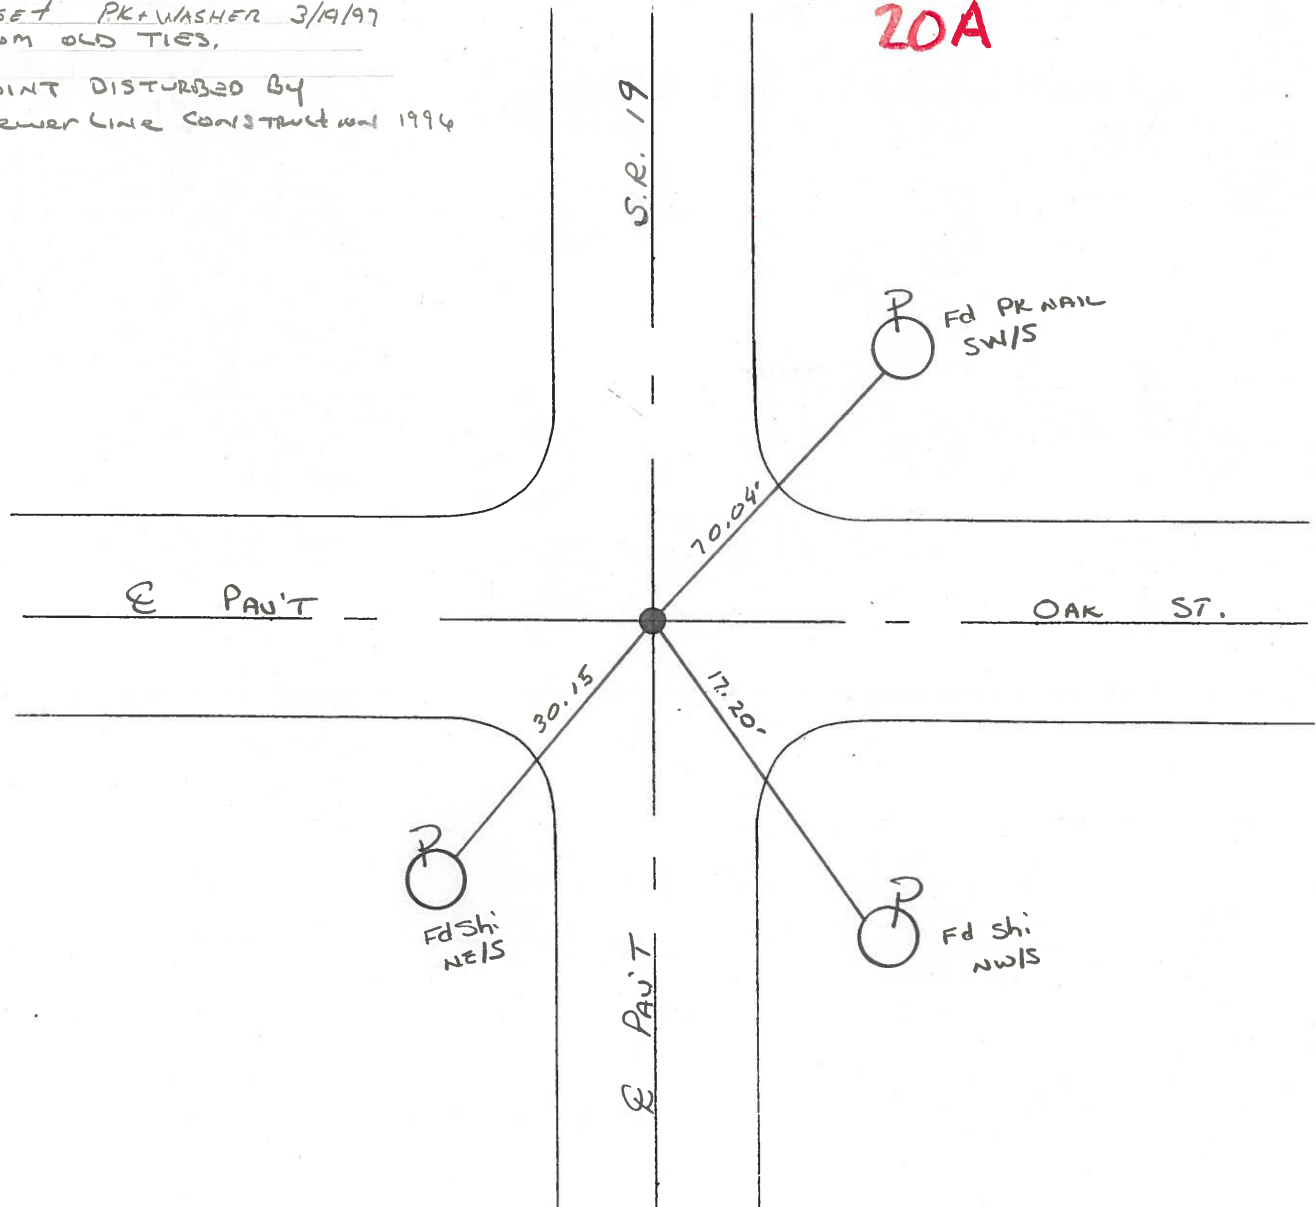

PERSONNEL TITLE PERSONNEL TITLE


CRONINCOUNTY OTTAWADATE 4/20/89RIPPLES. R. #19WEATHER SUNNYGEYMANSEC. OAK HARBORTEMP. 63°DESCRIPTION TIES - INTERSECTING STREETS - SET BY OTHERS

JOB NO. _____

LEFT

CENTER LINE


RIGHT

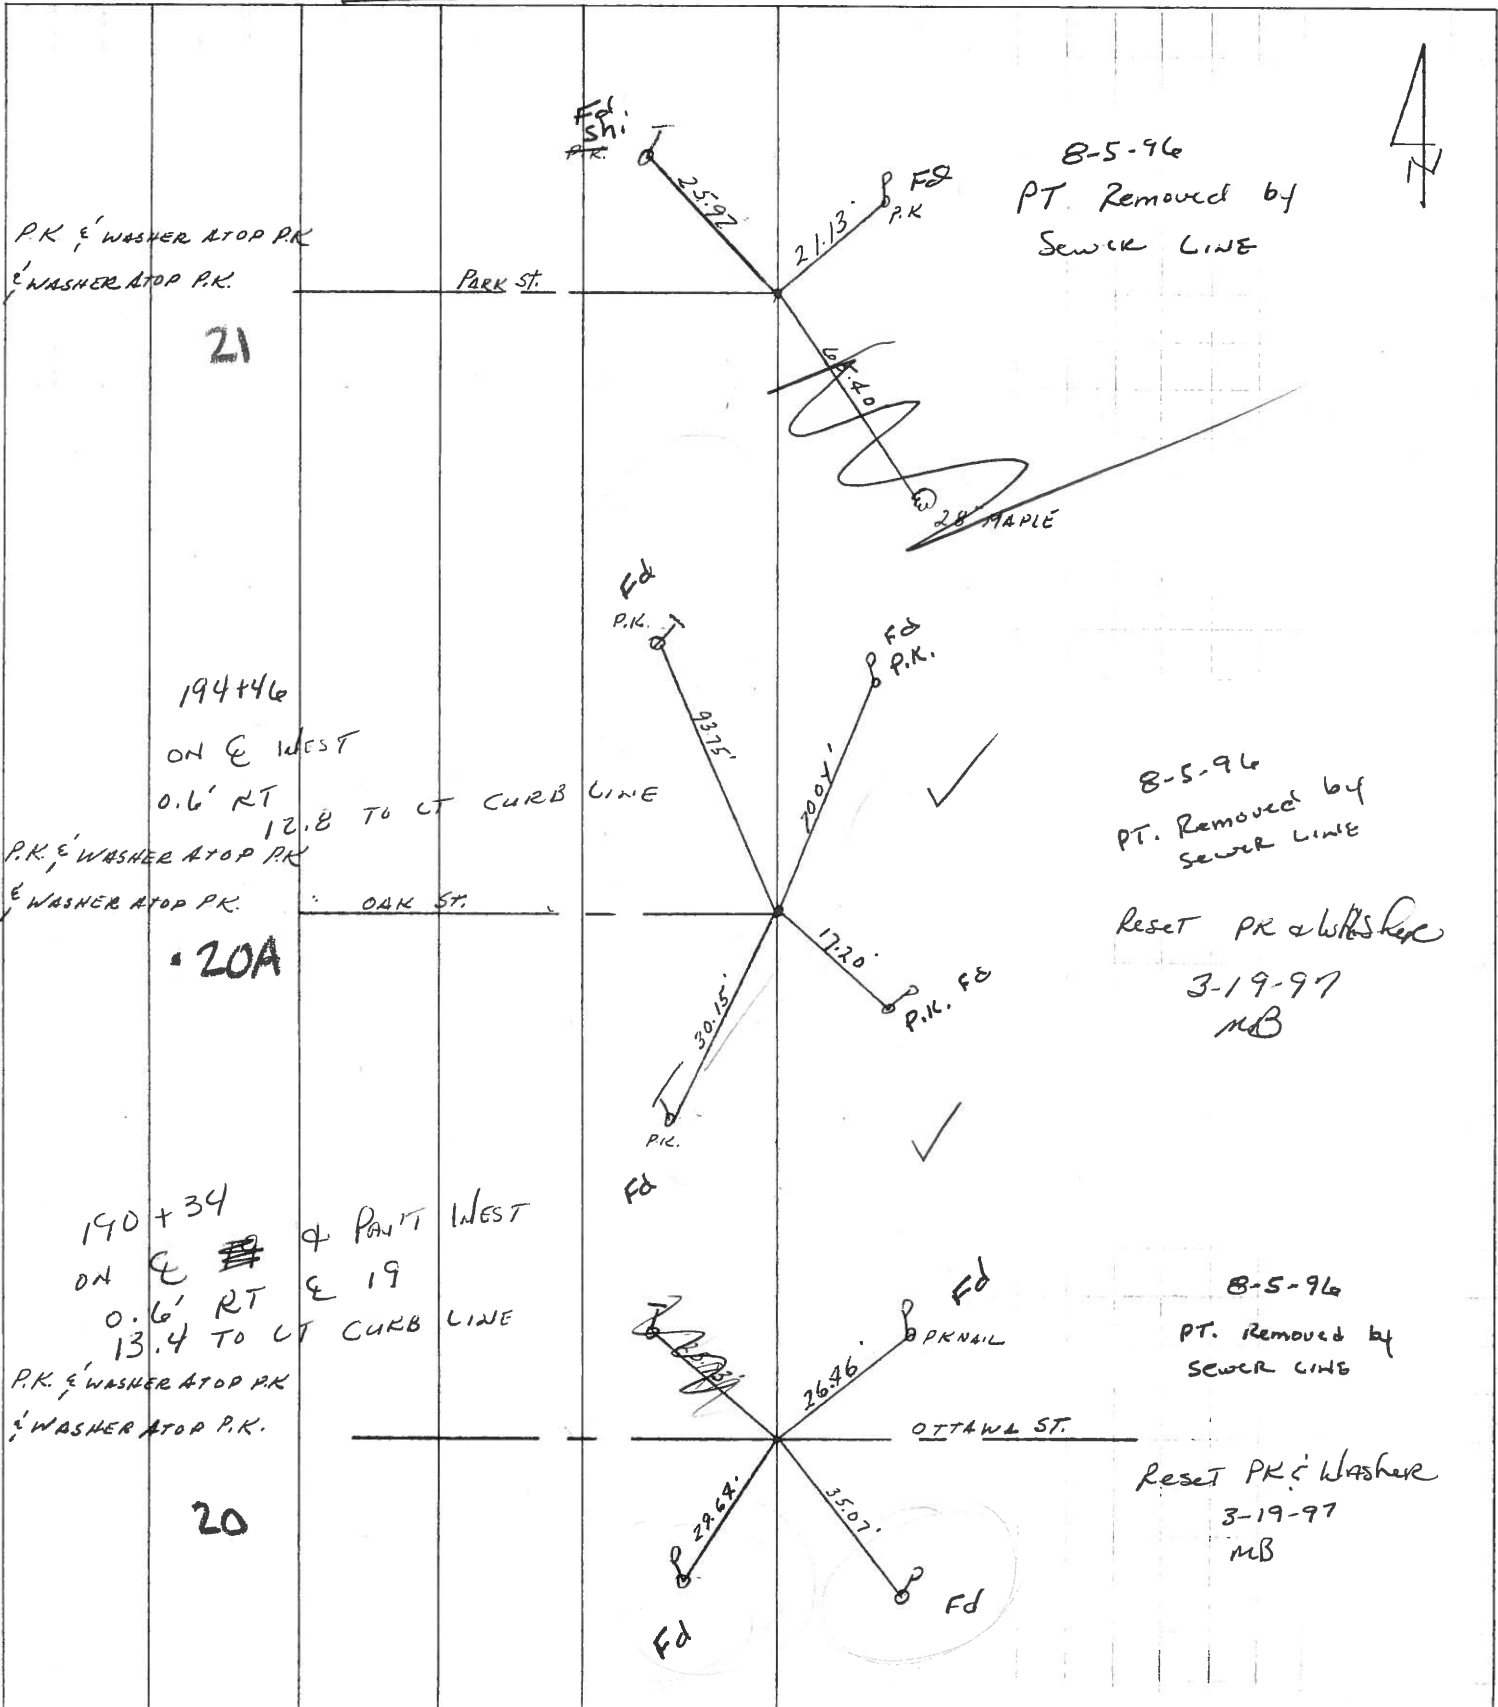

PERSONNEL	TITLE	PERSONNEL	TITLE	COUNTY	DATE	WEATHER	TEMP.
<u>CRONIN</u>				<u>OTTAWA</u>	<u>4/20/89</u>	<u>SUNNY</u>	<u>63°</u>
<u>RIPPLE</u>				<u>#19</u>			
<u>GEYMAN</u>				<u>OAK HARBOR</u>			

DESCRIPTION TIES - INTERSECTING STREETS - SET BY OTHERS

JOB NO. _____

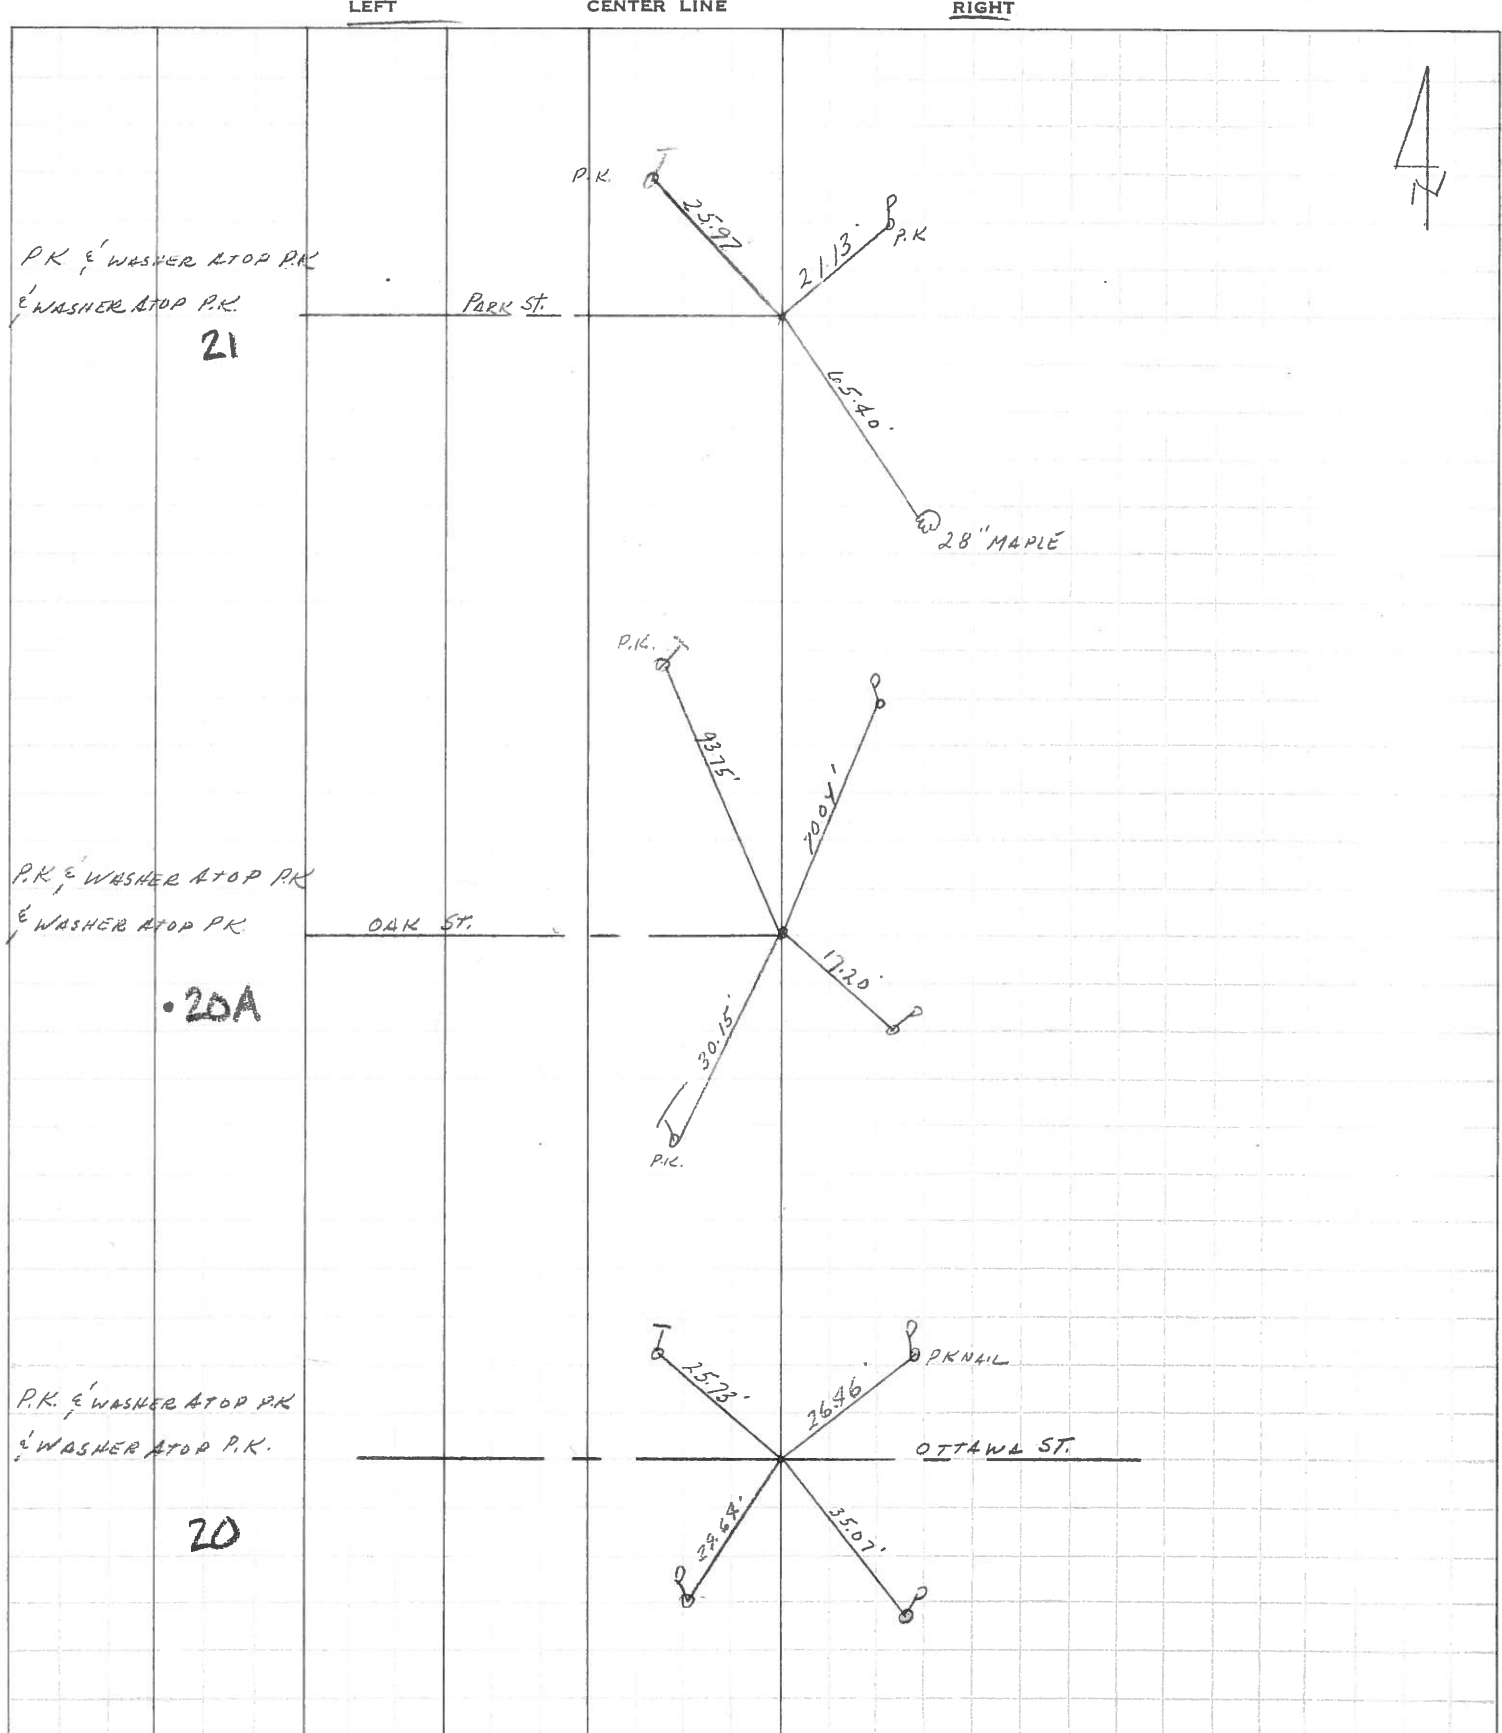

PERSONNEL TITLE PERSONNEL TITLE

COUNTY OttawaDATE 4-25-78S. R. 19WEATHER FairSEC. 554TEMP. 45°DESCRIPTION Oak Harbor

LEFT


CENTER LINE

RIGHT

JOB NO.

Reset P.K. Washer ✓
6/6/79 70°

F.d. P.K. Nail

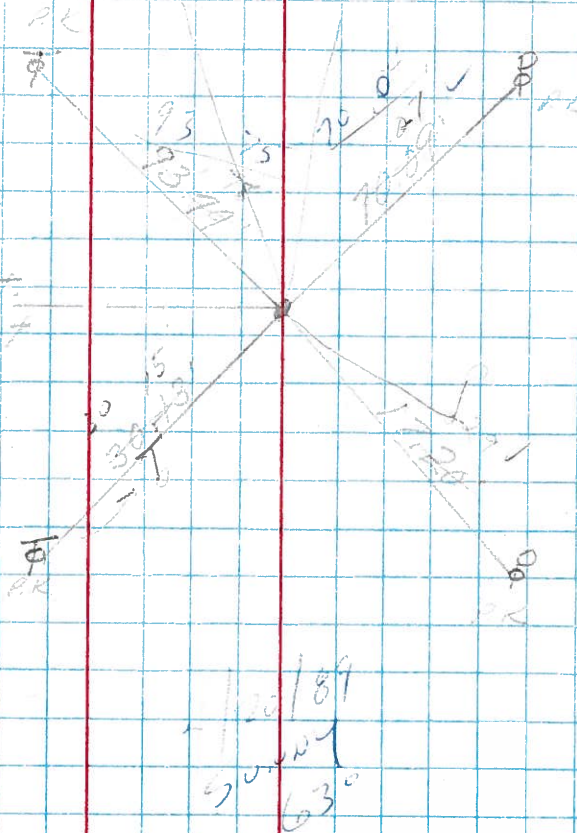.20AOak St.
WestReset P.K. Washer ✓
6/6/79 70°

F.d. P.K. Nail

20

J.G. WILSON VEENED

P.K. Nail

Ottawa St.
East