


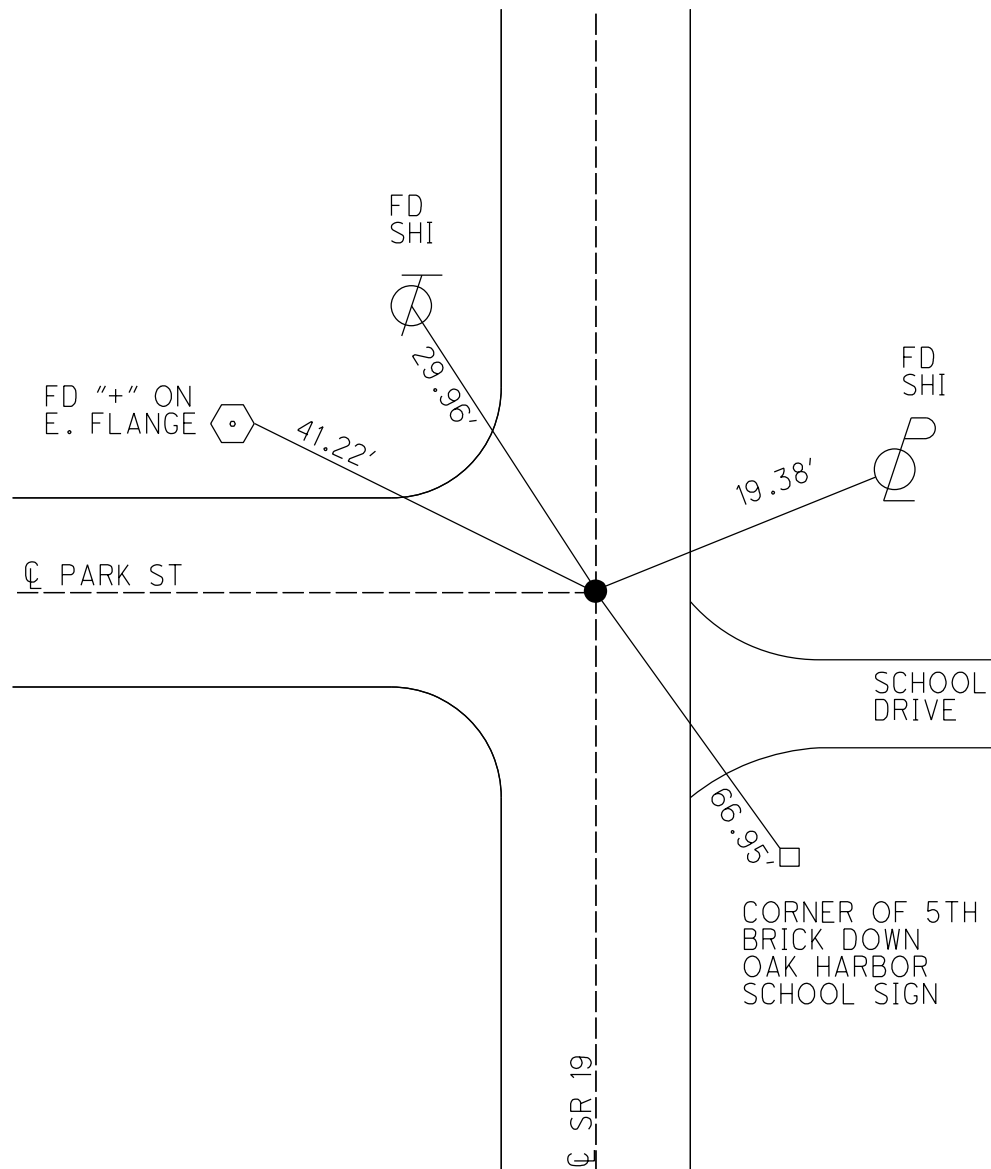

O.D.O.T. DISTRICT 2 SURVEY OFFICE (USE ONLY)

PERSONNEL

REFERENCE NO.

21

SHEET

4

OF 29

NOTES HUSS

DATE

10/28/09

ROUTE

SR 19

H.C. CANTERBURY

WEATHER

FAIR

COUNTY

OTTAWA

R.C. HUSS

TEMP.

55°

TOWNSHIP

SALEM

SECTION

5

T 6 N R 15 E

TYPE MONUMENT P.K./WASHER



ON SURFACE - ~~BELOW~~ ON

~~LEFT~~ - CL PAV'T - RIGHT 0.8'

11.7' TO RT EDGE PAVEMENT

S.L.M. 198+66.26

GRID: NORTHING: 673026.463 EASTING: 1791846.136

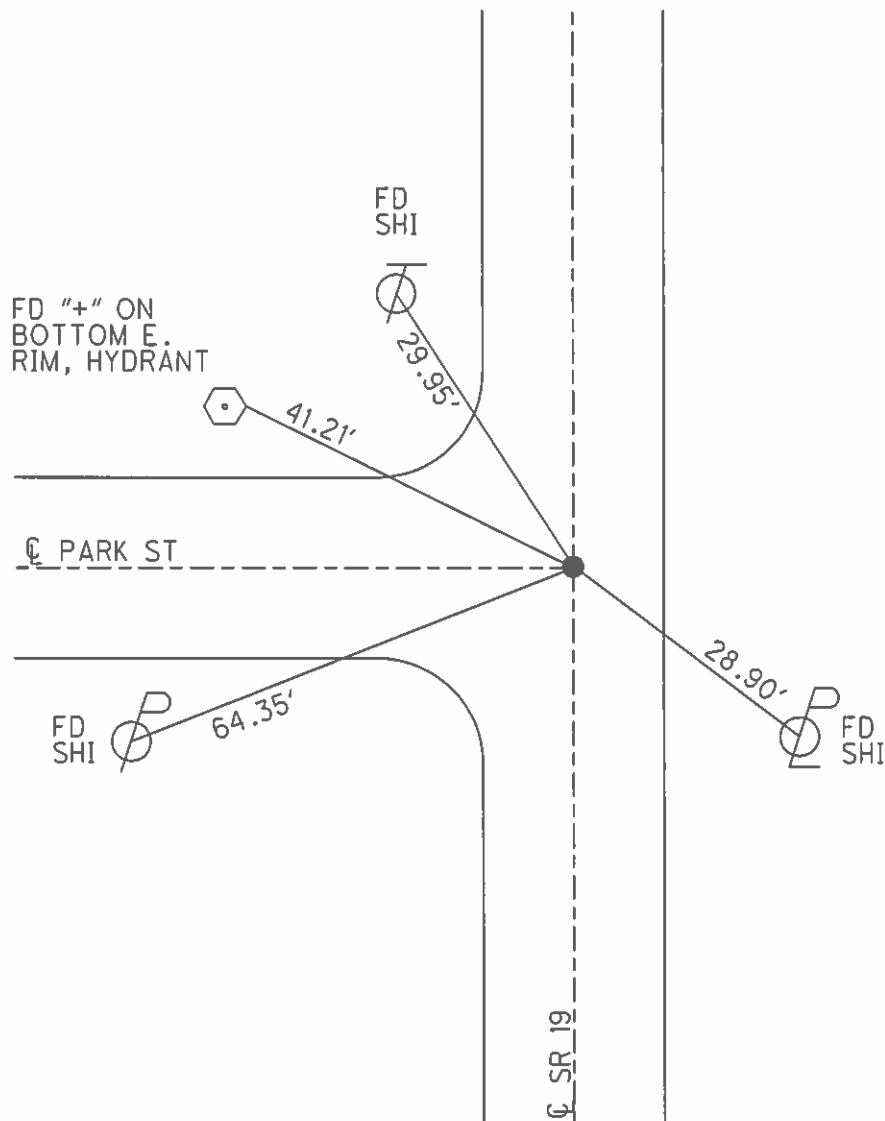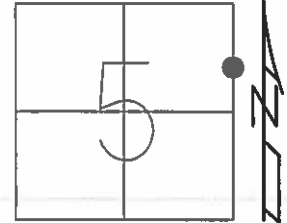

O.D.O.T. DISTRICT 2 SURVEY OFFICE (USE ONLY)

PERSONNEL

REFERENCE NO. 21

SHEET 8 OF 33

NOTES HUSS

DATE 10/28/09

ROUTE SR 19

H.C. CANTERBURY

WEATHER FAIR

COUNTY OTTAWA

R.C. HUSS

TEMP. 55°

TOWNSHIP SALEM

SECTION 5

T 6 N R 15 E

TYPE MONUMENT P.K./WASHER



ON SURFACE - ~~BELOW~~ ON

~~LEFT~~ - ℄ PAV'T - RIGHT 0.8'

11.7' TO RT EDGE PAVEMENT

S.L.M. 198+66.26

Grid: Northing: 673026.463 Easting: 1791846.136

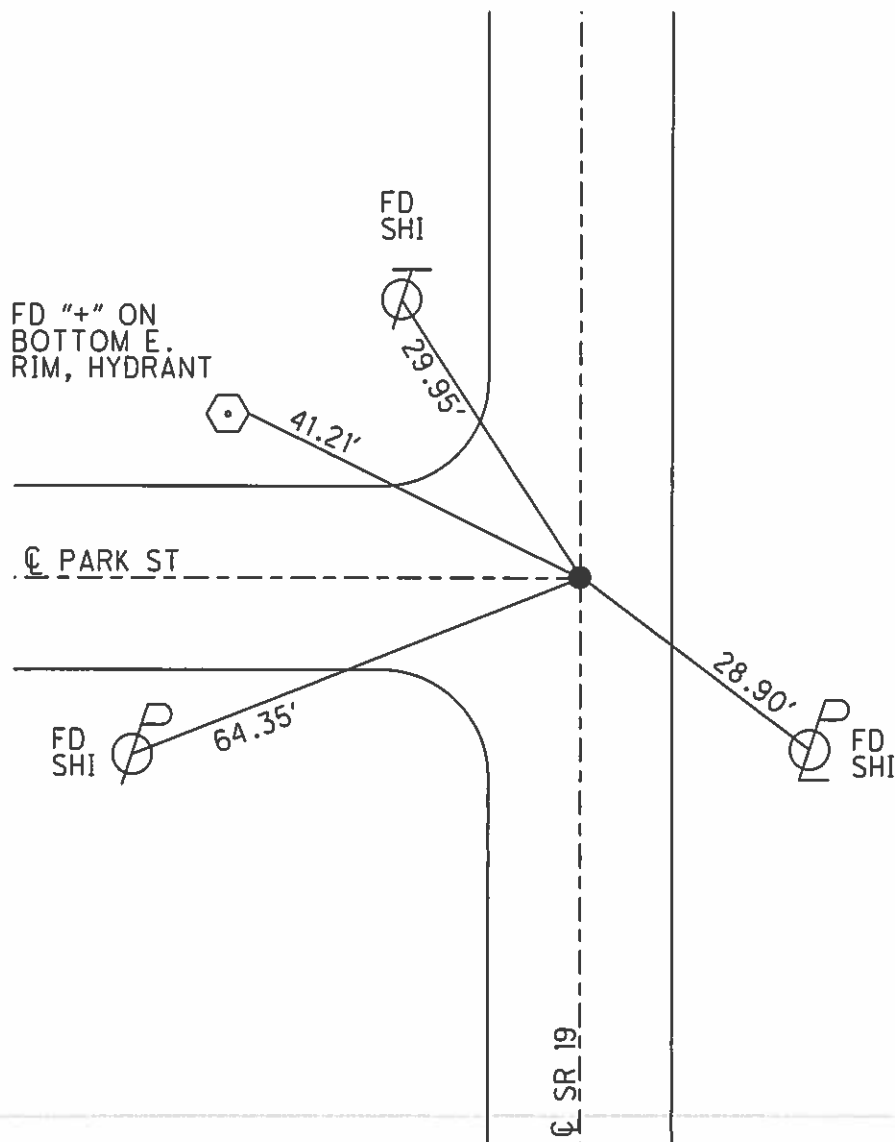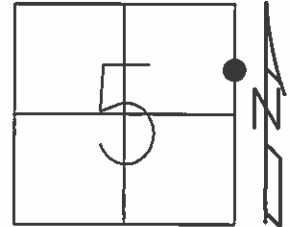

PERSONNEL

TITLE

PERSONNEL

TITLE


COUNTY OTTAWADATE 4/20/89CRONINRIPPLEGEYMANS. R. #19WEATHER SUNNYSEC. OAK HARBORTEMP. 63°DESCRIPTION TIES - INTERSECTING STREETS - SET BY OTHERS

JOB NO. _____

LEFT

CENTER LINE

RIGHT

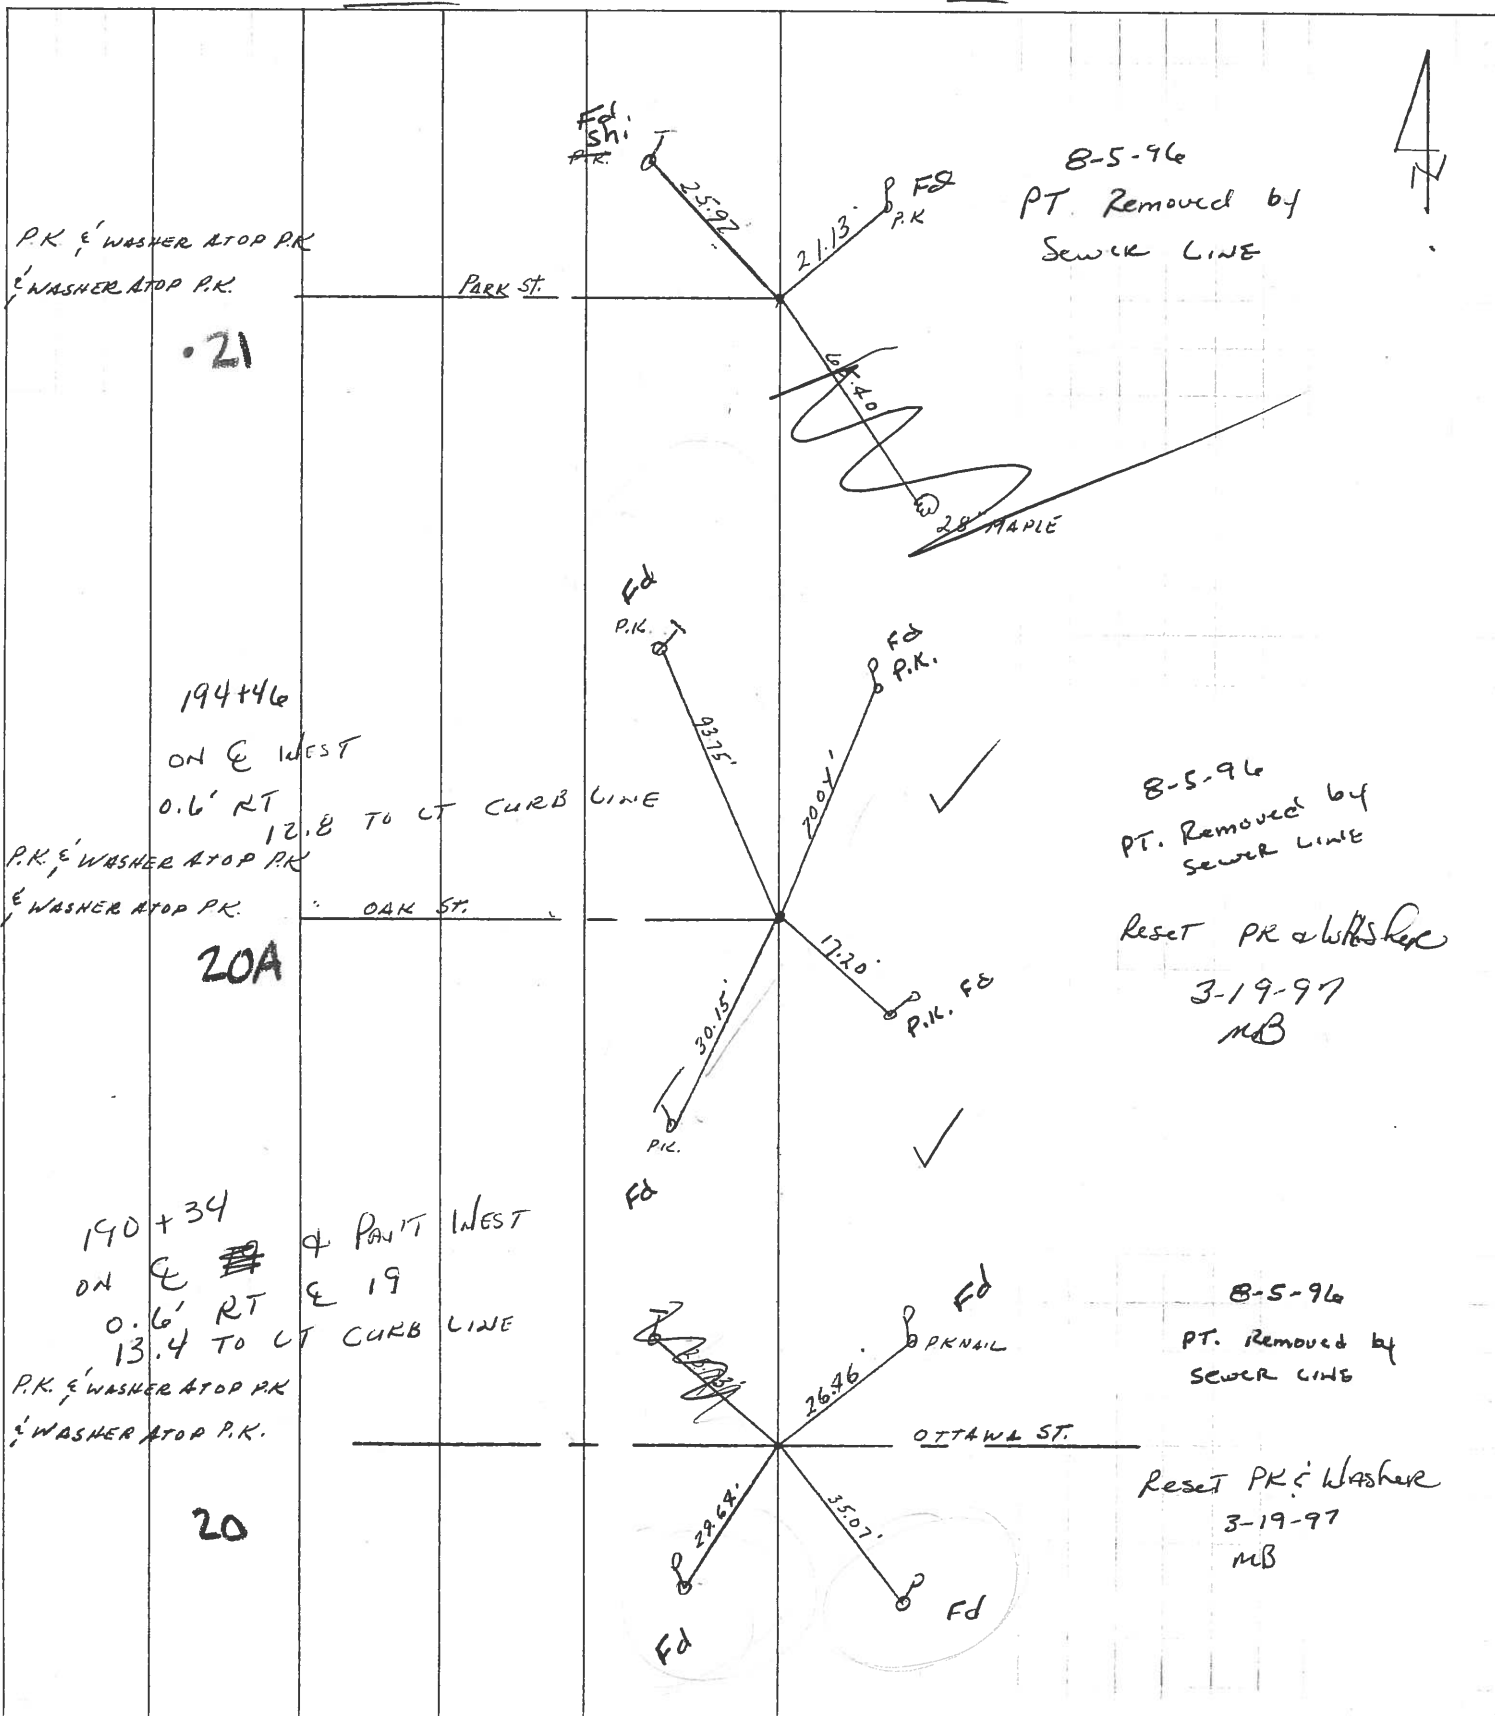

PERSONNEL

TITLE

PERSONNEL

TITLE

COUNTY OTTAWADATE 4/20/89CRONINRIPPLEGEYMANS. R. #19WEATHER SUNNYSEC. OAK HARBORTEMP. 63°DESCRIPTION TIES - INTERSECTING STREETS - SET BY OTHERS

JOB NO. _____

LEFT

CENTER LINE

RIGHT

P.K. & WASHER ATOP P.K.

& WASHER ATOP P.K.

•21

PARK ST.

P.K. & WASHER ATOP P.K.

& WASHER ATOP P.K.

20A




OAK ST.

P.K. & WASHER ATOP P.K.

& WASHER ATOP P.K.

20

OTTAWA ST.

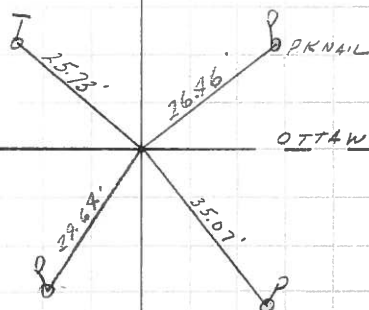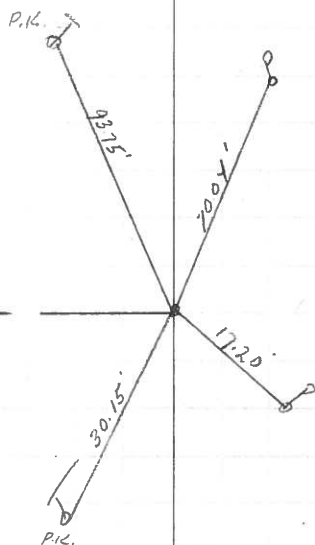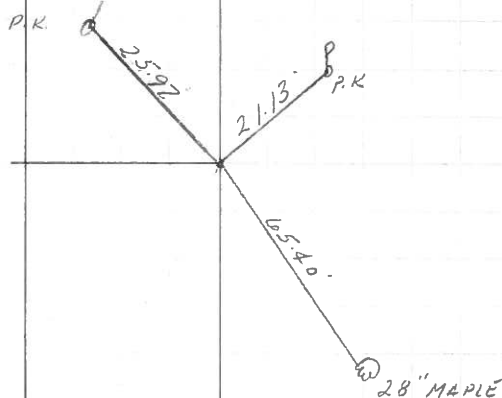

PERSONNEL TITLE PERSONNEL TITLE

COUNTY Ottawa DATE 5-4-71S. R. 19 WEATHERSEC. 5 & 4 TEMP.

DESCRIPTION


Oak Harbor

JOB NO.

LEFT

CENTER LINE

RIGHT

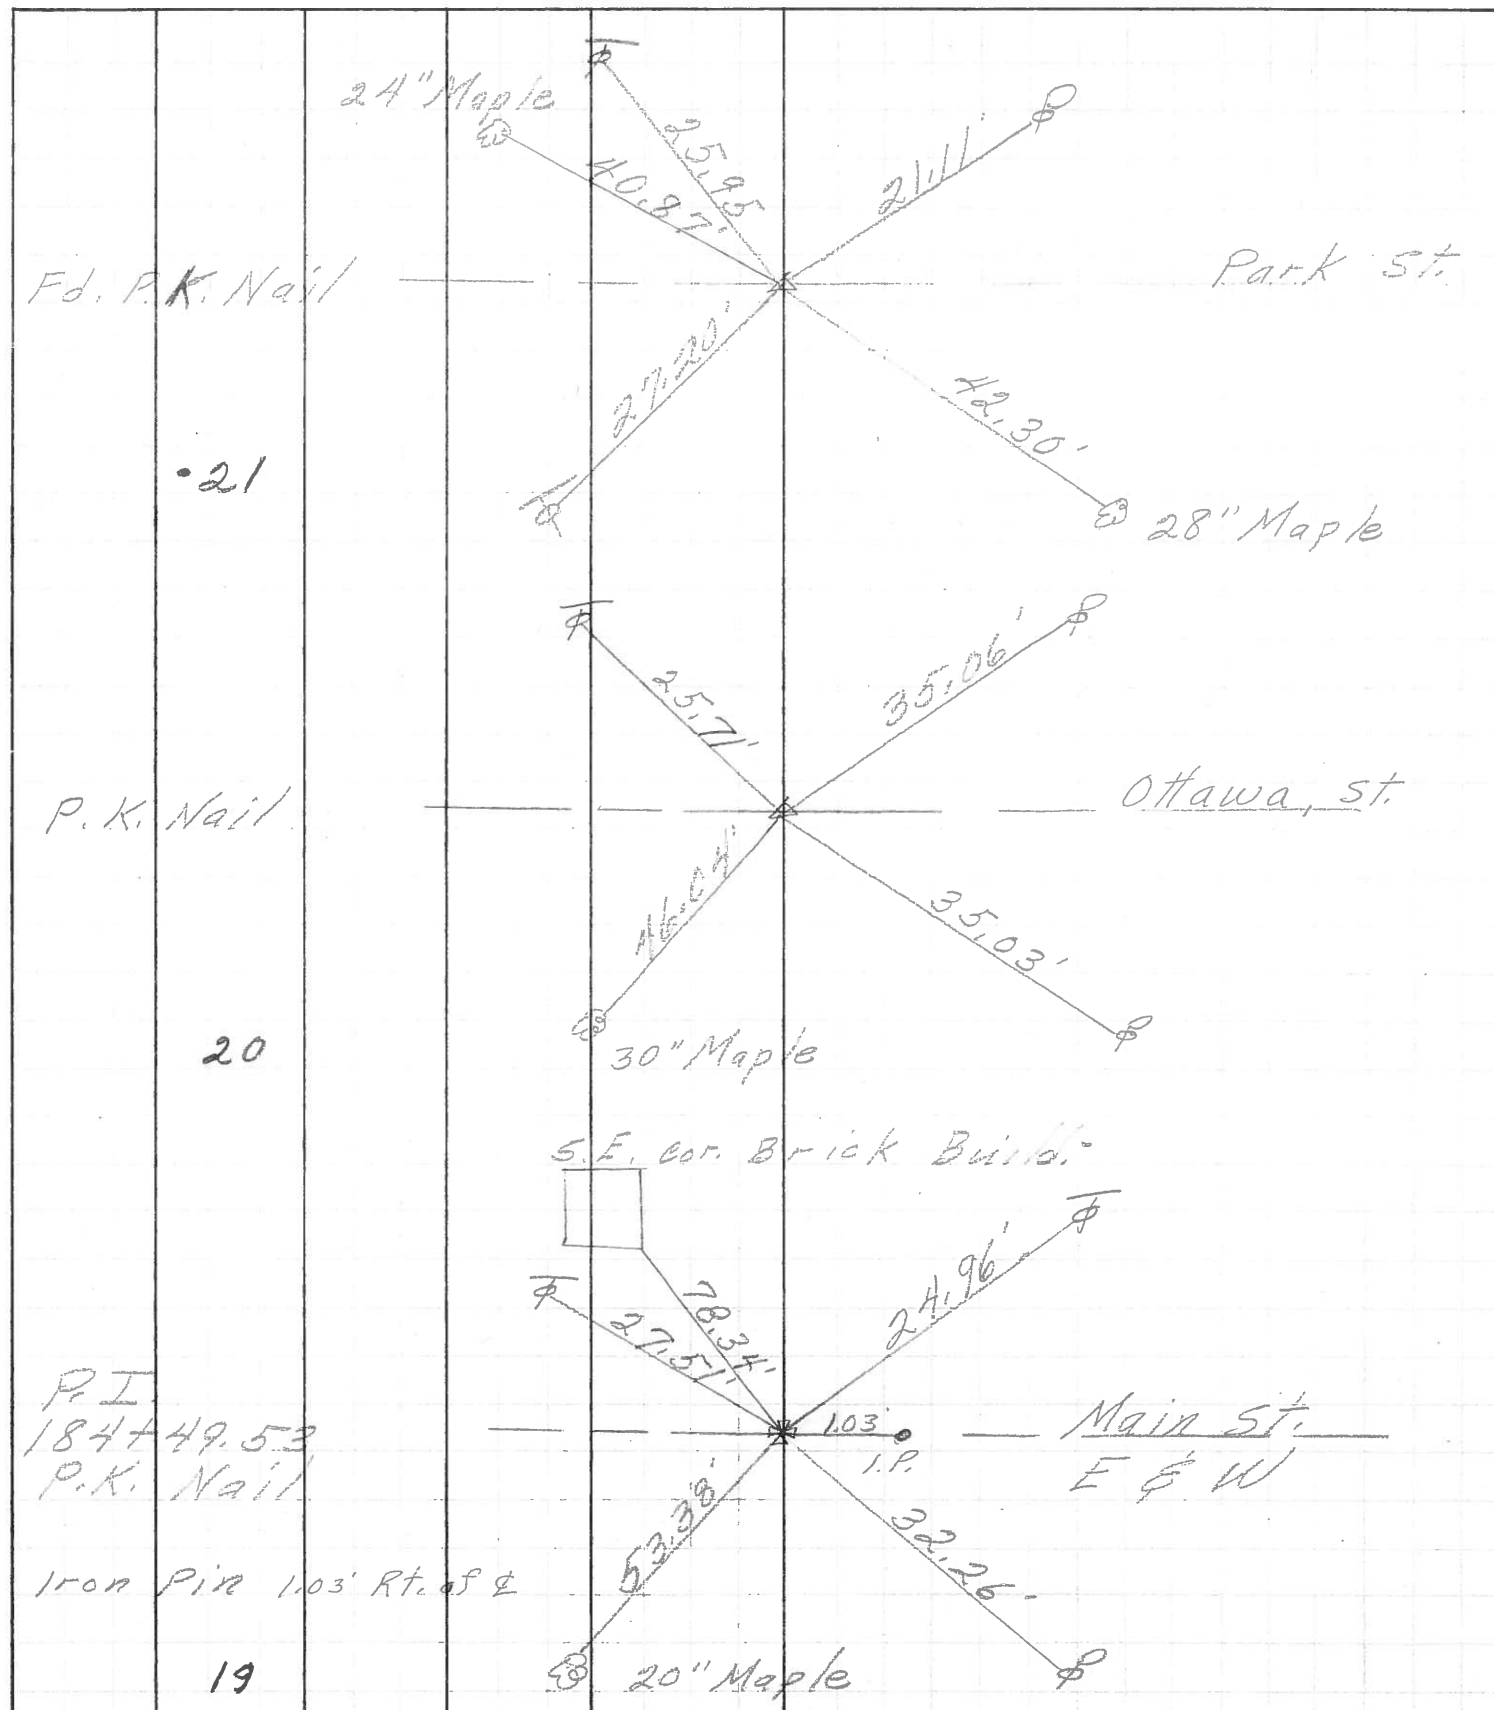

PERSONNEL TITLE PERSONNEL TITLE

COUNTY Ottawa DATE 5-13-68SchneiderMosserBarbourReddingS. R. 19 WEATHER FairSEC. Oak Harbor TEMP. 65°DESCRIPTION Ties for Control Points JOB NO. _____

LEFT

CENTER LINE

RIGHT

Fd. P.K. Nail

6122 24

Houghton St.

21.16'

24.39'

55.74

65.33

34.55

2 store
Res

Top 1st. Conc-Block.

24" Maple

30" Buckeye

36.15

28.79'

26" Maple

P. I.

Fd. P.K. Nail

Townline St.

6121 23

Townline St.

23.52'

23.89

21.31'

17.72'

Fd. P.K. Nail

6120 22

Jefferson St.

25.91

20.52'

Fd. P.K. Nail

6119 .21

24" Maple

25.95

40.81

21.11'

Park St.

27.20

42.30'

28' Maple