

O.D.O.T. DISTRICT 2 SURVEY OFFICE (USE ONLY)

PERSONNEL

REFERENCE NO. 21 A

SHEET OF

NOTES ASTON

DATE 10/25/23

ROUTE SR 19

H.C. NIESE

WEATHER BREEZY

COUNTY OTTAWA

R.C. ASTON

TEMP. 60°

TOWNSHIP SALEM

SECTION 5

DWG BY BARRIERE

PID 101239

T 6 N R 15 E

TYPE MONUMENT MAG NAIL/WASHER

ON SURFACE - BELOW 1" BELOW

OFFSET CL PAVEMENT 1' RT LT : RT

 TO EDGE PAVEMENT

STATION: 202+78.14

HORIZ.DATUM: NAD 83 (2011)


GEOID: 18

GRID: NORTHING: 673438.453

EASTING: 1791850.494


LDP: NORTHING: 332935.210

EASTING: 151713.438

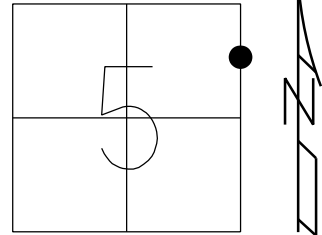

RECORD:

SET NAIL/SHI
3/15/07, RGN
SET MAG/WASHER
11/6/07, SAH
FD NAIL/SHI
REF21A
10/28/09, HUSS
FD NAIL SHANK
1" DOWN, REF21A
6/29/23, TDN
SET MAG/WASHER
REF21A
10/25/23, TDN

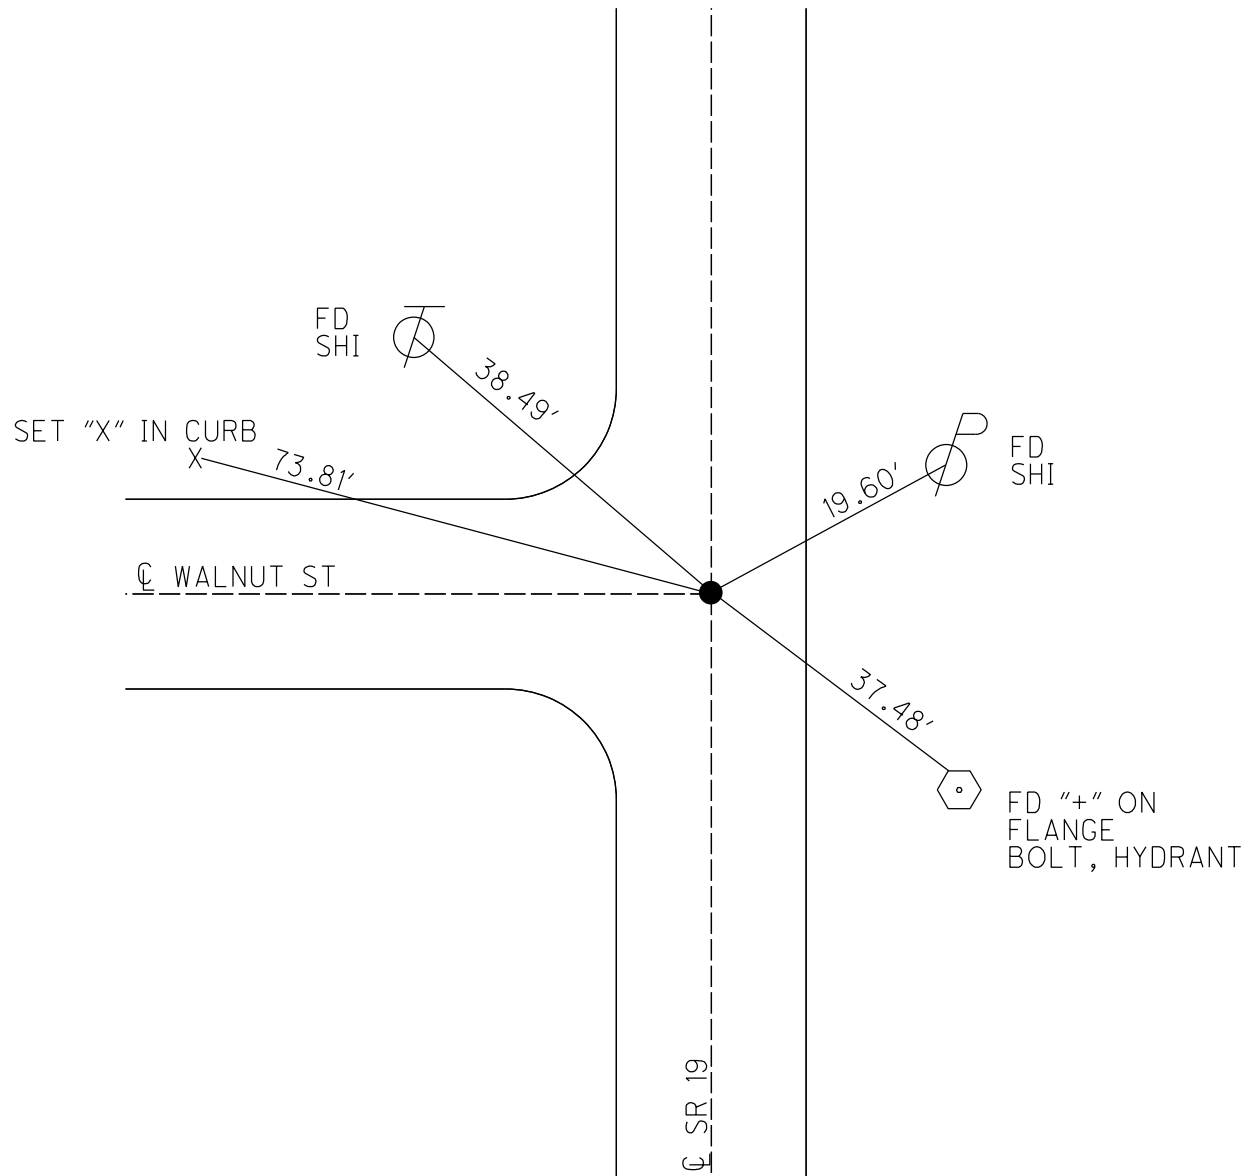

O.D.O.T. DISTRICT 2 SURVEY OFFICE (USE ONLY)

PERSONNEL

REFERENCE NO.

21 A

SHEET

5

OF 29

NOTES

HUSS

DATE

10/28/09

ROUTE

SR 19

H.C.

CANTERBURY

WEATHER

FAIR

COUNTY

OTTAWA

R.C.

HUSS

TEMP.

55°

TOWNSHIP

SALEM

SECTION

5

T 6 N

R 15 E

TYPE MONUMENT

NAIL/SHI

ON SURFACE - ~~BELOW~~

ON

~~LEFT~~ - CL PAV'T - RIGHT

0.4'

11.9'



TO RT EDGE PAVEMENT

S.L.M.

202+78.29

GRID: NORTHING: 673438.453

EASTING: 1791850.494

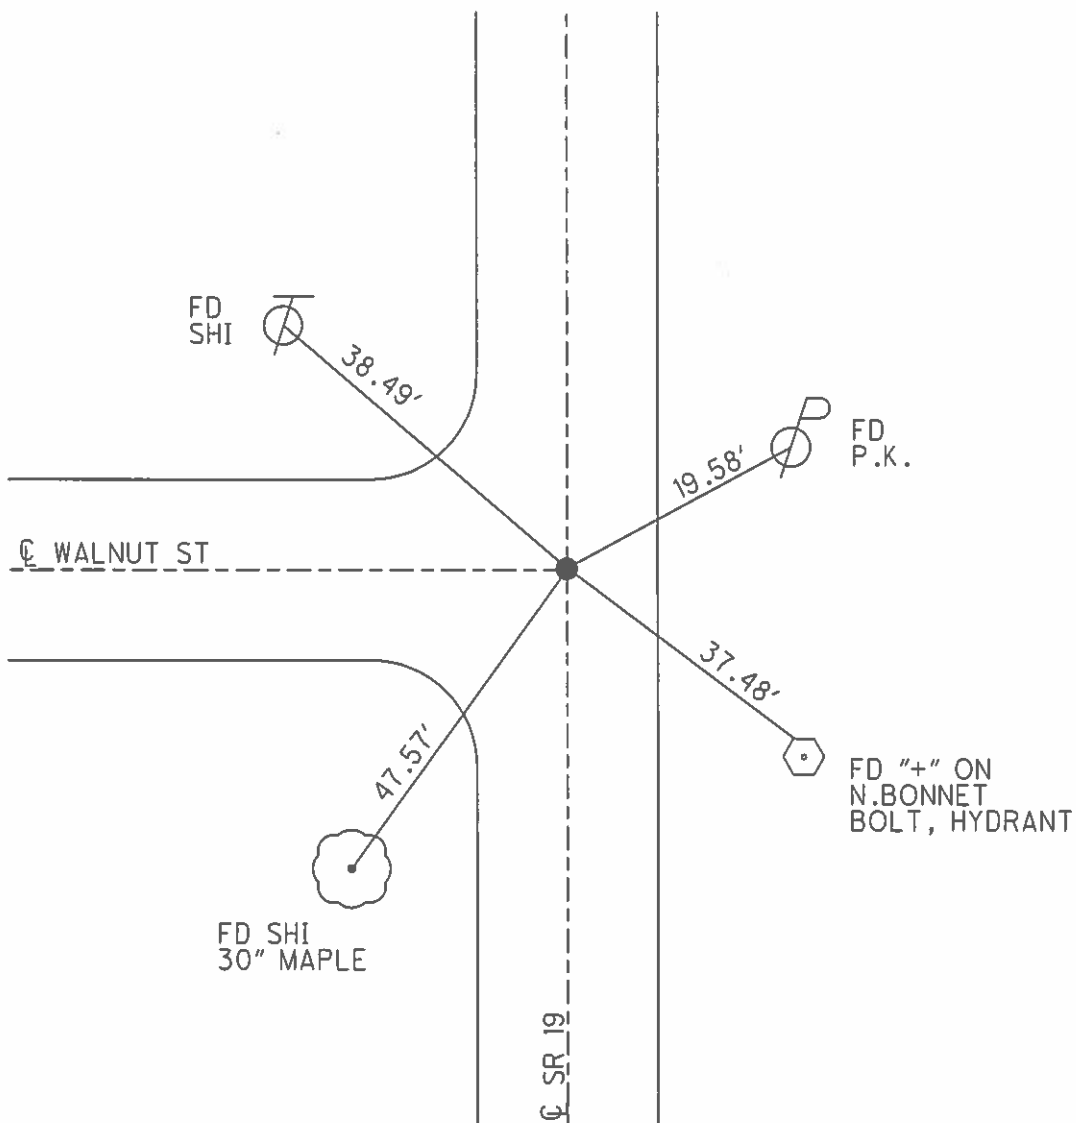
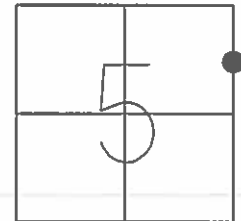


O.D.O.T. DISTRICT 2 SURVEY OFFICE (USE ONLY)

PERSONNEL	REFERENCE NO. <u>21 A</u>	SHEET <u>9</u> OF <u>33</u>
NOTES <u>HUSS</u>	DATE <u>10/28/09</u>	ROUTE <u>SR 19</u>
H.C. <u>CANTERBURY</u>	WEATHER <u>FAIR</u>	COUNTY <u>OTTAWA</u>
R.C. <u>HUSS</u>	TEMP. <u>55°</u>	TOWNSHIP <u>SALEM</u>
		SECTION <u>5</u>
		T <u>6</u> N R <u>15</u> E

TYPE MONUMENT NAIL / SHINNER
 ON SURFACE - ~~BELOW~~ ON
~~LEFT~~ - CL PAV'T - RIGHT 0.4'
11.9' TO RT EDGE PAVEMENT
 S.L.M. 202+78.29

Grid: Northing: 673438.453 Easting: 1791850.494

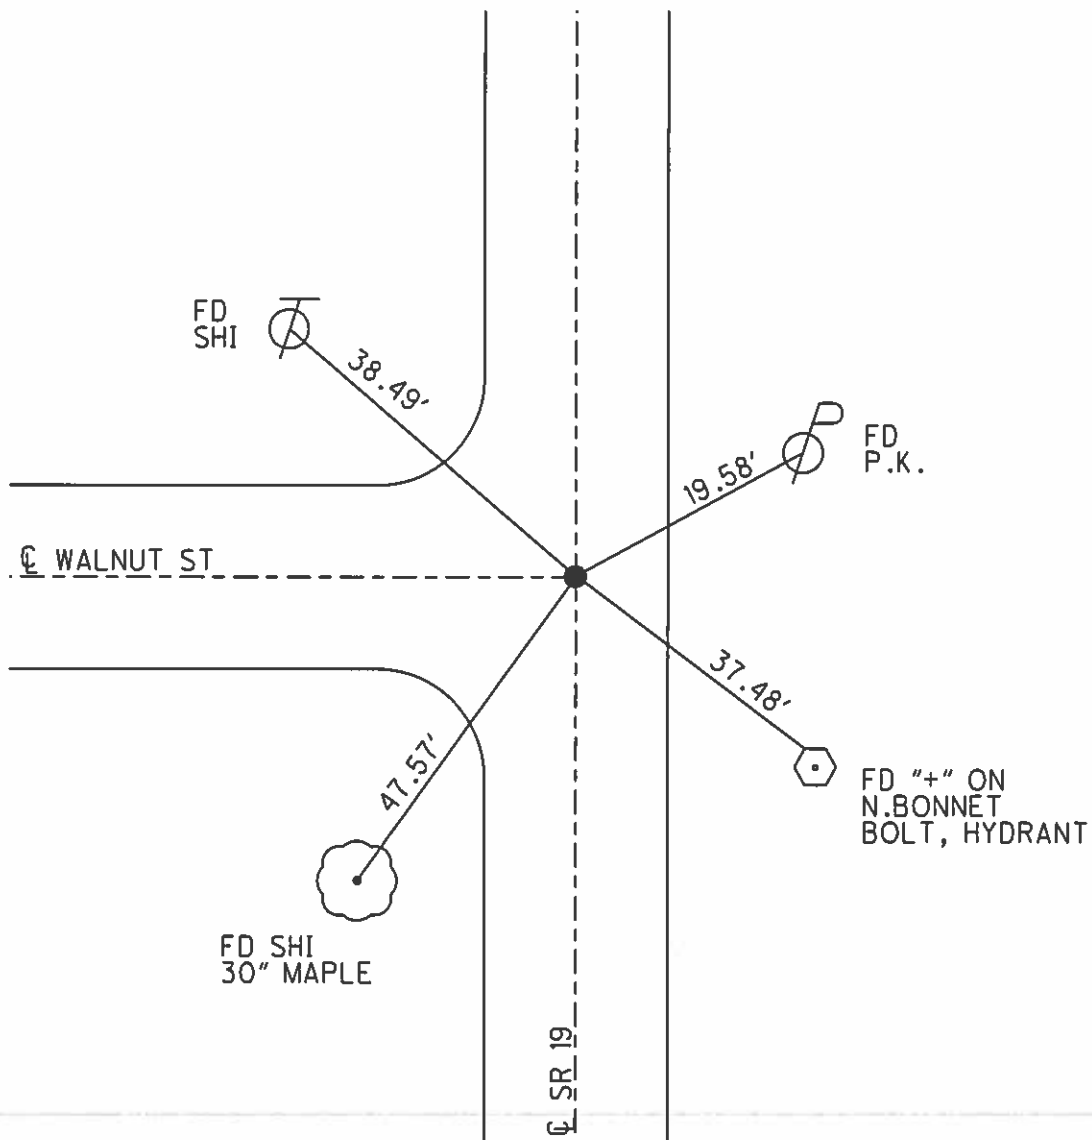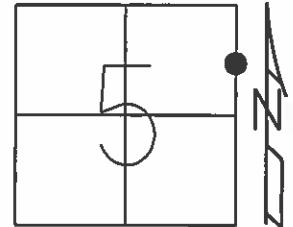

DRAWN 4/24/89DATE 4/20/89

PERSONNEL

TITLE

PERSONNEL

TITLE


COUNTY OTTAWACRONINRIPPLEGEYMANS. R. #19WEATHER SUNNYSEC. OAK HARBORTEMP. 63°DESCRIPTION TIES - INTERSECTING STREETS - SET BY OTHERS

JOB NO. _____

LEFT

CENTER LINE

RIGHT

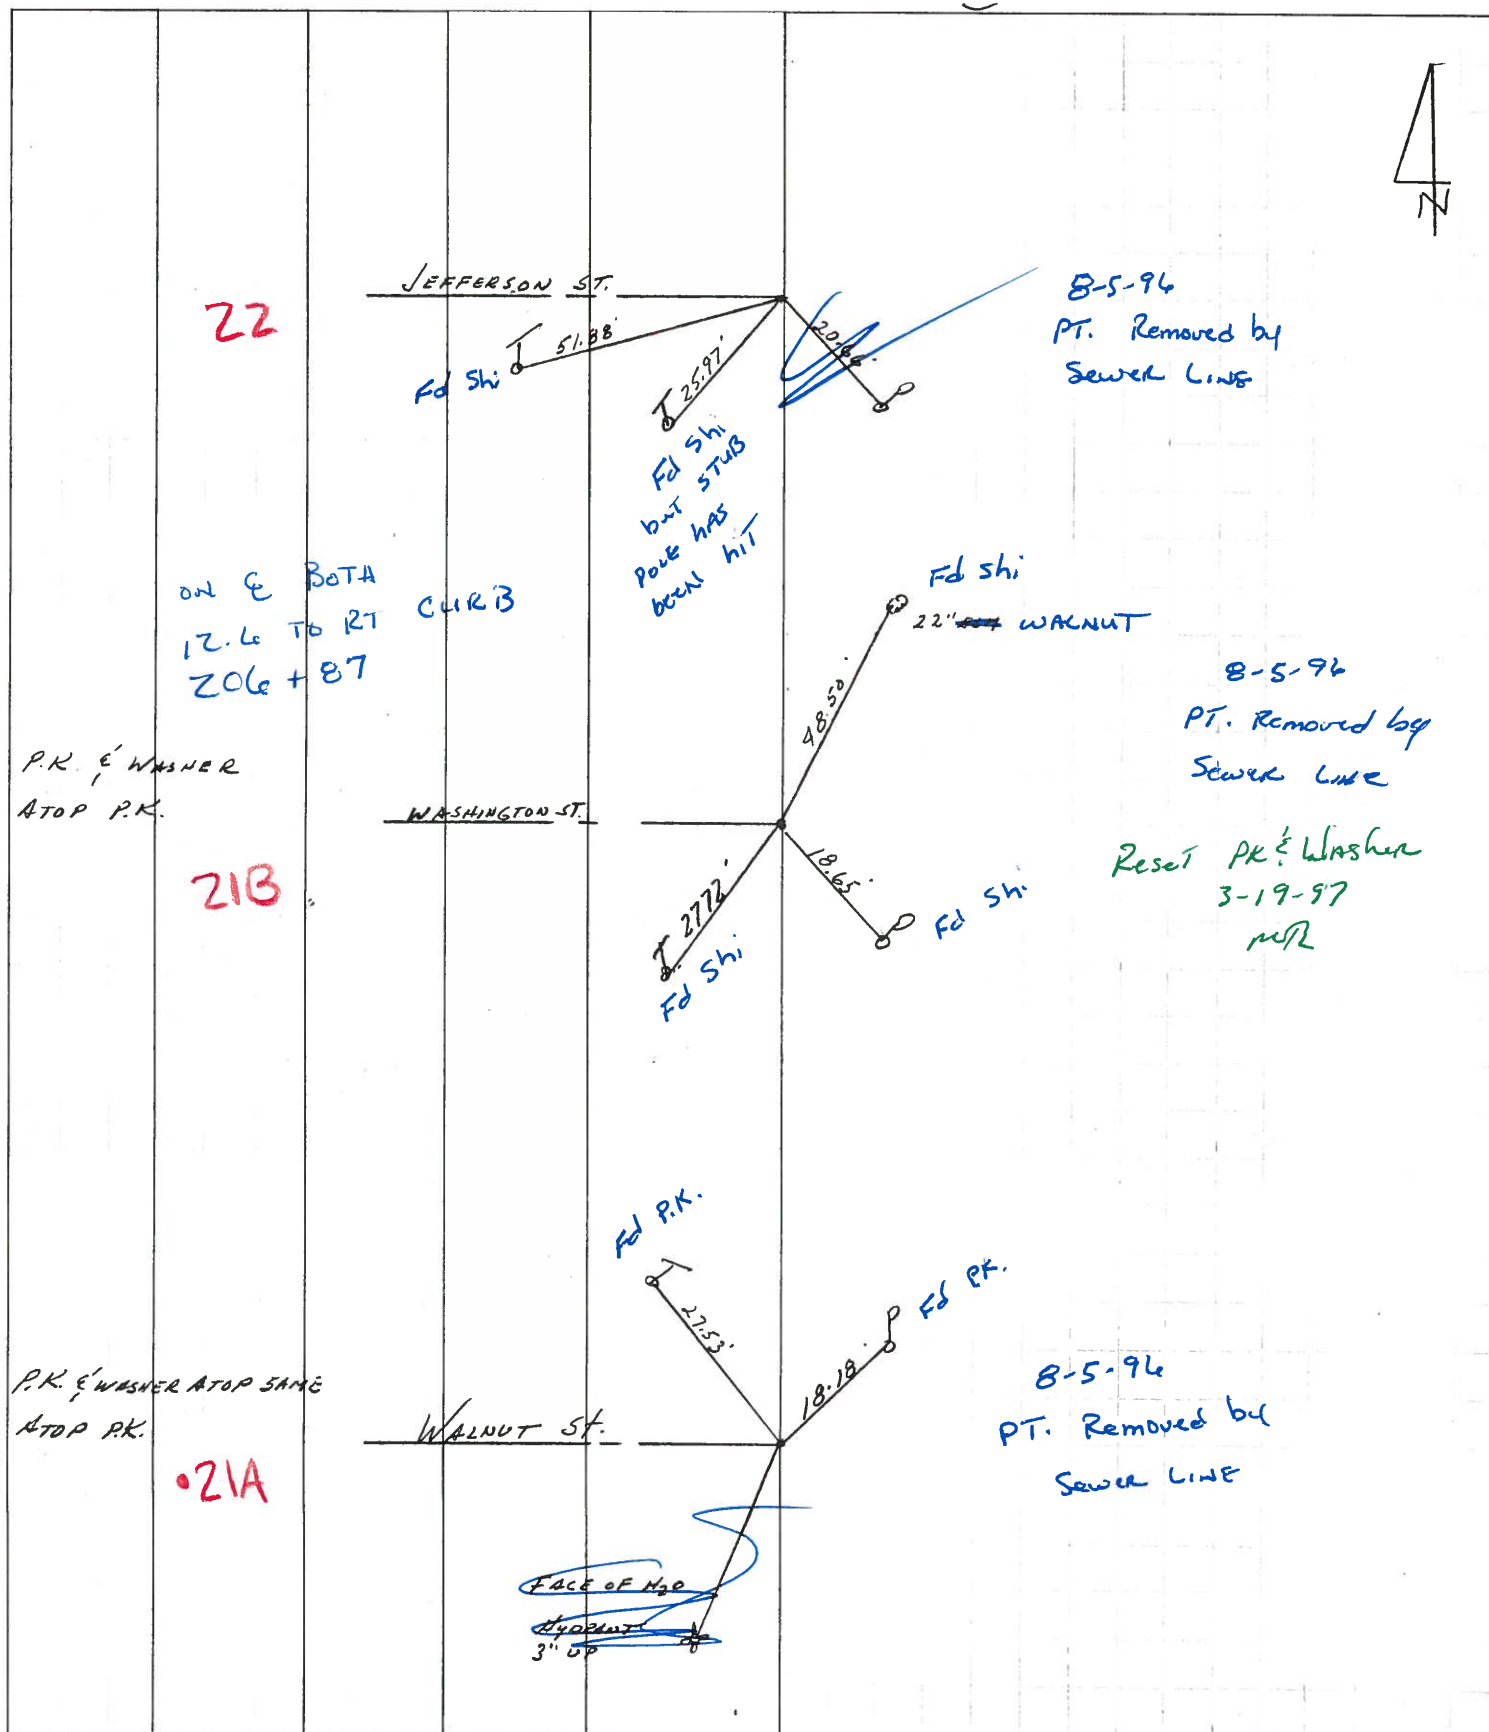

PERSONNEL

TITLE

PERSONNEL

TITLE


DRAWN 4/24/89DATE 4/20/89CRONINCOUNTY OTTAWARIPPLES. R. #19WEATHER SUNNYGEYMANSEC. OAK HARBORTEMP. 63°DESCRIPTION TIES - INTERSECTING STREETS - SET BY OTHERS

JOB NO. _____

LEFT

CENTER LINE

RIGHT

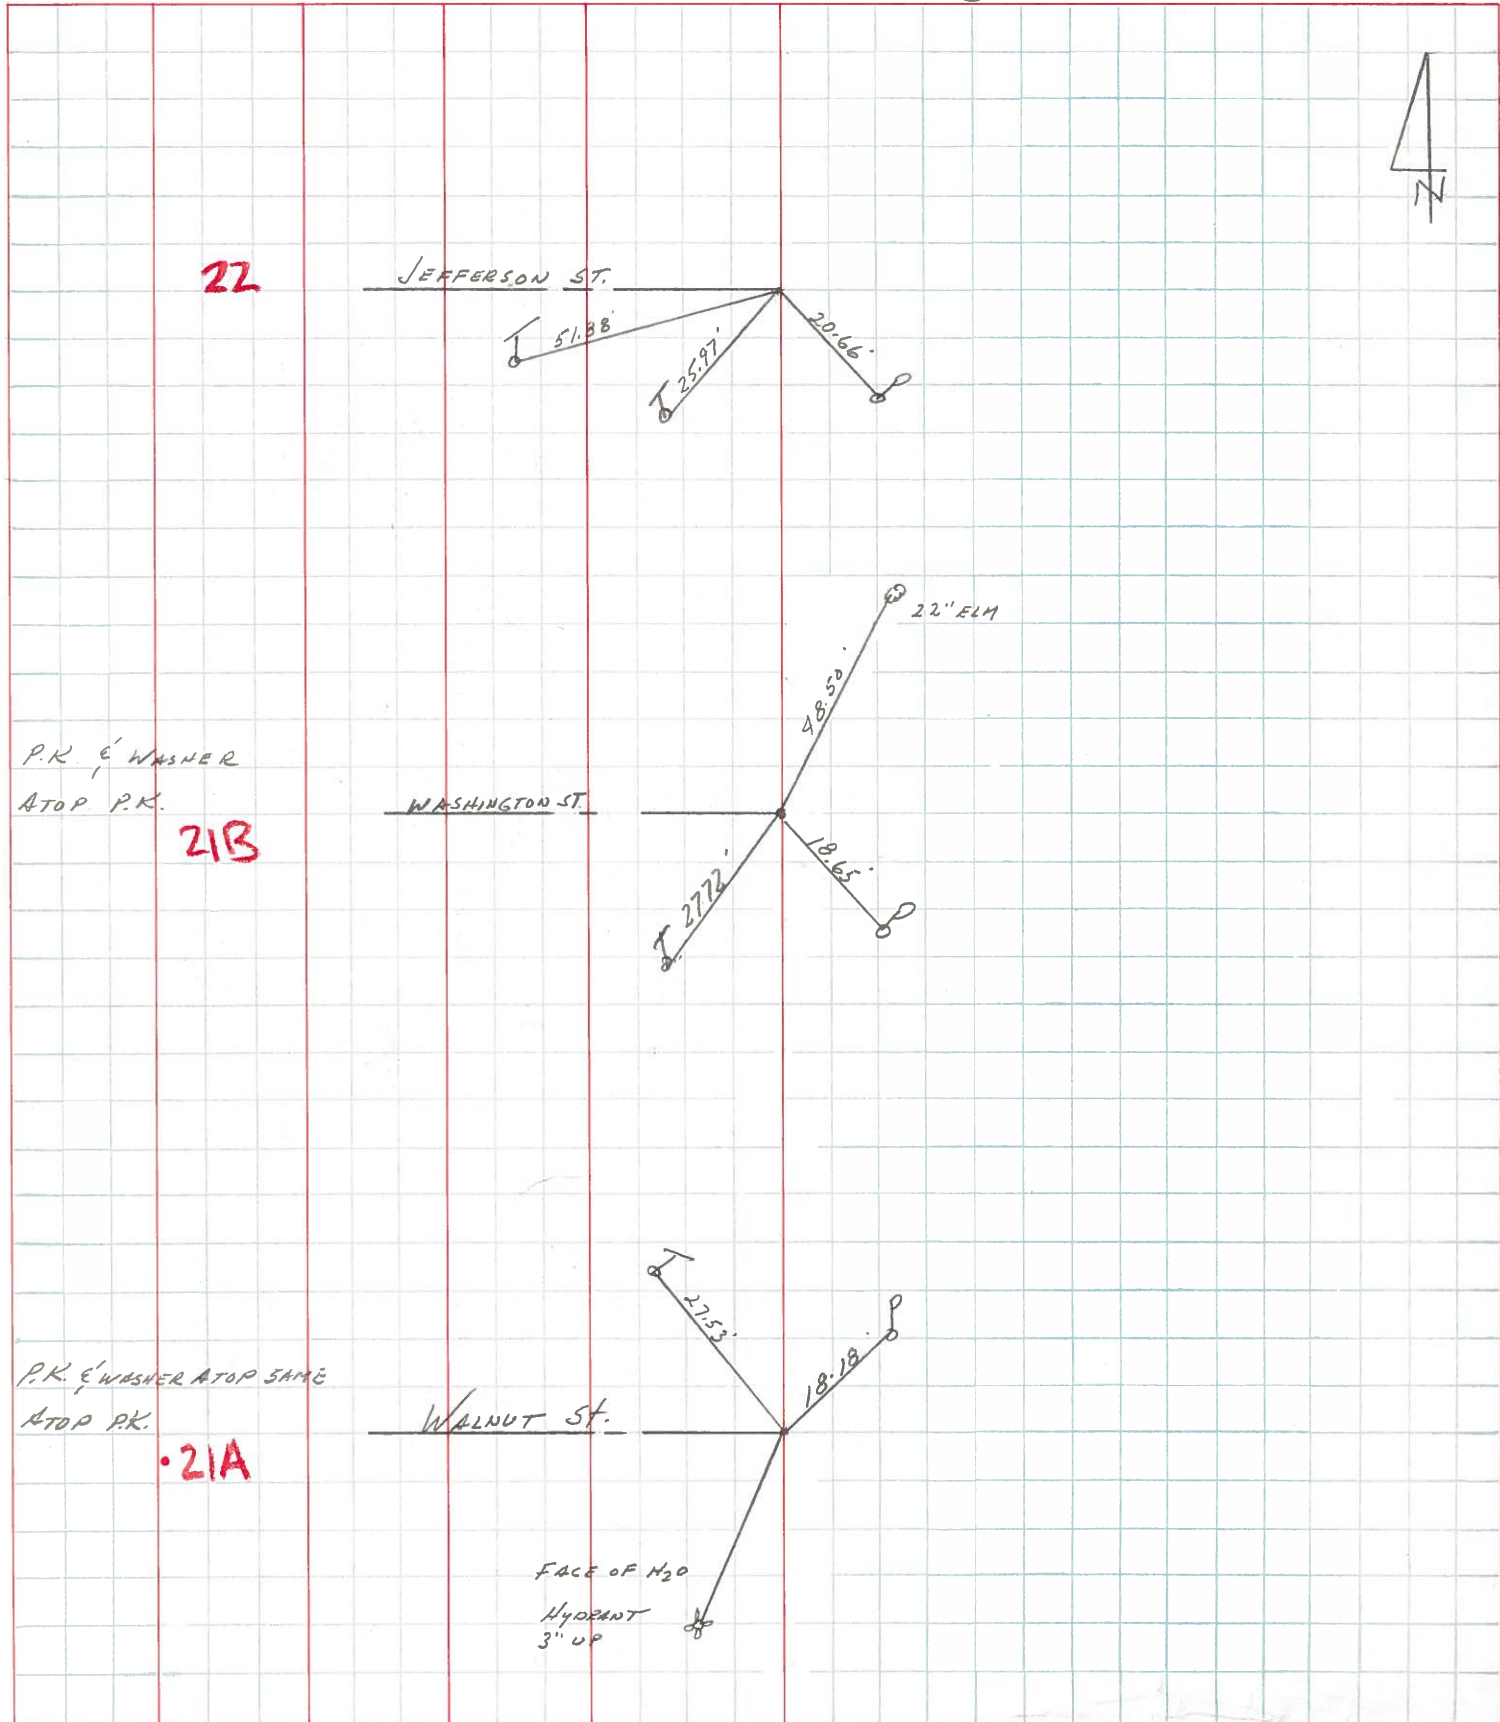

PERSONNEL TITLE PERSONNEL TITLE

COUNTY Ottawa DATE 4-25-78S. R. 19 WEATHER Fair - WindySEC. 554 TEMP. 45°DESCRIPTION Cork Harbor JOB NO. _____

LEFT

CENTER LINE

RIGHT

Reset PK & Washer ✓
6/6/77 70°Ed. PK Nail Walnut St.
West**21A**

A face of fire hyd. 5" above ground

4/20/77
SUNNY
63°4/19/77
SUNNY
79°

24" Maple

Reset PK & Washer ✓
6/6/77 70°

Ed. PK Nail

21Park St.
East

28" Maple