

O.D.O.T. DISTRICT 2 SURVEY OFFICE (USE ONLY)

PERSONNEL

REFERENCE NO. 21 B

SHEET OF

NOTES ASTON
H.C. NIESE
R.C. ASTON

DATE 10/25/23
WEATHER BREEZY
TEMP. 60°

ROUTE SR 19
COUNTY OTTAWA
TOWNSHIP SALEM
SECTION 5
T 6 N R 15 E

DWG BY BARRIERE PID 101239

TYPE MONUMENT MAG NAIL/WASHER

ON SURFACE - BELOW ON

OFFSET $\varnothing$ PAVEMENT ON LT : RT

 TO EDGE PAVEMENT

STATION: 206+90.52

HORIZ.DATUM: NAD 83 (2011)


GEOID: 18

GRID: NORTHING: 673850.812


EASTING: 1791854.670

LDP: NORTHING: 333347.607

EASTING: 151714.664

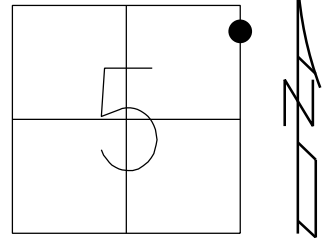

RECORD:
FD PK/WASHER
1/9/06, RGN
FD PK/WASHE
3/15/07, RGN
SET MAG/WASHER
11/6/07, SAH
FD PK/WASHER
REF21B
10/28/09, HUSS
FD PK/WASHER
REF21B
6/29/23, TDN
SET MAG/WASHER
REF21B
10/25/23, TDN

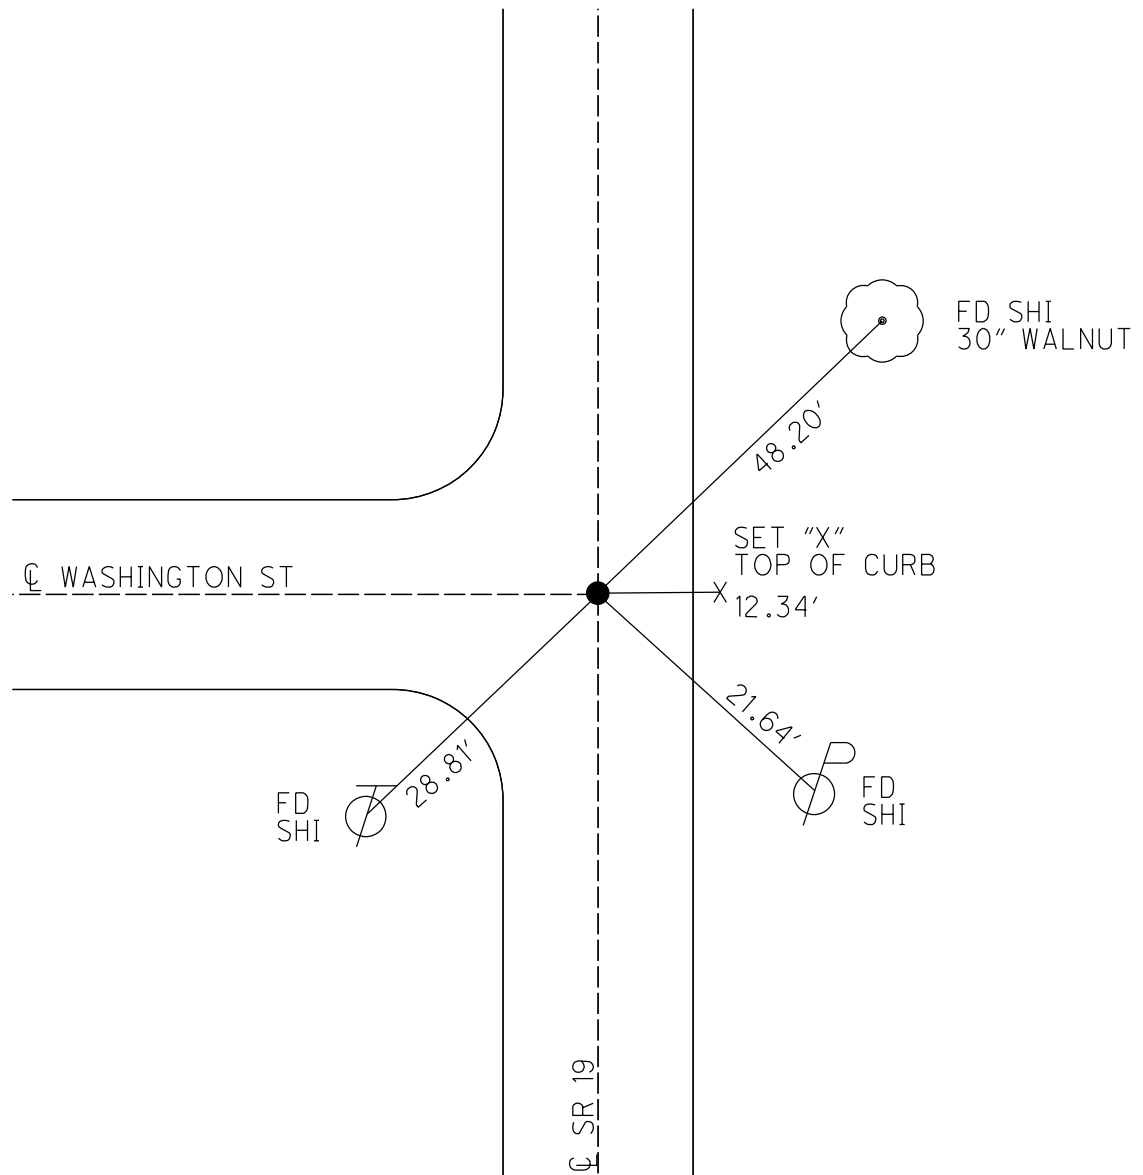

O.D.O.T. DISTRICT 2 SURVEY OFFICE (USE ONLY)

PERSONNEL

REFERENCE NO.

21 B

SHEET

6

OF 29

NOTES HUSS

DATE

10/28/09

ROUTE

SR 19

H.C. CANTERBURY

WEATHER

FAIR

COUNTY

OTTAWA

R.C. HUSS

TEMP.

55°

TOWNSHIP

SALEM

SECTION

32

T 6 N R 15 E

TYPE MONUMENT P.K./WASHER


ON SURFACE - ~~BELOW~~ ON

LEFT - ☉ PAV'T - RIGHT ON


12.6' TO RT EDGE PAVEMENT

S.L.M. 206+90.67

GRID: NORTHING: 673850.812 EASTING: 1791854.670

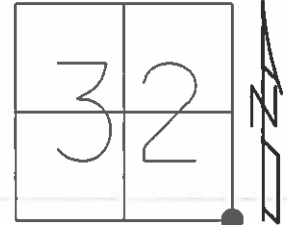

RECORD:
FD P.K./WASHER
1/9/06, RGN

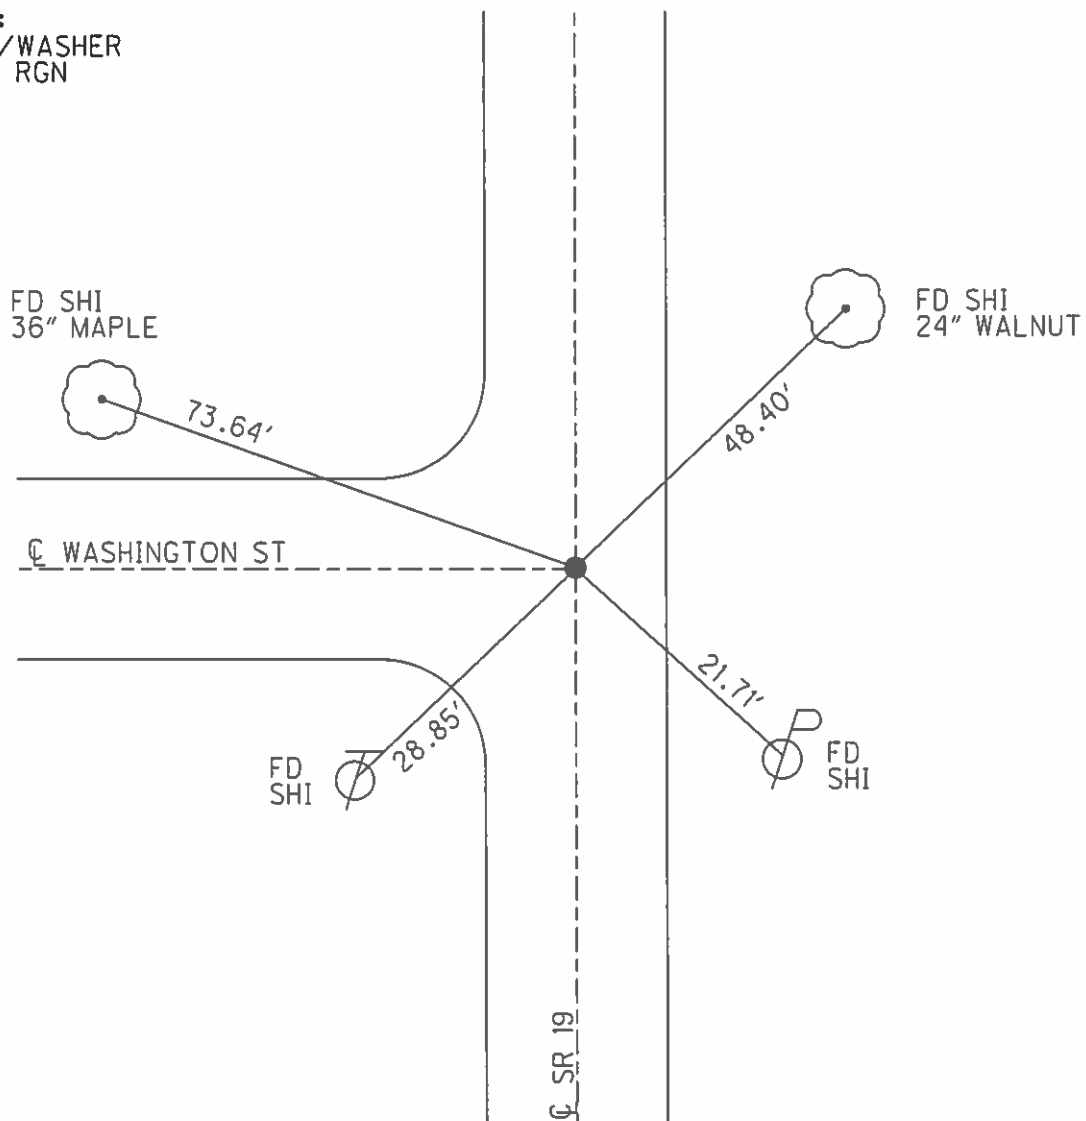


O.D.O.T. DISTRICT 2 SURVEY OFFICE (USE ONLY)


PERSONNEL _____ REFERENCE NO. 21 B SHEET 10 OF 33
NOTES HUSS DATE 10/28/09 ROUTE SR 19
H.C. CANTERBURY WEATHER FAIR COUNTY OTTAWA
R.C. HUSS TEMP. 55° TOWNSHIP SALEM
SECTION 32
T 6 N R 15 E

TYPE MONUMENT P.K./WASHER
ON SURFACE - ~~BELOW~~ ON
LEFT - CL PAV'T - RIGHT ON
12.6' TO RT EDGE PAVEMENT
S.L.M. 206+90.67

Grid: Northing: 673850.812 Easting: 1791854.670

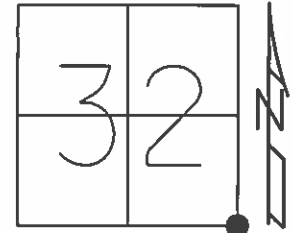

FD P.K./WASHER
1/9/06, RGN

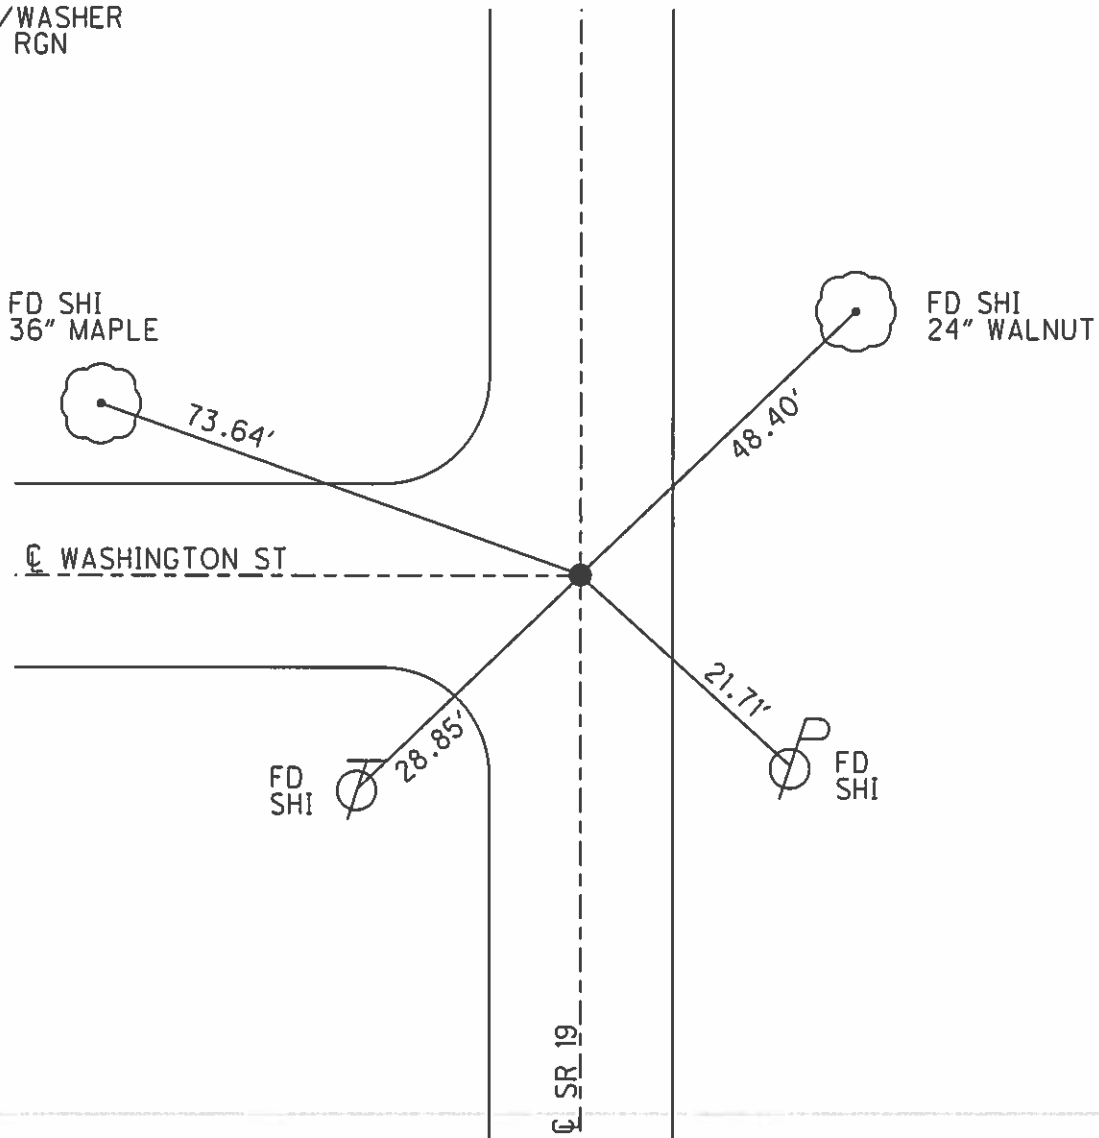

O.D.O.T. DISTRICT 2 SURVEY OFFICE

PERSONNEL

REFERENCE NO. _____

SHEET 22 OF 22

NOTES BARNHISEL

H.C. POUSOS ☒

R.C. HANES

DATE 8-5-96

WEATHER SUNNY

TEMP. +85°

ROUTE 19

COUNTY OTTAWA

TOWNSHIP SALEM

SECTION 32

T. 6 N R. 15 E


TYPE MONUMENT NEW SEWER LINE Removed

ON SURFACE - BELOW ☑ CONTROL

~~LEFT~~ - ☑ PAV'T. - ~~RIGHT~~ ON ☑ OF BOTH P.M.T's. 213

12.6' TO RT EDGE PAVEMENT


S.L.M. 206+87

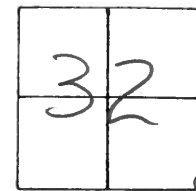

PT. REMOVED BY SEWER LINE 8-5-96

RESET P.K. & WASHER 3-19-97


FROM OLD TIES

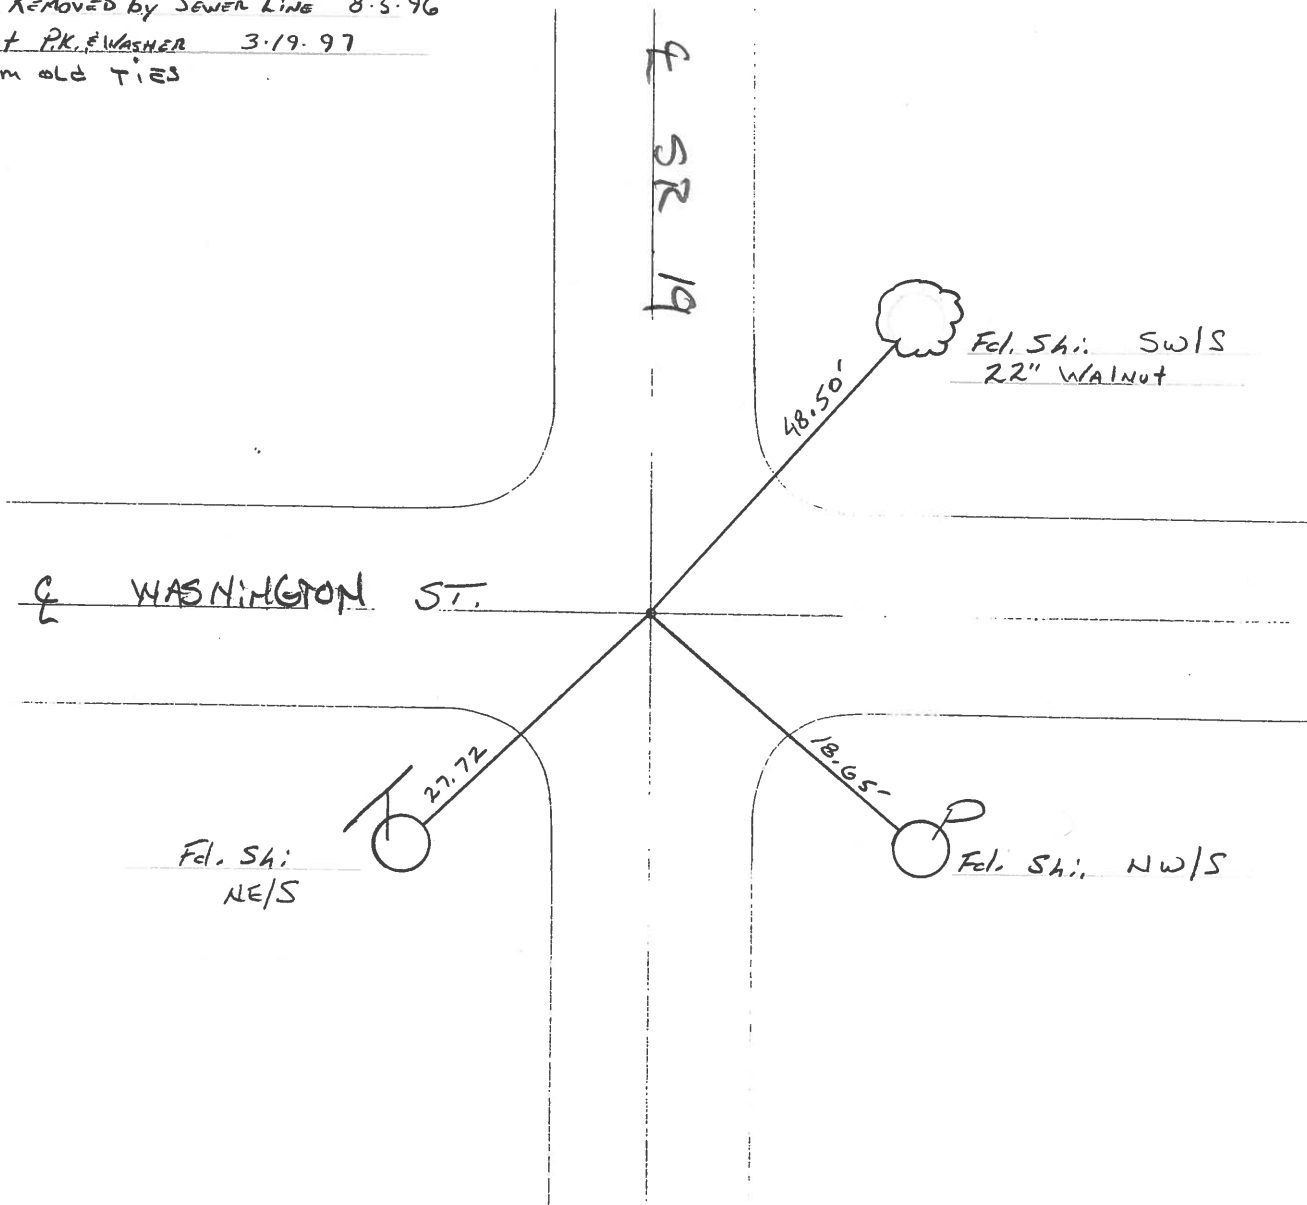

PERSONNEL	TITLE	PERSONNEL	TITLE	COUNTY	DATE	WEATHER	TEMP.
CRONIN				OTTAWA	4/24/89	SUNNY	63°
RIPPLE				S. R. #19			
GEYMAN				SEC. OAK HARBOR			

DESCRIPTION TIES - INTERSECTING STREETS - SET BY OTHERS

JOB NO.

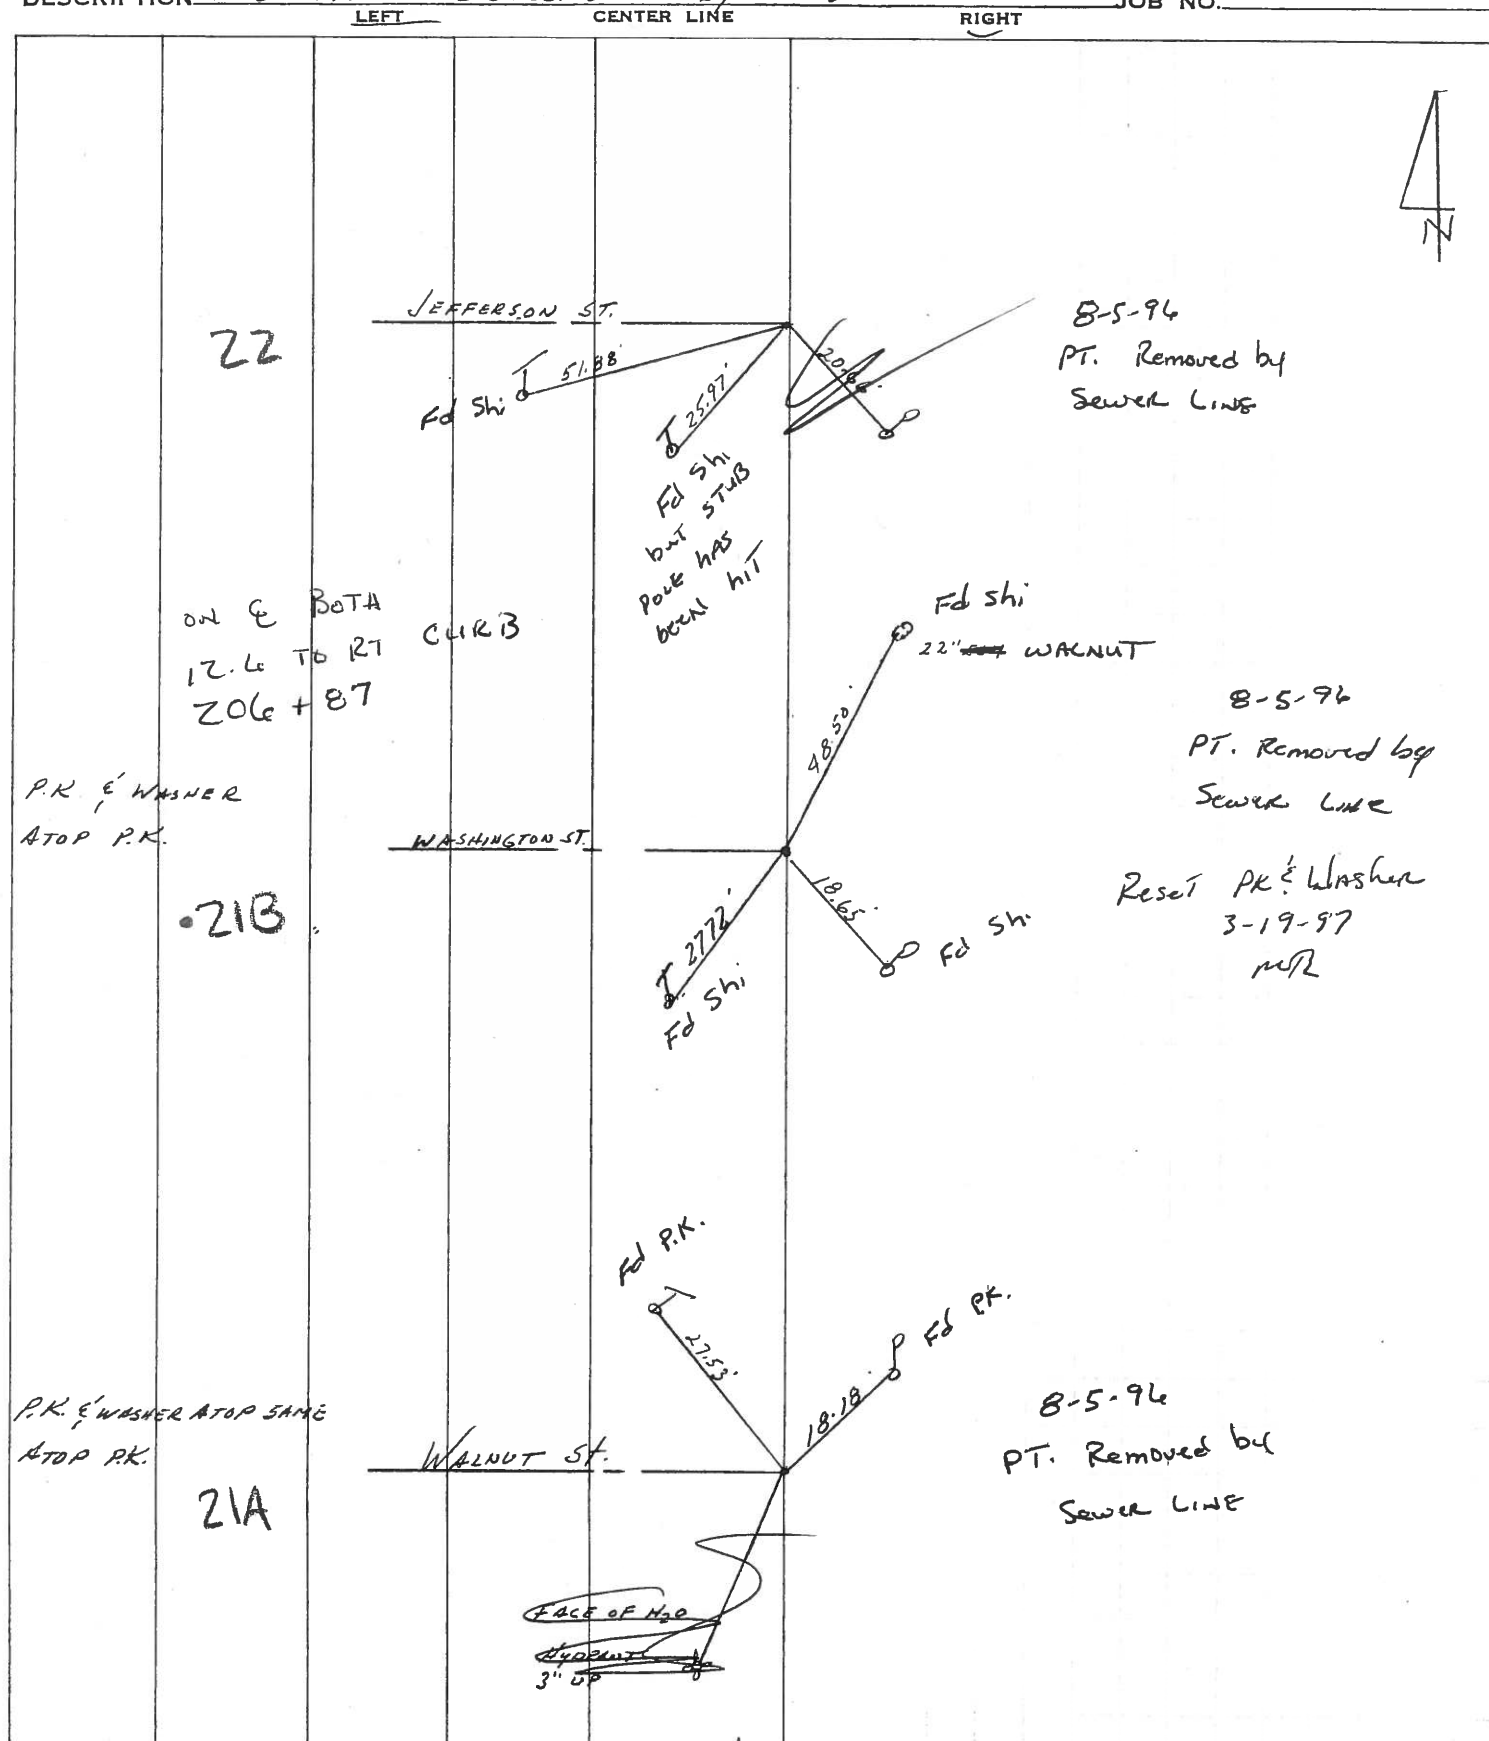

PERSONNEL

TITLE

PERSONNEL

TITLE

COUNTY OTTAWADRAWN 4/24/89DATE 4/20/89CRONINRIPPLEGEYMANS. R. #19WEATHER SUNNYSEC. oak harborTEMP. 63°DESCRIPTION TIES - INTERSECTING STREETS - SET BY OTHERS

JOB NO. _____

LEFT

CENTER LINE

RIGHT

