

O.D.O.T. DISTRICT 2 SURVEY OFFICE (USE ONLY)

PERSONNEL

REFERENCE NO. 22

SHEET OF

NOTES ASTON

DATE 10/25/23

ROUTE SR 19

H.C. NIESE

WEATHER BREEZY

COUNTY OTTAWA

R.C. ASTON

TEMP. 60°

TOWNSHIP SALEM

DWG BY BARRIERE

PID 101239

SECTION 5

T 6 N R 15 E

TYPE MONUMENT MAG NAIL/WASHER

ON SURFACE - BELOW ON

OFFSET $\varnothing$ PAVEMENT ON LT : RT

 TO EDGE PAVEMENT

STATION: 211+02.59

HORZ.DATUM: NAD 83 (2011)


GEOID: 18

GRID: NORTHING: 674262.775


EASTING: 1791858.851

LDP: NORTHING: 333759.704

EASTING: 151716.089

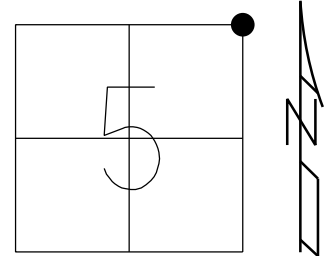

RECORD:
FD MAG/WASHER
3/20/07, RGN
SET MAG/WASHER
11/6/07, SAH
FD MAG/WASHER
REF23
10/28/09, HUSS
FD MAG/WASHER
REF23
6/29/23, TDN
SET MAG/WASHER
REF23
10/25/23, TDN

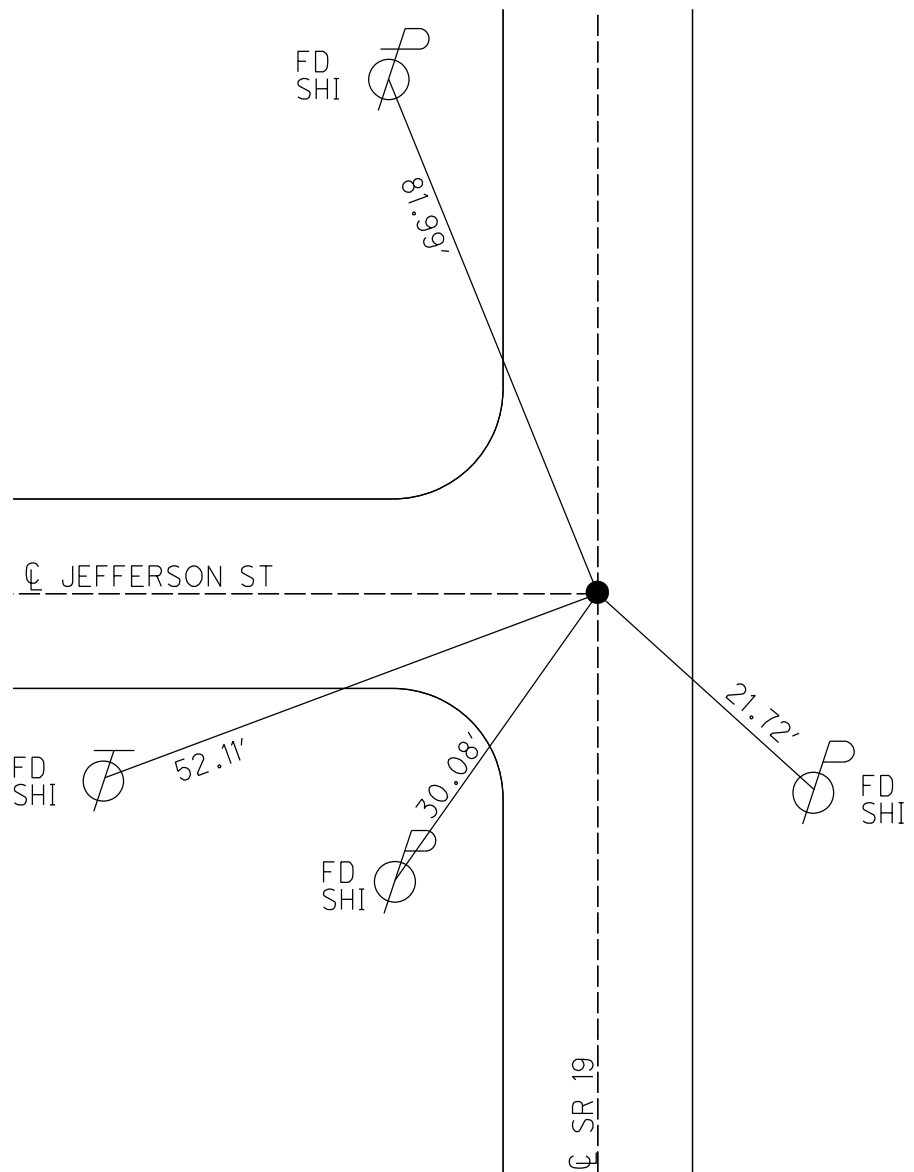

O.D.O.T. DISTRICT 2 SURVEY OFFICE (USE ONLY)

PERSONNEL

REFERENCE NO. 22

SHEET 7 OF 29

NOTES HUSS

DATE 10/28/09

ROUTE SR 19

H.C. CANTERBURY

WEATHER FAIR

COUNTY OTTAWA

R.C. HUSS

TEMP. 55°

TOWNSHIP SALEM

SECTION 32

T 6 N R 15 E

TYPE MONUMENT MAG/WASHER



ON SURFACE - ~~BELOW~~ ON

LEFT - CL PAV'T - RIGHT ON

12.7' TO RT EDGE PAVEMENT

S.L.M. 211+02.81

GRID: NORTHING: 674262.775 EASTING: 1791858.851

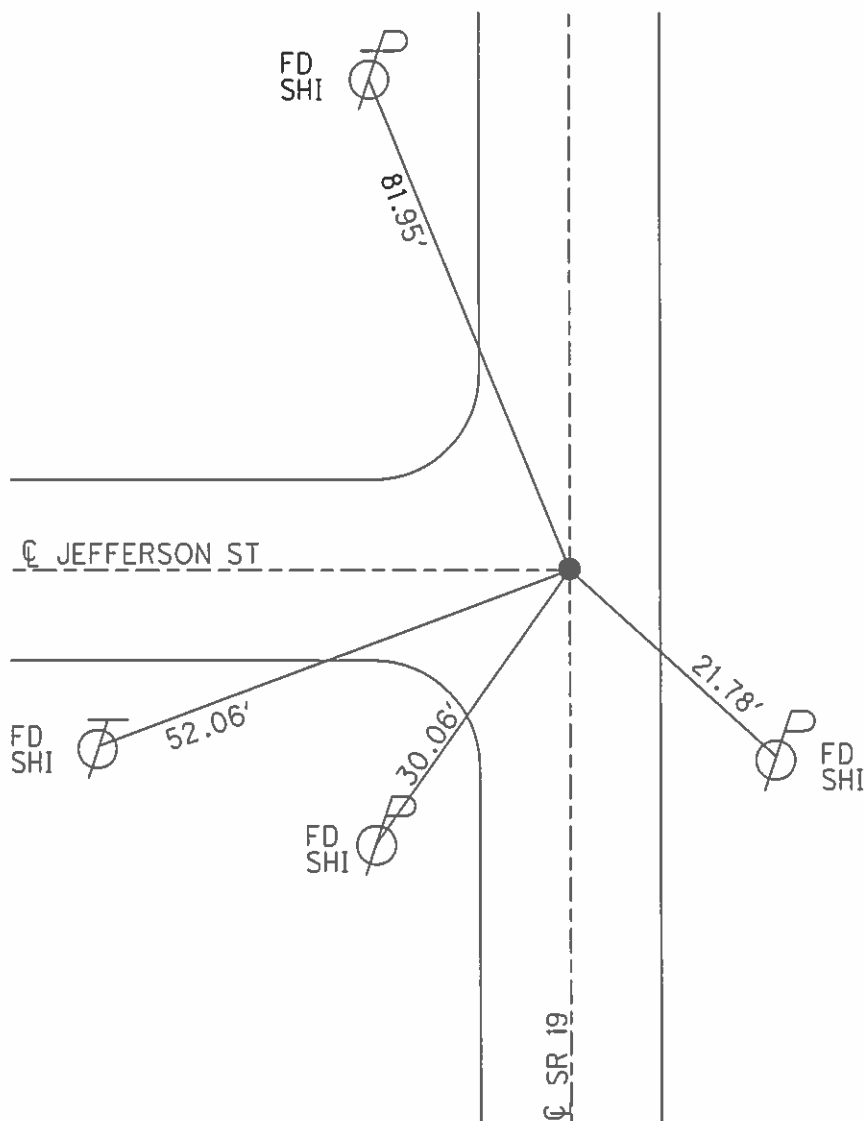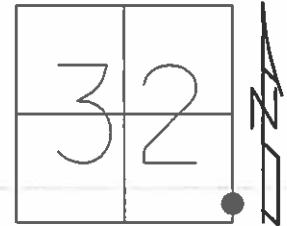

O.D.O.T. DISTRICT 2 SURVEY OFFICE (USE ONLY)

PERSONNEL

REFERENCE NO.

22

SHEET

11

OF 33

NOTES HUSS

DATE

10/28/09

ROUTE

SR 19

H.C.

CANTERBURY

WEATHER

FAIR

COUNTY

OTTAWA

R.C.

HUSS

TEMP.

55°

TOWNSHIP

SALEM

SECTION

32

T 6 N R 15 E

TYPE MONUMENT MAG/WASHER



ON SURFACE - ~~BELOW~~ ON

LEFT - ℄ PAV'T - RIGHT ON

12.7' TO RT EDGE PAVEMENT

S.L.M. 211+02.81

Grid: Northing: 674262.775 Easting: 1791858.851

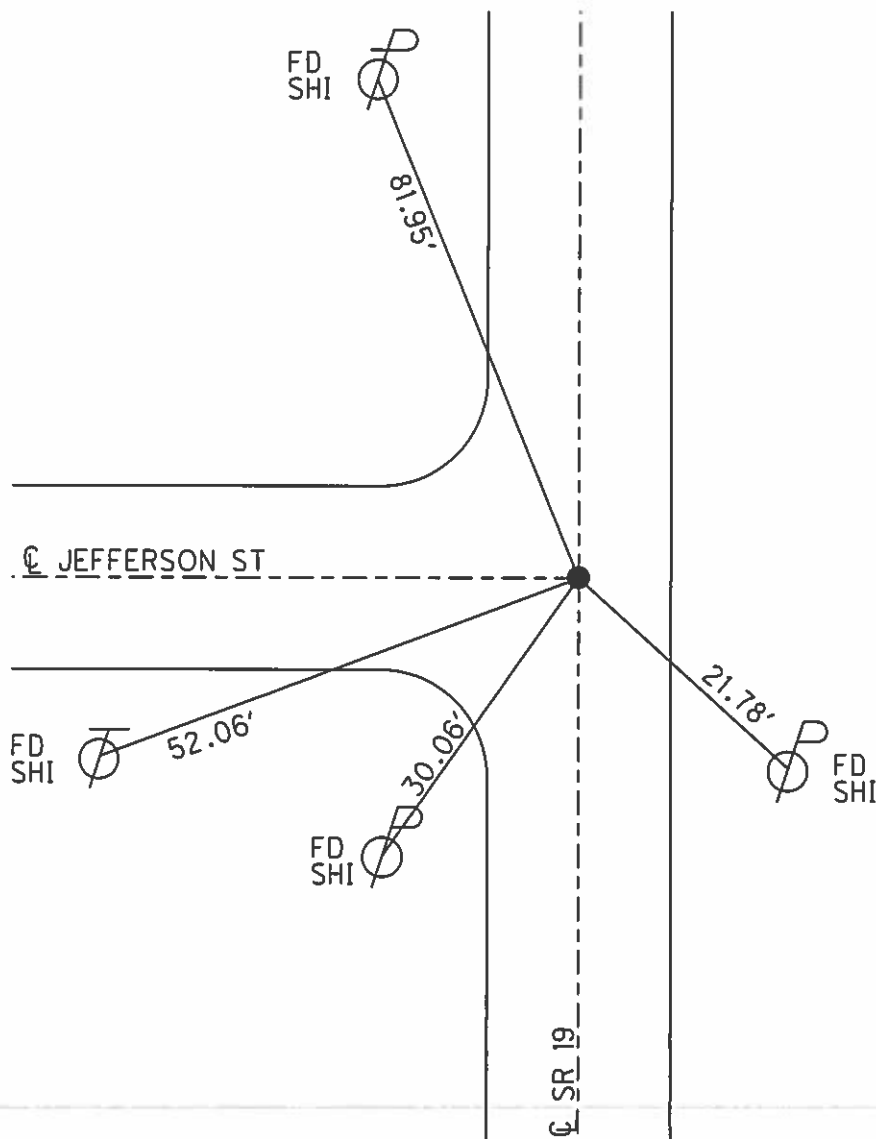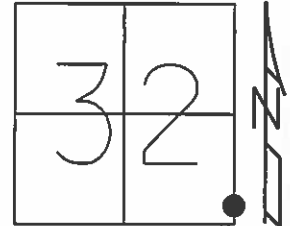

PERSONNEL

TITLE

PERSONNEL

TITLE


DRAWN 4/24/89DATE 4/20/89COUNTY OTTAWAS. R. #19WEATHER SUNNYSEC. OAK HARBORTEMP. 63°DESCRIPTION TIES - INTERSECTING STREETS - SET BY OTHERS

LEFT

CENTER LINE

RIGHT

JOB NO. _____

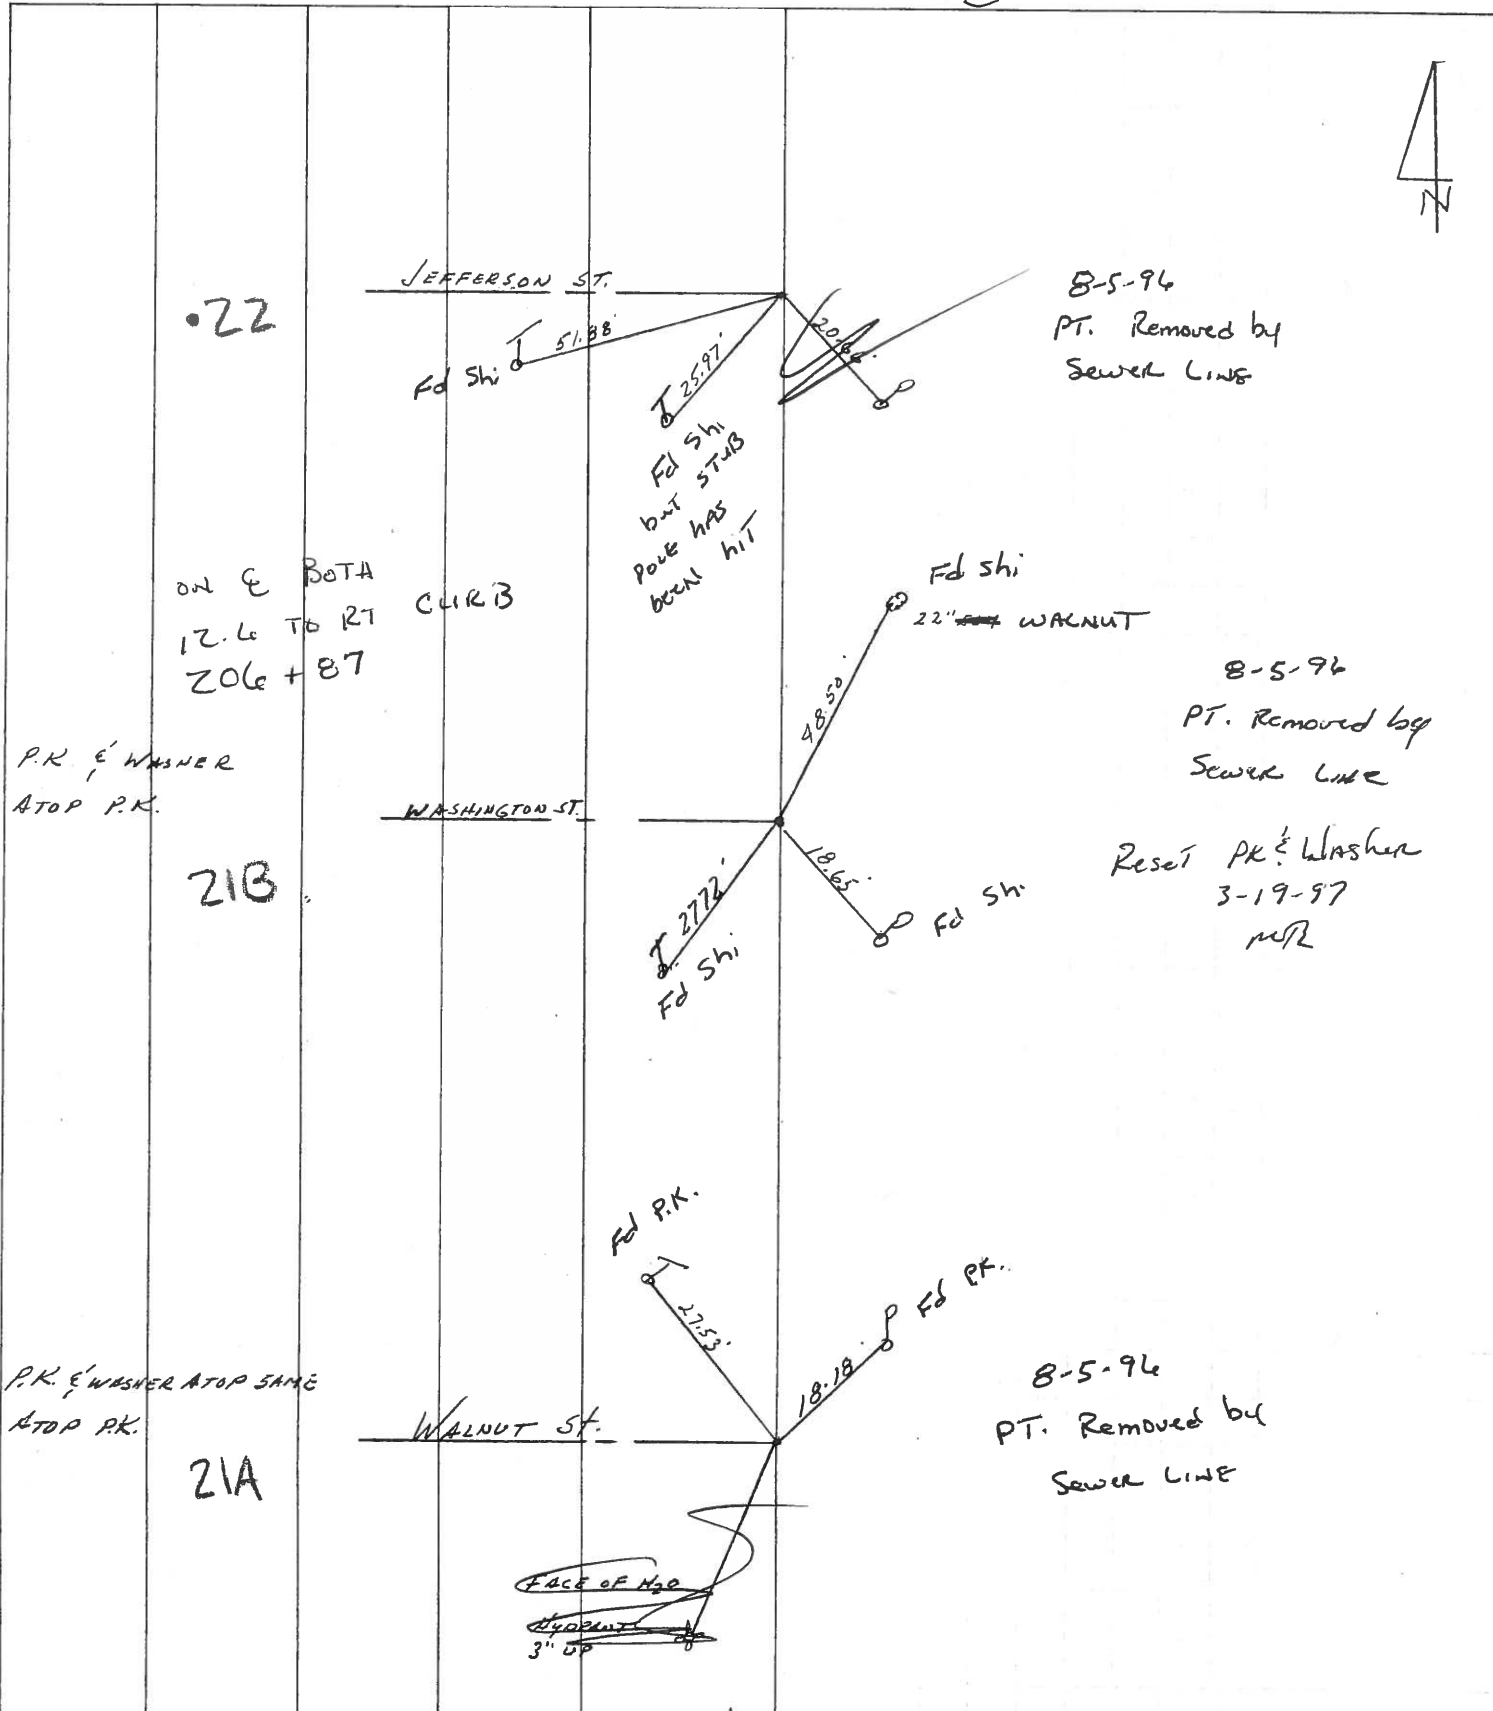

PERSONNEL

TITLE

PERSONNEL

TITLE


DRAWN 4/24/89DATE 4/20/89COUNTY OTTAWAWEATHER SUNNYS. R. #19SEC. OAK HARBORTEMP. 63°DESCRIPTION TIES - INTERSECTING STREETS - SET BY OTHERS

JOB NO. _____

LEFT

CENTER LINE

RIGHT

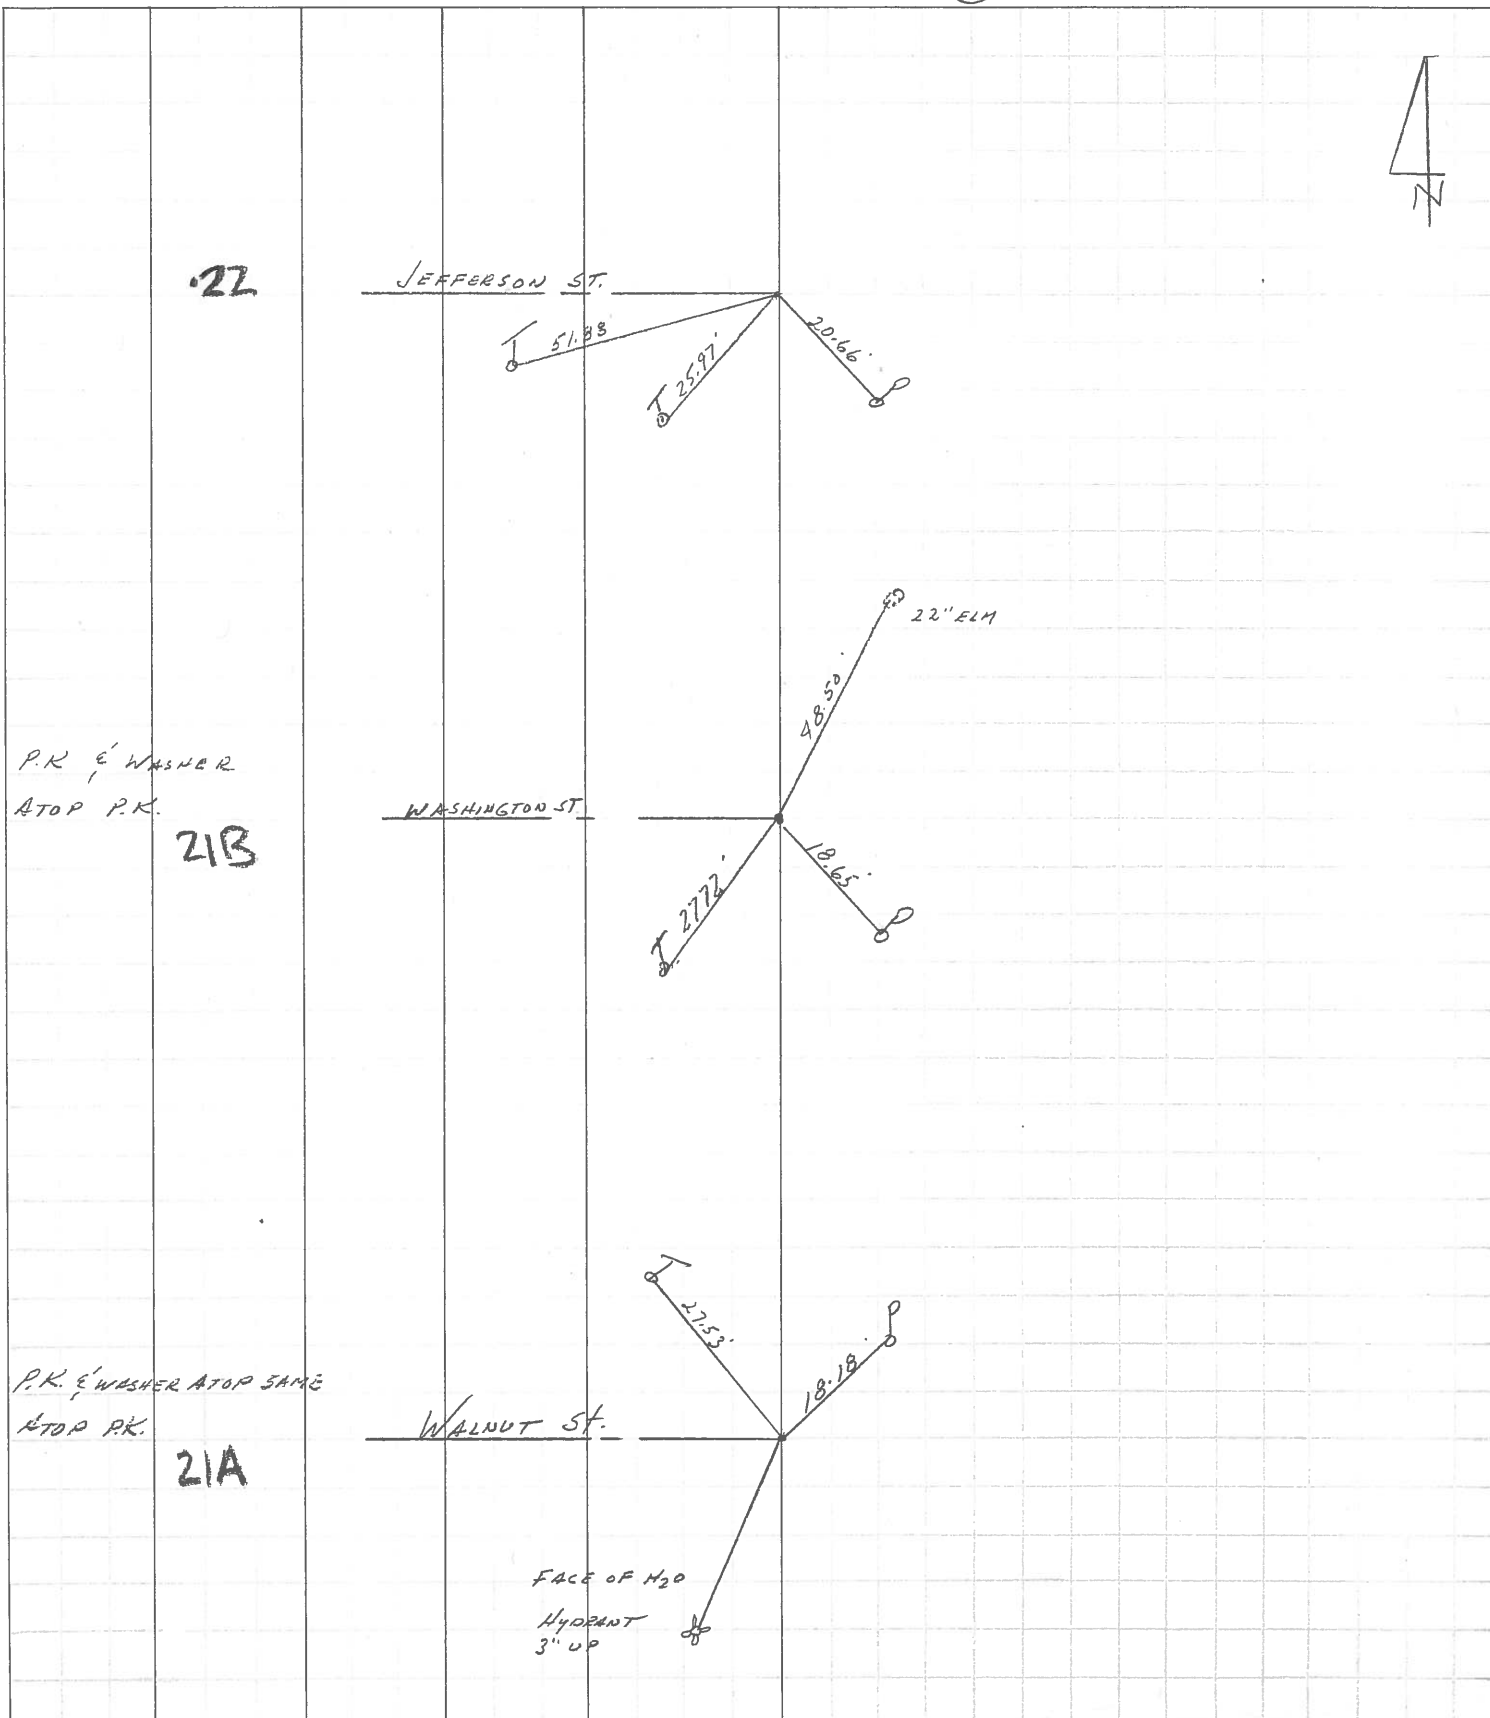

PERSONNEL TITLE PERSONNEL TITLE


COUNTY OttawaDATE 4-25-78S. R. 19WEATHER Fair-WindySEC. 32 & 3TEMP. 45°DESCRIPTION Oak Harbor

LEFT

CENTER LINE

RIGHT

JOB NO.

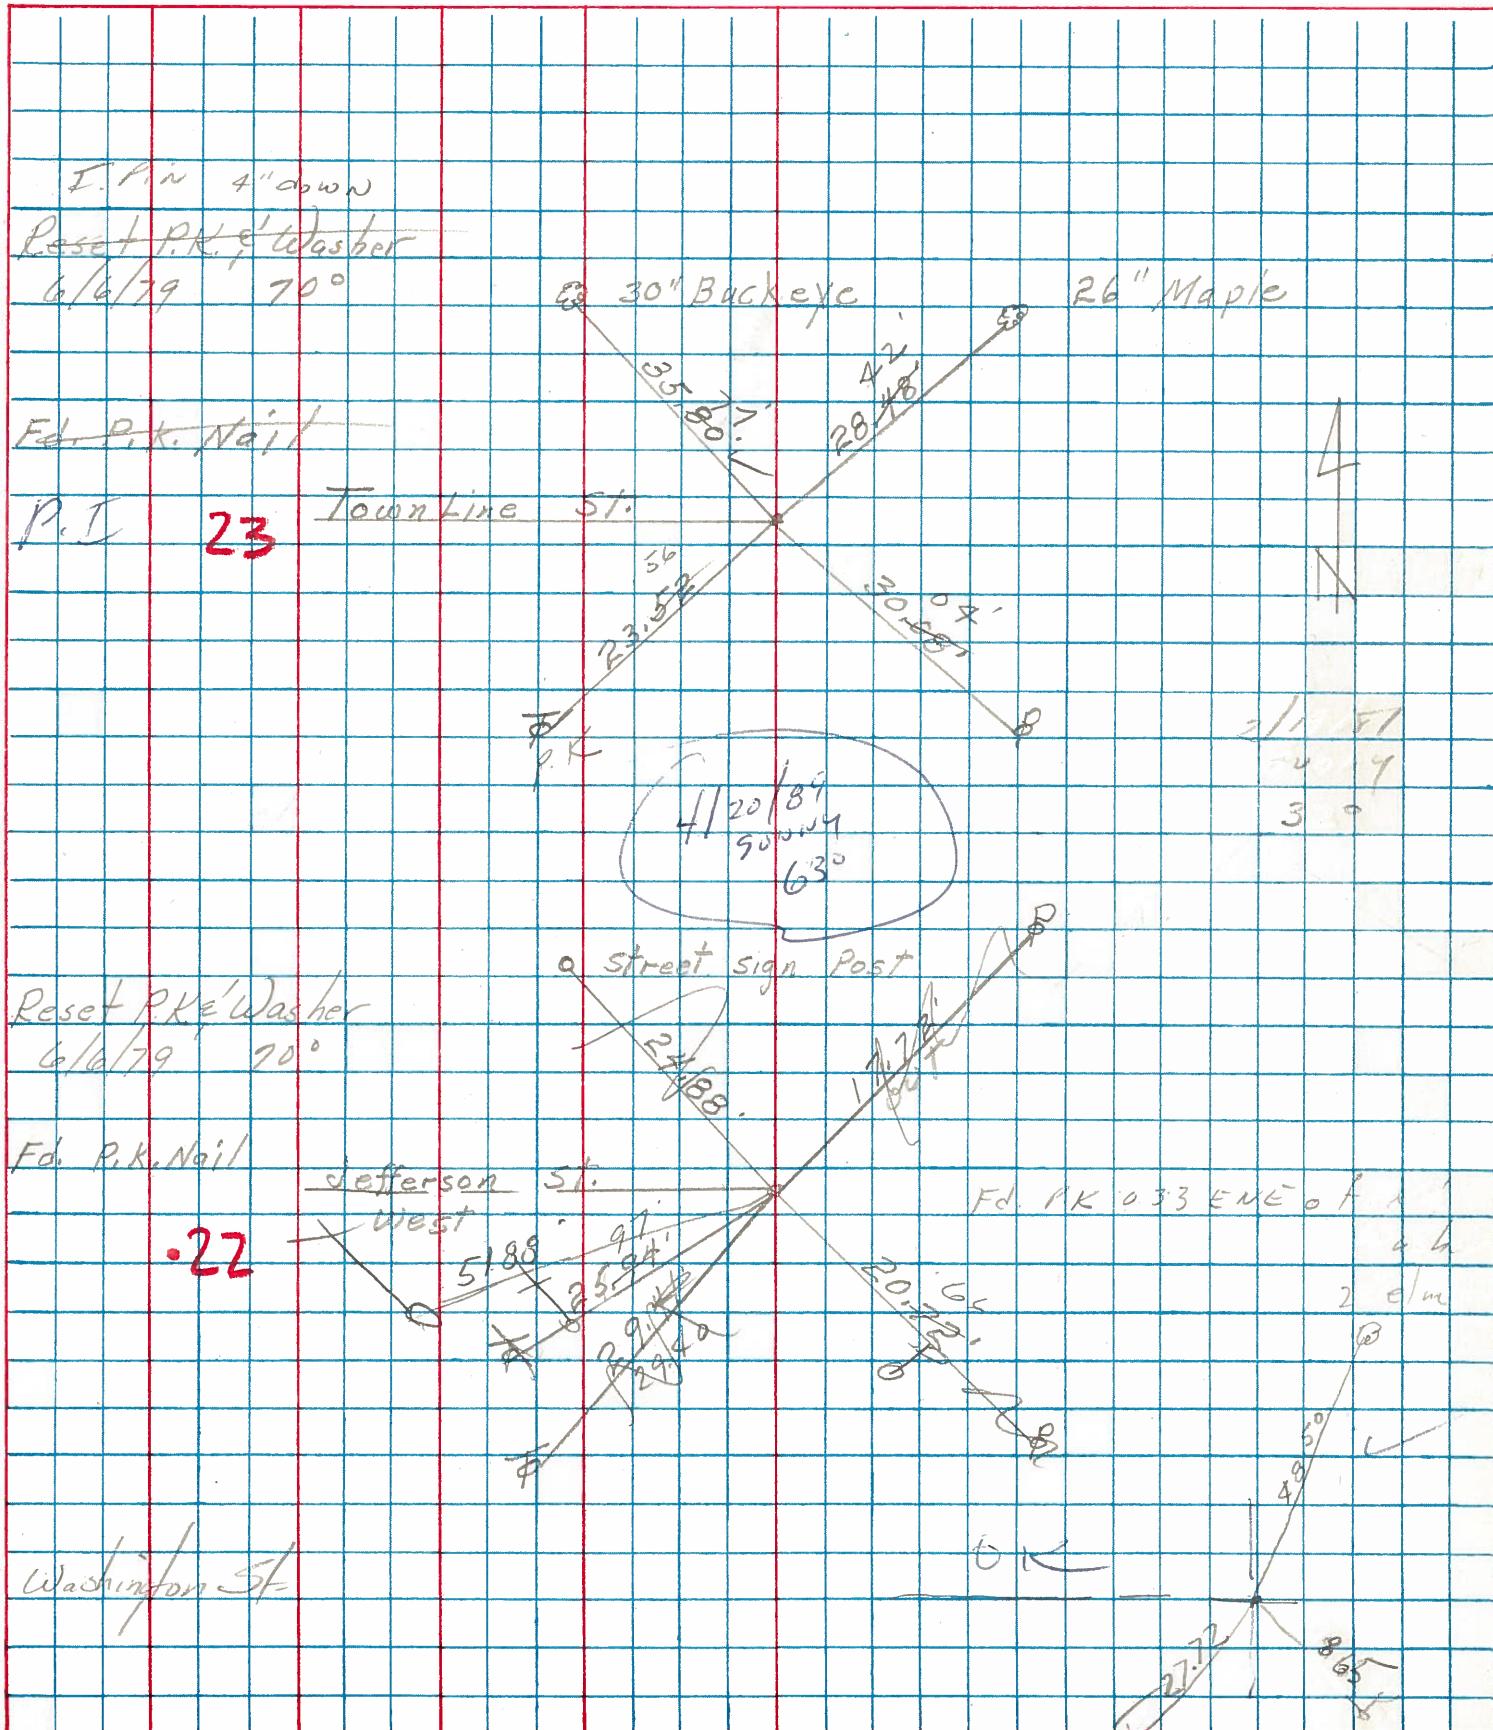

PERSONNEL TITLE PERSONNEL TITLE

COUNTY Ottawa DATE 5-4-71S. R. 19 WEATHERSEC. 32E 33 TEMP.DESCRIPTION Oak Harbor JOB NO.

LEFT

CENTER LINE

RIGHT

Fd. P.K. Nail

24

Houghton St.

55.74'

2 story
Res.

65.33'

34.55'

24" Maple

30" Buckeye

36.15'

28.79'

26" Maple

Fd. P.K. Nail

23

Townline St.

23.52'

23.89'

Fd. P.K. Nail

22

Jefferson St.
West

21.31'

17.72'

25.91'

20.52'

PERSONNEL TITLE PERSONNEL TITLE

SHEET NO. 7

COUNTY Ottawa DATE 5-13-68
 S. R. 19 WEATHER Fair
 SEC. Oak Harbor TEMP. 65°
 PERSONNEL TITLE PERSONNEL TITLE
Schneider _____
Mosser _____
Barbour _____
Redding _____

DESCRIPTION Ties for Control Points JOB NO. _____
 LEFT CENTER LINE RIGHT

