

O.D.O.T. DISTRICT 2 SURVEY OFFICE (USE ONLY)

PERSONNEL

REFERENCE NO. 23

SHEET OF

NOTES ASTON

DATE 10/25/23

ROUTE SR 19

H.C. NIESE

WEATHER BREEZY

COUNTY OTTAWA

R.C. ASTON

TEMP. 60°

TOWNSHIP SALEM

SECTION 32

DWG BY BARRIERE

PID 101239

T 6 N R 15 E

TYPE MONUMENT MAG NAIL/WASHER

ON SURFACE - BELOW ON

OFFSET $\varnothing$ PAVEMENT ON LT : RT

 TO EDGE PAVEMENT

STATION: 213+93.21

HORIZ.DATUM: NAD 83 (2011)

GEOID: 18

GRID: NORTHING: 674553.514

EASTING: 1791861.906

LDP: NORTHING: 334050.332


EASTING: 151717.193

32	33
05	04



RECORD: P.I.
STA 212+13.35
 $\Delta = 0^\circ 55' \text{ LT}$
(1950 PLANS)

FD MAG/WASHER
3/20/07, RGN
SET MAG/WASHER
11/6/07, SAH
FD PK/WASHER
REF23
10/28/09, HUSS
FD PK SHANK
REF23
6/29/23, TDN
SET MAG/WASHER
REF23
10/25/23, TDN


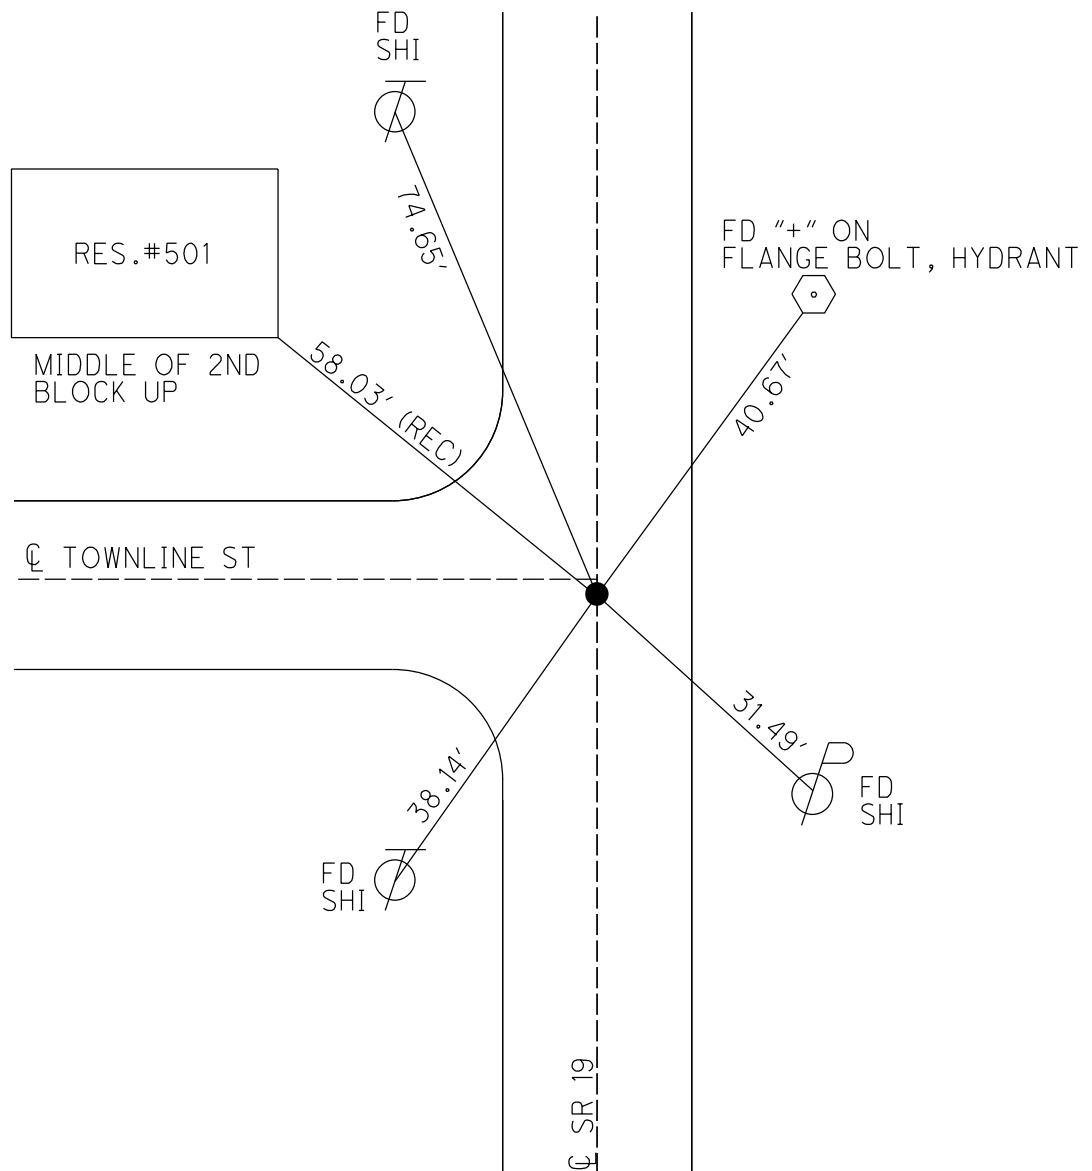


O.D.O.T. DISTRICT 2 SURVEY OFFICE (USE ONLY)

PERSONNEL _____ REFERENCE NO. 23 SHEET 8 OF 29
NOTES HUSS DATE 10/28/09 ROUTE SR 19
H.C. CANTERBURY WEATHER FAIR COUNTY OTTAWA
R.C. HUSS TEMP. 55° TOWNSHIP SALEM
SECTION 32
T 6 N R 15 E

TYPE MONUMENT P.K./WASHER
ON SURFACE - ~~BELOW~~ ON
LEFT - CL PAV'T - RIGHT ON, 2' S. OF TOWNLINE
11.9' TO RT EDGE PAVEMENT
S.L.M. 213+93.14

GRID: NORTHING: 674553.514 EASTING: 1791861.906

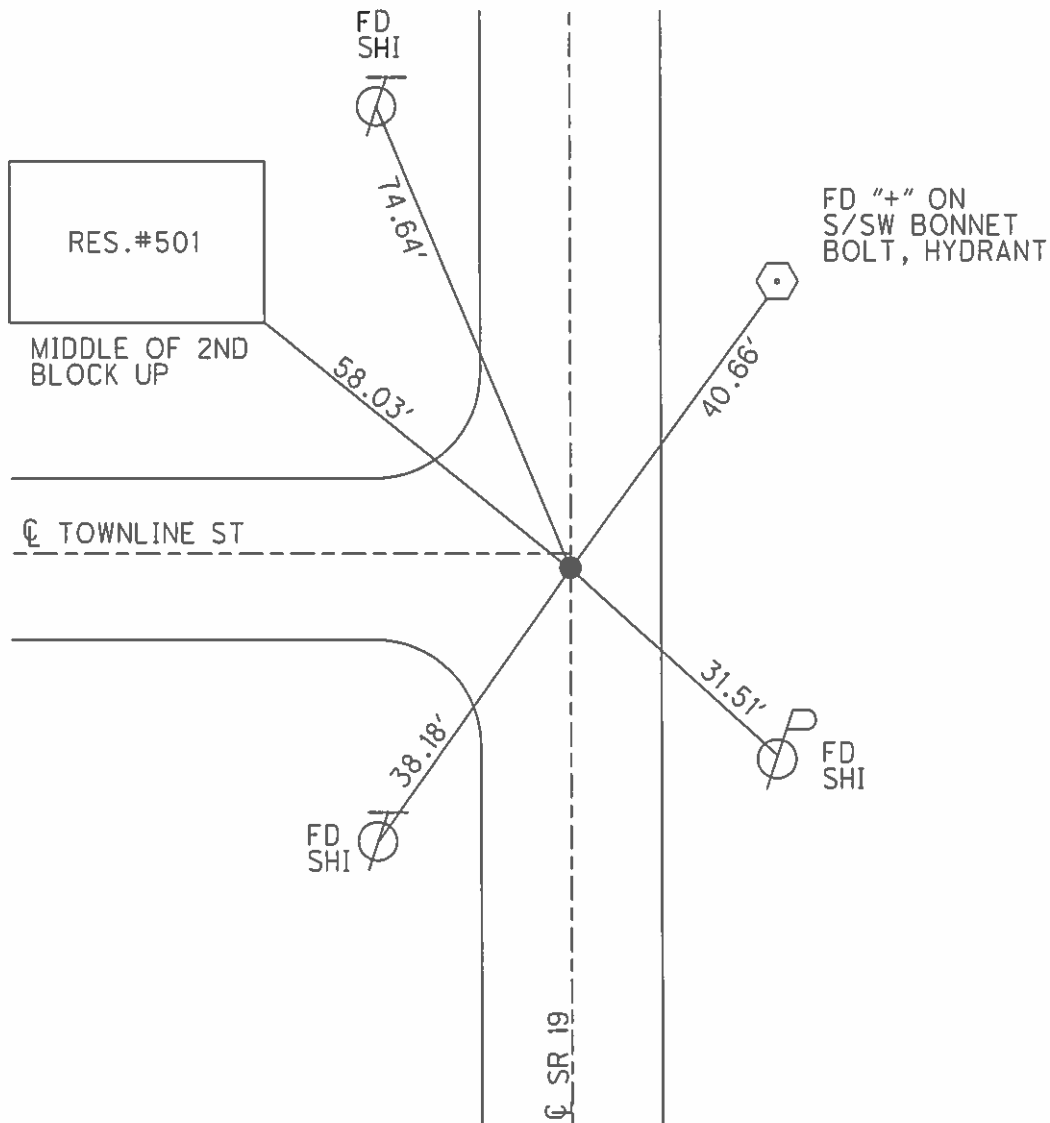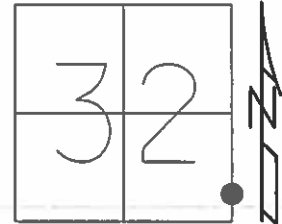



O.D.O.T. DISTRICT 2 SURVEY OFFICE (USE ONLY)

PERSONNEL _____ REFERENCE NO. 23 SHEET 12 OF 33

NOTES HUSS DATE 10/28/09 ROUTE SR 19
H.C. CANTERBURY WEATHER FAIR COUNTY OTTAWA
R.C. HUSS TEMP. 55° TOWNSHIP SALEM
SECTION 32
T 6 N R 15 E

TYPE MONUMENT P.K./WASHER
ON SURFACE - ~~BELOW~~ ON
LEFT - CL PAV'T - RIGHT ON, 2' S. OF TOWNLIN
11.9' TO RT EDGE PAVEMENT
S.L.M. 213+93.14

Grid: Northing: 674553.514 Easting: 1791861.906

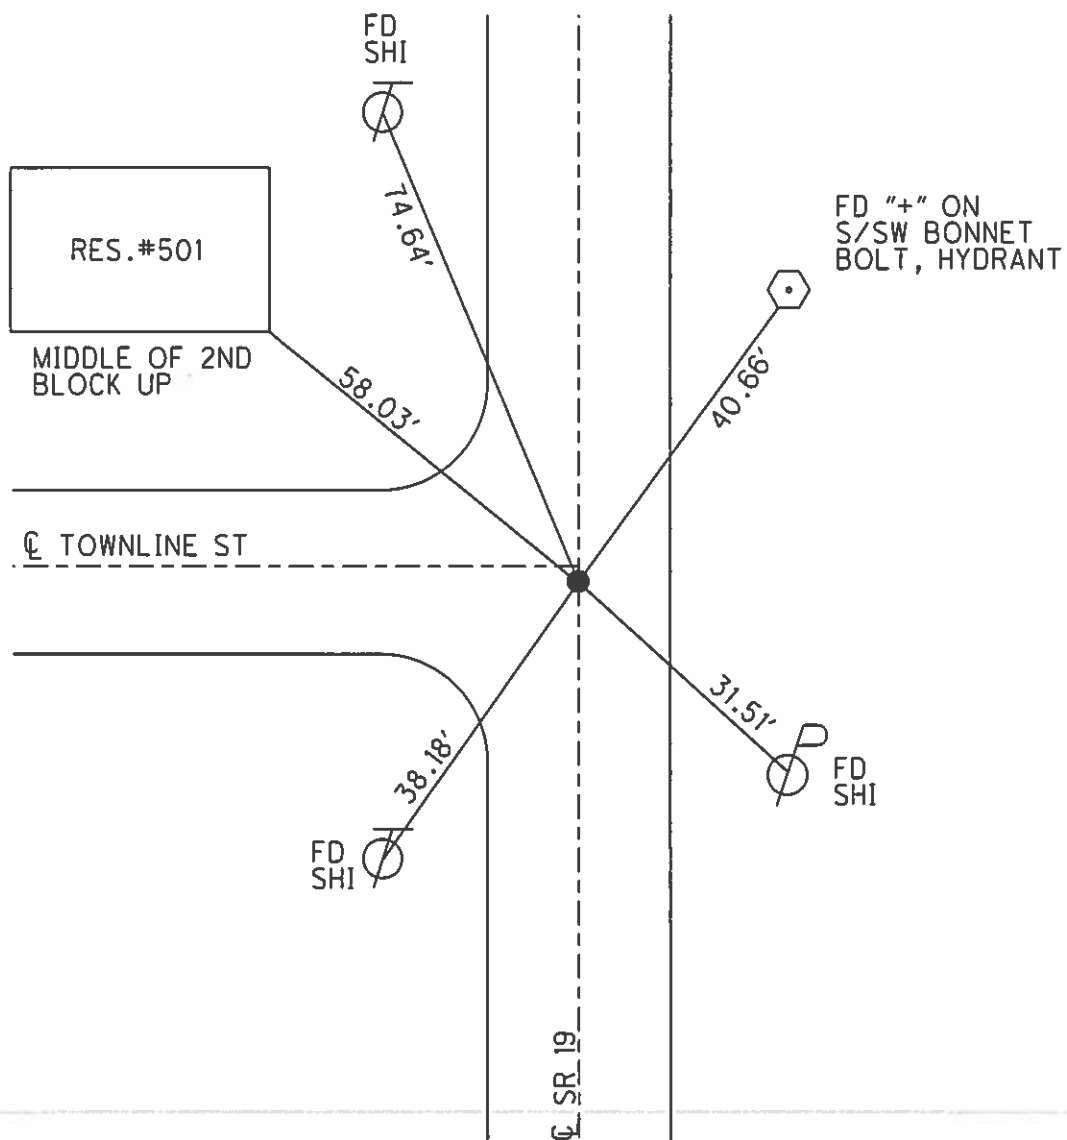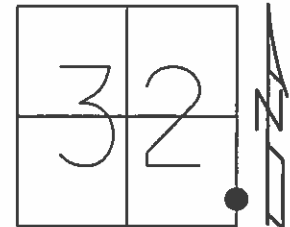

O.D.O.T. DISTRICT 2 SURVEY OFFICE

PERSONNEL

NOTES CROWIN

H.C. RIPPLE

R.G. GEYMAN

REFERENCE NO. 20

DRAWN 4/24/89

DATE 4/20/89

WEATHER SUNNY

TEMP. 63°

SHEET 20 OF

ROUTE #19

COUNTY OTTAWA

TOWNSHIP SALEM & CARROLL

SECTION 4, 5, 32 & 33

T 6 N R 15 E

TYPE MONUMENT P.K. & WASHER

ON SURFACE - BELOW

LEFT- & PAV'T. - RIGHT

TO EDGE PAVEMENT

S.L.M. 212+13.35 (1951 Plans)

23

T 7 N - R 15 E
T 6 N - R 15 E

32	33
5	4



8-5-96

PT Removed by

Sewer Line

DID NOT

NO TIES

Reset Point
Remained

30" BUCKEYE

NO
SHINER

P.I.

$\Delta = 00^{\circ}55'$ LT. PLAN


I P.N 6" BELOW

SURFACE

$\Delta = 01^{\circ}11'$ LT. TO C/L MEAS.

4/7/83

TOWNLINE ST.

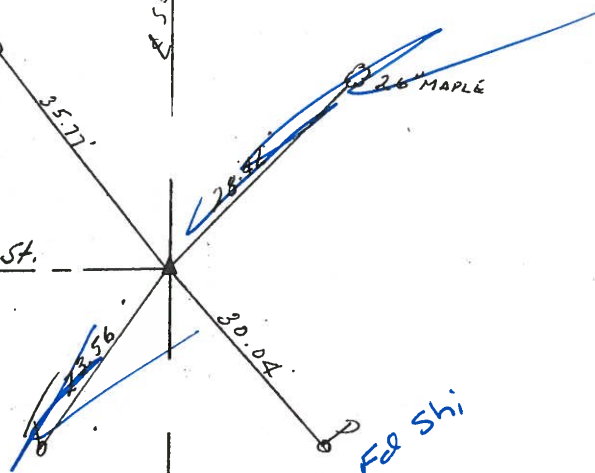

O.D.O.T. DISTRICT 2 SURVEY OFFICE

PERSONNEL

NOTES

H.C.

R.C.

REFERENCE NO. 20

DRAWN 4/24/89

DATE 4/20/89

WEATHER SUNNY

TEMP. 63°

SHEET ¹⁹~~20~~ OF 22

ROUTE #19

COUNTY OTTAWA

TOWNSHIP SALEM & CARROLL

SECTION 4, 5, 32 & 33

T 6 N R 15 E

TYPE MONUMENT P.K. & WASHER

ON SURFACE - BELOW

LEFT - CL PAV'T. - RIGHT

TO EDGE PAVEMENT

S.L.M. 212+13.35 (1951 PLANS)

23

T 7 N - R 15 E
T 6 N - R 15 E

32	33
5	4



NOTE:

8-5-90

SEWER LINE CONSTRUCTION
DISTURBED CONTROL POINT.

NO TIES REMAINED.

DID NOT RESET.
SLO



P.I.

$\Delta = 00^\circ 55'$ LT. PLAN

I P.N 6" BELOW

SURFACE

$\Delta = 01^\circ 11'$ LT. TO C/L MEAS.

4/7/83

30" BUCKEYE

35.77'

SURVEY

26" MAPLE

28.42'

TOWNLINE ST.

23.56'

30.04'

PERSONNEL TITLE PERSONNEL TITLE

COUNTY Ottawa DATE 2

S. R. 19 WEATHER 1.10


SEC. 32 TEMP.

DESCRIPTION Oak Harbor JOB NO.

LEFT

CENTER LINE

RIGHT

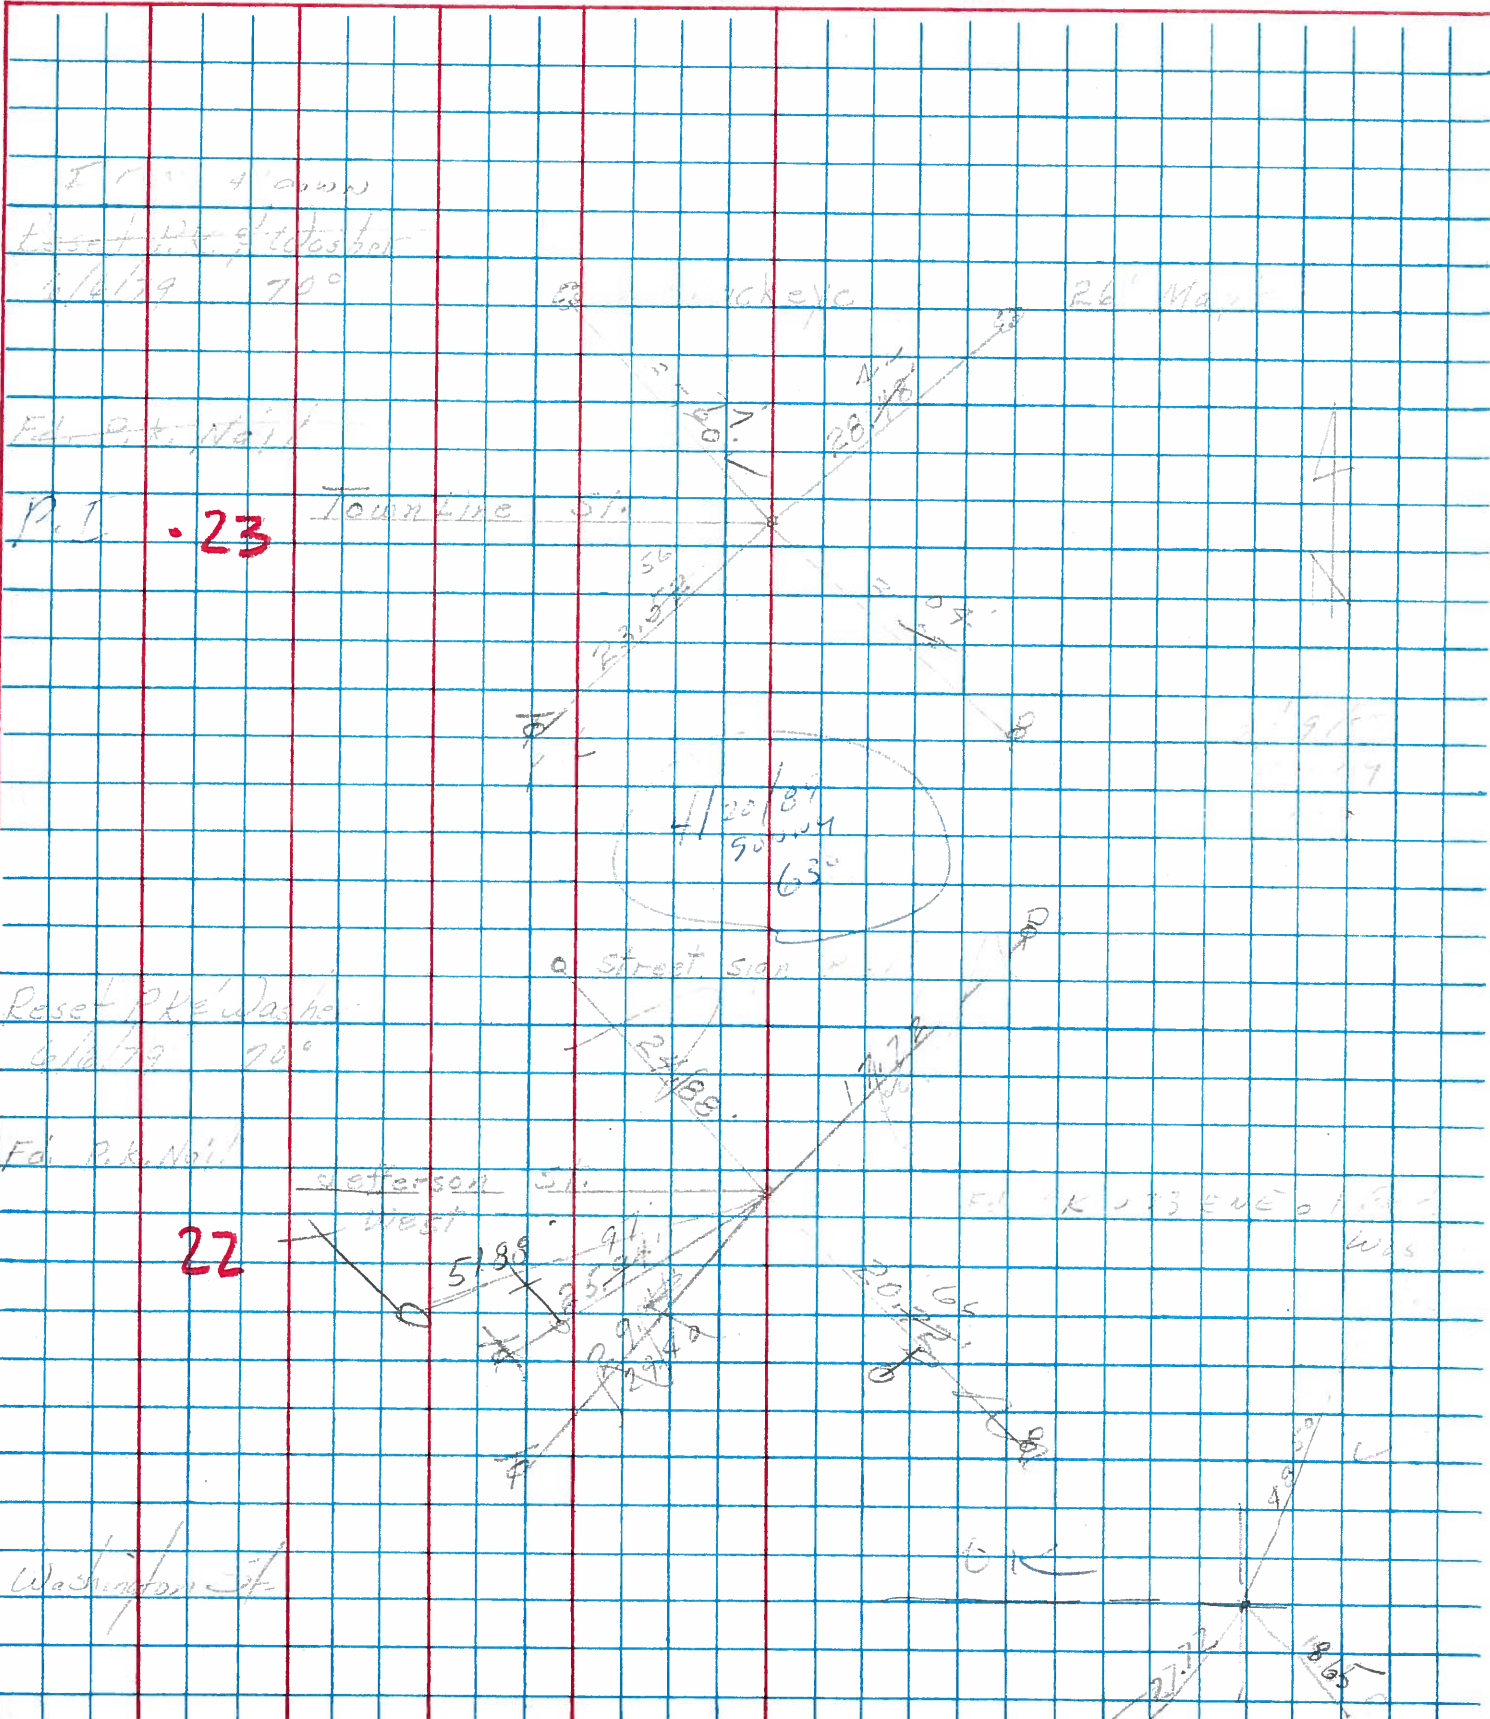

PERSONNEL TITLE PERSONNEL TITLE

Schneider
Masser
Barbour
Redding

COUNTY Ottawa DATE 5-13-68

S. R. 19 WEATHER Fair

SEC. Oak Harbor TEMP. 65°

DESCRIPTION Ties for Control Points JOB NO. _____

