

O.D.O.T. DISTRICT 2 SURVEY OFFICE (USE ONLY)

PERSONNEL

REFERENCE NO. 24

SHEET OF

NOTES ASTON
H.C. NIESE
R.C. ASTON

DATE 10/25/23
WEATHER BREEZY
TEMP. 60°

ROUTE SR 19
COUNTY OTTAWA
TOWNSHIP CARROLL
SECTION 32

DWG BY BARRIERE PID 101239

T 6 N R 15 E

TYPE MONUMENT MAG NAIL/WASHER

ON SURFACE - BELOW ON

OFFSET $\varnothing$ PAVEMENT 0.5' LT LT : RT

 TO EDGE PAVEMENT

STATION: 218+97.15

HORZ.DATUM: NAD 83 (2011)


GEOID: 18

GRID: NORTHING: 675057.347


EASTING: 1791859.178

LDP: NORTHING: 334554.254

EASTING: 151711.031

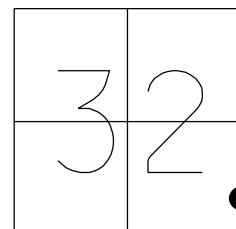

RECORD:
SET NAIL/SHINER
REF24
3/20/07, RGN
FD PK/WASHER
REF24
10/28/09, HUSS
FD HOLE
REF24
6/29/23, TDN
SET MAG/WASHER
REF24
10/25/23, TDN

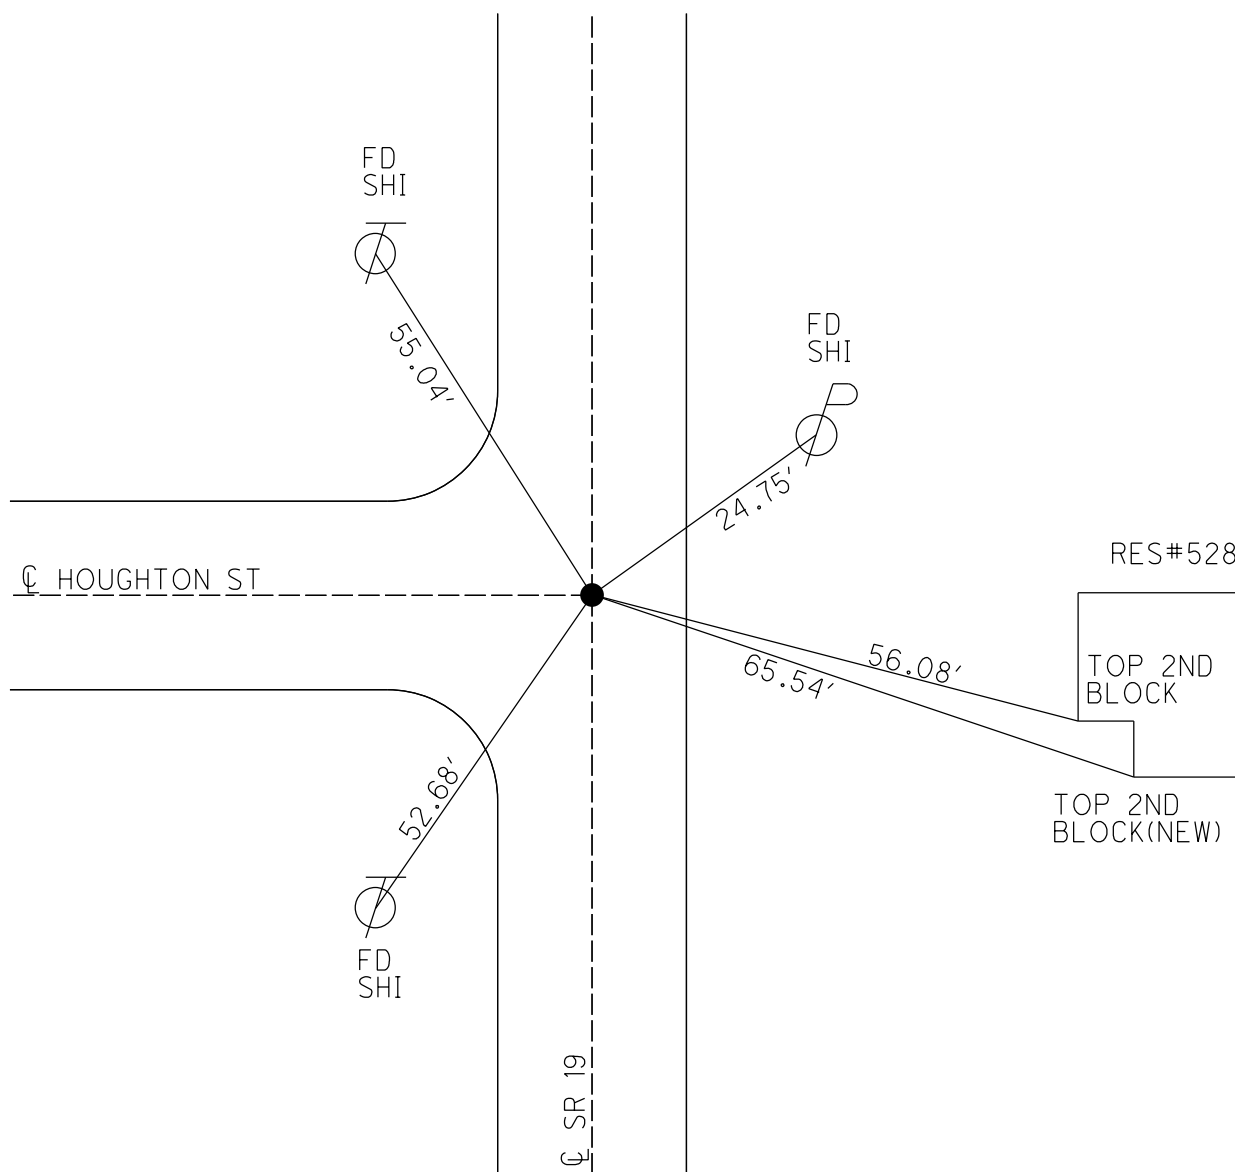

O.D.O.T. DISTRICT 2 SURVEY OFFICE (USE ONLY)

PERSONNEL

REFERENCE NO. 24

SHEET 9 OF 29



NOTES HUSS
H.C. CANTERBURY
R.C. GOLDBERG

DATE 10/29/09
WEATHER FAIR
TEMP. 50°

ROUTE SR 19
COUNTY OTTAWA
TOWNSHIP SALEM
SECTION 32
T 6 N R 15 E

TYPE MONUMENT NAIL/SHI
ON SURFACE - ~~BELOW~~ ON
LEFT - Q PAV'T - ~~RIGHT~~ 0.5'
12.4' TO RT EDGE PAVEMENT
S.L.M. 218+97

GRID: NORTHING: 675057.347 EASTING: 1791859.178

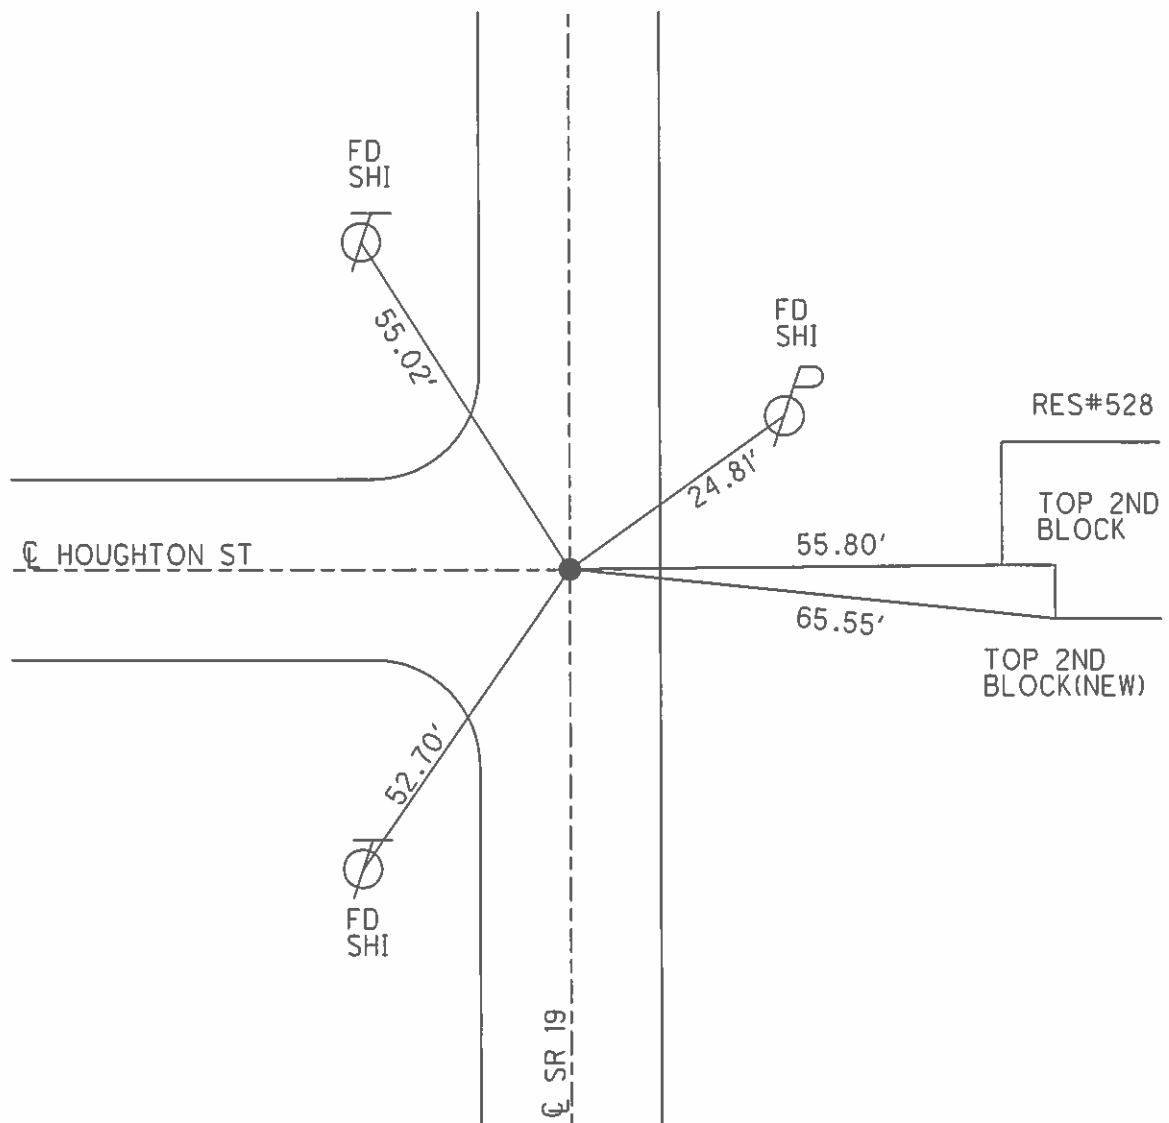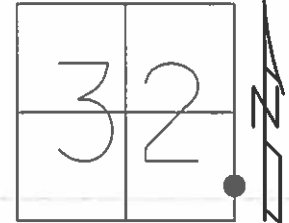

O.D.O.T. DISTRICT 2 SURVEY OFFICE (USE ONLY)

PERSONNEL

REFERENCE NO.

24

SHEET

13

OF 33

NOTES

HUSS

DATE

10/29/09

ROUTE

SR 19

H.C.

CANTERBURY

WEATHER

FAIR

COUNTY

OTTAWA

R.C.

GOLDBERG

TEMP.

50°

TOWNSHIP

SALEM

SECTION

32

T 6 N

R 15 E

TYPE MONUMENT NAIL/SHINNER



ON SURFACE - ~~BELOW~~ ON

LEFT - CL PAV'T - ~~RIGHT~~ 0.5'

12.4' TO RT EDGE PAVEMENT

S.L.M. 218+97

Grid: Northing: 675057.347 Easting: 1791859.178

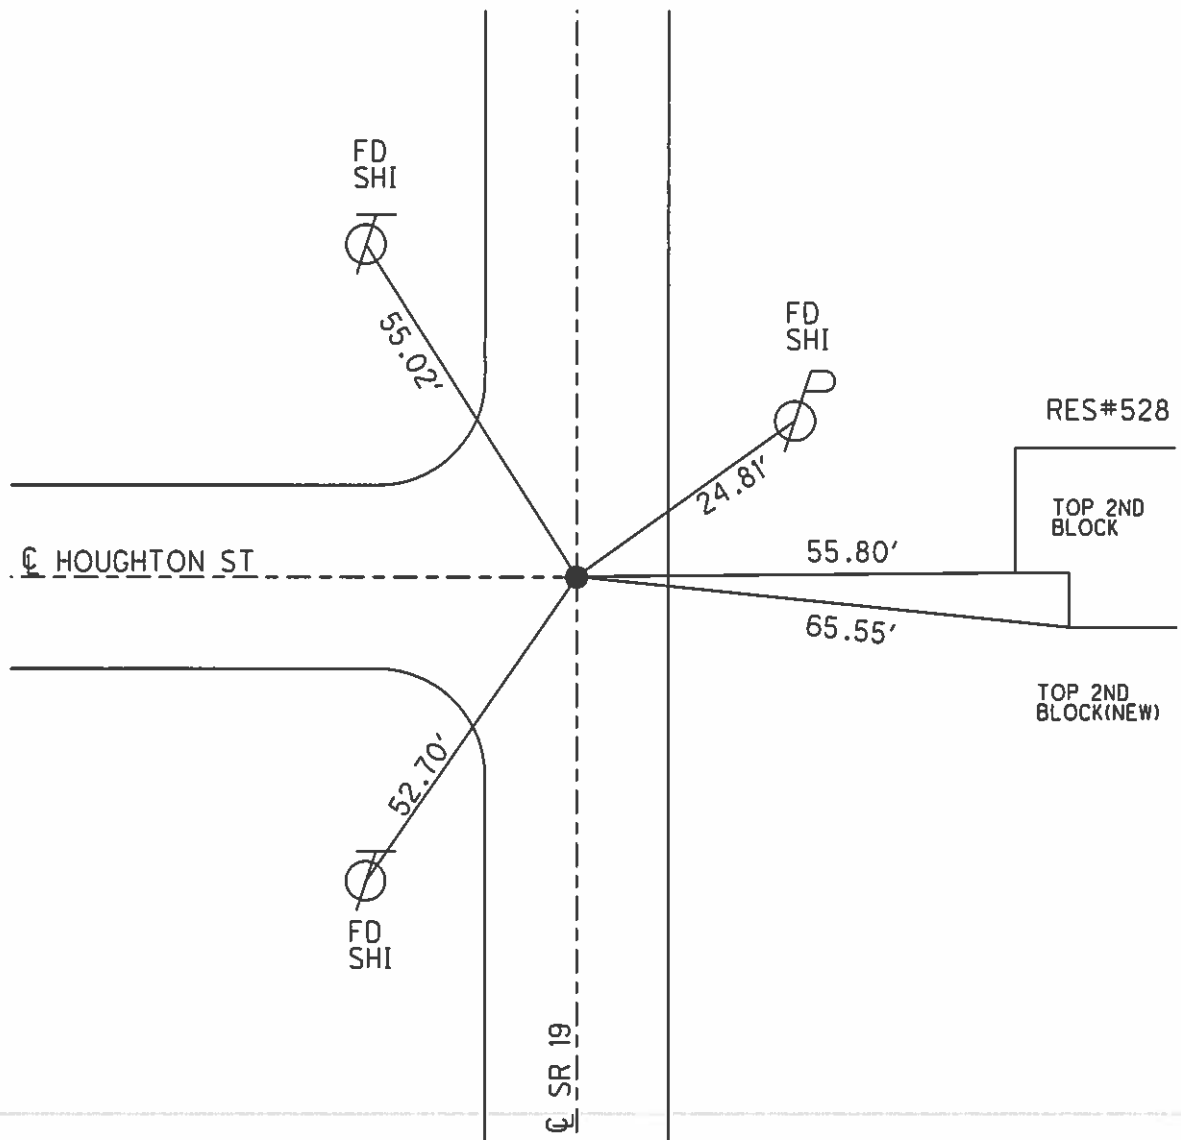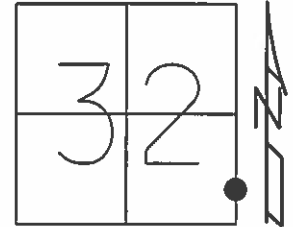

PERSONNEL

TITLE

PERSONNEL

TITLE

COUNTY OTTAWA

DRAWN 4/24/89

DATE 4/20/89

CRONIN

RIPPLE

GEYMAN

S. R. #19

WEATHER SUNNY

SEC. OKK HARBOR

TEMP. 63°


DESCRIPTION TIES INTERSECTING STREETS - SET BY OTHERS

JOB NO. _____

LEFT

CENTER LINE

RIGHT

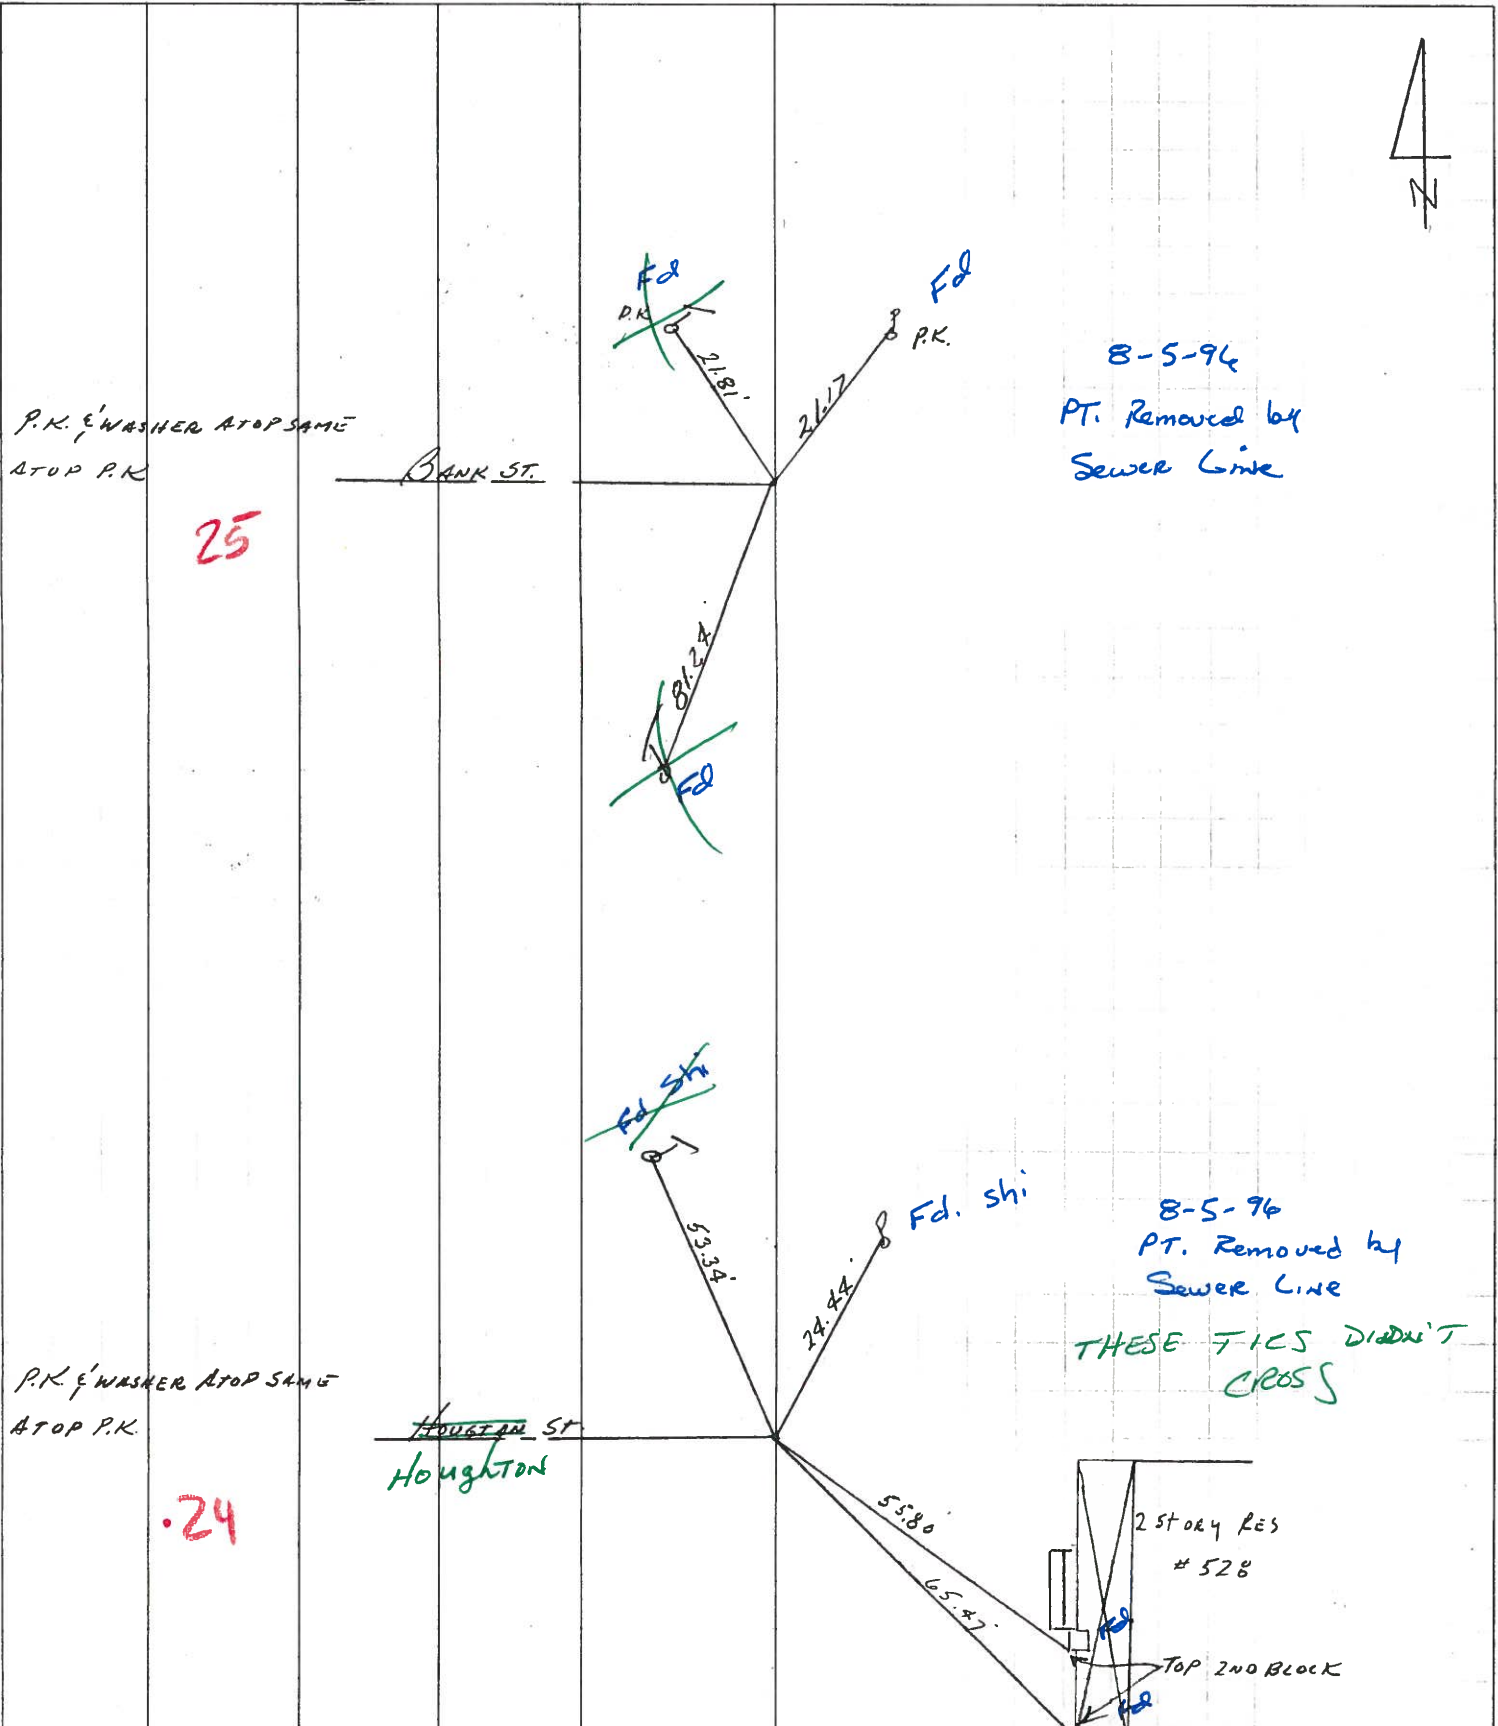

PERSONNEL

TITLE

PERSONNEL

TITLE


DRAWN 4/24/89COUNTY OTTAWADATE 4/20/89CRONINRIPPLEGEYMANS. R. #19WEATHER SUNNYSEC. OKK HARBORTEMP. 63°DESCRIPTION TIES INTERSECTING STREETS - SET BY OTHERS

JOB NO. _____

LEFT


CENTER LINE

RIGHT

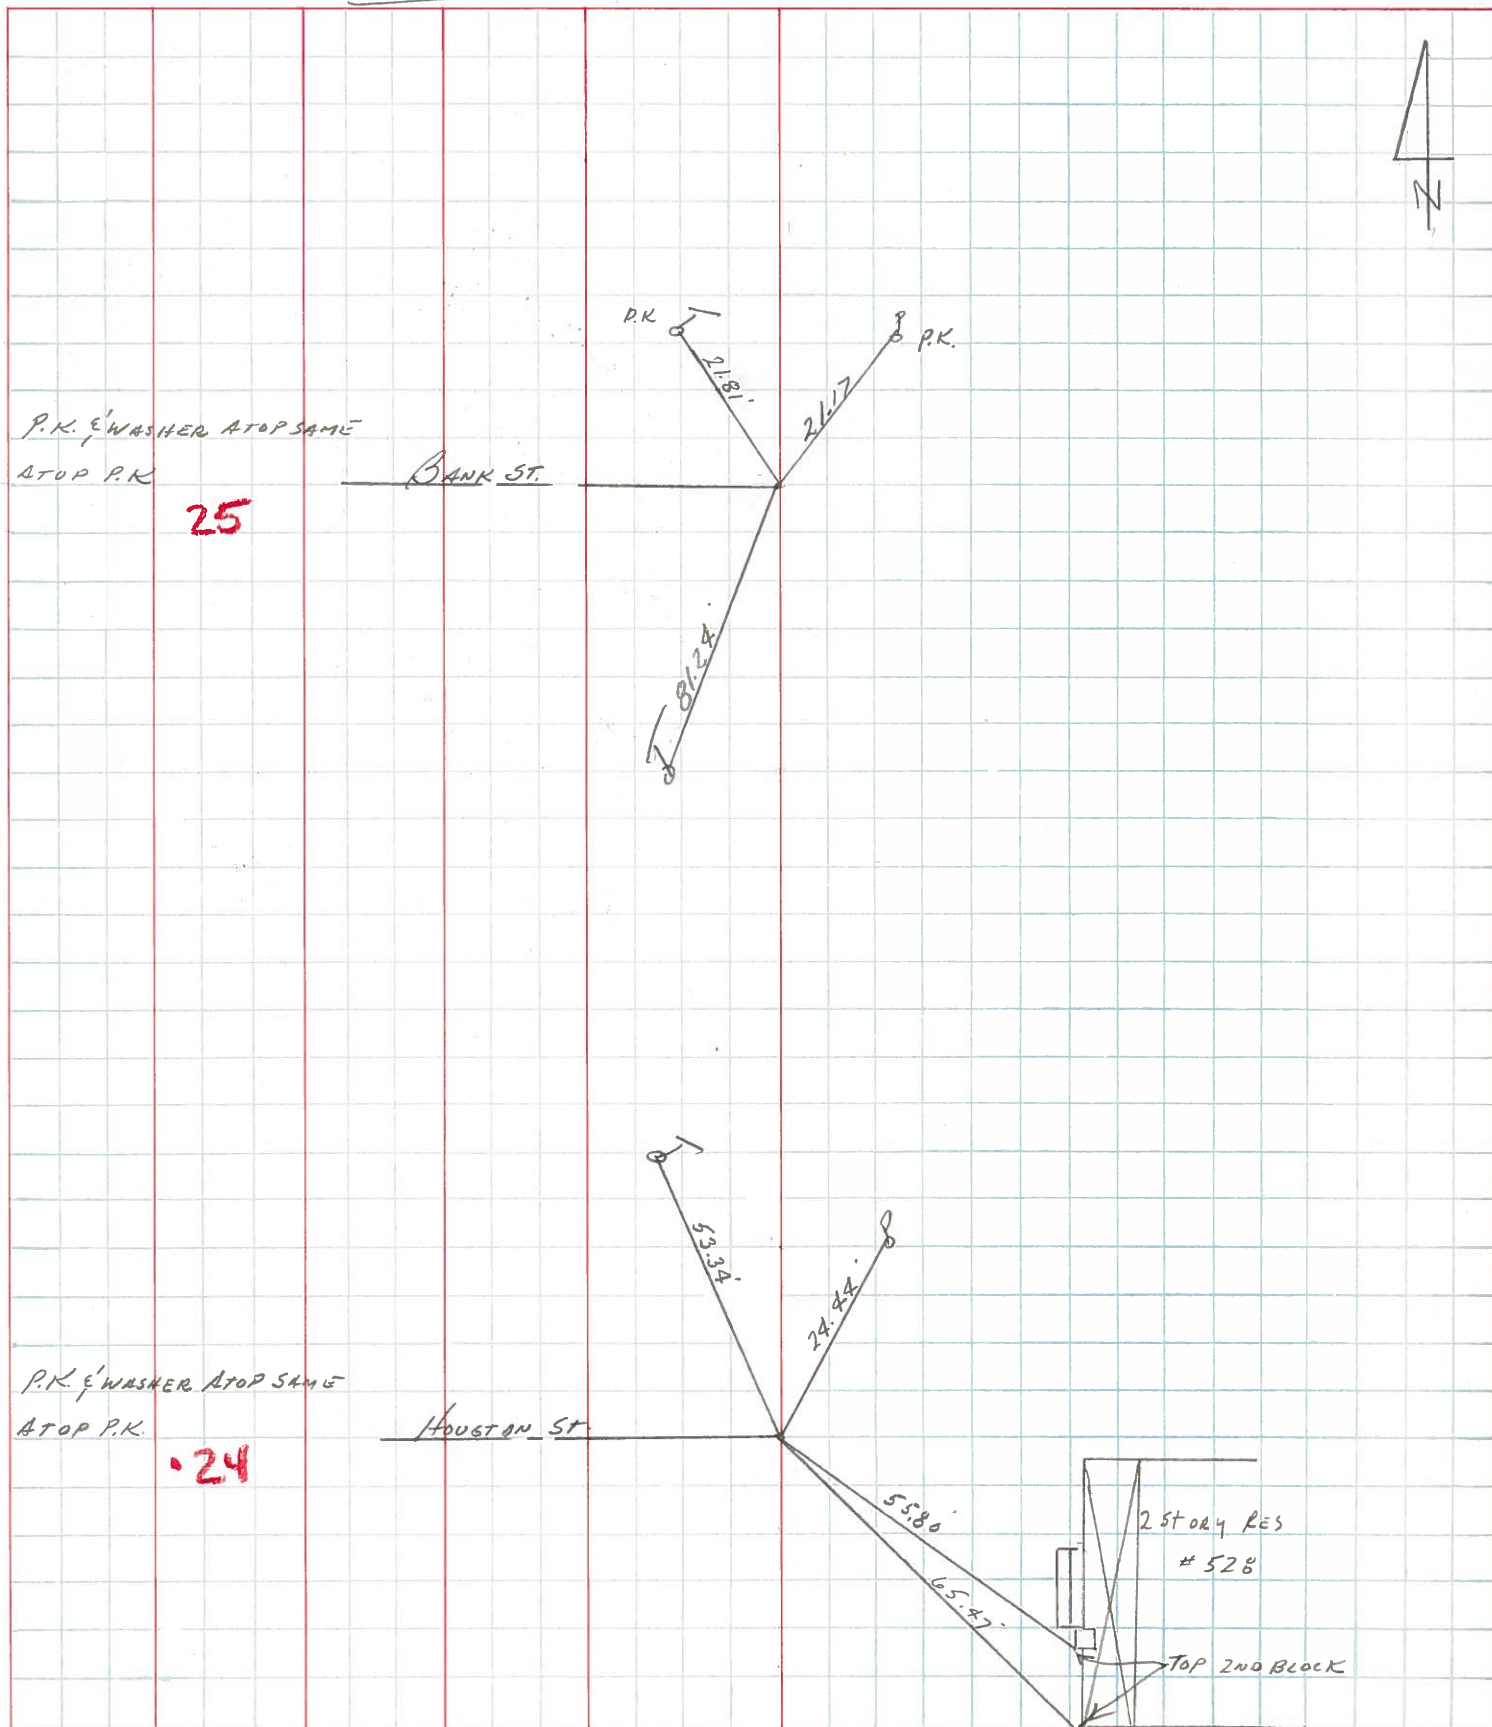

PERSONNEL	TITLE	PERSONNEL	TITLE	COUNTY	DATE
				Ottawa	4-25-78
				S. R.	19
				WEATHER	Fair - windy
				SEC.	32 E 33
				TEMP.	50°

DESCRIPTION Oak Harbor LEFT CENTER LINE RIGHT JOB NO.

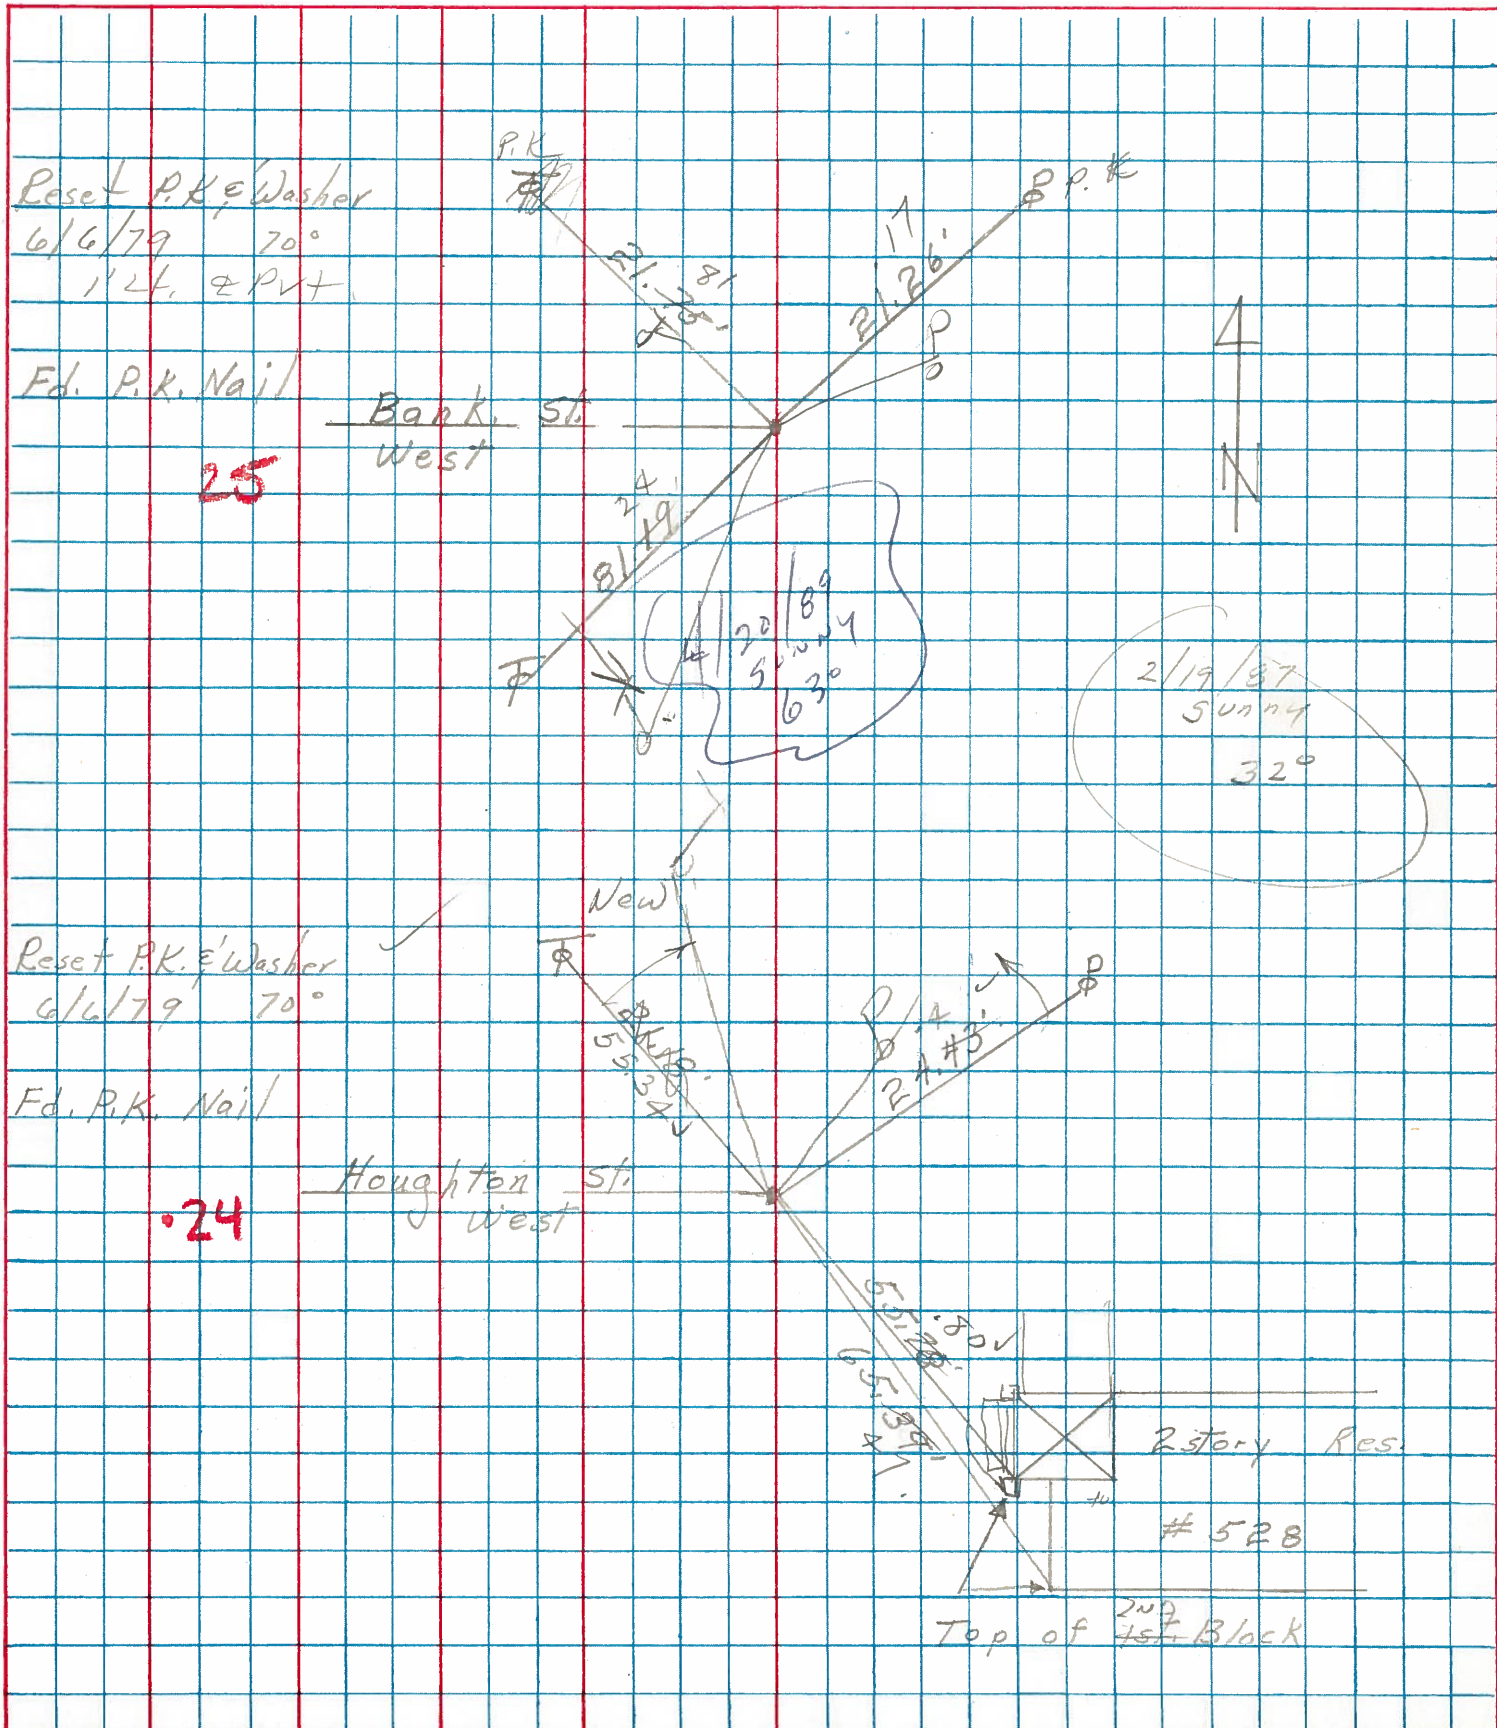

PERSONNEL	TITLE	PERSONNEL	TITLE


COUNTY Ottawa DATE 5-4-71

S. R. 19 WEATHER _____

SEC. 32E 33 TEMP. _____

DESCRIPTION Oak Harbor JOB NO. _____

LEFT CENTER LINE RIGHT

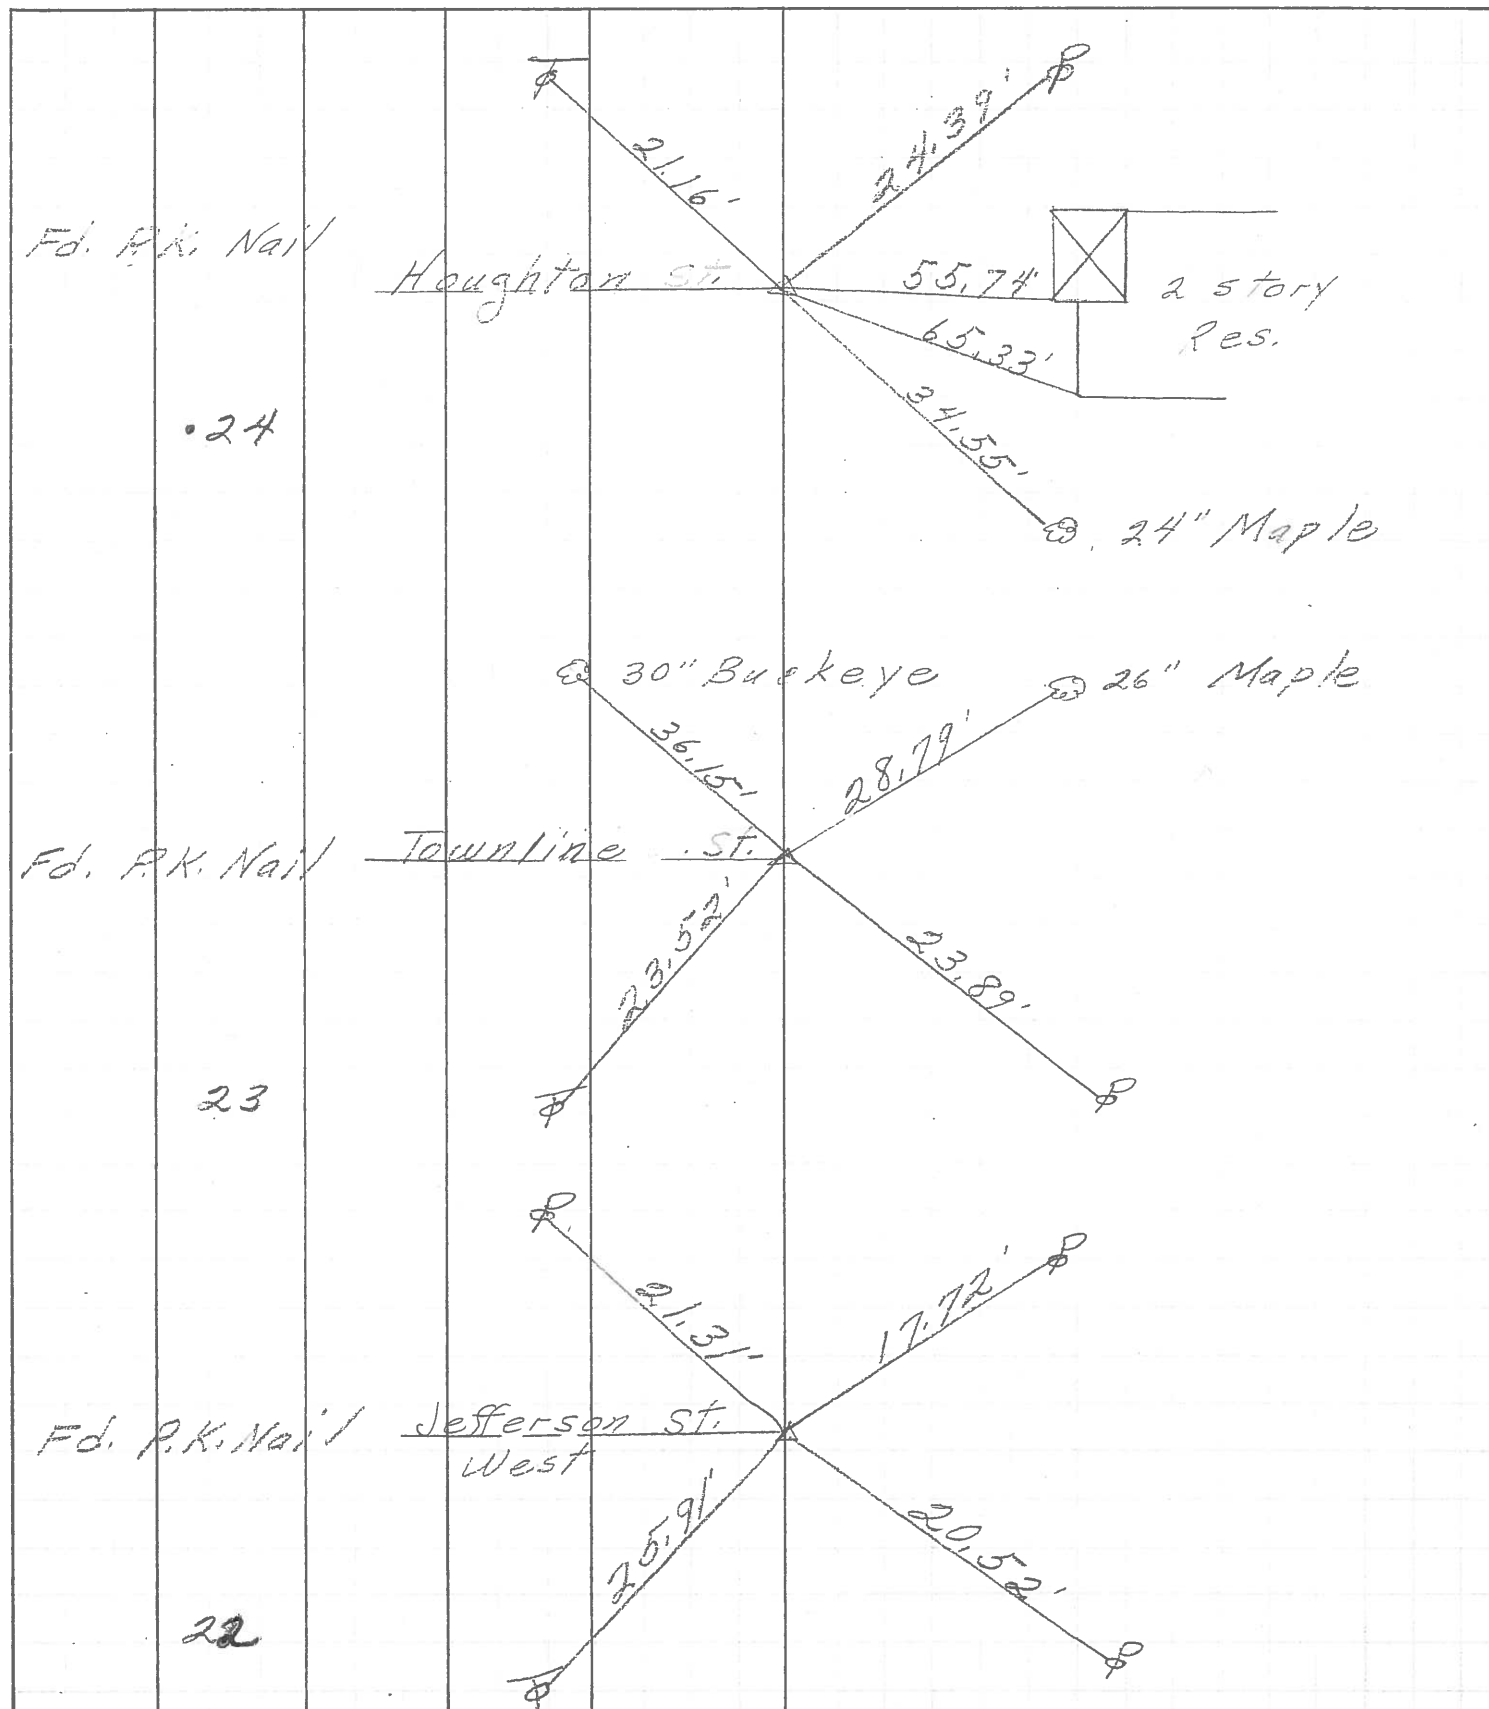

PERSONNEL	TITLE	PERSONNEL	TITLE	COUNTY	<u>Ottawa</u>	DATE	<u>5-13-68</u>
<u>Schneider</u>				S. R.	<u>19</u>	WEATHER	<u>Fair</u>
<u>Mosser</u>				SEC.	<u>Oak Harbor</u>	TEMP.	<u>65°</u>
<u>Barbour</u>							
<u>Redding</u>							
DESCRIPTION				<u>Ties for Control Points</u>		JOB NO.	

