

O.D.O.T. DISTRICT 2 SURVEY OFFICE (USE ONLY)

PERSONNEL

REFERENCE NO.

25

SHEET

10

OF 29

NOTES

HUSS

DATE

10/28/09

ROUTE

SR 19

H.C.

CANTERBURY

WEATHER

FAIR

COUNTY

OTTAWA

R.C.

GOLDBERG

TEMP.

50°

TOWNSHIP

SALEM

SECTION

32

T 7 N

R 15 E

TYPE MONUMENT

MAG/WASHER

ON SURFACE -

~~BELOW~~

ON

LEFT - ℄ PAV'T - RIGHT

ON

13.4'

TO RT



EDGE PAVEMENT

S.L.M.

224+03.87

GRID: NORTHING: 675563.732

EASTING: 179.1856.758

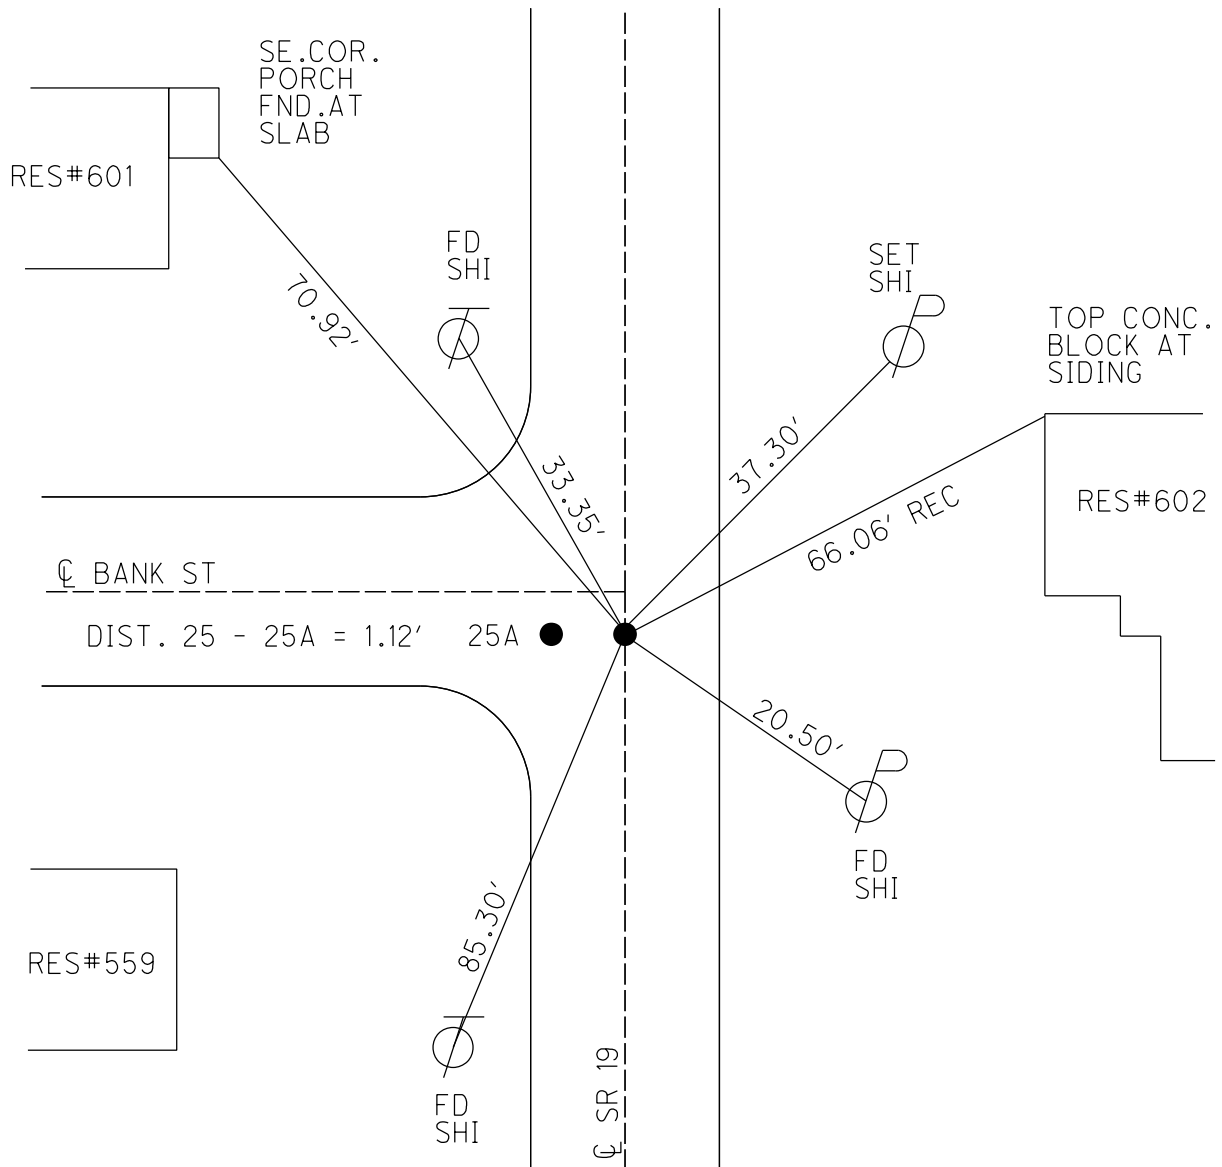
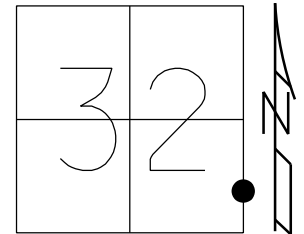


O.D.O.T. DISTRICT 2 SURVEY OFFICE (USE ONLY)

PERSONNEL _____ REFERENCE NO. 25 SHEET 10 OF 29
NOTES HUSS DATE 10/28/09 ROUTE SR 19
H.C. CANTERBURY WEATHER FAIR COUNTY OTTAWA
R.C. GOLDBERG TEMP. 50° TOWNSHIP SALEM
SECTION 32
T 7 N R 15 E

TYPE MONUMENT MAG/WASHER
ON SURFACE - ~~BELOW~~ ON
LEFT - Q PAV'T - RIGHT ON
13.4' TO RT EDGE PAVEMENT
S.L.M. 224+03.87

GRID: NORTHING: 675563.732 EASTING: 179.1856.758

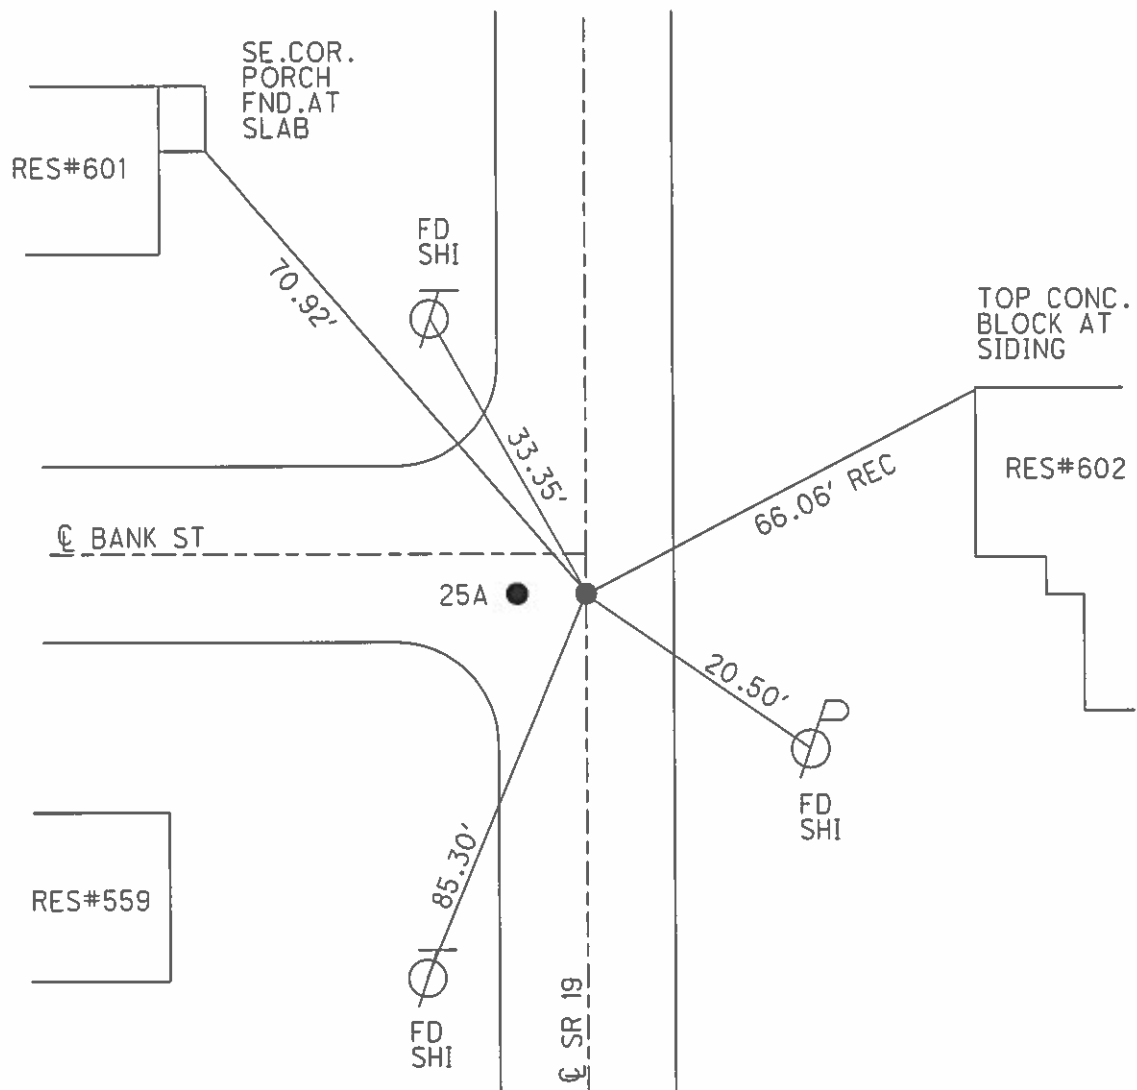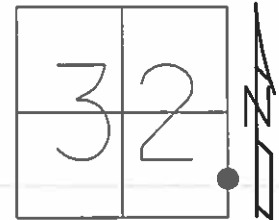

O.D.O.T. DISTRICT 2 SURVEY OFFICE (USE ONLY)

PERSONNEL

REFERENCE NO.

25

SHEET

14

OF 33

NOTES

HUSS

DATE

10/28/09

ROUTE

SR 19

H.C.

CANTERBURY

WEATHER

FAIR

COUNTY

OTTAWA

R.C.

GOLDBERG

TEMP.

50°

TOWNSHIP

SALEM

SECTION

32

T 7 N

R 15 E

TYPE MONUMENT

MAG/WASHER

ON SURFACE - ~~BELOW~~

ON

LEFT - ℄ PAV'T - RIGHT

ON



13.4' TO RT EDGE PAVEMENT

S.L.M.

224+03.87

Grid: Northing: 675563.732

Easting: 179.1856.758

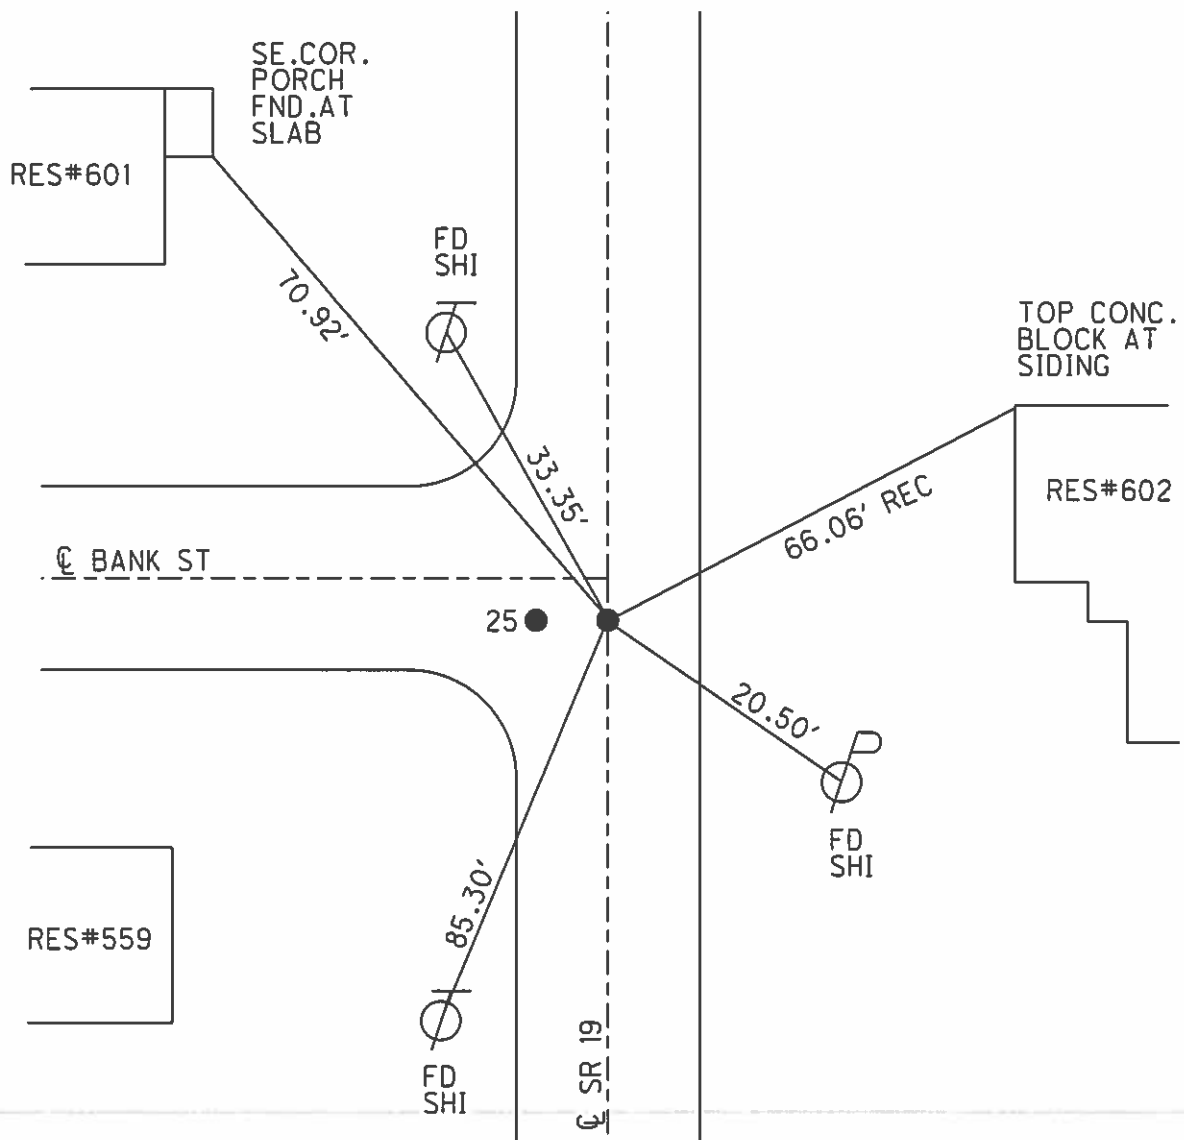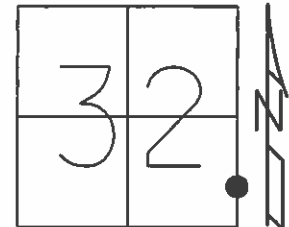

PERSONNEL

TITLE

PERSONNEL

TITLE

COUNTY OTTAWA

DRAWN 4/24/89

DATE 4/20/89

CRONIN

RIPPLE

GEYMAN

S. R. #19

WEATHER SUNNY

SEC. OKK HARBOR

TEMP. 63°


DESCRIPTION TIES INTERSECTING STREETS - SET BY OTHERS

JOB NO. _____

LEFT

CENTER LINE

RIGHT

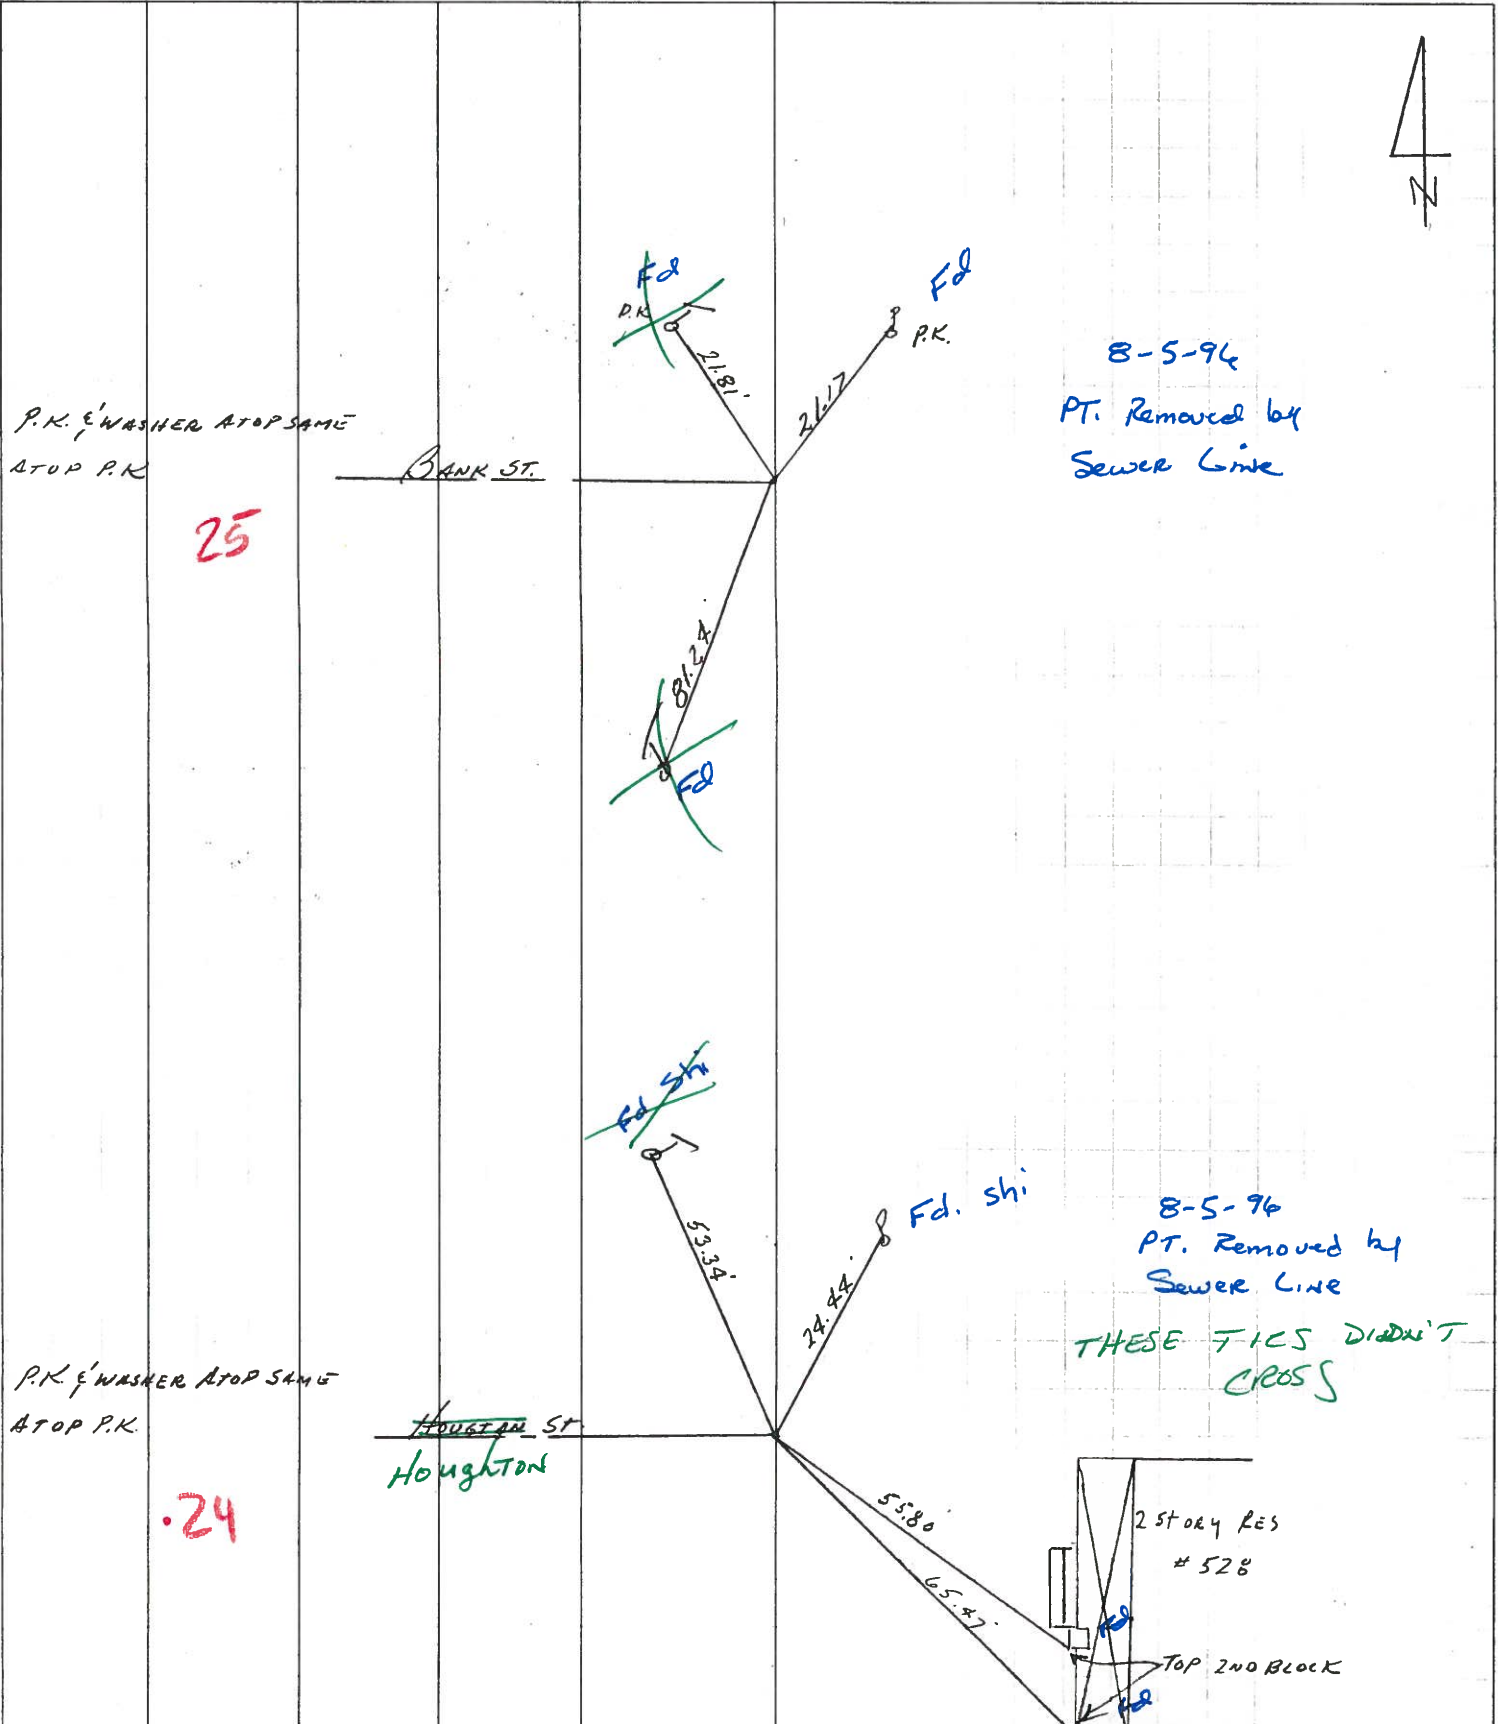

PERSONNEL

TITLE

PERSONNEL

TITLE


DRAWN 4/24/89COUNTY OTTAWADATE 4/20/89CRONINRIPPLEGEYMANS. R. #19WEATHER SUNNYSEC. OKK HARBORTEMP. 63°DESCRIPTION TIES INTERSECTING STREETS - SET BY OTHERS

JOB NO. _____

LEFT


CENTER LINE

RIGHT

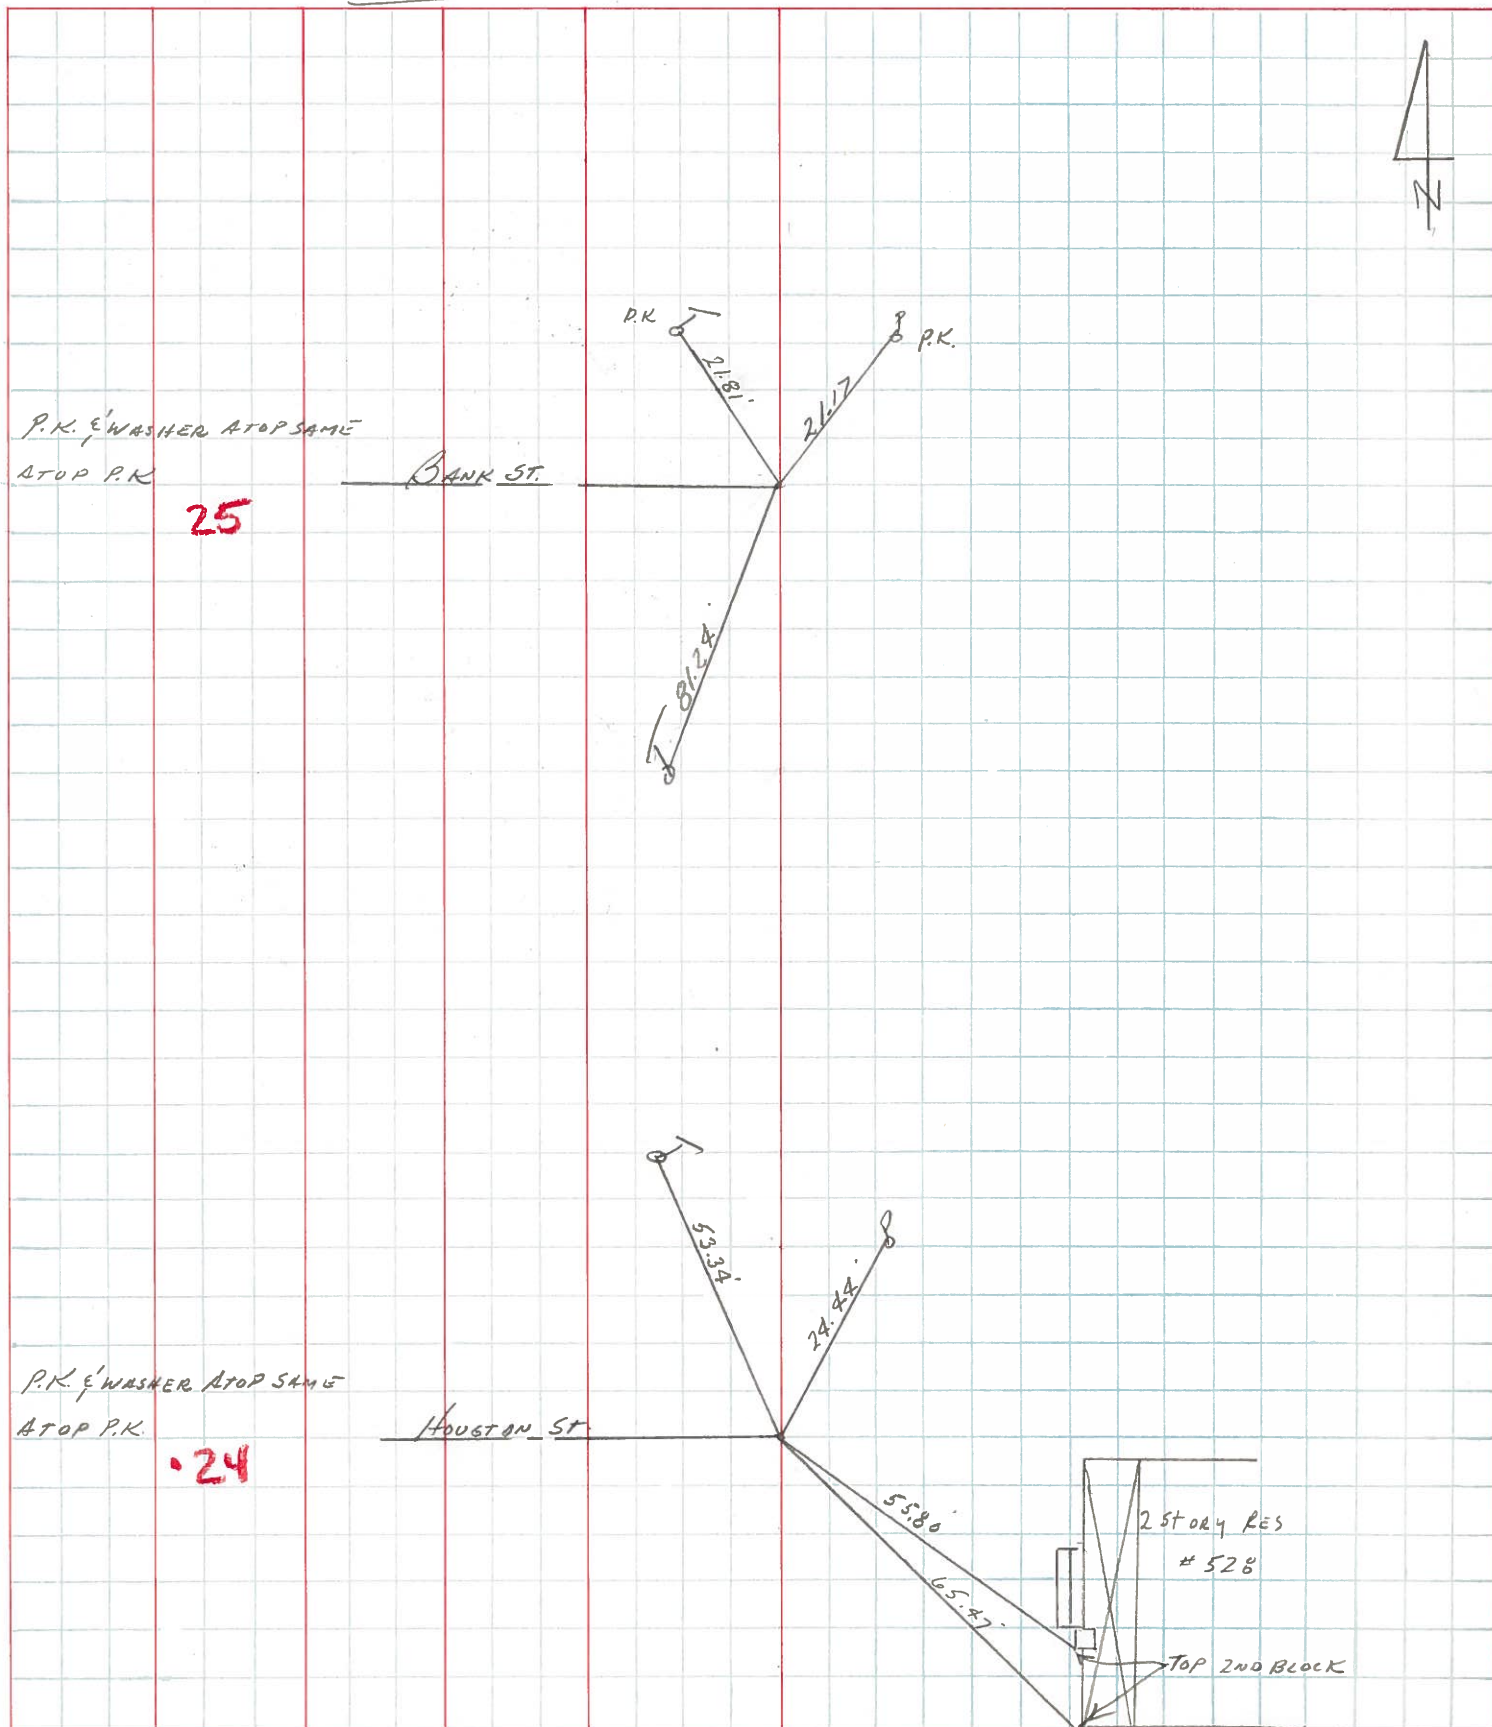

PERSONNEL	TITLE	PERSONNEL	TITLE	COUNTY	DATE	WEATHER	TEMP.
				Ottawa	4-25-78	Fair - windy	50°
				S. R. 19			
				SEC. 32 E 33			

DESCRIPTION Oak Harbor LEFT CENTER LINE RIGHT JOB NO.

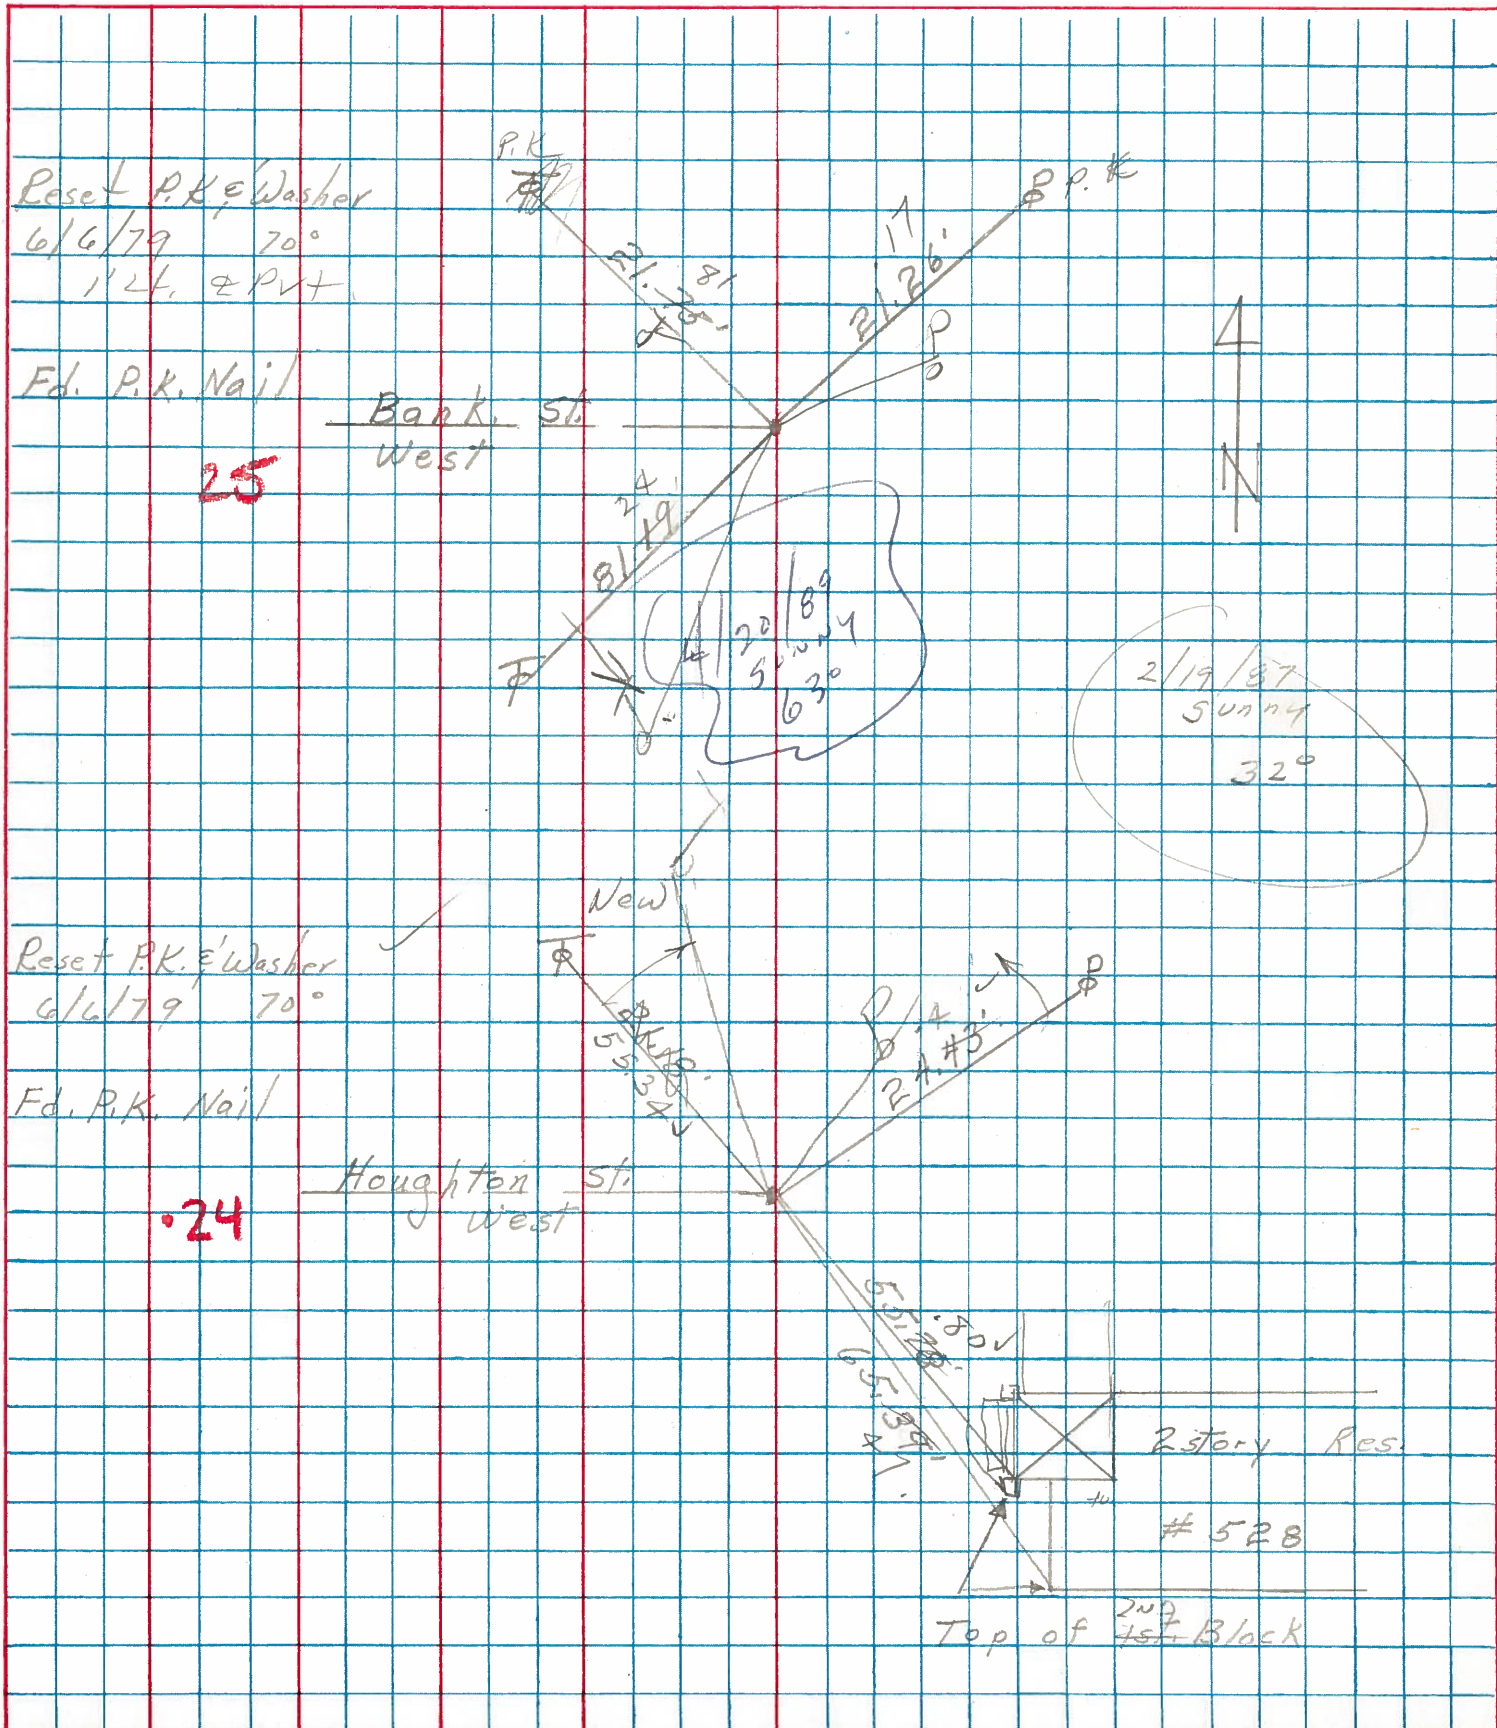


PERSONNEL	TITLE	PERSONNEL	TITLE

COUNTY Ottawa DATE 5-4-71

S. R. 19 WEATHER _____

SEC. 32E 33 TEMP. _____

DESCRIPTION Oak Harbor LEFT CENTER LINE RIGHT JOB NO. _____

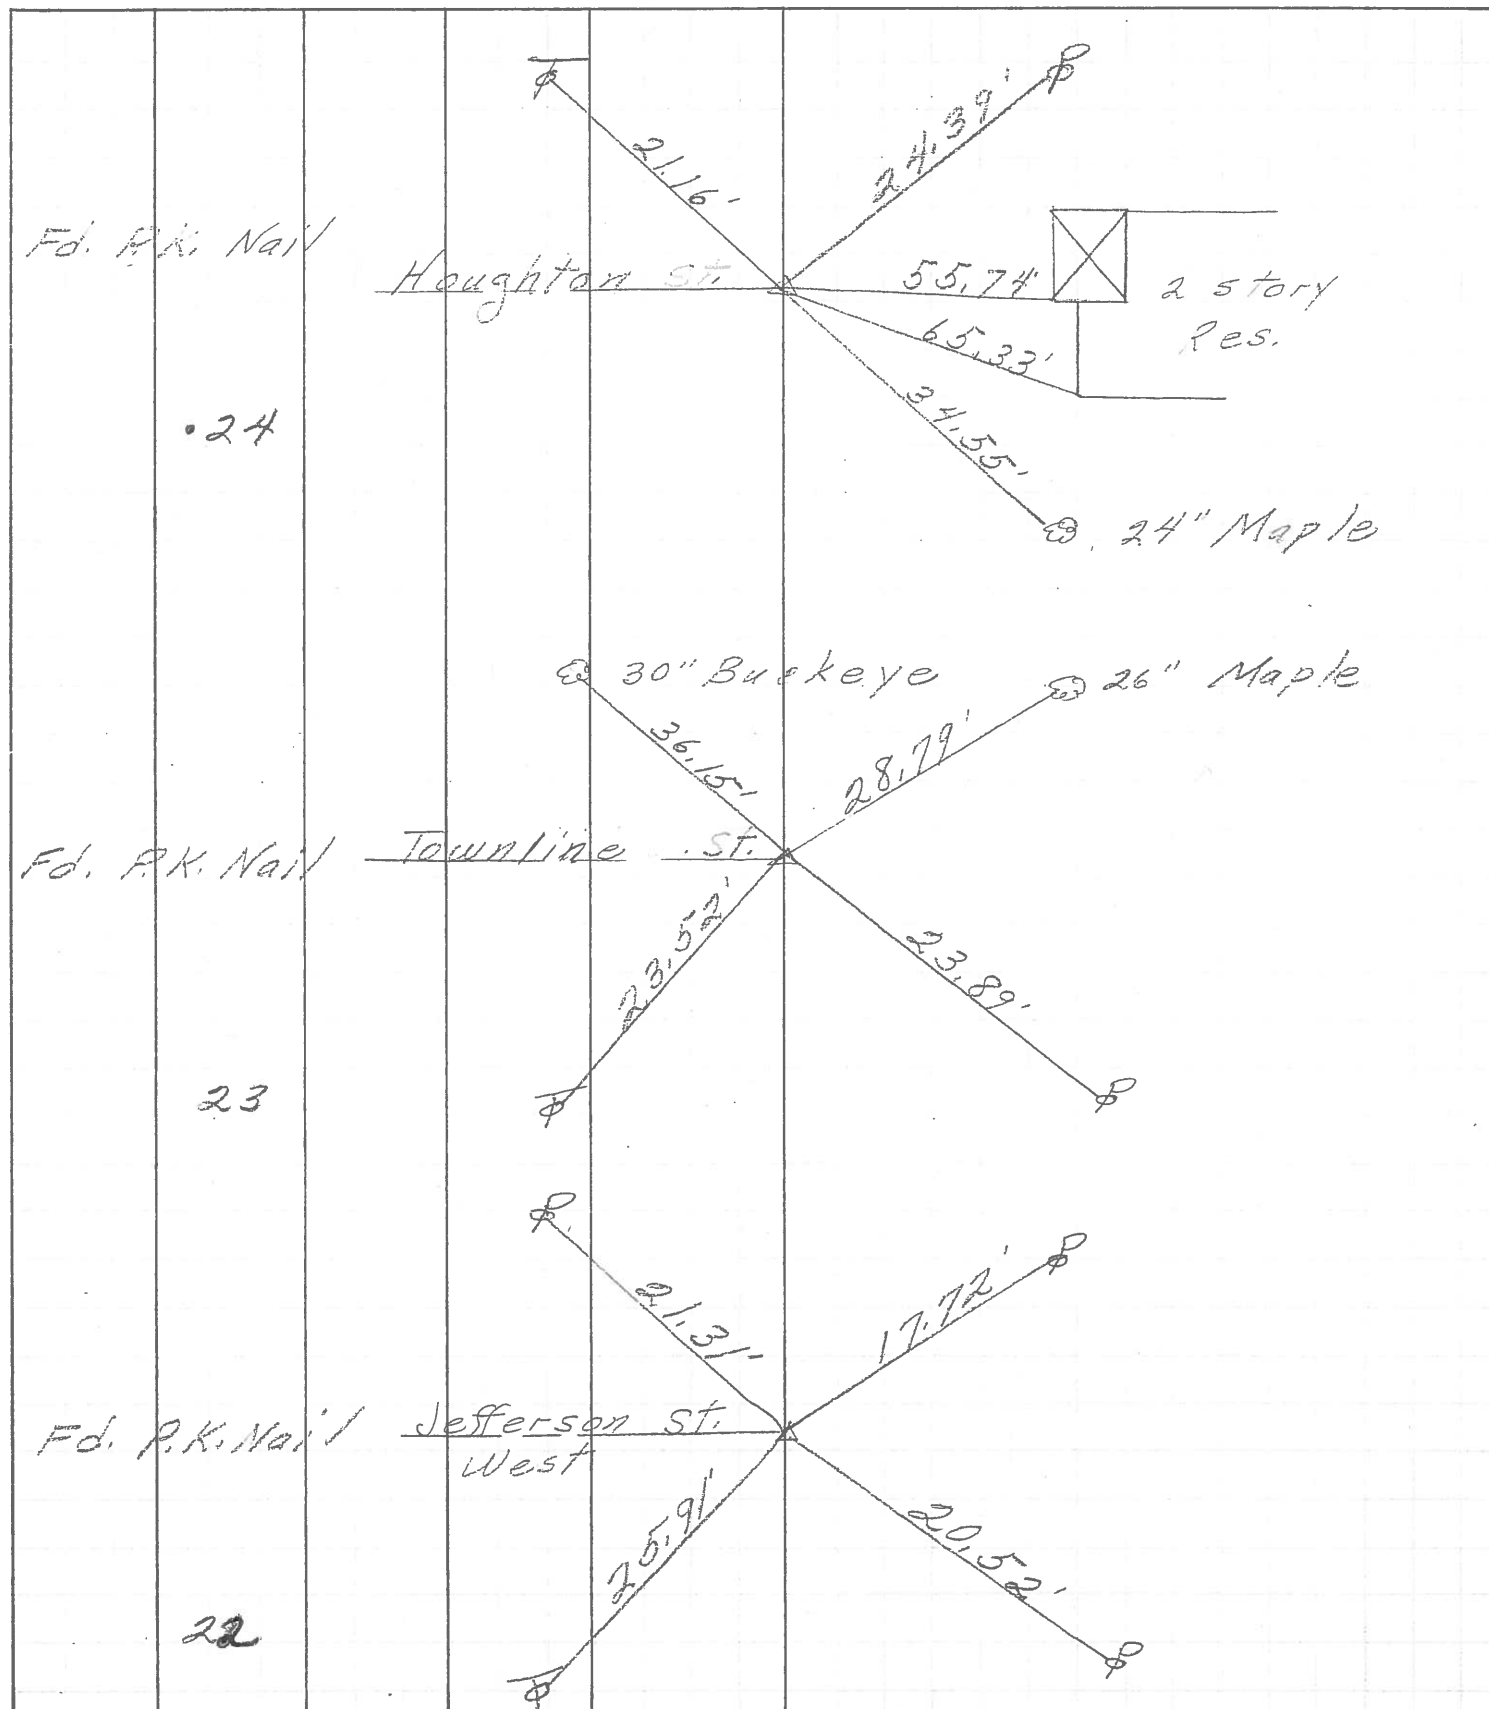

PERSONNEL TITLE PERSONNEL TITLE

Schneider COUNTY Ottawa DATE 5-13-68

Mosser S. R. 19 WEATHER Fair

Barbour SEC. Oak Harbor TEMP. 65°

Redding DESCRIPTION Ties for Control Points JOB NO. _____

LEFT CENTER LINE RIGHT

