

O.D.O.T. DISTRICT 2 SURVEY OFFICE (USE ONLY)

PERSONNEL

REFERENCE NO. 25 A

SHEET OF

NOTES ASTON

DATE 10/25/23

ROUTE SR 19

H.C. NIESE

WEATHER BREEZY

COUNTY OTTAWA

R.C. ASTON

TEMP. 60°

TOWNSHIP CARROLL

DWG BY BARRIERE

PID 101239

SECTION 32

T 6 N R 15 E

TYPE MONUMENT MAG NAIL/WASHER

ON SURFACE - BELOW ON

OFFSET $\oslash$ PAVEMENT 0.5' LT LT : RT

 TO EDGE PAVEMENT

STATION: 224+03.87

HORZ.DATUM: NAD 83 (2011)


GEOID: 18

GRID: NORTHING: 675563.895

EASTING: 1791855.561

LDP: NORTHING: 335060.778

EASTING: 151703.862

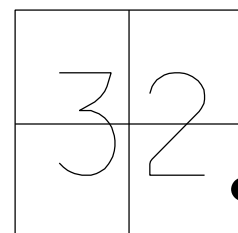

RECORD:

FD PK/WASHER

REF25A

10/28/09, HUSS

FD PK/WASHER


REF25A

6/29/23, TDN

SET MAG/WASHER

REF25A


10/25/23, TDN

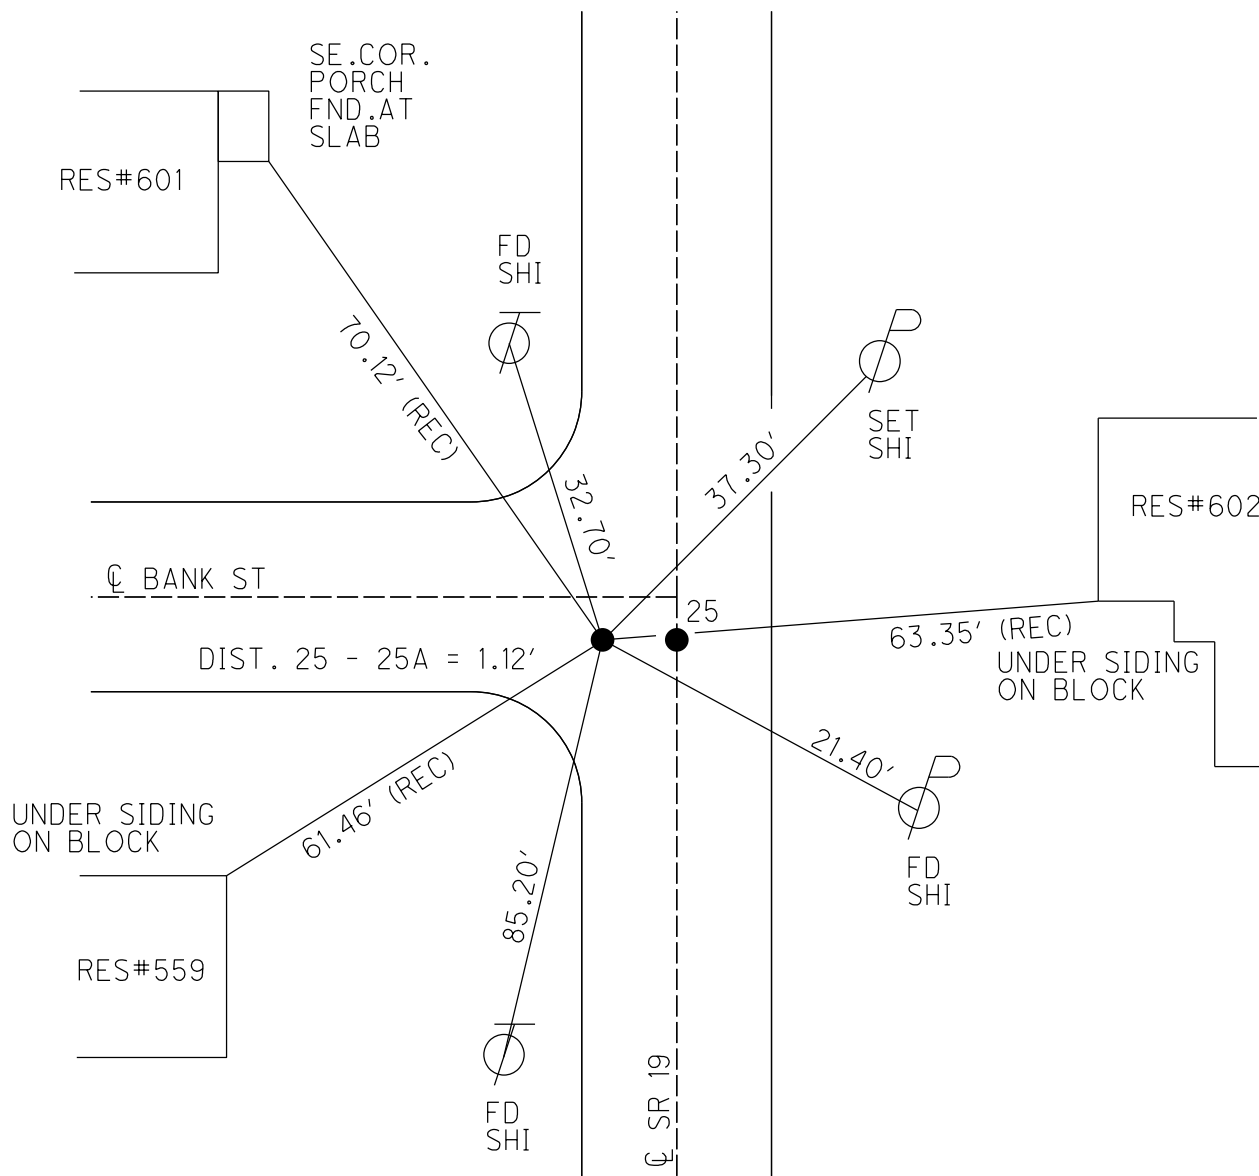


O.D.O.T. DISTRICT 2 SURVEY OFFICE (USE ONLY)

PERSONNEL	REFERENCE NO.	25 A	SHEET	11	OF	29
NOTES	HUSS	DATE	10/28/09	ROUTE	SR 19	
H.C.	CANTERBURY	WEATHER	FAIR	COUNTY	OTTAWA	
R.C.	GOLDBERG	TEMP.	50°	TOWNSHIP	SALEM	
				SECTION	32	
				T	7	N
				R	15	E

TYPE MONUMENT P.K./WASHER
ON SURFACE - ~~BELOW~~ ON
LEFT - CL PAV'T - ~~RIGHT~~ ± 1.0'
- TO - EDGE PAVEMENT
S.L.M. 224+.03.87

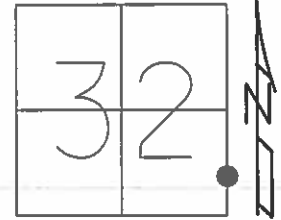

GRID: NORTHING: 675563.895 EASTING: 1791855.561

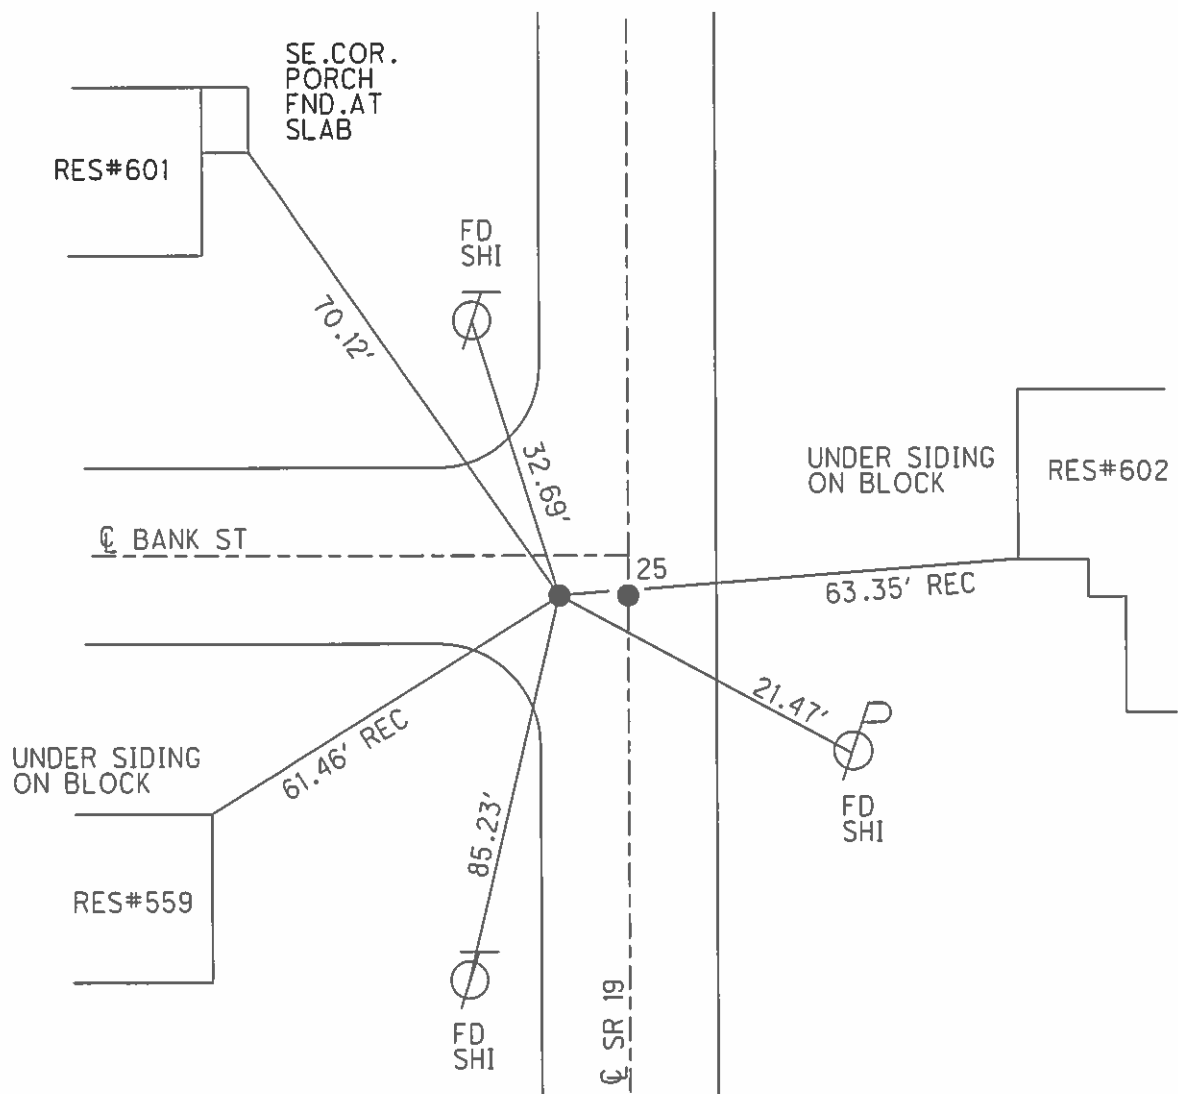

O.D.O.T. DISTRICT 2 SURVEY OFFICE (USE ONLY)

PERSONNEL

REFERENCE NO.

25 A

SHEET

15

OF 33

NOTES

HUSS

DATE

10/28/09

ROUTE

SR 19

H.C.

CANTERBURY

WEATHER

FAIR

COUNTY

OTTAWA

R.C.

GOLDBERG

TEMP.

50°

TOWNSHIP

SALEM

SECTION

32

T 7 N R 15 E

TYPE MONUMENT P.K./WASHER

ON SURFACE - ~~BELOW~~ ON

LEFT - CL PAV'T - ~~RIGHT~~ ± 1.0'

- TO - EDGE PAVEMENT

S.L.M. 224+ .03.87

Grid: Northing: 675563.895 Easting: 1791855.561

