
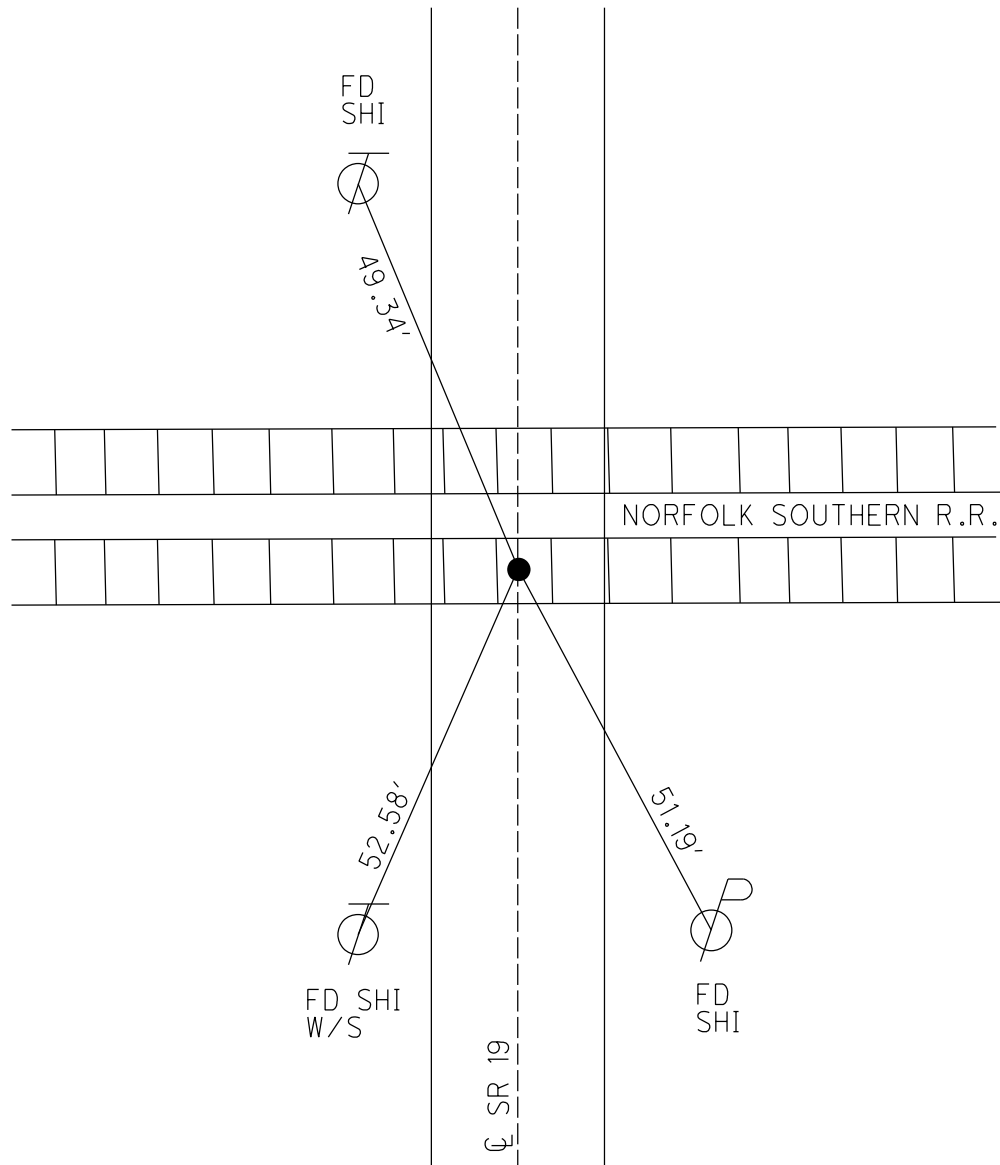


O.D.O.T. DISTRICT 2 SURVEY OFFICE (USE ONLY)

PERSONNEL _____ REFERENCE NO. 25 C SHEET 13 OF 29
NOTES NUHFER DATE 5/8/07 ROUTE SR 19
H.C. HUSS WEATHER SUNNY COUNTY OTTAWA
R.C. _____ TEMP. 75° TOWNSHIP SALEM
_____ SECTION 32
T 7 N R 15 E

TYPE MONUMENT MAG/WASHER
ON SURFACE - ~~BELOW~~ ON
LEFT - CL PAV'T - RIGHT ON
- TO - EDGE PAVEMENT
S.L.M. 227+49.71
GRID: NORTHING: 675909.924 EASTING: 1791854.970

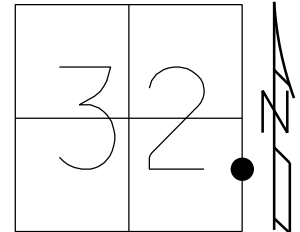

O.D.O.T. DISTRICT 2 SURVEY OFFICE (USE ONLY)

PERSONNEL

REFERENCE NO.

25 C

SHEET

13

OF

29

NOTES NUHFER

DATE 5/8/07

ROUTE SR 19

H.C. HUSS

WEATHER SUNNY

COUNTY OTTAWA

R.C. _____

TEMP. 75°

TOWNSHIP SALEM

SECTION 32

T 7 N R 15 E

TYPE MONUMENT MAG/WASHER



ON SURFACE - ~~BELOW~~ ON

LEFT - ℄ PAV'T - RIGHT ON

- TO - EDGE PAVEMENT

S.L.M. 227+04

GRID: NORTHING: 675909.924 EASTING: 1791854.970

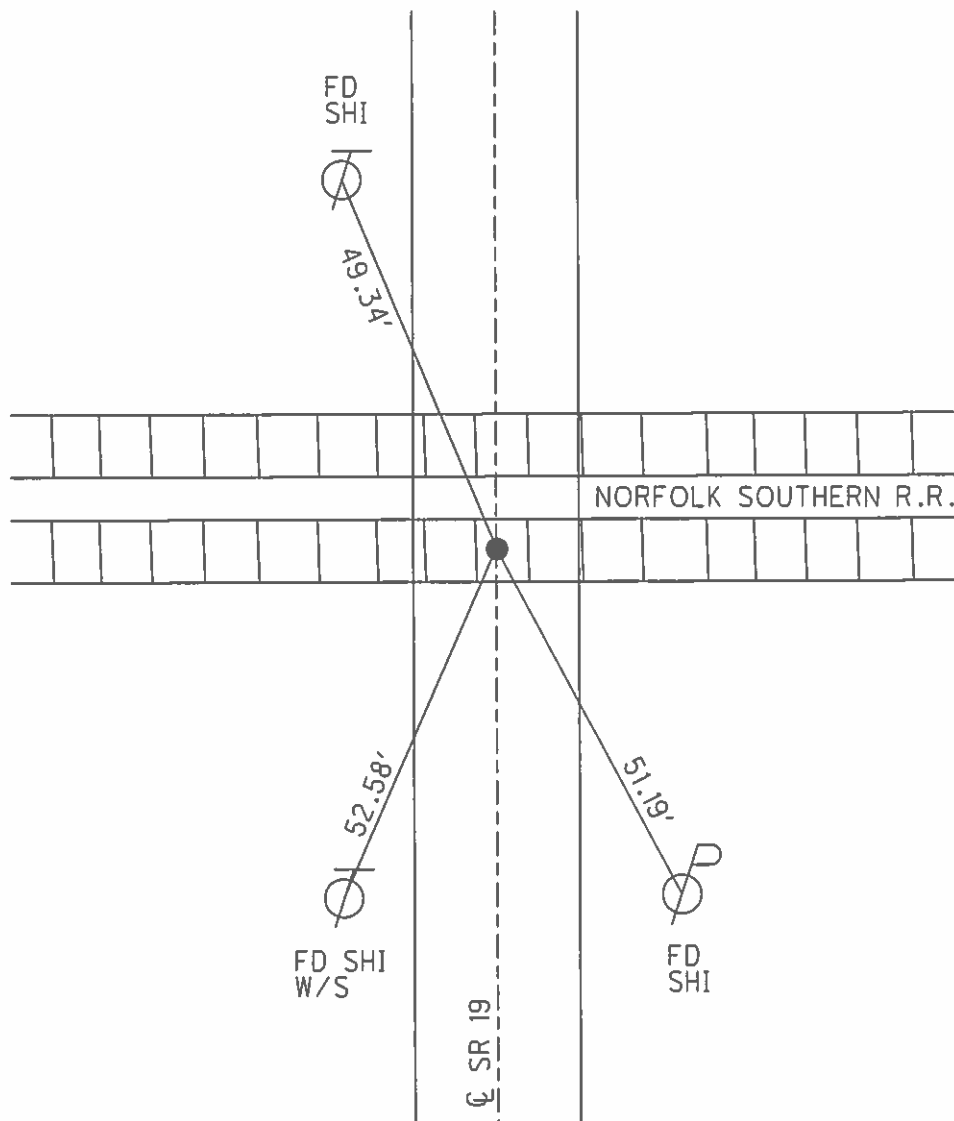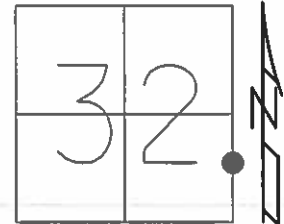

O.D.O.T. DISTRICT 2 SURVEY OFFICE (USE ONLY)

PERSONNEL

REFERENCE NO.

25 C

SHEET

17

OF 33

NOTES

NUHFER

DATE

5/8/07

ROUTE

SR 19

H.C.

HUSS

WEATHER

SUNNY

COUNTY

OTTAWA

R.C.

TEMP.

75°

TOWNSHIP

SALEM

SECTION

32

T 7 N

R 15 E

TYPE MONUMENT

MAG/WASHER

ON SURFACE - ~~BELOW~~

ON

LEFT - C PAV'T - RIGHT



ON

- TO - EDGE PAVEMENT

S.L.M. 227+04

Grid: Northing: 675909.924

Easting: 1791854.970

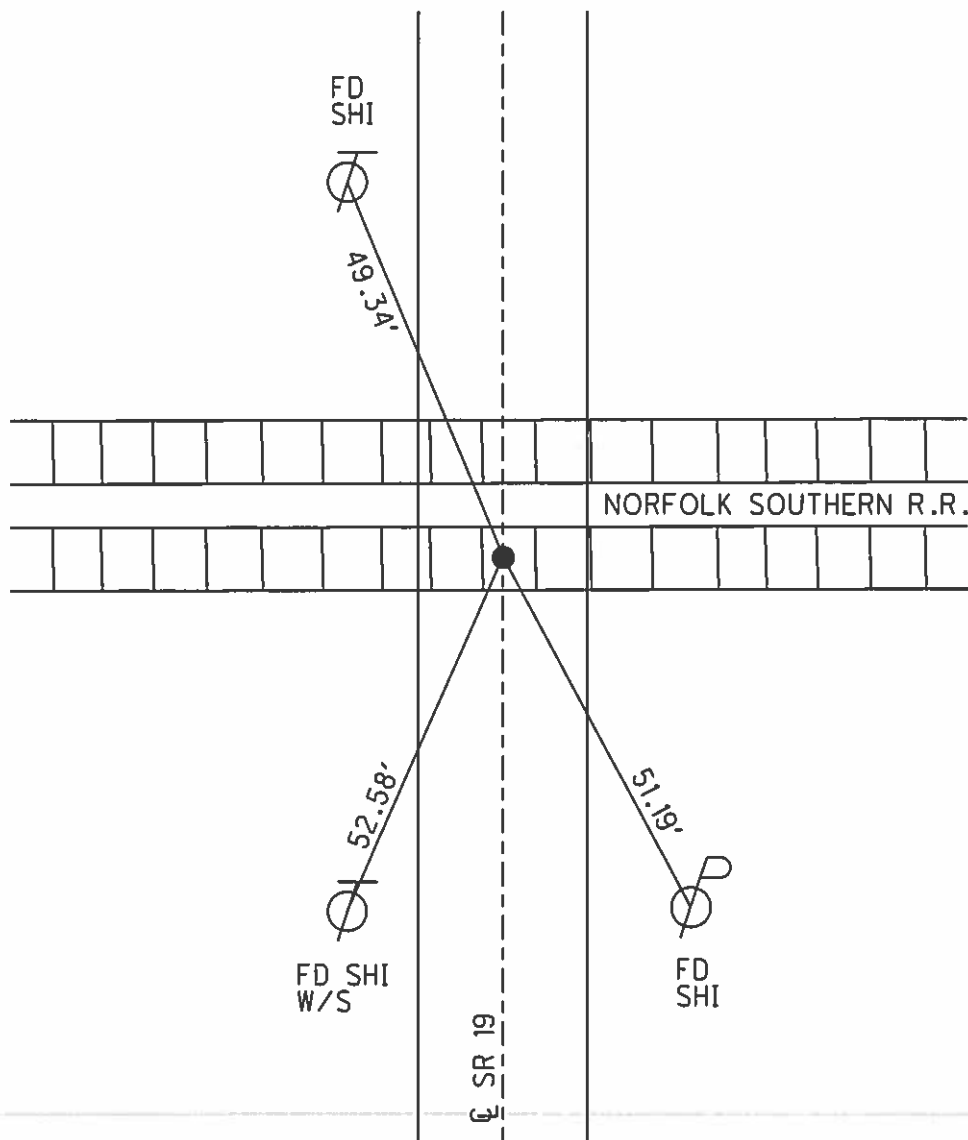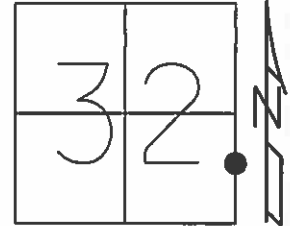

PERSONNEL TITLE PERSONNEL TITLE

COUNTY Ottawa DATE 4-25-78S. R. 19 WEATHER Fair-WindySEC. 32-33 TEMP. 50°DESCRIPTION Oak Harbor JOB NO.

LEFT

CENTER LINE

RIGHT

Lake St.
West

Both have County ties
No Point in Perm. t.

Brood St.
West

25D

Reset P.K. & Washer
6/6/79 70°

South Track


N.Y.C. R.R.

P.I.

225+53.20

P.K. Nail

25C

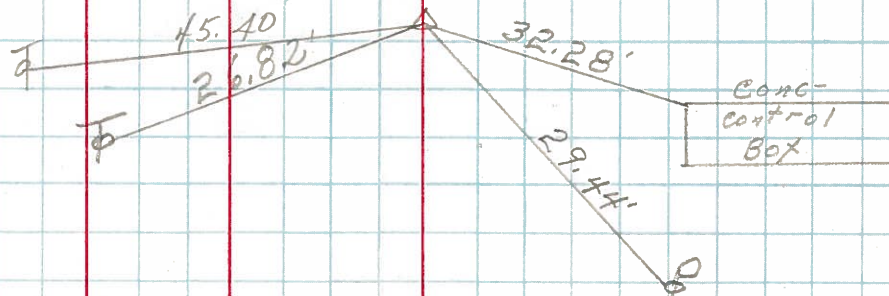

PERSONNEL TITLE PERSONNEL TITLE

COUNTY Ottawa DATE 5-4-71S. R. 19 WEATHERSEC. 32 & 33 TEMP.DESCRIPTION Oak Harbor & 1 point North JOB NO.

LEFT

CENTER LINE

RIGHT

266+58

Fd. P.K. Nail
6' Rt. of £See
New
TIES

27

P.K. Nail

2-story
Res.See
New
TIES

26

P.I.

225+53.20

P.K. Nail

250

Co. Mort.

42.19'
51.26'

43.33'

Co. Mort.

Inland Marine

Co. Rd. #98

36.68'

Co. Set R.R. spk.

10.0'

66.69'
67.47'

55.47'

55.33'

30.30'
29.32'

10.0'

54.81'
55.18'Oak Harbor Corp.
Line

← Conc. curb →

Light Pole

South track

N.Y.C. R.R.

45.42'
76.66'

32.28'

37.17'

Conc. Control Box

96" Manhole

PERSONNEL TITLE PERSONNEL TITLE

Schneider

COUNTY OttawaDATE 5-13-68

Mosser

S. R. 19WEATHER Fair

Barbour

SEC. Oak Harbor North TEMP. 65°

Redding

DESCRIPTION

Ties for Control Points

JOB NO.

LEFT

CENTER LINE

RIGHT

did not find

6127

30

Co. Rd. #96

did not find

Co. has ties

6126

28

Co. Rd. #97

did not find

Co. has ties

6125

27

Co. Rd. #98

Set P.K. Nail
end of curbCorp. Line 2 story
Res.

Top of foundation

6124

26

P.I. 225+58.20

South of Railroad
P.K. Nail

6123

.25C

26" Maole

