

O.D.O.T. DISTRICT 2 SURVEY OFFICE (USE ONLY)

PERSONNEL

REFERENCE NO. 25 D

SHEET OF

NOTES ASTON

DATE 10/25/23

ROUTE SR 19

H.C. NIESE

WEATHER BREEZY

COUNTY OTTAWA

R.C. ASTON

TEMP. 49°

TOWNSHIP CARROLL

DWG BY BARRIERE

PID 101239

SECTION 32

T 7 N R 15 E

TYPE MONUMENT MAG NAIL/WASHER

ON SURFACE - BELOW ON

OFFSET Q PAVEMENT 2.0' LT LT : RT

 TO EDGE PAVEMENT

STATION: 232+73.71

HORIZ.DATUM: NAD 83 (2011)


GEOID: 18

GRID: NORTHING: 676433.871


EASTING: 1791845.278

LDP: NORTHING: 335930.694

EASTING: 151687.600

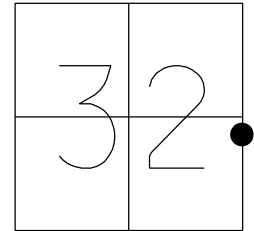

RECORD:
FD PK NAIL
3/20/07, RGN
FD PK NAIL
REF25D
11/08/07
SET MAG/WASHER
REF25D
6/30/23, TDN
SET MAG/WASHER
REF25D
10/23/23, TDN

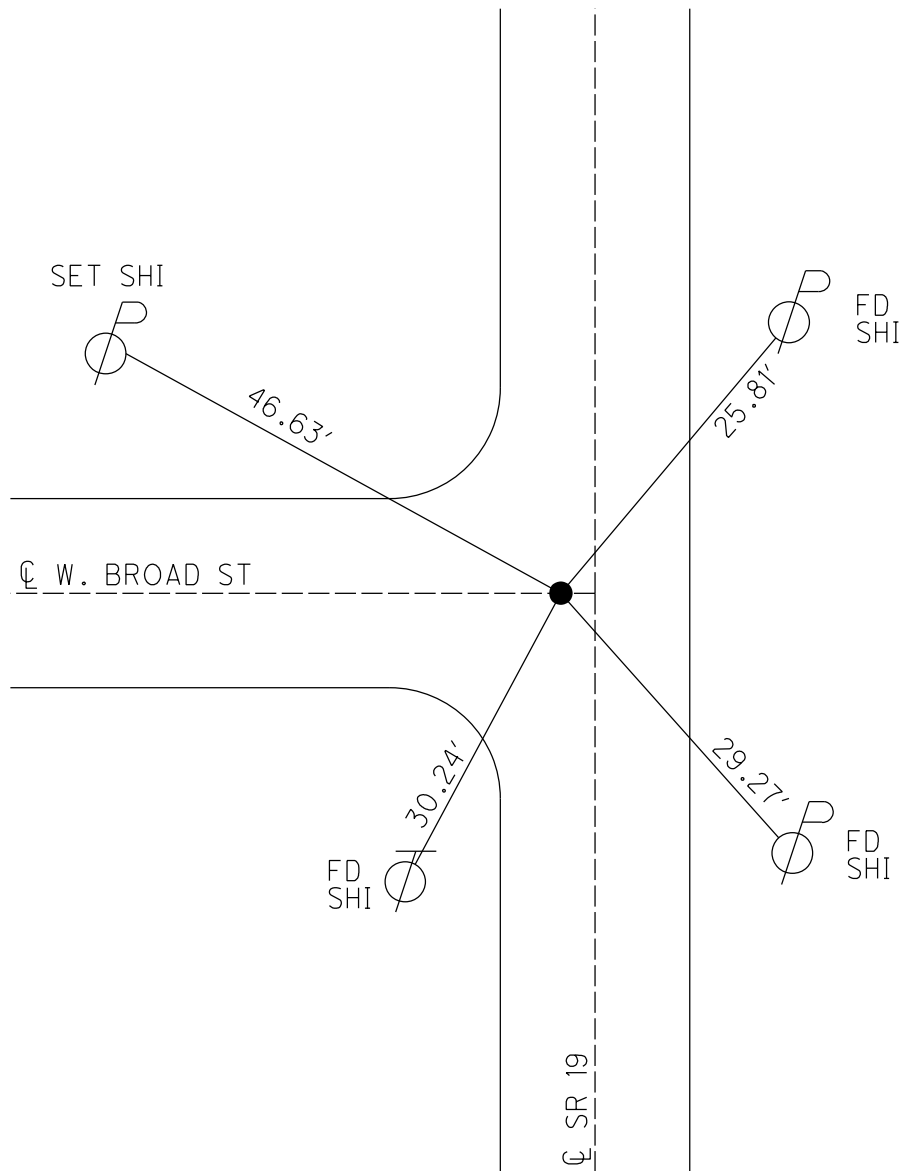

O.D.O.T. DISTRICT 2 SURVEY OFFICE (USE ONLY)

PERSONNEL

REFERENCE NO.

25 D

SHEET

14

OF 29

NOTES

HUSS

DATE

6/11/08

ROUTE

SR 19

H.C.

CANTERBURY

WEATHER

CLDY/WINDY

COUNTY

OTTAWA

R.C.

MOSER

TEMP.

59°

TOWNSHIP

SALEM

SECTION

32

T 7 N

R 15 E

TYPE MONUMENT

P.K.NAIL

ON SURFACE - ~~BELOW~~

ON

LEFT - C PAV'T - ~~RIGHT~~

2.0'


12.3' TO RT EDGE PAVEMENT

S.L.M. 232+32


GRID: NORTHING: 676433.871

EASTING:

1791845.278

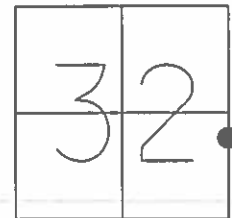

NOTE:
POINT SET
BY OTHERS

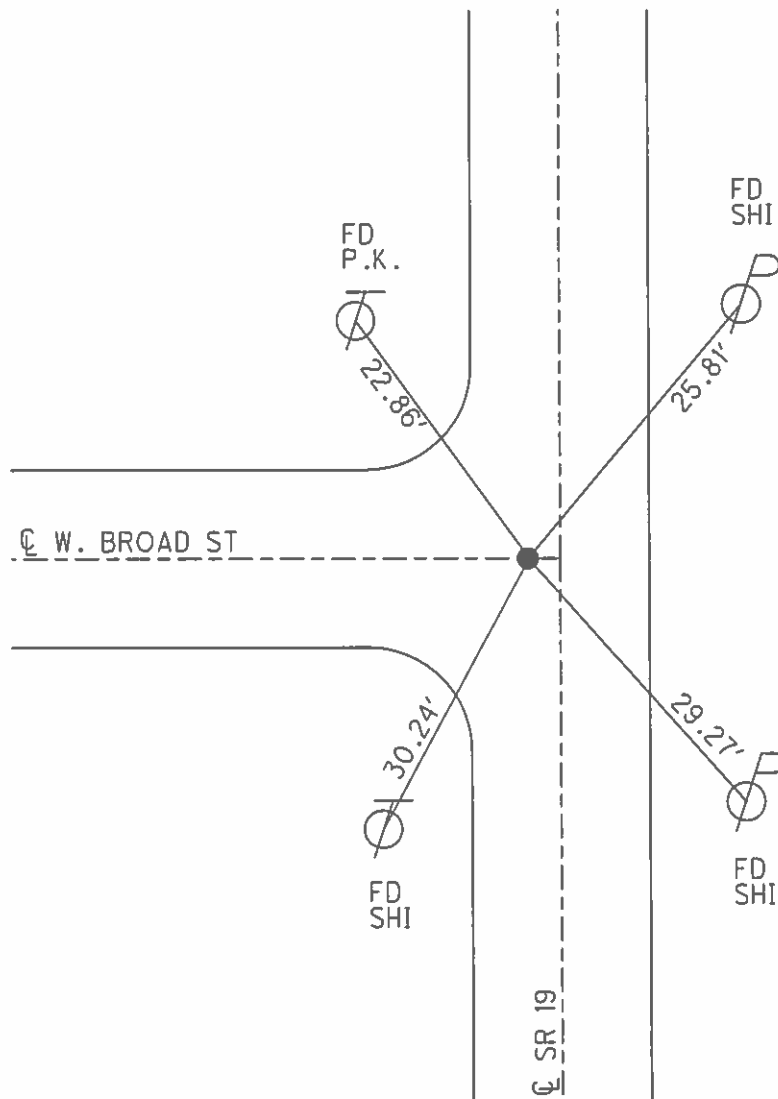

O.D.O.T. DISTRICT 2 SURVEY OFFICE (USE ONLY)

PERSONNEL

REFERENCE NO.

25 D

SHEET

18

OF 33

NOTES

HUSS

DATE

6/11/08

ROUTE

SR 19

H.C.

CANTERBURY

WEATHER

CLDY/WINDY

COUNTY

OTTAWA

R.C.

MOSER

TEMP.

59°

TOWNSHIP

SALEM

SECTION

32

T 7 N

R 15 E

TYPE MONUMENT

P.K.NAIL, (SET BY OTHERS)

ON SURFACE - ~~BELOW~~

ON

LEFT - Q PAV'T - ~~RIGHT~~



2.0'

12.3' TO RT EDGE PAVEMENT

S.L.M. 232+32

Grid: Northing: 676433.871

Easting: 1791845.278

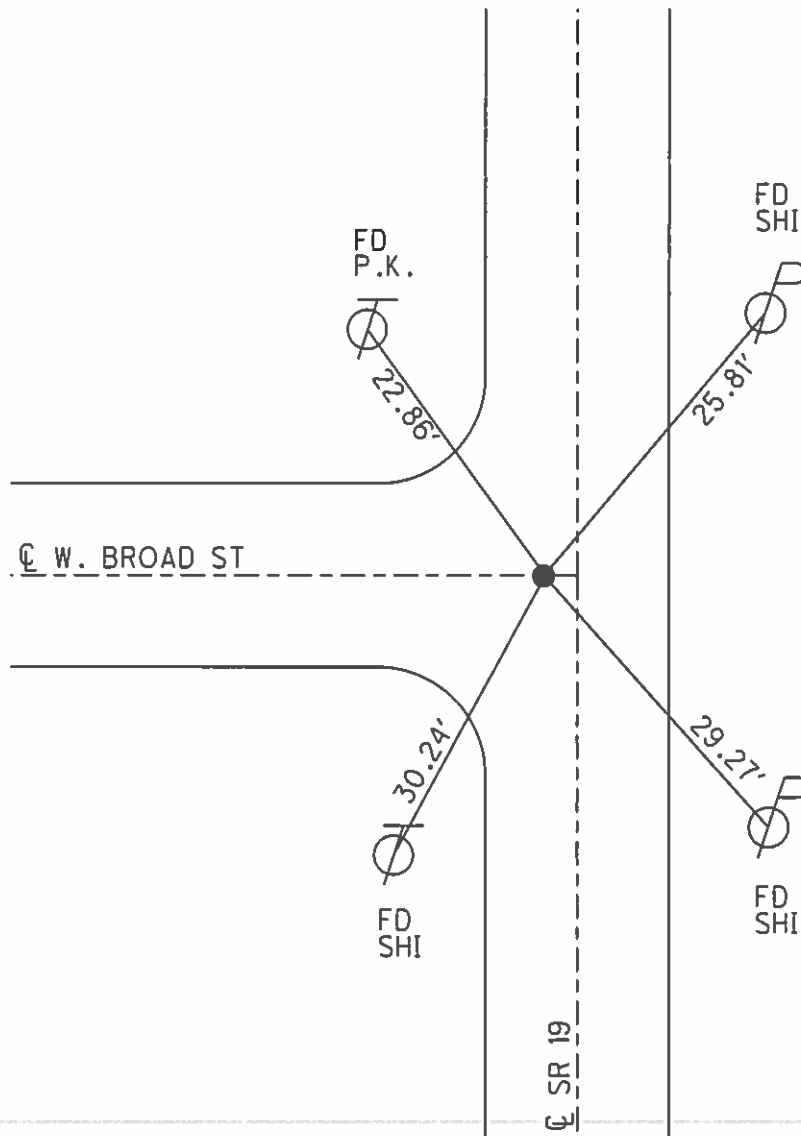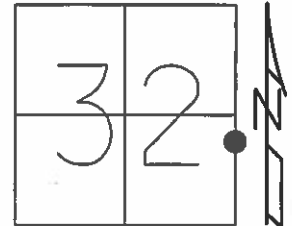

PERSONNEL TITLE PERSONNEL TITLE

COUNTY Ottawa DATE 4-25-78S. R. 19 WEATHER Fair-WindSEC. 32-33 TEMP. 50°DESCRIPTION Oak Harbor JOB NO. _____

LEFT

CENTER LINE

RIGHT

Lake St.
West

N

Both have county ties
No point in Palm t.**.25D**Broad St.
WestReset P.K. & Washer
6/6/79 70°


South Track

N.Y.C. R.R.

P.I.

225+53.20

P.K. Nail

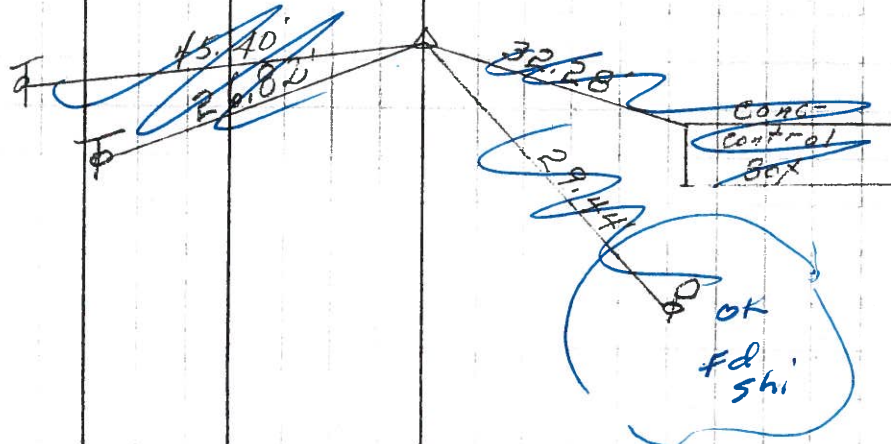25C

PERSONNEL TITLE PERSONNEL TITLE

COUNTY Ottawa DATE 4-25-78S. R. 19 WEATHER Fair-WindySEC. 32-33 TEMP. 50°DESCRIPTION Oak Harbor JOB NO.

LEFT

CENTER LINE

RIGHT

Lake St.
West

Both have County ties
No Point in Payment.

Broad St.
West

•25D

Reset P.K. & Washer
6/6/79 72°

South Track

N.Y.C. R.R.

P.I.

225+53.20

P.K. Nail

25C

