

O.D.O.T. DISTRICT 2 SURVEY OFFICE (USE ONLY)

PERSONNEL

REFERENCE NO. 26

SHEET OF

NOTES ASTON

DATE 10/25/23

ROUTE SR 19

H.C. NIESE

WEATHER BREEZY

COUNTY OTTAWA

R.C. ASTON

TEMP. 45°

TOWNSHIP CARROLL

DWG BY BARRIERE

PID 101239

SECTION 32

T 7 N R 15 E

TYPE MONUMENT MAG NAIL/WASHER

ON SURFACE - BELOW ON

OFFSET $\varnothing$ PAVEMENT 2.0' LT LT : RT

 TO EDGE PAVEMENT

STATION: 240+13.20

HORIZ.DATUM: NAD 83 (2011)


GEOID: 18

GRID: NORTHING: 677173.329


EASTING: 1791835.324

LDP: NORTHING: 336670.063

EASTING: 151672.548

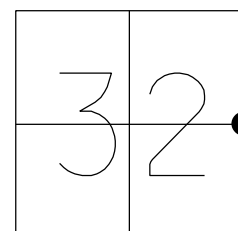

RECORD: P.I.
E.1/4 SEC. 32
CO. SET LG.R.R.SPIKE
(STEINMILLER)
8/12/68
FD P.K.NAIL
ATOP LG.R.R.SPIKE
10/10/91
FD MAG/WASHER
REF 26
5/12/20, JLL
SET MAG/WASHER
3-23-21 DSA
FD MAG/WASHER
REF26
6/29/23, TDN
SET MAG/WASHER
REF26
10/23/23, TDN

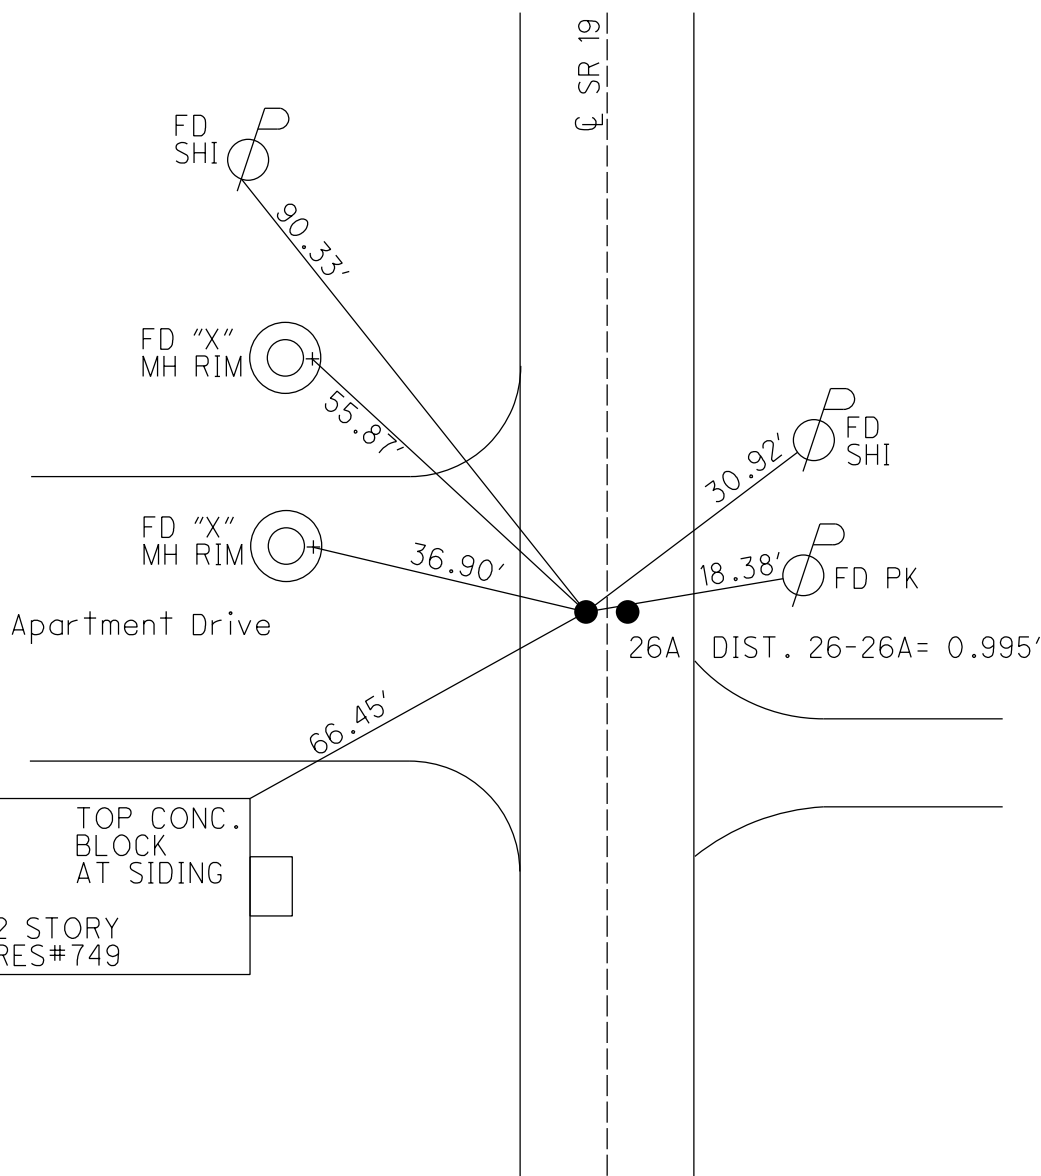

O.D.O.T. DISTRICT 2 SURVEY OFFICE (USE ONLY)

PERSONNEL

REFERENCE NO. 26

SHEET 15 OF 29

NOTES AUBLE

DATE 5/12/20

ROUTE SR 19

H.C. LEU

WEATHER SUNNY/WINDY

COUNTY OTTAWA

R.C. BALBAUGH

TEMP. 48°F

TOWNSHIP SALEM

SECTION 32

DWG BY NIESE

PID 107903

T 7 N R 15 E

TYPE MONUMENT MAG/WASHER

ON SURFACE - ~~BELOW~~ ON

OFFSET 12.0' Q PAVEMENT 1.0' LT : ~~RT~~

12.0' TO RT EDGE PAVEMENT



STATION: 240+27

HORIZ.DATUM: NAD83(2011)

GEOID: NAVD88 2012A

GRID: NORTHING: 677173.329


EASTING: 1791835.324

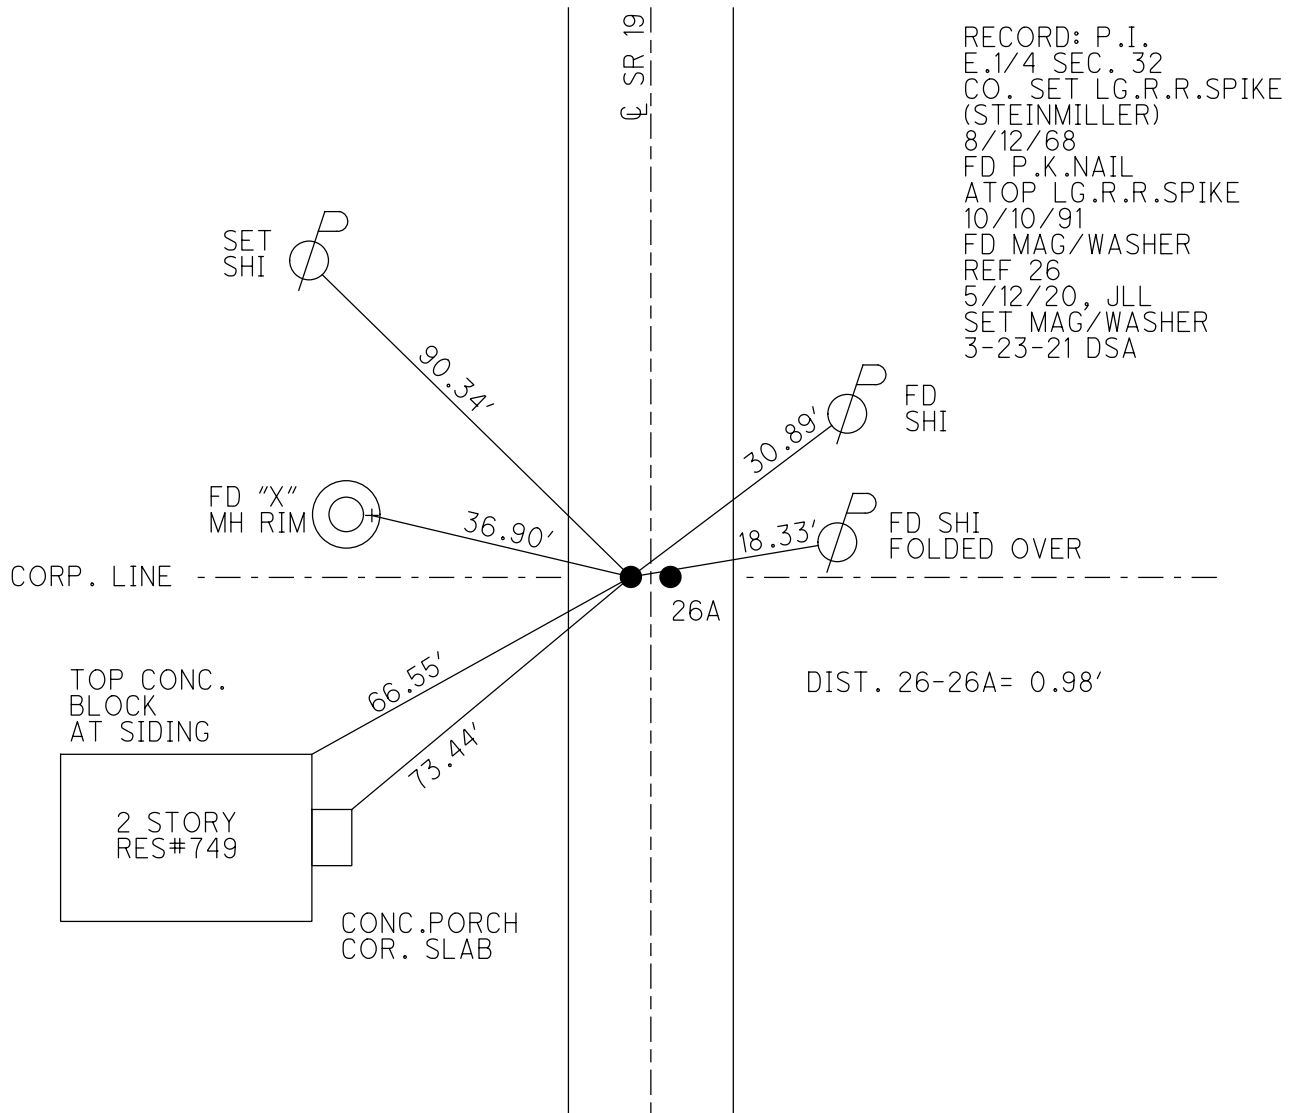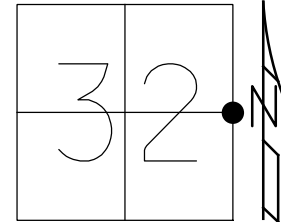

O.D.O.T. DISTRICT 2 SURVEY OFFICE (USE ONLY)

PERSONNEL _____ REFERENCE NO. 26 SHEET 15 OF 29
 NOTES HUSS DATE 6/17/08 ROUTE SR 19
 H.C. CANTERBURY WEATHER CLDY/WINDY COUNTY OTTAWA
 R.C. MOSER TEMP. 59° TOWNSHIP SALEM
 _____ SECTION 32
 _____ T 7 N R 15 E


TYPE MONUMENT SM RR SPIKE
 ON SURFACE - ~~BELOW~~ ON
 LEFT - ℄ PAV'T - ~~RIGHT~~ 0.5'
11.52' TO RT EDGE PAVEMENT
 S.L.M. 240+27

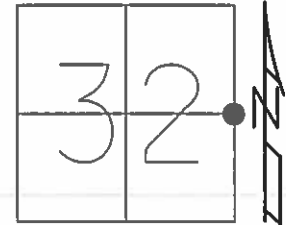

GRID: NORTHING: 677173.353 EASTING: 1791835.275

NOTE:
 10/10/91
 P.I. AND OAK HARBOR
 CORP.LINE.

RECORD:
 COUNTY SET LG RR SPIKE,
 (STEINMILLER),
 8/12/68
 E. 1/4 POST OF SEC.32
 P.K.NAIL ON TOP

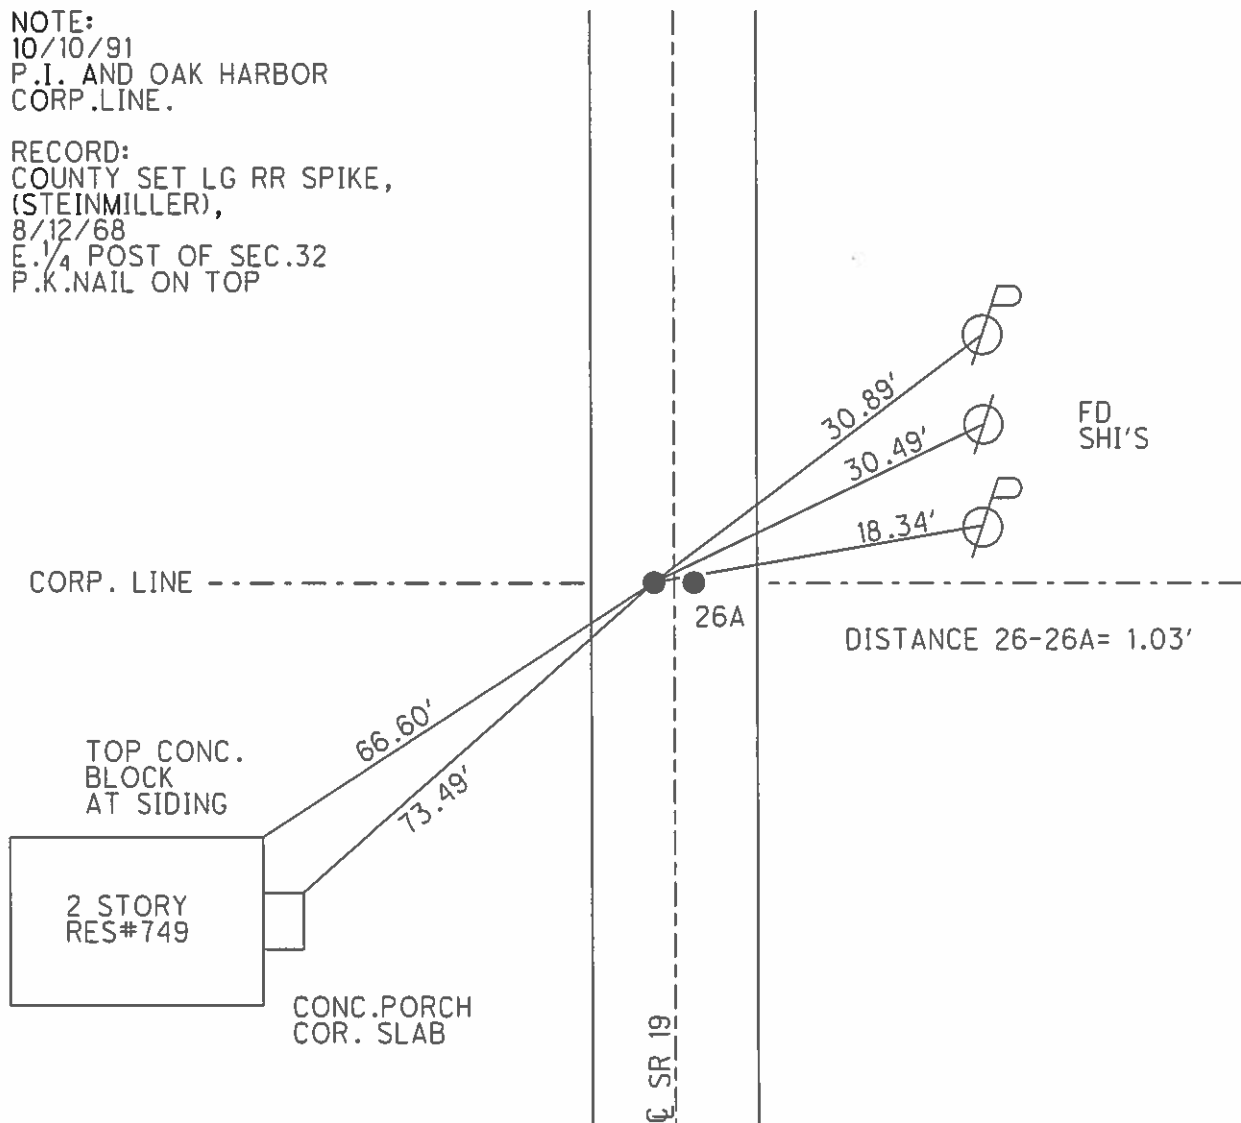


O.D.O.T. DISTRICT 2 SURVEY OFFICE (USE ONLY)

PERSONNEL	REFERENCE NO. <u>26</u>	SHEET <u>19</u> OF <u>33</u>
NOTES <u>HUSS</u>	DATE <u>6/17/08</u>	ROUTE <u>SR 19</u>
H.C. <u>CANTERBURY</u>	WEATHER <u>CLDY/WINDY</u>	COUNTY <u>OTTAWA</u>
R.C. <u>MOSER</u>	TEMP. <u>59°</u>	TOWNSHIP <u>SALEM</u>
		SECTION <u>32</u>
		T <u>7</u> N R <u>15</u> E


TYPE MONUMENT SM.R.R.SPIKE
 ON SURFACE - ~~BELOW~~ ON
 LEFT - Q PAV'T - ~~RIGHT~~ 0.5'
11.52' TO RT EDGE PAVEMENT
 S.L.M. 240+27

Grid: Northing: 677173.353 Easting: 1791835.275

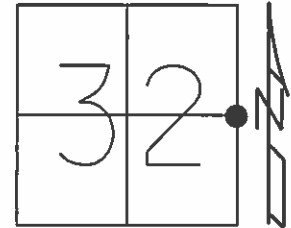

NOTE: 10/10/91
P.I. AND OAK HARBOR
CORP.LINE.

COUNTY SET LG.R.R.SPIKE,
(STEINMILLER), 8/12/68
E. 1/4 POST OF SEC.32
P.K.NAIL ON TOP

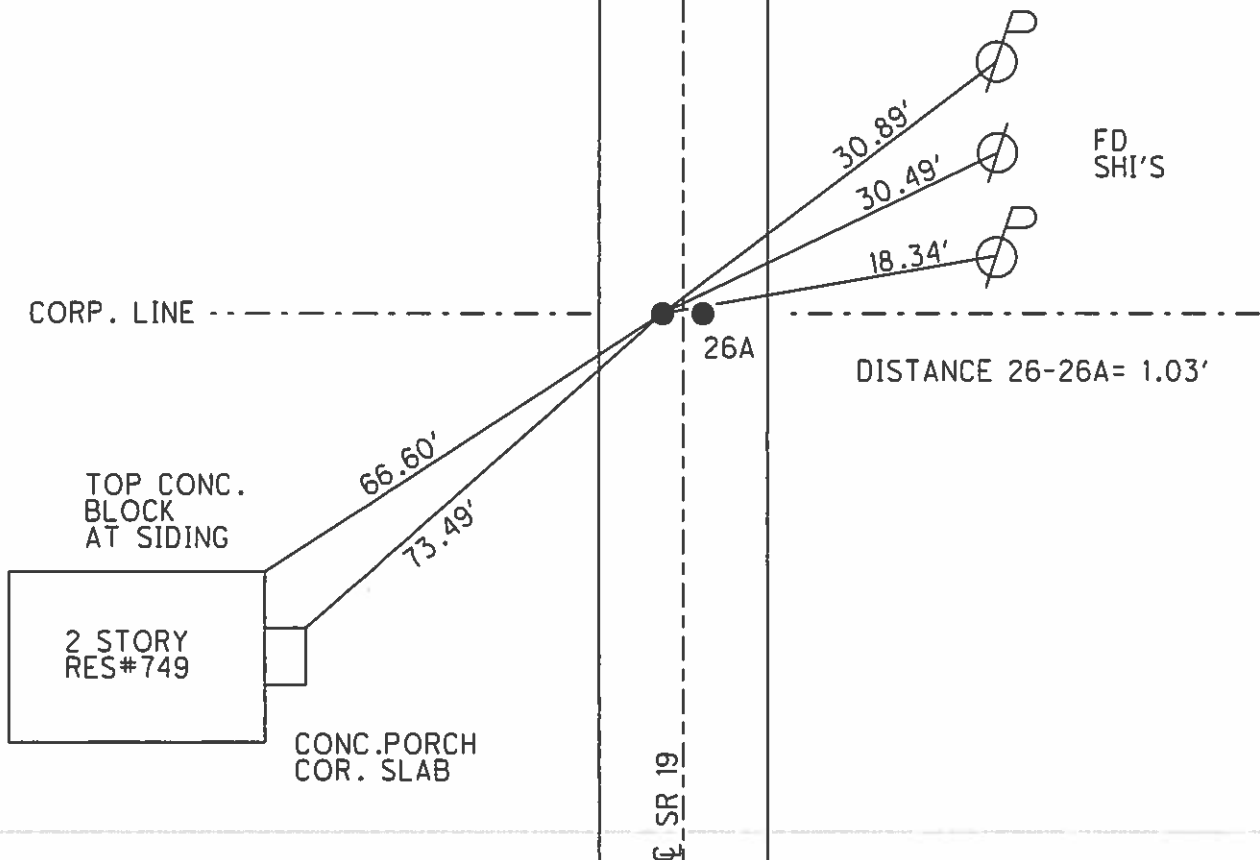

O.D.O.T. DISTRICT 2 SURVEY OFFICE

PERSONNEL

REFERENCE NO. 26

SHEET 1 OF 11

NOTES Cheney

H.C. BARBOUR

R.C. RIPPLE

DATE 10/10/91

WEATHER Sunny

TEMP. 60°

ROUTE SR# 19

COUNTY OTTAWA

TOWNSHIP SALEM

SECTION 32 & 33

T. 7 N R. 15 E


TYPE MONUMENT Set Two P.K. Nails

ON SURFACE - BELOW

LEFT - CL PAV'T. - RIGHT 0.5'

8'x9' TO RT. EDGE PAVEMENT


S.L.M. 240+27

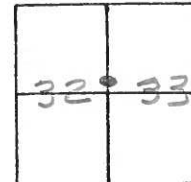

P.I. & OAK HARBOUR Corp. Line

County Set R.R. Spk. P.K. Nail
ON Top.

P.K. Nail ATOP SMALL Spk.

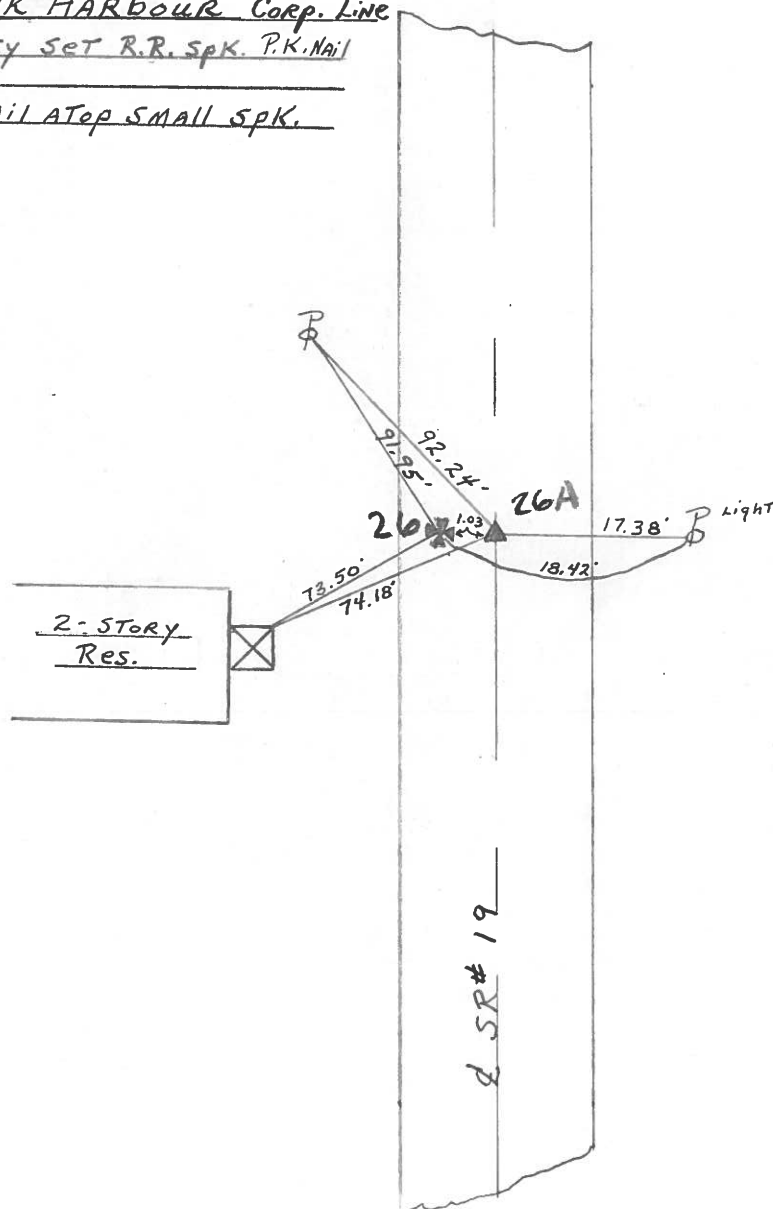

PERSONNEL TITLE PERSONNEL TITLE

COUNTY Ottawa DATE 5-4-71S. R. 19 WEATHERSEC. 32 & 33 TEMP.DESCRIPTION Oak Harbor & 1 point North JOB NO.

LEFT

CENTER LINE

RIGHT

266+58
F.d. P.K. Nail
5' n't. of E

See
New
TIES

27

P.K. Nail

2-story
Res.

See
New
TIES


• 26

P.I.

225+53.20

P.K. Nail

250

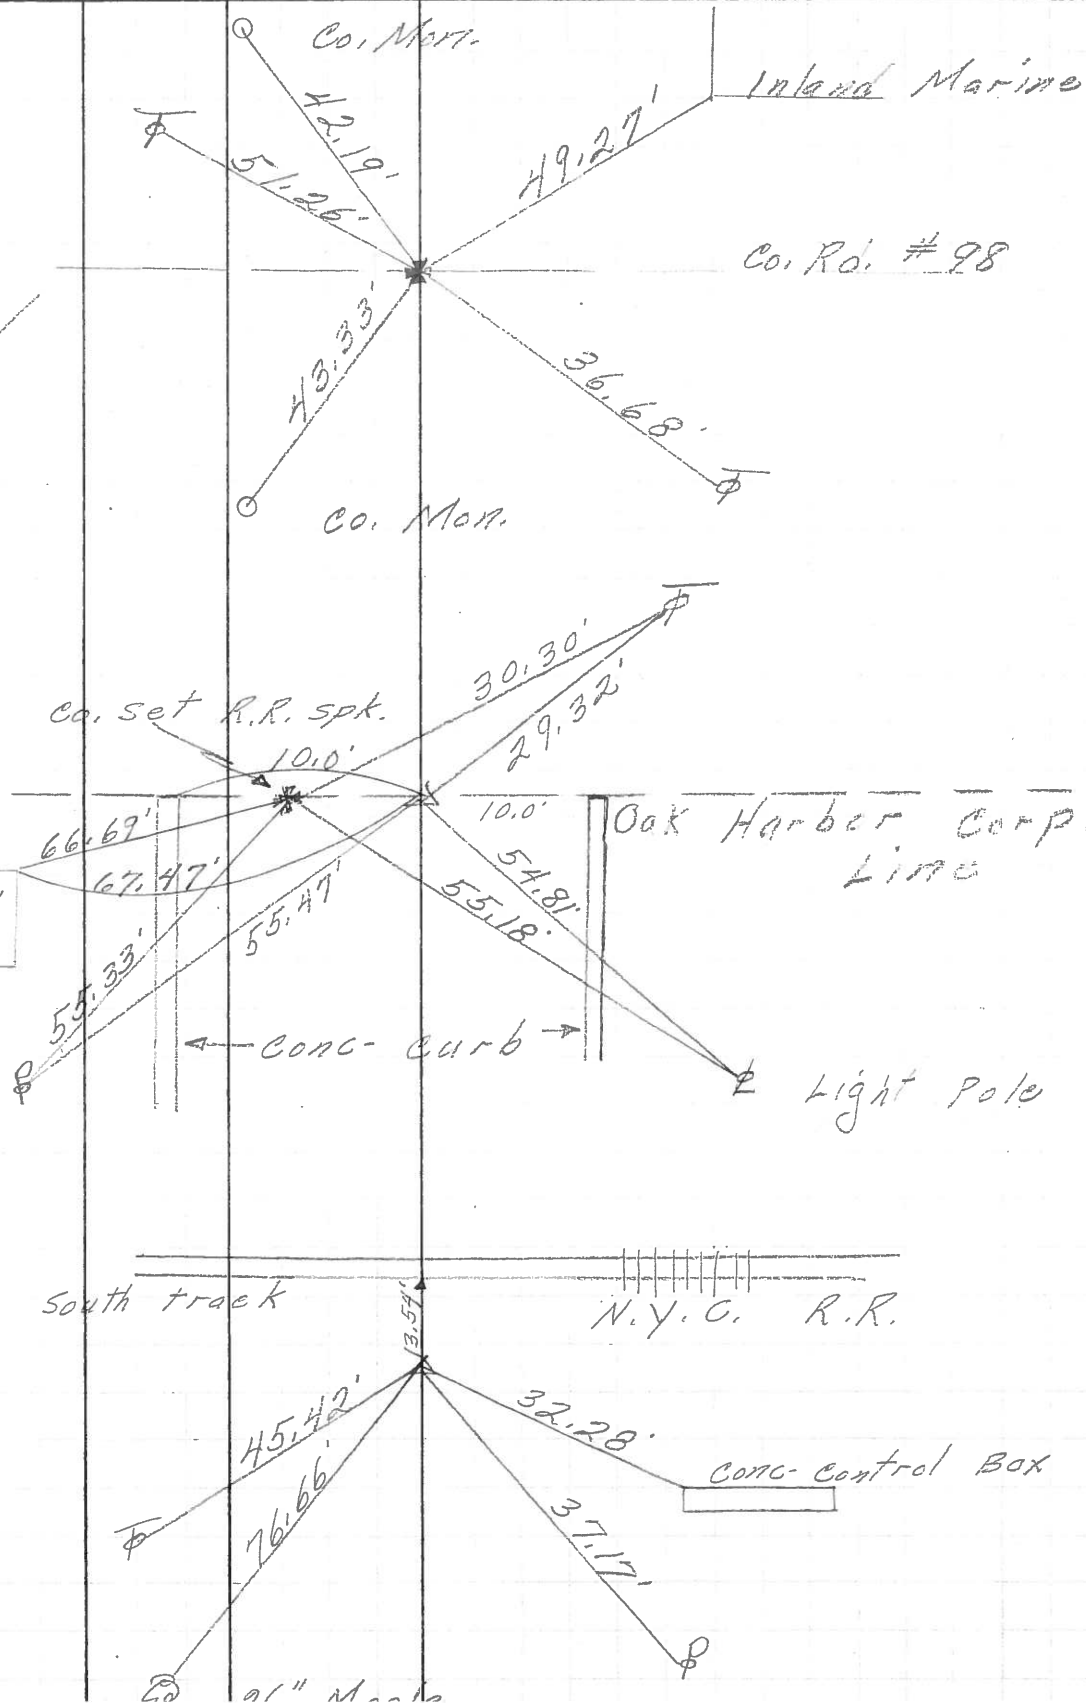

PERSONNEL	TITLE	PERSONNEL	TITLE	COUNTY	DATE	S. R.	WEATHER	SEC.	TEMP.	DESCRIPTION	LEFT	CENTER LINE	RIGHT	JOB NO.
Schneider				Ottawa	5-13-68	19	Fair	Oak Harbor North	65°	Ties for Control Points				
Masser														
Barbour														
Redding														

