

O.D.O.T. DISTRICT 2 SURVEY OFFICE (USE ONLY)

PERSONNEL

REFERENCE NO. 26 A

SHEET OF

NOTES ASTON

DATE 10/25/23

ROUTE SR 19

H.C. NIESE

WEATHER SUNNY

COUNTY OTTAWA

R.C. ASTON

TEMP. 45°

TOWNSHIP CARROLL

SECTION 32

DWG BY BARRIERE

PID 101239

T 7 N R 15 E

TYPE MONUMENT MAG NAIL/WASHER

ON SURFACE - BELOW ON

OFFSET $\angle$ PAVEMENT 2.0' LT LT : RT

 TO EDGE PAVEMENT

STATION: 240+13.32

HORZ.DATUM: NAD 83 (2011)


GEOID: 18

GRID: NORTHING: 677173.391


EASTING: 1791836.327

LDP: NORTHING: 336670.208

EASTING: 151673.530

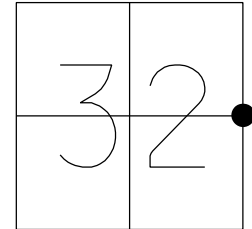

RECORD:
FD P.K. NAIL
ATOP SM.R.R.SPIKE
10/10/91
SET MAG/WASHER
10/26/09, SAH
FD MAG/WASHER
REFA26
5/12/20, JLL
SET MAG/WASHER
3/23/21, DSA
FD MAG/WASHER
REF26A
6/29/23, TDN
SET MAG/WASHER
REF26A
10/23/23, TDN

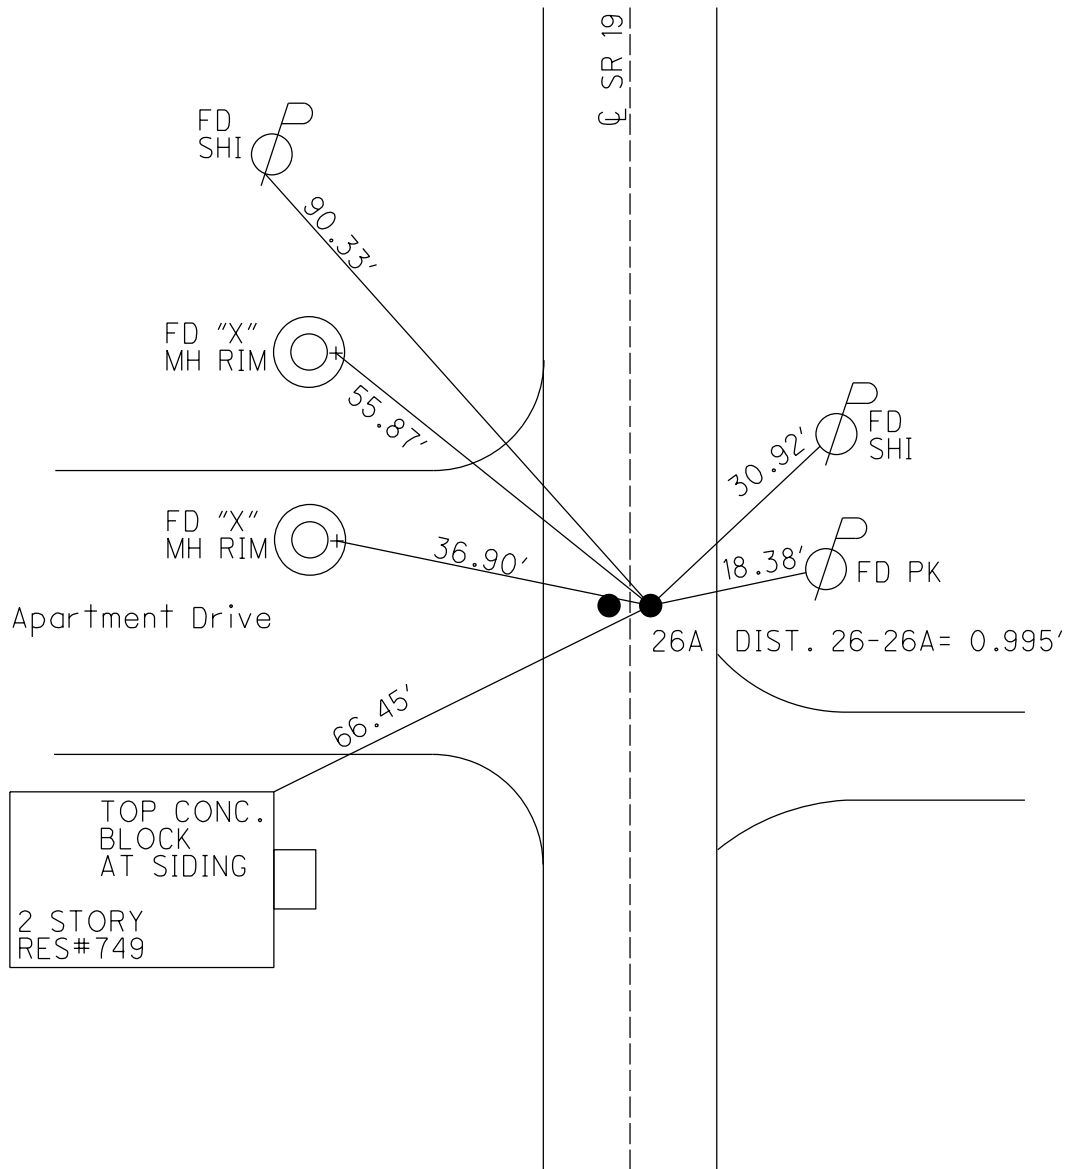

O.D.O.T. DISTRICT 2 SURVEY OFFICE (USE ONLY)

PERSONNEL

REFERENCE NO. 26 A

SHEET 16 OF 29

NOTES AUBLE

DATE 5/12/20

ROUTE SR 19

H.C. LEU

WEATHER SUNNY/WINDY

COUNTY OTTAWA

R.C. BALBAUGH

TEMP. 48°F

TOWNSHIP SALEM

SECTION 32

DWG BY NIESE

PID 107903

T 7 N R 15 E

TYPE MONUMENT MAG/WASHER

ON SURFACE - ~~BELOW~~ ON

OFFSET Q PAVEMENT ON ~~LT:RT~~

11.0' TO RT EDGE PAVEMENT


STATION: 240+27

HORZ.DATUM: NAD83(2011)


GEOID: NAVD88 2012A

GRID: NORTHING: 677173.391

EASTING: 1791836.327

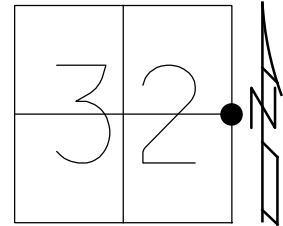

RECORD:
FD P.K. NAIL
ATOP SM.R.R.SPIKE
10/10/91
SET MAG/WASHER
10/26/09, SAH
FD MAG/WASHER
REFA26
5/12/20, JLL
SET MAG/WASHER
3-23-21 DSA

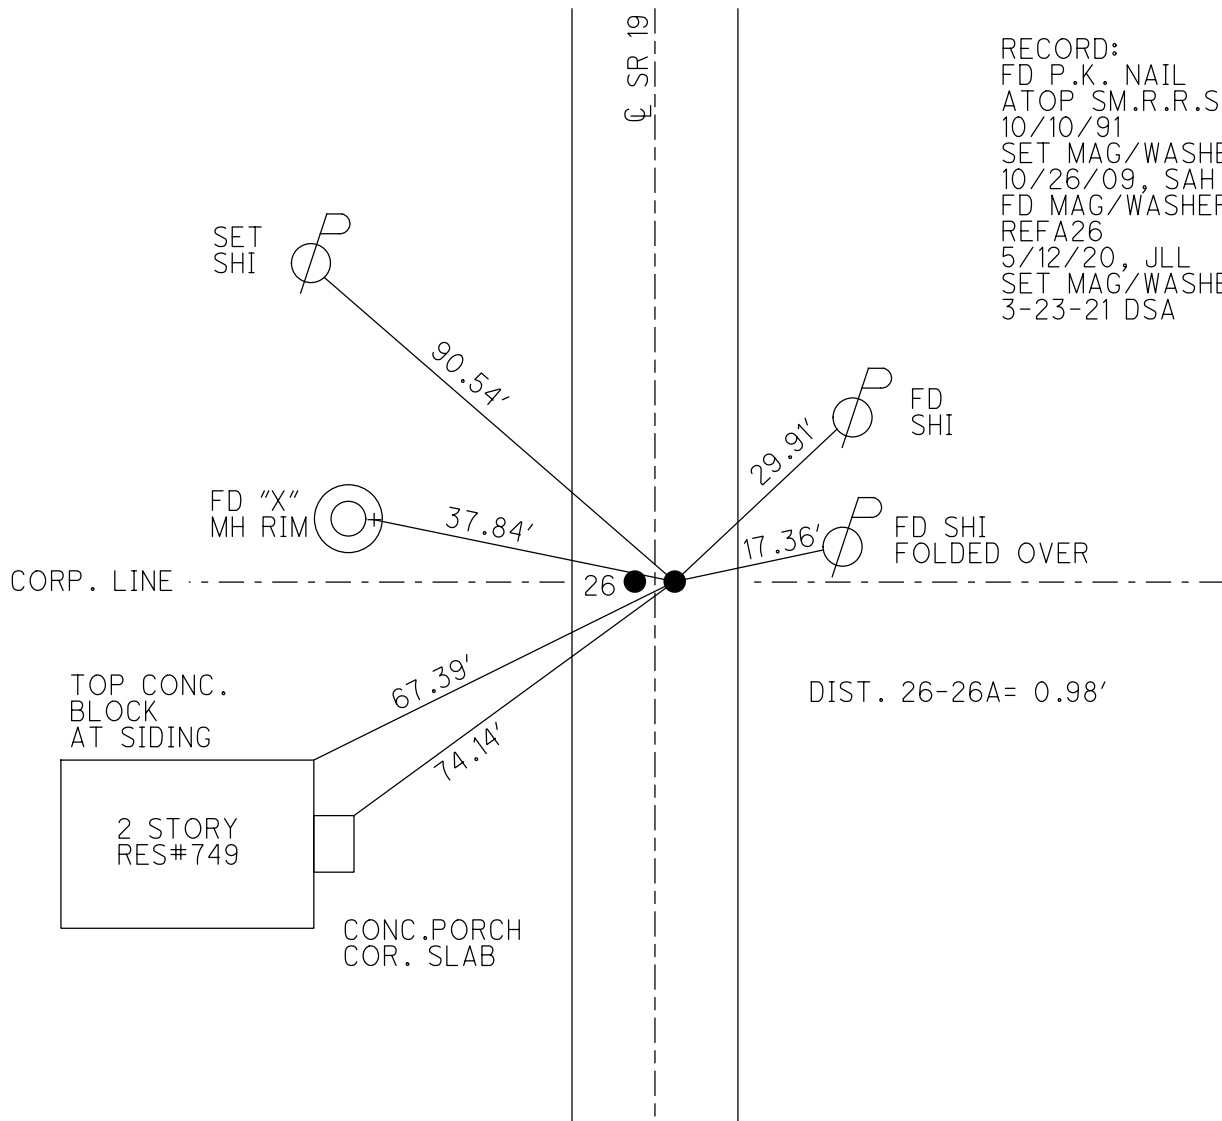

O.D.O.T. DISTRICT 2 SURVEY OFFICE (USE ONLY)

PERSONNEL

REFERENCE NO.

26 A

SHEET

16

OF 29

NOTES HUSS

DATE

6/17/08

ROUTE

SR 19

H.C. CANTERBURY

WEATHER

CLDY/WINDY

COUNTY

OTTAWA

R.C. MOSER

TEMP.

59°

TOWNSHIP

SALEM

SECTION

32

T 7 N R 15 E

TYPE MONUMENT MAG NAIL


ON SURFACE - ~~BELOW~~ ON

~~LEFT~~ - C PAV'T - RIGHT 0.5'

10.55' TO RT EDGE PAVEMENT

S.L.M. 240+27

GRID: NORTHING: 677173.426 EASTING: 1791836.315

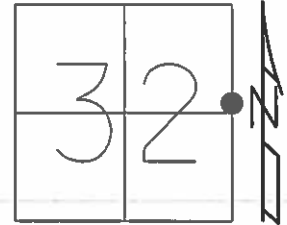


NOTE:

10/10/91
FD P.K.NAIL ATOP
SM RR SPIKE

RECORD:


SET MAG/WASHER
10/26/09, SAH

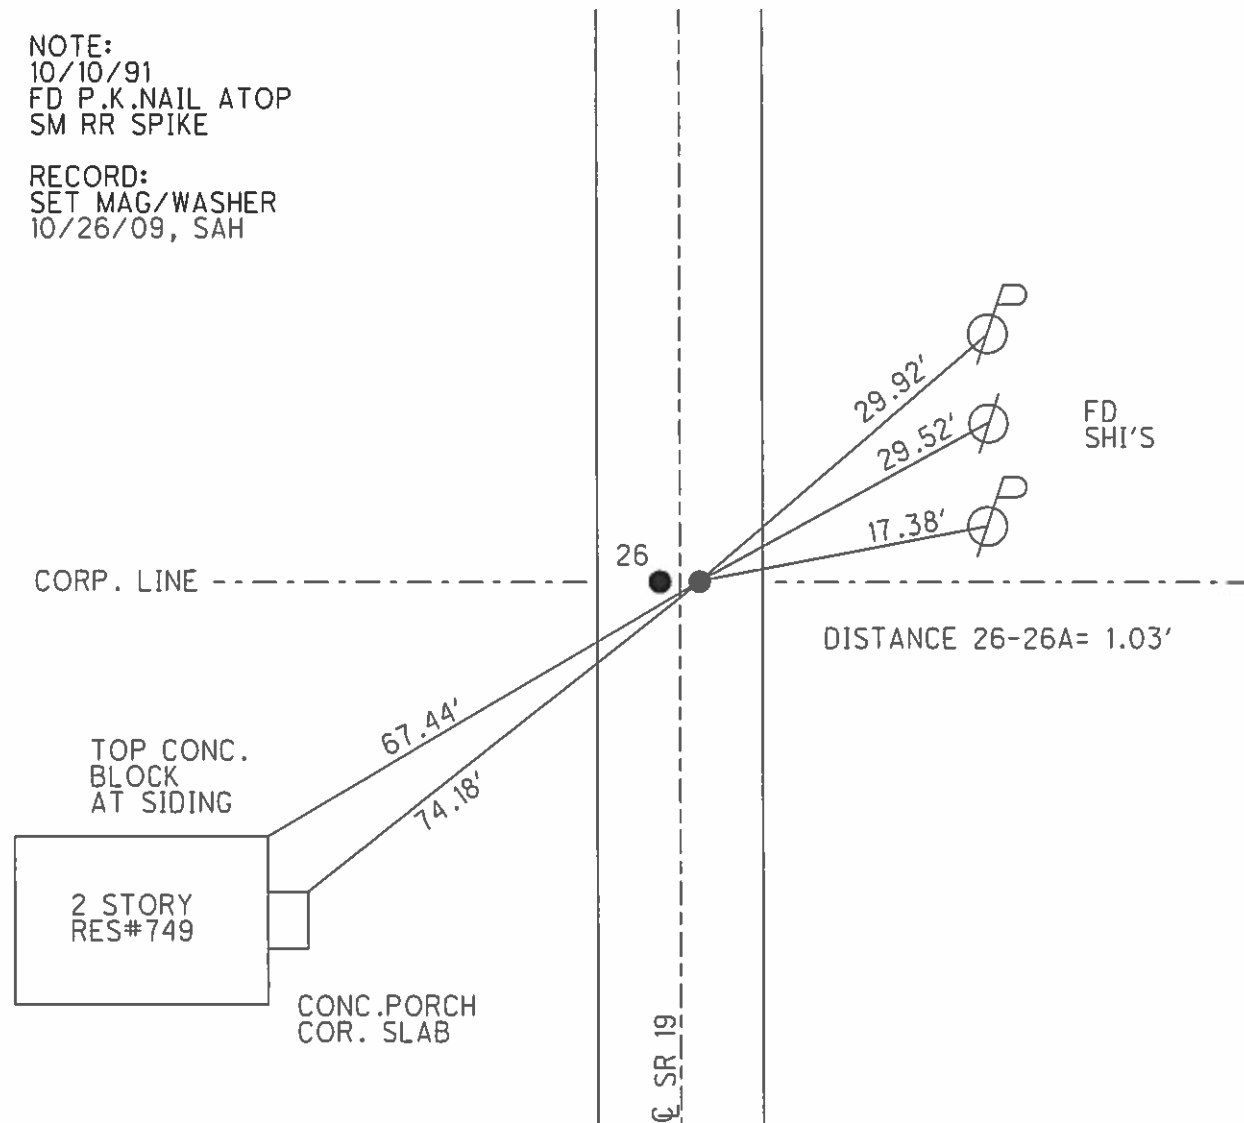

O.D.O.T. DISTRICT 2 SURVEY OFFICE (USE ONLY)

PERSONNEL	REFERENCE NO.	26 A	SHEET	20	OF	33
NOTES	HUSS	DATE	6/17/08	ROUTE	SR 19	
H.C.	CANTERBURY	WEATHER	CLDY/WINDY	COUNTY	OTTAWA	
R.C.	MOSER	TEMP.	59°	TOWNSHIP	SALEM	
				SECTION	32	
				T	7 N	R 15 E


TYPE MONUMENT MAG NAIL
 ON SURFACE - ~~BELOW~~ ON
~~LEFT~~ - CL PAV'T - RIGHT 0.5'
10.55' TO RT EDGE PAVEMENT
 S.L.M. 240+27

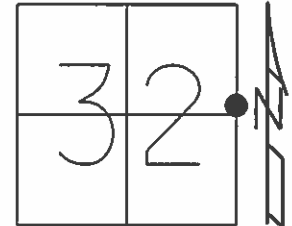

Grid: Northing: 677173.426 Easting: 1791836.315

NOTE: 10/10/91
 FD P.K.NAIL ATOP
 SM.R.R.SPIKE

SET MAG/WASHER
 10/26/09, SAH

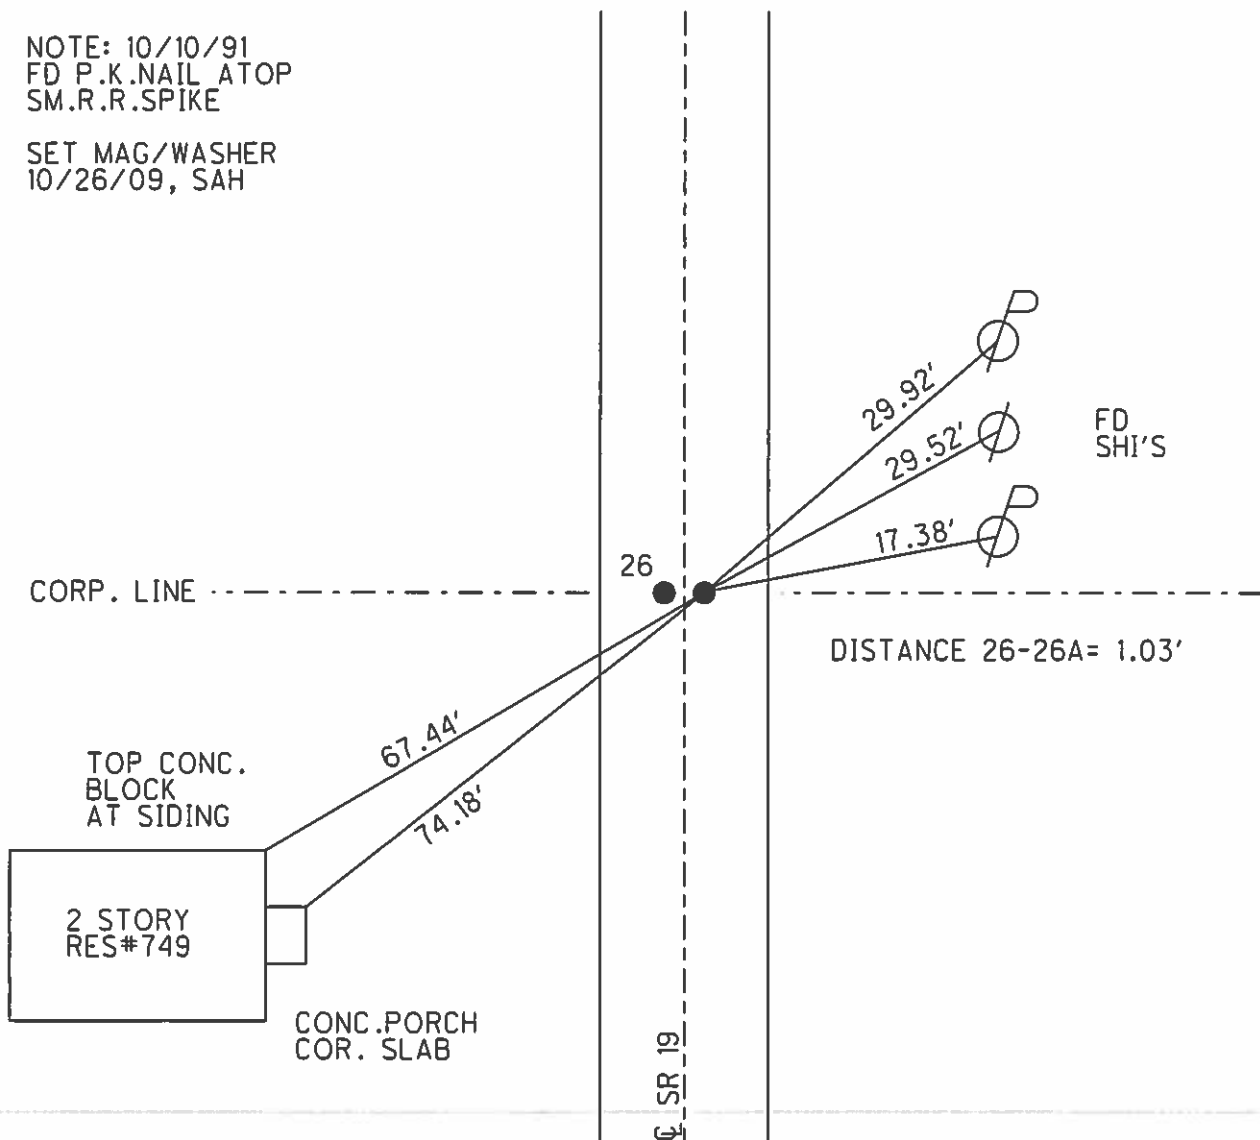

O.D.O.T. DISTRICT 2 SURVEY OFFICE

PERSONNEL

REFERENCE NO. 26

SHEET 1 OF 11

NOTES Cheney

H.C. BARBOUR

R.C. RIPPLE

DATE 10/10/91

WEATHER Sunny

TEMP. 60°

ROUTE SR# 19

COUNTY OTTAWA

TOWNSHIP SALEM

SECTION 32 & 33

T. 7 N R. 15 E


TYPE MONUMENT Set Two P.K. Nails

ON SURFACE - BELOW

LEFT - CL PAV'T. - RIGHT 0.5'

8'x9' TO RT. EDGE PAVEMENT


S.L.M. 240+27

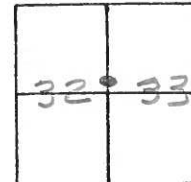

P.I. & OAK HARBOUR Corp. Line

County Set R.R. Spk. P.K. Nail
ON Top.

P.K. Nail ATOP SMALL Spk.

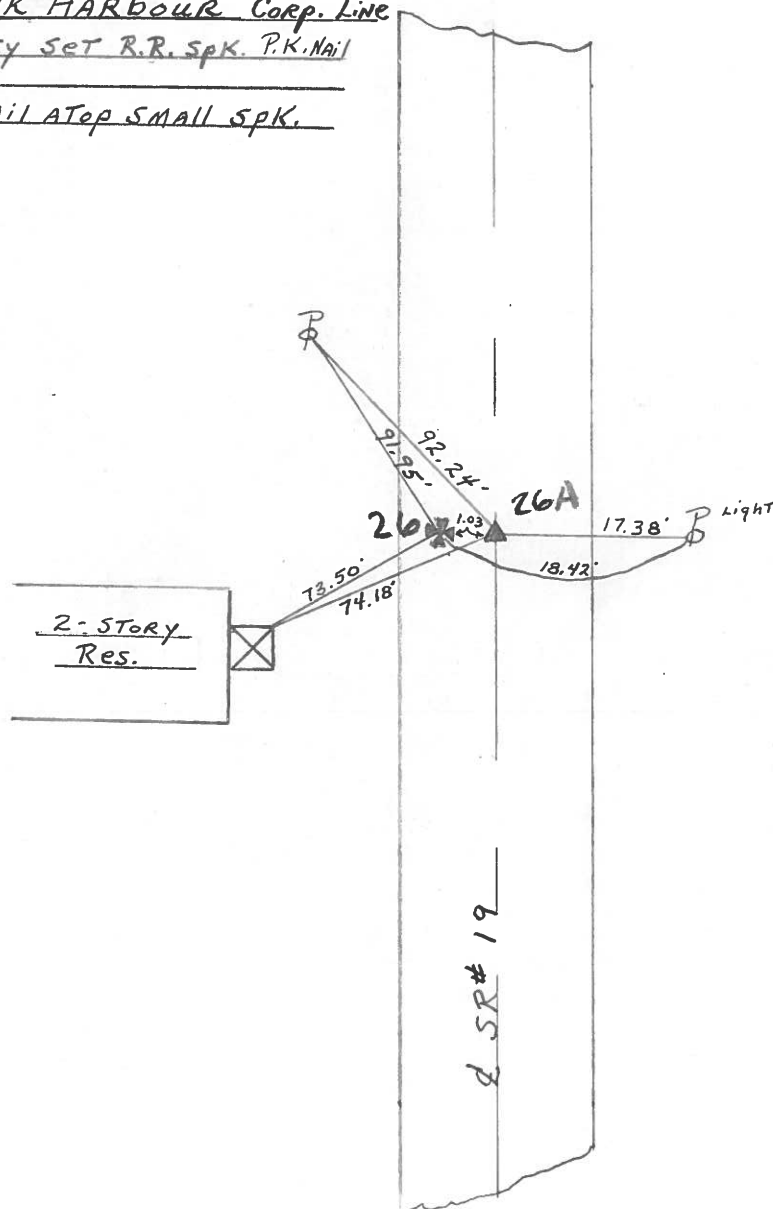

PERSONNEL TITLE PERSONNEL TITLE

COUNTY Ottawa DATE 5-4-71S. R. 19 WEATHERSEC. 32 & 33 TEMP.DESCRIPTION Oak Harbor & 1 point North JOB NO.

LEFT

CENTER LINE

RIGHT

266+58
F.d. P.K. Nail
5' n't. of E

See
New
TIES

27

P.K. Nail

2-story
Res.

See
New
TIES

• 26

P.I.

225+53.20

P.K. Nail

250

