


O.D.O.T. DISTRICT 2 SURVEY OFFICE (USE ONLY)


PERSONNEL	REFERENCE NO. <u>39</u>	SHEET <u>9</u> OF <u>17</u>
NOTES <u>ASTON</u>	DATE <u>5/13/24</u>	ROUTE <u>SR 163</u>
H.C. <u>NIESE</u>	WEATHER <u>WINDY</u>	COUNTY <u>OTTAWA</u>
R.C. <u>PRESTON-COLVIN</u>	TEMP. <u>75°</u>	TOWNSHIP <u>SALEM</u>
<u>MILLER & BLUBAUGH</u>		SECTION <u>6</u>
DWG BY <u>ASTON</u>	PID <u>101239</u>	T <u>6</u> N R <u>15</u> E

TYPE MONUMENT MAG/WASHER
 ON SURFACE - ~~BELOW~~ ON
 OFFSET CL PAVEMENT 27.2' LT : RT
2.5' TO RT EDGE PAVEMENT
 STATION: 659+40.78

HORZ.DATUM: NAD83(2011) GEOID: 18
 GRID: NORTHING: 674656.053 EASTING: 1783950.297

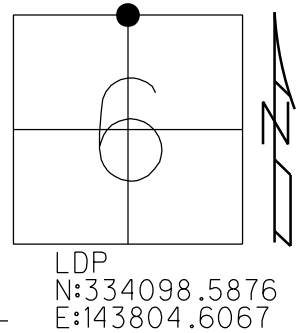

RECORD: P.I.
 STA 659+40.78
 FD P.K. NAIL
 SET P.K. NAIL
 8/13/76
 D.N.F.
 1993
 FD HOLE
 REF39
 7-3-23, TDN
 SET MAG/WASHER
 5-13-24, TDN

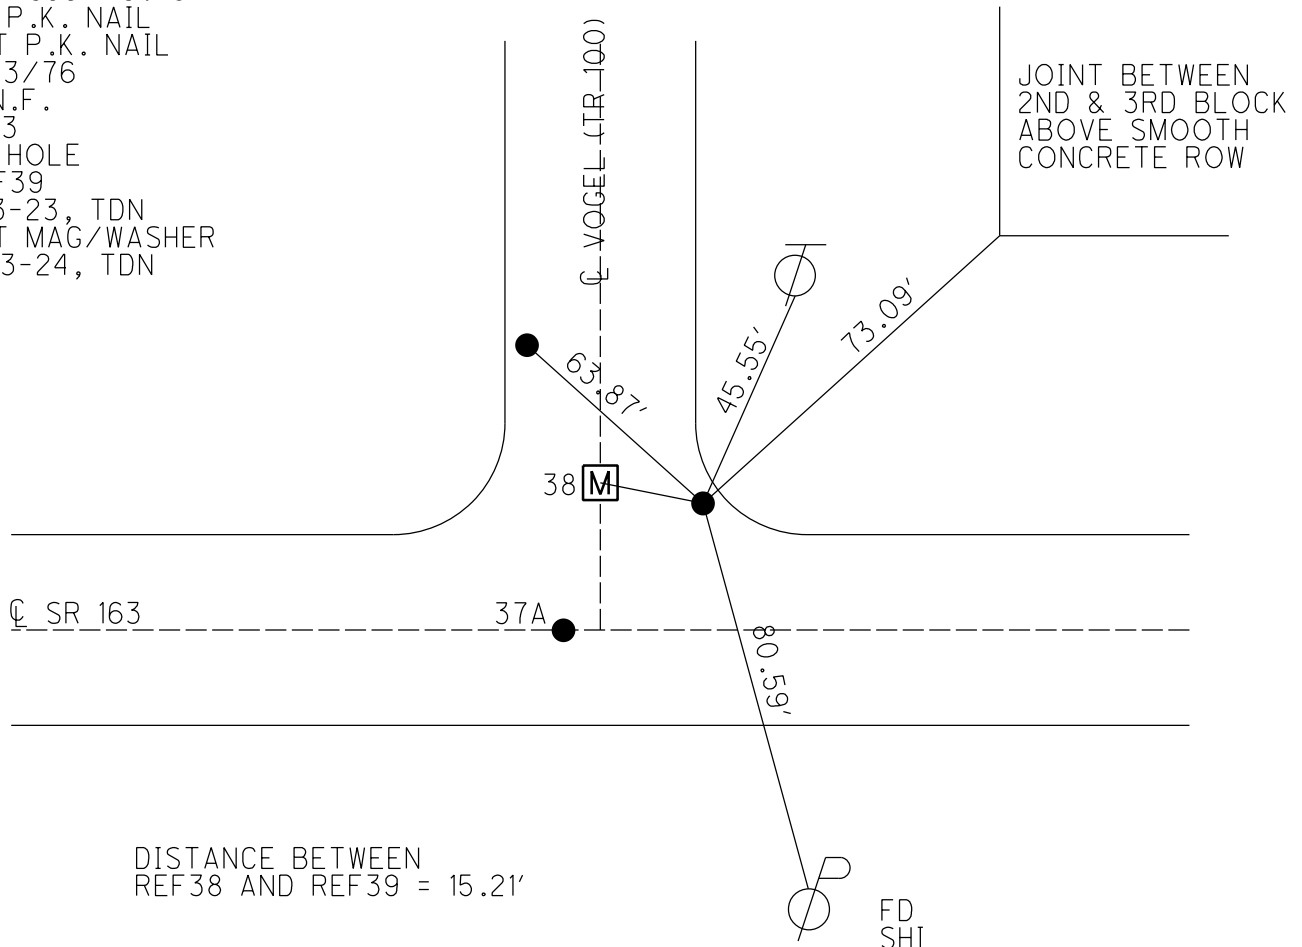

O.D.O.T. DISTRICT 2 SURVEY OFFICE (USE ONLY)

PERSONNEL

REFERENCE NO. 39

SHEET 9 OF 17

NOTES CHENEY

DATE 8/13/76

ROUTE SR 163

H.C. RIPPLE

WEATHER FAIR

COUNTY OTTAWA

R.C. BARBOUR

TEMP. 80°

TOWNSHIP SALEMSECTION 6

DWG BY NIESE PID

T_6_N R_15_E

TYPE MONUMENT P.K. NAIL

ON SURFACE - ~~BELOW~~ _____ ON

OFFSET C PAVEMENT _____ LT : RT

_____TO_____EDGE PAVEMENT


STATION: 659+40.78

HORZ.DATUM: _____


GEOID: _____

GRID: NORTHING: _____

EASTING: _____

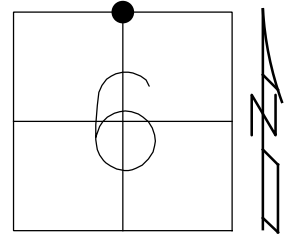

RECORD: P.I.
STA 659+40.78
FD P.K. NAIL
SET P.K. NAIL
8/13/76
D.N.F.
1993

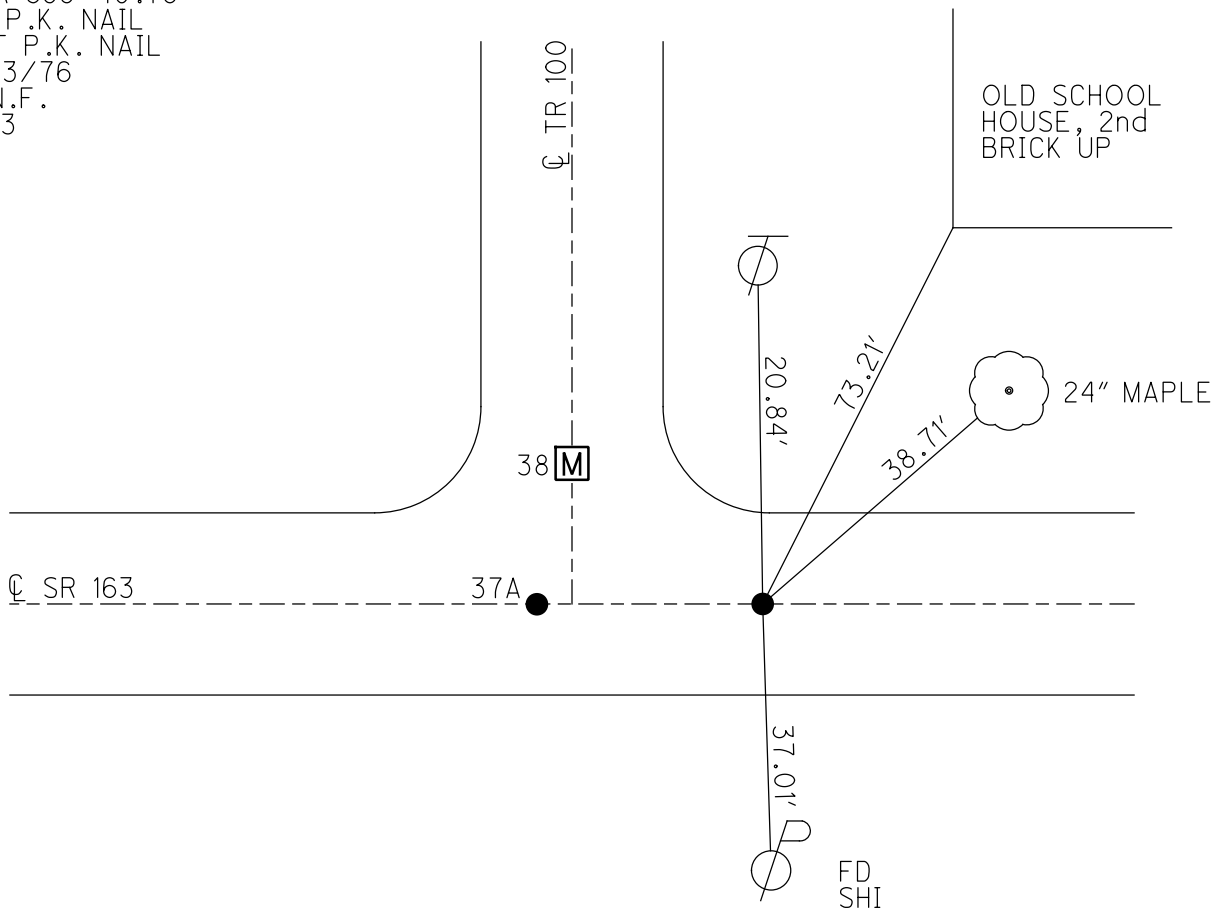

O.D.O.T. DISTRICT 2 SURVEY OFFICE

PERSONNEL

REFERENCE NO. 38-39 SHEET 19 OF 24

NOTES CHENEY

H.C. RIPPLE

R.C. BARBOUR

DATE 6-17-1993

WEATHER FAIR

TEMP. 80°

ROUTE #163

COUNTY OTAWA

TOWNSHIP SALEM

SECTION 6, 31

T 6 N R 15 E


TYPE MONUMENT MONUMENT Box

ON SURFACE - BELOW ON

LEFT - 0 PAV'T. - RIGHT 23'

11' RT. TO RT. EDGE PAVEMENT

S.L.M. 660+40

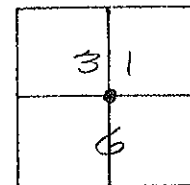

RECORD: 8-13-1976

P.I. STA. 659+40.78 (DID NOT FIND 1993)

PK. NAIL

RESET PK. NAILS

659+25.55 (Mon. Box 1993)

SET PK. NAIL

COUNTY SET RR. SPK.

ON SEC. LINE SOUTH

RESET SMALL SPK.

(DID NOT FIND 1993)

* NOTE: SEE SHEET No. 13
8-13-1976 REF.

Box 15 UP

9-27-1993

RCC

OLD SCHOOL
HOUSE

TOP OF
2ND BLOCK

Fd Mon. Box

T.R. #100

P Fd. N/S.
SW. SIDE

59.3'

87.4'

0. PAV'T.

S.R. #163

78.4'



Fd. N/S.
N. SIDE

Preventive Maintenance
Microsurfaced 2000
Existing Point Uncovered
Date 5-15-00

PERSONNEL TITLE PERSONNEL TITLE

COUNTY Ottawa DATE 8-13-76S. R. 163 WEATHER FairSEC. 36-31 1/2 1-6 TEMP. 80°DESCRIPTION Benton, Harris, Salem Townships JOB NO.

LEFT

CENTER LINE

RIGHT

P.I. 40

672+13.07

Ed. P.K. Nail on surface

Reset P.K. Nail

P.I. 37

659+40.73

P.K. Nail

Reset P.K. Nails

659+25.55

Set P.K. Nail

38

Go set R.R. spk.

24" Maple
old school
House
Top 2nd grade
20.84
Twp. Rd. #100
North

Reset small spk.
Sec. line
south

P.I.

632+69.53

Ed. 1 1/2" Pipe

5" down

Reset P.K. Nail

Carroll Twp.

Benton
Twp.

Salem Twp.

Gen. Rd. #23

Harris Twp.

37

PERSONNEL TITLE PERSONNEL TITLE

COUNTY OttawaDATE 3-3-66S. R. 163

WEATHER

SEC. 9.98TEMP. 60°


DESCRIPTION

LEFT

CENTER LINE

RIGHT

JOB NO.

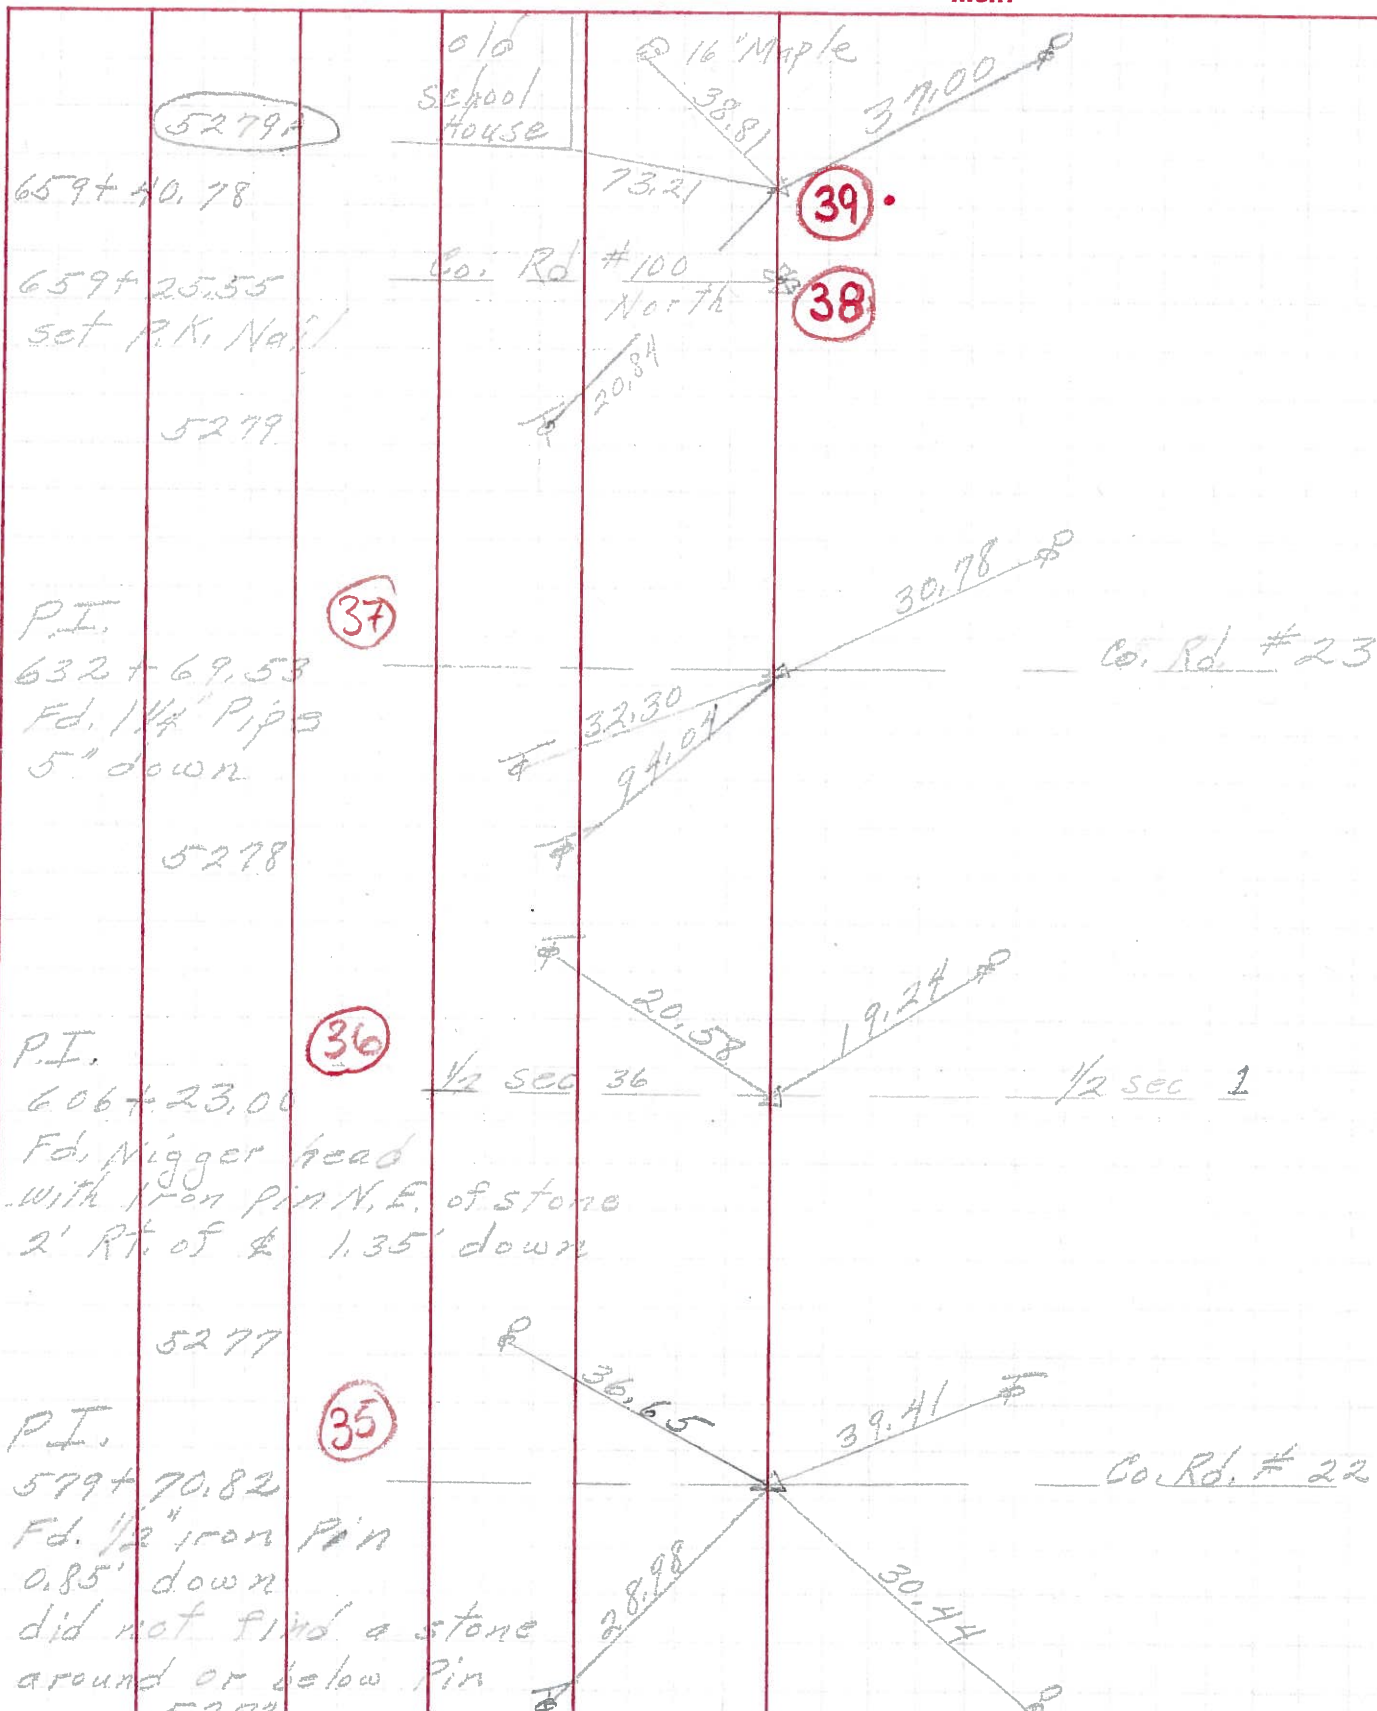Control Points

PERSONNEL TITLE PERSONNEL TITLE

COUNTY Ottawa DATE 3-3-66S. R. 163 WEATHERSEC. 36-31 & 1-6 TEMP.DESCRIPTION Benton, Harris, Salem & Carroll Twp. JOB NO.

LEFT

CENTER LINE

RIGHT

P.I.
 Ed. P.K. Nail
 on surface

(40)

old
 school
 house

P.I.
 659 + 40.78
 P.K. Nail

(39)

659 + 25.55
 set P.K. Nail

(38)

— Z —

P.I.
 632 + 69.53
 Ed. 1 1/2" pipe
 5" down
 Twp. Cor.

(37)

Carroll Twp.

Salem Twp.

Co. Rd. #23

Harris Twp.

Benton Twp.

