

O.D.O.T. DISTRICT 2 SURVEY OFFICE (USE ONLY)

PERSONNEL

REFERENCE NO. 46

SHEET 2 OF 74

NOTES ASTON

DATE 5-14-24

ROUTE SR 163

H.C. NIESE

WEATHER CLEAR

COUNTY OTTAWA

R.C. PRESTON-COLVIN

TEMP. 70°

TOWNSHIP SALEM

DWG BY ASTON

PID NO PID

T 6 N R 15 E

TYPE MONUMENT MAG/WASHER

ON SURFACE - BELOW ON

OFFSET Q PAVEMENT ON LT : RT

17.5' TO LT EDGE PAVEMENT


STATION: 721+53

HORIZ.DATUM: NAD83 2011


GEOID: 18

GRID: NORTHING: 672537.386

EASTING: 1789532.146

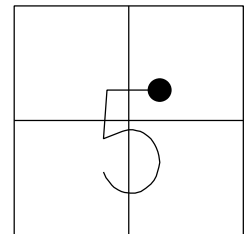

LDP
N:332018.2244
E:149401.1863

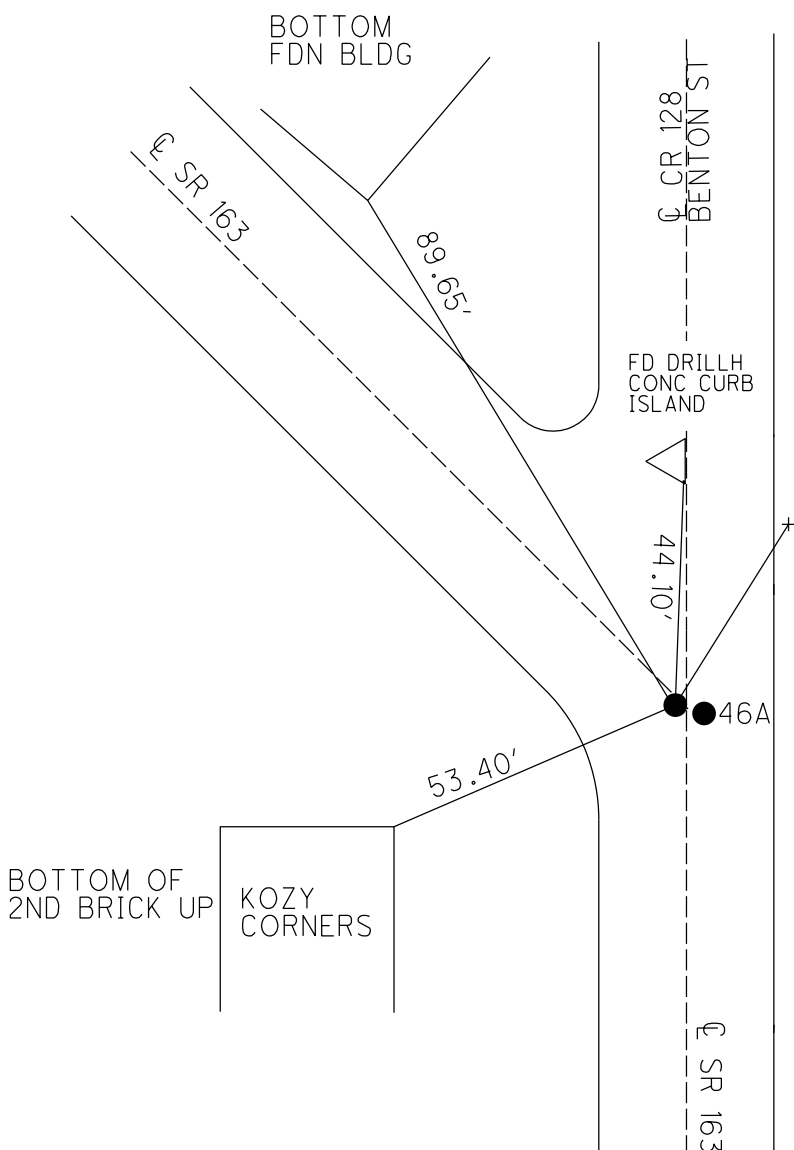

RECORD: P.I.
STA 720+40.77
SET P.K./WASHER
8-16-76
FD P.K./WASHER
6-21-93, BARBOUR
SET P.K./WASHER
7-27-93, RCC
FD P.K. SHANK
REF46
7-27-17, JLL
SET MAG/WASHER
7-10-18, JLL
FD MAG/WASHER
REF46
5-14-24, TDN

FD SAW CUT "+"
TOP OF CURB
20.35'

DIST. 46-46A = 0.33'

O.D.O.T. DISTRICT 2 SURVEY OFFICE (USE ONLY)

PERSONNEL

REFERENCE NO. 46

SHEET 2 OF 74

NOTES HOMAN

DATE 7-27-17

ROUTE SR 163

H.C. LEU

WEATHER CLOUDY

COUNTY OTTAWA

R.C. CARSON

TEMP. 76°

TOWNSHIP SALEM

SECTION 5

DWG BY JAMES PID 95757

T 6 N R 15 E

TYPE MONUMENT P.K. SHANK

~~ON SURFACE~~ - BELOW 0.15'

OFFSET Q PAVEMENT ON LT : RT

17.5' TO LT EDGE PAVEMENT



STATION: 721+53

HORZ.DATUM: NAD83 2011

GEOID: NAVD88 2012A

GRID: NORTHING: 672537.340

EASTING: 1789532.206

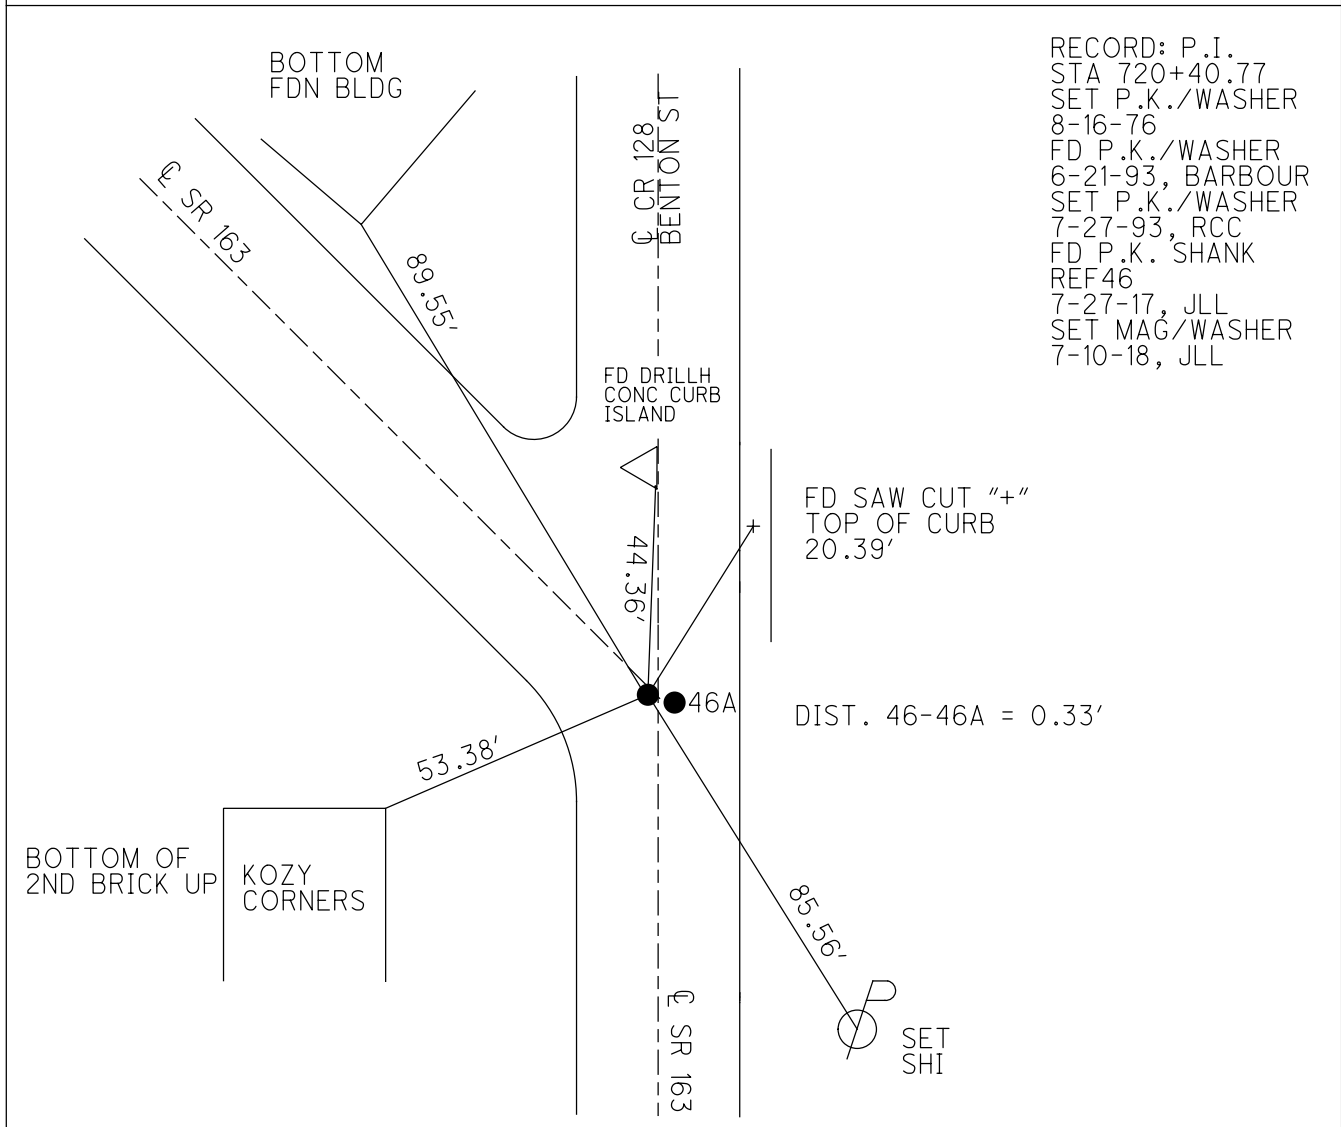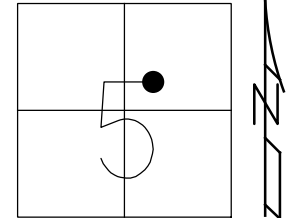

O.D.O.T. DISTRICT 2 SURVEY OFFICE

PERSONNEL

REFERENCE NO. 46

SHEET 22 OF 24

NOTES CHENEY

H.C. KIPPLE

R.C. BARBONE

GEYMAN

DATE 6-21-1993

WEATHER Cloudy

TEMP. 75°

ROUTE #163

COUNTY OTTAWA

TOWNSHIP SALEMSECTION 5-Oak Harbor

T 6 N R 15 E


TYPE MONUMENT PK/WASHER

ON SURFACE - ~~BELOW~~ ON

~~LEFT~~ - C. PAV'T. - ~~RIGHT~~ ON E. INTERSECTION

17.5' TO LT. EDGE PAVEMENT

S.L.M. 721453

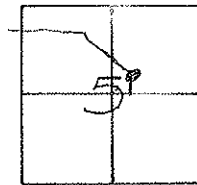

RECORDED: 8-16-1976


P.I. STA. 720 + 40.77

R.R. S. K.

RESET Rk. XAK

FOUNDATION OLD HALLO INN
BOTTOM 1ST. CONC. BECK

DRILLED HOLE INSIDE
ANGLE POINT CONC. CURB
OF ISLAND

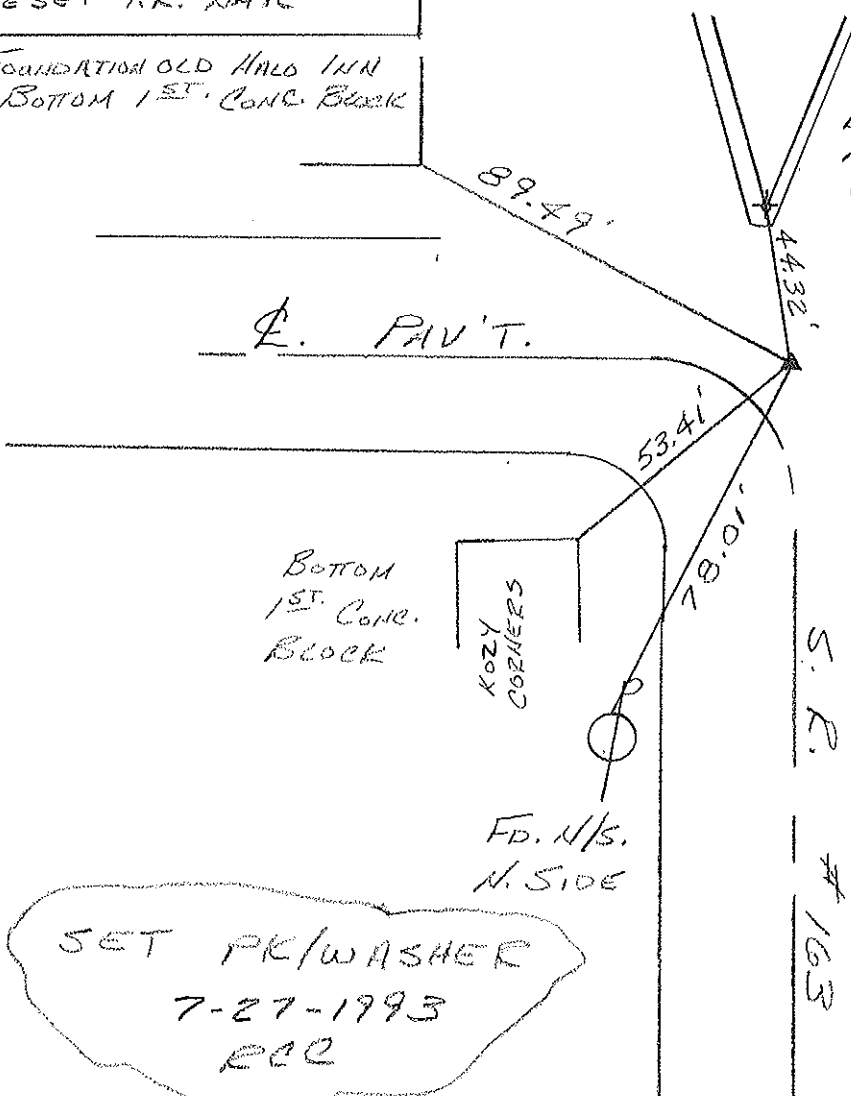

PERSONNEL TITLE PERSONNEL TITLE

COUNTY

DATE

S. R.

WEATHER

SEC.

TEMP.

DESCRIPTION

LEFT

CENTER LINE

RIGHT

JOB NO.

P.I. 720+40.97	5286	(46)	N. E. cor. gas station	N. E. cor. doorway 83.23 47.83	S. E. cor. gas station 61.73 S.R. 163	
Oak Harbor Corp Limits (?)	5285	(45)		89.57 N. E. cor. of Foundation Restaurant 1/2" above ground 2" Pipe 44.92	53.42	89.84
P.I. 709+98.01 P.K. Nail	5284	(44)		30.19	28.99 128.89	
P.I. 701+81.50 Iron Pin	5283	(43)		73.97 101.63 11.00'	87.80	N. & S. in Permit

PERSONNEL TITLE PERSONNEL TITLE

COUNTY Ottawa DATE 11-17-66S. R. 163 WEATHER FairSEC. 5 Salem Twp TEMP. 60°

DESCRIPTION

Oak Harbor

JOB NO.

LEFT

CENTER LINE

RIGHT

P.I.
720+40.77

(46)

N.E. cor.
gas stationN.E. cor.
doorway

S.E. cor. gas station

S.R. # 163

83.25'

71.83'

61.73'

89.57'

N.E. cor. of foundation Restaurant

2" Pipe - 1 1/2' above the ground

44.92'

53.42'

Oak Harbor Corp Line

716+33.66
Corp Line
Oak Harbor

(45)

89.84'

P.I.
709+98.01
P.K. Nail
 $\Delta = 0^{\circ}27'8''$

(44)

30.19'

28.99'

128.89'