

O.D.O.T. DISTRICT 2 SURVEY OFFICE (USE ONLY)

PERSONNEL

REFERENCE NO. 21

SHEET 21 OF 30

NOTES MILLER
H.C. MILLER
R.C. BLUBAUGH

DATE 8/21/24
WEATHER SUNNY
TEMP. 63°

ROUTE SR 590
COUNTY OTTAWA
TOWNSHIP BENTON
SECTION 22
T 7 N R 14 E

DWG BY BARRIERE PID 107604

TYPE MONUMENT MONBOX W/ 7/8" IPIN

ON SURFACE - BELOW ON

OFFSET Q PAVEMENT ON LT : RT

8.7' TO LT EDGE PAVEMENT

STATION: 319+72

HORIZ.DATUM: NAD83 (2011)


GEOID: 18

GRID: NORTHING: 685349.138


EASTING: 1770795.060

LDP: NORTHING: 344702.428

EASTING: 130573.842

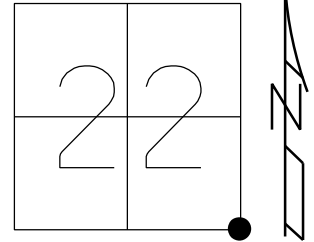

RECORD:
FD P.K./WASHER
7/9/08
SV121
8/13/08, MC
SET MAG/WASHER
6/09/09, SAH
FD MAG/WASHER
2-26-18, 4-23-18
10-4-18, JFO
FD MAG/WASHER
REF21
4/10/23, TDN
FD MAG/WASHER
REF21
5/31/24, JAM
FD MONBOX W/ 7/8" IPIN
CKREF21
8/21/24

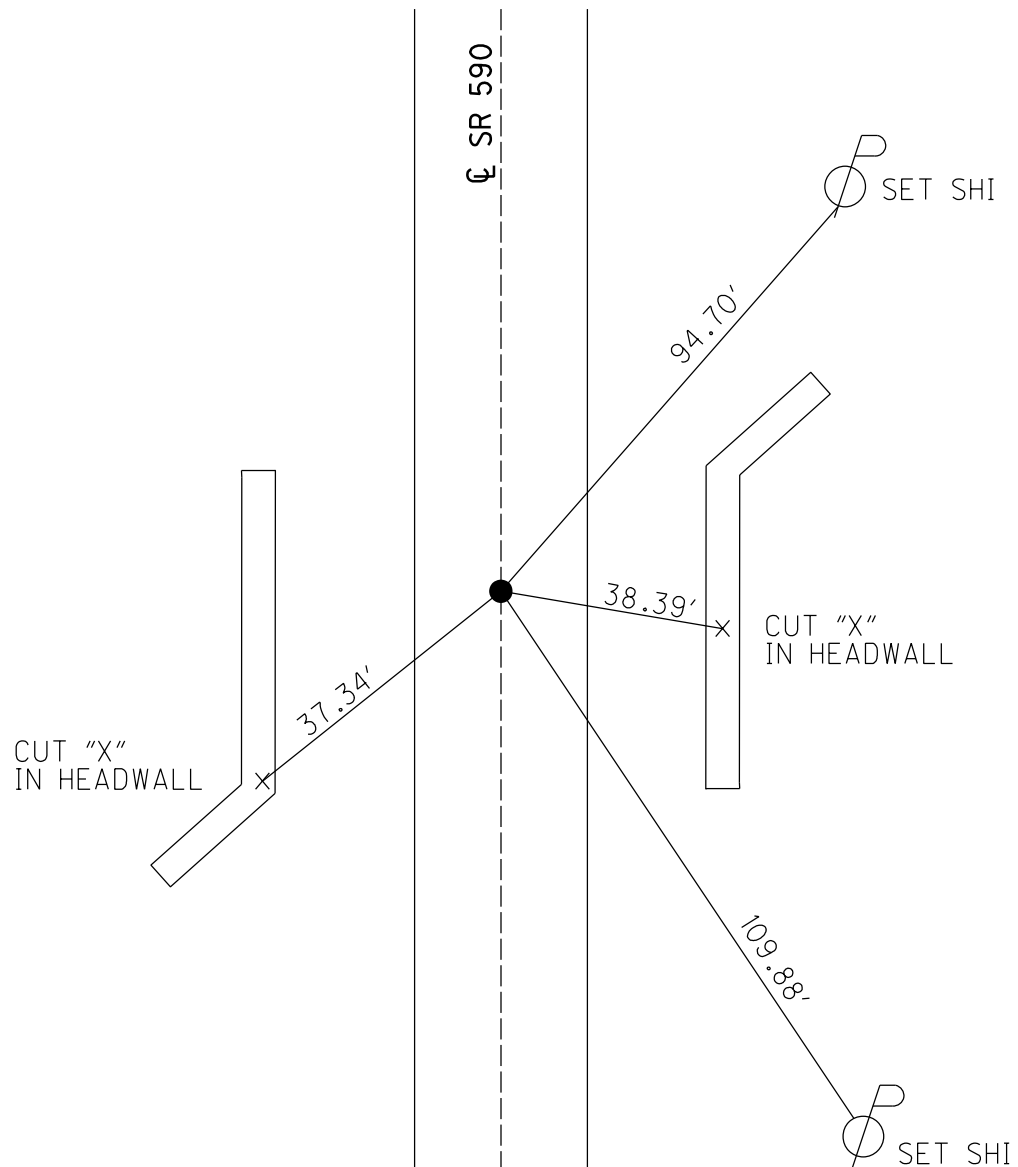

O.D.O.T. DISTRICT 2 SURVEY OFFICE (USE ONLY)

PERSONNEL

REFERENCE NO. 21

SHEET 21 OF 30

NOTES RHOADES

DATE 2/26/18

ROUTE SR 590

H.C. O'DONNELL

WEATHER SUNNY

COUNTY OTTAWA

R.C. RHOADES

TEMP. 41°

TOWNSHIP BENTON

DWG BY MILLER PID 101240

SECTION 22

T 7 N R 14 E

TYPE MONUMENT MAG/WASHER

ON SURFACE - ~~BELOW~~ ON

OFFSET Q PAVEMENT 1' LT : ~~RT~~

8.7' TO LT EDGE PAVEMENT


STATION: 319+72

HORIZ.DATUM: NAD83-2011

GEOID: NAVD88-2012A


GRID: NORTHING: 685349.138

EASTING: 1770795.060

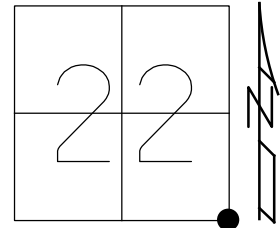

RECORD:
FD P.K./WASHER
7/9/08
SV121
8/13/08, MC
SET MAG/WASHER
6/09/09, SAH
FD MAG/WASHER
2-26-18, 4-23-18
10-4-18, JFO
FD MAG/WASHER
REF21
4/10/23, TDN

FD CUT "X"s
ON TOP
OF WALLS

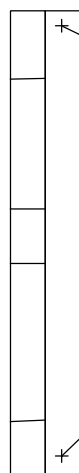


14.53'

20.70'

Q SR 590

18.12'

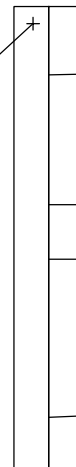

BRIDGE
OTT 590-0605

O.D.O.T. DISTRICT 2 SURVEY OFFICE (USE ONLY)

PERSONNEL

REFERENCE NO. 21

SHEET 21 OF 30

NOTES RHOADES

DATE 2/26/18

ROUTE SR 590

H.C. O'DONNELL

WEATHER SUNNY

COUNTY OTTAWA

R.C. RHOADES

TEMP. 41°

TOWNSHIP BENTON

DWG BY MILLER

PID 101240

SECTION 22

T 7 N R 14 E

TYPE MONUMENT MAG/WASHER

ON SURFACE - ~~BELOW~~ ON

OFFSET Q PAVEMENT 1' LT : ~~RT~~

8.7' TO LT EDGE PAVEMENT


STATION: 319+72

HORZ.DATUM: NAD83-2011

GEOID: NAVD88-2012A


GRID: NORTHING: 685349.156

EASTING: 1770795.052

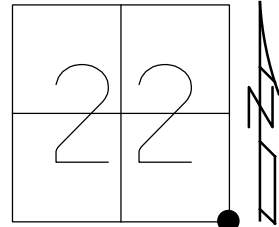

RECORD:
FD P.K./WASHER
7/9/08
SV121
8/13/08, MC
SET MAG/WASHER
6/09/09, SAH
FD MAG/WASHER
2-26-18, 4-23-18
10-4-18, JFO

FD CUT "X"s
ON TOP
OF WALLS

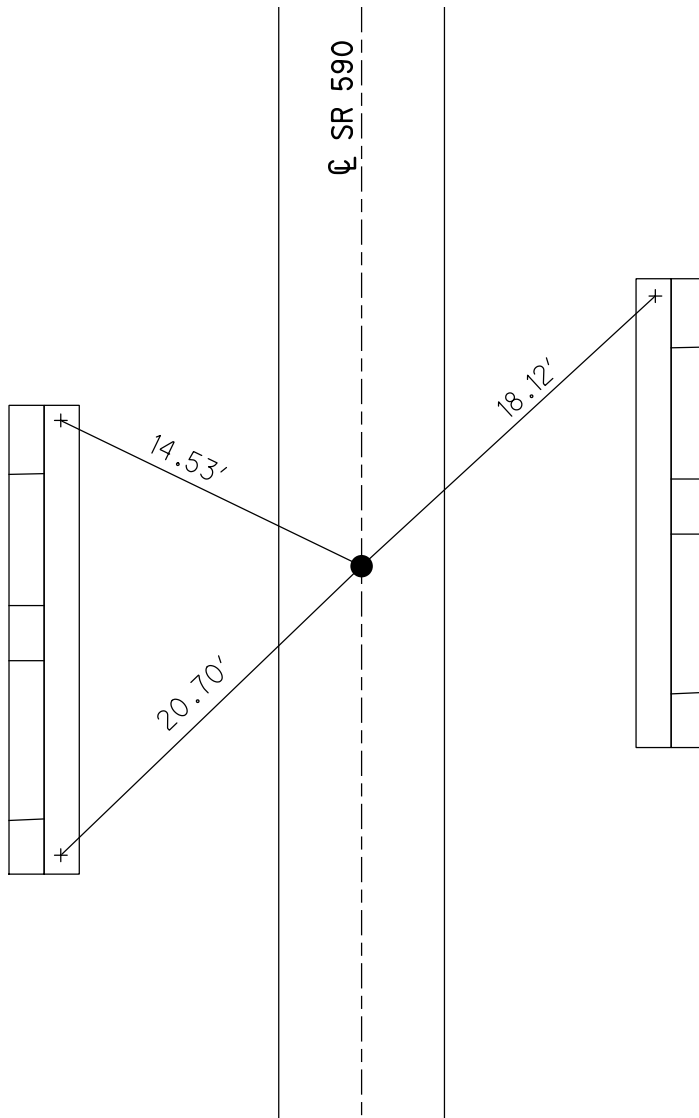


BRIDGE
OTT 590-0605

O.D.O.T. DISTRICT 2 SURVEY OFFICE (USE ONLY)


PERSONNEL _____ REFERENCE NO. 21 SHEET 21 OF 30
 NOTES CANTERBURY DATE 7/9/08 ROUTE SR 590
 H.C. HUSS WEATHER FAIR COUNTY OTTAWA
 R.C. CANTERBURY TEMP. 80° TOWNSHIP BENTON
 SECTION 22
 T 7 N R 14 E

TYPE MONUMENT _____ P.K./WASHER _____
 ON SURFACE - ~~BELOW~~ _____ ON _____
 LEFT - Q PAV'T - ~~RIGHT~~ _____ 1' _____
8.7' TO LT EDGE PAVEMENT
 S.L.M. _____ 319+72

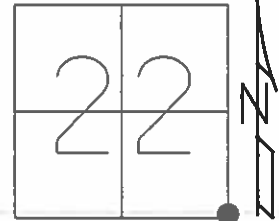

GRID: NORTHING: 685349.100 EASTING: 1770795.051

RECORD:
 SET MAG/WASHER
 6/09/09, SAH
 GPS SV121,
 8/13/08

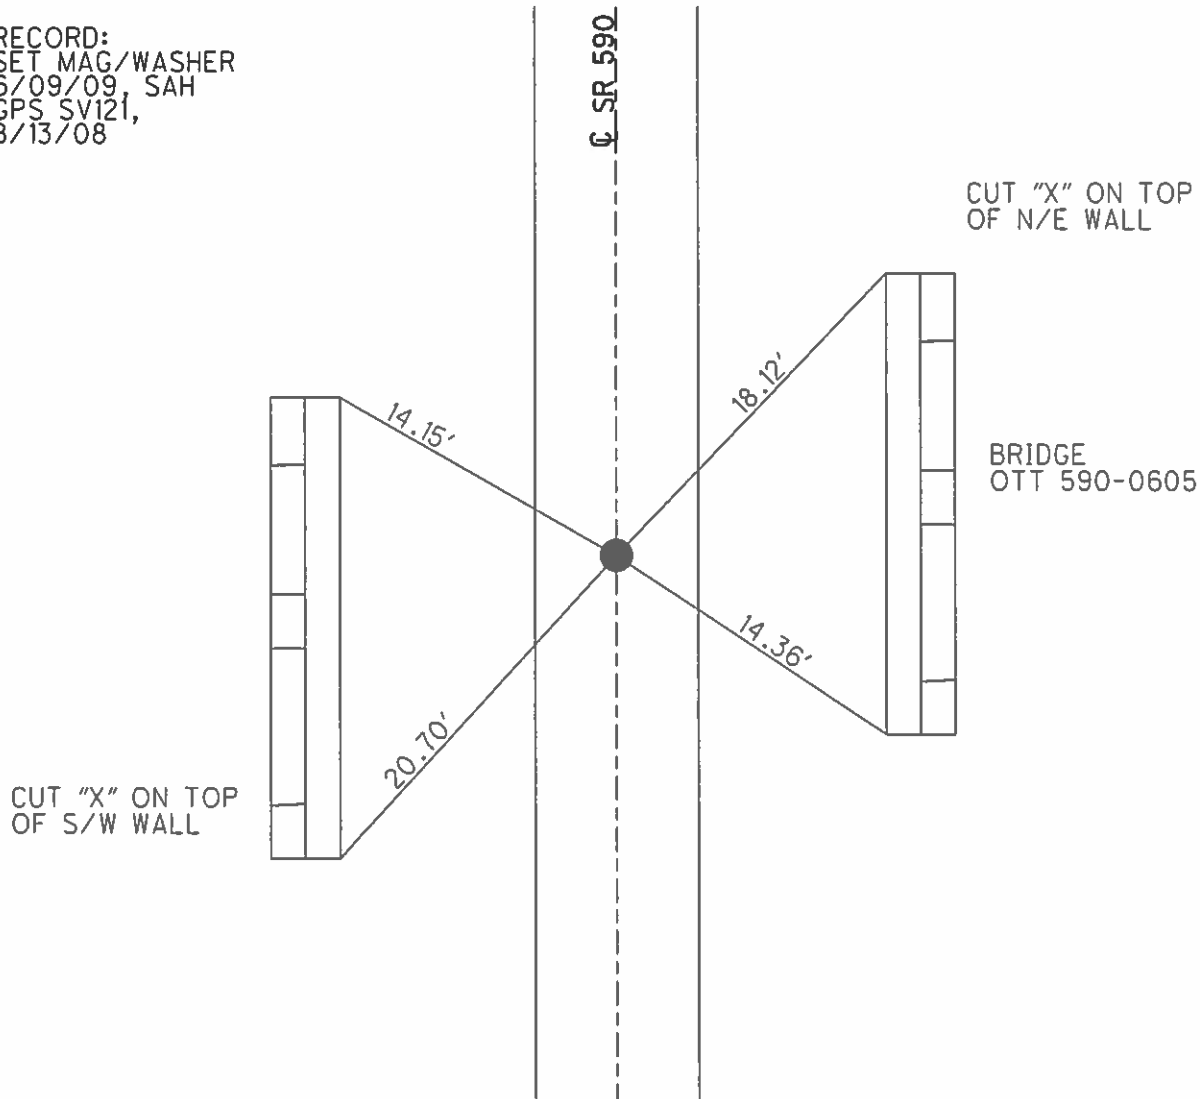

O.D.O.T. DISTRICT 2 SURVEY OFFICE (Use Only)

PERSONNEL

REFERENCE NO. 21

SHEET OF

NOTES CANTERBURY

DATE 7-9-08

ROUTE S.R. 590

H.C. HUSS

WEATHER Fair

COUNTY OTTAWA

R.C. CANTERBURY

TEMP. +80 F

TOWNSHIP BENTON

SECTION 22, 23, 26, 27

T 7 N R 14 E

TYPE MONUMENT P.K./WASHER

ON SURFACE - ~~BELOW~~ Surface

LEFT - C PAV'T - ~~RIGHT~~ 1' LT

8.7' TO LT EDGE PAVEMENT

S.L.M. 319+72


22	23
27	26



GRID: Northing: 685349.100 Easting: 1770795.051

RECORD:
SET MAG/W 6-9-09 SAH

SHOT GPS SV121
08-13-08

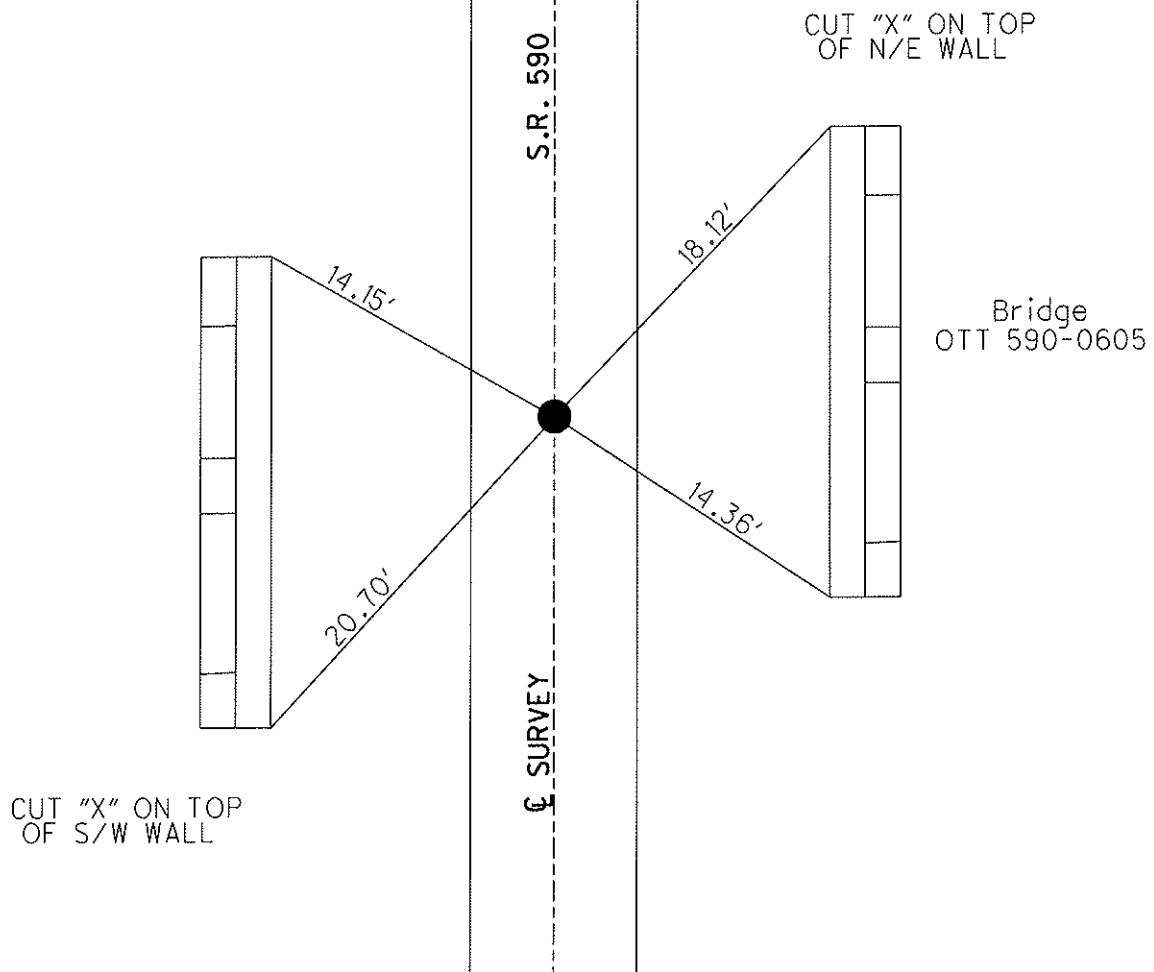

O.D.O.T. DISTRICT 2 SURVEY OFFICE

PERSONNEL

REFERENCE NO. 21

SHEET 4 OF 1

NOTES Ripple

H.C. BARBOUR

R.C. Geyman

DATE 8/06/90 DRAWN 8/08/90

WEATHER Cloudy

TEMP. 62°

ROUTE SR #590

COUNTY OTAWA

TOWNSHIP Benton

SECTION 22, 23, 26, & 27

T 7 N R 14 E

TYPE MONUMENT Set P.K. & Washer

ON SURFACE - BELOW P.K. & Washer

LEFT - Q PAV'T. - RIGHT 1.0' LT. & PVT.


TO EDGE PAVEMENT

S.L.M.

22	23
27	26



FD P.K. & WASHER
SURFACE
9-12-94

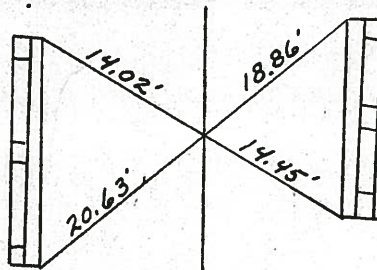

Bridge
0+590 - 0+605

Q SR #590

O.D.O.T. DISTRICT 2 SURVEY OFFICE

PERSONNEL

REFERENCE NO. 21

SHEET 4 OF 1

NOTES RIPPLE

H.C. BARBOUR

R.C. GEYMAN

DATE 8/06/90 DRAWN 8/08/90

WEATHER CLOUDY

TEMP. 62°

ROUTE SR #590

COUNTY OTTAWA

TOWNSHIP BENTON

SECTION 22, 23, 26, & 27

T 7 N R 14 E

TYPE MONUMENT SET P.K. & WASHER


ON SURFACE - BELOW P.K. & WASHER

LEFT - & PAV'T. - RIGHT 1.0' LT. & PVT.

TO EDGE PAVEMENT

S.L.M.

22	23
27	26

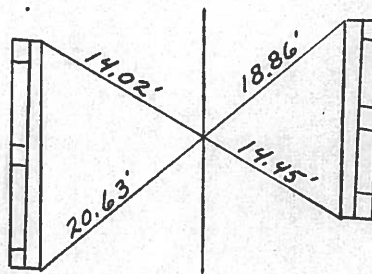

Bridge
OTT. 590-0605

d. SR #590

O.D.O.T. DISTRICT 2 SURVEY OFFICE

SHEET

OF

County Ottawa S.R. #590

Township Benton

Section 22, 23, 26 & 27

T1N, R14E

Personnel Cronin - Draw

Ripple

Geyman

Mosser

Barbour


21

Date 7/19/82 Drawn 8/5/82

Weather sunny - humid

Temp. 85°

22	23
27	26

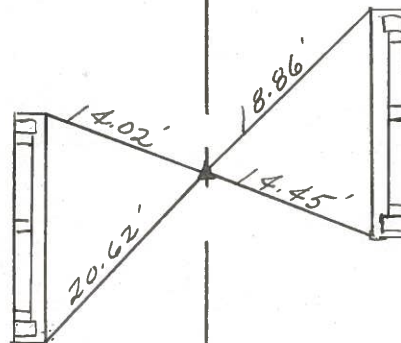

Bridge
0+590-0605

set P.K. & Washer atop
P.K. & Washer. 1.0'
Lt. & Pavement

S. R. #590




PERSONNEL TITLE PERSONNEL TITLE

COUNTY Ottawa DATE 7-27-71S. R. 590 WEATHER CloudySEC. 27 & 26 TEMP. 75°DESCRIPTION S.R. #163 to S.R. #2 Benton Twp. JOB NO. _____

LEFT

CENTER LINE

RIGHT

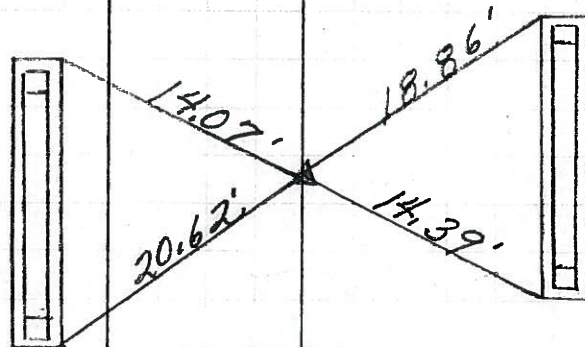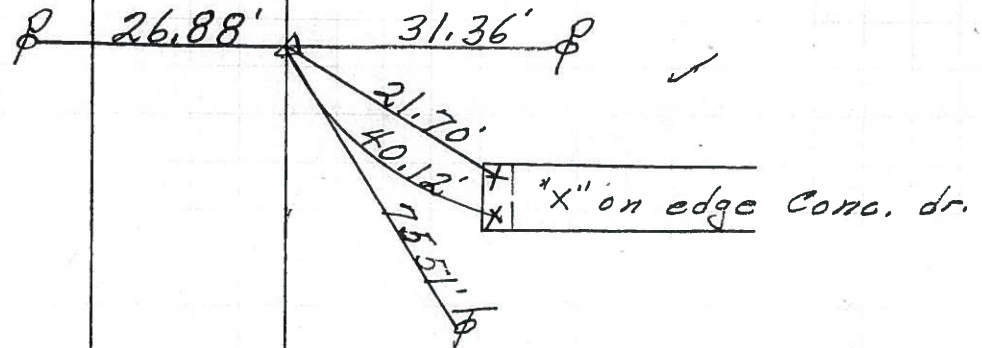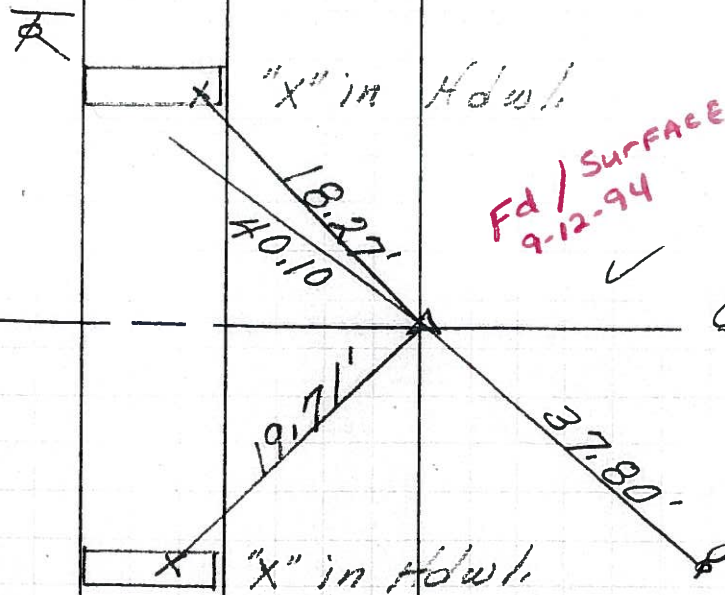R.R. Spk
on surface0.5 MI. from
Bridge # 06.0521
22P.K. ⁺ WASHER
Nail
Br. # 06.0520
21P.K. ⁺ WASHER
Nail
on surface19
20Cor. of Bridge
RailsCo. Rd. # 77
True Rd.

5.55 S.L.M.

PERSONNEL TITLE PERSONNEL TITLE

COUNTY Ottawa DATE 7-27-71S. R. 590 WEATHER CloudySEC. 27 E 26 TEMP. 75°DESCRIPTION S.R. #163 to S.R. #2 Benton Twp. JOB NO. _____


LEFT

CENTER LINE

RIGHT


R.R. Spk
on surface
0.5 MI from
Bridge # 06.05

21
22

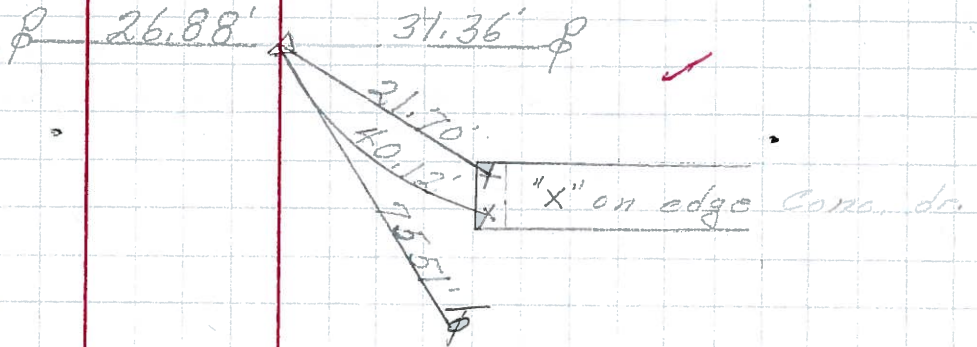

P.K. Nail
Br. # 06.05


20
21

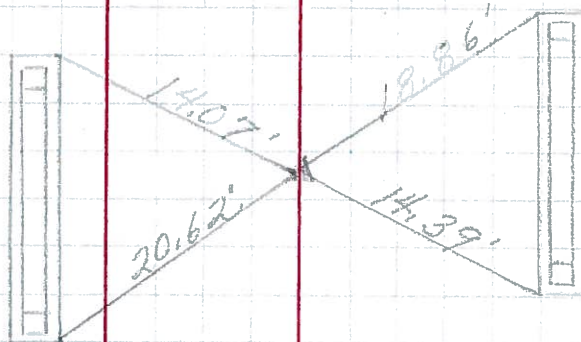

Cor. of Bridge
Rails

P.K. Nail
on surface

19
20

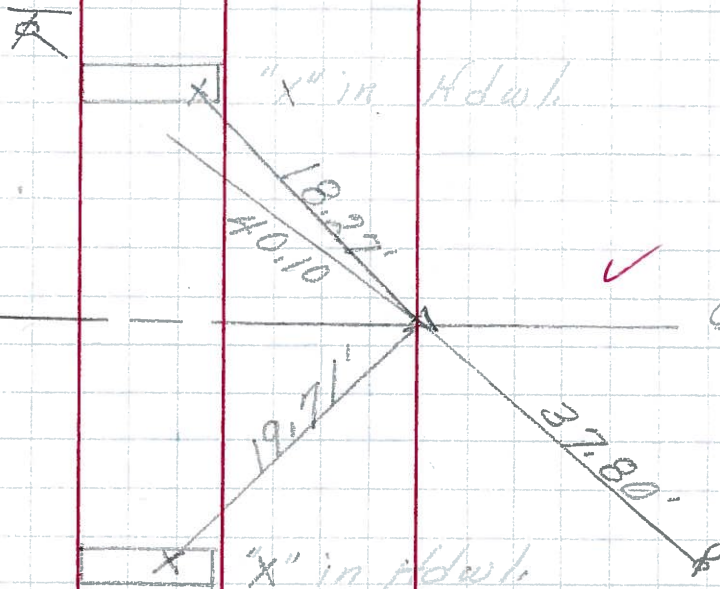

Co. Rd. # 77
True Rd.

PERSONNEL TITLE PERSONNEL TITLE

SchneiderCOUNTY Ottawa DATE 6-21-68MosserS. R. 590 WEATHER Cloudy-WindyBarbourSEC. S.R.#163 to S.R.#2 TEMP. 75°DESCRIPTION Ties for Control Points JOB NO. _____

LEFT


CENTER LINE

RIGHT

R. R. spk.
on top


6486

(23)

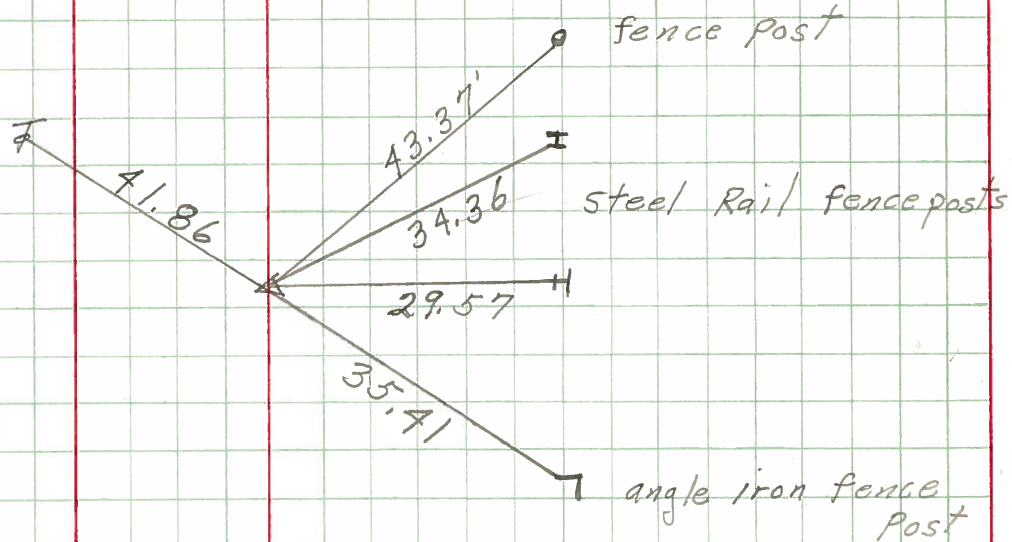R. R. spk.
on top

6485

(22)

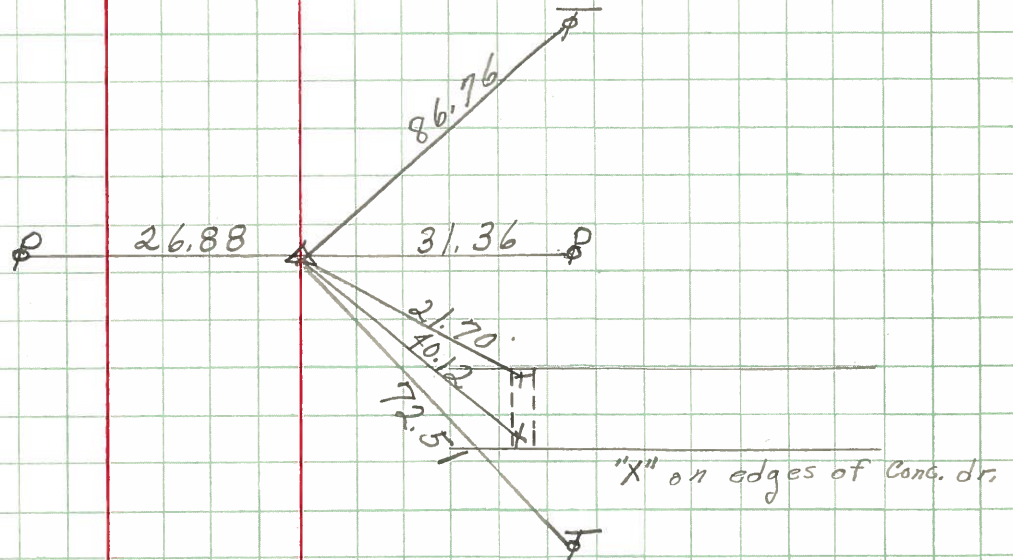P. K. Nail
Br. # 06.05

6484

(21)

