

O.D.O.T. DISTRICT 2 SURVEY OFFICE (USE ONLY)

PERSONNEL

REFERENCE NO. 21A

SHEET 22 OF 30

NOTES BARRIERE
H.C. MILLER
R.C. BLUBAUGH

DATE 5/31/24
WEATHER SUNNY
TEMP. 52°

ROUTE SR 590
COUNTY OTTAWA
TOWNSHIP BENTON
SECTION 22
T 7 N R 14 E

DWG BY BARRIERE PID 107604

TYPE MONUMENT MAG NAIL/WASHER

ON SURFACE - BELOW ON

OFFSET $\angle$ PAVEMENT 7' RT LT : RT

TO EDGE PAVEMENT

STATION: 341+54

HORIZ.DATUM: OH NORTH LDP


GEOID: 18

GRID: NORTHING: 687565.987


EASTING: 1770911.486

LDP: NORTHING: 346885.377

EASTING: 130587.196

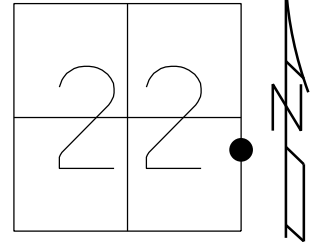

RECORD:
FD LG.R.R.SPIKE
0.25' DOWN
7/9/08
SV121
8/04/08, MC
SET MAG/WASHER
6/09/09, SAH
FD MAG/WASHER
REFA21
2-26-18, 4-23-18
10-4-18, JFO
FD MAG/WASHER
REFA21
4/10/23, TDN
FD MAG/WASHER
REF21A
5/25/24, JAM

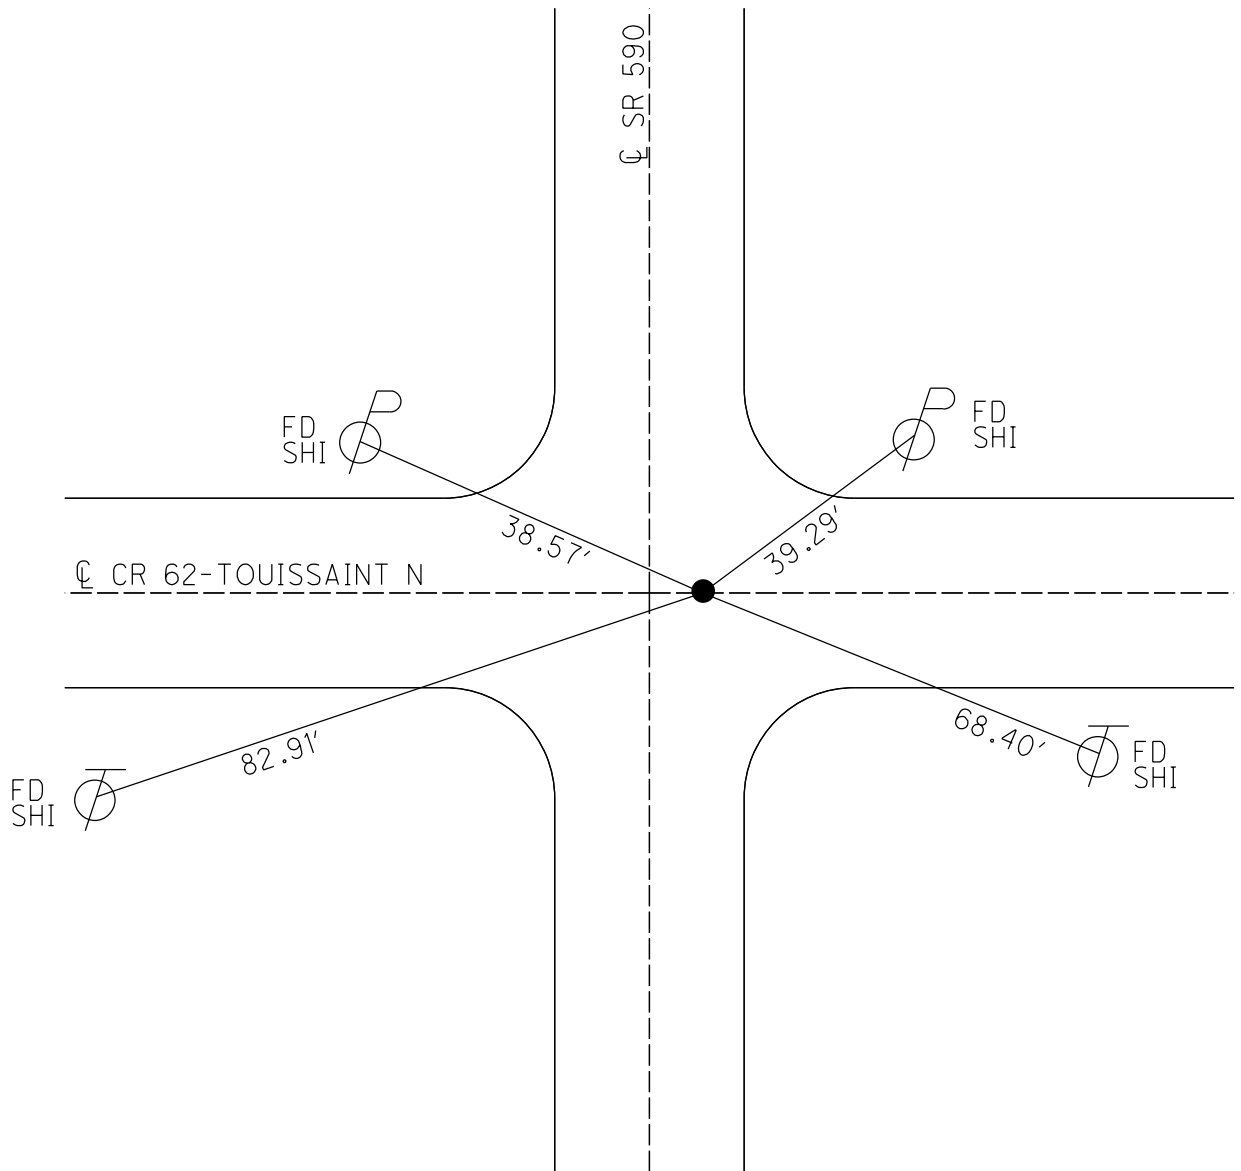

O.D.O.T. DISTRICT 2 SURVEY OFFICE (USE ONLY)

PERSONNEL

REFERENCE NO. 21 A

SHEET 22 OF 30

NOTES RHOADES

DATE 2/26/18

ROUTE SR 590

H.C. O'DONNELL

WEATHER SUNNY

COUNTY OTTAWA

R.C. RHOADES

TEMP. 41°

TOWNSHIP BENTON

DWG BY MILLER

PID 101240

SECTION 22

T 7 N R 14 E

TYPE MONUMENT MAG/WASHER

ON SURFACE - ~~BELOW~~ ON

OFFSET Q PAVEMENT 8' ~~LT~~ : RT

- TO - EDGE PAVEMENT


STATION: 341+54

HORIZ.DATUM: NAD83-2011


GEOID: NAVD88-2012A

GRID: NORTHING: 687531.717

EASTING: 1770823.389

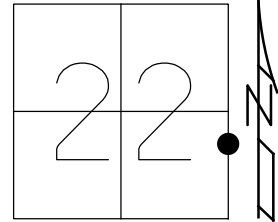

RECORD:
FD LG.R.R.SPIKE
0.25' DOWN
7/9/08
SV121
8/04/08, MC
SET MAG/WASHER
6/09/09, SAH
FD MAG/WASHER
REFA21
2-26-18, 4-23-18
10-4-18, JFO
FD MAG/WASHER
REFA21
4/10/23, TDN

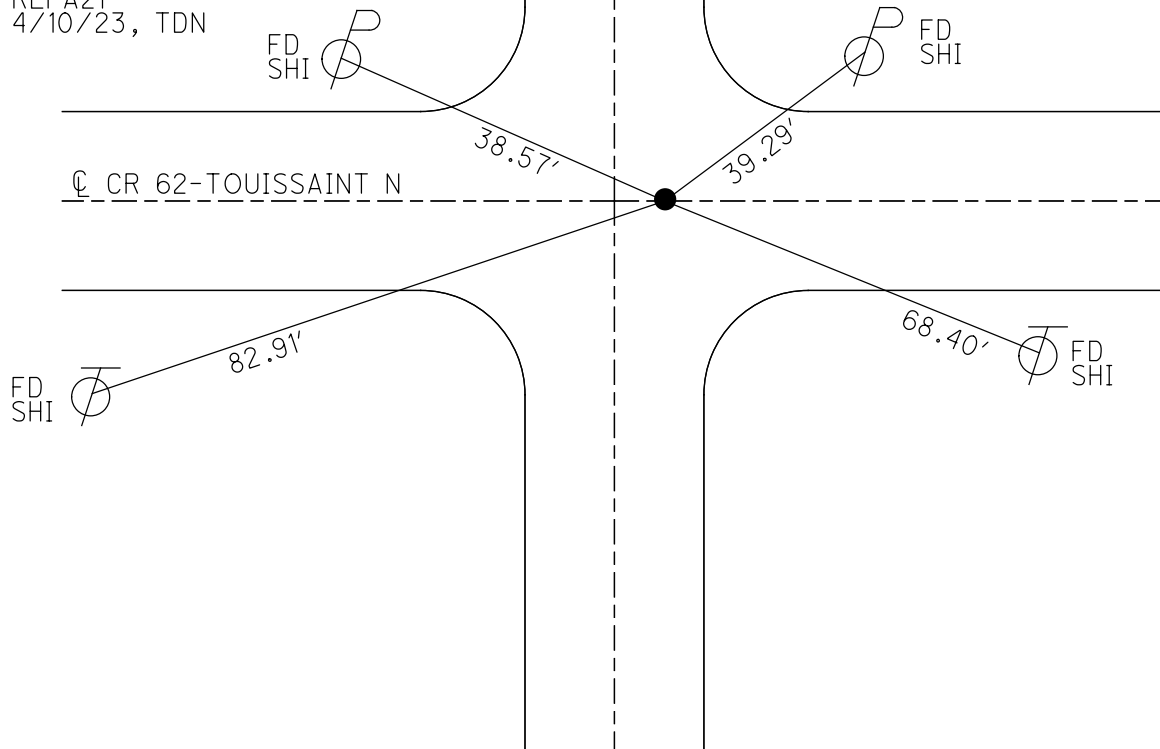

O.D.O.T. DISTRICT 2 SURVEY OFFICE (USE ONLY)

PERSONNEL

REFERENCE NO. 21 A

SHEET 22 OF 30

NOTES RHOADES

DATE 2/26/18

ROUTE SR 590

H.C. O'DONNELL

WEATHER SUNNY

COUNTY OTTAWA

R.C. RHOADES

TEMP. 41°

TOWNSHIP BENTON

DWG BY MILLER

PID 101240

SECTION 22

T 7 N R 14 E

TYPE MONUMENT MAG/WASHER

ON SURFACE - ~~BELOW~~ ON

OFFSET Q PAVEMENT 8' ~~LT~~ : RT

- TO - EDGE PAVEMENT


STATION: 341+54

HORIZ.DATUM: NAD83-2011


GEOID: NAVD88-2012A

GRID: NORTHING: 687531.728

EASTING: 1770823.394

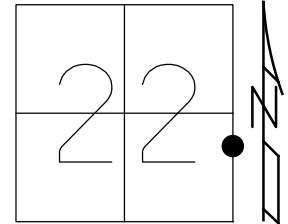

RECORD:
FD LG.R.R.SPIKE
0.25' DOWN
7/9/08
SV121
8/04/08, MC
SET MAG/WASHER
6/09/09, SAH
FD MAG/WASHER
REFA21
2-26-18, 4-23-18
10-4-18, JFO

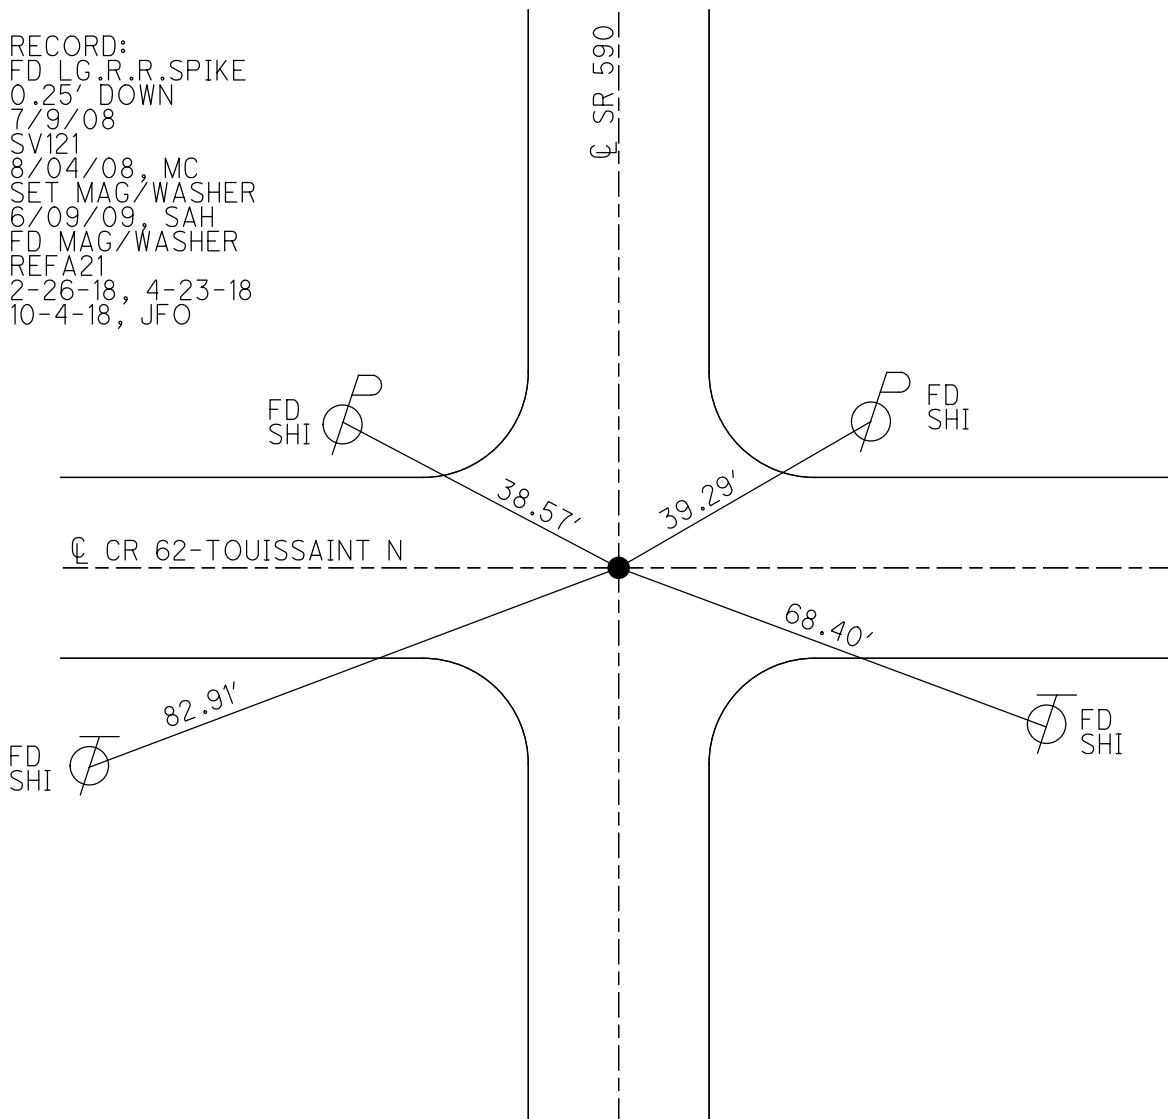

O.D.O.T. DISTRICT 2 SURVEY OFFICE (USE ONLY)

PERSONNEL _____ REFERENCE NO. 21 A SHEET 22 OF 30

NOTES CANTERBURY DATE 07/09/08 ROUTE SR 590
H.C. HUSS WEATHER FAIR COUNTY OTTAWA
R.C. CANTERBURY TEMP. 80° TOWNSHIP BENTON
SECTION 22
T 7 N R 14 E


TYPE MONUMENT LG RR SPIKE

~~ON SURFACE~~ - BELOW 0.25'


~~LEFT~~ - Q PAV'T - RIGHT 6.5' (ON Q EXTENDED OF
TOUSSAINT RD.)
TO EDGE PAVEMENT

S.L.M. 341+54

GRID: NORTHING: 687531.726 EASTING: 1770823.362

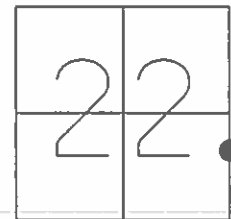

RECORD:
RESET MAG/WASHER
6/09/09, SAH
GPS SV121,
8/04/08

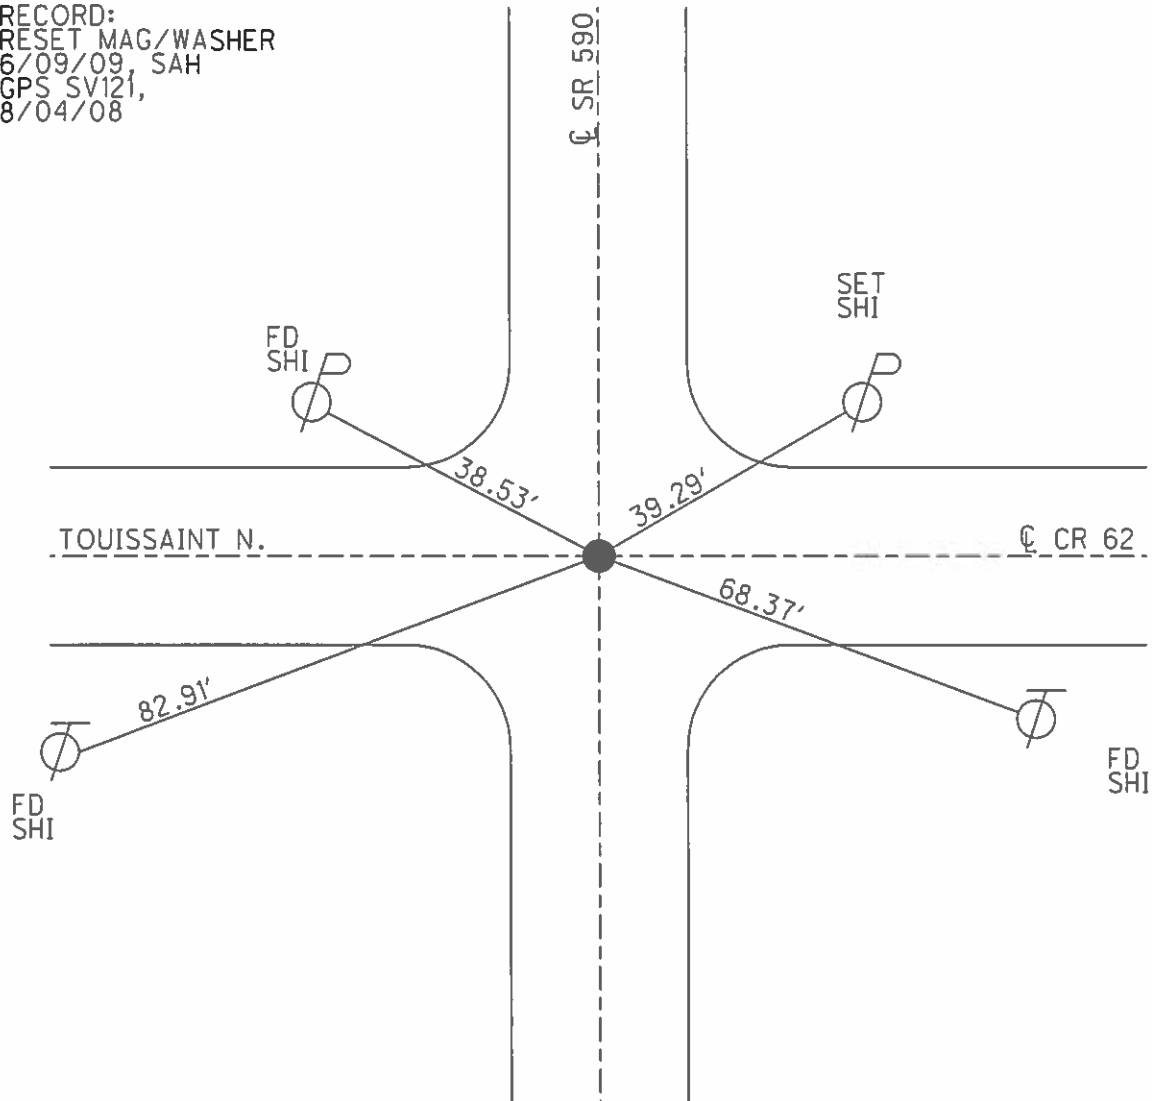

O.D.O.T. DISTRICT 2 SURVEY OFFICE (Use Only)

PERSONNEL

REFERENCE NO. 21A

SHEET OF

NOTES CANTERBURY

DATE 07/09/08

ROUTE S.R. 590

H.C. HUSS

WEATHER Fair

COUNTY OTTAWA

R.C. CANTERBURY

TEMP. +80 F

TOWNSHIP BENTON

SECTION 22 & 23

T 7 N R 14 E


TYPE MONUMENT LG RR SPK

~~ON SURFACE~~ - BELOW 0.25' Down

~~LEFT~~ - C PAV'T - RIGHT 6.5' RT

 TO EDGE PAVEMENT

S.L.M. 341+54

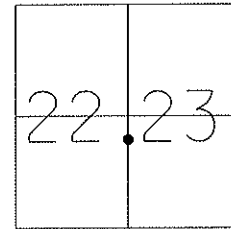


GRID: Northing: 687531.726 Easting: 1770823.362

SHOT GPS SV-121
08-13-08

ON CL EXTENDED OF TOUSSAINT RD.

RESET MAG/WASHER
06/09/09 SAH

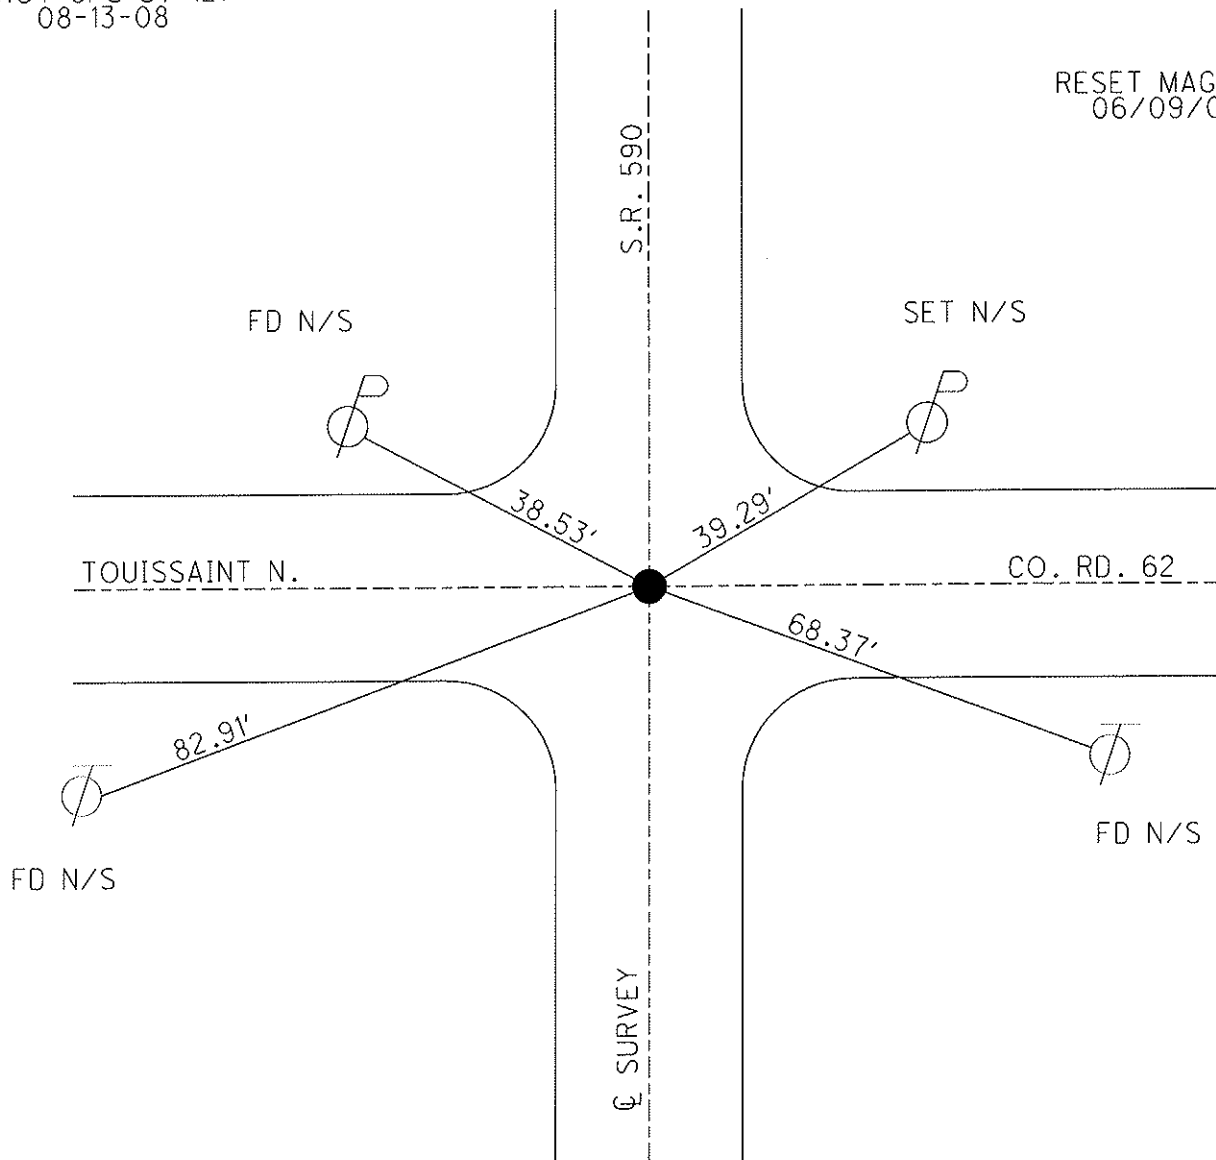

O.D.O.T. DISTRICT 2 SURVEY OFFICE

PERSONNEL

REFERENCE NO. 21A SHEET 5 OF 1

NOTES RIPPLE

H.C. BARBOUR

R.C. Geyman

DATE 8/06/90 DRAWN 8/08/90

WEATHER Cloudy

TEMP. 62°

ROUTE S.R. #590


COUNTY OTTAWA

TOWNSHIP BENTON

SECTION 22 & 23

T 7 N R 14 E

TYPE MONUMENT Set P.K. Washer
ON SURFACE - BELOW A Top RR Spike
LEFT - CL PAV'T. - RIGHT 6.0' RT. CL PAV'T.
____ TO ____ EDGE PAVEMENT
S.L.M. _____

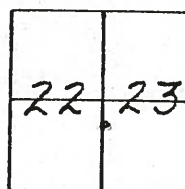


FD P.K. 'CL WASHER
SURFACE
9-12-94



TOUSSAINT N.

Co. Rd. #62

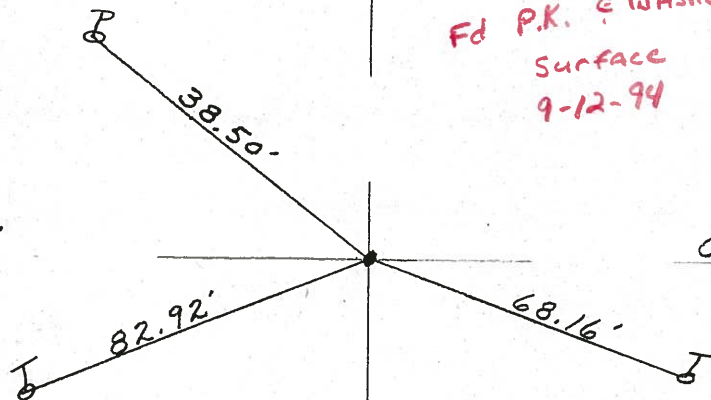

CL S.R. #590

O.D.O.T. DISTRICT 2 SURVEY OFFICE

PERSONNEL

REFERENCE NO. 21A

SHEET 5 OF 1

NOTES RIPPLE

H.C. BARBOUR

R.C. GEYMAN

DATE 8/06/90 DRAWN 8/08/90

WEATHER CLOUDY

TEMP. 62°

ROUTE S.R. #590



COUNTY OTTAWA

TOWNSHIP BENTON

SECTION 22 & 23

T 7 N R 14 E

TYPE MONUMENT SET P.K. WASHER
ON SURFACE - BELOW A TOP RR SPIKE
LEFT - CL PAV'T. - RIGHT 6.0' RT. CL PVT.
TO EDGE PAVEMENT
S.L.M.

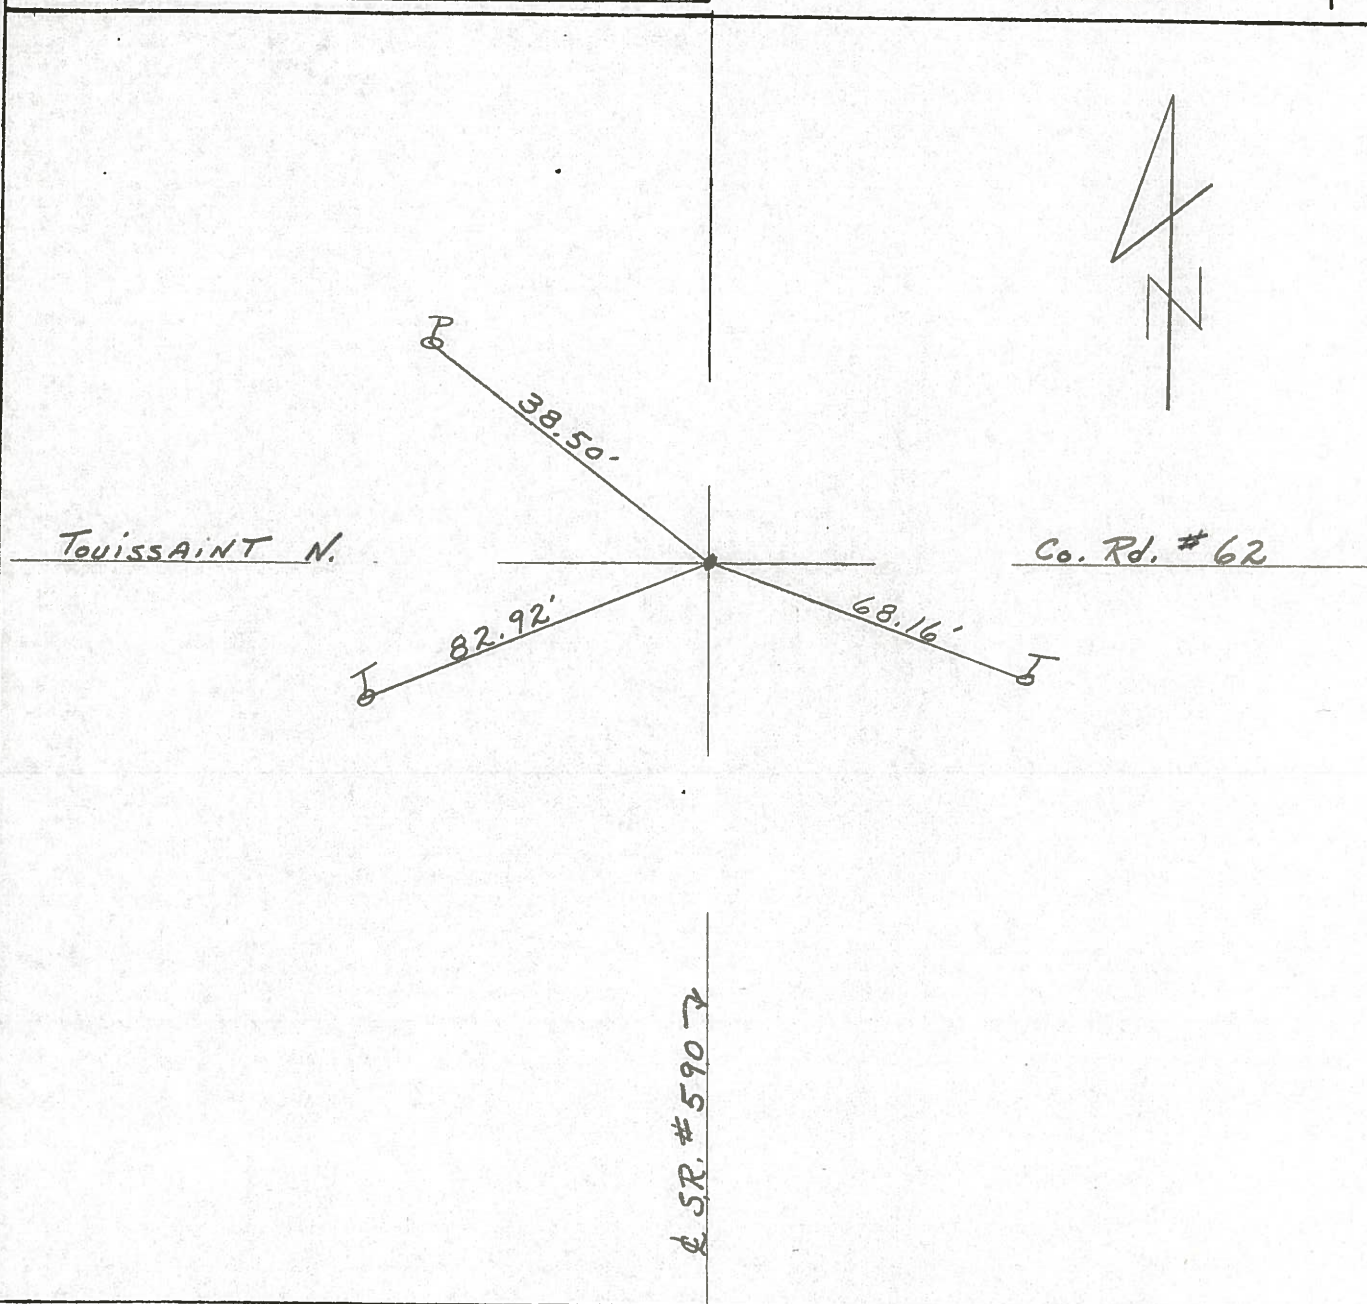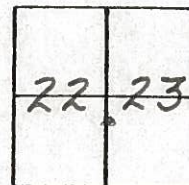

O.D.O.T. DISTRICT 2 SURVEY OFFICE

SHEET

OF

County Ottawa S.R. #590

Township Benton

Section 22 & 23

T1N, R14E

Personnel Cronin-Draw

Ripple

Geyman

Mosser


Barbour

#21-A

Date 7/19/82 Drawn 8/5/82

Weather sunny-humid

Temp. 85°

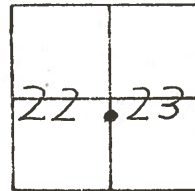

Set P.K. & Washer
at top R.R. spike .5.0'
Rt. R. Pavement

