

O.D.O.T. DISTRICT 2 SURVEY OFFICE (USE ONLY)

PERSONNEL

REFERENCE NO. 1

SHEET 1 OF 27

NOTES AUBLE

DATE 7/31/23

ROUTE US 6

H.C. AUBLE

WEATHER FAIR

COUNTY SANDUSKY

R.C. RHOADES

TEMP. 75°

TOWNSHIP MADISON

ASTON

SECTION 31

DWG BY RHOADES PID R/W

T 5 N R 13 E

TYPE MONUMENT MONBOX W/ 1" IPIN

ON SURFACE - ~~BELOW~~ ON

OFFSET CL PAVEMENT ON LT : RT

- TO - EDGE PAVEMENT



STATION: 0+00

HORZ.DATUM: NAD83(2011)

GEOID: NAVD88 2018

GRID: NORTHING: 611428.370

EASTING: 1716626.270

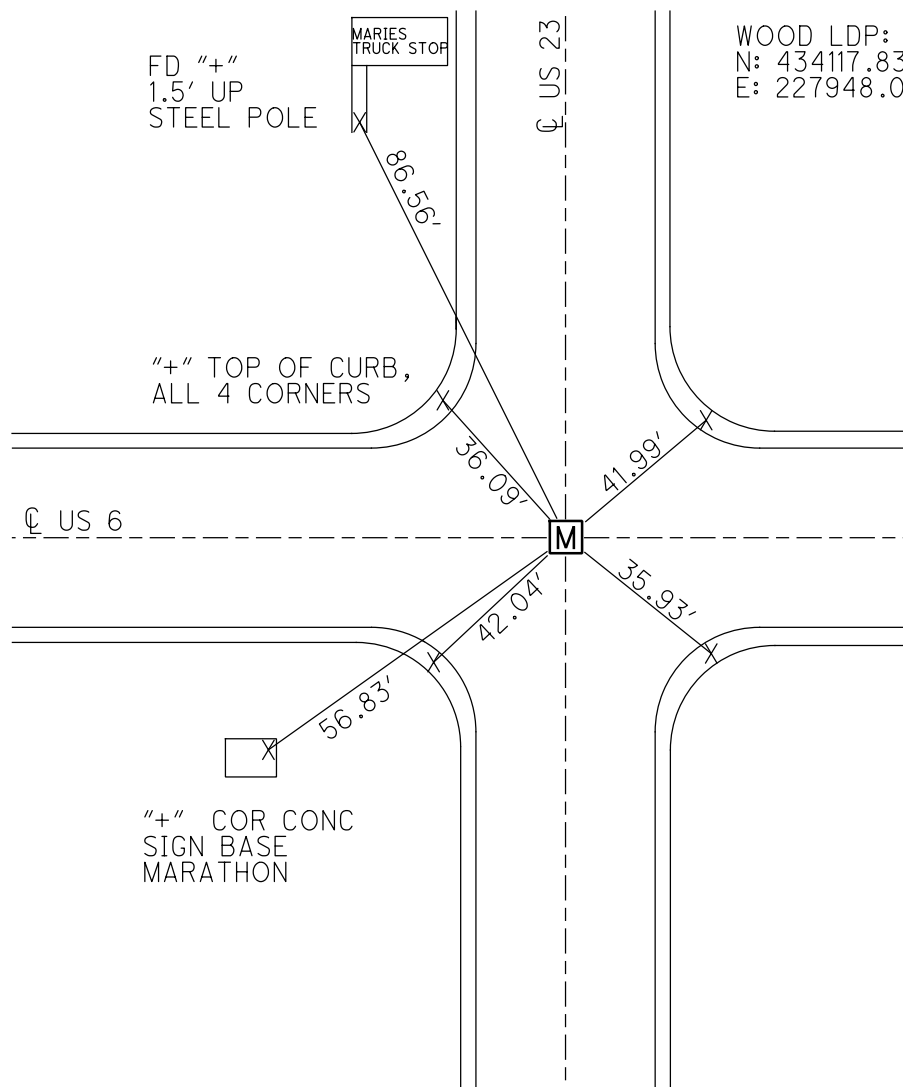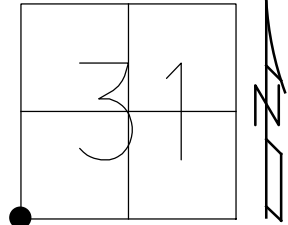

WOOD LDP:
N: 434117.838
E: 227948.000


RECORD: P.I.
 $\Delta=00^{\circ}16'$ LT (PLAN)
FD RUSTED PK NAIL
12/18/80
FD R.R.SPIKE
4.5" DOWN
7/30/81, CL
SET SM.R.R.SPIKE
9/27/83, CL
FD MONBOX
W/1" IPIN
REF37
11/29/12, SHH
NEWREF37
4/22/14
FD MONBOX
W/1" IPIN
10/17/16, JLL
FD MONBOX
W/ 1" IPIN
REF37
7-31-23, DSA

NOTE: REF 37 US 23

O.D.O.T. DISTRICT 2 SURVEY OFFICE (USE ONLY)

PERSONNEL _____ REFERENCE NO. 2 SHEET 2 OF 27
 NOTES HOMAN DATE 8-11-09 ROUTE US 6
 H.C. HOMAN WEATHER CLOUDY COUNTY SANDUSKY
 R.C. ROUSOS TEMP. 80° TOWNSHIP MADISON
 SECTION 31
 T 5 N R 13 E

TYPE MONUMENT R.R.SPIKE
 ON SURFACE - ~~BELOW~~ ON
 LEFT - ℄ PAV'T - RIGHT ON
12.3 TORT EDGE PAVEMENT
 S.L.M. 25+48
 GPS NORTHING: 611417.824 EASTING: 1719173.373

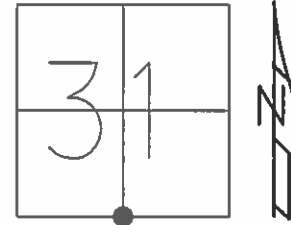


RECORD = P.I.
 $\Delta = 0^\circ 24' \text{ RT}$
 STA. 25+47.37

SET SM.R.R.SPIKE
 5/6/93, MB

SET MAG/WASHER
 11/2/09, DCH

FD MAG/WASHER
 REF2
 11/29/12, SAH

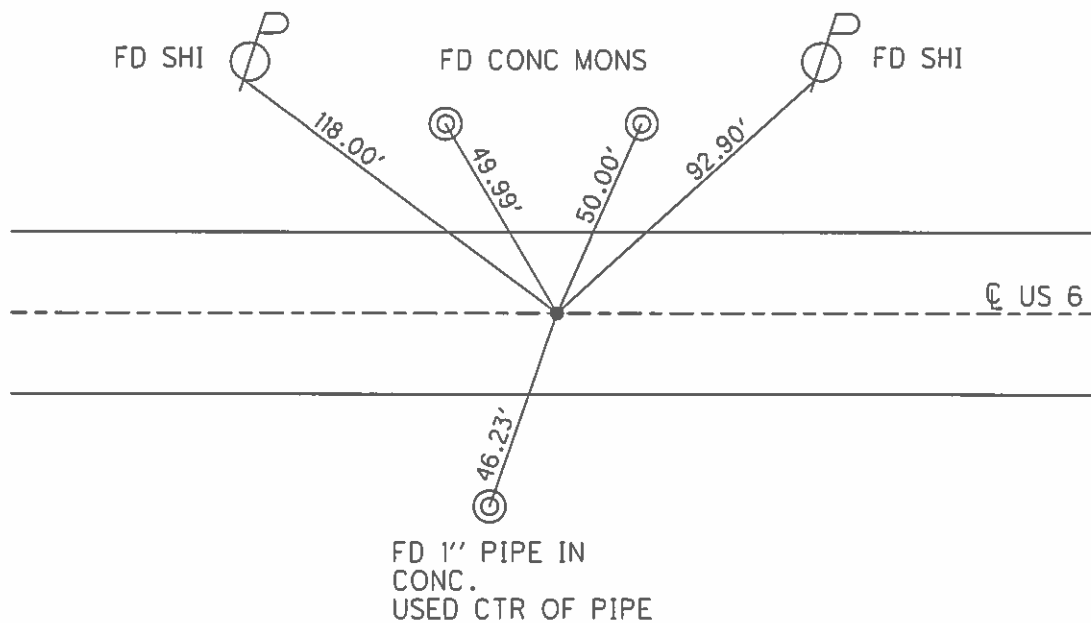

O.D.O.T. DISTRICT 2 SURVEY OFFICE

PERSONNEL

REFERENCE NO. 3

SHEET 3 OF 26

NOTES Homan

DATE 8-11-09

ROUTE US 6

H.C. Homan

WEATHER cloudy

COUNTY Sandusky

R.C. Rousos

TEMP. 80°

TOWNSHIP Madison

SECTION 31

T 5 N R 13 E

TYPE MONUMENT R.R.SPIKE


ON SURFACE - ~~BELOW~~ ON

~~LEFT~~ - Q PAV'T - ~~RIGHT~~ ON

12.5 TO LT EDGE PAVEMENT

S.L.M. 52 + 36

GPS Northing: 611388.715 Easting: 1721859.903

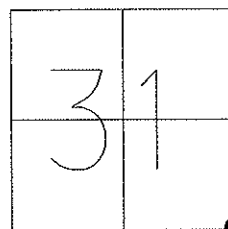

Record: P.O.T.

52+35.80


$\Delta = 0^{\circ}+00'$

REset Sm RR Spk

5-6-93 M.B.

Reset Mag & Washer

11-03-09 DH

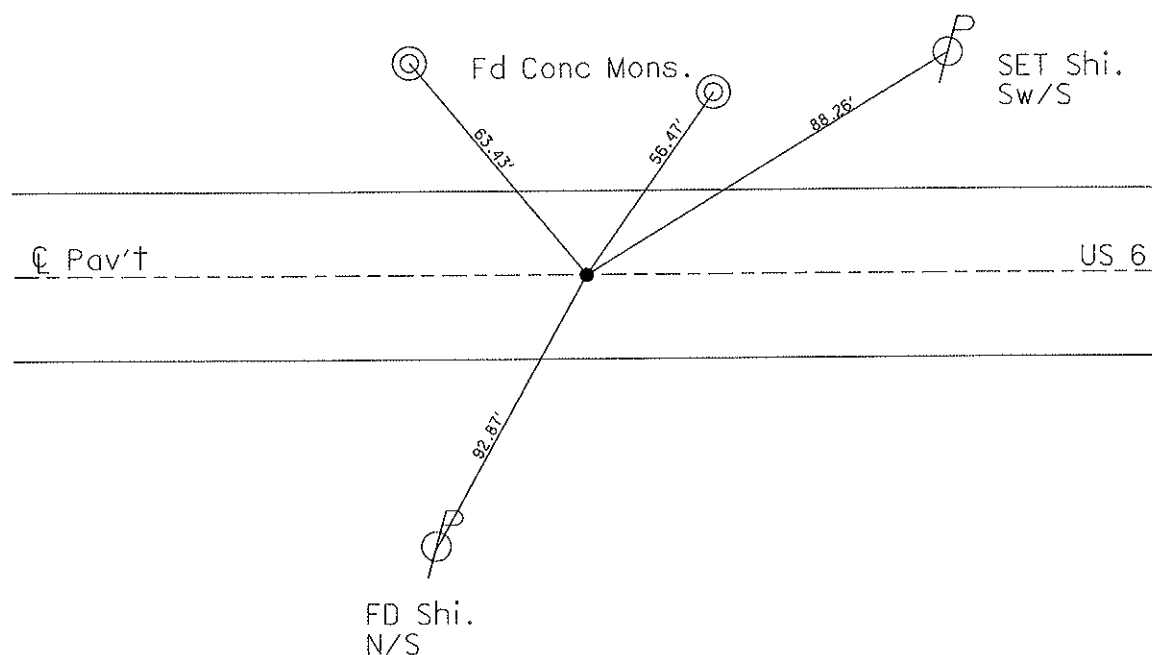

O.D.O.T. DISTRICT 2 SURVEY OFFICE

PERSONNEL

REFERENCE NO. 4

SHEET 4 OF 26

NOTES HOMAN

DATE 8-11-09

ROUTE US 6

H.C. HOMAN

WEATHER CLOUDY

COUNTY SANDUSKY

R.C. ROUSOS

TEMP. 80°

TOWNSHIP MADISON

SECTION 32

T 5 N R 13 E

TYPE MONUMENT BOTH R.R. SPIKES


ON SURFACE - ~~BELOW~~ ON

~~LEFT~~ - CL PAV'T - ~~RIGHT~~ ON

12.3 TOLT. EDGE PAVEMENT

S.L.M. 79+65

GPS Northing: 611358.717 Easting: 1724574.821

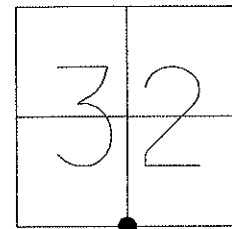


RECORD P.O.T. 79 + 51.71

RESET SM. RR SPK'S 5-6-93

RESET MAGS & WASHERS

11-03-09 DH

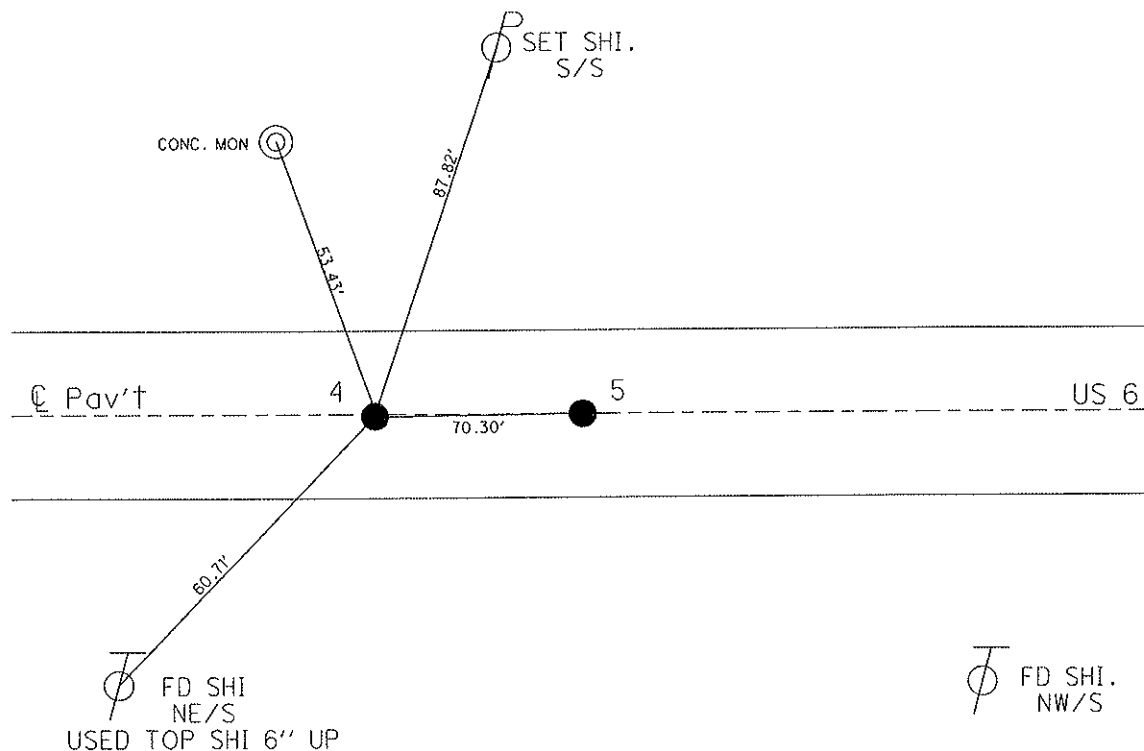

O.D.O.T. DISTRICT 2 SURVEY OFFICE

PERSONNEL

REFERENCE NO. 5

SHEET 5 OF 26

NOTES HOMAN

DATE 8-11-09

ROUTE US 6

H.C. HOMAN

WEATHER CLOUDY

COUNTY SANDUSKY

R.C. ROUSOS

TEMP. 80°

TOWNSHIP MADISON

SECTION 32

T 5 N R 13 E

TYPE MONUMENT BOTH R.R.SPIKES



ON SURFACE - ~~BELOW~~ ON

~~LEFT~~ - Q PAV'T - ~~RIGHT~~ ON

12.3 TOL. EDGE PAVEMENT

S.L.M. A=79+65, B=80+35


GPS Northing: 611357.870 Easting: 1724645.117

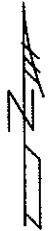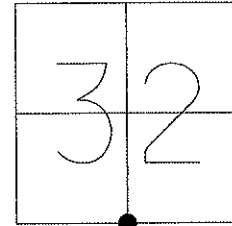

RECORD P.O.T. 80 + 22.00

RESET SM. RR SPK'S 5-6-93

RESET MAGS & WASHER
11-03-09 DH

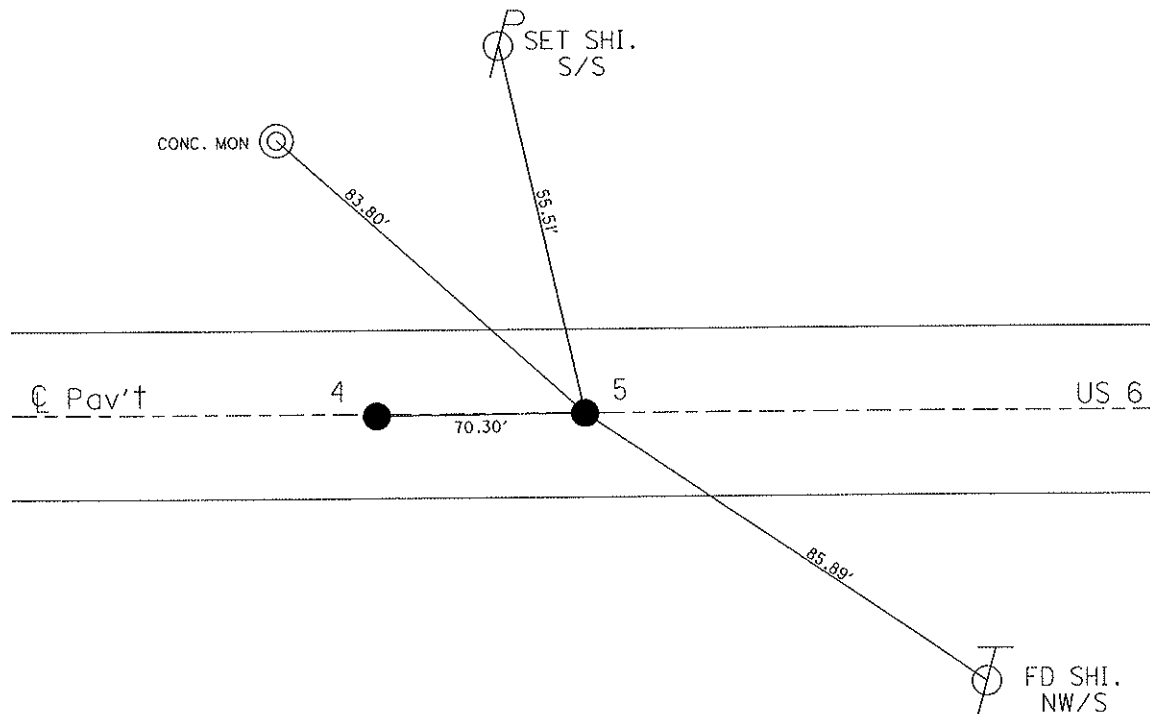

O.D.O.T. DISTRICT 2 SURVEY OFFICE

PERSONNEL

REFERENCE NO. 6

SHEET 6 OF 26

NOTES HOMAN

DATE 8-12-09

ROUTE US 6

H.C. HOMAN

WEATHER CLOUDY

COUNTY SANDUSKY

R.C. ROUSOS

TEMP. 70°

TOWNSHIP MADISON

SECTION 32

T 5 N R 13 E

TYPE MONUMENT R.R. SPIKE


ON SURFACE - ~~BELOW~~ ON

~~LEFT~~ - Q PAV'T - ~~RIGHT~~ ON


12.4 TO RT. EDGE PAVEMENT

S.L.M. 106.70

GPS Northing: 611329.152 Easting: 1727277.200

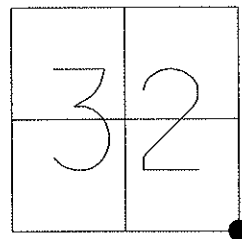

RECORD 106+55.10,
CO. RD. 26 NORTH
RESET SM.R.R. SPIKE
5/6/93 M.B.

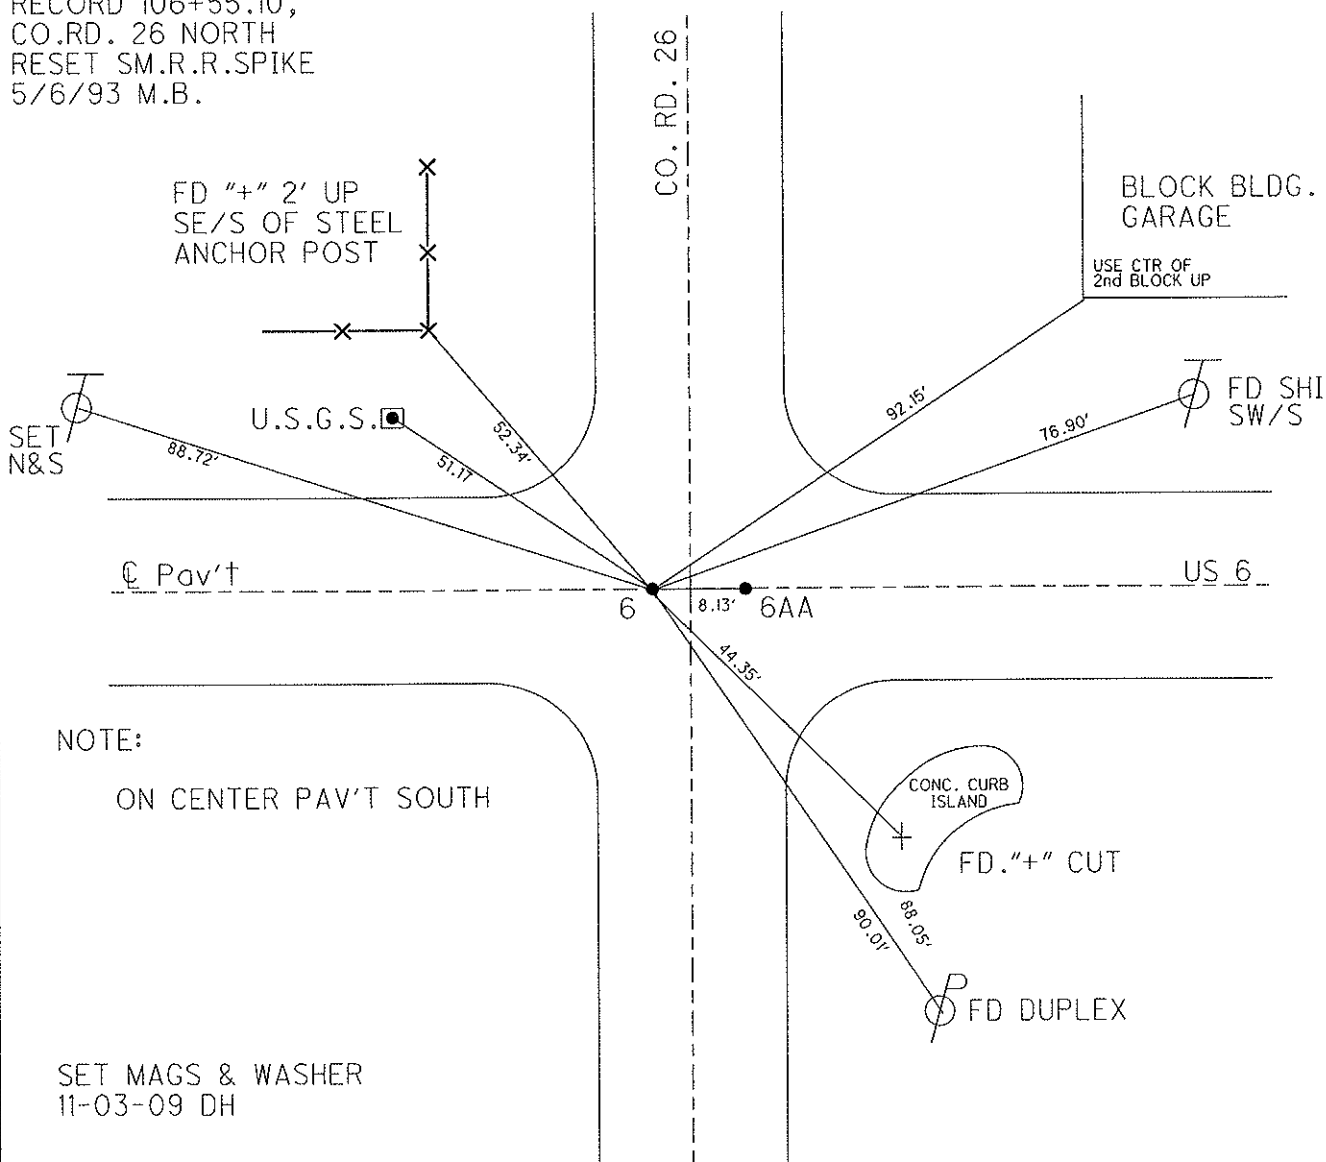

NOTE:

ON CENTER PAV'T SOUTH

SET MAGS & WASHER
11-03-09 DH

O.D.O.T. DISTRICT 2 SURVEY OFFICE

PERSONNEL

REFERENCE NO. 6AA

SHEET 7 OF 26

NOTES HOMAN

DATE 8-12-09

ROUTE US 6

H.C. HOMAN

WEATHER CLOUDY

COUNTY SANDUSKY

R.C. ROUSOS

TEMP. 70°

TOWNSHIP MADISON

SECTION 32

T 5 N R 13 E

TYPE MONUMENT R.R. SPIKES



ON SURFACE - ~~BELOW~~ ON

~~LEFT~~ - Q PAV'T - ~~RIGHT~~ ON

12.4 TORT. EDGE PAVEMENT

S.L.M. 106+78.13

GPS Northing: 6611328.999 Easting: 1727285.337

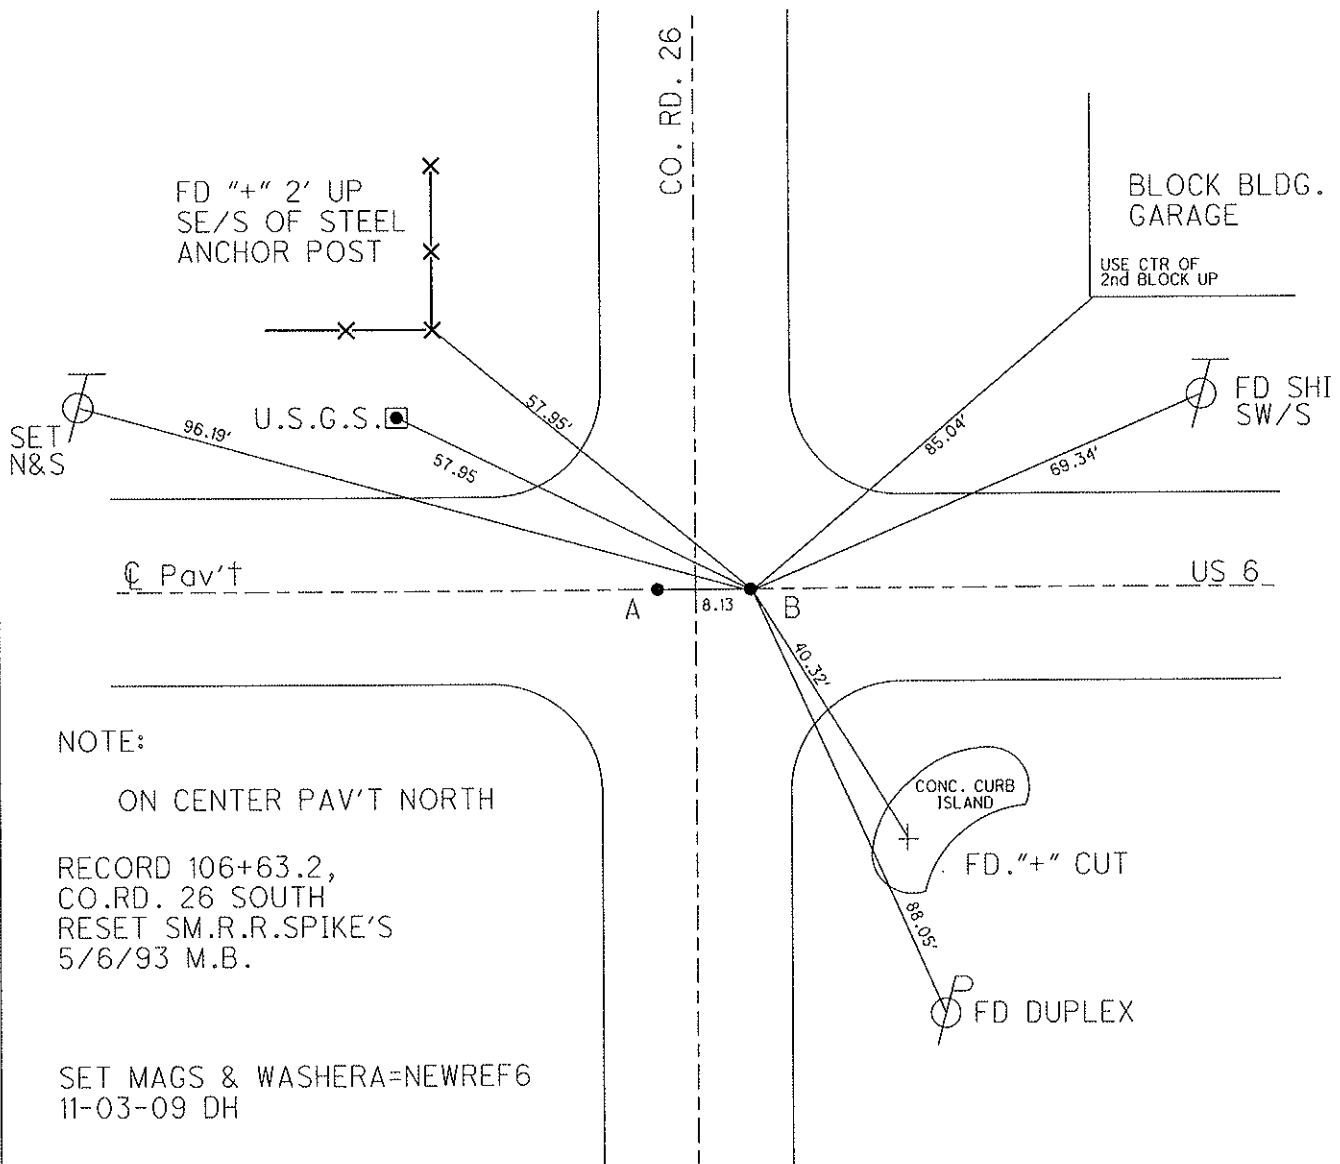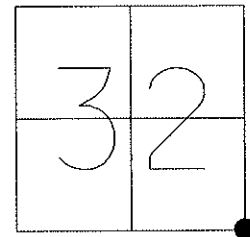

O.D.O.T. DISTRICT 2 SURVEY OFFICE

PERSONNEL

REFERENCE NO. 6-A

SHEET 8 OF 26

NOTES HOMAN

DATE 8-12-09

ROUTE US 6

H.C. HOMAN

WEATHER CLOUDY

COUNTY SANDUSKY

R.C. ROUSOS

TEMP. 75°

TOWNSHIP MADISON

SECTION 33

T 5 N R 13 E

TYPE MONUMENT MON BOX



ON SURFACE - ~~BELOW~~ ON

~~LEFT~~ - Q PAV'T - ~~RIGHT~~ ON

12.5 TORT. EDGE PAVEMENT


S.L.M. 126 + 13

GPS Northing: 611308.6401 Easting: 1729208.9346

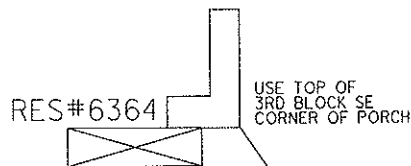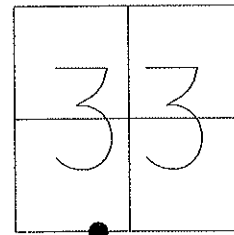

RECORD PI=125+86.84

RESET SM RR SPK.
5-6-93 M.B.

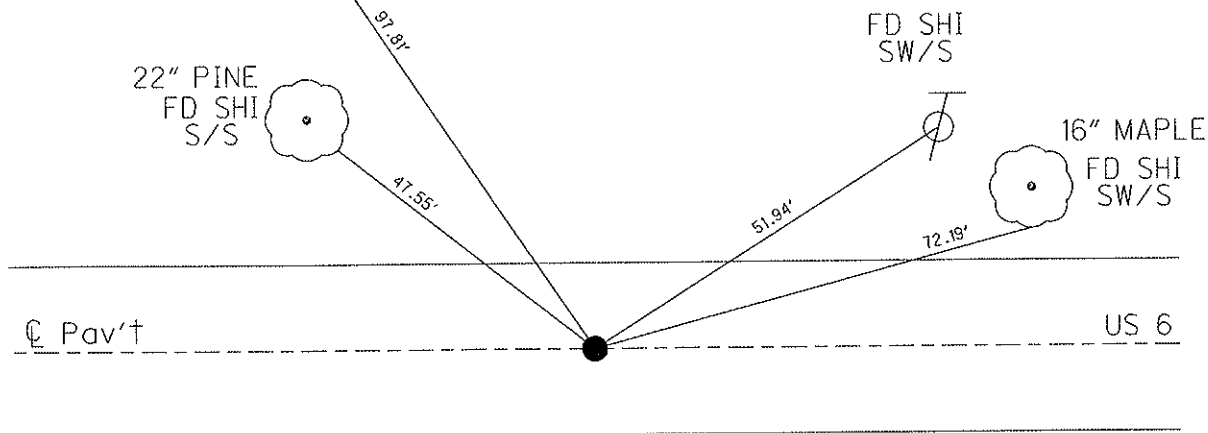

O.D.O.T. DISTRICT 2 SURVEY OFFICE

PERSONNEL

REFERENCE NO. 6-B

SHEET 9 OF 26

NOTES

HOMAN

DATE 8-12-09

ROUTE US 6

H.C.

HOMAN

WEATHER CLOUDY

COUNTY SANDUSKY

R.C.

ROUSOS

TEMP. 75°

TOWNSHIP MADISON

SECTION 33

T 5 N R 13 E

TYPE MONUMENT IRON PIN IN CONC.



ON SURFACE - ~~BELOW~~ ON

LEFT - Q PAV'T - ~~RIGHT~~ 0.6"

11.8 TOLT. EDGE PAVEMENT


S.L.M. 133+29

GPS Northing: 611300.1151 Easting: 1729917.0445

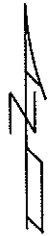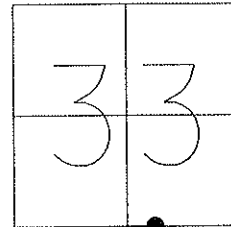

RECORD: P.I.=132+96.14

RESET SM R.R. SPIKE
5-6-93 M.B.

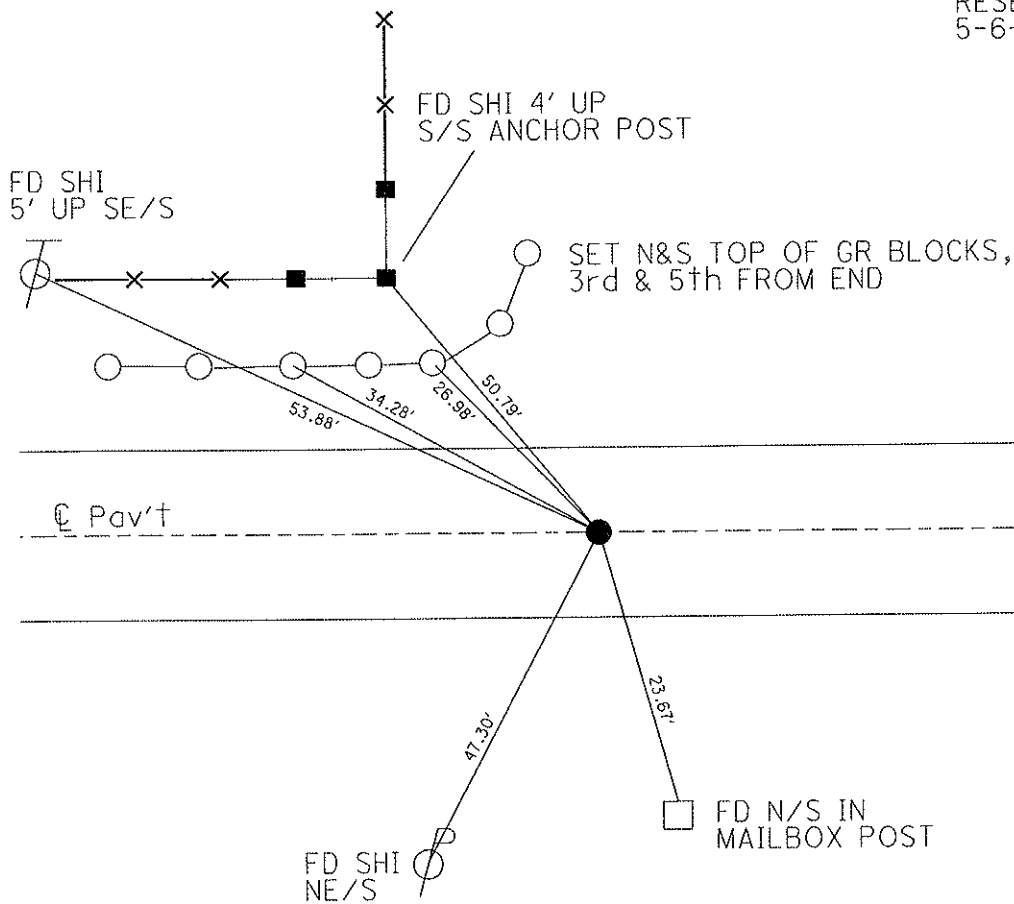

O.D.O.T. DISTRICT 2 SURVEY OFFICE

PERSONNEL

REFERENCE NO. 7

SHEET 10 OF 26

NOTES HOMAN

DATE 8-12-09

ROUTE US 6

H.C. HOMAN

WEATHER CLOUDY

COUNTY SANDUSKY

R.C. ROUSOS

TEMP. 75°

TOWNSHIP MADISON

SECTION 33

T 5 N R 13 E

TYPE MONUMENT R.R. SPIKE



ON SURFACE - ~~BELOW~~ ON

~~LEFT~~ - Q PAV'T - ~~RIGHT~~ ON

12.4 TOLT. EDGE PAVEMENT

S.L.M. 159 + 38


GPS Northing: 611254.814 Easting: 1732519.867

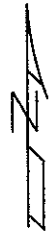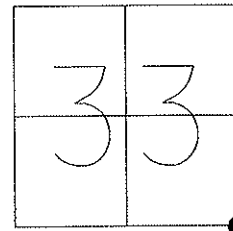

RECORD: STA. 159+38

RESET SM. R.R. SPIKE
5/06/93 M.B.

RESET MAG & WASHER
NEWREF 11-03-09 D.H.

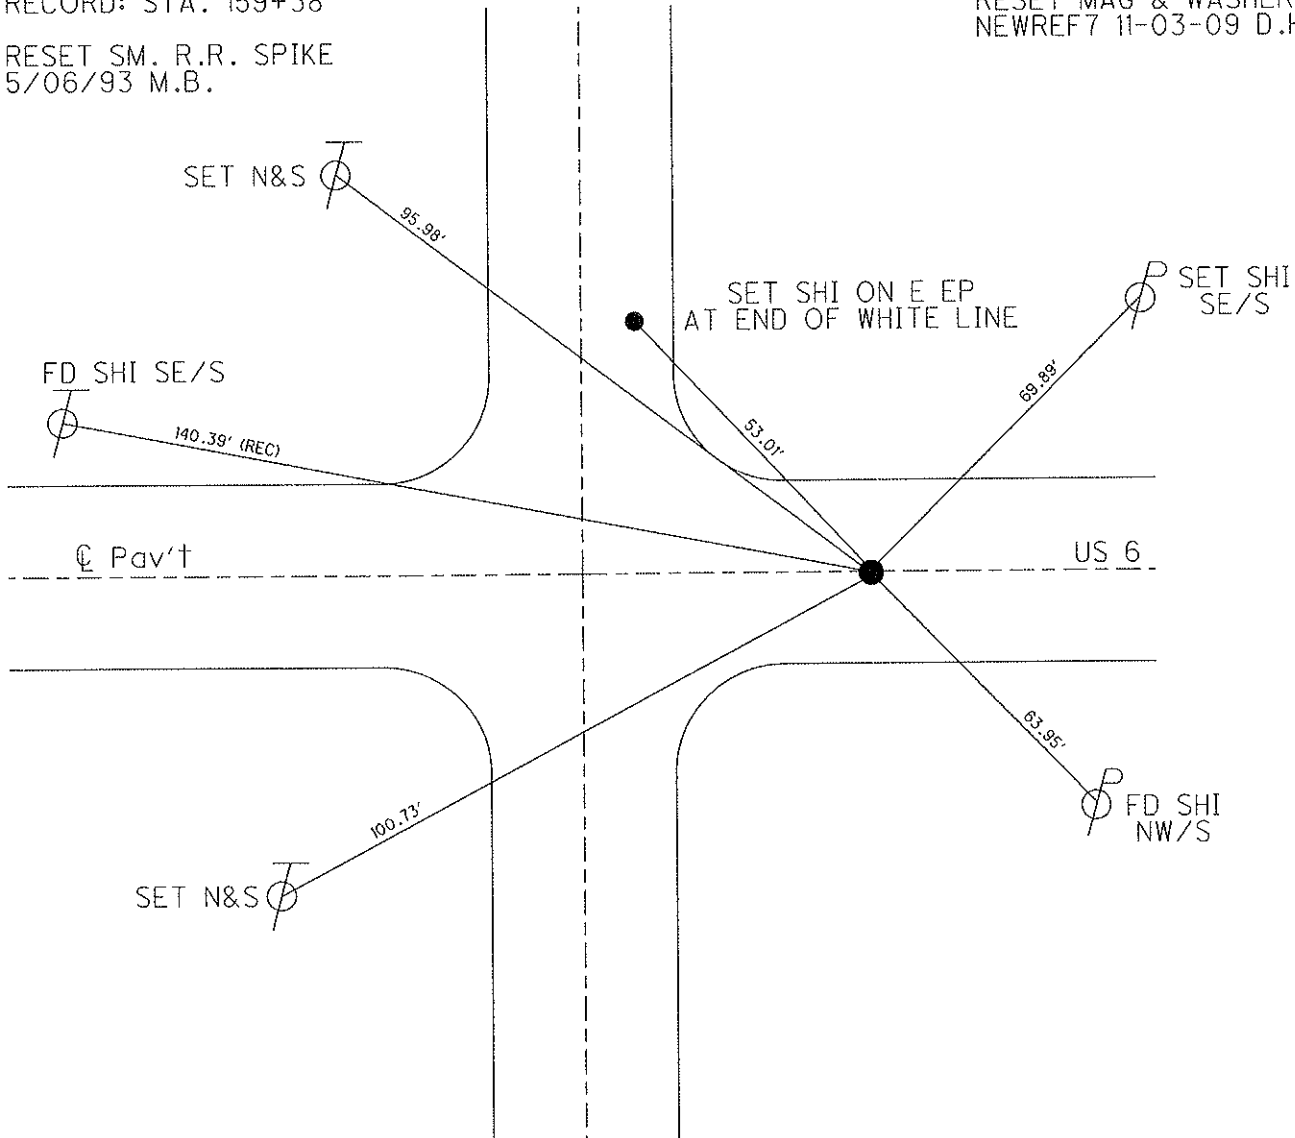

O.D.O.T. DISTRICT 2 SURVEY OFFICE

PERSONNEL

REFERENCE NO. 7A

SHEET 11 OF 26

NOTES HOMAN

DATE 8-12-09

ROUTE US 6

H.C. HOMAN

WEATHER CLOUDY

COUNTY SANDUSKY

R.C. ROUSOS

TEMP. 75°

TOWNSHIP MADISON

SECTION 34

T 5 N R 13 E

TYPE MONUMENT R.R. SPIKE


ON SURFACE - ~~BELOW~~ ON

~~LEFT~~ - Q PAV'T - ~~RIGHT~~ ON

12.3 TOLT. EDGE PAVEMENT

S.L.M. 180 + 40


GPS Northing: 611212.634 Easting: 1734619.145

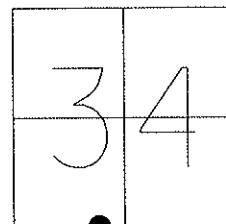

RECORD: STA. 180+00

RESET SM. R.R. SPIKE
5-06-93 M.B.



SET MAG & WASHER
NEWREFA7, 11/03/09 D.H.

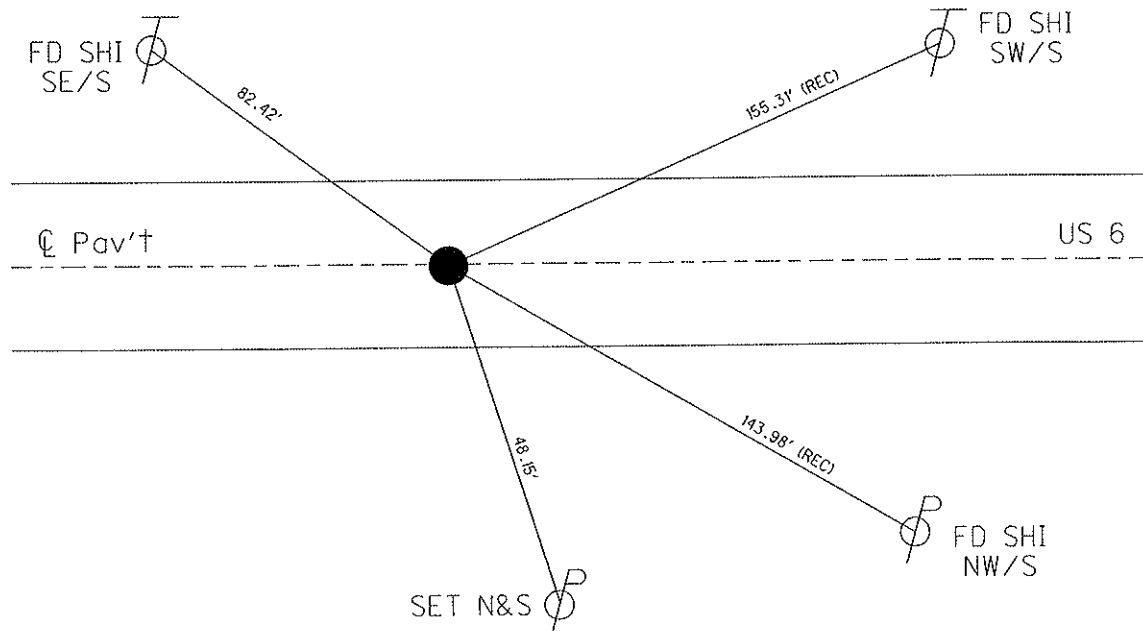

O.D.O.T. DISTRICT 2 SURVEY OFFICE (USE ONLY)

PERSONNEL _____ REFERENCE NO. 8 SHEET 12 OF 27
 NOTES _____ DATE 8/12/09 ROUTE US 6
 H.C. HOMAN WEATHER CLOUDY COUNTY SANDUSKY
 R.C. ROUSOS TEMP. 75° TOWNSHIP MADISON
 _____ SECTION 34
 _____ T 5 N R 13 E

TYPE MONUMENT R.R.SPIKE
 ON SURFACE - ~~BELOW~~ ON
 LEFT - Q PAV'T - RIGHT ON
12.8' TO LT EDGE PAVEMENT
 S.L.M. 212+49
 GPS NORTHING: 611137.165 EASTING: 1737816.929

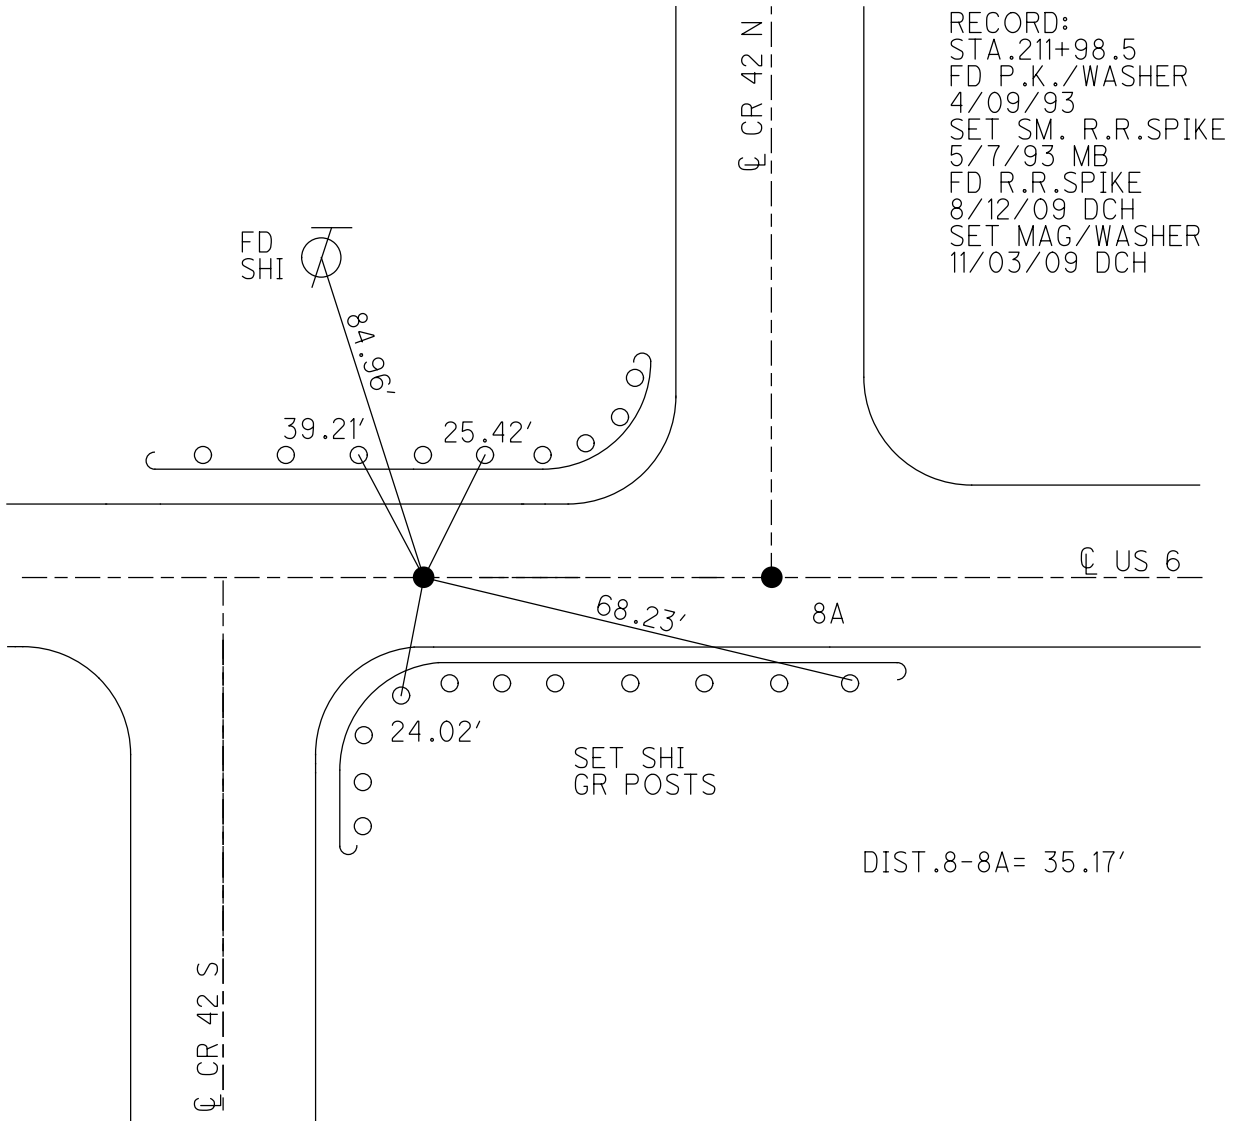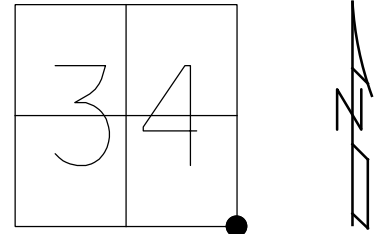

O.D.O.T. DISTRICT 2 SURVEY OFFICE (USE ONLY)

PERSONNEL

REFERENCE NO.

8 A

SHEET

13

OF 27

NOTES

HOMAN

DATE

8/12/09

ROUTE

US 6

H.C.

HOMAN

WEATHER

CLOUDY

COUNTY

SANDUSKY

R.C.

ROUSOS

TEMP.

75°

TOWNSHIP

MADISON

SECTION

34

T 5

N

R 13

E

TYPE MONUMENT

P.K.NAIL

ON SURFACE - ~~BELOW~~

ON

LEFT - ~~Q~~ PAV'T - RIGHT

ON

12.8'

TO LT EDGE PAVEMENT

S.L.M.




212+84.17

GPS NORTHING:

611136.505

EASTING:

1737852.051

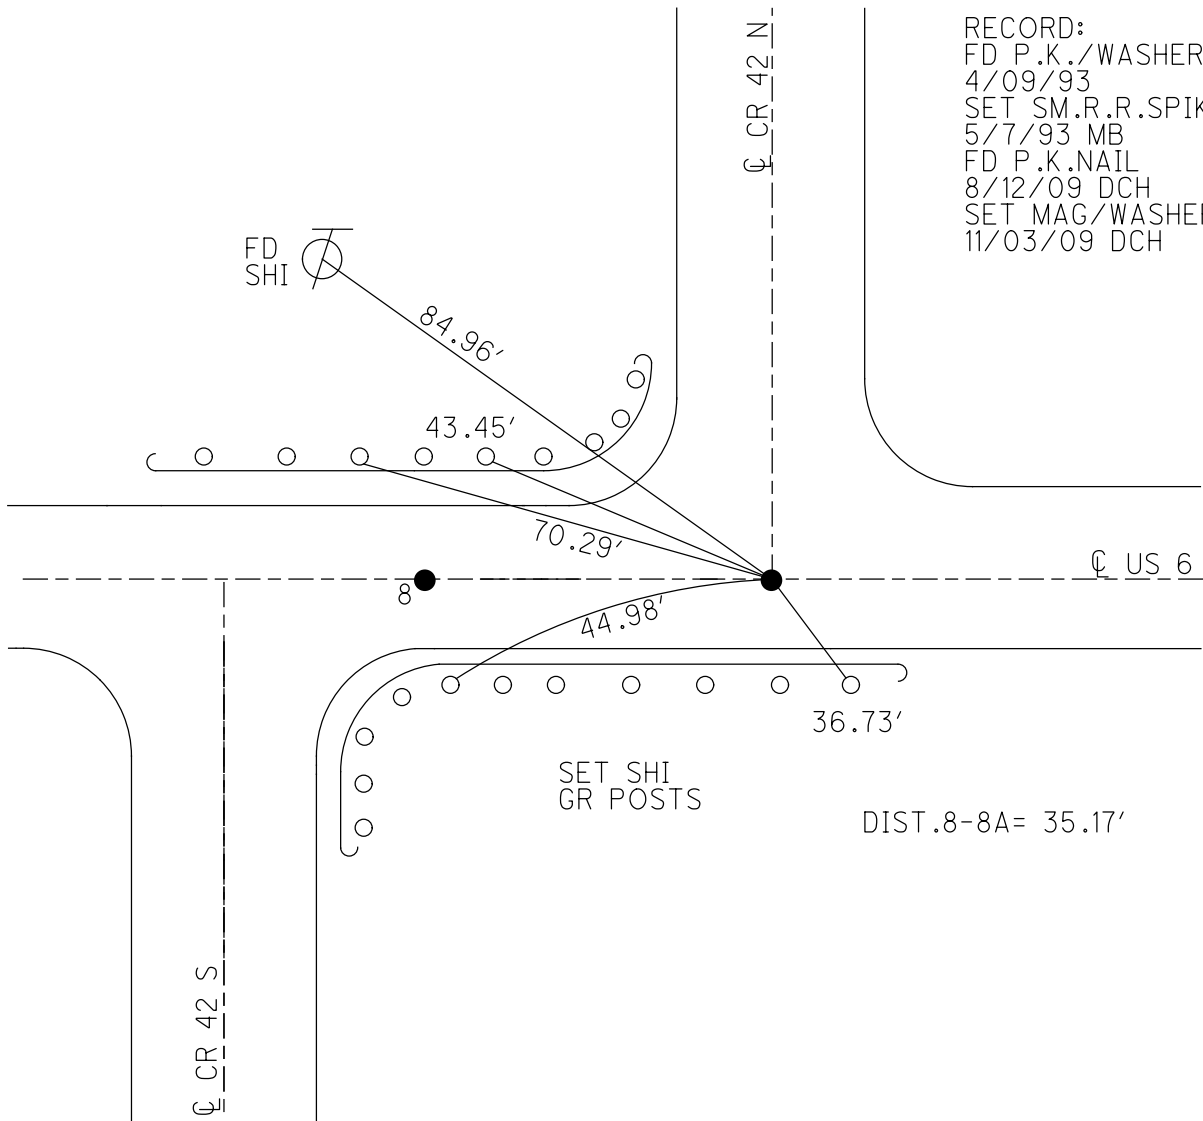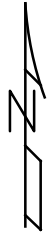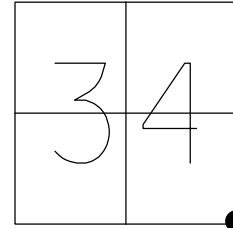

RECORD:

FD P.K./WASHER

4/09/93

SET SM.R.R.SPIKE

5/7/93 MB

FD P.K.NAIL

8/12/09 DCH

SET MAG/WASHER

11/03/09 DCH

O.D.O.T. DISTRICT 2 SURVEY OFFICE

PERSONNEL

REFERENCE NO. 8B

SHEET 14 OF 26

NOTES HOMAN

DATE 8/12/09

ROUTE US 6

H.C. HOMAN

WEATHER CLOUDY

COUNTY SANDUSKY

R.C. ROUSOS

TEMP. 75°

TOWNSHIP MADISON

SECTION 35

T 5 N R 14 E

TYPE MONUMENT R.R.SPIKE



ON SURFACE - ~~BELOW~~ ON

~~LEFT~~ - Q PAV'T - ~~RIGHT~~ ON

12.0' TO RT EDGE PAVEMENT

S.L.M. 225+55 (RECORD 225+00)

GPS Northing: 611115.846 Easting: 1739116.695

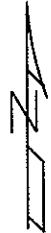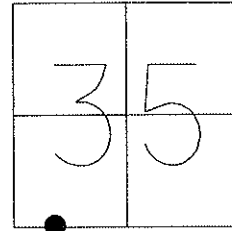


FD P.K. & WASHER
4/09/93

RESET SM. R.R.SPIKE
5/7/93 M.B.

FD R.R.SPIKE
8/12/09 DCH

RESET MAG & WASHER
11/03/09 DCH

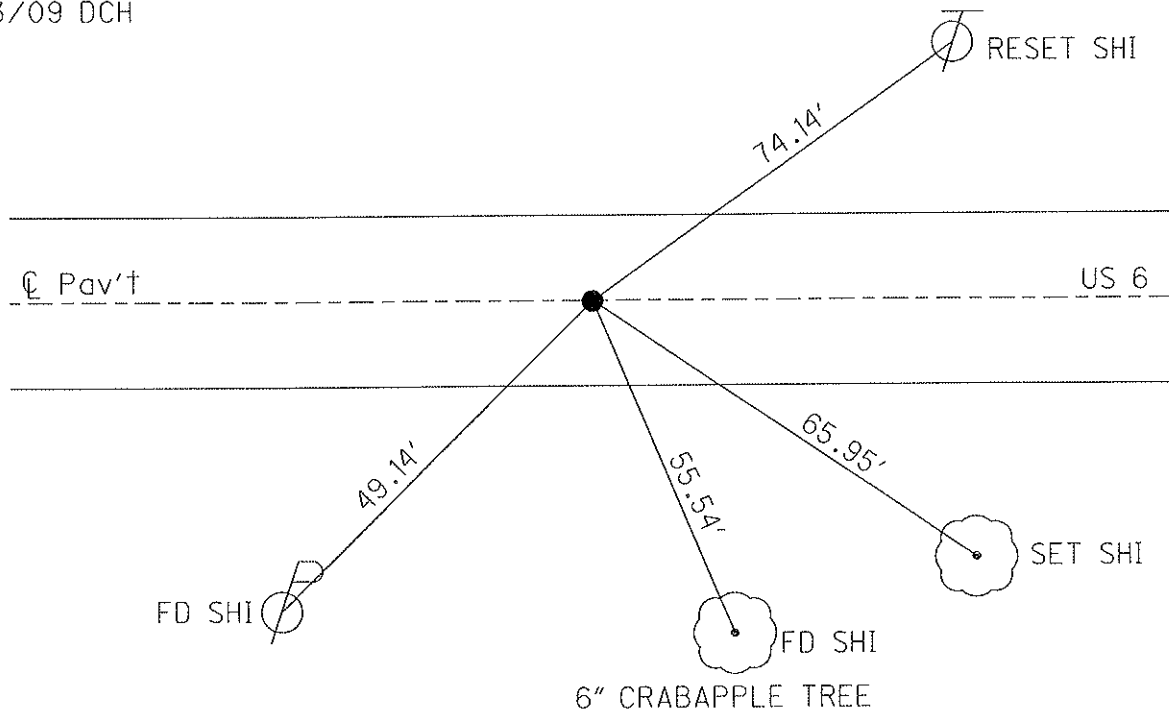

O.D.O.T. DISTRICT 2 SURVEY OFFICE

PERSONNEL

REFERENCE NO. 9

SHEET 15 OF 26

NOTES HOMAN

DATE 8/12/09

ROUTE US 6

H.C. HOMAN

WEATHER CLOUDY

COUNTY SANDUSKY

R.C. ROUSOS

TEMP. 75°

TOWNSHIP MADISON

SECTION 35

T 5 N R 13 E

TYPE MONUMENT R.R.SPIKE



ON SURFACE - ~~BELOW~~ ON

~~LEFT~~ - Q PAV'T - ~~RIGHT~~ ON

12.9 TO LT EDGE PAVEMENT

S.L.M. 239+12

GPS Northing: 611102.026 Easting: 1740468.868

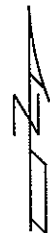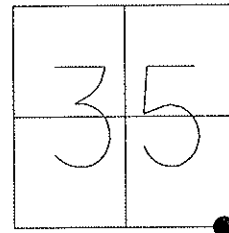

FD P.K. & WASHER
4/09/93


RESET SM. R.R.SPIKE
5/7/93 M.B.

FD R.R.SPIKES
8/12/09 DCH

RESET MAGS & WASHER
11/03/09 DCH

RECORD:
SMALL SPKS
238+53.07
CO.RD.50 SOUTH

NOTE: 4/9/93
1.6 WEST OF Q SOUTH

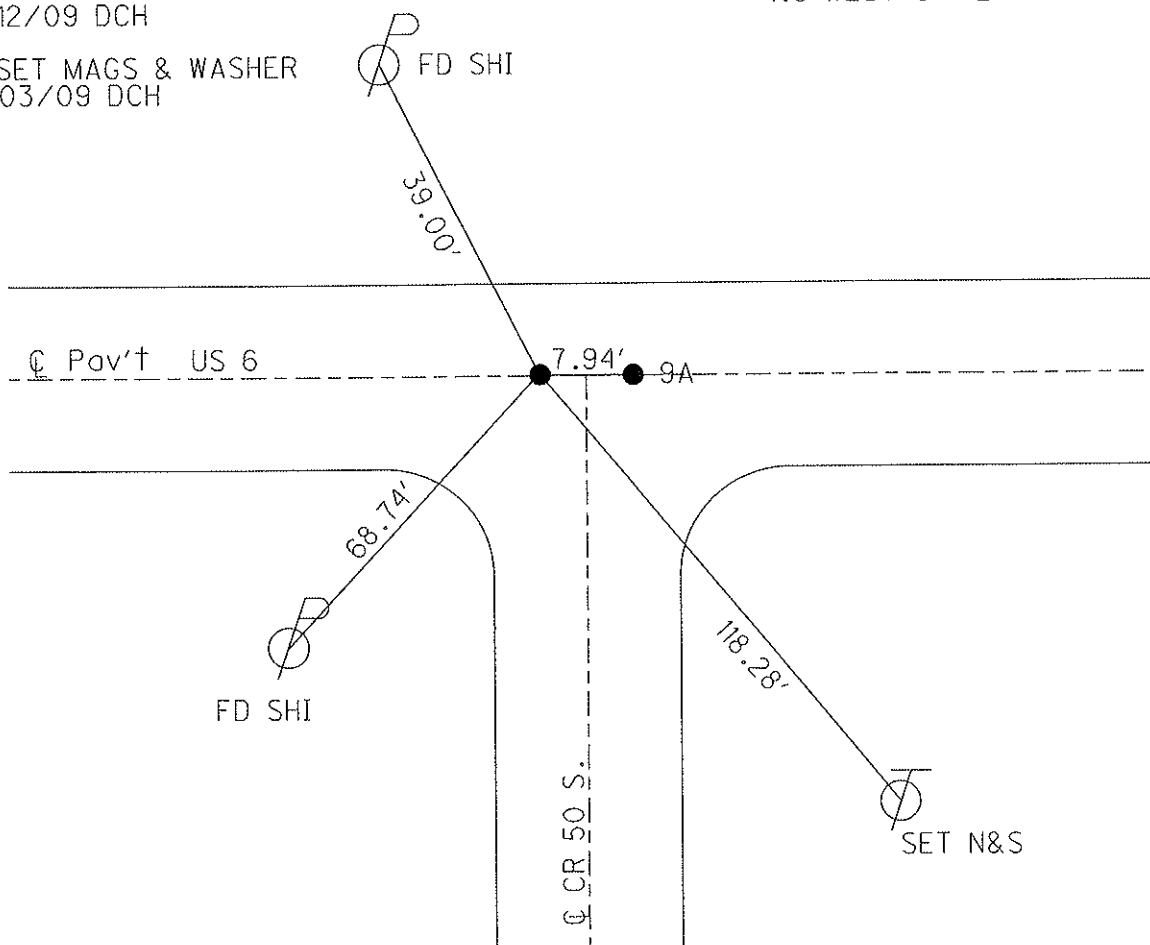

O.D.O.T. DISTRICT 2 SURVEY OFFICE

PERSONNEL

REFERENCE NO. 9A

SHEET 16 OF 26

NOTES HOMAN

DATE 8/12/09

ROUTE US 6

H.C. HOMAN

WEATHER CLOUDY

COUNTY SANDUSKY

R.C. ROUSOS

TEMP. 75°

TOWNSHIP MADISON

SECTION 35

T 5 N R 13 E

TYPE MONUMENT RR SPIKE


ON SURFACE - ~~BELOW~~ ON

~~LEFT~~ - Q PAV'T - ~~RIGHT~~ ON

12.9 TO LT EDGE PAVEMENT

S.L.M. PT. A= 239+12

GPS Northing: 611102.058 Easting: 1740476.820

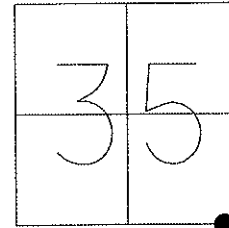

FD P.K. & WASHER

4/09/93

RESET SM. R.R.SPIKE

5/7/93 M.B.

FD R.R.SPIKES

8/12/09 DCH

RESET MAG & WASHER 11/03/09 DCH

RECORD:


SMALL SPKS

238+53.07

CO.RD.50 SOUTH

NOTE: 4/9/93

PT. IS 6.2 EAST OF Q SOUTH

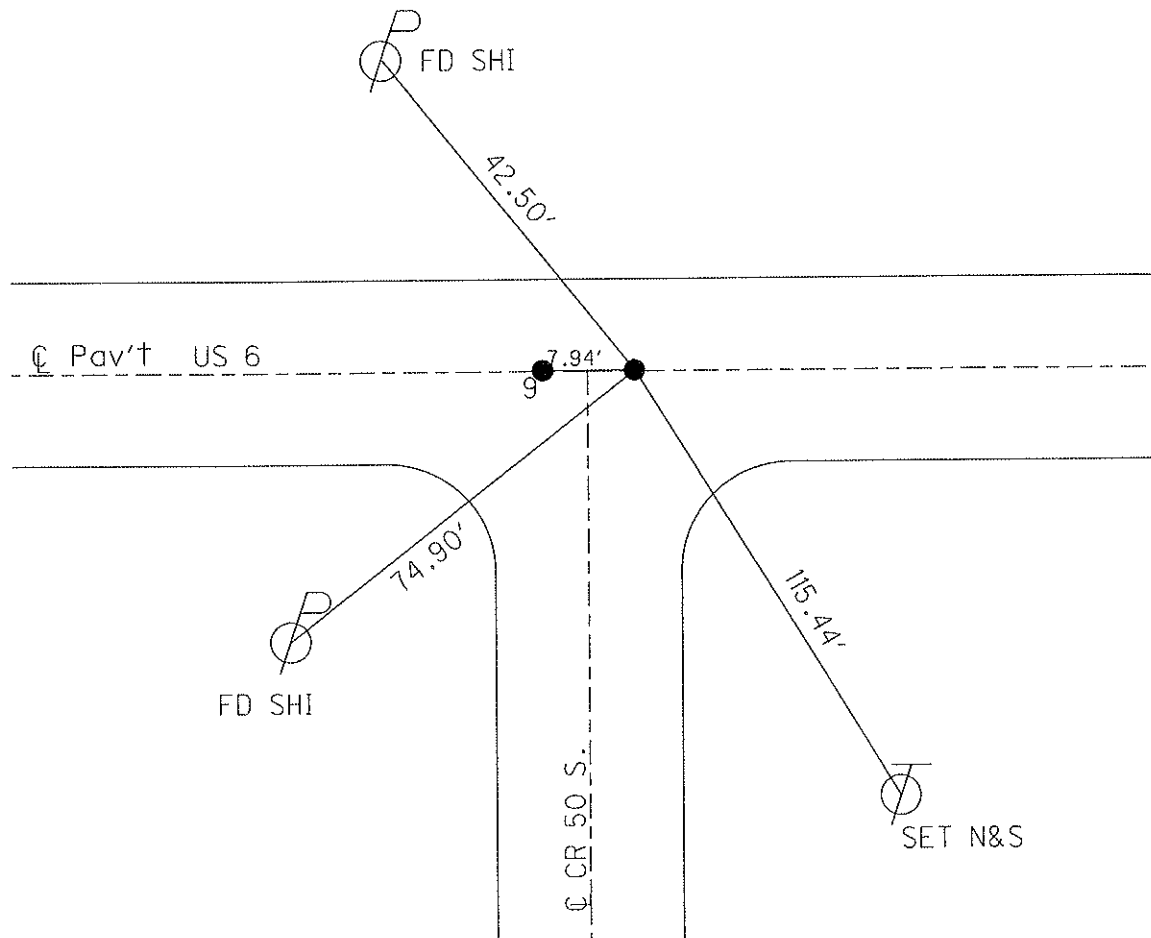

O.D.O.T. DISTRICT 2 SURVEY OFFICE

PERSONNEL

REFERENCE NO. 10

SHEET 17 OF 26

NOTES HOMAN

DATE 8/12/09

ROUTE US 6

H.C. HOMAN

WEATHER CLOUDY

COUNTY SANDUSKY

R.C. ROUSOS

TEMP. 75°

TOWNSHIP MADISON

SECTION 35

T 5 N R 13 E

TYPE MONUMENT P.K. SHANK



ON SURFACE - ~~BELOW~~ ON

~~LEFT~~ - Q PAV'T - ~~RIGHT~~ ON & 1.0 E. OF Q SR 300

12.5 TO RT EDGE PAVEMENT

S.L.M. 265+66

GPS Northing: 611089.369 Easting: 1743115.029

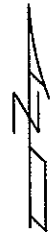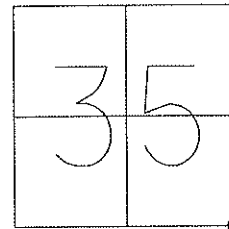


RECORD 265+00

FD P.K. & WASHER
4/06/93

RESET SM. R.R. SPIKE
5/7/93 M.B.

FD P.K. SHANK
8/12/09 DCH

RESET MAG/WASHER
11/03/09 DCH

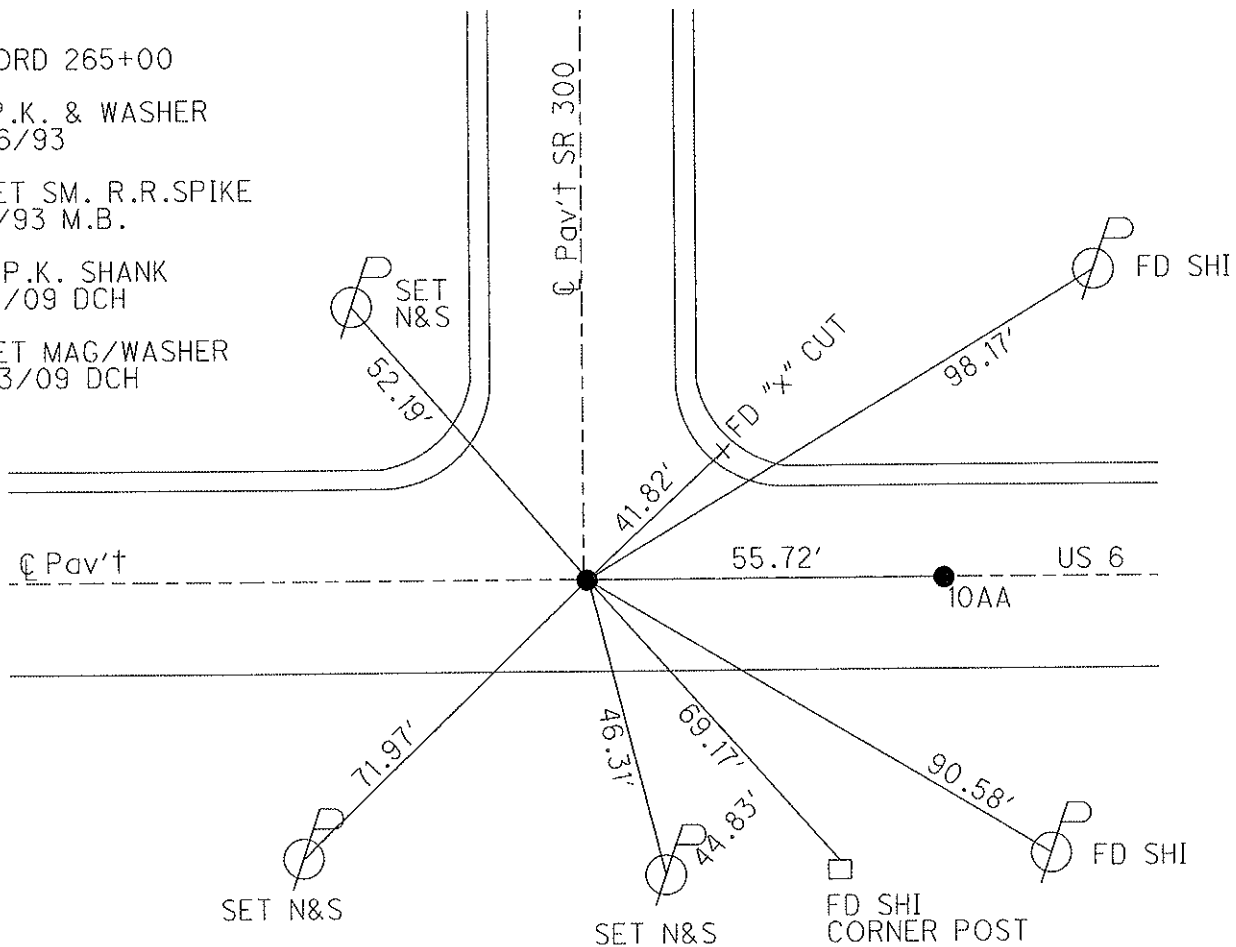

O.D.O.T. DISTRICT 2 SURVEY OFFICE

PERSONNEL

REFERENCE NO. 10AA

SHEET 18 OF 26

NOTES HOMAN

DATE 8/12/09

ROUTE US 6

H.C. HOMAN

WEATHER CLOUDY

COUNTY SANDUSKY

R.C. ROUSOS

TEMP. 75°

TOWNSHIP MADISON

SECTION 35

T 5 N R 13 E

TYPE MONUMENT RR SPIKE



ON SURFACE - ~~BELOW~~ ON

~~LEFT~~ - Q PAV'T - ~~RIGHT~~ ON

12.5 TO RT EDGE PAVEMENT

S.L.M. 265+66


GPS Northing: 611089.451 Easting: 1743170.708

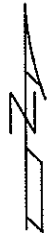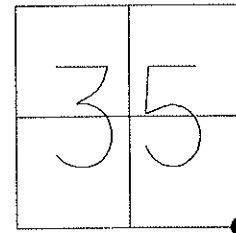

RESET SM. R.R.SPIKE
5/7/93 M.B.

FD R.R.SPIKE
8/12/09 DCH

RESET MAG/WASHER
11/03/09 DCH

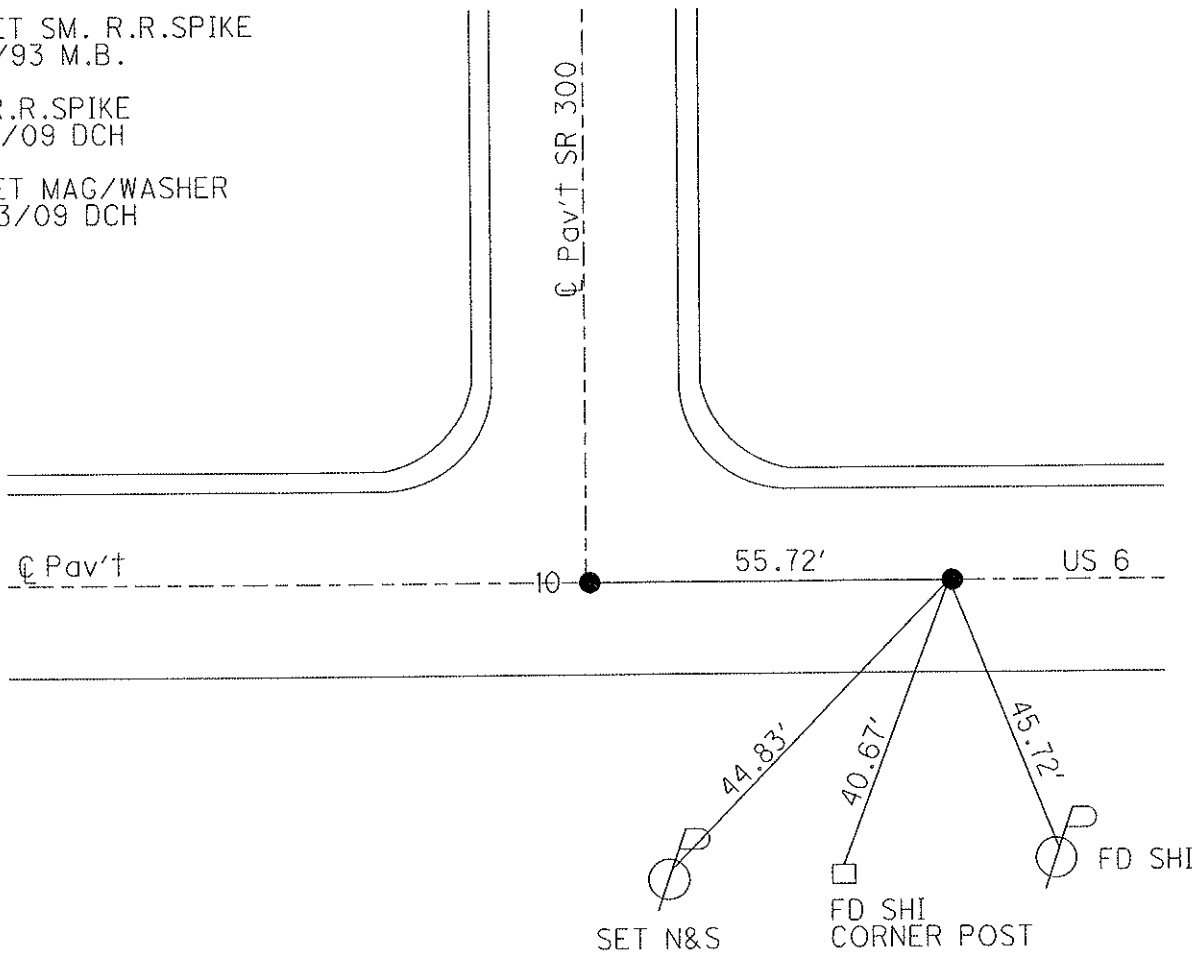

O.D.O.T. DISTRICT 2 SURVEY OFFICE

PERSONNEL

REFERENCE NO. 10A

SHEET 19 OF 26

NOTES HOMAN

DATE 8/12/09

ROUTE US 6

H.C. HOMAN

WEATHER CLOUDY

COUNTY SANDUSKY

R.C. ROUSOS

TEMP. 75°

TOWNSHIP MADISON

SECTION 36

T 5 N R 13 E

TYPE MONUMENT RR SPIKE


ON SURFACE - ~~BELOW~~ ON

~~LEFT~~ - ℄ PAV'T - ~~RIGHT~~ ON

13.2' TO RT EDGE PAVEMENT

S.L.M. 282+10

GPS Northing: 611101.456 Easting: 1744757.048

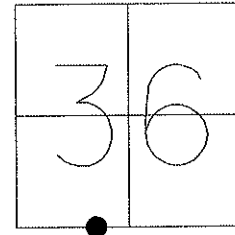


RECORD 281+43.08

FD P.K. & WASHER
4/06/93

RESET SM. R.R.SPIKE
5/7/93 M.B.

FD R.R.SPIKE
8/12/09 DCH

RESET MAG & WASHER
NEWREFB10
11/03/09 DCH

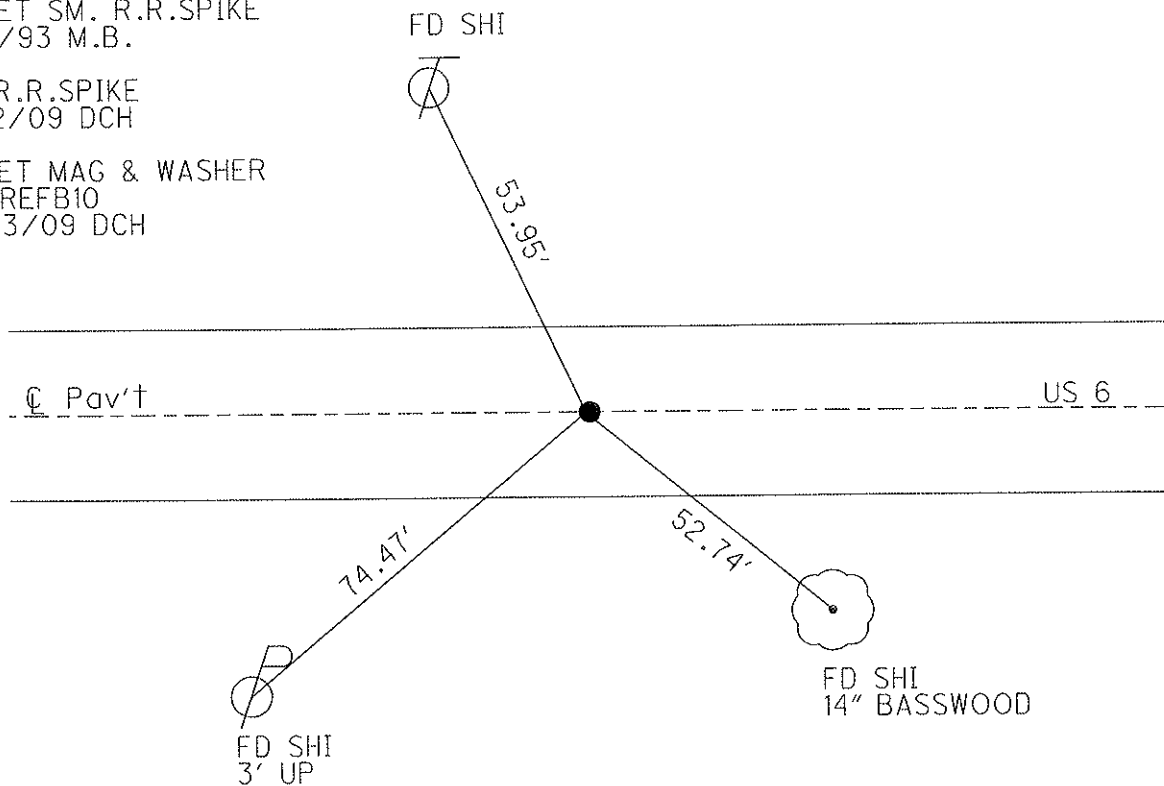

O.D.O.T. DISTRICT 2 SURVEY OFFICE

PERSONNEL

REFERENCE NO. 11

SHEET 20 OF 26

NOTES HOMAN

DATE 8/12/09

ROUTE US6

H.C. HOMAN

WEATHER CLOUDY

COUNTY SANDUSKY

R.C. ROUSOS

TEMP. 75°

TOWNSHIP MADISON

SECTION 36

T 5 N R 13 E

TYPE MONUMENT RR SPIKE




ON SURFACE - BELOW ON

~~LEFT~~ - Q PAV'T - RIGHT ON

12.7 TO RT EDGE PAVEMENT

S.L.M. 292+17

GPS Northing: 611105.170 Easting: 1745758.548

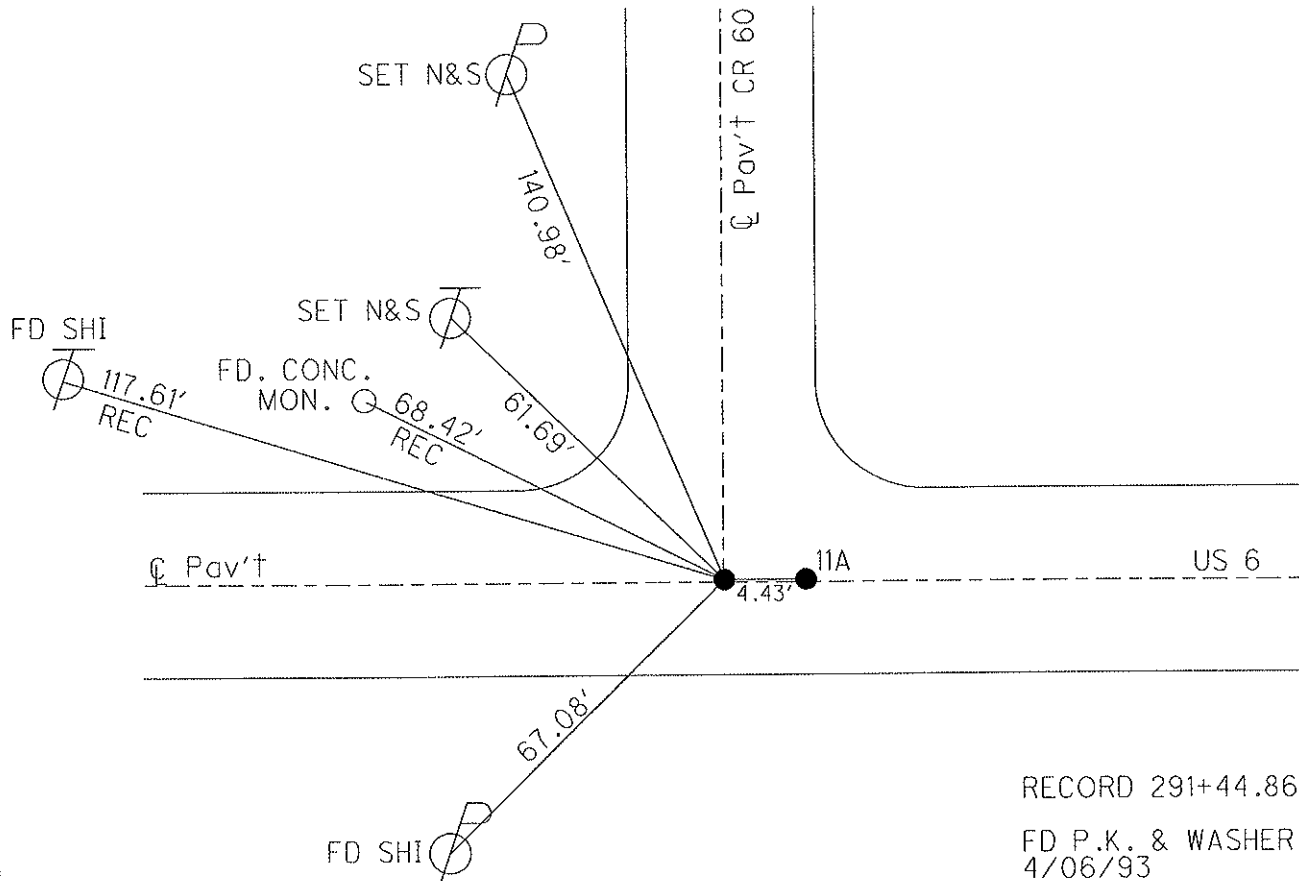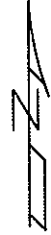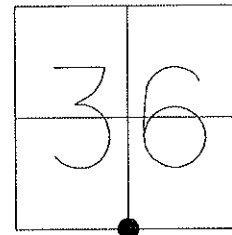

RECORD 291+44.86

FD P.K. & WASHER
4/06/93

RESET SM. R.R.SPIKE
5/7/93 M.B.

FD R.R.SPIKE
8/12/09 DCH

RESET MAG & WASHER
11/04/09 DCH

O.D.O.T. DISTRICT 2 SURVEY OFFICE

PERSONNEL

REFERENCE NO. 11 A

SHEET 21 OF 26

NOTES HOMAN

DATE 8/12/09

ROUTE US6

H.C. HOMAN

WEATHER CLOUDY

COUNTY SANDUSKY

R.C. ROUSOS

TEMP. 75°

TOWNSHIP MADISON

SECTION 36

T 5 N R 13 E

TYPE MONUMENT RR SPIKE



ON SURFACE - BELOW ON

~~LEFT~~ - Q PAV'T - RIGHT ON

12.7 TO RT EDGE PAVEMENT

S.L.M.

GPS Northing: 611105.144 Easting: 1745762.925

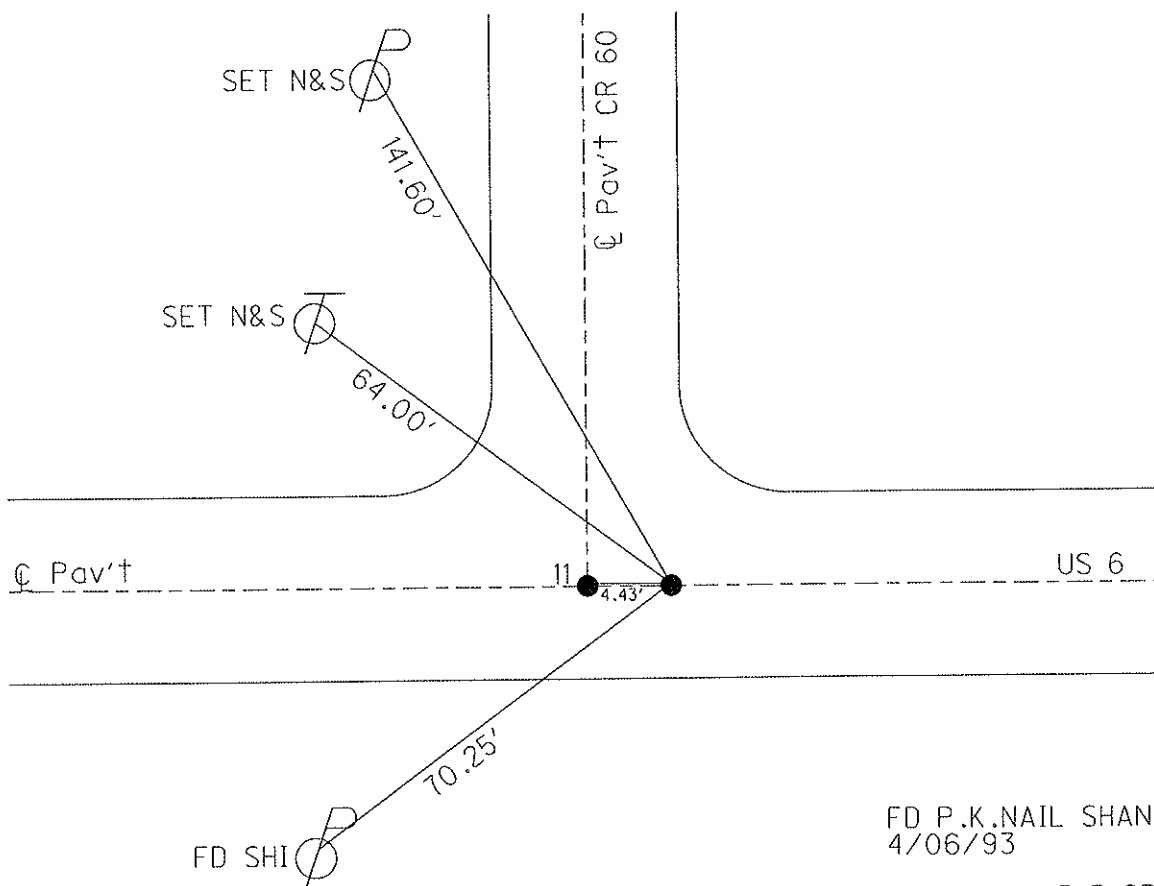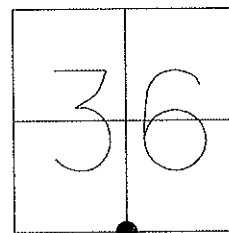

FD P.K.NAIL SHANK
4/06/93

RESET SM. R.R.SPIKE
5/7/93 M.B.

FD R.R.SPIKE
8/12/09 DCH

RESET MAG & WASHER
11/04/09 DCH

O.D.O.T. DISTRICT 2 SURVEY OFFICE

PERSONNEL

REFERENCE NO. 12

SHEET 22 OF 26

NOTES HUMAN _____

DATE 8/12/09

ROUTE US 6

H.C. HOMAN

WEATHER CLOUDY

COUNTY SANDUSKY

R.C. ROUSOS

TEMP. 75°

TOWNSHIP MADISONSECTION 36

T 5 N R 13 E

TYPE MONUMENT RR SPIKE


ON SURFACE - BELOW _____ ON _____

~~LEFT~~ - C PAV'T - ~~RIGHT~~ ON

11.7 TOLL EDGE PAVEMENT

S.L.M. 307+27

GPS Northing: 611103.733 Easting: 1747260.915

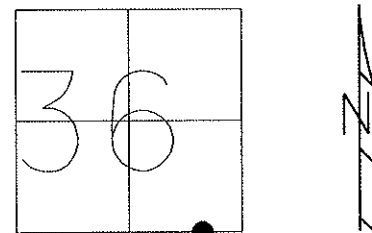


RECORD 306+47.78

FD P.K. & WASHER,
4/06/93

RESET SM. R.R.SPIKE
5/7/93 M.B.

FD R.R.SPIKE
8/12/09 DCH

RESET MAG & WASHER
11/04/09 DCH

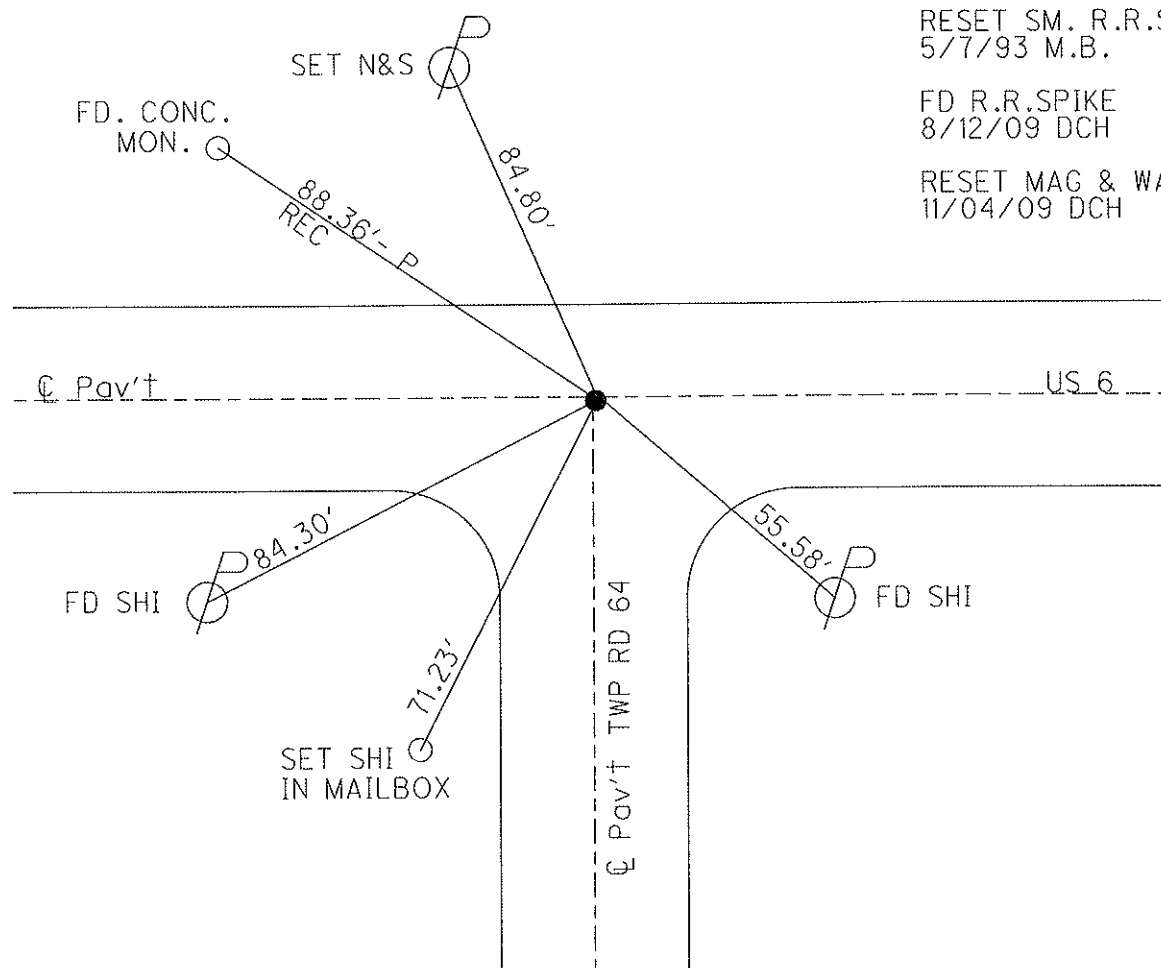

O.D.O.T. DISTRICT 2 SURVEY OFFICE

PERSONNEL

REFERENCE NO. 13

SHEET 23 OF 26

NOTES HOMAN

DATE 8/12/09

ROUTE US6

H.C. HOMAN

WEATHER CLOUDY

COUNTY SANDUSKY

R.C. ROUSOS

TEMP. 75°

TOWNSHIP WASHINGTON

SECTION 31

T 5 N R 14 E

TYPE MONUMENT R.R.SPIKE



ON SURFACE - ~~BELOW~~ ON

~~LEFT~~ - Q PAV'T - ~~RIGHT~~ ON

14.0 TO RT EDGE PAVEMENT

S.L.M. 318+60

GPS Northing: 611104.403 Easting: 1748392.290

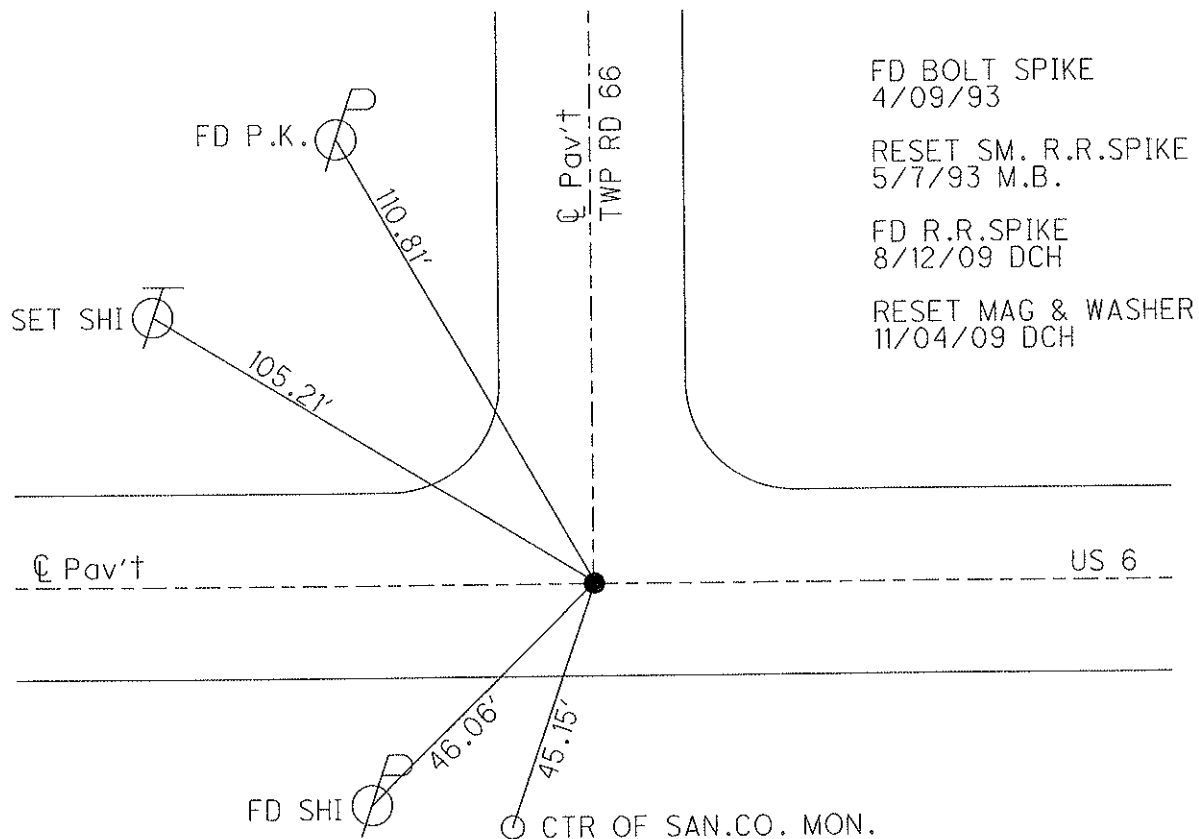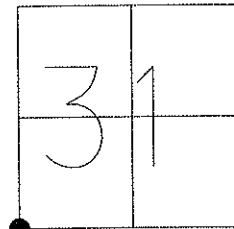

O.D.O.T. DISTRICT 2 SURVEY OFFICE

PERSONNEL

REFERENCE NO. 14

SHEET 24 OF 26

NOTES HOMAN

DATE 8/12/09

ROUTE US 6

H.C. HOMAN

WEATHER CLOUDY

COUNTY SANDUSKY

R.C. ROUSOS

TEMP. 75°

TOWNSHIP WASHINGTON

SECTION 31

T 5 N R 14 E

TYPE MONUMENT R.R. SPIKE


ON SURFACE - ~~BELOW~~ ON

~~LEFT~~ - Q PAV'T - ~~RIGHT~~ ON

11.5 TO LT EDGE PAVEMENT

S.L.M. 330+12

GPS Northing: 611103.315 Easting: 1749543.381

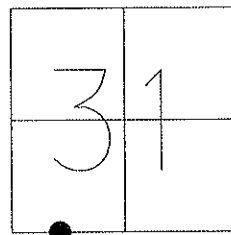


RECORD 329+31.23
WEST CORP. HELENA

FD LG. R.R. SPIKE
4/06/93

RESET SM. R.R. SPIKE
5/7/93 M.B.

FD R.R. SPIKE
8/12/09 DCH

RESET MAG & WASHER
11/04/09 DCH

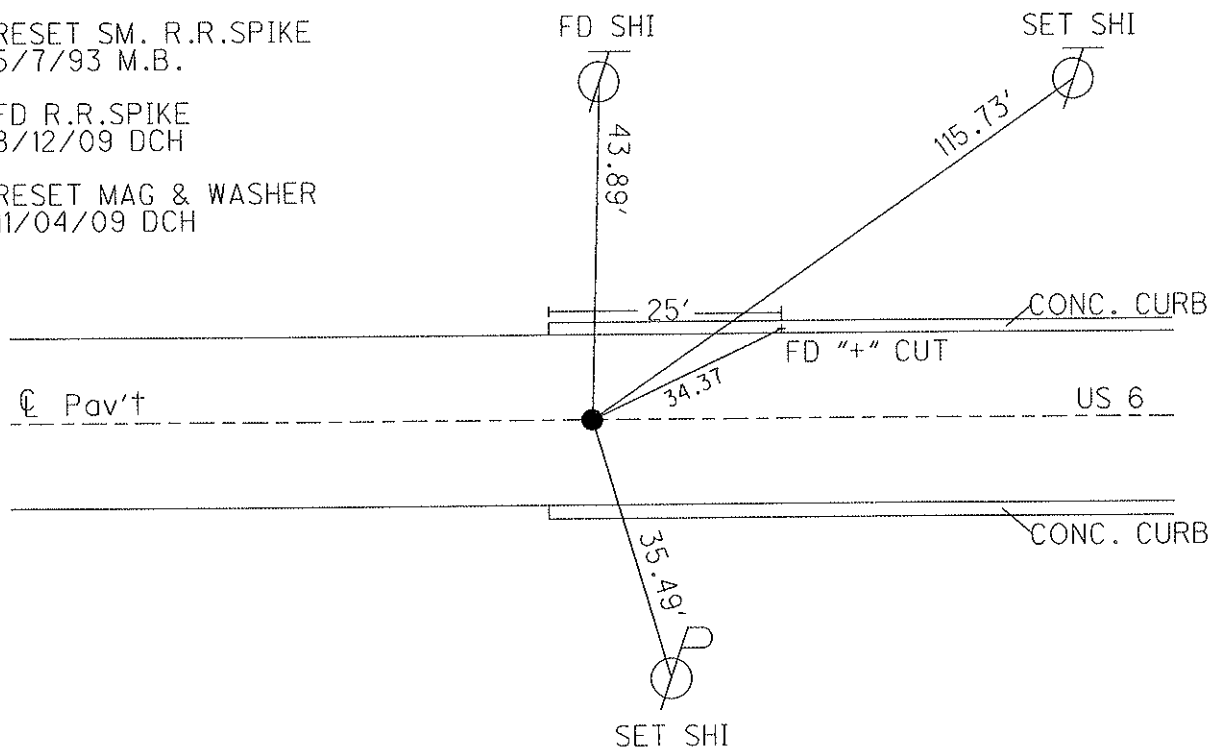

O.D.O.T. DISTRICT 2 SURVEY OFFICE (USE ONLY)

PERSONNEL _____ REFERENCE NO. 14 A SHEET 25 OF 27
 NOTES RHOADES DATE 9/26/12 ROUTE US 6
 H.C. CODER WEATHER MISTY COUNTY SANDUSKY
 R.C. RHOADES TEMP. 70° TOWNSHIP WASHINGTON
 _____ SECTION 31
 _____ T 5 N R 14 E

TYPE MONUMENT P.K.SHANK


~~ON SURFACE~~ - BELOW 1"

LEFT - Q PAV'T - ~~RIGHT~~ 0.5'


21.9' TO LT EDGE PAVEMENT

S.L.M. 345+50.66

GPS NORTHING: 611104.554 EASTING: 1751080.507

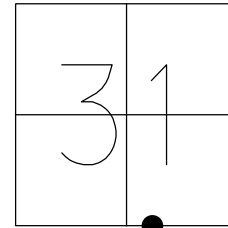

RECORD:
 STA.345+75.60
 FD IPIN
 4/6/93, MB
 SET SM.R.R.SPIKE
 5/7/33, MB
 FD P.K.SHANK
 1" DOWN
 9/26/12, SDC
 SET MAG/WASHER
 FINREFA14
 5/22/13, SDC

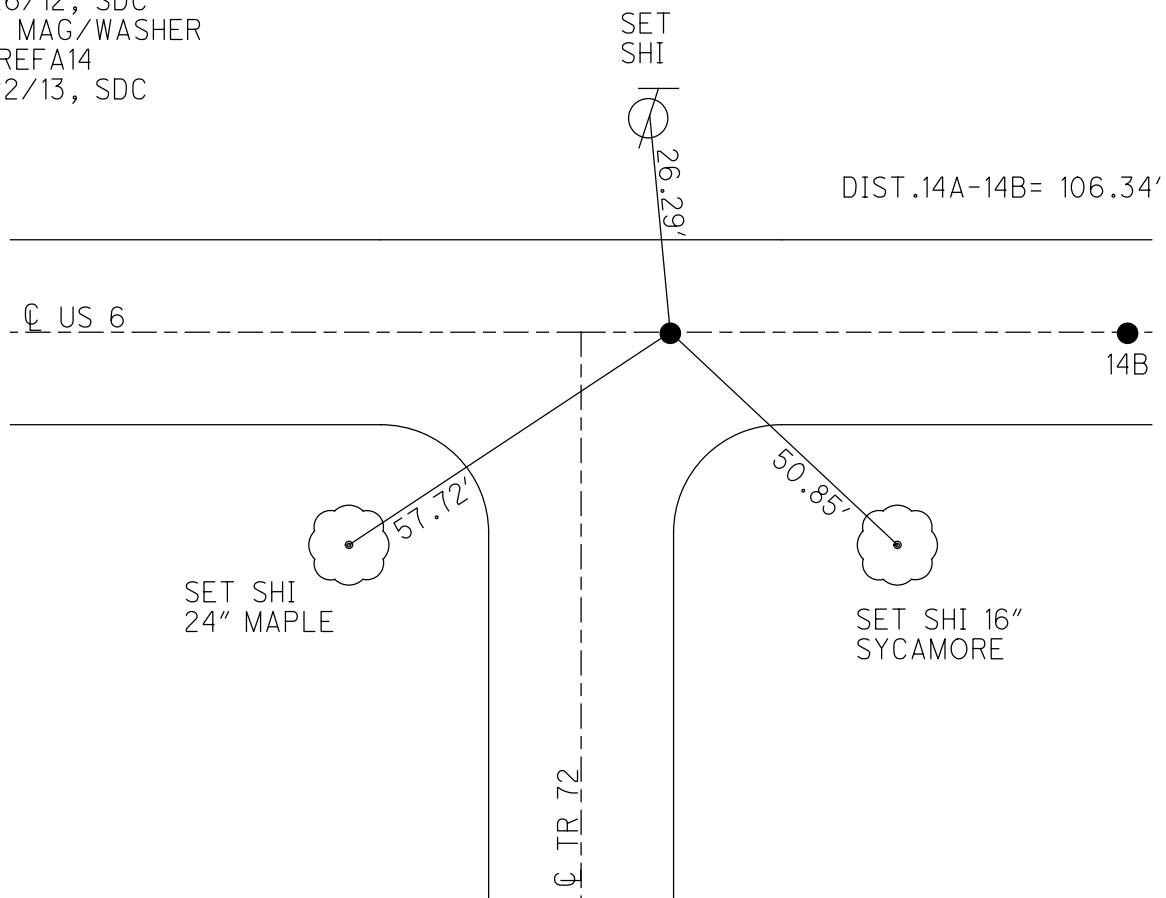

O.D.O.T. DISTRICT 2 SURVEY OFFICE (USE ONLY)

PERSONNEL

REFERENCE NO. 14 B

SHEET 26 OF 27

NOTES RHOADES

DATE 9/26/12

ROUTE US 6

H.C. CODER

WEATHER MISTY

COUNTY SANDUSKY

R.C. RHOADES

TEMP. 70°

TOWNSHIP WASHINGTON

SECTION 31

T 5 N R 14 E

TYPE MONUMENT SM.R.R.SPIKE


ON SURFACE - ~~BELOW~~ ON

LEFT - Q PAV'T - ~~RIGHT~~ 0.5'

21.9 TO LT. EDGE PAVEMENT

S.L.M. 346+57

GPS Northing: 611104.063 Easting: 1751186.852

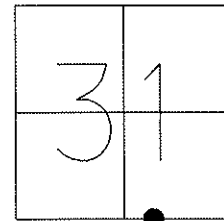


RECORD 345+75.60
IRON PIN

FD IRON PIN
4/06/93

RESET SM. R.R.SPIKE
5/7/93 M.B.

SET MAG/WASHER
GPS, FINREFB14
5/22/13, SDC

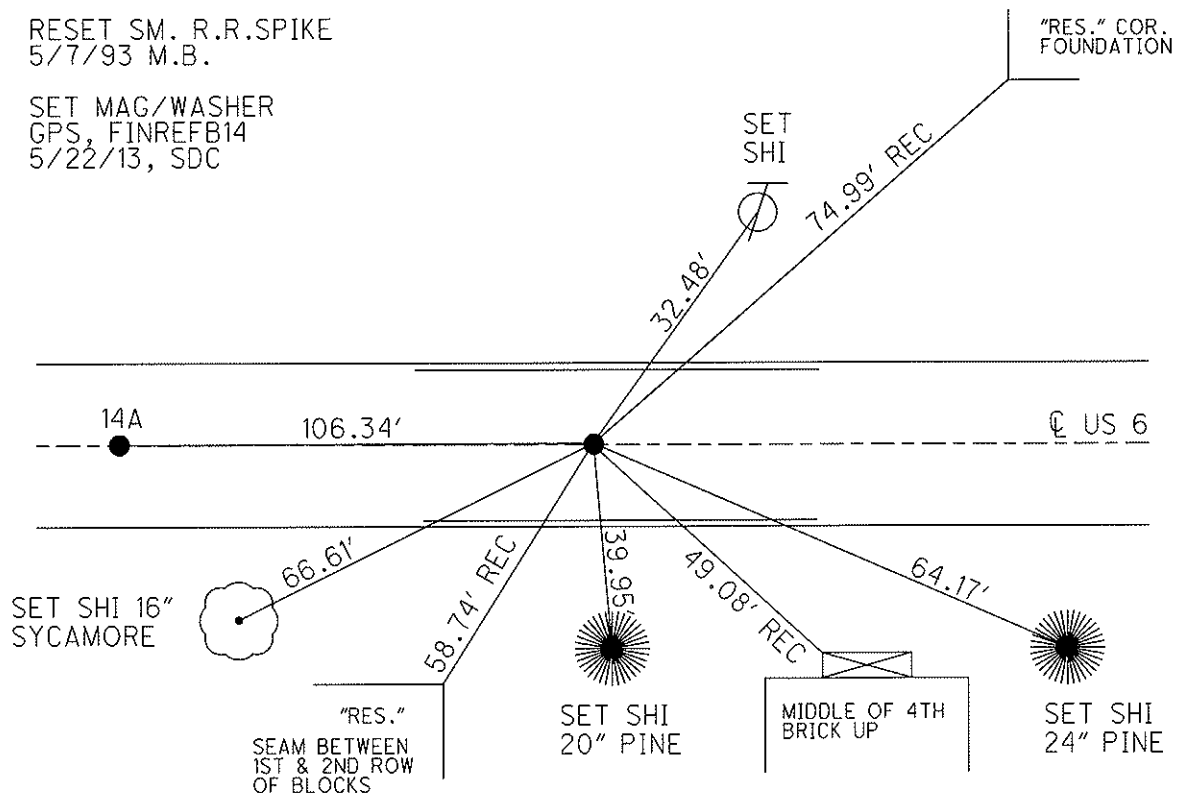

O.D.O.T. DISTRICT 2 SURVEY OFFICE

PERSONNEL

REFERENCE NO. 15

SHEET 26 OF 26

NOTES HOMAN

DATE 7/06/04

ROUTE US 6

H.C. NUHFER

WEATHER CLOUDY

COUNTY SANDUSKY

R.C. CANTERBURY

TEMP. 70°

TOWNSHIP JACKSON

ADKINS

SECTION 6

T 4 N R 14 E

TYPE MONUMENT MON BOX W/ IRON PIN


ON SURFACE - ~~BELOW~~ ON

~~LEFT~~ - Q PAV'T - ~~RIGHT~~ ON

12.4' TO RT EDGE PAVEMENT

S.L.M. 357+86


GPS Northing: Easting:

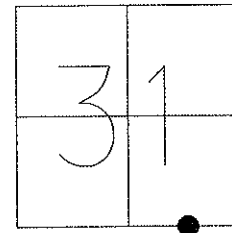

RECORD 357+86.19
EAST CORP. LINE HELENA

FD MON BOX
W/ IRON PIN
7/06/04




NOTE: ALL DISTANCES ARE
MEASURED PLUMB TO THE
CENTER OF IRON PIN
INSIDE MONUMENT BOX

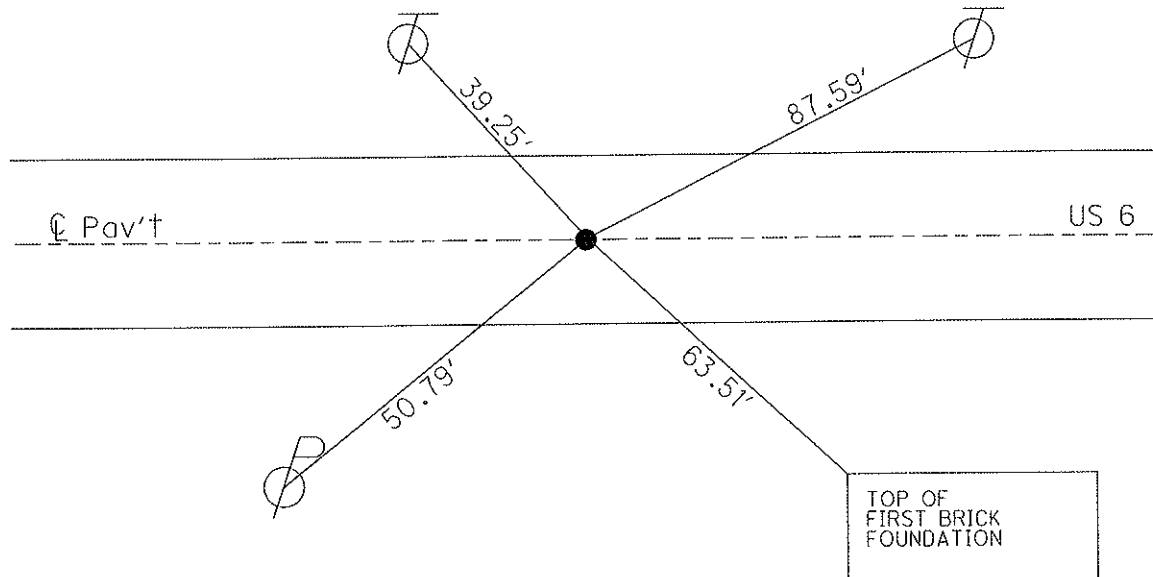

O.D.O.T. DISTRICT 2 SURVEY OFFICE (USE ONLY)

PERSONNEL	REFERENCE NO. <u>16</u>	SHEET <u>1</u> OF <u>25</u>
NOTES	DATE <u>07/06/04</u>	ROUTE <u>SR 6</u>
H.C. <u>HOMAN</u>	WEATHER <u>CLOUDY</u>	COUNTY <u>SANDUSKY</u>
R.C. <u>NUHFER</u>	TEMP. <u>+70°</u>	TOWNSHIP <u>WASHINGTON</u>
<u>CANTERBURY</u>		SECTION <u>32</u>
<u>ADKINS</u>		T <u>5</u> N R <u>14</u> E

TYPE MONUMENT MONBOX W/ IRON PIN
 ON SURFACE - ~~BELOW~~ ON, 3' WEST OF TR 74
~~LEFT~~ - CL PAV'T - ~~RIGHT~~ ON
12.1' TO RT EDGE PAVEMENT
 S.L.M. 372+20
 GRID: NORTHING: 611086.292 EASTING: 1753831.013

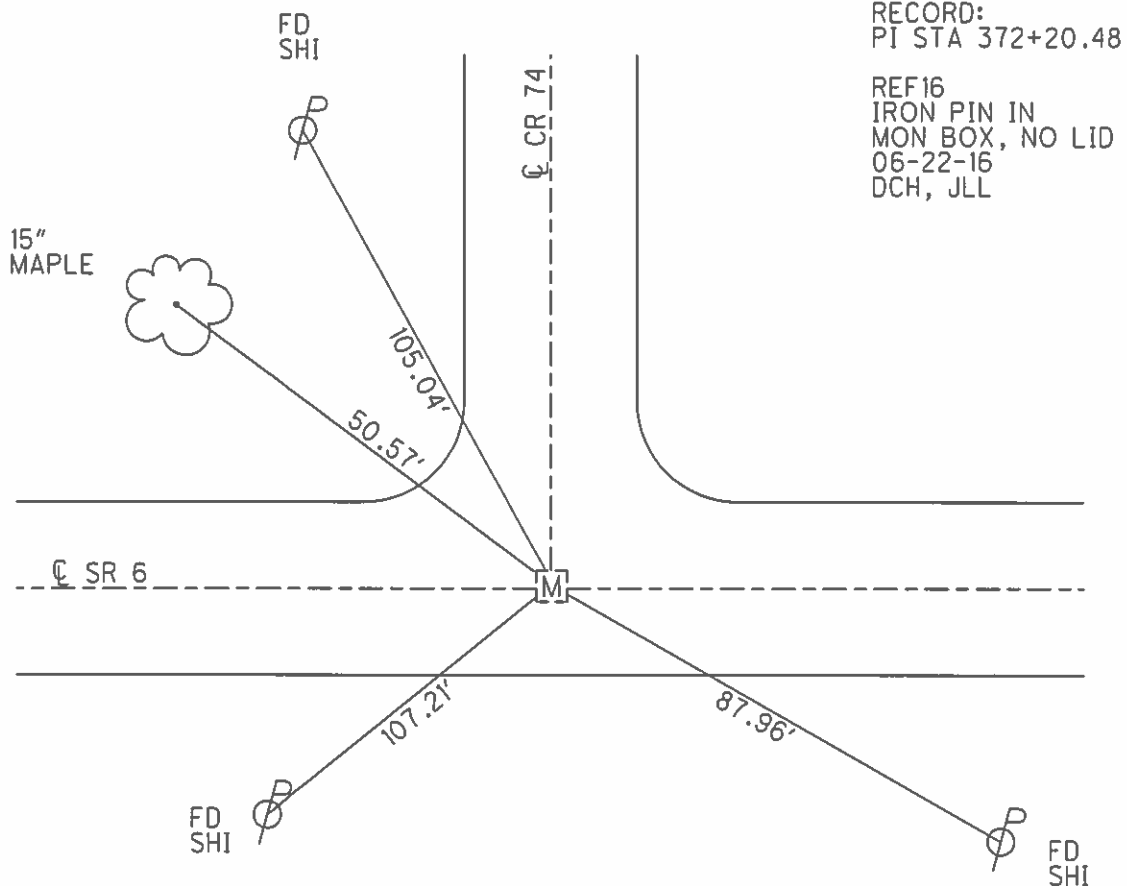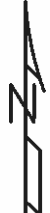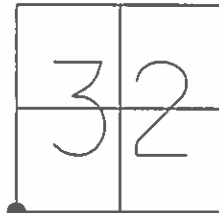


O.D.O.T. DISTRICT 2 SURVEY OFFICE (USE ONLY)

PERSONNEL	REFERENCE NO. <u>17</u>	SHEET <u>2</u> OF <u>25</u>
NOTES	DATE <u>07/06/04</u>	ROUTE <u>SR 6</u>
H.C. <u>HOMAN</u>	WEATHER <u>CLOUDY</u>	COUNTY <u>SANDUSKY</u>
R.C. <u>NUHFER</u>	TEMP. <u>+70°</u>	TOWNSHIP <u>JACKSON</u>
<u>CANTERBURY</u>		SECTION <u>5</u>
<u>ADKINS</u>		
		T <u>4</u> N R <u>14</u> E


TYPE MONUMENT MON BOX W/ IRON PIN
 ON SURFACE - ~~BELOW~~ ON, 3' W OF CL SR 635
~~LEFT - CL PAV'T - RIGHT~~ ON
11.7' TO LT EDGE PAVEMENT
 S.L.M. 397+12

GRID: NORTHING: 611060.1703 EASTING: 1756324.922

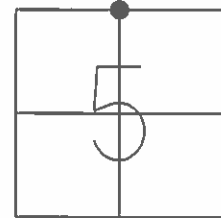

RECORD: 397+12.34

REF17
 FD MON BOX
 W/ 1" IPIN
 06-22-16
 DCH, JLL

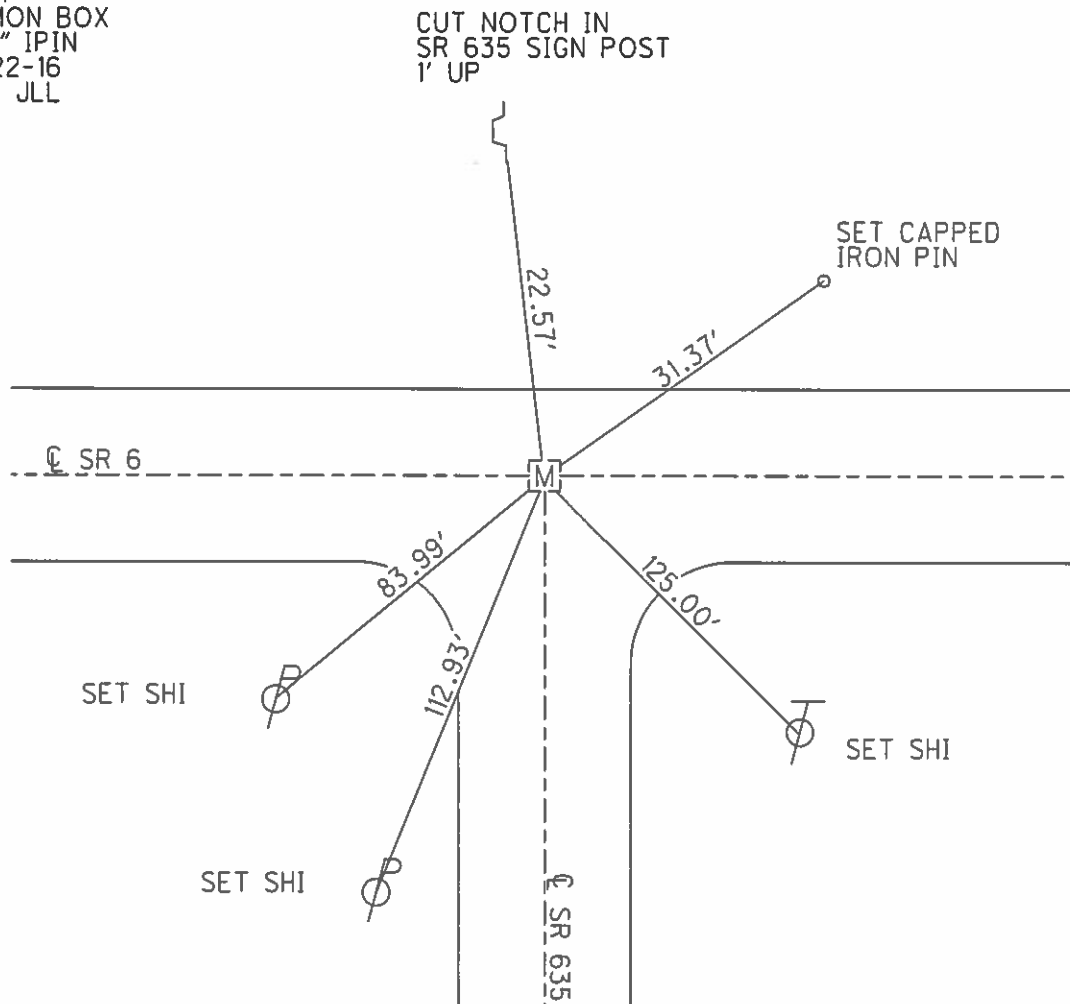

O.D.O.T. DISTRICT 2 SURVEY OFFICE (USE ONLY)

PERSONNEL

REFERENCE NO. 18

SHEET 3 OF 25

NOTES HOMAN
H.C. NUHFER
R.C. CANTERBURY
ADKINS

DATE 07/06/04
WEATHER CLOUDY
TEMP. +70°

ROUTE SR 6
COUNTY SANDUSKY
TOWNSHIP WASHINGTON
SECTION 33
T 5 N R 14 E

TYPE MONUMENT MON BOX W/ IRON PIN


ON SURFACE - ~~BELOW~~ ON

~~LEFT~~ - CL PAV'T - ~~RIGHT~~ ON

11.6' TO RT EDGE PAVEMENT


S.L.M. 423+30

GRID: NORTHING: 611032.676 EASTING: 1758936.958

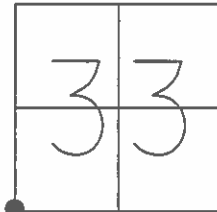

REF18
FD MON BOX
W/ 1" IPIN
06-22-16
DCH, JLL


CAPPED IRON PINS SET TYP

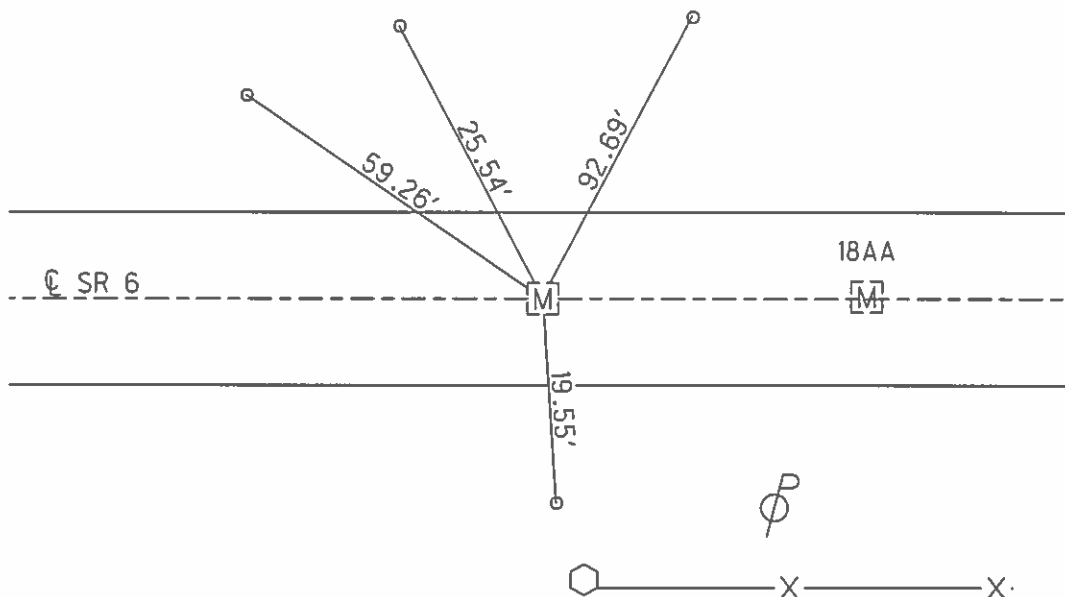

O.D.O.T. DISTRICT 2 SURVEY OFFICE (USE ONLY)

PERSONNEL _____ REFERENCE NO. 18 AA SHEET 4 OF 25
 NOTES _____ DATE 07/06/04 ROUTE SR 6
 H.C. HOMAN WEATHER CLOUDY COUNTY SANDUSKY
 R.C. CANTERBURY TEMP. +70° TOWNSHIP WASHINGTON
 _____ ADKINS _____ SECTION 33
 T 5 N R 14 E


TYPE MONUMENT MON BOX W/ IRON PIN
 ON SURFACE - ~~BELOW~~ ON
~~LEFT - C PAV'T - RIGHT~~ ON
11.6' TO RT EDGE PAVEMENT
 S.L.M. 425+28

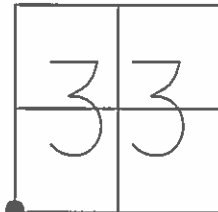

GRID: NORTHING: 611030.776 EASTING: 1759136.346

RECORD: 425+28.06

REFA18
 FD MON BOX
 W/ 1" IPIN
 06-22-16
 DCH, JLL

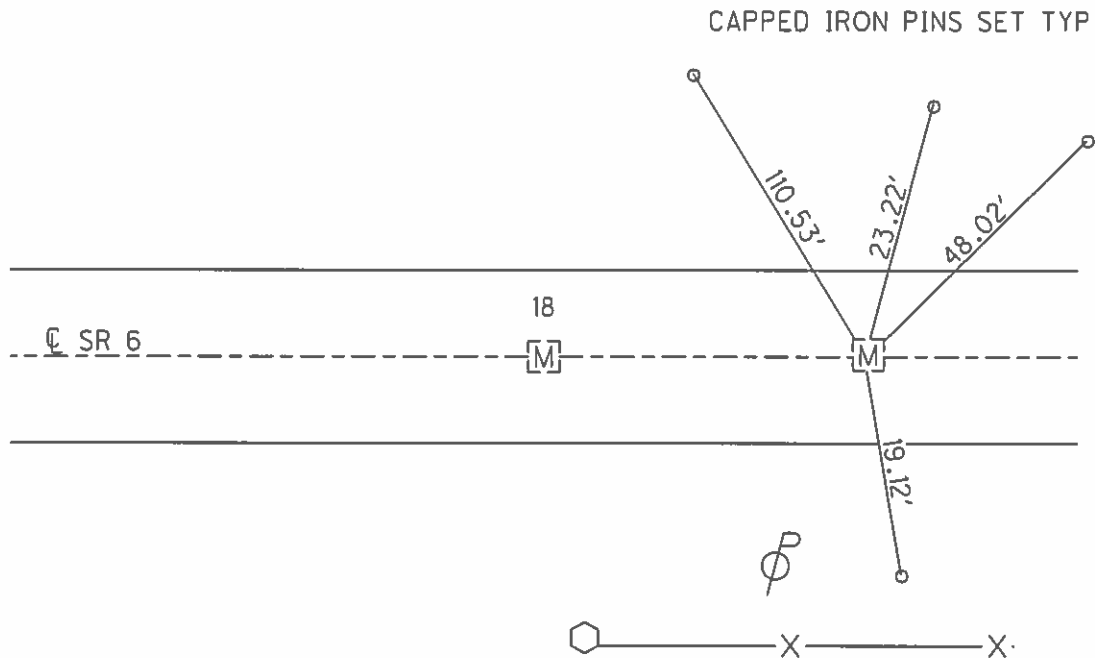

O.D.O.T. DISTRICT 2 SURVEY OFFICE (USE ONLY)

PERSONNEL

REFERENCE NO. 18 A


SHEET 5 OF 25

NOTES HOMAN
H.C. NUHFER
R.C. CANTERBURY
ADKNS

DATE 07/06/04
WEATHER CLOUDY
TEMP. +70°

ROUTE SR 6
COUNTY SANDUSKY
TOWNSHIP WASHINGTON
SECTION 33
T 5 N R 14 E


TYPE MONUMENT MON BOX W/ IRON PIN
ON SURFACE - ~~BELOW~~ ON
~~LEFT~~ - Q PAV'T - ~~RIGHT~~ ON
12.7' TO RT EDGE PAVEMENT
S.L.M. 438+47

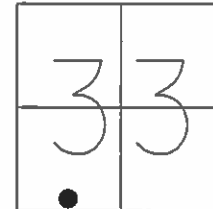

GRID: NORTHING: 611023.742 EASTING: 1760454.874

RECORD: 438+47.17

REFB18
FD MON BOX
W/ 1" IPIN
06-22-16
DCH, JLL

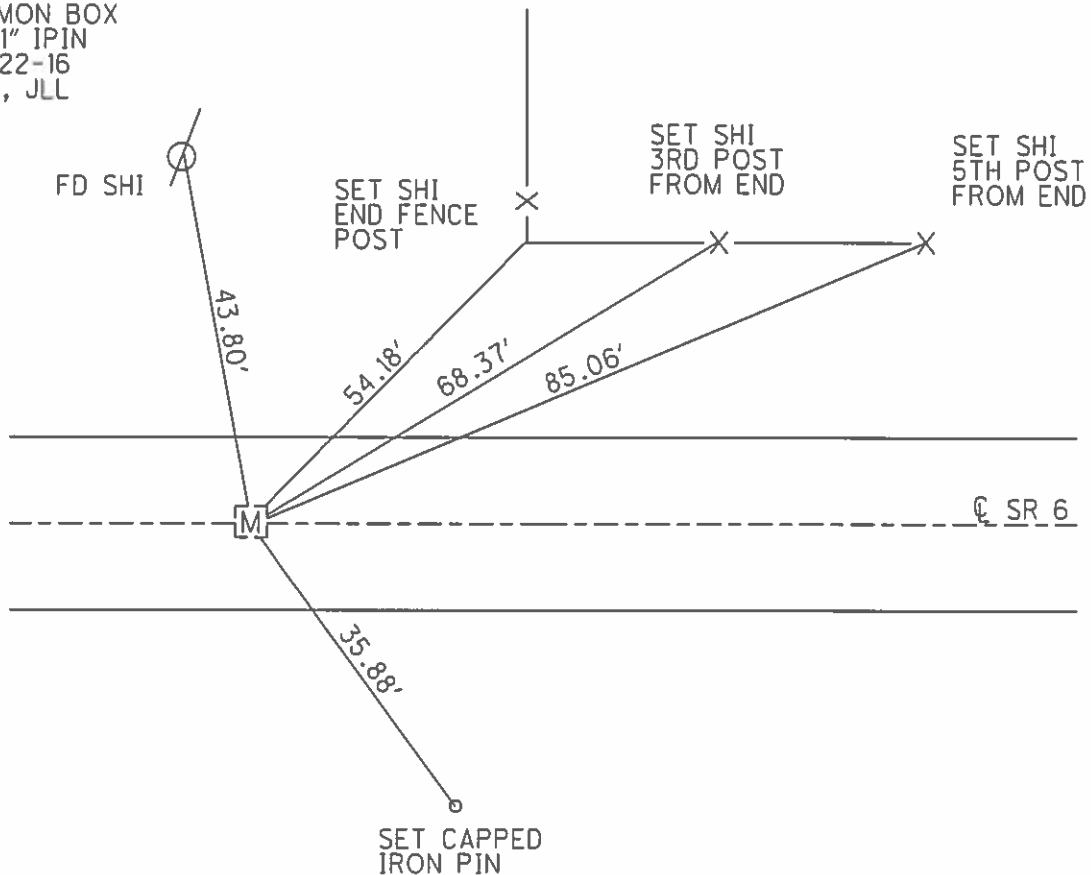


O.D.O.T. DISTRICT 2 SURVEY OFFICE (USE ONLY)

PERSONNEL _____ REFERENCE NO. 19 SHEET 6 OF 25
 NOTES HOMAN DATE 07/06/04 ROUTE SR 6
 H.C. NUHFER WEATHER CLOUDY COUNTY SANDUSKY
 R.C. CANTERBURY TEMP. +70° TOWNSHIP JACKSON
ADKINS SECTION 4
 T 4 N R 14 E


TYPE MONUMENT MON BOX W/ IRON PIN
 ON SURFACE - ~~BELOW~~ ON
~~LEFT~~ - CL PAV'T - ~~RIGHT~~ ON, 2' W OF CL TR 88
12.3' TO LT. EDGE PAVEMENT
 S.L.M. 449+32

GRID: NORTHING: 611016.695 EASTING: 1761539.651

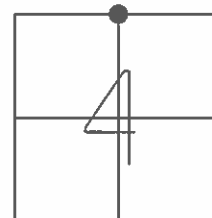

RECORD: 449+32.19

REF19
 FD MON BOX
 W/ 1" IPIN
 06-22-16
 DCH, JLL

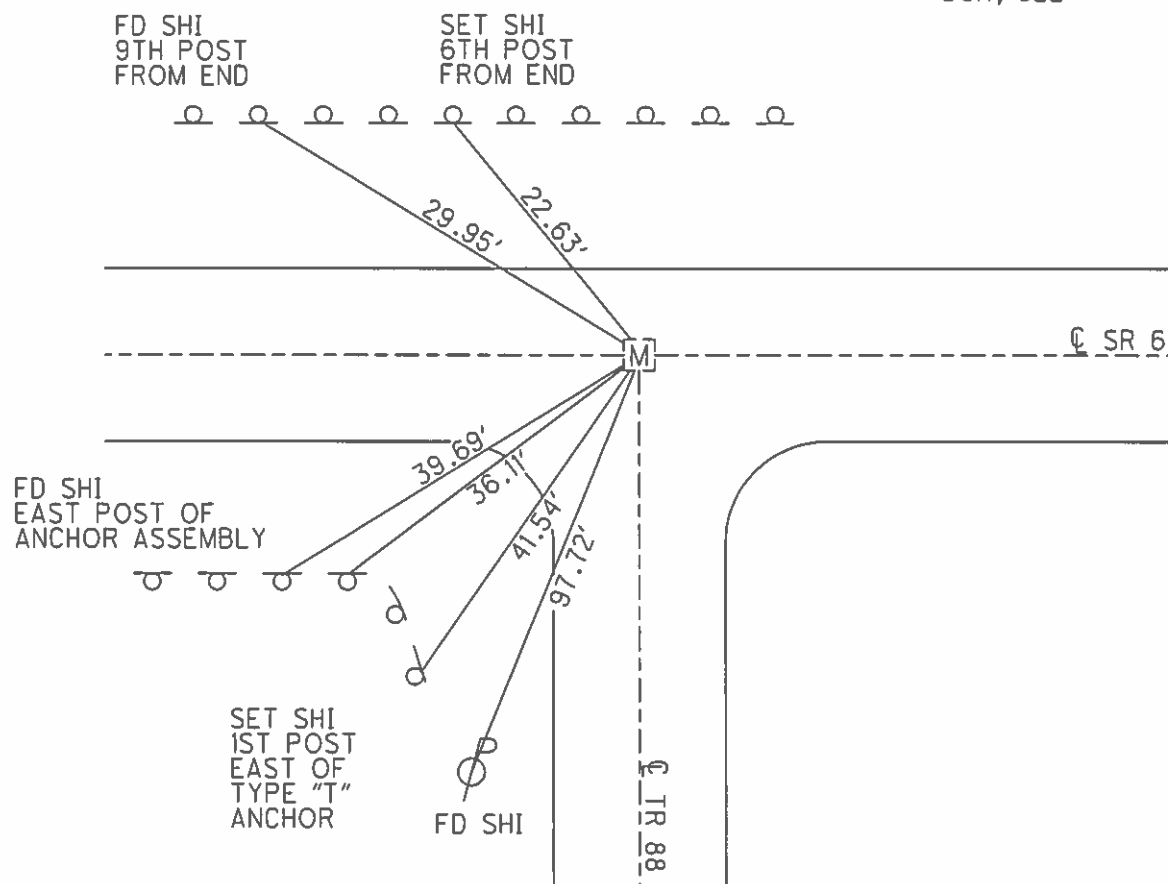

O.D.O.T. DISTRICT 2 SURVEY OFFICE (USE ONLY)

PERSONNEL

REFERENCE NO. 20

SHEET 7 OF 25

NOTES
H.C. HOMAN
R.C. NUHFER
CANTERBURY
ADKINS

DATE 07/06/04
WEATHER CLOUDY
TEMP. +75°

ROUTE SR 6
COUNTY SANDUSKY
TOWNSHIP WASHINGTON
SECTION 33
T 5 N R 14 E

TYPE MONUMENT MON BOX W/ IRON PIN


ON SURFACE - ~~BELOW~~ ON

~~LEFT~~ - Q PAV'T - ~~RIGHT~~ ON

11.7' TO RT EDGE PAVEMENT


S.L.M. 464+85


GRID: NORTHING: 611007.595 EASTING: 1763092.072

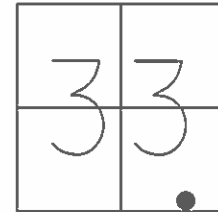

RECORD: 464+85.19

REF20
FD MON BOX
W/ 1" IPIN
06-22-16
DCH, JLL

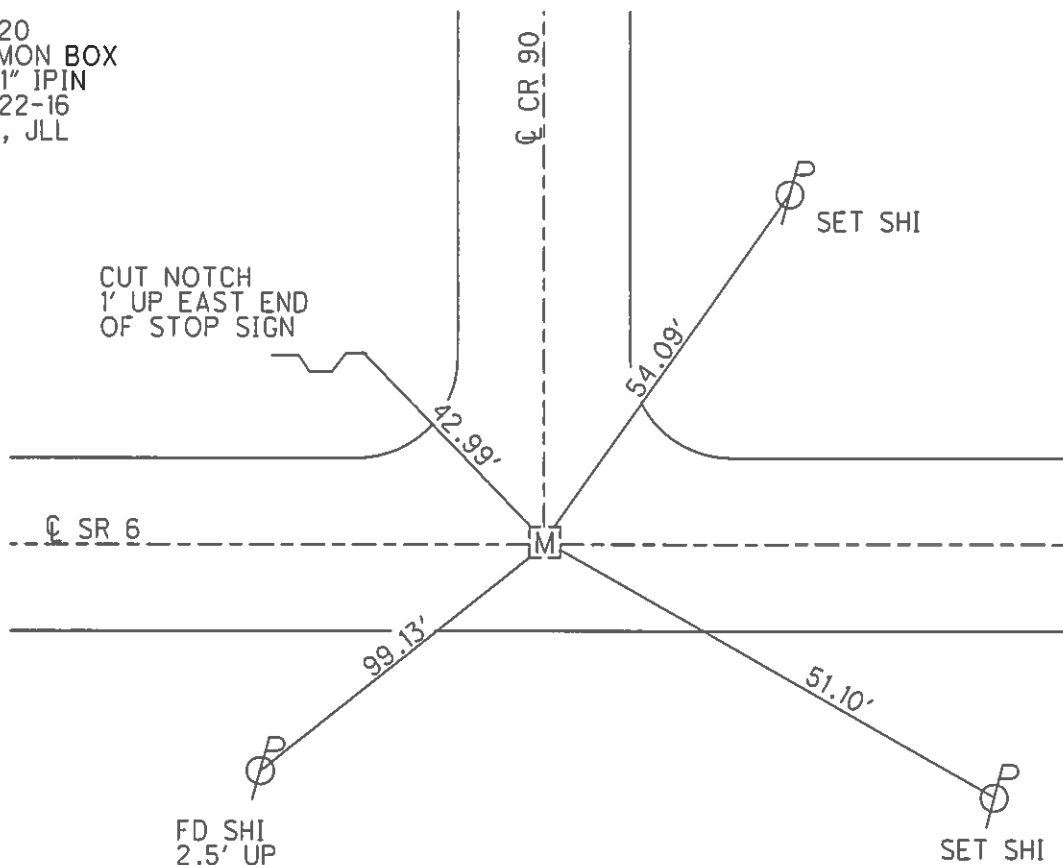

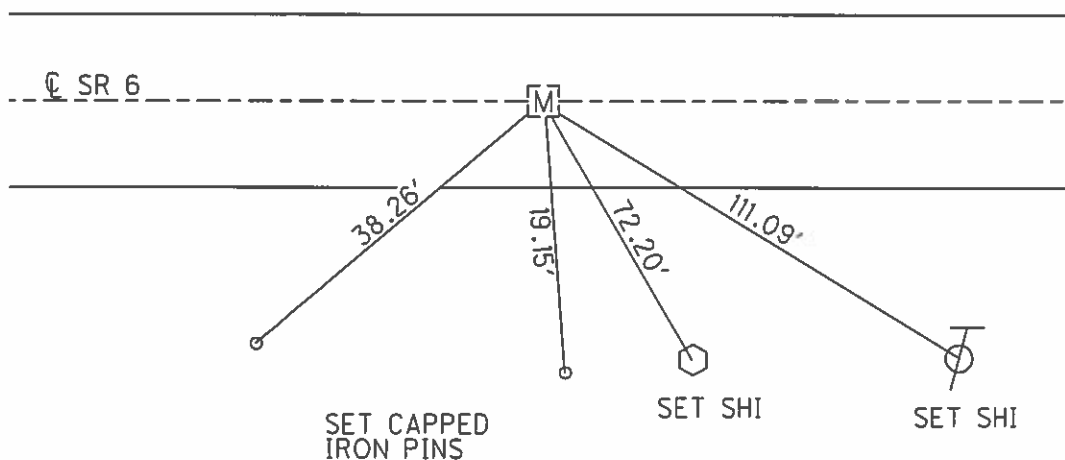

O.D.O.T. DISTRICT 2 SURVEY OFFICE (USE ONLY)

PERSONNEL

REFERENCE NO. 21 SHEET 9 OF 25

NOTES	HOMAN	DATE	07/06/04	ROUTE	SR 6
H.C.	NUHFER	WEATHER	CLOUDY	COUNTY	SANDUSKY
R.C.	CANTERBURY	TEMP.	+80°	TOWNSHIP	WASHINGTON
	ADKINS			SECTION	34

T_5_N R_14_E

TYPE MONUMENT MON BOX W/ IRON PIN

ON SURFACE - ~~BELOW~~ _____ ON _____

~~LEFT~~ - C PAV'T - ~~RIGHT~~ ON

12.9' TO LT EDGE PAVEMENT

S.L.M. _____ 489+08

GRID: NORTHING: 611003.222 EASTING: 1765514.291




DISTANCE 21-21AA = 1.70'

RECORD: 489+08.34

REF21
FD MON BOX
W/1" IPIN
06-22-16
DCH, JLL

UNCOVERED PK NAIL
09-12-16 DCH

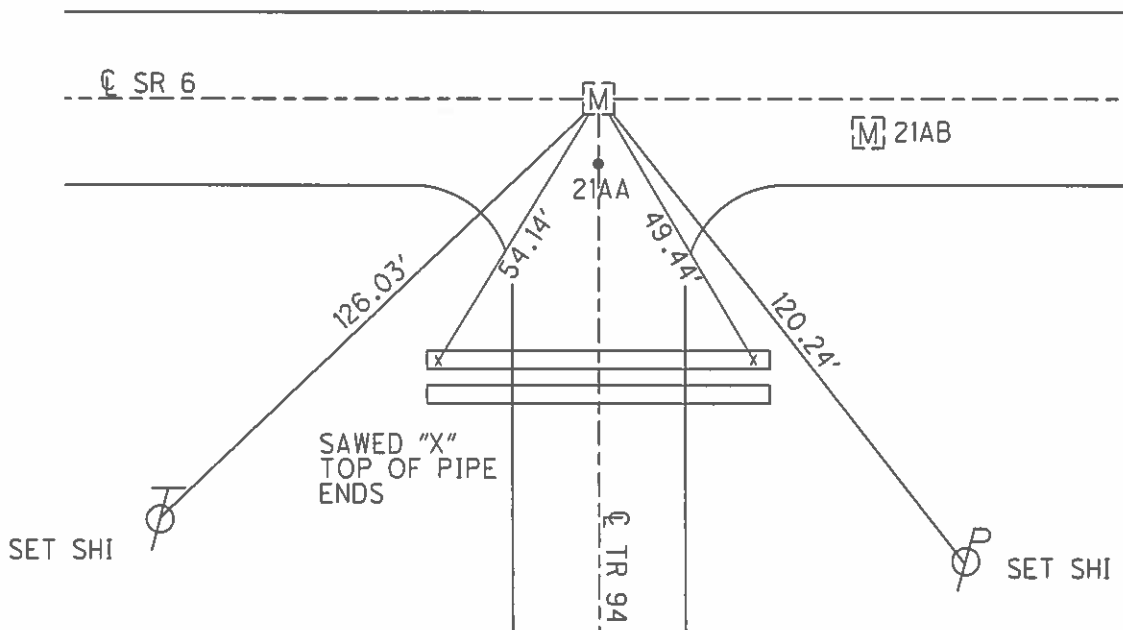

O.D.O.T. DISTRICT 2 SURVEY OFFICE (USE ONLY)

PERSONNEL

REFERENCE NO.

21 AA

SHEET

10 OF

25

NOTES

HOMAN

DATE

07/06/04

ROUTE

SR 6

H.C.

NUHFER

WEATHER

CLOUDY

COUNTY

SANDUSKY

R.C.

CANTERBURY

TEMP.

+80°

TOWNSHIP

WASHINGTON

ADKINS

SECTION

34

T 5 N R 14 E

TYPE MONUMENT

PK NAIL

ON SURFACE - ~~BELOW~~

ON

~~LEFT - C PAV'T - RIGHT~~

1.7'

- TO - EDGE PAVEMENT

S.L.M.



489+08.34

GRID: NORTHING:

611001.438

EASTING:

1765514.181

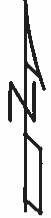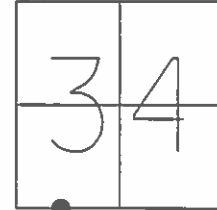


DISTANCE 21-21AA = 1.70'

MAG/WASHER
10-04-04 DCH

REFA21
FD PK NAIL/WASHER
06-22-16
DCH, JLL

UNCOVERED PK NAIL
09-12-16 DCH

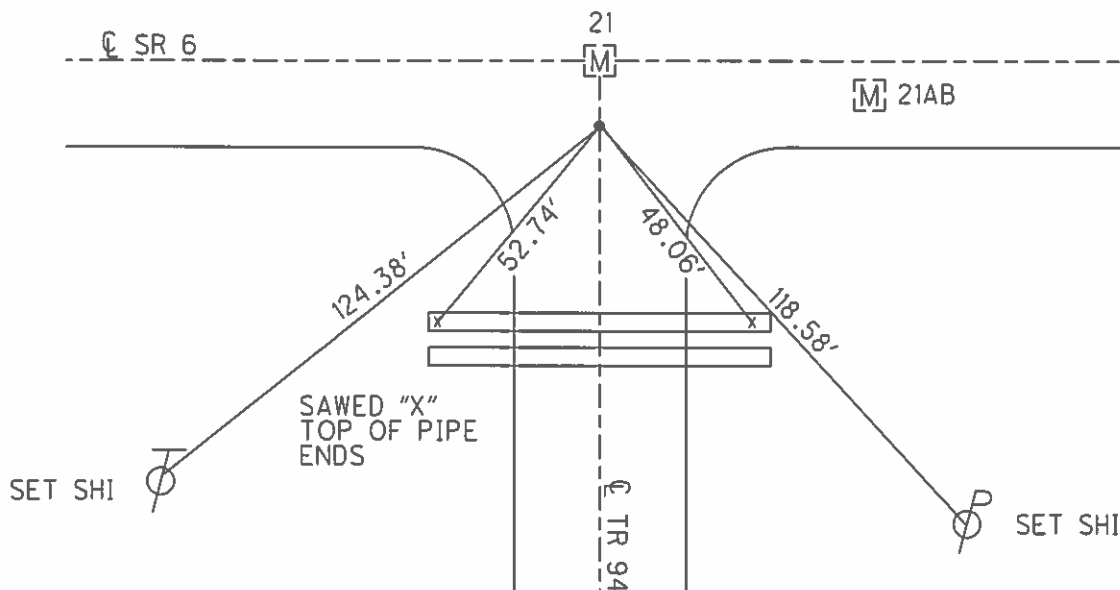

O.D.O.T. DISTRICT 2 SURVEY OFFICE (USE ONLY)

PERSONNEL

REFERENCE NO.

21 AB

SHEET

11

OF

25

NOTES

HOMAN

DATE

07/06/04

ROUTE

SR 6

H.C.

NUHFER

WEATHER

CLOUDY

COUNTY

SANDUSKY

R.C.

CANTERBURY

TEMP.

+80°

TOWNSHIP

WASHINGTON

ADKINS

SECTION

34

T 5 N R 14 E

TYPE MONUMENT

MON BOX W/ IRON PIN

ON SURFACE - ~~BELOW~~

ON

~~LEFT~~ - ~~Q~~ PAV'T - ~~RIGHT~~

ON

9.1' TO RT EDGE PAVEMENT

S.L.M.


491+33

GRID: NORTHING:

611001.603

EASTING:


1765738.890

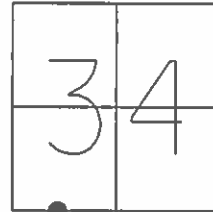

RECORD: 491+32.95

REFB21
FD MON BOX
W/ 1" IPIN
06-22-16
DCH, JLL

UNCOVERED PK NAIL
09/12/16 DCH

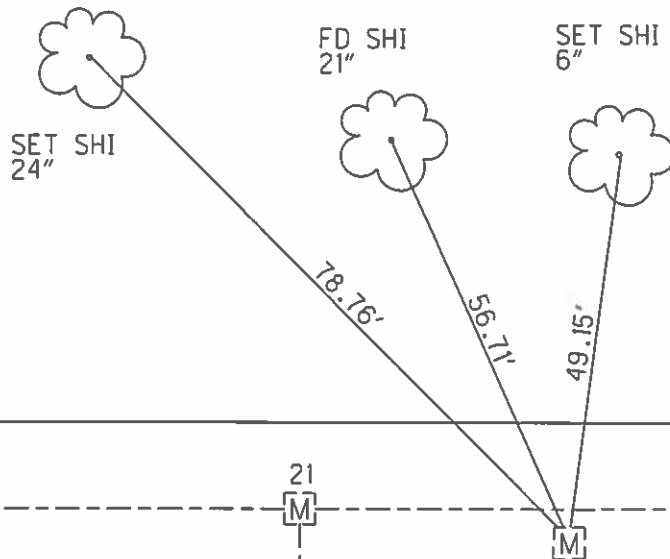

O.D.O.T. DISTRICT 2 SURVEY OFFICE (USE ONLY)

PERSONNEL

REFERENCE NO. 21 A

SHEET 12 OF 25

NOTES
H.C. HOMAN
R.C. NUHFER
CANTERBURY
ADKINS

DATE 07/06/04
WEATHER CLOUDY
TEMP. +80°

ROUTE SR 6
COUNTY SANDUSKY
TOWNSHIP WASHINGTON
SECTION 34
T 5 N R 14 E

TYPE MONUMENT MON BOX W/ IRON PIN


ON SURFACE - ~~BELOW~~ ON

~~LEFT - C PAV'T~~ - RIGHT 4.2'

7.6' TO RT EDGE PAVEMENT


S.L.M. 504+54

GRID: NORTHING: 611005.139 EASTING: 1767060.264

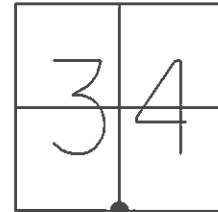

RECORD: 504+54.44



REFC21
FD MON BOX
W/ 1" IPIN
06-22-16
DCH, JLL

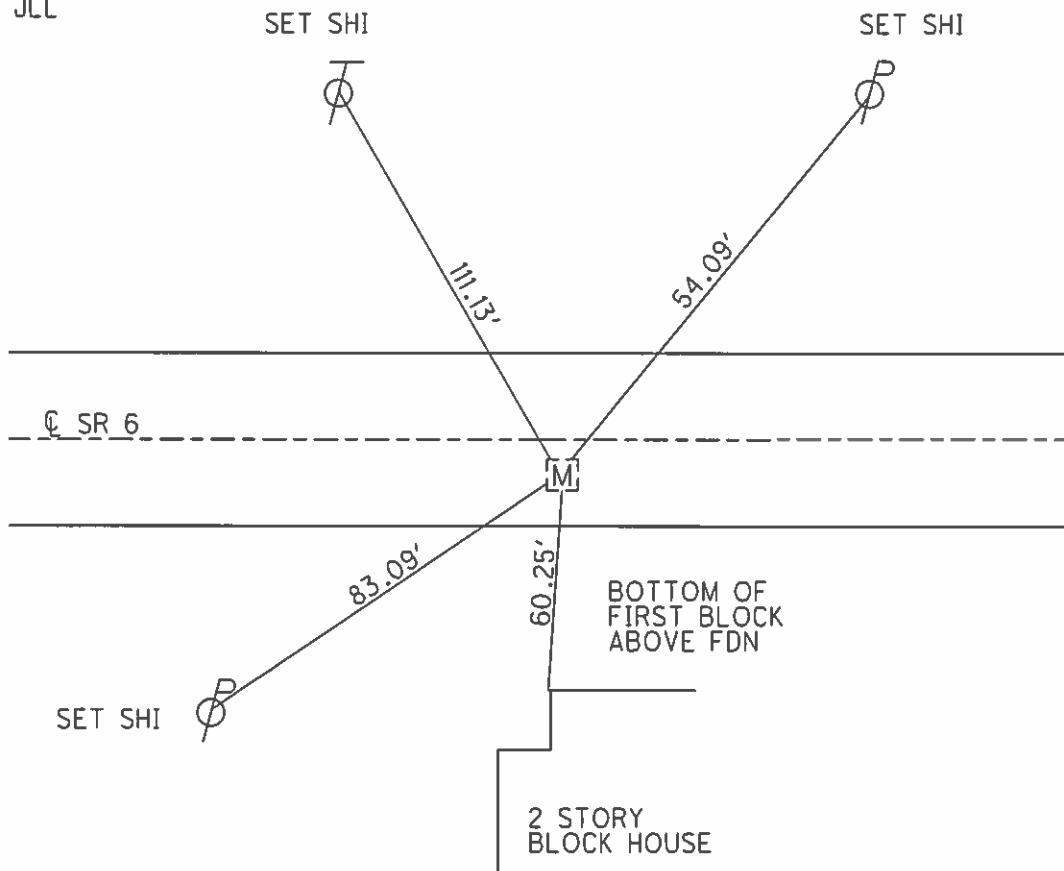


O.D.O.T. DISTRICT 2 SURVEY OFFICE (USE ONLY)

PERSONNEL	REFERENCE NO. <u>22</u>	SHEET <u>13</u> OF <u>25</u>	
NOTES	HOMAN	DATE	07/07/04
H.C.	NUHFER	WEATHER	CLOUDY
R.C.	CANTERBURY	TEMP.	75°
	ADKINS	ROUTE	SR 6
	HUSS BARNHISEL	COUNTY	SANDUSKY
		TOWNSHIP	JACKSON
		SECTION	2
		T <u>4</u> N	R <u>14</u> E

TYPE MONUMENT MON BOX W/ IRON PIN
 ON SURFACE ~~BELOW~~ ON
~~LEFT~~ - Q PAV'T - ~~RIGHT~~ ON
12.6' TO RT EDGE PAVEMENT
 S.L.M. 529+77
 GRID: NORTHING: 611018.654 EASTING: 1769581.685

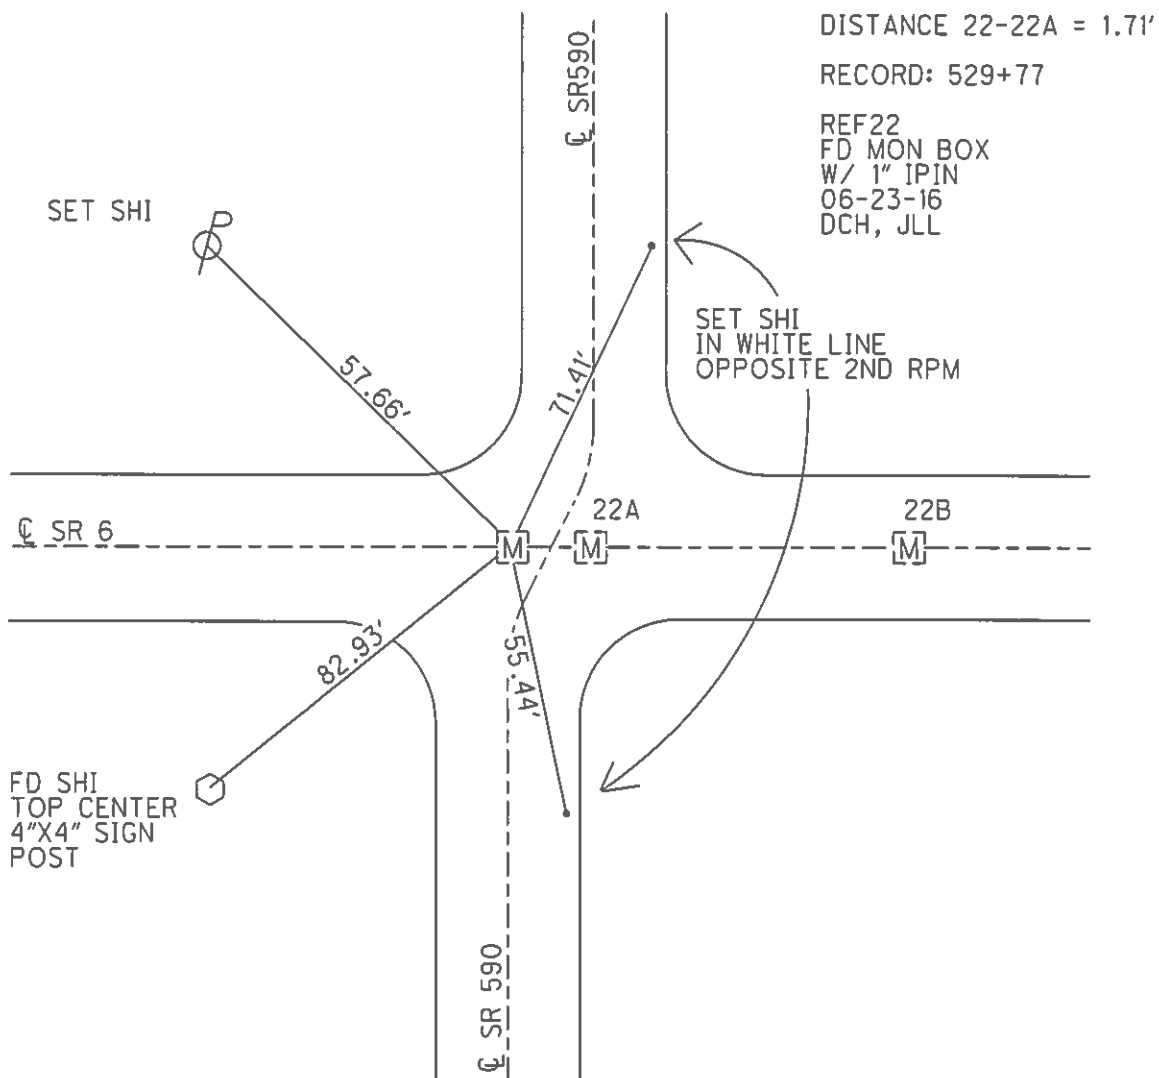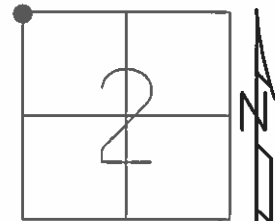

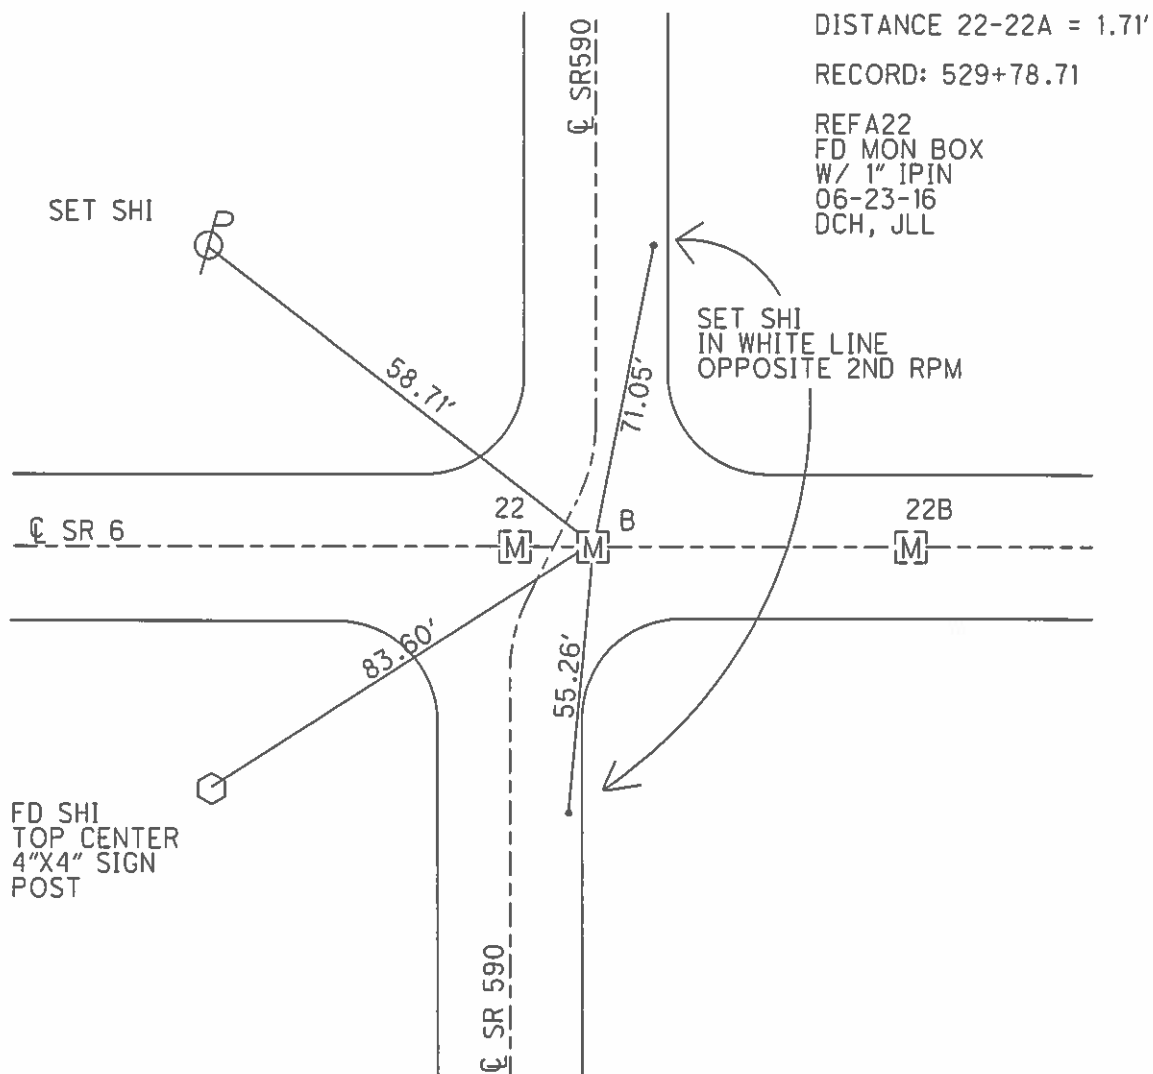

O.D.O.T. DISTRICT 2 SURVEY OFFICE (USE ONLY)

PERSONNEL

REFERENCE NO. 22 B SHEET 15 OF 25


NOTES HOMAN
H.C. NUHFER
R.C. CANTERBURY
ADKINS
HUSS BARNHISEL

DATE 07/07/04
WEATHER CLOUDY
TEMP. +75°

ROUTE SR 6
COUNTY SANDUSKY
TOWNSHIP JACKSON
SECTION 2
T 4 N R 14 E


TYPE MONUMENT MON BOX W/ IRON PIN
ON SURFACE - ~~BELOW~~ ON
~~LEFT - C PAV'T - RIGHT~~ ON
12.6' TO RT EDGE PAVEMENT
S.L.M. 531+00

GRID: NORTHING: 611020.556 EASTING: 1769705.033

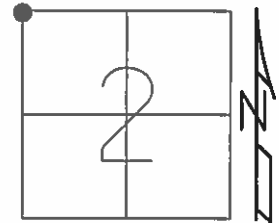

RECORD: 530+00.39

REFB22
FD MON BOX
W/ 1" IPIN
06-23-16
DCH, JLL

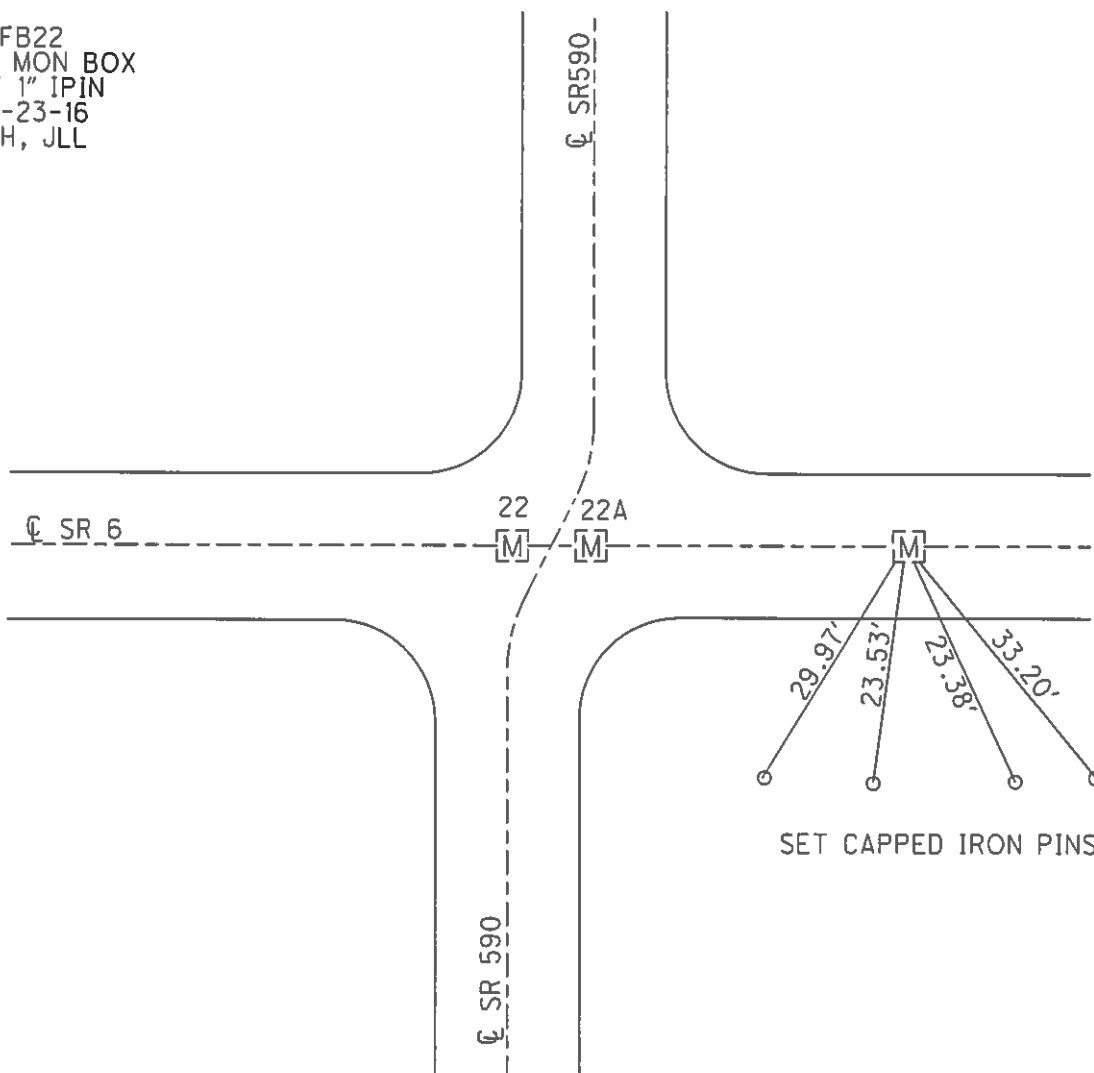

O.D.O.T. DISTRICT 2 SURVEY OFFICE (USE ONLY)

PERSONNEL _____ REFERENCE NO. 23 SHEET 16 OF 25

NOTES _____ DATE 07/07/04 ROUTE SR 6

H.C. HOMAN WEATHER CLOUDY COUNTY SANDUSKY

R.C. CANTERBURY TEMP. +75° TOWNSHIP JACKSON

_____ BARNHISEL _____ SECTION 2

_____ HUSS ADKINS _____ T 4 N R 14 E

TYPE MONUMENT MON BOX W/ IRON PIN


ON SURFACE - ~~BELOW~~ ON

~~LEFT - C PAV'T~~ - RIGHT 5.4'


6.6' TO RT. EDGE PAVEMENT

S.L.M. 556+30

GRID: NORTHING: 611045.934 EASTING: 1772228.033

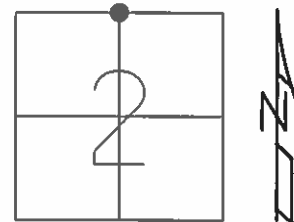

REF23
FD MON BOX
W/ 1" IPIN
06-23-16
DCH, JLL

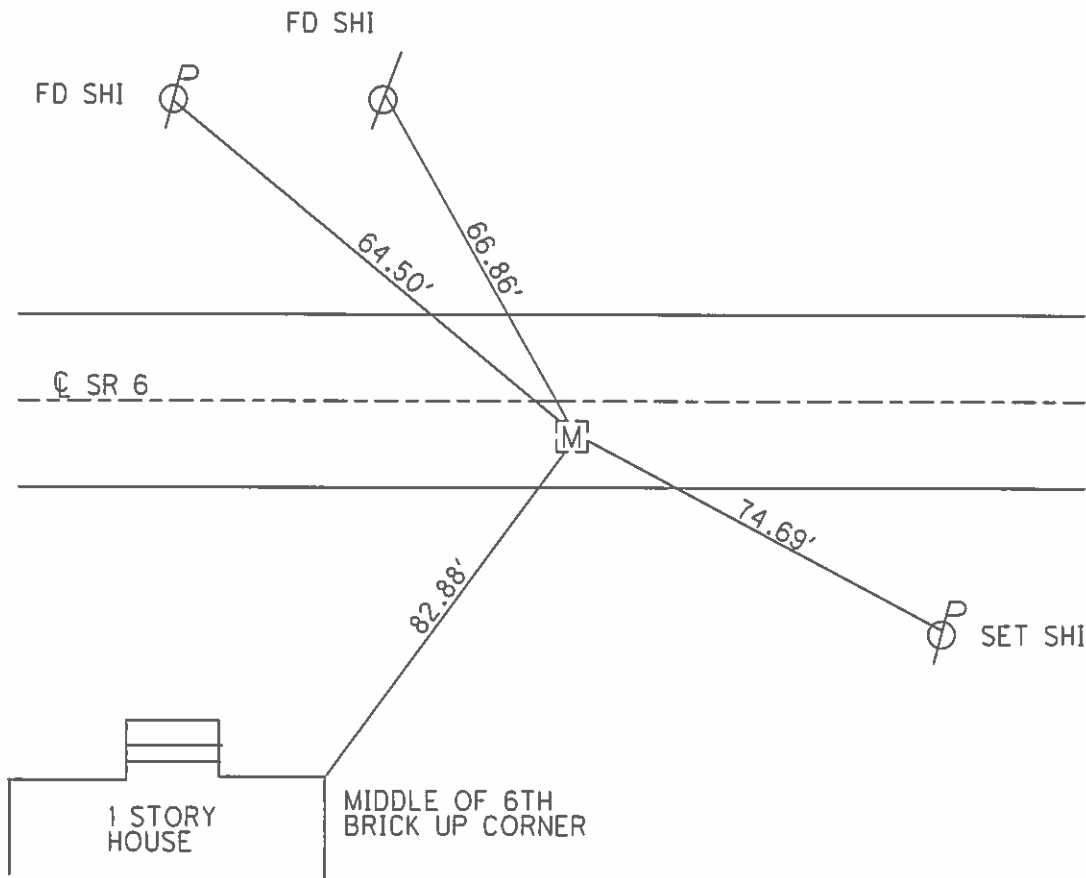

O.D.O.T. DISTRICT 2 SURVEY OFFICE (USE ONLY)

PERSONNEL

REFERENCE NO. 24

SHEET 17 OF 25

NOTES
H.C. HOMAN
R.C. NUHFER
CANTERBURY
BARNHISEL
HUSS ADKINS

DATE 07/07/04
WEATHER CLOUDY
TEMP. +75°

ROUTE SR 6
COUNTY SANDUSKY
TOWNSHIP JACKSON
SECTION 1

T 4 N R 14 E

TYPE MONUMENT MON BOX W/ IRON PIN



ON SURFACE - ~~BELOW~~ ON

~~LEFT - C PAV'T~~ - RIGHT 6.4'

5.6' TO RT EDGE PAVEMENT


S.L.M. 582+80

GRID: NORTHING: 611077.132 EASTING: 1774875.170

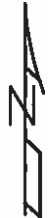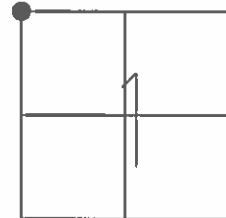

RECORD: 582+72.28

REF24
FD MON BOX
W/ 1" IPIN
06-23-16
DCH, JLL

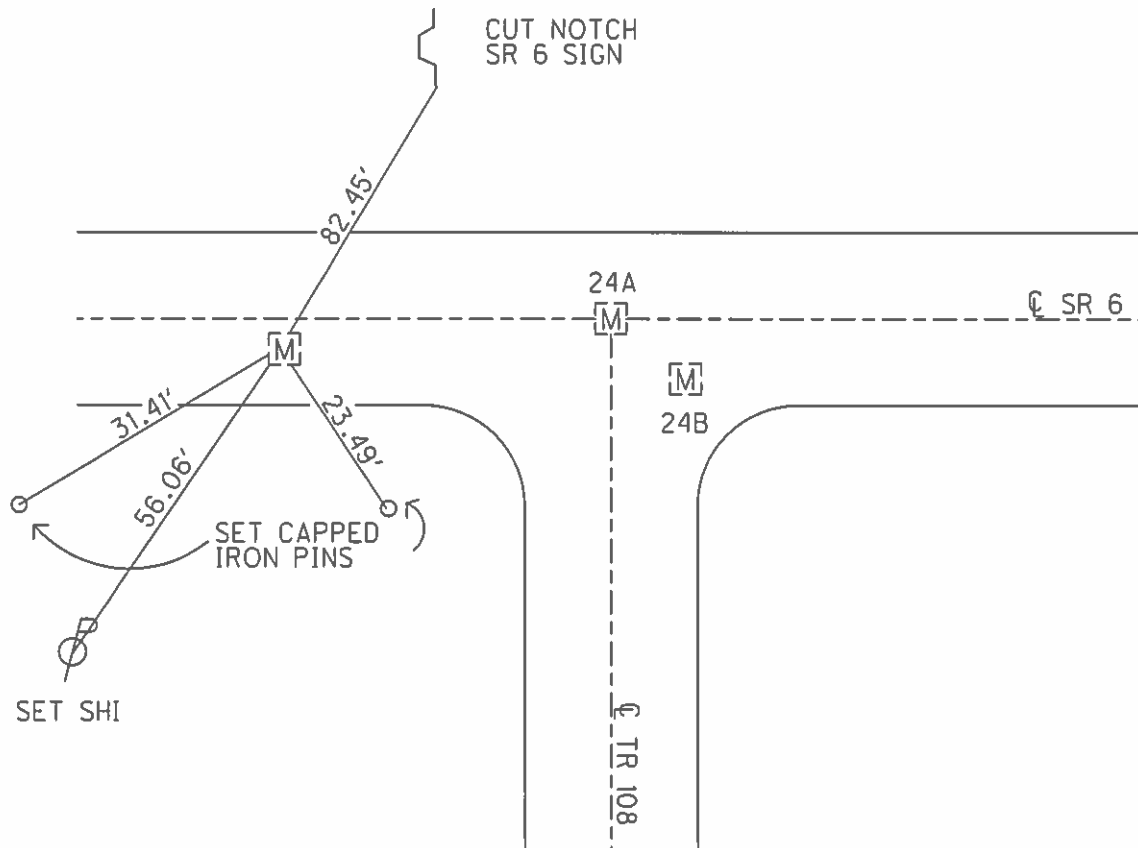


O.D.O.T. DISTRICT 2 SURVEY OFFICE (USE ONLY)

PERSONNEL		REFERENCE NO.	24 B	SHEET	19	OF	25
NOTES	HOMAN	DATE	07/07/04	ROUTE	SR 6		
H.C.	NUHFER	WEATHER	CLOUDY	COUNTY	SANDUSKY		
R.C.	CANTERBURY	TEMP.	+75°	TOWNSHIP	JACKSON		
	BARNHISEL			SECTION	1		
	HUSS ADKINS			T	4	N	R 14 E


TYPE MONUMENT MON BOX W/ IRON PIN
 ON SURFACE - ~~BELOW~~ ON
~~LEFT - C PAV'T - RIGHT~~ 3.7'
- TO - EDGE PAVEMENT
 S.L.M. 585+88.94

GRID: NORTHING: 611083.927 EASTING: 1775190.937

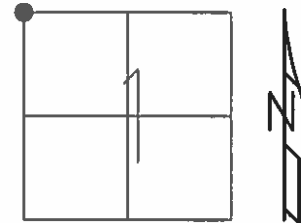

DISTANCE 24A-24B= 6.94'

REFB24
 FD MON BOX
 W/ 1' IPIN
 06-23-16
 DCH, JLL

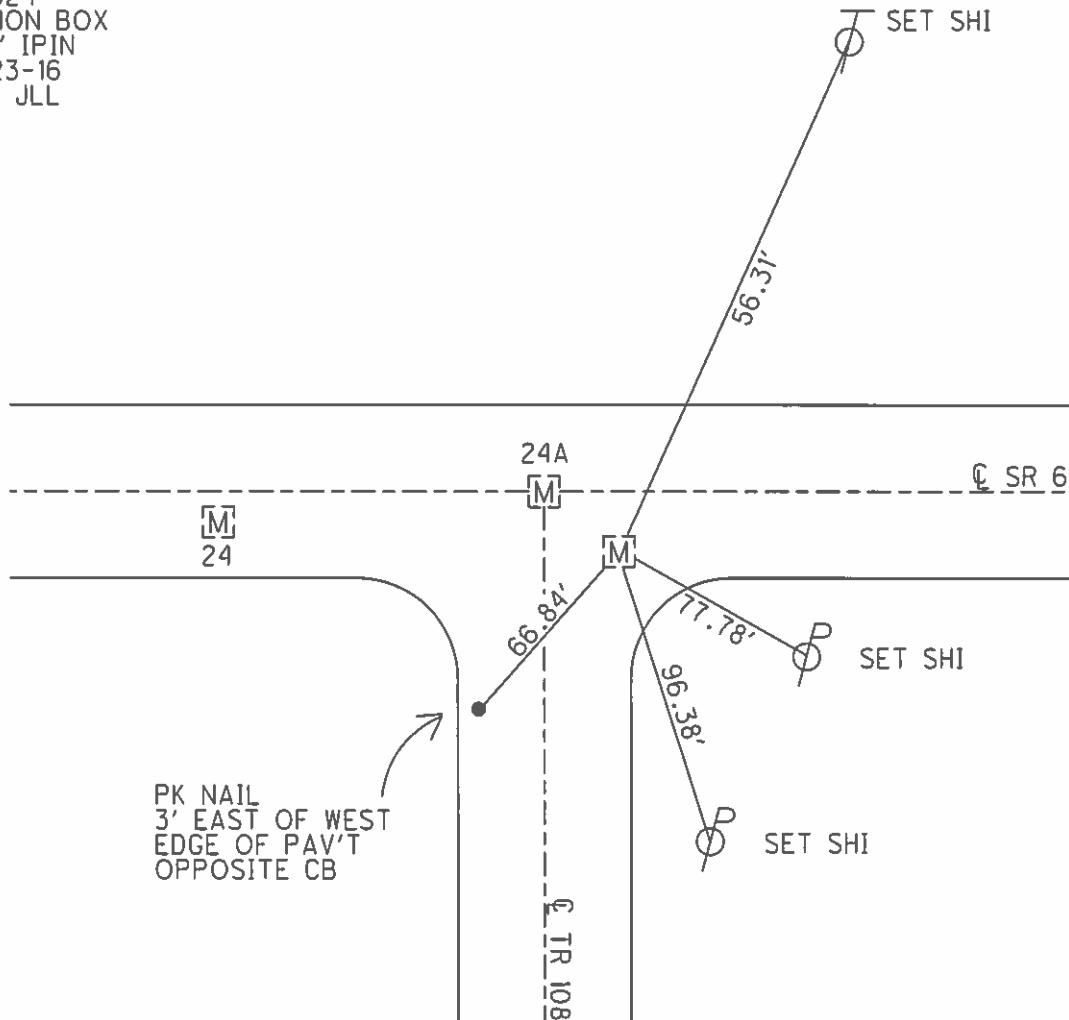

O.D.O.T. DISTRICT 2 SURVEY OFFICE (USE ONLY)

PERSONNEL

REFERENCE NO. 25 SHEET 20 OF 25

NOTES HOMAN
H.C. NUHFER
R.C. CANTERBURY
BARNHISEL
HUSS ADKINS

DATE 07/07/04
WEATHER CLOUDY
TEMP. +80°

ROUTE SR6
COUNTY SANDUSKY
TOWNSHIP WASHINGTON
SECTION 36
T 5 N R 14 E

TYPE MONUMENT MON BOX W/ IRON PIN


ON SURFACE - ~~BELOW~~ ON

~~LEFT - C-PAV'T~~ - RIGHT 3.1'

8.9' TO RT EDGE PAVEMENT


S.L.M. 610+50

GRID: NORTHING: 611136.862 EASTING: 1777643.800

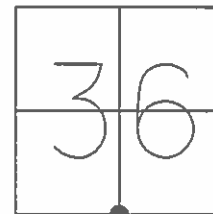

RECORD: 610+50

REF25
FD MON BOX
W/ 1" IPIN
06-23-16
DCH, JLL

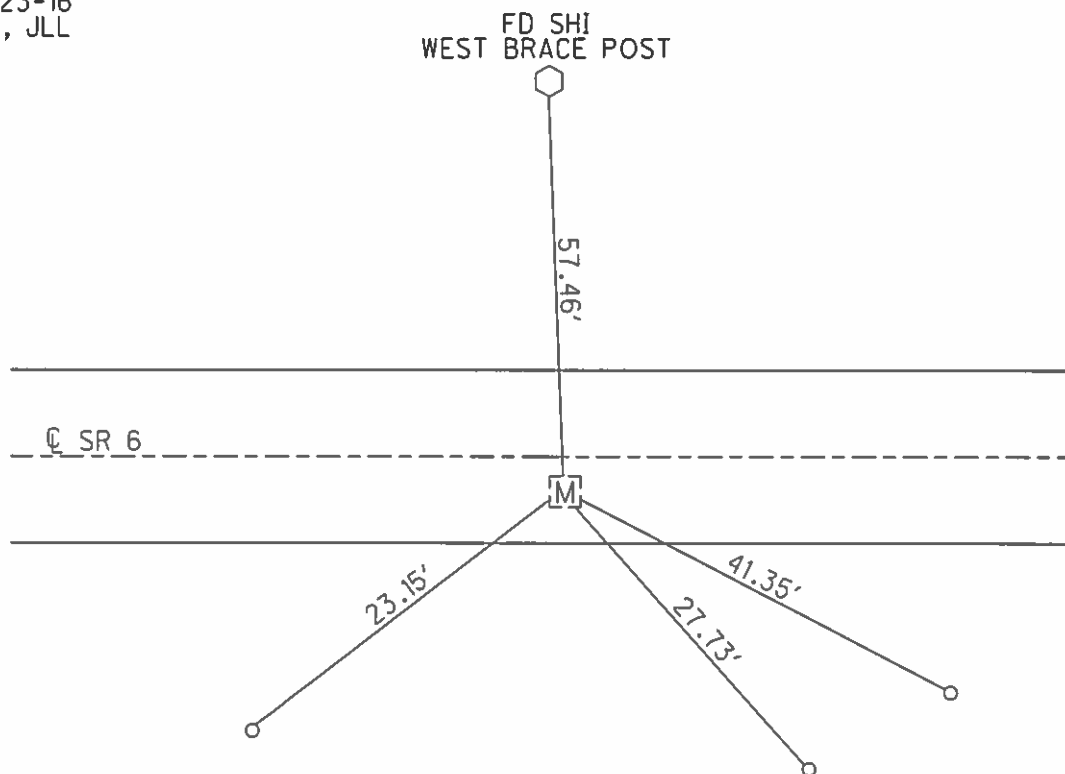

SET CAPPED IRON PINS

O.D.O.T. DISTRICT 2 SURVEY OFFICE (USE ONLY)

PERSONNEL

REFERENCE NO. 25 A SHEET 21 OF 25


NOTES HOMAN
H.C. NUHFER
R.C. CANTERBURY/HUSS
BARNHISEL
HUSS/ADKINS

DATE 07/08/04
WEATHER CLOUDY
TEMP. +65°

ROUTE SR 6
COUNTY SANDUSKY
TOWNSHIP BALLVILLE
SECTION 6
T 4 N R 15 E

TYPE MONUMENT MON BOX W/ IRON PIN
ON SURFACE - ~~BELOW~~ ON
LEFT - ~~C PAV'T~~ - ~~RIGHT~~ 4.3'
8.1' TO LT EDGE PAVEMENT
S.L.M. 633+26


GRID: NORTHING: 611188.992 EASTING: 1779919.212

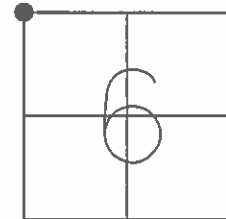

RECORD: 633+20.95

REFA25
FD MON BOX
W/ 1" IPIN
06-23-16
DCH, JLL

SET N&S
SET 1ST & 3RD
PAINT MARKING
PARKING LOT

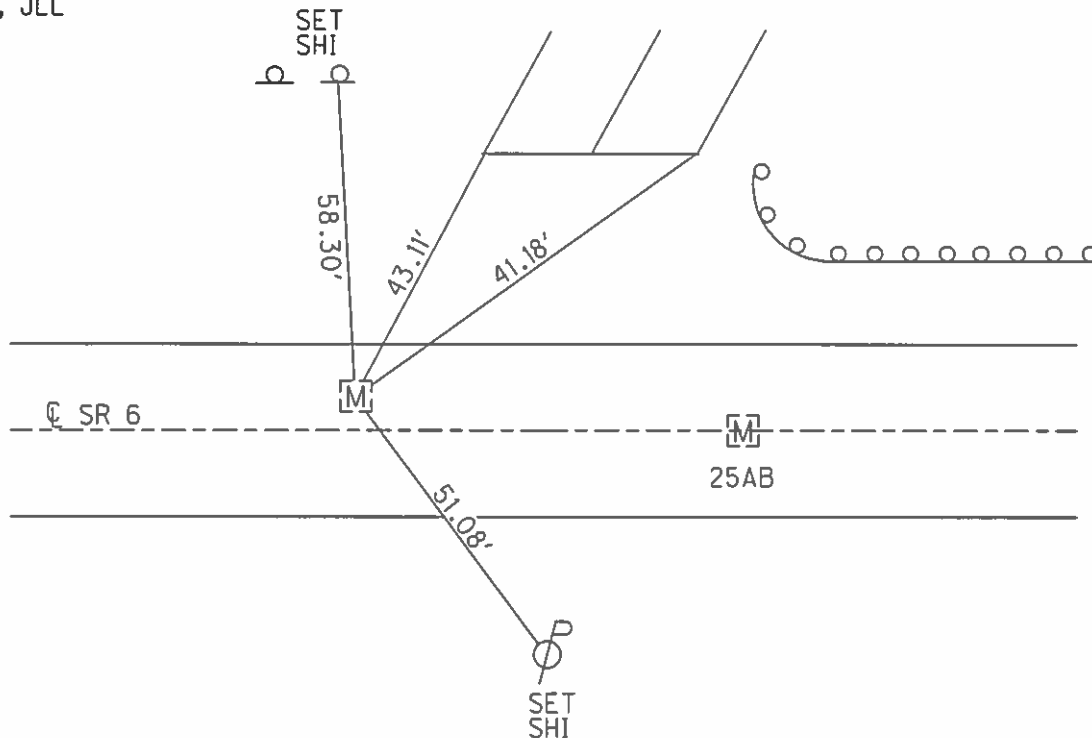

O.D.O.T. DISTRICT 2 SURVEY OFFICE (USE ONLY)

PERSONNEL

REFERENCE NO.

25 AB

SHEET

22 OF

25

NOTES

HOMAN

DATE

07/08/04

ROUTE

SR 6

H.C.

NUHFER

WEATHER

CLOUDY

COUNTY

SANDUSKY

R.C.

CANTERBURY/HUSS

TEMP.

+65°

TOWNSHIP

BALLVILLE

BARNHISEL

SECTION

6

HUSS/ADKINS

T 4 N R 15 E

TYPE MONUMENT

MON BOX W/ IRON PIN

ON SURFACE - ~~BELOW~~

ON

LEFT - ~~C PAV'T~~ - ~~RIGHT~~

0.5'

11.7' TO LT EDGE PAVEMENT

S.L.M.


636+74

GRID: NORTHING:

611182.124

EASTING:

1780265.867

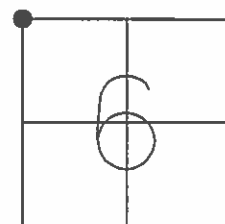

RECORD: 636+67.30


REFB25

FD MON BOX

W/ 1" IPIN

06/23/16

DCH, JLL

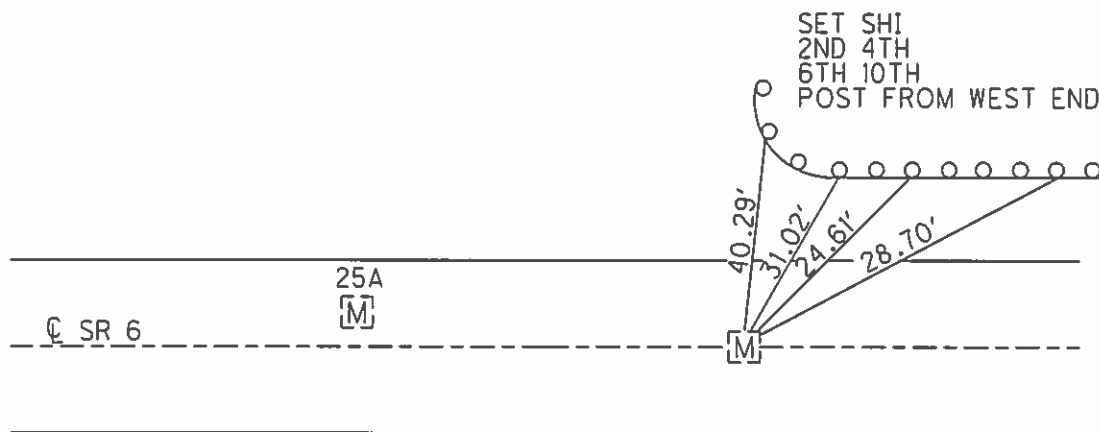

O.D.O.T. DISTRICT 2 SURVEY OFFICE (USE ONLY)

PERSONNEL

REFERENCE NO. 25 B


SHEET 23 OF 25

NOTES
H.C. HOMAN
R.C. NUHFER
CANTERBURY
BARNHISEL
HUSS/ADKINS

DATE 07/07/04
WEATHER CLOUDY
TEMP. +80°

ROUTE SR 6
COUNTY SANDUSKY
TOWNSHIP BALLVILLE
SECTION 6
T 4 N R 15 E


TYPE MONUMENT MON BOX
ON SURFACE - ~~BELOW~~ ON
~~LEFT - C PAV'T~~ - RIGHT 2'
10' TO RT EDGE PAVEMENT
S.L.M. 647+71

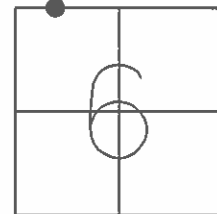

GRID: NORTHING: 611159.709 EASTING: 1781352.838

RECORD: 647+55.38

REFC25
FD MON BOX
W/ 1" IPIN
06-23-16
DCH, JLL

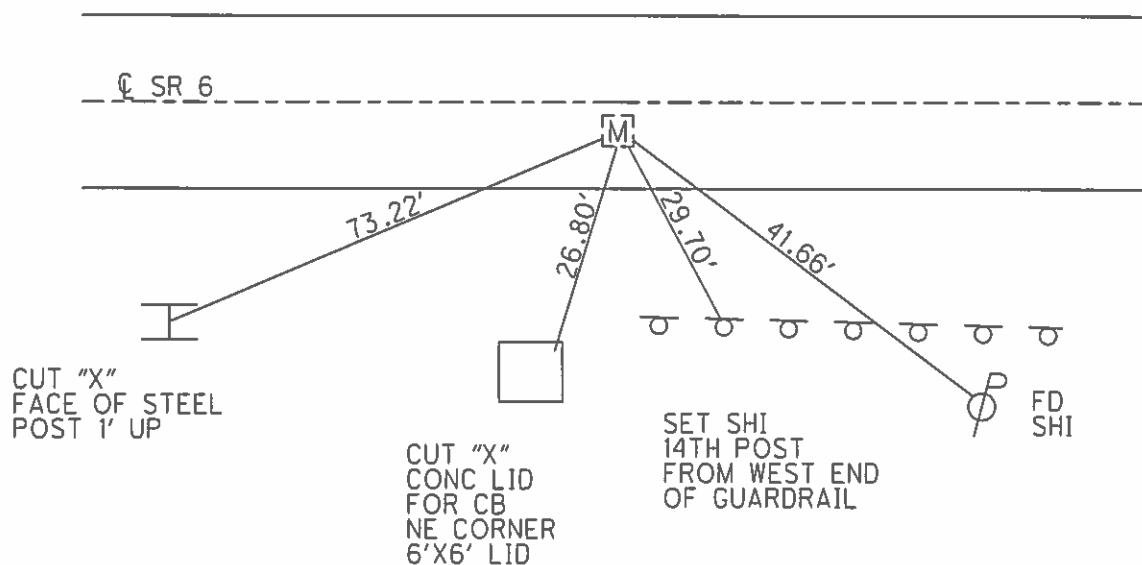

O.D.O.T. DISTRICT 2 SURVEY OFFICE (USE ONLY)

PERSONNEL

REFERENCE NO.

26

SHEET

24

OF

25

NOTES

HOMAN

DATE

07/08/04

ROUTE

SR 6

H.C.

NUHFER

WEATHER

CLOUDY

COUNTY

SANDUSKY

R.C.

CANTERBURY

TEMP.

+65°

TOWNSHIP

BALLVILLE

BARNHISEL

SECTION

6

HUSS/ADKINS

T 4 N R 15 E

TYPE MONUMENT MON BOX W/ IRON PIN


ON SURFACE - ~~BELOW~~ ON

~~LEFT - C PAV'T~~ - RIGHT 2.6'

9.3' TO RT EDGE PAVEMENT


S.L.M. 658+51

GRID: NORTHING: 611138.720 EASTING: 1782427.067

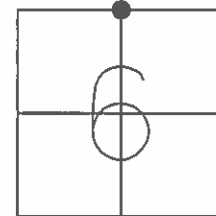

RECORD: 658+30.45

REF26
FD MON BOX
W/ 1" IPIN
06-23-16
DCH, JLL

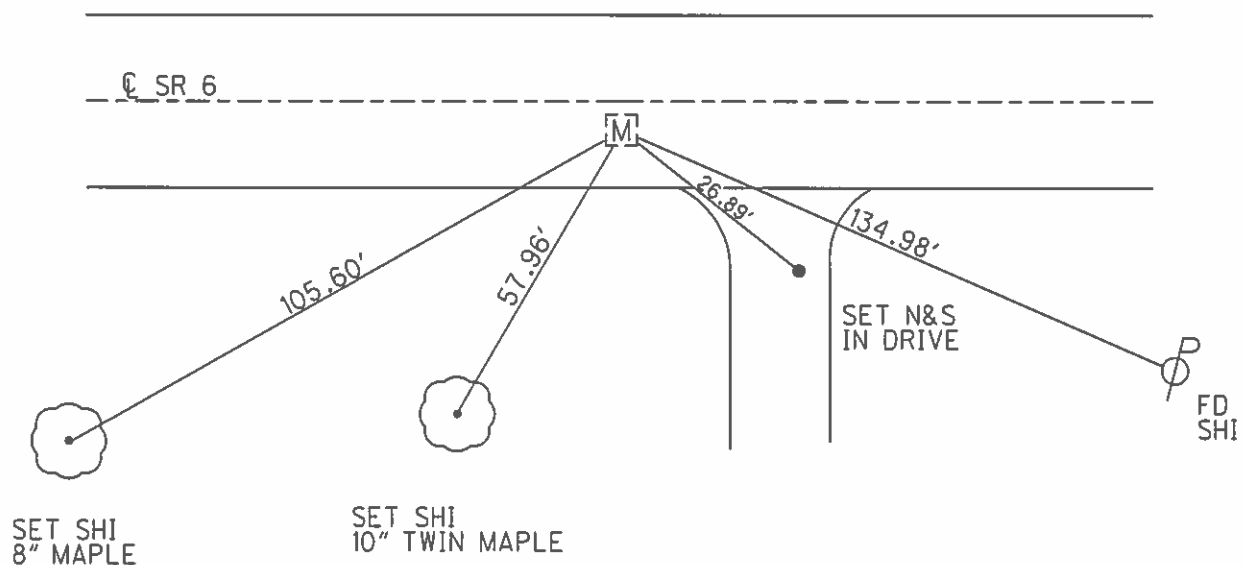

O.D.O.T. DISTRICT 2 SURVEY OFFICE (USE ONLY)

PERSONNEL	REFERENCE NO. <u>27</u>	SHEET <u>25</u> OF <u>25</u>
NOTES	DATE <u>07/08/04</u>	ROUTE <u>SR 6</u>
H.C. <u>HOMAN</u>	WEATHER <u>CLOUDY</u>	COUNTY <u>SANDUSKY</u>
R.C. <u>NUHFER</u>	TEMP. <u>+65°</u>	TOWNSHIP <u>SANDUSKY</u>
<u>CANTERBURY</u>		SECTION <u>31</u>
<u>BARNHISEL</u>		
<u>HUSS/ADKINS</u>		

T 5 N R 15 E

TYPE MONUMENT MON BOX W/ IRON PIN


ON SURFACE - ~~BELOW~~ ON

~~LEFT~~ - Q PAV'T - ~~RIGHT~~ ON, 5' W OF Q CR 130


12.2' TO RT EDGE PAVEMENT

S.L.M. 671+01

GRID: NORTHING: 61118.007 EASTING: 1783670.557

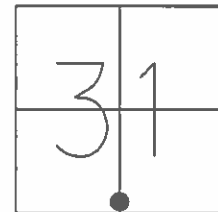

REF27
FD MON BOX
W/ 1" IPIN
06-23-16
DCH, JLL

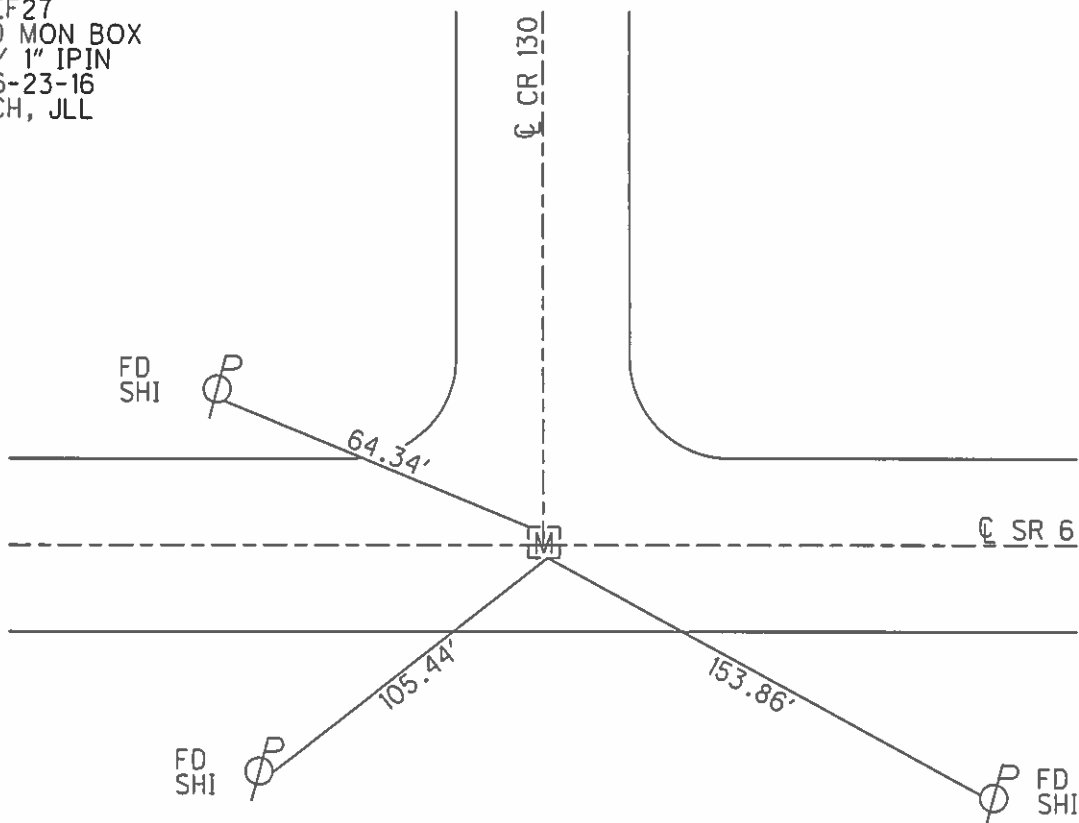

O.D.O.T. DISTRICT 2 SURVEY OFFICE (USE ONLY)

PERSONNEL

REFERENCE NO. 27 A

SHEET 1 OF 18

NOTES LEU

DATE 6/17/19

ROUTE US 6

H.C. LEU

WEATHER CLOUDY

COUNTY SANDUSKY

R.C. AUBLE

TEMP. 63°

TOWNSHIP SANDUSKY

DWG BY GARRETT

PID 77825

SECTION 25

T 5 N R 15 E

TYPE MONUMENT MONBOX W/ 1" IPIN

ON SURFACE - ~~BELOW~~ ON

OFFSET Q PAVEMENT ON LT : RT

- TO - EDGE PAVEMENT


STATION: 983+26.5

HORZ.DATUM: NAD83 (2011)

GEOID: 2012A


GRID: NORTHING: 618098.707

EASTING: 1807119.409

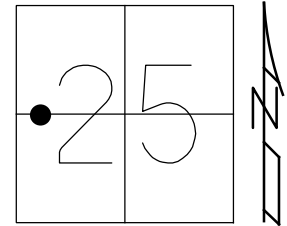

RECORD:
FD MONBOX
6/10/08, DH
FD MONBOX
REF27
11/15/19, JLL

DIST, 27A-28= 5.18'

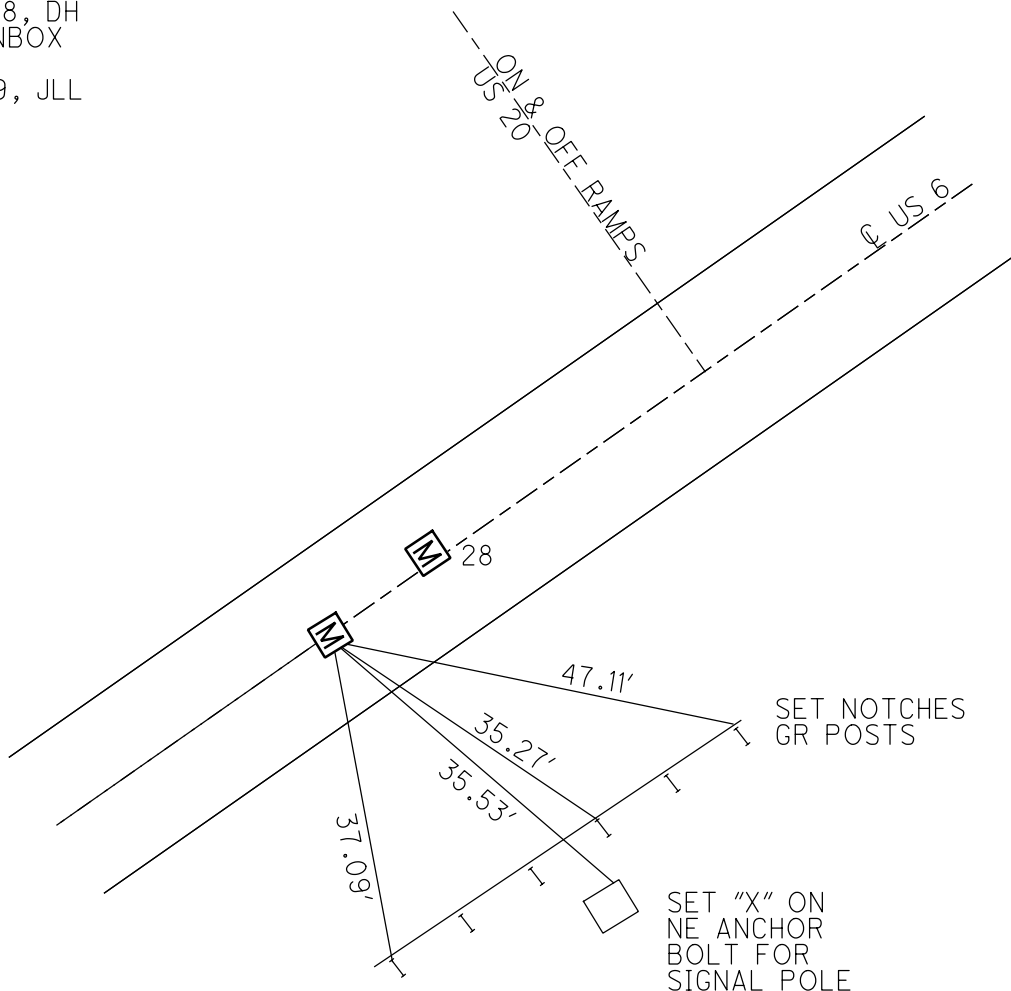

O.D.O.T. DISTRICT 2 SURVEY OFFICE (USE ONLY)

PERSONNEL

REFERENCE NO. 28

SHEET 2 OF 18

NOTES LEU

DATE 6/17/19

ROUTE US 6

H.C. LEU

WEATHER CLOUDY

COUNTY SANDUSKY

R.C. AUBLE

TEMP. 63°

TOWNSHIP SANDUSKY

SECTION 25

DWG BY GARRETT

PID 77825

T 5 N R 15 E

TYPE MONUMENT MONBOX W/ 1" IPIN

ON SURFACE - ~~BELOW~~ ON

OFFSET CL PAVEMENT 2.6' LT : ~~RT~~

- TO - EDGE PAVEMENT


STATION: 983+31.04

HORZ.DATUM: NAD83 (2011)

GEOID: 2012A


GRID: NORTHING: 618098.396

EASTING: 1807119.567

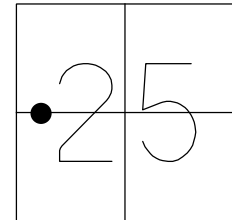

RECORD:
FD MON BOX
6/10/08, DH
FD MONBOX
REF28
11/15/19, JLL

DIST, 27A-28= 5.18'

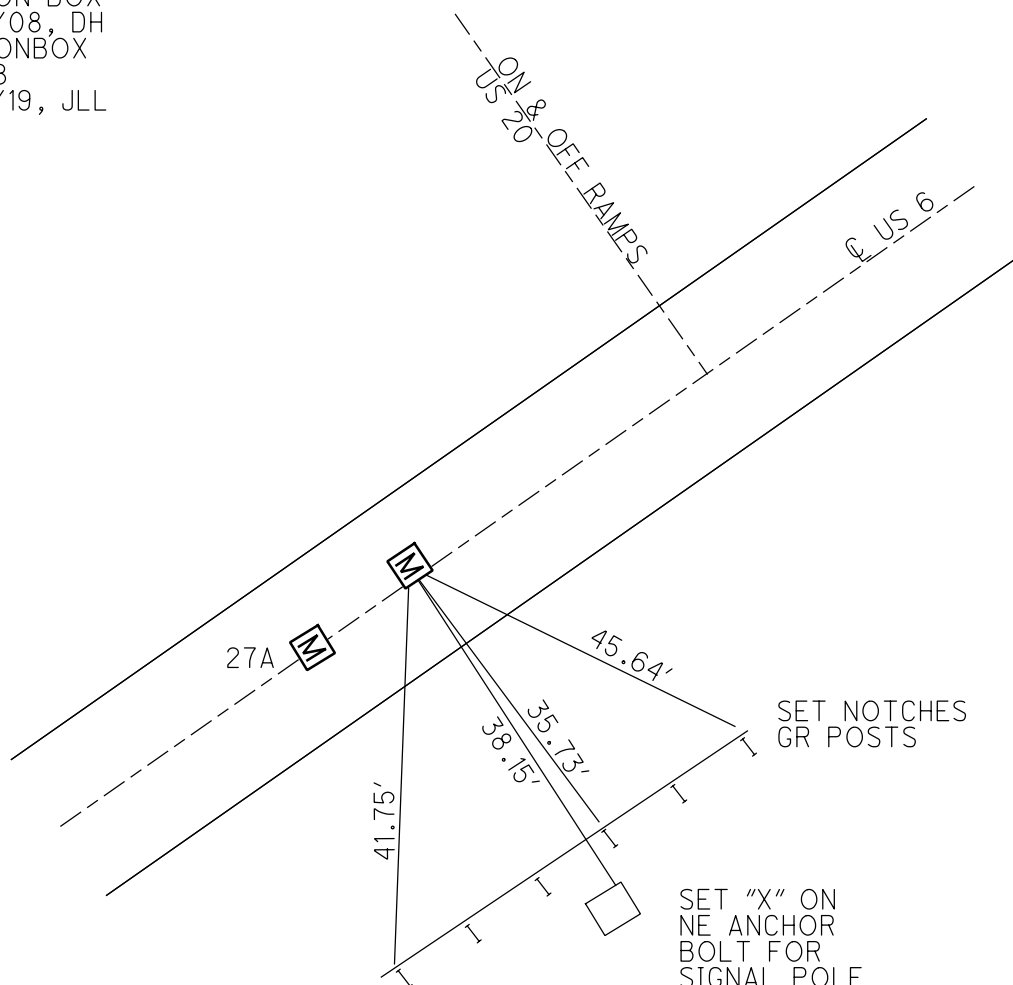

O.D.O.T. DISTRICT 2 SURVEY OFFICE (USE ONLY)

PERSONNEL

REFERENCE NO. 28 AA

SHEET 3 OF 18

NOTES LEU
H.C. LEU
R.C. MILLER

DATE 5/14/19
WEATHER SUNNY
TEMP. 53°

ROUTE US 6
COUNTY SANDUSKY
TOWNSHIP SANDUSKY
SECTION 25
T 5 N R 15 E

DWG BY GARRETT PID 77825

TYPE MONUMENT MONBOX W/ 1" IPIN

ON SURFACE - ~~BELOW~~ ON

OFFSET Q PAVEMENT ON LT : RT

- TO - EDGE PAVEMENT


STATION: 992+00

HORZ.DATUM: NAD83 (2011)


GEOID: 2012A

GRID: NORTHING: 618616.178

EASTING: 1807817.373

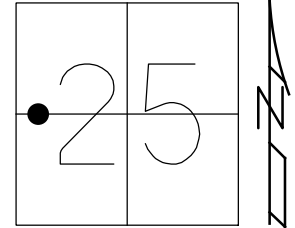

RECORD:
FD MONBOX
11/15/19, JLL
CKSTA992
5/27/2020

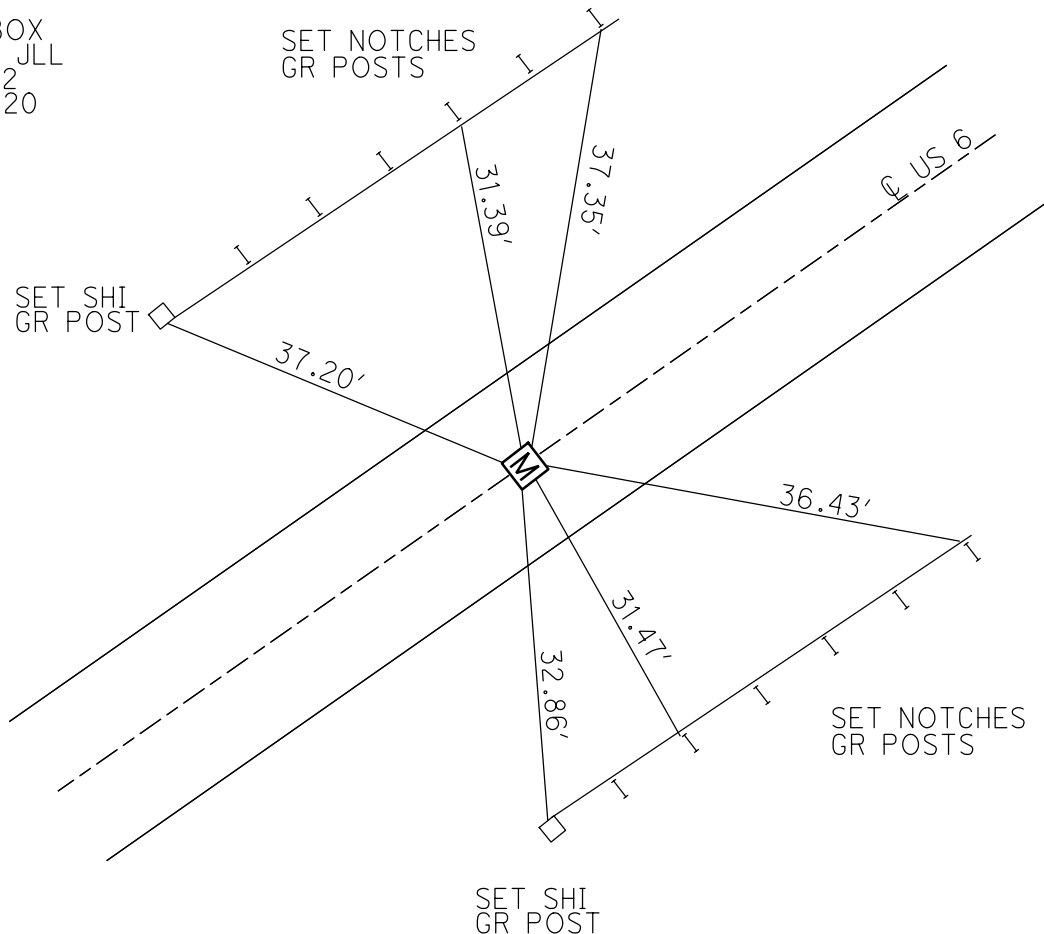

O.D.O.T. DISTRICT 2 SURVEY OFFICE

PERSONNEL

REFERENCE NO. 28-A

SHEET 3 OF 17

NOTES HOMAN

DATE 8/06/09

ROUTE US 6

H.C. HOMAN

WEATHER SUNNY

COUNTY SANDUSKY

R.C. ROUSOS

TEMP. 70°

TOWNSHIP SANDUSKY

SECTION 25

T 5 N R 15 E

TYPE MONUMENT MON.BOX


ON SURFACE - BELOW ON

~~LEFT~~ - Q PAV'T - ~~RIGHT~~ ON

TO EDGE PAVEMENT

S.L.M. 999+66.74

GPS Northing: 619074.832 Easting: 1808431.725

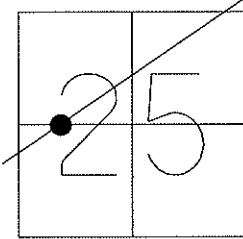


NOTE: 9/03/91
PREVIOUS MONUMENTS:
P.K. & WASHER
"4" IN CONC. PAV'T

P.I. 35+73
ON N-S 1/4 SEC. LINE

RESET P.K. & WASHER
9/03/91

FD MON BOX
ON CORPLINE
6/10/08 DH

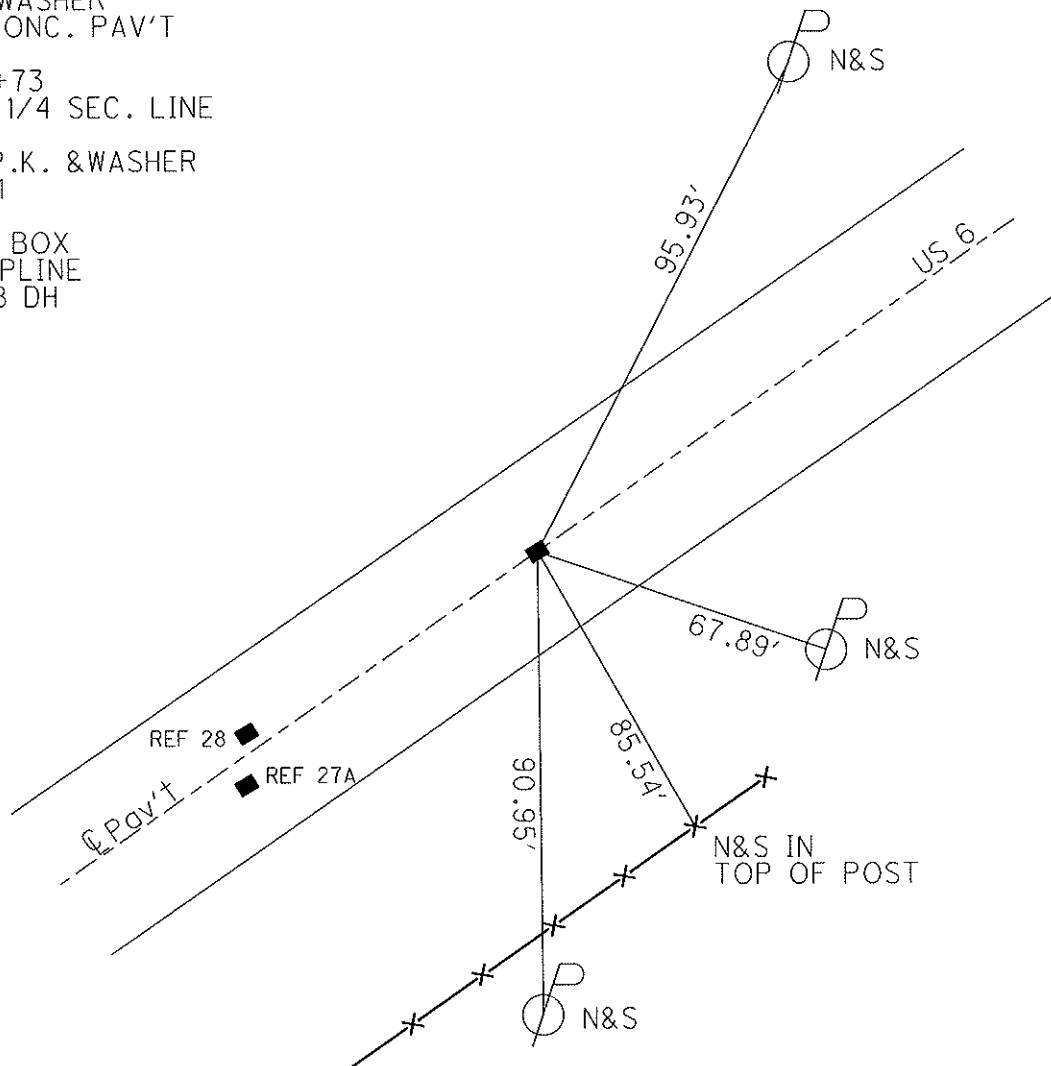

O.D.O.T. DISTRICT 2 SURVEY OFFICE

PERSONNEL

REFERENCE NO. 28-B

SHEET 4 OF 17

NOTES

HOMAN

DATE 8/06/09

ROUTE US 6

H.C.

HOMAN

WEATHER SUNNY

COUNTY SANDUSKY

R.C.

ROUSOS

TEMP. 70°

TOWNSHIP SANDUSKY

SECTION 25

T 5 N R 15 E

TYPE MONUMENT P.K.


~~ON SURFACE~~ - BELOW 3"

~~LEFT~~ - Q PAV'T - RIGHT 1.5'

TO EDGE PAVEMENT

S.L.M. 1016+09.50

GPS Northing: 620056.653 Easting: 1809748.783

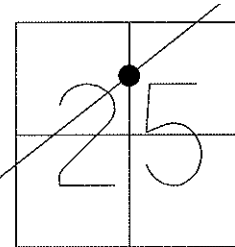


NOTE: 9/03/91
PREVIOUS MONUMENTS:
P.K. & WASHER
MINE SPIKE

P.I. 52+05
ON N-S 1/2 SEC. LINE
RECORD = 00°13' RT.

RESET P.K. & WASHER
STA. 1024+42
9/03/91

SET MAG & WASHER
10/29/09 DH

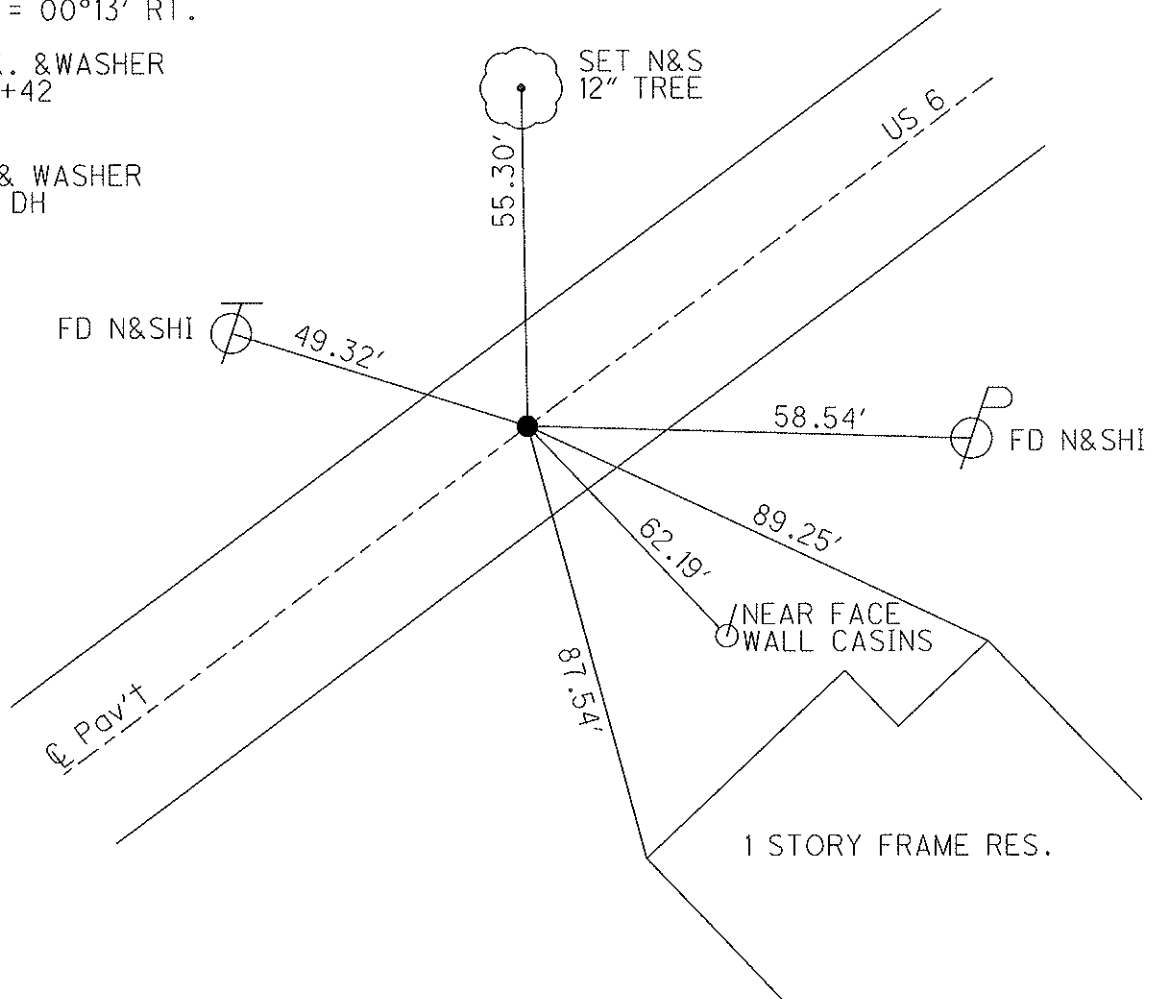

O.D.O.T. DISTRICT 2 SURVEY OFFICE

PERSONNEL

REFERENCE NO. 29

SHEET 5 OF 17

NOTES

HOMAN

DATE 8/06/09

ROUTE US 6

H.C.

HOMAN

WEATHER SUNNY

COUNTY SANDUSKY

R.C.

ROUSOS

TEMP. 75°

TOWNSHIP SANDUSKY, RILEY

SECTION 24 & 19

T 5 N R 15&16 E

TYPE MONUMENT P.K. & WASHER


ON SURFACE - ~~BELOW~~ ON

~~LEFT~~ - Q PAV'T - RIGHT 2.0'

TO EDGE PAVEMENT

S.L.M. 1408+81.24


GPS Northing: 621997.326 Easting: 1812382.826

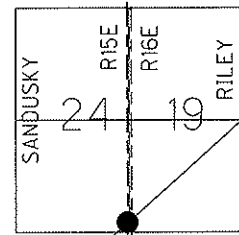

NOTE: 9/03/91
PREVIOUS MONUMENTS:
SMALL SPIKE & WASHER
P.K. & WASHER
P.I. 84+68.10

FD P.K.'S & WASHERS
6/10/09 DH

SET MAG & WASHER
STA.=1048+81.24
10/29/09 DH

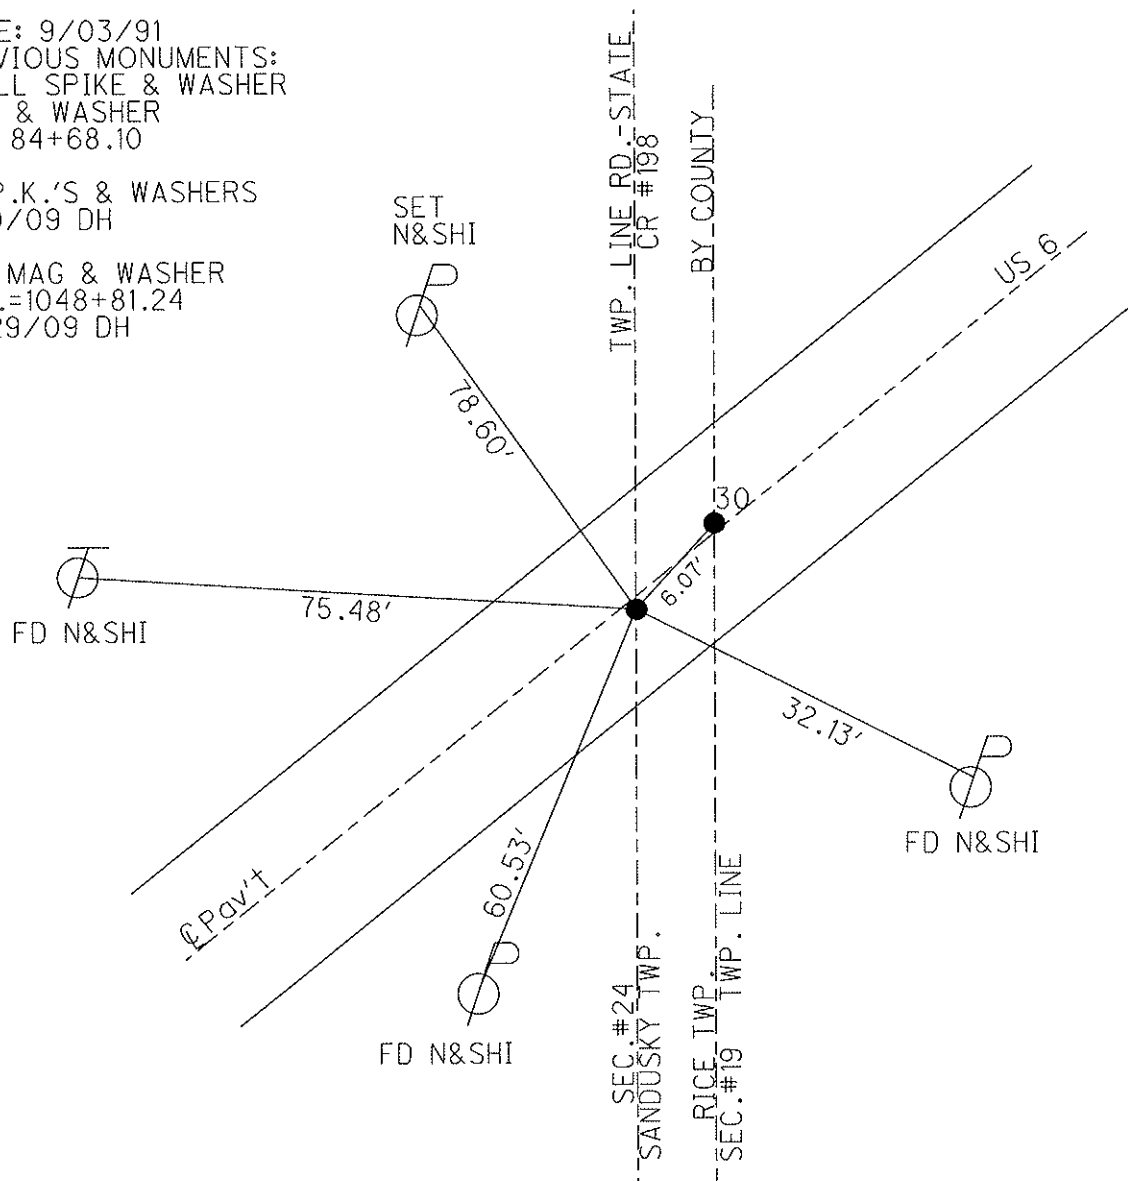

O.D.O.T. DISTRICT 2 SURVEY OFFICE

PERSONNEL

REFERENCE NO. 30

SHEET 6 OF 17

NOTES HOMAN

DATE 8/06/09

ROUTE US 6

H.C. HOMAN

WEATHER SUNNY

COUNTY SANDUSKY

R.C. ROUSOS

TEMP. 75°

TOWNSHIPS SANDUSKY, RILEY

SECTION 24 & 19

T 5 N R 15&16 E

TYPE MONUMENT P.K. & WASHER



ON SURFACE - ~~BELOW~~ ON

~~LEFT~~ - Q PAV'T - RIGHT A= 2.0' - STATE

TO EDGE PAVEMENT

S.L.M. 1048+86.97


GPS Northing: 622002.101 Easting: 1812386.537

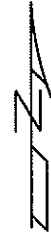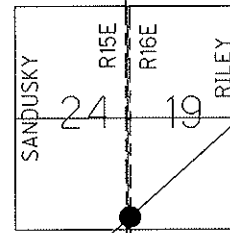

NOTE: 9/03/91
PREVIOUS MONUMENTS:
SMALL SPIKE & WASHER
P.K. & WASHER
P.I. 84+68.10

FD P.K.'S & WASHERS
6/10/09 DH

SET MAG & WASHER

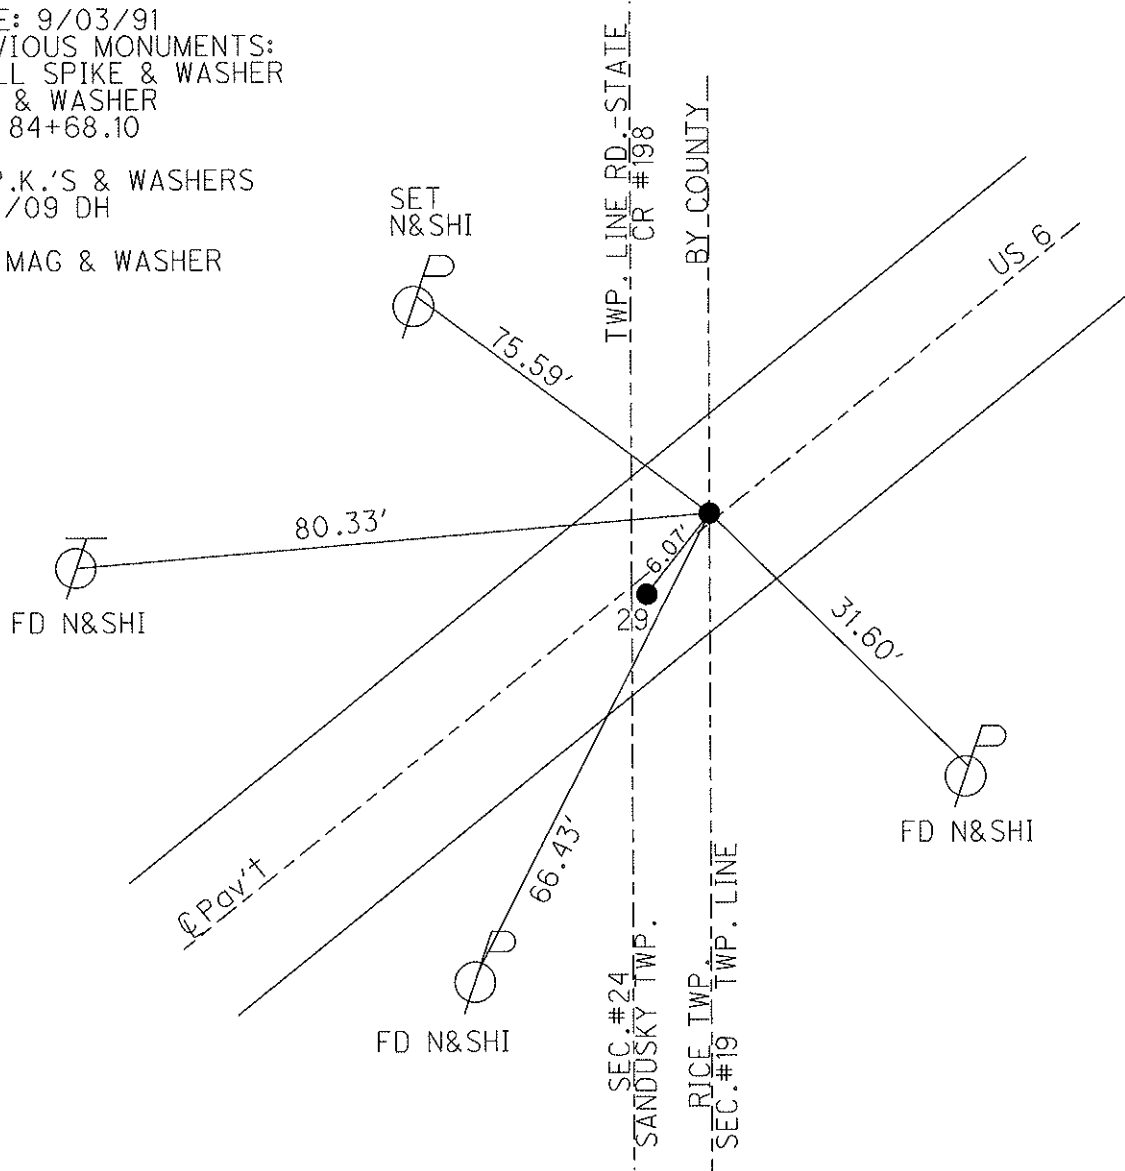

O.D.O.T. DISTRICT 2 SURVEY OFFICE

PERSONNEL

REFERENCE NO. 30-A

SHEET 7 OF 17

NOTES HOMAN

DATE 8/06/09

ROUTE US 6

H.C. HOMAN

WEATHER SUNNY

COUNTY SANDUSKY

R.C. ROUSOS

TEMP. 80°

TOWNSHIP RILEY

SECTION 19

T 5 N R 16 E

TYPE MONUMENT P.K. & WASHER


~~ON SURFACE~~ - BELOW 3"

~~LEFT - C PAV'T~~ - RIGHT 3.5'

TO EDGE PAVEMENT

S.L.M. 1071+25.60

GPS Northing: 623321.623 Easting: 1814194.937

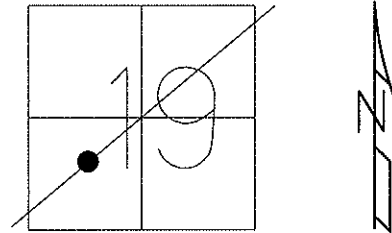


NOTE: 9/03/91
P.I. WAS CHANGED IN THE
FIELD. DOES NOT CONFORM
WITH 1926 PLAN,
JACK CRONIN 1975

PREVIOUS MONUMENTS:
SMALL SPIKE & WASHER
P.K. & WASHER
RECORD P.I. 107+12.4

FD P.K. & WASHER,
3" DOWN 6/10/09 DH

SET MAG & WASHER
10/29/09 DH

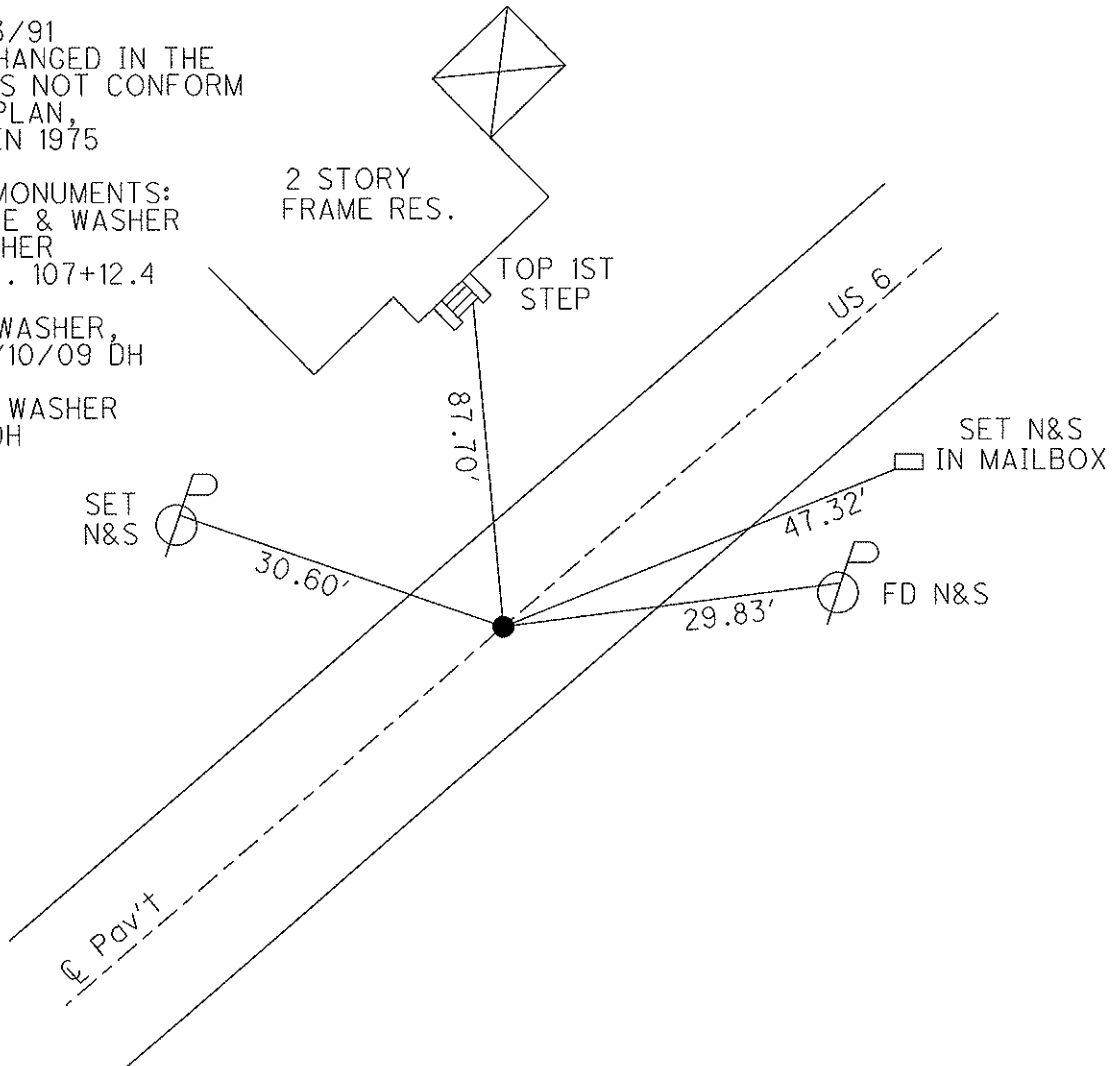

O.D.O.T. DISTRICT 2 SURVEY OFFICE

PERSONNEL

REFERENCE NO. 30-B

SHEET 8 OF 17

NOTES HOMAN

DATE 8/06/09

ROUTE US 6

H.C. HOMAN

WEATHER SUNNY

COUNTY SANDUSKY

R.C. ROUSOS


TEMP. 80°

TOWNSHIP RILEY

SECTION 19

T 5 N R 16 E

TYPE MONUMENT P.K. & WASHER

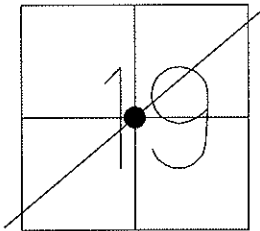

~~ON SURFACE~~ - BELOW 3"

~~LEFT - C PAV'T~~ - RIGHT 2.5'

TO EDGE PAVEMENT

S.L.M. 1086+30.81


GPS Northing: 624241.837 Easting: 1815386.030

NOTE: 9/03/91
P.I. WAS CHANGED IN THE
FIELD. DOES NOT CONFORM
WITH 1926 PLAN, STA. 122+17.4
JACK CRONIN 1975

PREVIOUS MONUMENTS:
SMALL MINE SPIKE
P.K. & WASHER
RECORD P.I. 122+17.4

FD P.K. 3" DOWN
6/10/09 DH

SET MAG & WASHER
10/29/09 DH

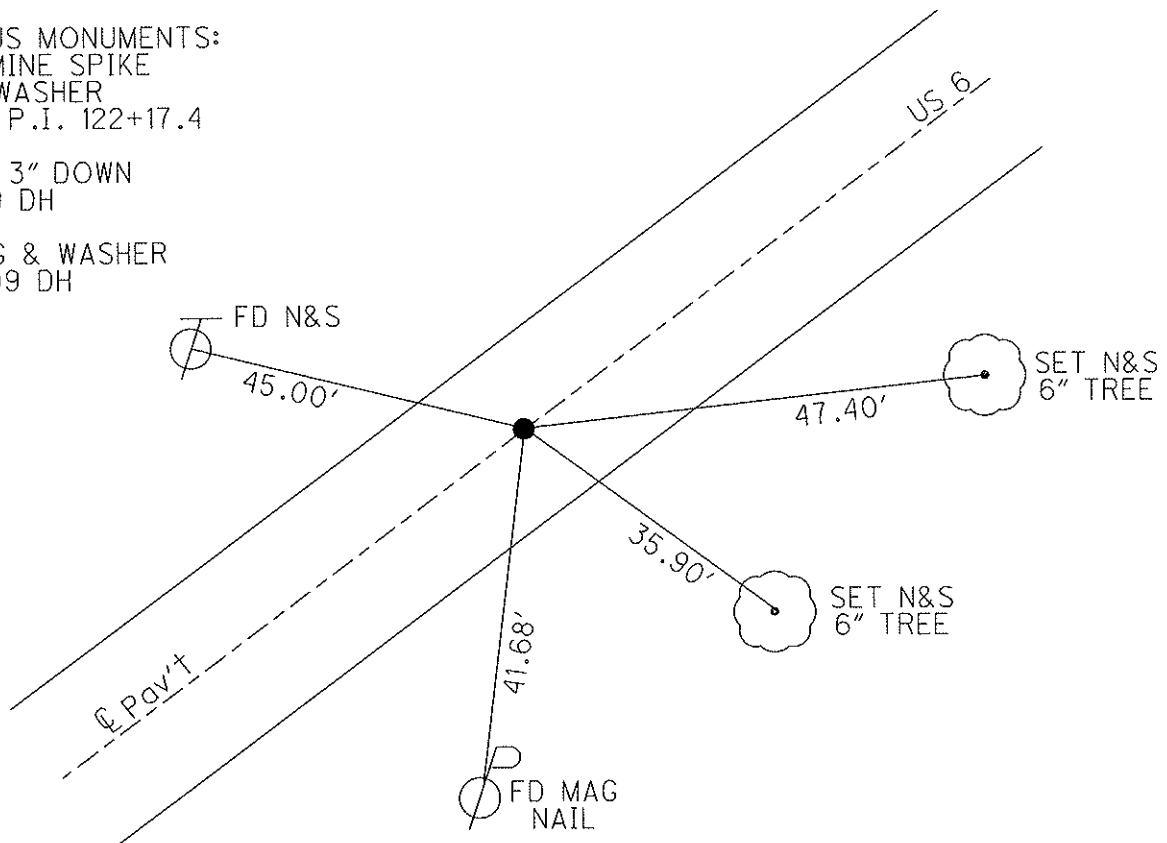

O.D.O.T. DISTRICT 2 SURVEY OFFICE

PERSONNEL

REFERENCE NO. 30-C

SHEET 9 OF 17

NOTES HOMAN

DATE 8/18/09

ROUTE US 6

H.C. HOMAN

WEATHER CLOUDY

COUNTY SANDUSKY

R.C. ROUSOS

TEMP. 75°

TOWNSHIP RILEY

SECTION 19 & 20

T 5 N R 16 E

TYPE MONUMENT P.K. & WASHER


ON SURFACE - ~~BELOW~~ ON

~~LEFT~~ - Q PAV'T - RIGHT 2'

TO EDGE PAVEMENT

S.L.M. 1123+67.22

GPS Northing: 626496.265 Easting: 1818365.650

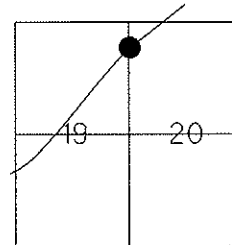


NOTE: 9/03/91
OLD PI STA.159+54.15

PREVIOUS MONUMENTS:
SMALL MINE SPIKE
P.K. & WASHER

FD P.K. SHANK,
6/10/08 DH

SET MAG & WASHER
10/29/09 DH

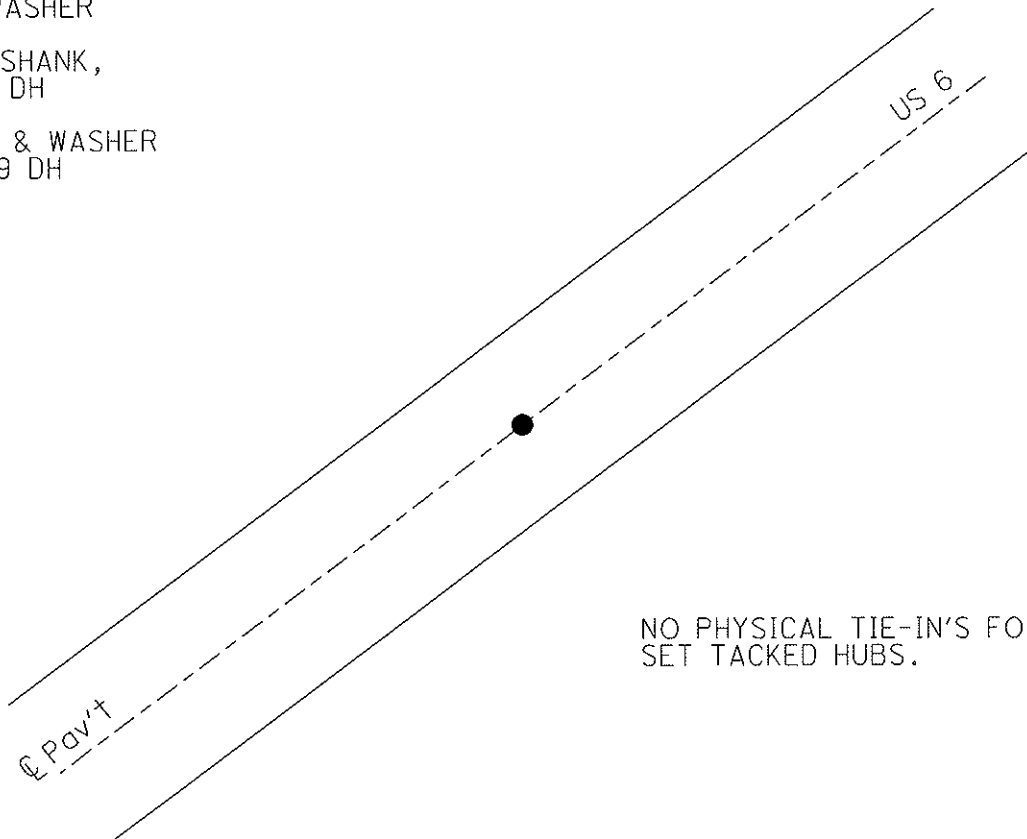

NO PHYSICAL TIE-IN'S FOUND.
SET TACKED HUBS.

O.D.O.T. DISTRICT 2 SURVEY OFFICE

PERSONNEL

REFERENCE NO. 31

SHEET 10 OF 17

NOTES HOMAN

DATE 8/06/09

ROUTE US 6

H.C. HOMAN

WEATHER SUNNY

COUNTY SANDUSKY

R.C. ROUSOS

TEMP. 80°

TOWNSHIP RILEY

SECTION 17

T 5 N R 16 E

TYPE MONUMENT P.K. SHANK


ON SURFACE - ~~BELOW~~ ON

~~LEFT~~ - C PAV'T - RIGHT 1.0' RT

TO EDGE PAVEMENT

S.L.M. 1144+66.78


GPS Northing: 627742.125 Easting: 1820055.762

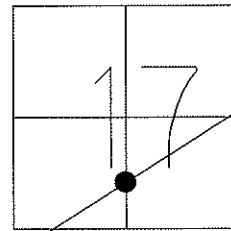

NOTE: 9/13/91
PREVIOUS MONUMENT:
R.R. SPIKE

FD P.K. SHANK,
6/10/08 DH

SET MAG & WASHER
10/29/09 DH

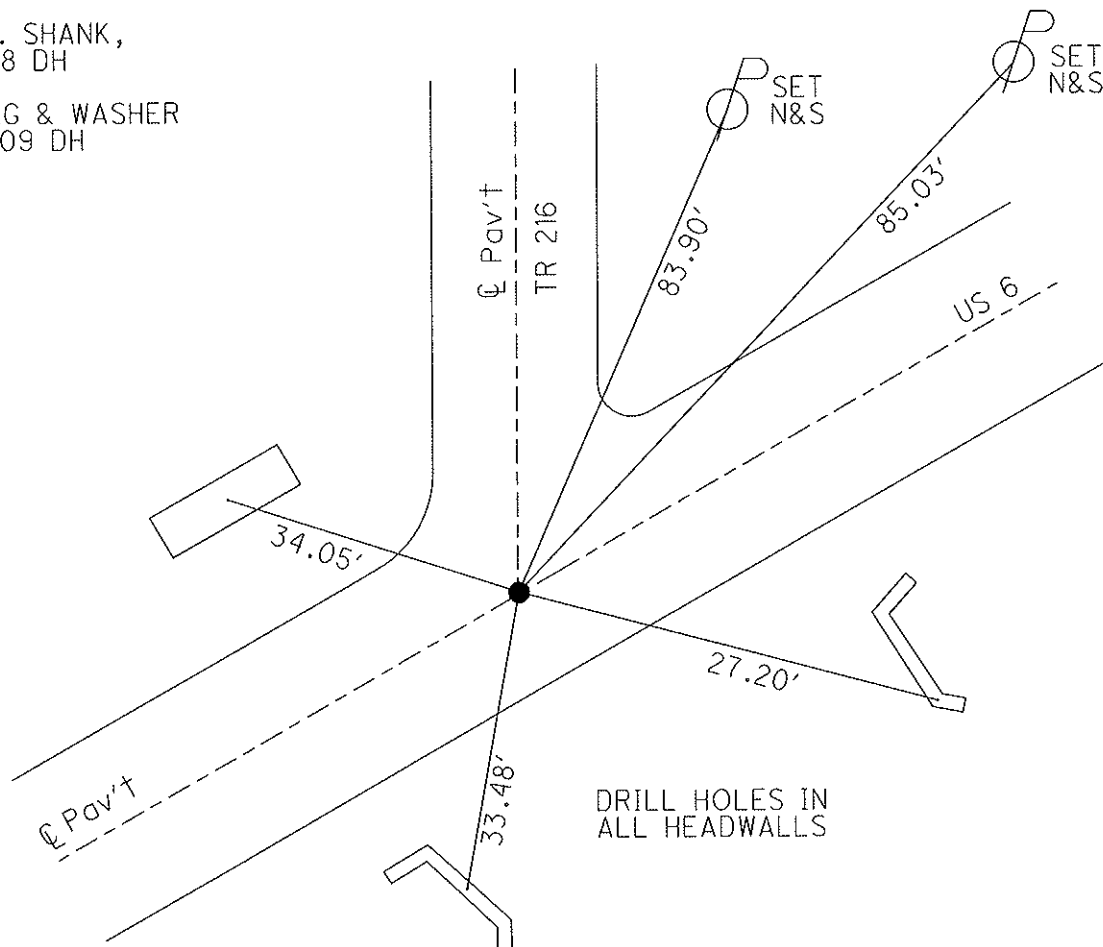

O.D.O.T. DISTRICT 2 SURVEY OFFICE

PERSONNEL

REFERENCE NO. 32

SHEET 11 OF 17

NOTES HOMAN

DATE 8/18/09

ROUTE US 6

H.C. HOMAN

WEATHER CLOUDY

COUNTY SANDUSKY

R.C. ROUSOS

TEMP. 75°

TOWNSHIP RILEY

SECTION 17

T 5 N R 16 E

TYPE MONUMENT P.K. & WASHER


ON SURFACE - ~~BELOW~~ ON

~~LEFT~~ - C PAV'T - RIGHT 1.5'

TO EDGE PAVEMENT

S.L.M.


GPS Northing: 628390.855 Easting: 1820937.530

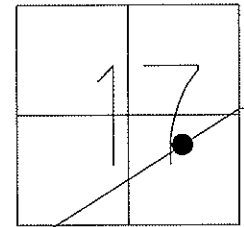

NOTE: 9/13/91
PREVIOUS MONUMENTS:
R.R. SPIKE

FD R.R. SPIKE
6/10/08 DH

RESET MAG& WASHER
10/29/09 DH

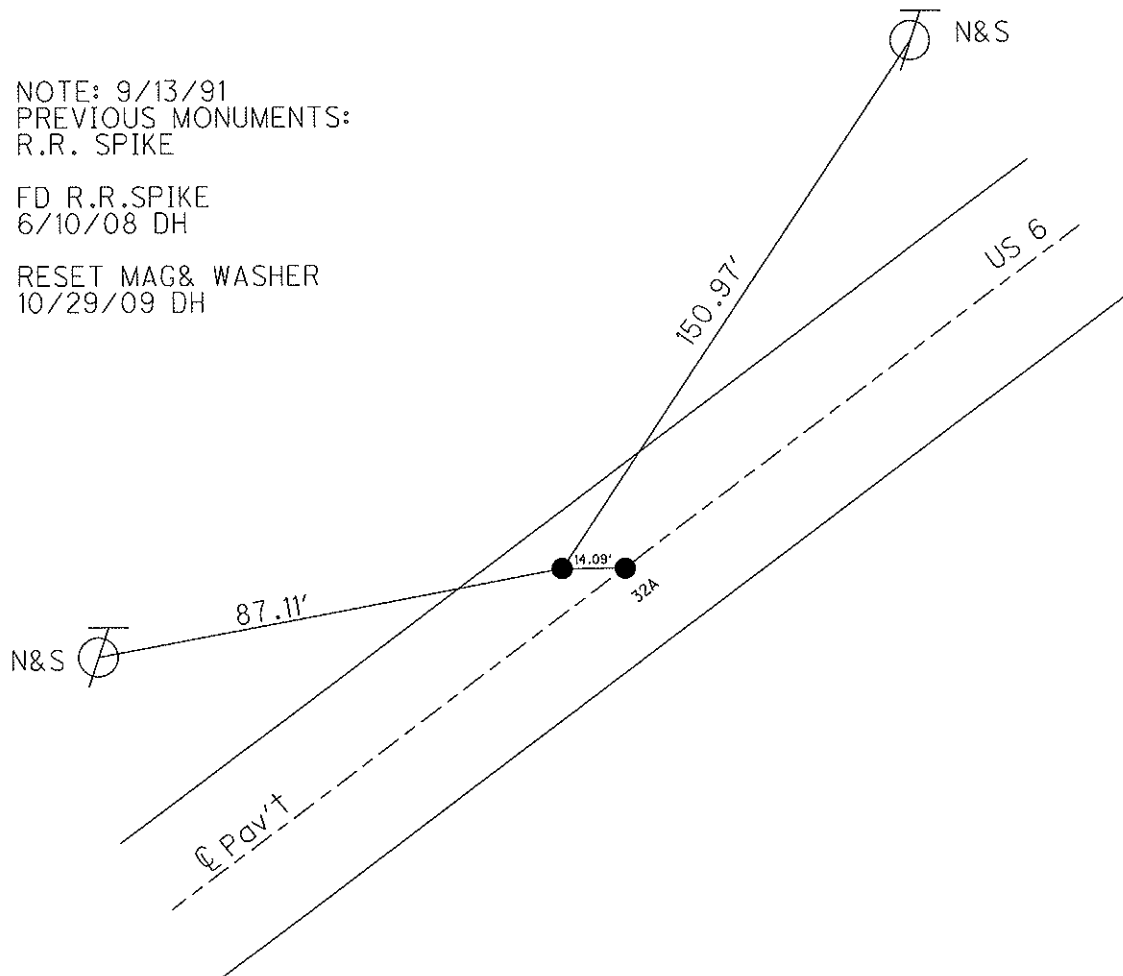

O.D.O.T. DISTRICT 2 SURVEY OFFICE

PERSONNEL

REFERENCE NO. 32A

SHEET 12 OF 17

NOTES HOMAN

DATE 8/18/09

ROUTE US 6

H.C. HOMAN

WEATHER CLOUDY

COUNTY SANDUSKY

R.C. ROUSOS

TEMP. 75°

TOWNSHIP RILEY

SECTION 17

T 5 N R 16 E

TYPE MONUMENT P.K. & WASHER


ON SURFACE - ~~BELOW~~ ON

~~LEFT~~ - Q PAV'T - ~~RIGHT~~

TO EDGE PAVEMENT

S.L.M. 1155+75.39


GPS Northing: 628397.241 Easting: 1820950.124

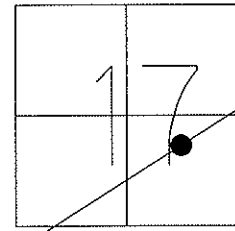

NOTE: 9/13/91
PREVIOUS MONUMENTS:
R.R. SPIKES
P.I. OLD STA. 1163+96

FD R.R. SPIKE
6/10/08 DH

RESET MAG & WASHER
10/29/09 DH

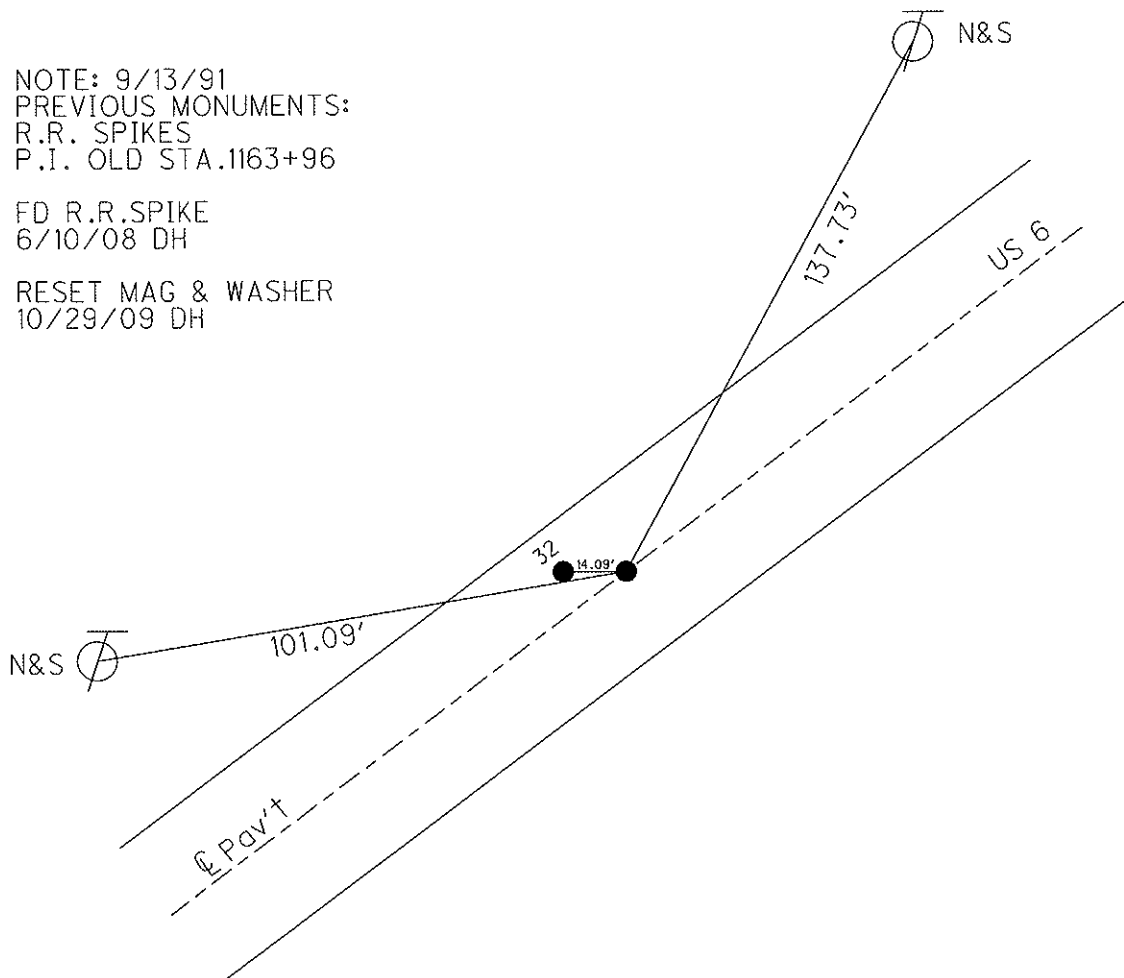

O.D.O.T. DISTRICT 2 SURVEY OFFICE

PERSONNEL

REFERENCE NO. 33

SHEET 13 OF 17

NOTES HOMAN

DATE 8/18/09

ROUTE US 6

H.C. HOMAN

WEATHER CLOUDY

COUNTY SANDUSKY

R.C. ROUSOS

TEMP. 75°

TOWNSHIP RILEY

SECTION 17

T 5 N R 16 E

TYPE MONUMENT 1" IRON ROD


ON SURFACE - BELOW

LEFT - Q PAV'T - RIGHT

8'± TO WEST EDGE PAVEMENT


S.L.M. 1177+73.50

GPS Northing: 629673.848 Easting: 1822739.560

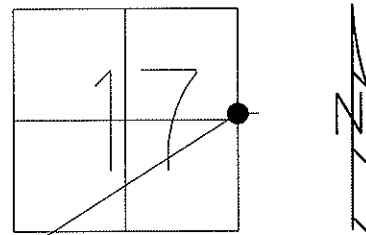

NOTE: 04/02/91
P.I.=STA.213+65 IRON ROD
 $\Delta = 40^{\circ}18'$ RT., FROM,
(MEAS.&FIELD BOOK)(07/28/1975?)

SAN-6-21.79
STA. 1151+56.02
 $\Delta = 40^{\circ}16'$ RT., FROM (PLAN)

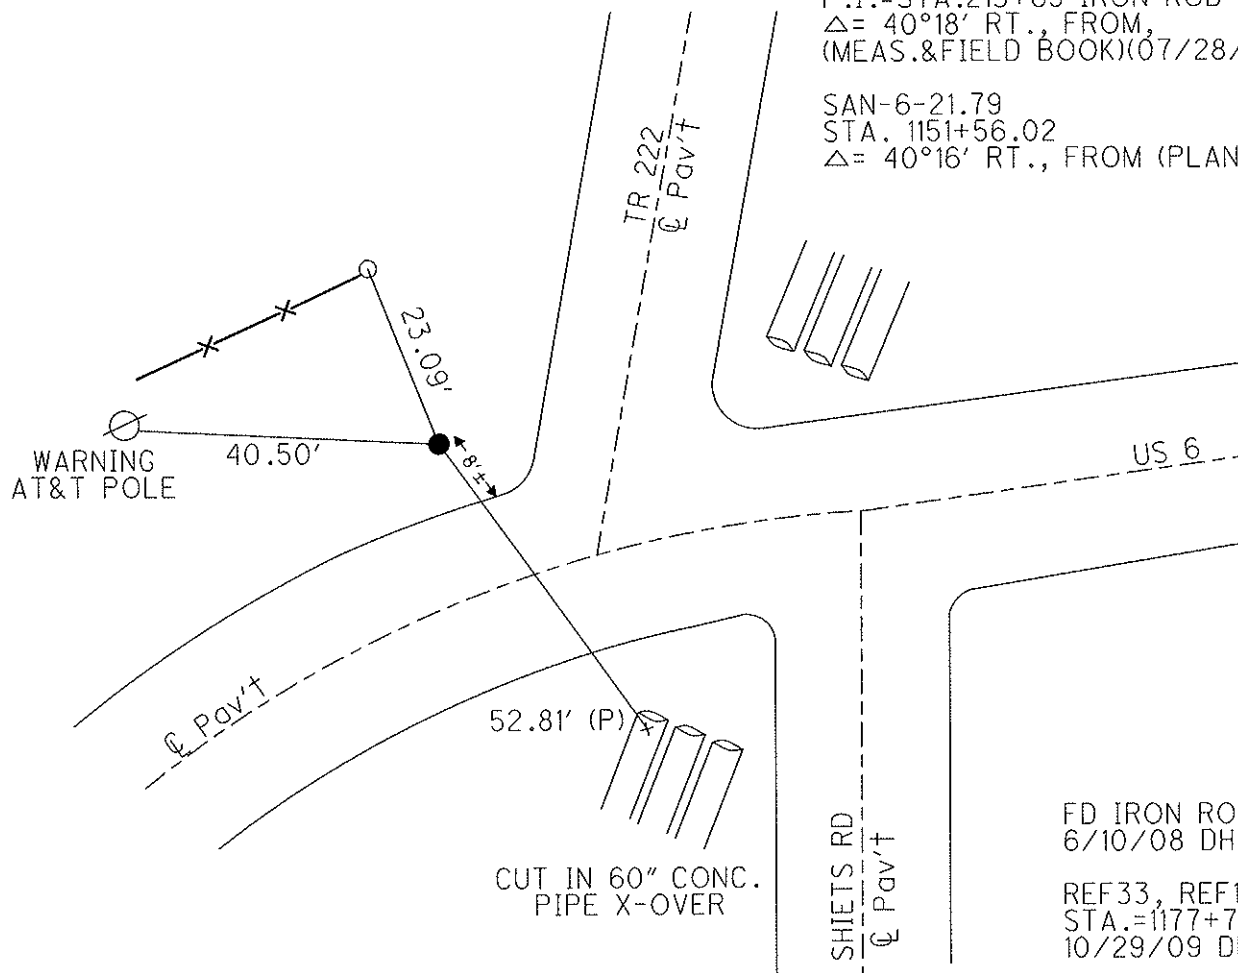

O.D.O.T. DISTRICT 2 SURVEY OFFICE

PERSONNEL

REFERENCE NO. 34

SHEET 14 OF 17

NOTES HOMAN

DATE 8/18/09

ROUTE 6

H.C. HOMAN

WEATHER CLOUDY

COUNTY SANDUSKY

R.C. ROUSOS

TEMP. 75°

TOWNSHIP RILEY

SECTION 16

T 5 N R 16 E

TYPE MONUMENT P.K. & WASHER


ON SURFACE - ~~BELOW~~ ON

LEFT - C PAV'T - RIGHT 1'

TO EDGE PAVEMENT

S.L.M. 1194+29.39

GPS Northing: 629535.246 Easting: 1824389.514

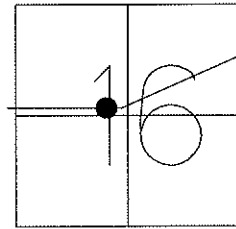

NOTE: 9/13/91

PLAN P.I.

$\Delta = 12^\circ 55'$ LT

STA. 230+08.12

SAN-6-21.59

STA. 1167+86.50,


FROM (RECORD)

FD P.K. & WASHER
6/10/08 DH

SET MAG & WASHER
10/29/09 DH

PREVIOUS MONUMENTS:

P.K. & WASHER, SMALL SPIKE

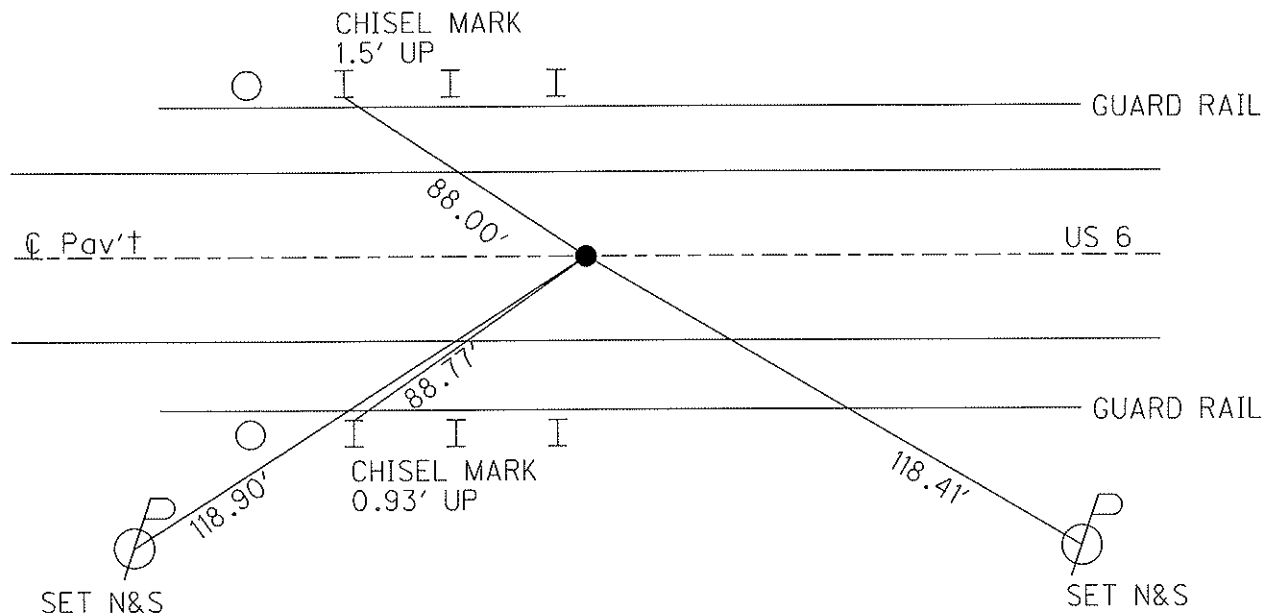

O.D.O.T. DISTRICT 2 SURVEY OFFICE

PERSONNEL

REFERENCE NO. 35

SHEET 15 OF 17

NOTES HOMAN

DATE 8/06/09

ROUTE US 6

H.C. HOMAN

WEATHER SUNNY

COUNTY SANDUSKY

R.C. ROUSOS

TEMP. 80°

TOWNSHIP RILEY

SECTION 16

T 5 N R 16 E

TYPE MONUMENT 1" IRON ROD


ON SURFACE - BELOW _____

LEFT - Q PAV'T - RIGHT _____

22' N TO S. EDGE PAVEMENT

S.L.M. 1197+38.92

GPS Northing: 629508.677 Easting: 1824697.823

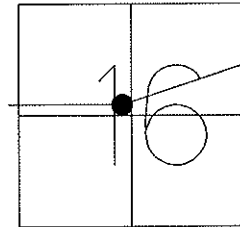


FD 1" IRON ROD
6/10/08 DH

Q Pav't

US 6

E/P

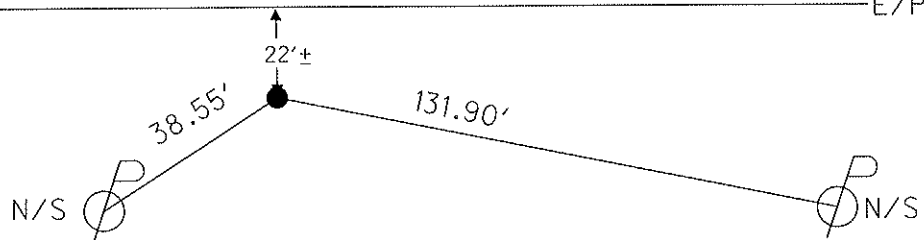

O.D.O.T. DISTRICT 2 SURVEY OFFICE

PERSONNEL

REFERENCE NO. 36

SHEET 16 OF 17

NOTES HOMAN

DATE 8/06/09

ROUTE US 6

H.C. HOMAN

WEATHER SUNNY

COUNTY SANDUSKY

R.C. ROUSOS

TEMP. 80°

TOWNSHIP RILEY

SECTION 16

T 5 N R 16 E

TYPE MONUMENT P.K. & WASHER


ON SURFACE - ~~BELOW~~ ON

~~LEFT~~ - Q PAV'T - RIGHT 2' RT

TO EDGE PAVEMENT

S.L.M. 1200+86.39

GPS Northing: 629625.737 Easting: 1825024.838

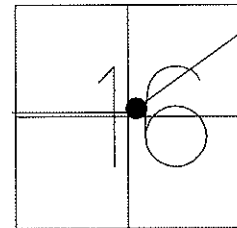

PREVIOUS MONUMENTS:

P.K. & WASHER
SMALL SPIKE

P.I. - PLAN

$\Delta = 12^\circ 26' 00''$ LT.


$\Delta = 12^\circ 26' 22''$ LT. MEAS.

STA. 236+49

NOTE: 9/13/91

SAN-6-21.59

ERROR IN DATA ON PLAN

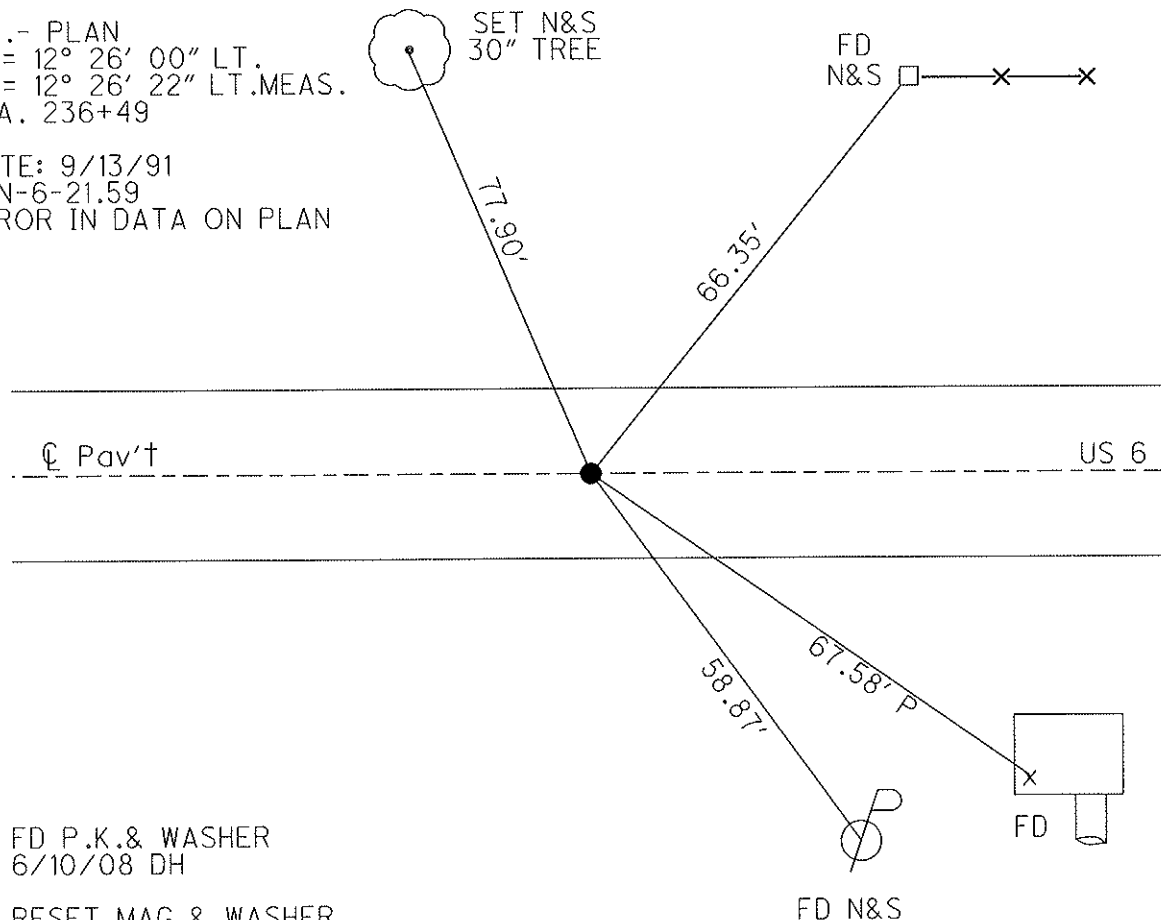

FD P.K. & WASHER
6/10/08 DH

RESET MAG & WASHER
10/29/09 DH

O.D.O.T. DISTRICT 2 SURVEY OFFICE (USE ONLY)

PERSONNEL

REFERENCE NO. 36 A

SHEET 18 OF 19

NOTES PRESTON-COLVIN

DATE 9-4-24

ROUTE US 6

H.C. NEISE

WEATHER SUNNY

COUNTY SANDUSKY

R.C. BARRIERE

TEMP. 65°

TOWNSHIP RILEY

SECTION 16

DWG BY PRESTON-COLVIN PID PAVING TRAIN

T 5 N R 16 E

TYPE MONUMENT MAG/WASHER

ON SURFACE - BELOW ON

OFFSET $\mathcal{Q}$ PAVEMENT ON LT : RT

- TO - EDGE PAVEMENT

STATION: 1233+50.83

HORIZ.DATUM: NAD83 (2011)


GEOID: NAVD88 2018

GRID: NORTHING: 630771.791


EASTING: 1828081.589

LDP: NORTHING: 326954.9

EASTING: 188239.5

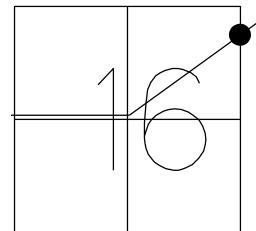

RECORD: P.I.
P.K./WASHER
R.R. SPIKE
STA. 1240+88
SET P.K./WASHER
6/9/02, DCH
FD R.R.SPIKE
6/10/08, DCH
FD R.R.SPIKE
4" DOWN
REF37
8/6/09, DCH
FD R.R.SPIKE
W/DIMPLE
4" DOWN
11/22/17, DCH
8/1/18, JLL
SET MAG/WASHER
7/31/19, JLL
FD MAG/WASHER
7/26/21, TDN
2/10/22, JFO
FD MAG/WASHER
REF36A
9-4-24, TDN
FD MAG/WASHER
10-3-24, JAM

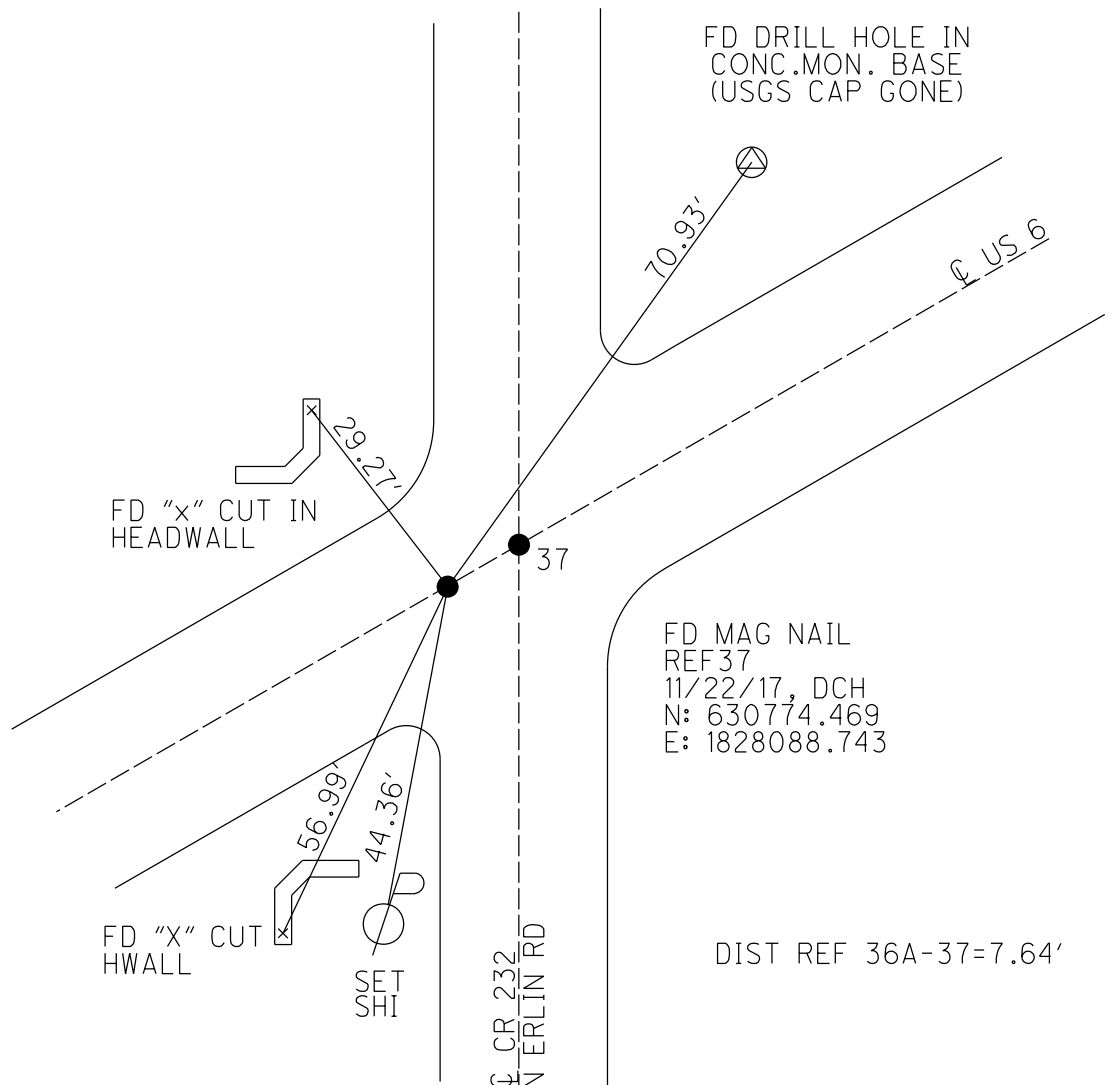

O.D.O.T. DISTRICT 2 SURVEY OFFICE (USE ONLY)

PERSONNEL

REFERENCE NO. 37

SHEET 19 OF 19

NOTES PRESTON-COLVIN

DATE 9-4-24

ROUTE US 6

H.C. NEISE

WEATHER SUNNY

COUNTY SANDUSKY

R.C. BARRIERE

TEMP. 65°

TOWNSHIP RILEY

SECTION 16

DWG BY PRESTON-COLVIN PID PAVING TRAIN

T 5 N R 16 E

TYPE MONUMENT MAG NAIL

ON SURFACE - BELOW ON

OFFSET $\mathcal{Q}$ PAVEMENT ON LT : RT

- TO - EDGE PAVEMENT

STATION: 1233+58

HORIZ.DATUM: NAD83 (2011)


GEOID: NAVD88 2018

GRID: NORTHING: 630774.469


EASTING: 1828088.743

LDP: NORTHING: 326957.7

EASTING: 188246.6

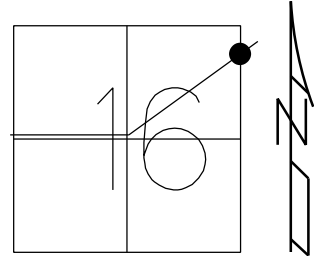

RECORD:
FD MAG NAIL
REF37
N: 630774.469
E: 1828088.743
11/22/17, DCH
FD MAG NAIL
7/26/21, TDN
2/10/22, JFO
FD MAG
REF37
9-4-24, TDN
FD MAG
10/3/24, JAM

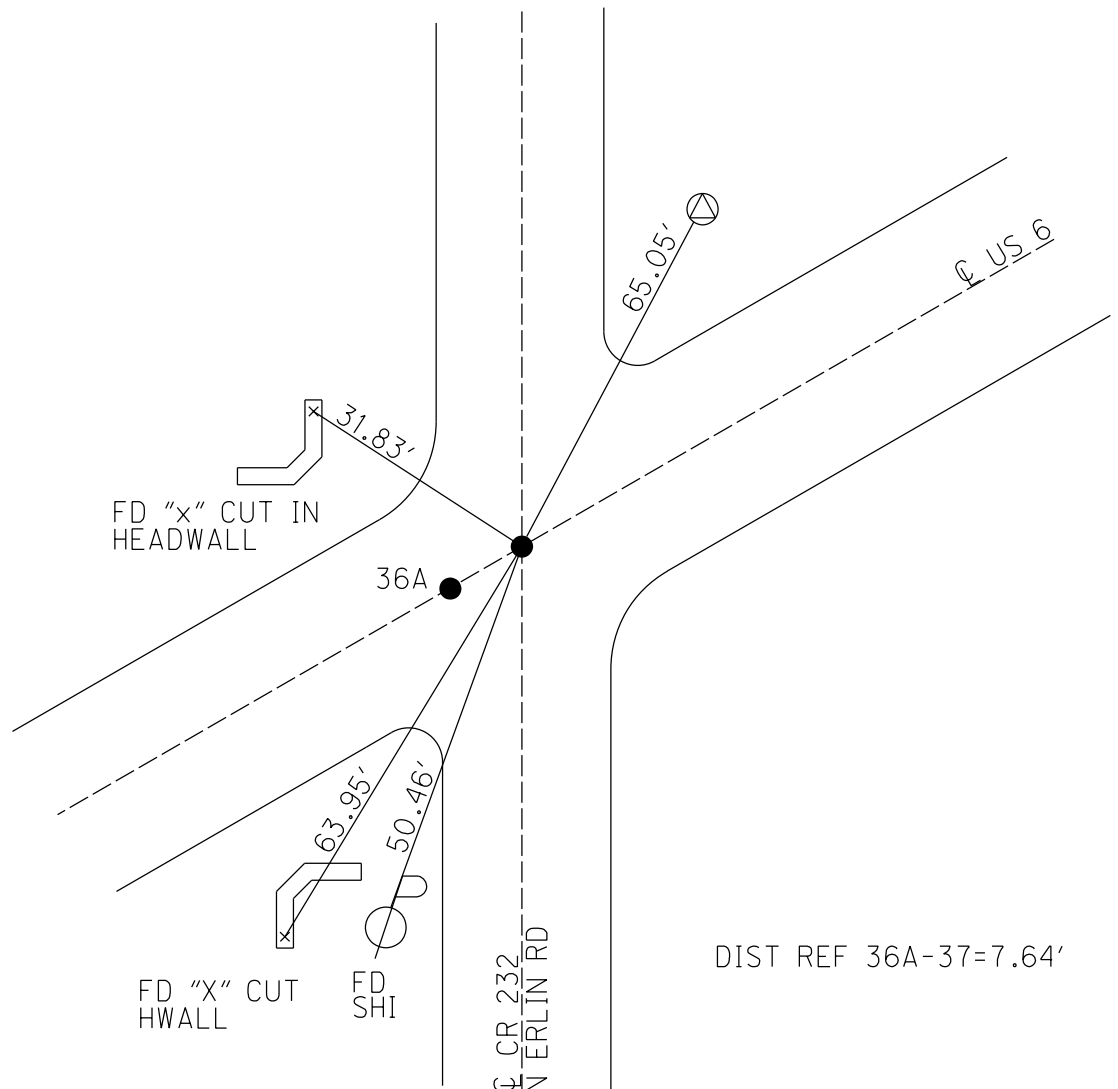

O.D.O.T. DISTRICT 2 SURVEY OFFICE (USE ONLY)

PERSONNEL

REFERENCE NO. 37 A

SHEET 1 OF 34

NOTES PRESTON-COLVIN

DATE 9-4-24

ROUTE US 6

H.C. NEISE

WEATHER SUNNY

COUNTY SANDUSKY

R.C. BARRIERE

TEMP. 65°

TOWNSHIP RILEY

SECTION 15

DWG BY PRESTON-COLVIN PID PAVING TRAIN

T 5 N R 16 E

TYPE MONUMENT MAG/WASHER

ON SURFACE - BELOW ON

OFFSET $\varnothing$ PAVEMENT 0.4' LT : RT

- TO - EDGE PAVEMENT

STATION: 1233+58

HORZ.DATUM: NAD83 (2011)


GEOID: NAVD88 2018

GRID: NORTHING: 630956.552


EASTING: 1828574.771

LDP: NORTHING: 327143.1

EASTING: 188731.5

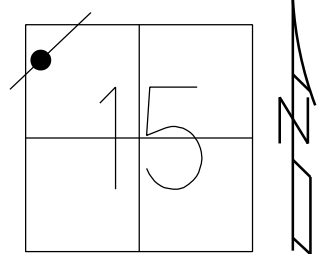

RECORD: P.I.
 OLD STA 5+26.5
 P.K./WASHER
 SMALL SPIKE
 FD P.K./WASHER
 3/16/02, DCH
 SET P.K./WASHER
 6/9/02, DCH
 FD P.K./WASHER
 REFB37
 11/22/17, DCH
 8/1/18, JLL
 SET MAG/WASHER
 7/31/19, JLL
 FD MAG/WASHER
 7/26/21, TDN
 SET MAG/WASHER
 1/28/22, TDN
 FD MAG/WASHER
 REF37A
 9-4-24, TDN
 FD MAG/WASHER
 10-3-24, JAM

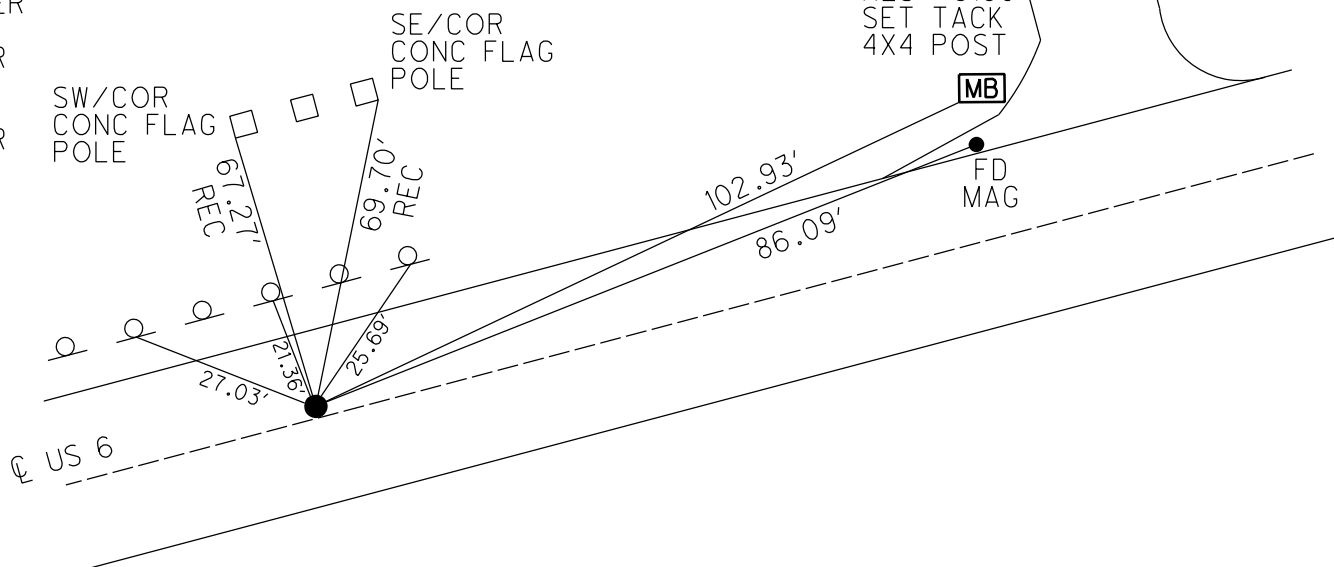

O.D.O.T. DISTRICT 2 SURVEY OFFICE (USE ONLY)

PERSONNEL

REFERENCE NO. 37 B

SHEET 2 OF 34

NOTES LEU

DATE 8/9/18

ROUTE US 6

H.C. LEU

WEATHER PTLY CLOUDY

COUNTY SANDUSKY

R.C. HAGEMeyer

TEMP. 84°

TOWNSHIP RILEY

SECTION 15

DWG BY AUBLE

PID 95769

T 5 N R 16 E

TYPE MONUMENT 1" IPIN

~~ON SURFACE~~ - BELOW 2"

OFFSET Q PAVEMENT 26.9' ~~LT~~ : RT

14.7' TO RT EDGE PAVEMENT


STATION: 1251+94

HORZ.DATUM: NAD83 (2011)


GEOID: 2012A

GRID: NORTHING: 631160.529

EASTING: 1829120.078

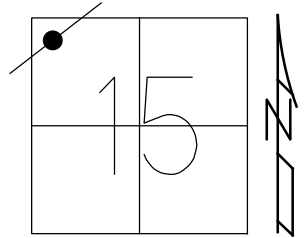

RECORD: P.I.
SET IPIN
PI OF SURVEY & CONST
STA 11+09.27
 $\Delta=12^{\circ}25'$ LT
 $\Delta=12^{\circ}29'30''$ LT
MEAS 7/28/75
FD 1" IPIN
3/16/02, DCH
FD 1" IPIN
2" DOWN
REFC37
11/22/17, DCH

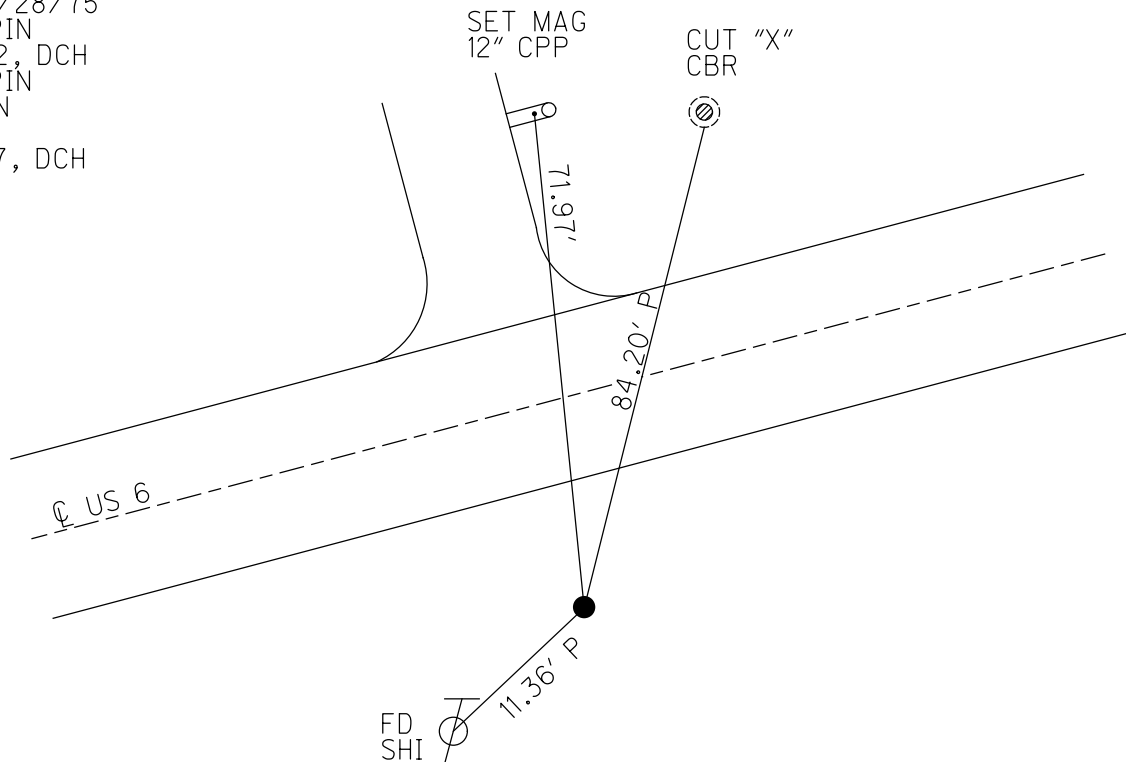

O.D.O.T. DISTRICT 2 SURVEY OFFICE (USE ONLY)

PERSONNEL

REFERENCE NO. 38

SHEET 3 OF 34

NOTES LEU
H.C. LEU
R.C. HAGEMeyer

DATE 8/9/18
WEATHER PTLY CLOUDY
TEMP. 83°

ROUTE US 6
COUNTY SANDUSKY
TOWNSHIP RILEY
SECTION 15
T 5 N R 16 E

DWG BY AUBLE PID 95769

TYPE MONUMENT 3/8" IPIN

~~ON SURFACE~~ - BELOW 2"

OFFSET Q PAVEMENT 33.2' LT : ~~RT~~
21.7' TO LT EDGE PAVEMENT


STATION: 1272+50

HORZ.DATUM: NAD83 (2011)


GEOID: 2012A


GRID: NORTHING: 632289.645


EASTING: 1830856.470

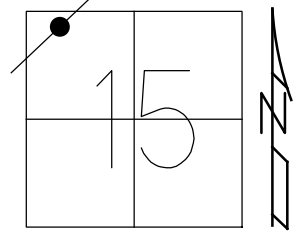

RECORD: P.I.
SET IPIN
SURVEY STA.31+67.80
CONST STA.31+75.47
FD 3/8" IPIN
3/16/02, DCH
FD 3/4" IPIN
2" DOWN
REF38
11/22/17, DCH

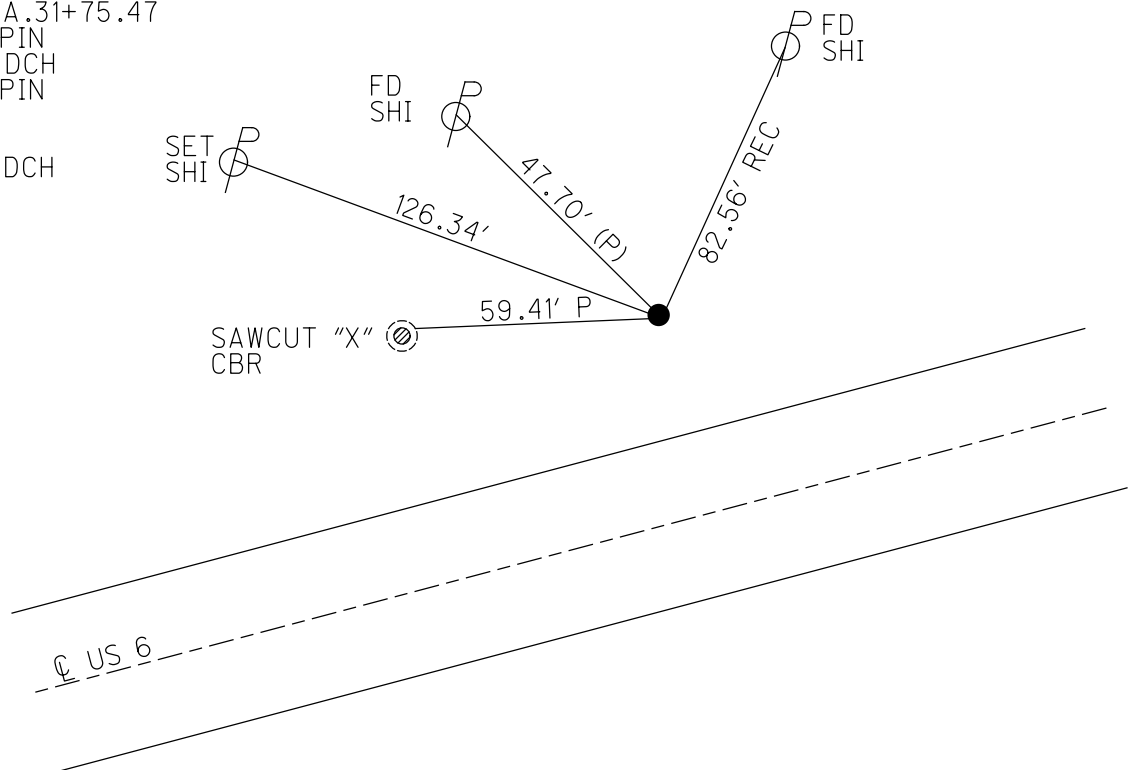


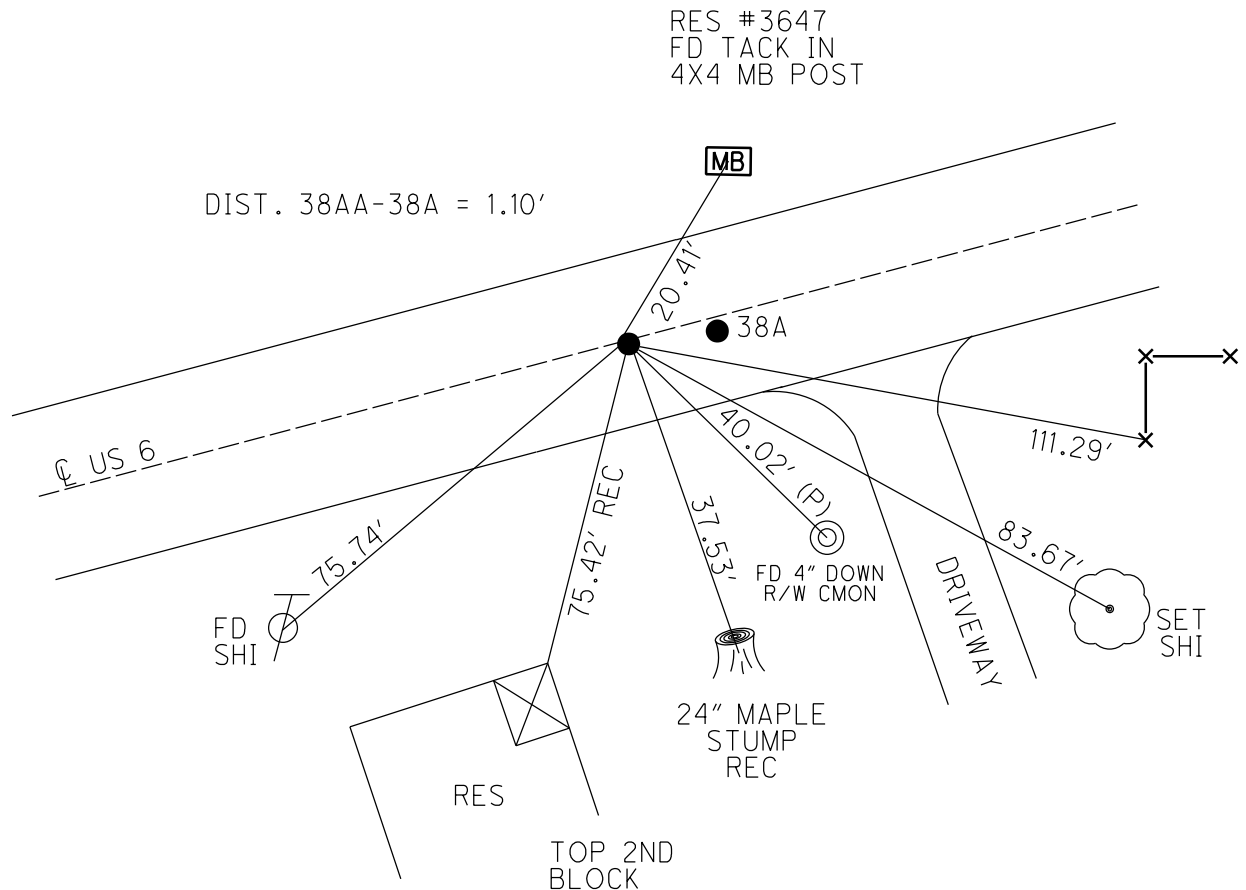

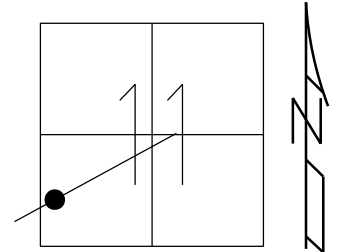
EASTING: 194151.6


O.D.O.T. DISTRICT 2 SURVEY OFFICE (USE ONLY)

PERSONNEL	REFERENCE NO. <u>39</u>	SHEET <u>6</u> OF <u>34</u>
NOTES <u>PRESTON-COLVIN</u>	DATE <u>9-4-24</u>	ROUTE <u>US 6</u>
H.C. <u>NEISE</u>	WEATHER <u>SUNNY</u>	COUNTY <u>SANDUSKY</u>
R.C. <u>BARRIERE</u>	TEMP. <u>68°</u>	TOWNSHIP <u>RILEY</u>
		SECTION <u>11</u>
DWG BY <u>PRESTON-COLVIN</u>	PID <u>PAVING TRAIN</u>	T <u>5</u> N R <u>16</u> E
TYPE MONUMENT <u>MAG/WASHER</u>		
ON SURFACE - BELOW <u>ON</u>		
OFFSET $\mathcal{Q}$ PAVEMENT <u>1.6'</u> $\perp$: RT		
<u>12.7'</u> TO <u>LT</u> EDGE PAVEMENT		
STATION: <u>1329+37</u>		
HORZ.DATUM: <u>NAD83 (2011)</u>		GEOID: <u>NAVD88 2018</u>
GRID: NORTHING: <u>634615.966</u>		EASTING: <u>1836069.682</u>
LDP: NORTHING: <u>330854.3</u>		EASTING: <u>196201.4</u>

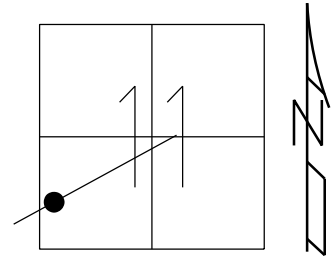

RECORD:
 STA. 88+87
 SM.SPIKE/WASHER
 FD P.K./WASHER
 3/16/02, DCH
 SET P.K./WASHER
 6/10/02, DCH
 FD SM.R.R.SPIKE
 4" DOWN
 REF39
 11/22/17, JLL
 SET MAG/WASHER
 8-2-19, JLL
 FD MAG/WASHER
 2/10/22, JFO
 1/20/23,
 12/28/23, JMR
 FD MEG/WASHER
 REF39
 9/4/24, TDN
 FD MEG/WASHER
 10/3/24, JAM

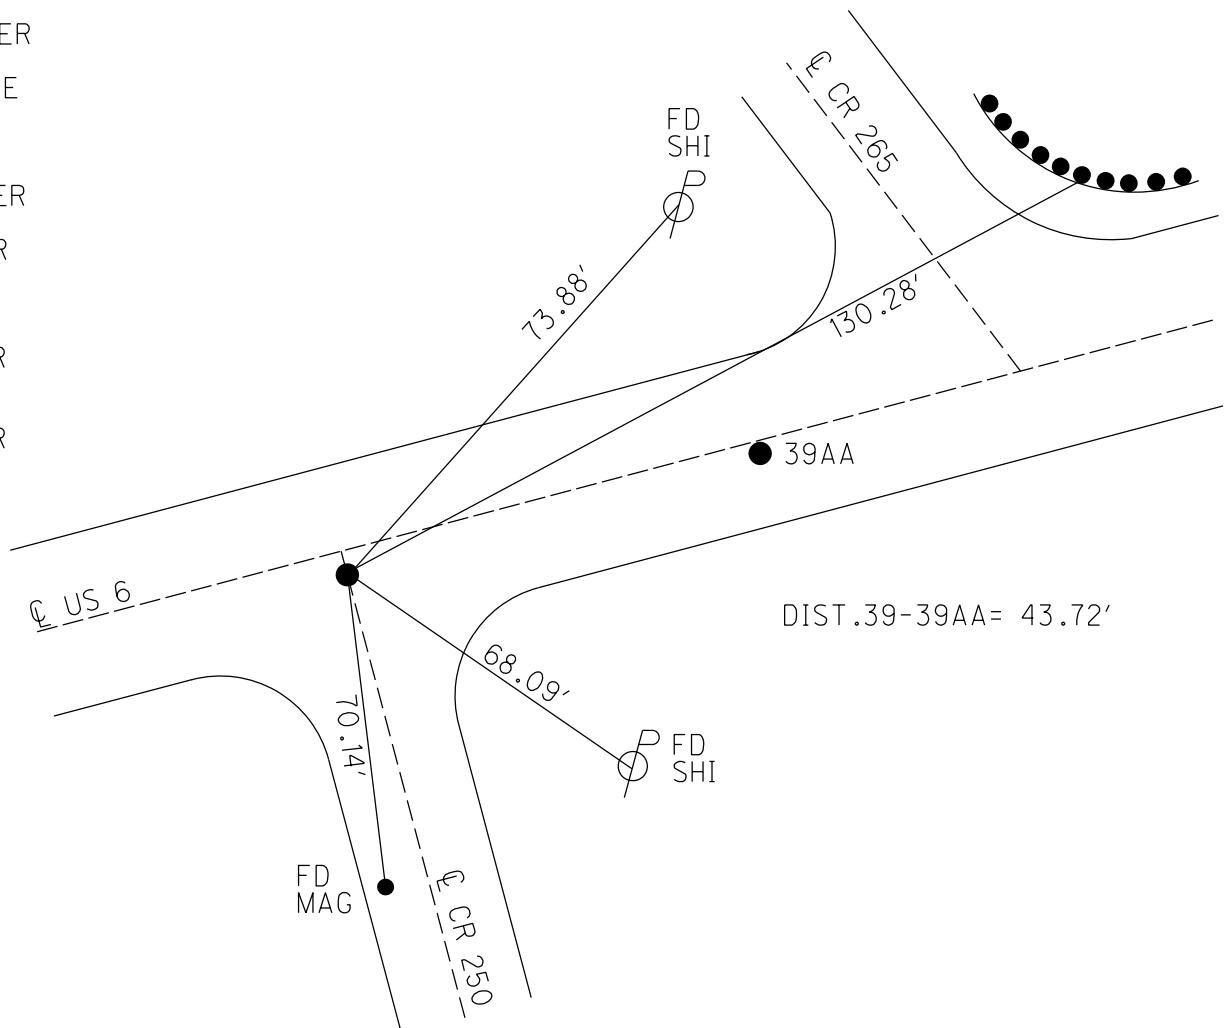

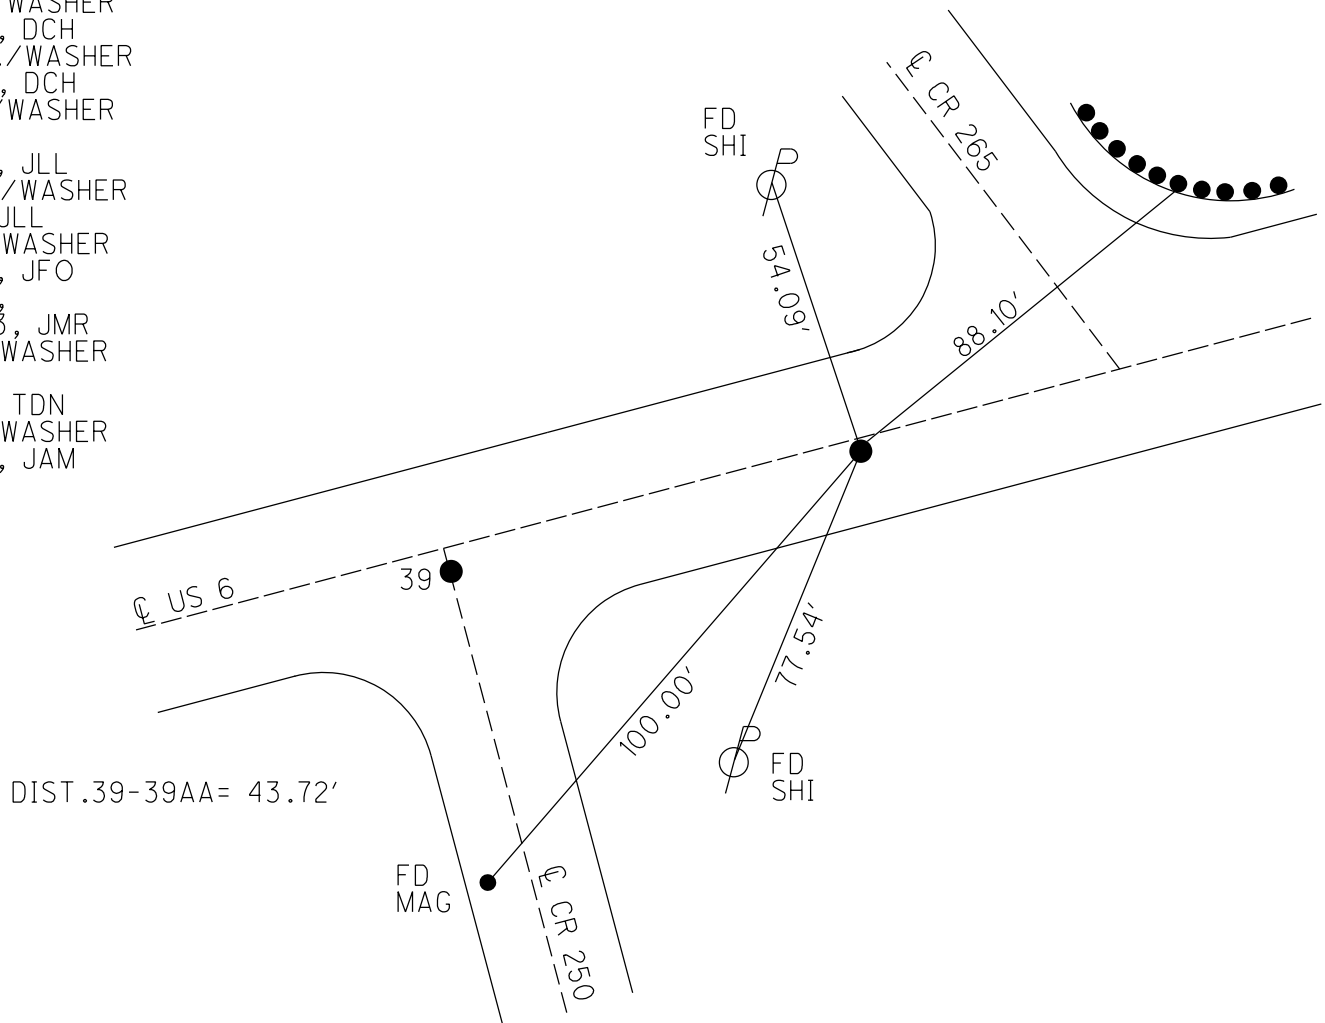

O.D.O.T. DISTRICT 2 SURVEY OFFICE (USE ONLY)

PERSONNEL

REFERENCE NO. 39 A

SHEET 8 OF 34

NOTES ROUSOS

DATE 3/16/02

ROUTE US 6

H.C. VAN DUSEN

WEATHER WINDY

COUNTY SANDUSKY

R.C. MOSSER

TEMP. 28°

TOWNSHIP RILEY

HOMAN

SECTION 11

DWG BY AUBLE

PID 95769

T 5 N R 16 E

TYPE MONUMENT 1" IPIN

ON SURFACE - BELOW -

OFFSET Q PAVEMENT - RT : RT

35' LT TO LT EDGE PAVEMENT


STATION: 1337+24

HORIZ.DATUM: NAD83 (2011)


GEOID: 2012A

GRID: NORTHING: 634939.065

EASTING: 1836799.243

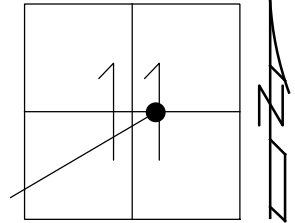

RECORD: P.I.
CONST.
OLD STA 1338+85.97
FD 1" IPIN
3/16/02, DCH
FD 1" IPIN
2" DOWN
REFB39
11/22/17, DCH

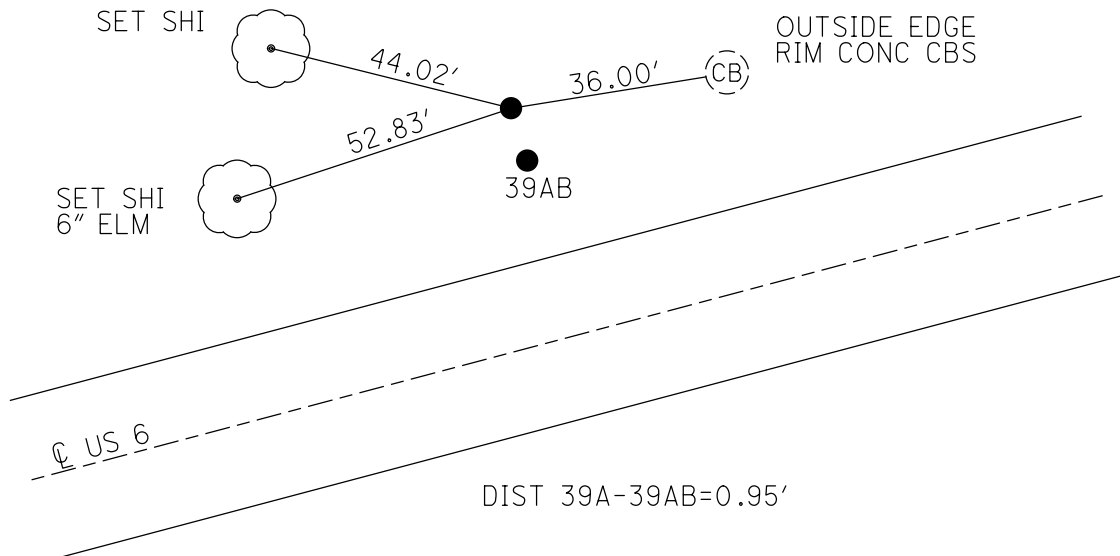

O.D.O.T. DISTRICT 2 SURVEY OFFICE (USE ONLY)

PERSONNEL

REFERENCE NO. 39 AB

SHEET 9 OF 34

NOTES ROUSOS

DATE 3/16/02

ROUTE US 6

H.C. VAN DUSEN

WEATHER WINDY

COUNTY SANDUSKY

R.C. MOSSER

TEMP. 28°

TOWNSHIP RILEY

HOMAN

SECTION 11

DWG BY AUBLE

PID 95769

T 5 N R 16 E

TYPE MONUMENT 1" IPIPE

~~ON SURFACE~~ - BELOW 2"

OFFSET ℄ PAVEMENT - LT : RT

35' LT TO LT EDGE PAVEMENT


STATION: 1337+24

HORZ. DATUM: NAD83 (2011)


GEOID: 2012A

GRID: NORTHING: 634938.195

EASTING: 1836799.280

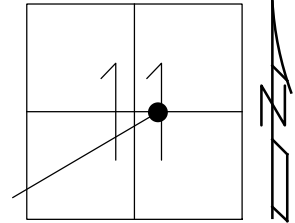

RECORD: P.I.
SURVEY & R/W
OLD STA 1338+85.77
FD 1" IPIN
3/16/02, DCH
FD 1" IPIN
2" DOWN
REFC39
11/22/17, DCH

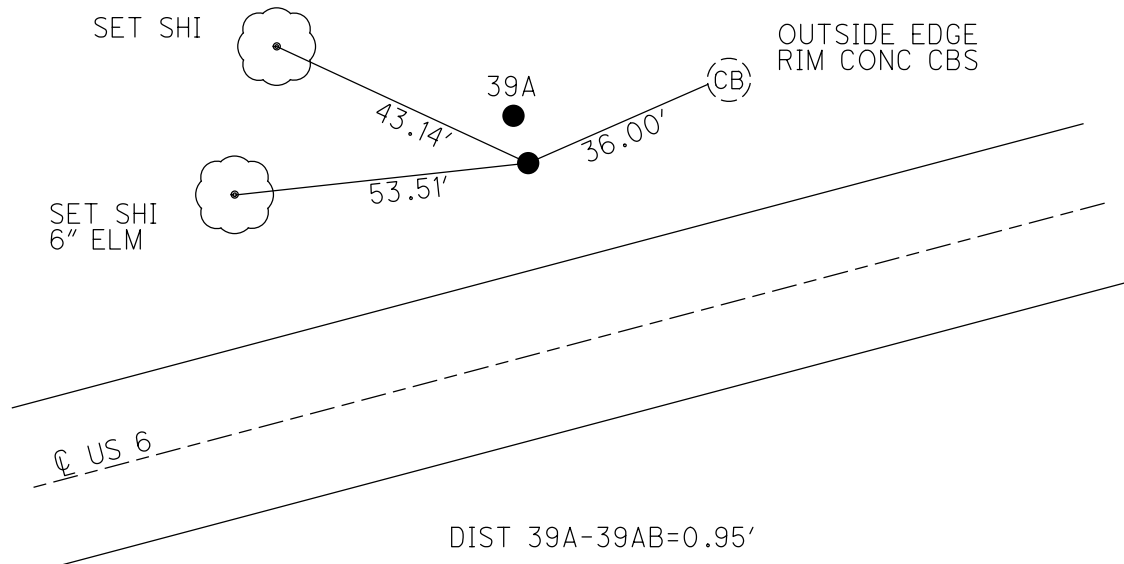

O.D.O.T. DISTRICT 2 SURVEY OFFICE (USE ONLY)

PERSONNEL

REFERENCE NO. 39 B

SHEET 10 OF 34

NOTES PRESTON-COLVIN

DATE 9-4-24

ROUTE US 6

H.C. NEISE

WEATHER SUNNY

COUNTY SANDUSKY

R.C. BARRIERE

TEMP. 70°

TOWNSHIP RILEY

SECTION 11

DWG BY PRESTON-COLVIN PID PAVING TRAIN

T 5 N R 16 E

TYPE MONUMENT P.K./WASHER

ON SURFACE - BELOW ON

OFFSET Q PAVEMENT ON LF : RT

12 TO RT EDGE PAVEMENT

STATION: 1341+85

HORIZ.DATUM: NAD83 (2011)


GEOID: NAVD88 2018

GRID: NORTHING: 634945.112


EASTING: 1837266.029

LDP: NORTHING: _____

EASTING: _____

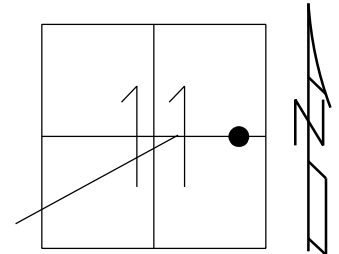

RECORD: P.T.
STA.1343+40.32
PREVIOUS MONUMENTS:
P.K./WASHER
SM.SPIKE/WASHER
FD P.K./WASHER
3/16/02, DCH
SET P.K./WASHER
6/10/02, DCH
FD P.K./WASHER
REFD39
11/22/17, DCH
SET MAG/WASHER
8-2-19, JLL
FD MAG/WASHER
2/10/22, JFO
1/20/23, JMR
DID NOT FIND
TIES DO NOT CROSS
DIG WHEN NEEDED
9-4-24, TDN

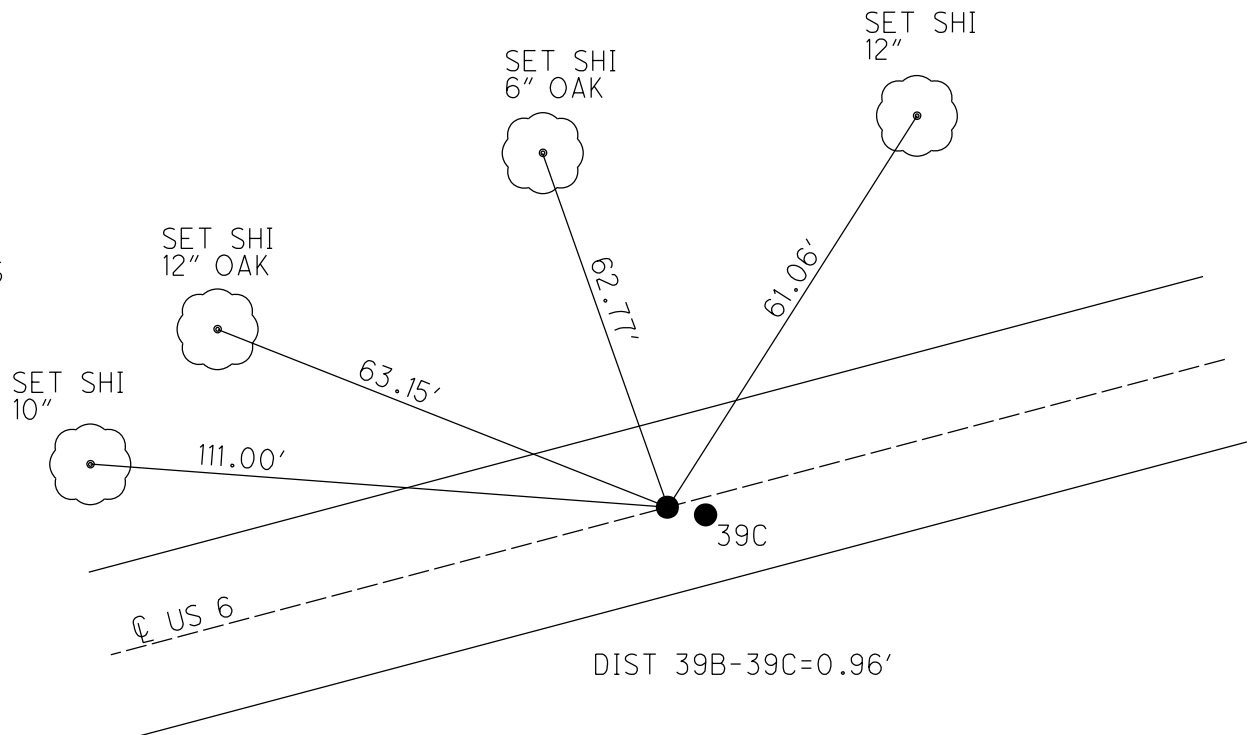

O.D.O.T. DISTRICT 2 SURVEY OFFICE (USE ONLY)

PERSONNEL

REFERENCE NO. 39 C

SHEET 11 OF 34

NOTES PRESTON-COLVIN

DATE 9-4-24

ROUTE US 6

H.C. NEISE

WEATHER SUNNY

COUNTY SANDUSKY

R.C. BARRIERE

TEMP. 70°

TOWNSHIP RILEY

SECTION 11

DWG BY PRESTON-COLVIN PID PAVING TRAIN

T 5 N R 16 E

TYPE MONUMENT P.K./WASHER

ON SURFACE - BELOW ON

OFFSET Q PAVEMENT 1.0' ET : RT

11' TO RT EDGE PAVEMENT

STATION: 1341+85

HORZ.DATUM: NAD83 (2011)


GEOID: NAVD88 2018

GRID: NORTHING: 634944.170


EASTING: 1837266.138

LDP: NORTHING: _____

EASTING: _____

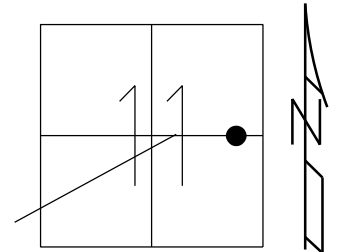

RECORD: P.T.
STA.1343+40.32
PREVIOUS MONUMENTS:
P.K./WASHER
SM.SPIKE/WASHER
FD P.K./WASHER
3/16/02, DCH
SET P.K./WASHER
6/10/02, DCH
FD P.K./WASHER
REFD39
11/22/17, DCH
SET MAG/WASHER
8-2-19, JLL
FD MAG/WASHER
2/10/22, JFO
1/20/23, JMR
DID NOT FIND
TIES DO NOT CROSS
DIG WHEN NEEDED
9-4-24, TDN

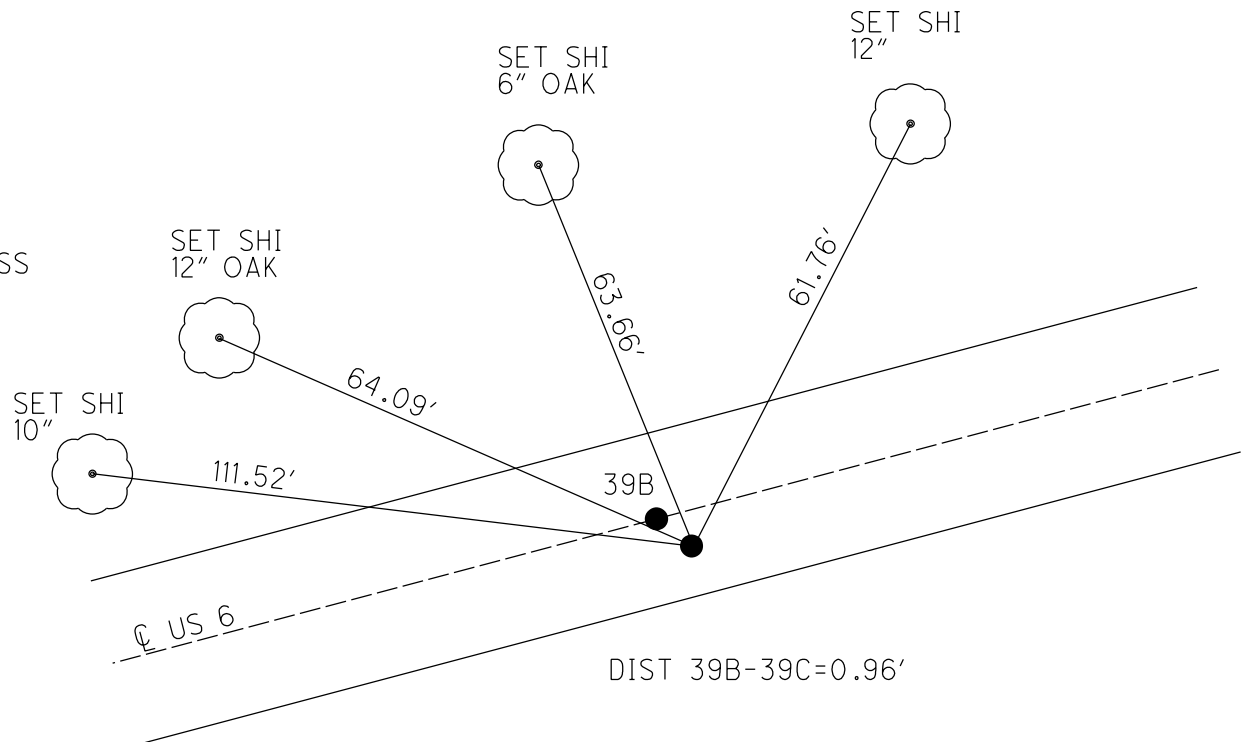

O.D.O.T. DISTRICT 2 SURVEY OFFICE (USE ONLY)

PERSONNEL

REFERENCE NO. 40

SHEET 12 OF 34

NOTES PRESTON-COLVIN

DATE 9-4-24

ROUTE US 6

H.C. NEISE

WEATHER SUNNY

COUNTY SANDUSKY

R.C. BARRIERE

TEMP. 78°

TOWNSHIP RILEY

SECTION 11

DWG BY PRESTON-COLVIN PID PAVING TRAIN

T 5 N R 16 E

TYPE MONUMENT P.K./WASHER

ON SURFACE - BELOW ON

OFFSET $\odot$ PAVEMENT 1.5' ~~LT~~ : RT

- TO - EDGE PAVEMENT

STATION: 1341+85

HORZ.DATUM: NAD83 (2011)


GEOID: NAVD88 2018

GRID: NORTHING: 634963.061


EASTING: 1838735.931

LDP: NORTHING: 331219.8

EASTING: 198865.4

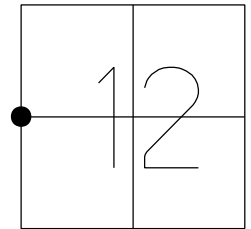

RECORD:
STA 115+96.5
PREVIOUS MONUMENTS:
P.K./WASHER
MINE SPIKE
FD P.K./WASHER
3/16/02, DCH
SET P.K./WASHER
6/10/02 DCH
FD P.K./WASHER
REF40
11/22/17, DCH
SET MAG/WASHER
8-2-19, JLL
FD MAG/WASHER
2/10/22, JFO
1/20/23, JMR
FD MAG/WASHER
REF40
9/4/24, TDN
FD MEG/WASHER
10/3/24, JAM

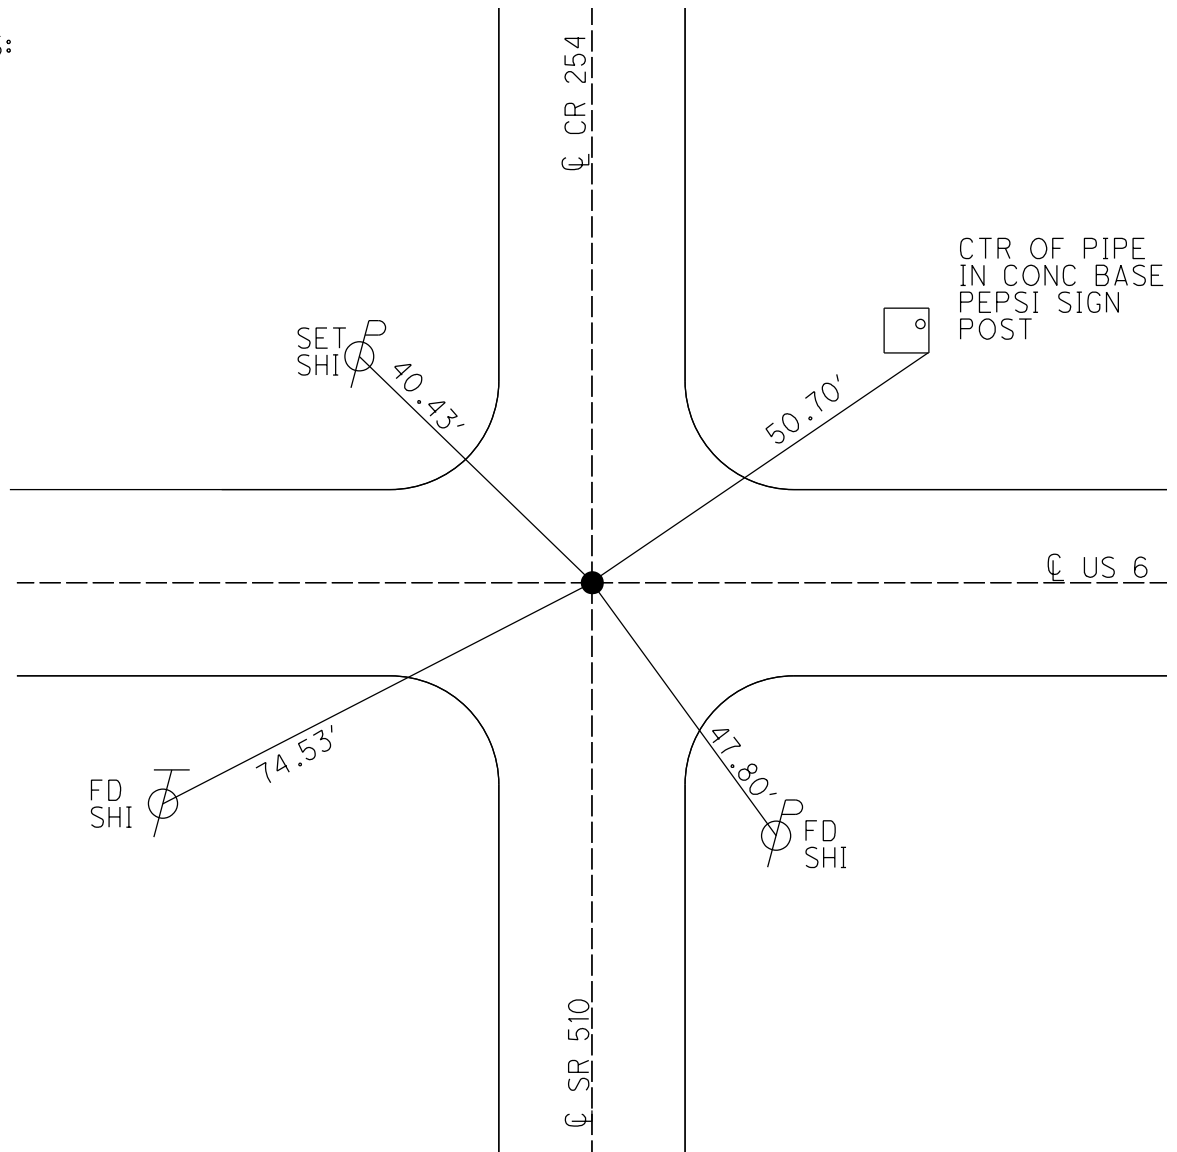

O.D.O.T. DISTRICT 2 SURVEY OFFICE (USE ONLY)

PERSONNEL

REFERENCE NO. 41

SHEET 13 OF 34

NOTES PRESTON-COLVIN

DATE 9-4-24

ROUTE US 6

H.C. NEISE

WEATHER SUNNY

COUNTY SANDUSKY

R.C. BARRIERE

TEMP. 78°

TOWNSHIP RILEY

SECTION 12

DWG BY PRESTON-COLVIN PID PAVING TRAIN

T 5 N R 16 E

TYPE MONUMENT MEG/WASHER

~~ON SURFACE~~ - BELOW 1.5"

OFFSET Q PAVEMENT 0.6' LT : RT

- TO - EDGE PAVEMENT

STATION: 1383+29

HORIZ.DATUM: NAD83 (2011)


GEOID: NAVD88 2018

GRID: NORTHING: 635077.737


EASTING: 1841414.113

LDP: NORTHING: 331352.9

EASTING: 201543

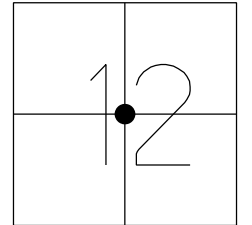

RECORD: P.I.
STA.1421+75.98
PREVIOUS MONUMENTS:
P.K./WASHER
R.R.SPIKE
FD P.K./WASHER
3/16/02, DCH
SET P.K./WASHER
6/10/02, DCH
FD P.K./WASHER
REF41
11/22/17, DCH
SET MAG/WASHER
8-2-19, JLL
FD MAG/WASHER
2/10/22, JFO
1/20/23, JMR
FD MEG/WASHER
REF41
9-4-24, TDN
REMOVED &
SET NEW
MEG/WASHER
1" DOWN
FD MEG/WASHER
10/3/24, JAM
1" DOWN

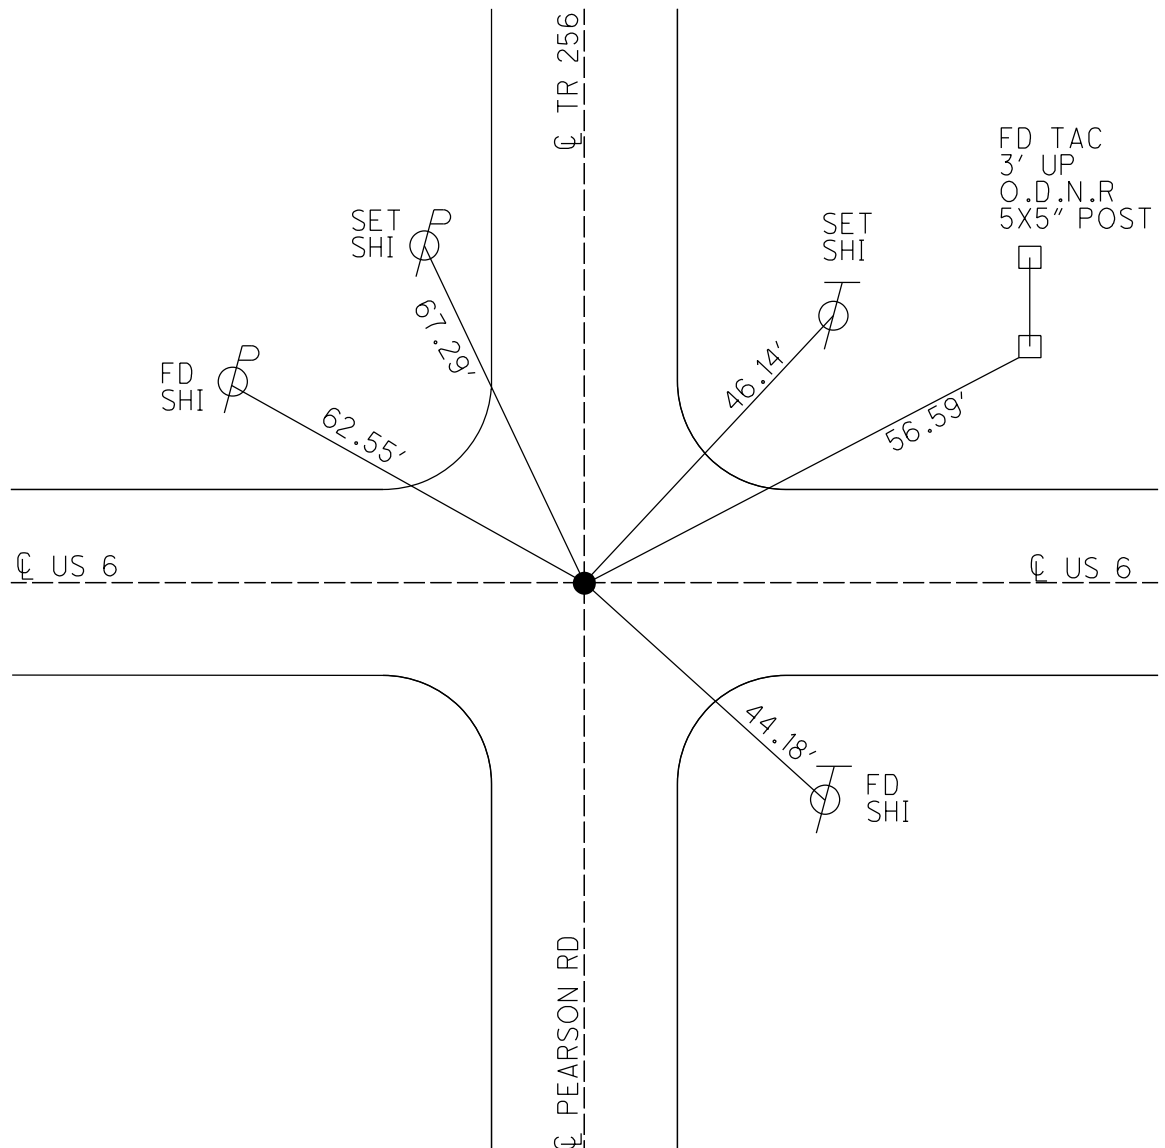

O.D.O.T. DISTRICT 2 SURVEY OFFICE (USE ONLY)

PERSONNEL

REFERENCE NO. 41 A

SHEET 14 OF 34

NOTES PRESTON-COLVIN

DATE 9-4-24

ROUTE US 6

H.C. NEISE

WEATHER SUNNY

COUNTY SANDUSKY

R.C. BARRIERE

TEMP. 75°

TOWNSHIP TOWNSEND

DWG BY PRESTON-COLVIN PID PAVING TRAIN

T 5 N R 16 E

TYPE MONUMENT MEG/WASHER

ON SURFACE - ~~BELOW~~ ON

OFFSET CL PAVEMENT 1.0' ~~LT~~ : RT

8' TO LT EDGE PAVEMENT

STATION: 1410+42

HORZ.DATUM: NAD83 (2011)


GEOID: NAVD88 2018

GRID: NORTHING: 635165.604


EASTING: 1844086.175

LDP: NORTHING: 331459.2

EASTING: 204214.6

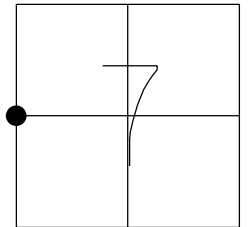

RECORD:
FD P.K./WASHER
REFA42
11/22/18, DCH
SET MAG/WASHER
8-2-19, JLL
FD MAG/WASHER
2/10/22, JFO
1/20/23, JMR
FD MEG/WASHER
REF41A
9/4/24, TDN
FD MEG/WASHER
10/3/24, JAM

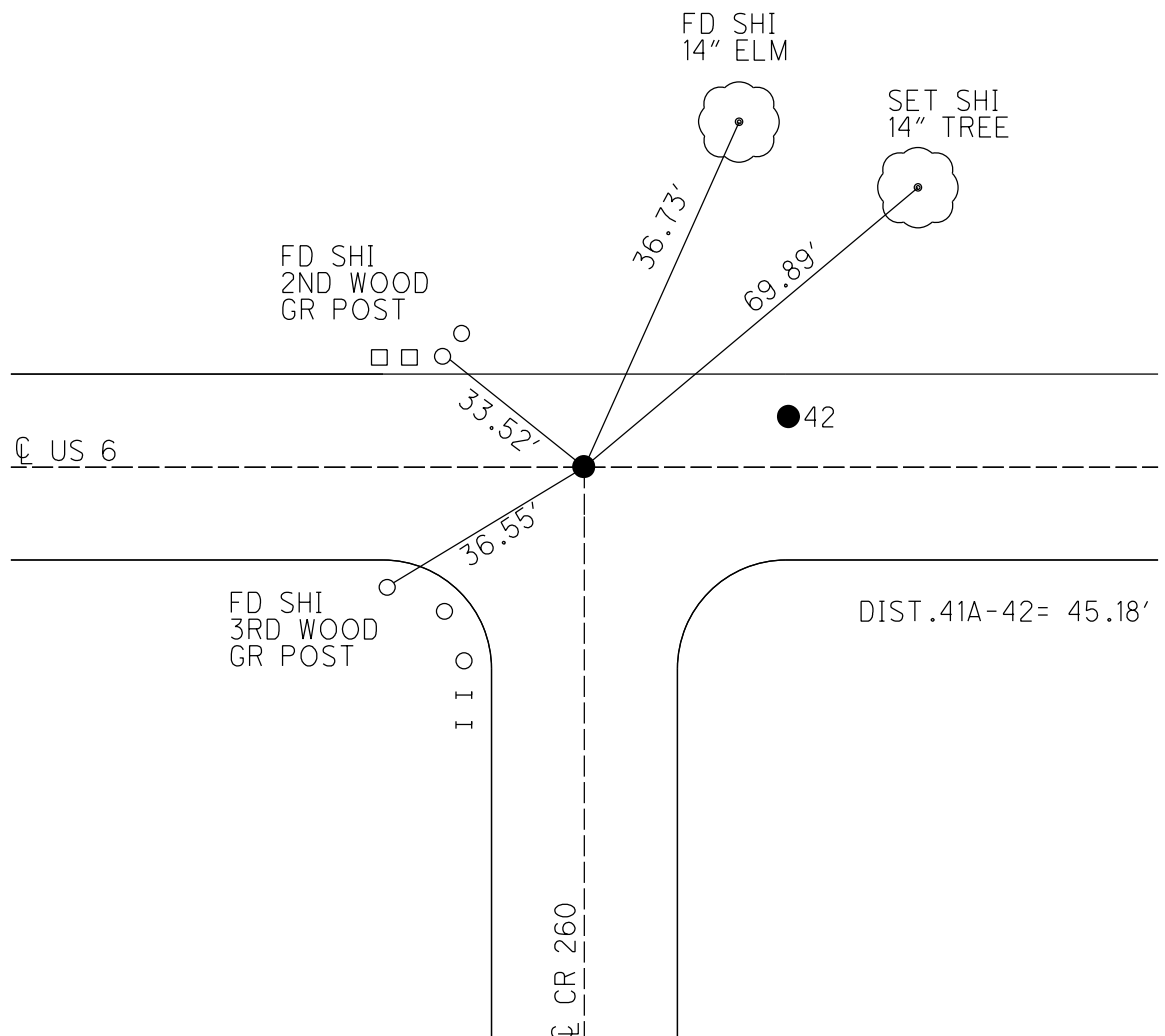

O.D.O.T. DISTRICT 2 SURVEY OFFICE (USE ONLY)

PERSONNEL

REFERENCE NO. 42

SHEET 15 OF 34

NOTES PRESTON-COLVIN

DATE 9-4-24

ROUTE US 6

H.C. NEISE

WEATHER SUNNY

COUNTY SANDUSKY

R.C. BARRIERE

TEMP. 62°

TOWNSHIP TOWNSEND

SECTION 7

DWG BY PRESTON-COLVIN PID PAVING TRAIN

T 5 N R 16 E

TYPE MONUMENT MEG/WASHER

ON SURFACE - ~~BELOW~~ ON

OFFSET Q PAVEMENT 2.8' ~~LT~~ : RT

- TO - EDGE PAVEMENT

STATION: 1410+42

HORIZ.DATUM: NAD83 (2011)


GEOID: NAVD88 2018

GRID: NORTHING: 635169.141


EASTING: 1844131.190

LDP: NORTHING: 331463.1

EASTING: 204259.6

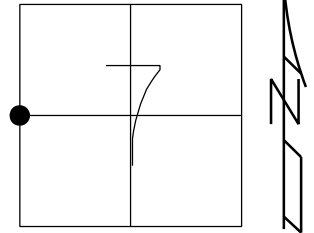

RECORD: P.I.
STA. 170+01
P.K./WASHER
BOAT SPIKE
FD P.K./WASHER
3/16/02, DCH
SET P.K./WASHER
6/10/02, DCH
FD P.K./WASHER
REFA42
11/22/18, DCH
SET MAG/WASHER
8-2-19, JLL
FD MAG/WASHER
2/10/22, JFO
1/20/23,
12/28/23, JMR
FD MAG/WASHER
10/3/24, JAM

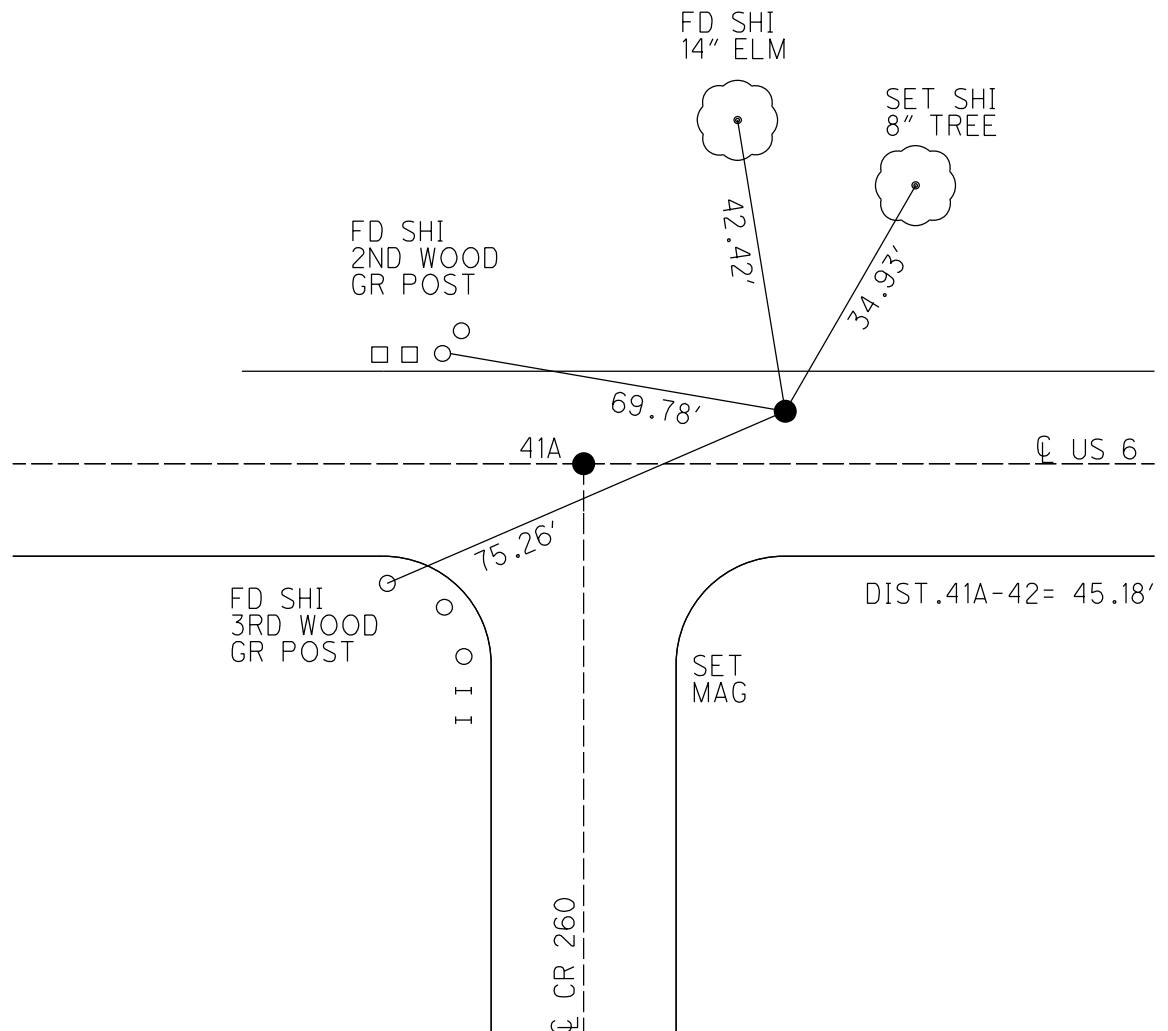

O.D.O.T. DISTRICT 2 SURVEY OFFICE (USE ONLY)

PERSONNEL

REFERENCE NO. 43

SHEET 16 OF 34

NOTES PRESTON-COLVIN

DATE 9-5-24

ROUTE US 6

H.C. NEISE

WEATHER SUNNY

COUNTY SANDUSKY

R.C. BARRIERE

TEMP. 62°

TOWNSHIP TOWNSEND

SECTION 7

DWG BY PRESTON-COLVIN PID PAVING TRAIN

T 5 N R 17 E

TYPE MONUMENT MEG/WASHER

ON SURFACE - ~~BELOW~~ ON

OFFSET CL PAVEMENT 0.3' ~~LT~~ : RT

11' TO RT EDGE PAVEMENT

STATION: 1436+56

HORIZ.DATUM: NAD83 (2011)


GEOID: NAVD88 2018

GRID: NORTHING: 635017.654


EASTING: 1846742.729

LDP: NORTHING: 331329.5

EASTING: 206872.3

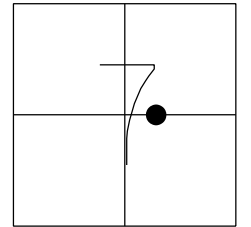

RECORD: P.I.
Δ= 00° 20' LT (PLAN)
STA 196+14.60
FD BOAT SPIKE
2" DOWN
FD P.K./WASHER
1.25" DOWN
FD P.K.WASHER
3/16/02, DCH
SET P.K./WASHER
6/11/02, DCH
FD P.K.SHANK
REF43
11/23/17, DCH
SET MAG/WASHER
7-31-19, JLL
FD MAG/WASHER
2/10/22, JFO
1/20/23, JMR
FD MAG/WASHER
REF43
9/5/24, TDN
FD MAG/WASHER
10/3/24, JAM

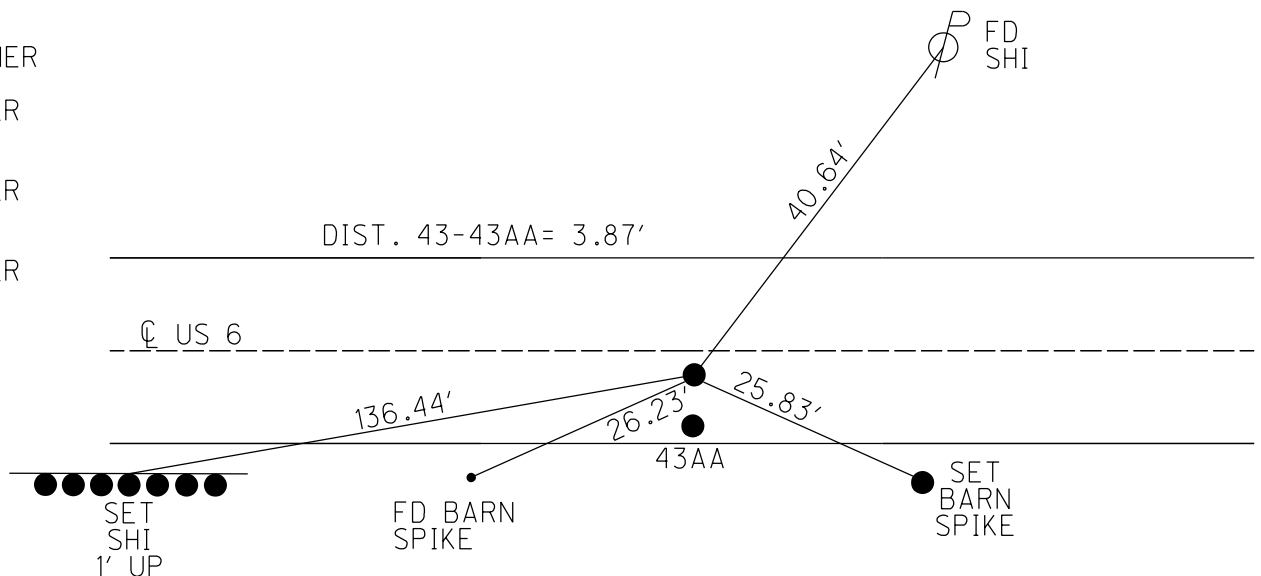

O.D.O.T. DISTRICT 2 SURVEY OFFICE (USE ONLY)

PERSONNEL

REFERENCE NO. 43 AA

SHEET 17 OF 34

NOTES PRESTON-COLVIN

DATE 9-5-24

ROUTE US 6

H.C. NEISE

WEATHER SUNNY

COUNTY SANDUSKY

R.C. BARRIERE

TEMP. 62°

TOWNSHIP TOWNSEND

DWG BY PRESTON-COLVIN

PID PAVING TRAIN

SECTION 7

T 5 N R 17 E

TYPE MONUMENT MEG/WASHER

ON SURFACE - ~~BELOW~~ ON

OFFSET CL PAVEMENT 5.0' ~~LT~~ : RT

7.7' TO RT EDGE PAVEMENT

STATION: 1436+56

HORZ.DATUM: NAD83 (2011)


GEOID: NAVD88 2018

GRID: NORTHING: 635013.778

EASTING: 1846742.462

LDP: NORTHING: 331325.6

EASTING: 206872

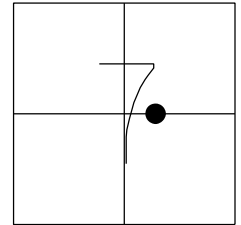

RECORD:

FD P.K./WASHER

3" DOWN

PLAN: CORNER STONE 5.4' RT OF CL

BOOK#1: CORNER STONE 5.2' RT OF CL

SET P.K./WASHER

FD P.K./WASHER

3/16/02, DCH

SET P.K./WASHER

6/11/02, DCH

FD P.K./SHANK

REFA43

11/23/17, DCH

SET MAG/WASHER

7-31-19, JLL

FD MAG/WASHER

2/10/22, JFO

1/20/23, JMR


FD MAG/WASHER

REF 43AA

9/5/24, TDN

FD MAG/WASHER

10/3/24, JAM

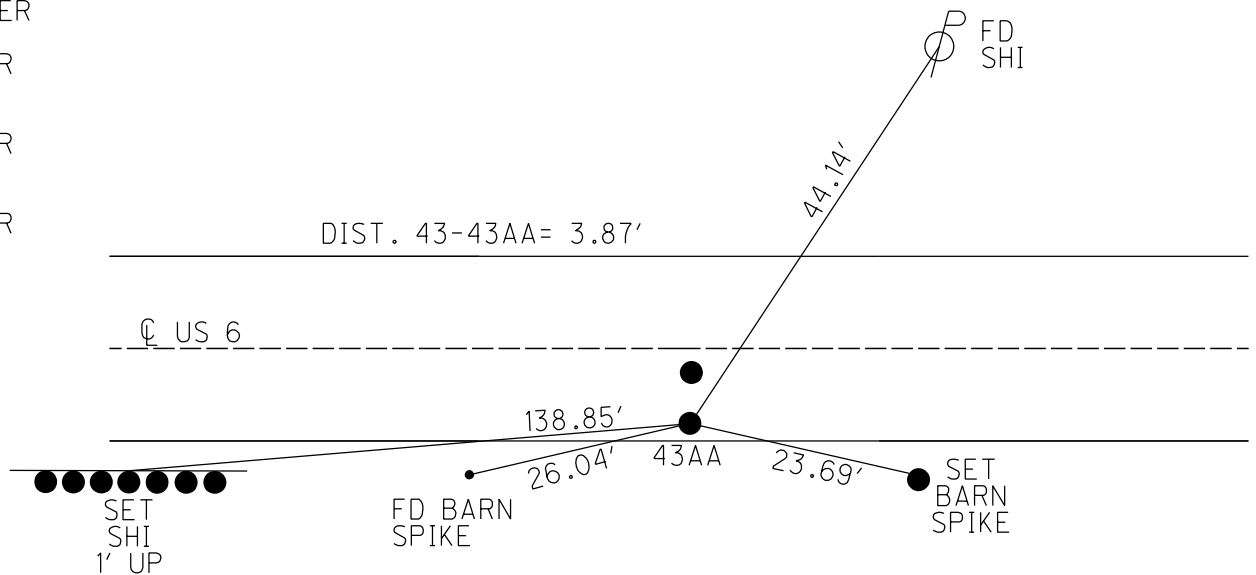

O.D.O.T. DISTRICT 2 SURVEY OFFICE (USE ONLY)

PERSONNEL

REFERENCE NO. 43 A

SHEET 18 OF 34

NOTES PRESTON-COLVIN

DATE 9-5-24

ROUTE US 6

H.C. NEISE

WEATHER SUNNY

COUNTY SANDUSKY

R.C. BARRIERE

TEMP. 62°

TOWNSHIP TOWNSEND

DWG BY PRESTON-COLVIN

PID PAVING TRAIN

SECTION 7

T 5 N R 17 E

TYPE MONUMENT MEG/WASHER

ON SURFACE - ~~BELOW~~ ON

OFFSET 0.8' ~~LT~~ : RT

12' TO LT EDGE PAVEMENT

STATION: 1448+44

HORIZ.DATUM: NAD83 (2011)


GEOID: NAVD88 2018

GRID: NORTHING: 634956.064


EASTING: 1847928.742

LDP: NORTHING: 331276.1

EASTING: 208058.8

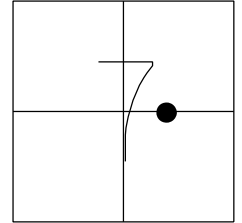

RECORD: P.I.
 $\Delta=00^{\circ} 45' RT$ (PLAN)
 STA. 208+01.90
 PREVIOUS MONUMENTS:
 P.K./WASHER
 BOAT SPIKE
 FD P.K./WASHER
 3/16/02, DCH
 SET P.K./WASHER
 6/11/02, DCH
 FD P.K./WASHER
 REFB43
 11/23/17, DCH
 SET MAG/WASHER
 7/31/19, JLL
 FD MAG/WASHER
 2/10/22, JFO
 1/20/23, JMR
 FD MAG/WASHER
 REF 43A
 9/5/24, TDN
 FD MAG/WASHER
 10/3/24, JAM

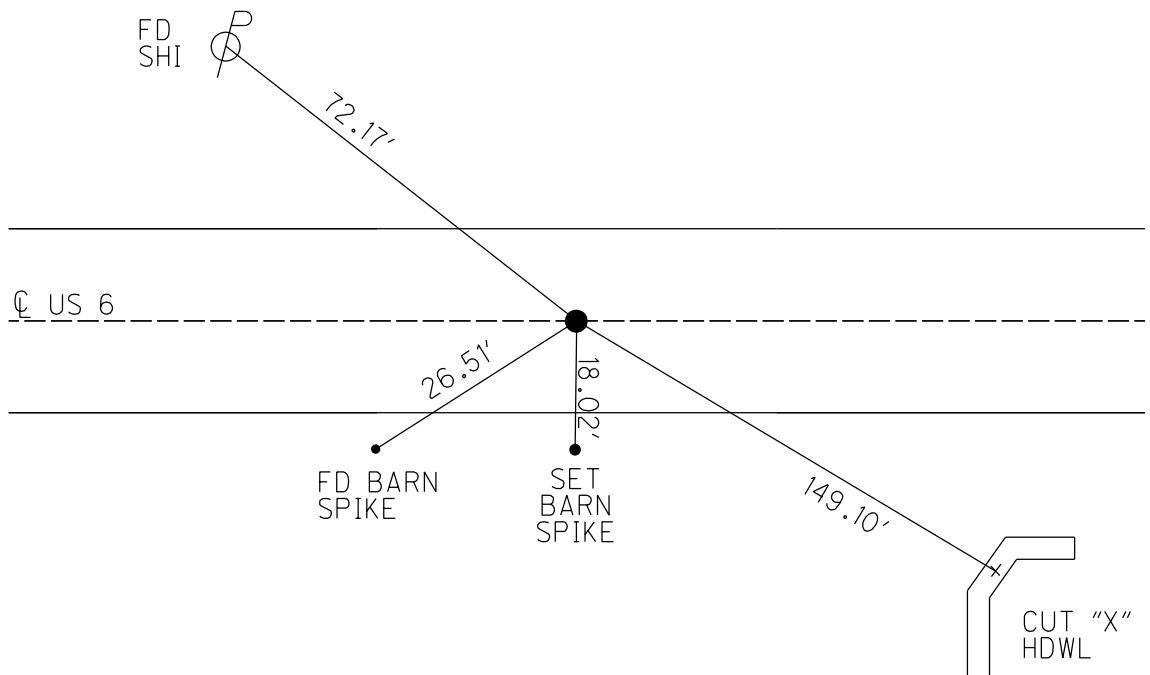

O.D.O.T. DISTRICT 2 SURVEY OFFICE (USE ONLY)

PERSONNEL

REFERENCE NO. 44

SHEET 19 OF 34

NOTES PRESTON-COLVIN

H.C. NEISE

R.C. BARRIERE

DATE 9-5-24

WEATHER SUNNY

TEMP. 62°

ROUTE US 6

COUNTY SANDUSKY

TOWNSHIP TOWNSEND

SECTION 8

T 5 N R 17 E

DWG BY PRESTON-COLVIN PID PAVING TRAIN

TYPE MONUMENT MEG/WASHER

ON SURFACE - ~~BELOW~~ ON

OFFSET C PAVEMENT 2.6' ~~LT~~ : RT

15.7' TO LT EDGE PAVEMENT

STATION: 1463+16

HORIZ.DATUM: NAD83 (2011)


GEOID: NAVD88 2018

GRID: NORTHING: 634860.616


EASTING: 1849397.758

LDP: NORTHING: 331190.8

EASTING: 209528.5

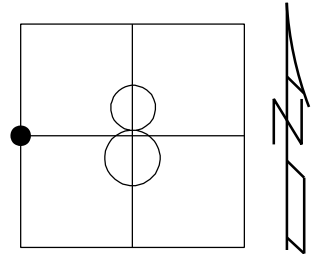

RECORD: P.I.
 $\Delta = 04^{\circ} 30'$ LT (PLAN)
 STA. 170+01
 PREVIOUS MONUMENTS:
 P.K./WASHER
 BOAT SPIKE
 P.K./WASHER
 3/16/02, DCH
 SET P.K./WASHER
 6/10/02, DCH
 FD P.K./WASHER
 SV1
 6/11/09, SAH
 9/14/12, SDC
 FD P.K./WASHER
 REF44
 11/23/17, DCH
 SET MAG/WASHER
 7-31-2019, JLL
 FD MAG/WASHER
 2/10/22, JFO
 1/20/23, JMR

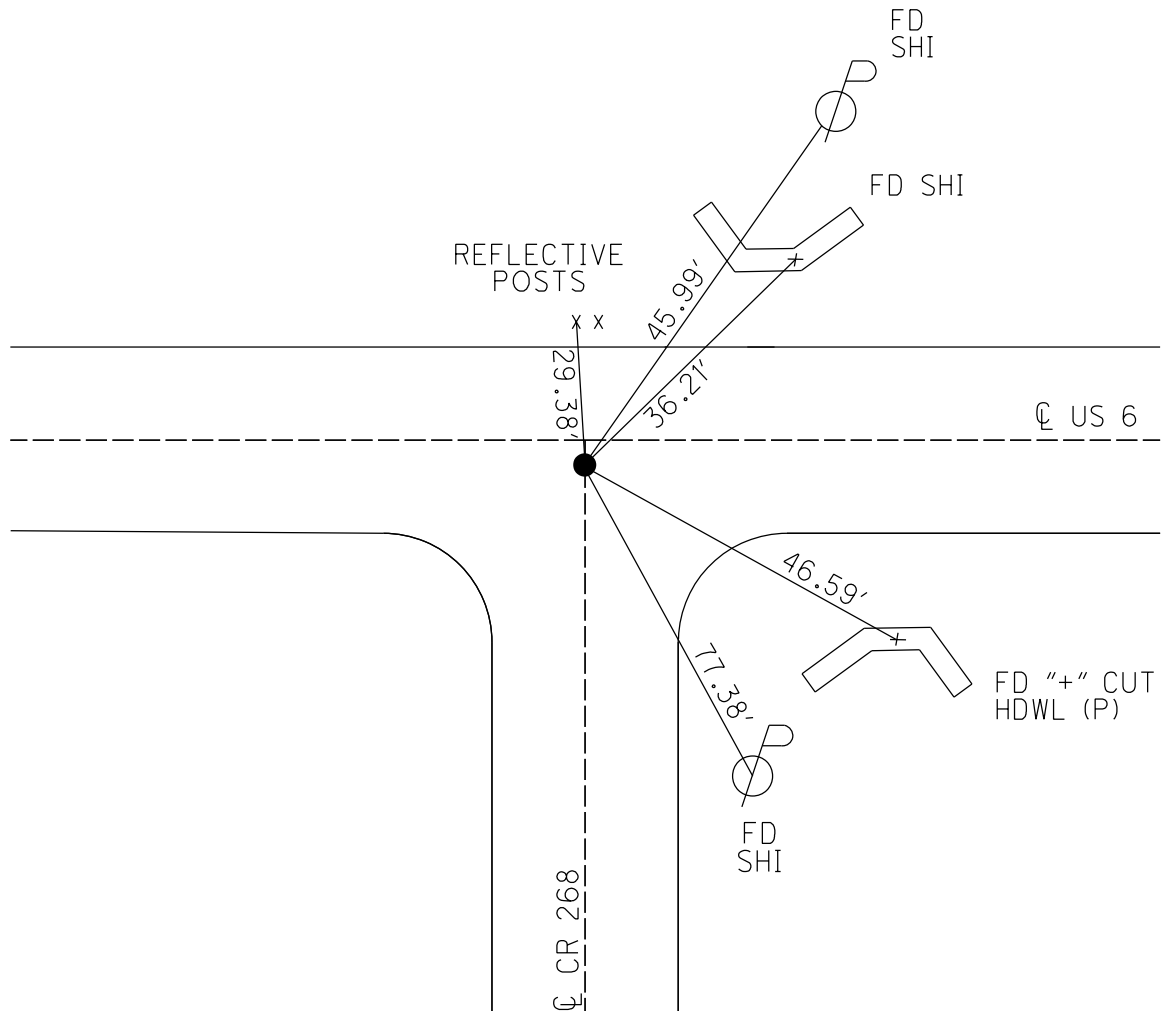


O.D.O.T. DISTRICT 2 SURVEY OFFICE (USE ONLY)


PERSONNEL	REFERENCE NO. <u>45</u>	SHEET <u>20</u> OF <u>34</u>
NOTES <u>PRESTON-COLVIN</u>	DATE <u>9-5-24</u>	ROUTE <u>US 6</u>
H.C. <u>NEISE</u>	WEATHER <u>SUNNY</u>	COUNTY <u>SANDUSKY</u>
R.C. <u>BARRIERE</u>	TEMP. <u>62°</u>	TOWNSHIP <u>TOWNSEND</u>
		SECTION <u>8</u>
DWG BY <u>PRESTON-COLVIN</u>	PID <u>PAVING TRAIN</u>	T <u>5</u> N R <u>17</u> E

TYPE MONUMENT MEG/WASHER
 ON SURFACE - ~~BELOW~~ ON
 OFFSET Q PAVEMENT 0.5' ~~LT~~ : RT
12' TO LT EDGE PAVEMENT
 STATION: 1475+94

HORZ.DATUM: <u>NAD83 (2011)</u>	GEOID: <u>NAVD88 2018</u>
GRID: NORTHING: <u>634877.385</u>	EASTING: <u>1850672.776</u>
LDP: NORTHING: <u>331216.4</u>	EASTING: <u>210803.4</u>

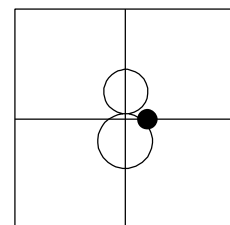

RECORD: P.I.
 $\Delta = 00^\circ 32''$ RT (PLAN)
 STA= 235+47
 PREVIOUS MONUMENTS:
 BOAT SPIKE
 FD P.K./WASHER
 3/16/02, DCH
 SET P.K./WASHER
 6/11/02, DCH
 FD P.K./WASHER
 SV2
 6/11/09, SAH
 9/14/12, SDC
 FD P.K./WASHER
 REF45
 11/23/17, DCH
 SET MAG/WASHER
 8-2-19, JLL
 FD MAG/WASHER
 2/10/22, JFO
 1/20/23, JMR
 FD MAG/WASHER
 REF 45
 9/5/24, TDN
 FD MAG/WASHER
 10/3/24, JAM

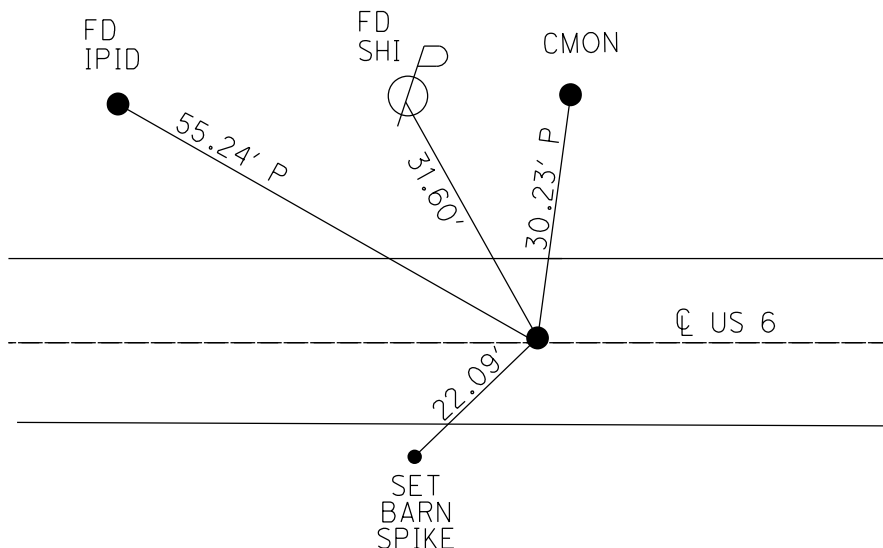

O.D.O.T. DISTRICT 2 SURVEY OFFICE (USE ONLY)

PERSONNEL

REFERENCE NO. 46

SHEET 21 OF 34

NOTES PRESTON-COLVIN

DATE 9-5-24

ROUTE US 6

H.C. NEISE

WEATHER SUNNY

COUNTY SANDUSKY

R.C. BARRIERE

TEMP. 73°

TOWNSHIP TOWNSEND

DWG BY PRESTON-COLVIN PID PAVING TRAIN

SECTION 8

T 5 N R 17 E

TYPE MONUMENT MEG/WASHER

ON SURFACE - ~~BELOW~~ ON

OFFSET $\varnothing$ PAVEMENT 15' ~~LT~~ : RT

3.5' TO RT EDGE PAVEMENT

STATION: 1513+04.16

HORZ.DATUM: NAD83 (2011)


GEOID: NAVD88 2018

GRID: NORTHING: 643892.475


EASTING: 185412.000

LDP: NORTHING: 331255.3

EASTING: 214259.7

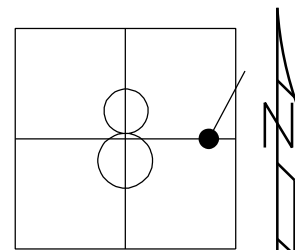

RECORD: P.I.
 $\Delta = 23^\circ 15''$ LT (PLAN)
 STA. 270+02.20
 FD IPIN
 4" DOWN
 1.8' S OF RT EP
 3/16/02, DCH
 SET P.K./WASHER
 6/11/02, DCH
 FD P.K./WASHER
 SV3
 6/11/09, SAH
 9/14/12, SDC
 FD P.K.NAIL
 REF 46
 11/23/17, DCH
 SET MAG/WASHER
 8-2-19, JLL
 FD MAG/WASHER
 2/10/22, JFO
 1/20/23, JMR
 FD MAG/WASHER
 REF 46
 9/5/24, TDN
 FD MAG/WASHER
 10/3/24, JAM

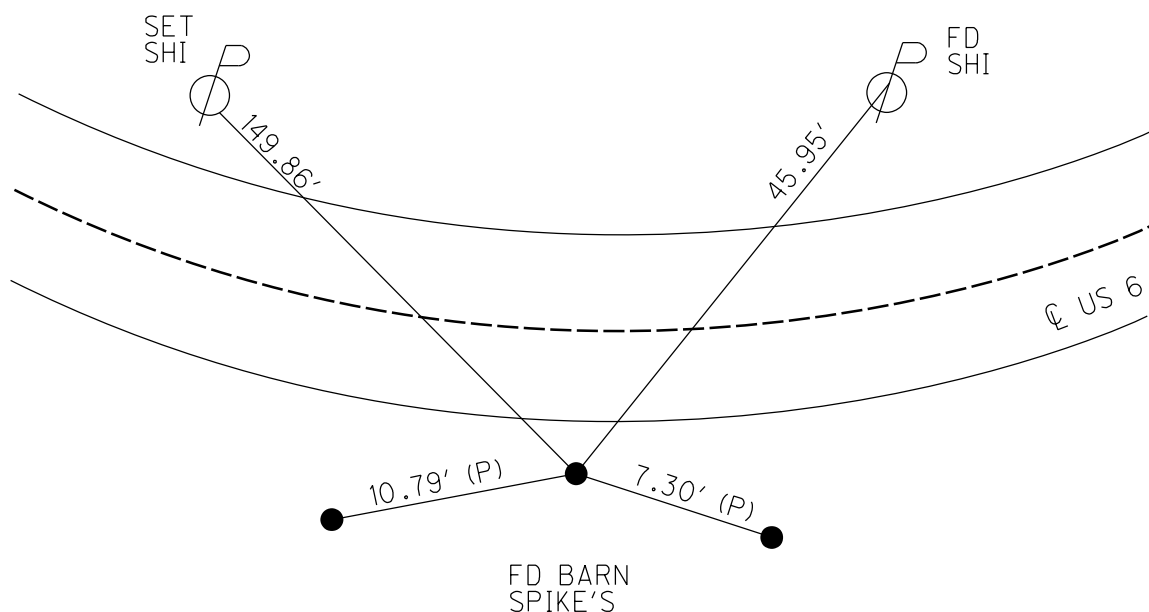

O.D.O.T. DISTRICT 2 SURVEY OFFICE (USE ONLY)

PERSONNEL	REFERENCE NO. <u>47</u>	SHEET <u>22</u> OF <u>34</u>
NOTES <u>PRESTON-COLVIN</u>	DATE <u>9-5-24</u>	ROUTE <u>US 6</u>
H.C. <u>NEISE</u>	WEATHER <u>SUNNY</u>	COUNTY <u>SANDUSKY</u>
R.C. <u>BARRIERE</u>	TEMP. <u>73°</u>	TOWNSHIP <u>TOWNSEND</u>
		SECTION <u>9</u>
		T <u>5</u> N R <u>17</u> E

DWG BY PRESTON-COLVIN PID PAVING TRAIN

TYPE MONUMENT MEG/WASHER

ON SURFACE - ~~BELOW~~ ON

OFFSET Q PAVEMENT 2.5' LT : RT

13' TO LT EDGE PAVEMENT

STATION: 1544+09

HORZ.DATUM: NAD83 (2011)


GEOID: NAVD88 2018

GRID: NORTHING: 636229.459


EASTING: 1857209.283

LDP: NORTHING: 332613.6

EASTING: 217330.9

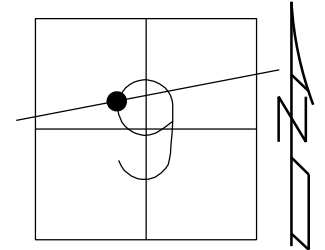

RECORD:
 R.R.SPIKE
 P.K./WASHER
 FD P.K./WASHER
 3/16/02, DCH
 SET MAG/WASHER
 9/26/02 DCH
 SET MAG NAIL
 REF 47
 8/6/18, DCH
 SET MAG/WASHER
 8-2-19, JLL
 FD MAG/WASHER
 2/10/22, JFO
 1/20/23,
 12/28/23, JMR
 FD MEG/WASHER
 REF 47
 9/5/24, TDN
 FD MEG/WASHER
 10/3/24, JAM

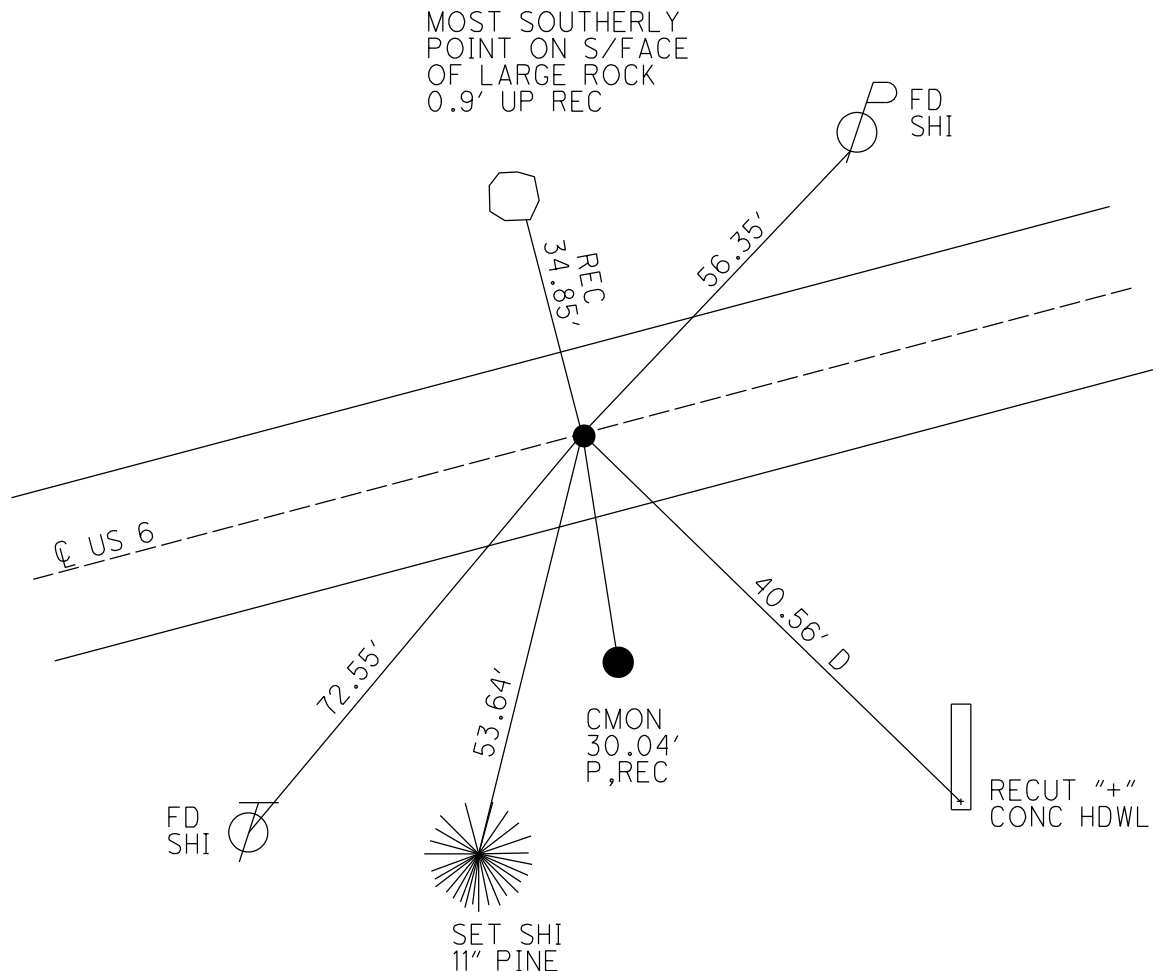

O.D.O.T. DISTRICT 2 SURVEY OFFICE (USE ONLY)

PERSONNEL

REFERENCE NO. 48

SHEET 23 OF 34

NOTES PRESTON-COLVIN

DATE 9-5-24

ROUTE US 6

H.C. NEISE

WEATHER SUNNY

COUNTY SANDUSKY

R.C. BARRIERE

TEMP. 74°

TOWNSHIP TOWNSEND

DWG BY PRESTON-COLVIN

PID PAVING TRAIN

SECTION 9

T 5 N R 17 E

TYPE MONUMENT MEG/WASHER

ON SURFACE - ~~BELOW~~ ON

OFFSET CL PAVEMENT 0.3' ~~LT~~ : RT

11.9' TO RT EDGE PAVEMENT

STATION: 1557+29

HORZ.DATUM: NAD83 (2011)


GEOID: NAVD88 2018

GRID: NORTHING: 636760.739


EASTING: 1858413.348

LDP: NORTHING: 333153.2

EASTING: 218531.4

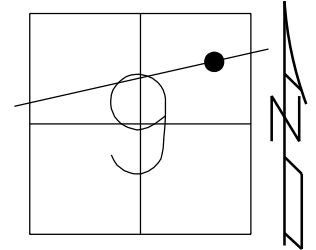

RECORD:
FD P.K./WASHER
3/16/02, DCH
SET MAG/WASHER
9-25-02, DCH
FD MAG/WASHER
REF48
11/23/17, DCH
SET MAG/WASHER
8-5-2019, JLL
FD MAG/WASHER
2/10/22, JFO
SET MAG/WASHER
11/20/23, DSA
FD MAG/WASHER
REF48
9/5/24, TDN
FD MAG/WASHER
10/3/24, JAM

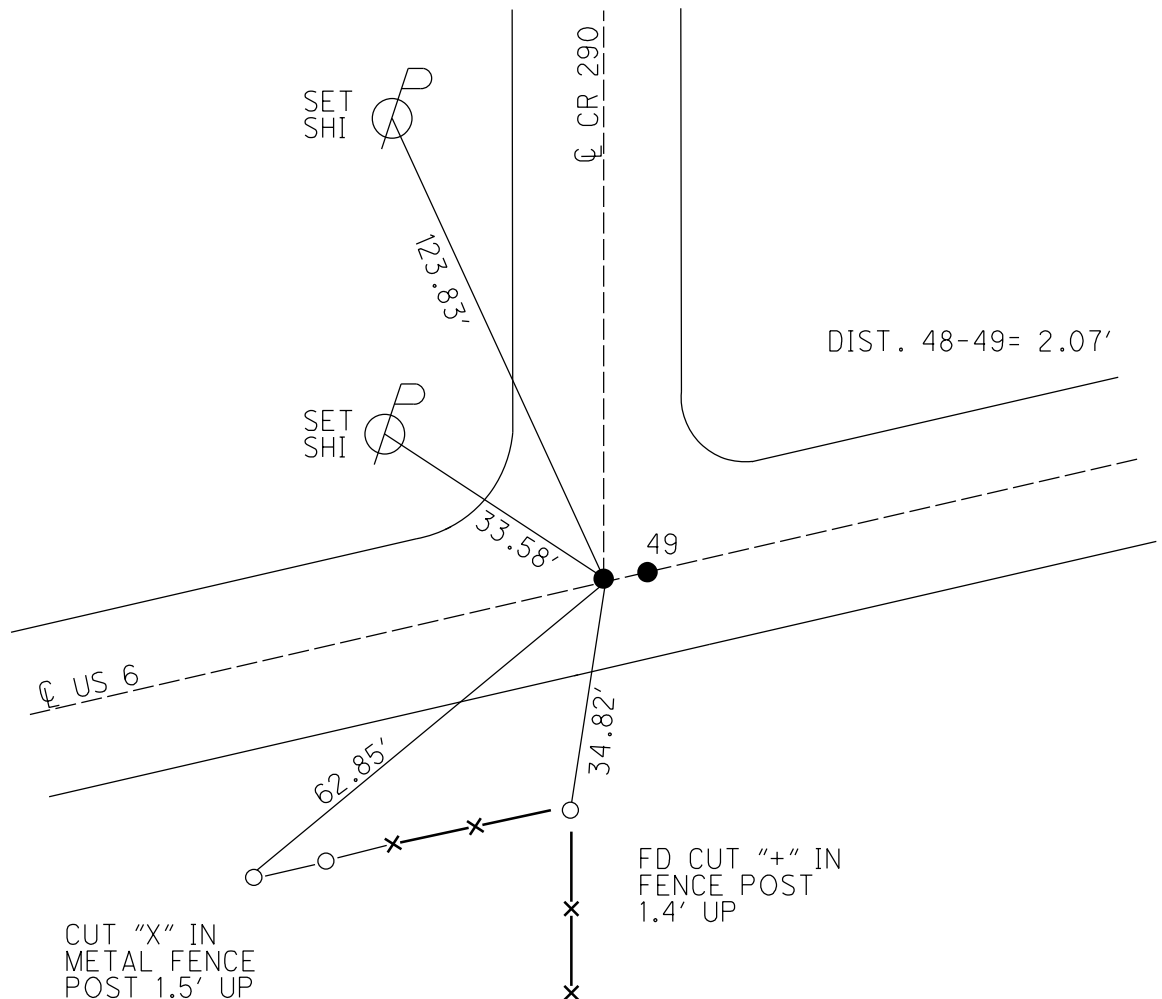

O.D.O.T. DISTRICT 2 SURVEY OFFICE (USE ONLY)

PERSONNEL

REFERENCE NO. 49

SHEET 24 OF 34

NOTES PRESTON-COLVIN

DATE 9-5-24

ROUTE US 6

H.C. NEISE

WEATHER SUNNY

COUNTY SANDUSKY

R.C. BARRIERE

TEMP. 74°

TOWNSHIP TOWNSEND

DWG BY PRESTON-COLVIN PID PAVING TRAIN

SECTION 9

T 5 N R 17 E

TYPE MONUMENT MEG/WASHER

ON SURFACE - ~~BELOW~~ ON

OFFSET Q PAVEMENT 0.3' ~~LT~~ : RT

11.9' TO RT EDGE PAVEMENT

STATION: 1557+29

HORZ.DATUM: NAD83 (2011)


GEOID: NAVD88 2018

GRID: NORTHING: 636761.650

EASTING: 1858415.240

LDP: NORTHING: 333154.1

EASTING: 218533.2

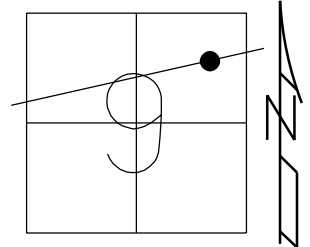

RECORD:

FD P.K./WASHER

3/16/02, DCH

SET MAG/WASHER

9-25-02, DCH

FD MAG/WASHER

REF49

11/23/17, DCH

SET MAG/WASHER

8-5-2019, JLL

FD MAG/WASHER

2/10/22, JFO

SET MAG/WASHER

11/20/23, DSA


FD MAG/WASHER

REF49

9/5/24, TDN

FD MAG/WASHER

10/3/24, JAM

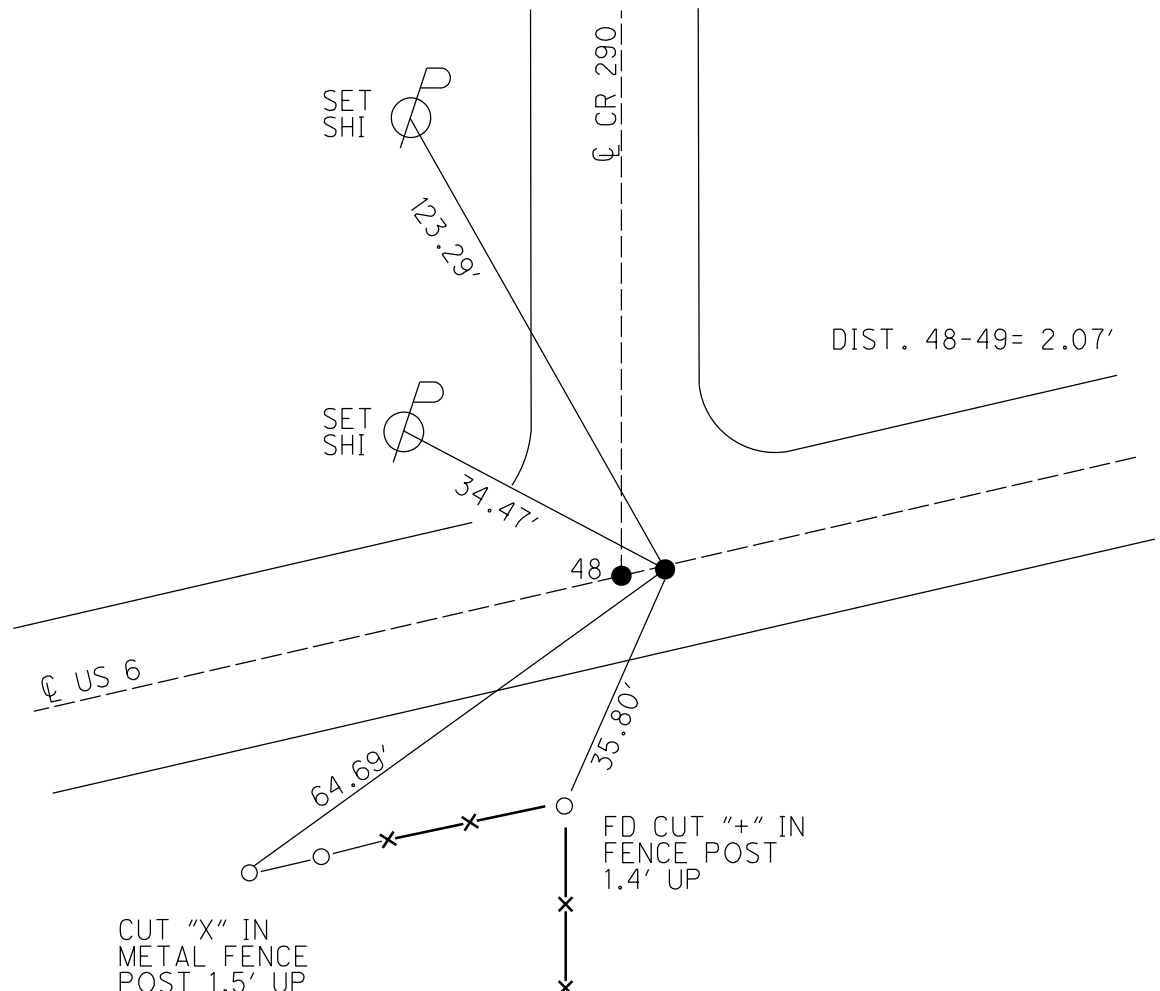

O.D.O.T. DISTRICT 2 SURVEY OFFICE (USE ONLY)

PERSONNEL

REFERENCE NO. 50

SHEET 25 OF 34

NOTES PRESTON-COLVIN

DATE 9-5-24

ROUTE US 6

H.C. NEISE

WEATHER SUNNY

COUNTY SANDUSKY

R.C. BARRIERE

TEMP. 74°

TOWNSHIP TOWNSEND

DWG BY PRESTON-COLVIN

PID PAVING TRAIN

T 5 N R 17 E

TYPE MONUMENT MEG/WASHER

ON SURFACE - ~~BELOW~~ ON

OFFSET ¢ PAVEMENT ON LT : RT

12.7' TO RT EDGE PAVEMENT

STATION: 1569+12

HORIZ.DATUM: NAD83 (2011)


GEOID: NAVD88 2018

GRID: NORTHING: 637239.209


EASTING: 1859497.565

LDP: NORTHING: 333639.2

EASTING: 219612.4

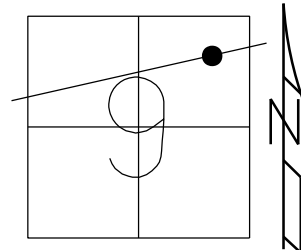

RECORD: P.I.
 $\Delta = 00^\circ 33' \text{ RT (PLAN)}$
 STA. 25+00
 P.K./WASHER
 BOAT SPIKE
 FD P.K./WASHER
 3/16/02, DCH
 FD P.K./WASHER
 REF50
 3-5-14, TMR
 FD MAG/WASHER
 REF50
 11/23/17, DCH
 SET MAG/WASHER
 8-5-19, JLL
 FD MAG/WASHER
 2/10/22, JFO
 1/20/23,
 12/28/23, JMR
 FD MAG/WASHER
 REF50
 9/5/24, TDN
 FD MAG/WASHER
 10/3/24, JAM

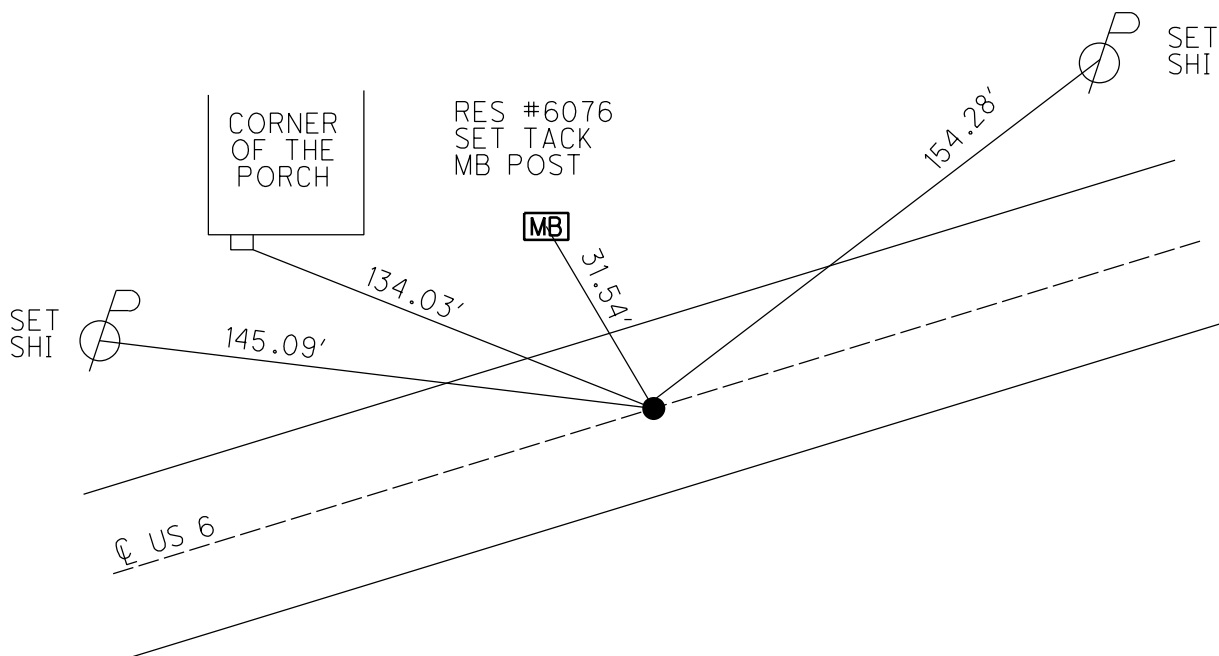

O.D.O.T. DISTRICT 2 SURVEY OFFICE (USE ONLY)

PERSONNEL

REFERENCE NO. 51

SHEET 26 OF 34

NOTES PRESTON-COLVIN

DATE 10/3/24

ROUTE US 6

H.C. NEISE

WEATHER SUNNY

COUNTY SANDUSKY

R.C. BARRIERE

TEMP. 74°

TOWNSHIP TOWNSEND

SECTION 3

DWG BY PRESTON-COLVIN PID PAVING TRAIN

T 5 N R 17 E

TYPE MONUMENT MEG/WASHER

ON SURFACE - ~~BELOW~~ ON

OFFSET Q PAVEMENT ON LT : RT

12.5' TO LT EDGE PAVEMENT

STATION: 1600+09

HORIZ.DATUM: NAD83 (2011)


GEOID: NAVD88 2018

GRID: NORTHING: 637239.209


EASTING: 1859497.565

LDP: NORTHING: _____

EASTING: _____

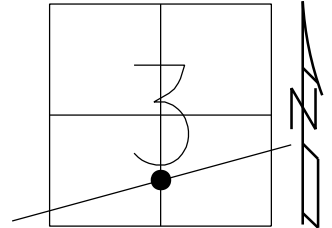

RECORD: P.I.
STA.56+00
 $\Delta = 00^\circ 10'$ LT (PLAN)
STA.1602+11.93
PREVIOUS MONUMENTS:
P.K./WASHER
SM.SQ HEADED SPIKE
SET FROM BRIDGE PLANS
FD P.K./WASHER
3/16/02, DCH
SET MAG/WASHER
9/26/02, DCH
FD PK/WASHER
REF51
3-5-14, TMR
SET MAG/WASHER
8/6/19, JLL
FD MAG/WASHER
2/10/22, JFO
1/20/23, JMR
FD MAG/WASHER
10/3/24, JAM

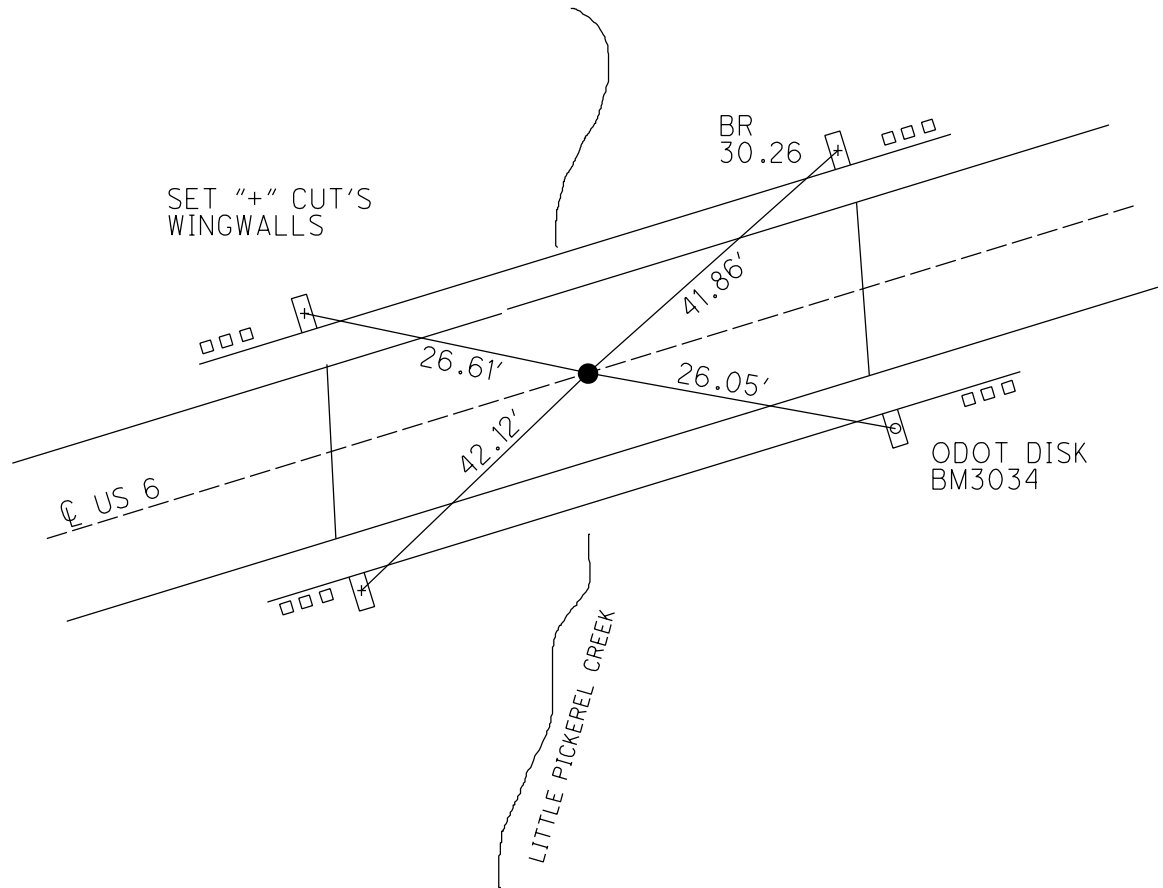

FD MAG NAIL
@ CR 294
NO INFO
LOOK INTO IT
10/3/24, JAM

O.D.O.T. DISTRICT 2 SURVEY OFFICE (USE ONLY)

PERSONNEL

REFERENCE NO. 51 AA

SHEET 27 OF 34

NOTES PRESTON-COLVIN

DATE 10/3/24

ROUTE US 6

H.C. NEISE

WEATHER SUNNY

COUNTY SANDUSKY

R.C. BARRIERE

TEMP. 77°

TOWNSHIP TOWNSEND

DWG BY PRESTON-COLVIN

PID PAVING TRAIN

SECTION 3

T 5 N R 17 E

TYPE MONUMENT MEG/WASHER

ON SURFACE - ~~BELOW~~ ON

OFFSET ¢ PAVEMENT 0.4' LT : ~~RT~~

- TO - EDGE PAVEMENT

STATION: 1614+19

HORZ.DATUM: NAD83 (2011)


GEOID: NAVD88 2018

GRID: NORTHING: 639024.160


EASTING: 1863641.387

LDP: NORTHING: 335452.7

EASTING: 223744.1

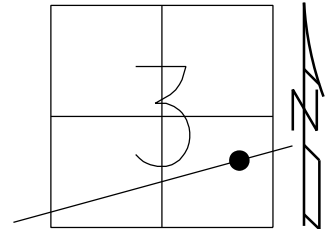

RECORD:
FD P.K.NAIL
REFAA51
8/8/18, JLL
SET MAG/WASHER
8-5-19, JLL
FD MAG/WASHER
2/10/22, JFO
1/20/23, JMR
FD MAG/WASHER
REF51AA
9/5/24, TDN
FD MAG/WASHER
10/3/24, JAM

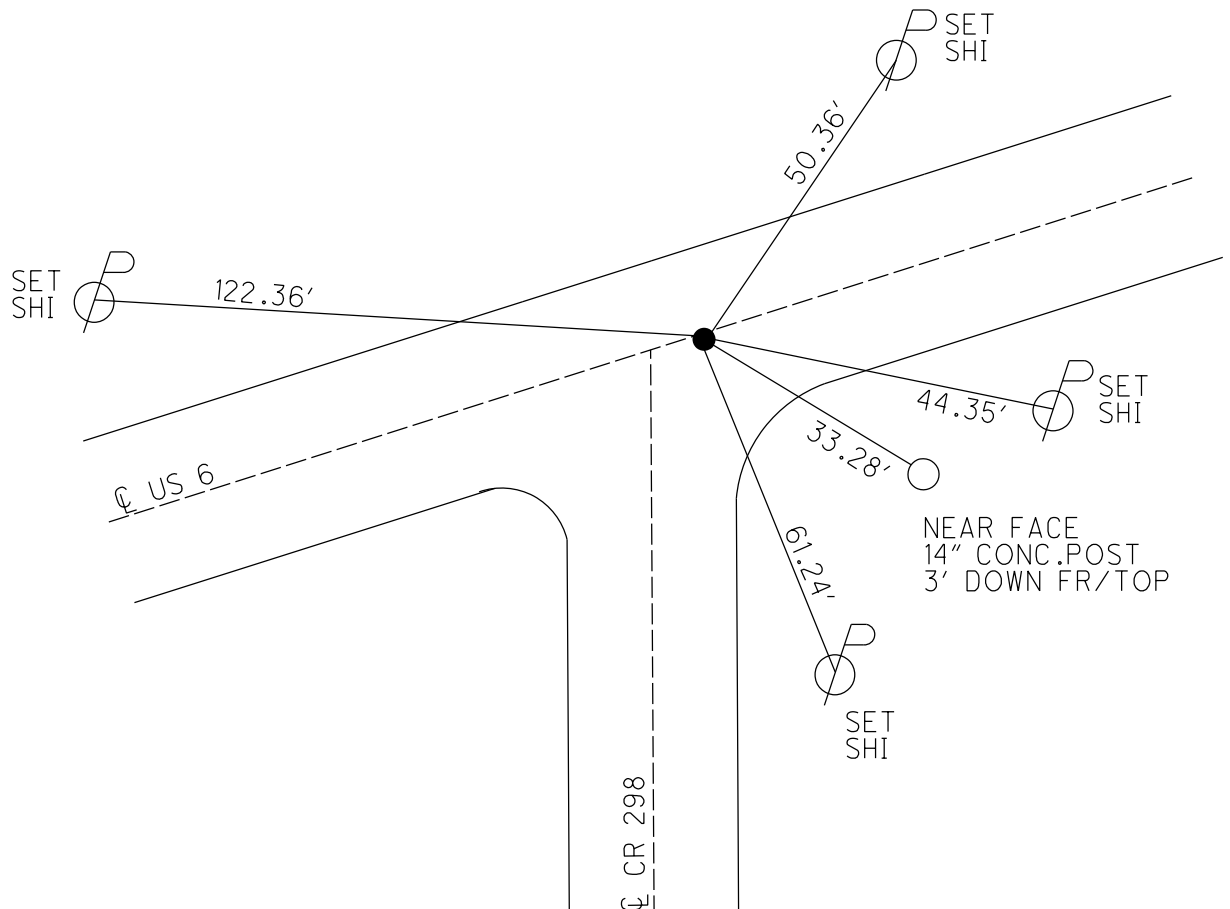

O.D.O.T. DISTRICT 2 SURVEY OFFICE (USE ONLY)

PERSONNEL

REFERENCE NO. 51 A

SHEET 28 OF 34

NOTES PRESTON-COLVIN

DATE 9/5/24

ROUTE US 6

H.C. NEISE

WEATHER SUNNY

COUNTY SANDUSKY

R.C. BARRIERE

TEMP. 80°

TOWNSHIP TOWNSEND

SECTION 2

DWG BY PRESTON-COLVIN PID PAVING TRAIN

T 5 N R 17 E

TYPE MONUMENT MEG/WASHER

ON SURFACE - ~~BELOW~~ ON

OFFSET ¢ PAVEMENT 0.5' ~~LT~~ : RT

13' TO LT EDGE PAVEMENT

STATION: 1629+81

HORZ.DATUM: NAD83 (2011)


GEOID: NAVD88 2018

GRID: NORTHING: 639640.754


EASTING: 1865066.673

LDP: NORTHING: 336079.2

EASTING: 225165.2

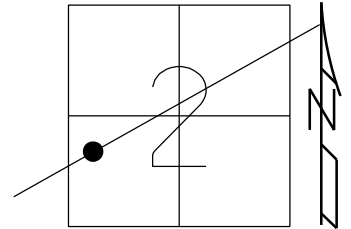

RECORD: P.I.
Δ= 00° 09' LT (PLAN)
STA.85+63.80
PREVIOUS MONUMENTS:
P.K./WASHER
BOAT SPIKE/WASHER
FD P.K./WASHER
3/16/02, DCH
SET MAG/WASHER
9/26/02 DCH
FD PK/WASHER
REFA51
3-5-14, TMR
FD MAG/WASHER
REFA51
11/23/17, DCH
SET MAG/WASHER
8-5-19, JLL
FD MAG/WASHER
2/10/22, JFO
1/20/23, JMR
FD MAG/WASHER
REF 51A
9/5/24, TDN
FD MAG/WASHER
10/3/24, JAM

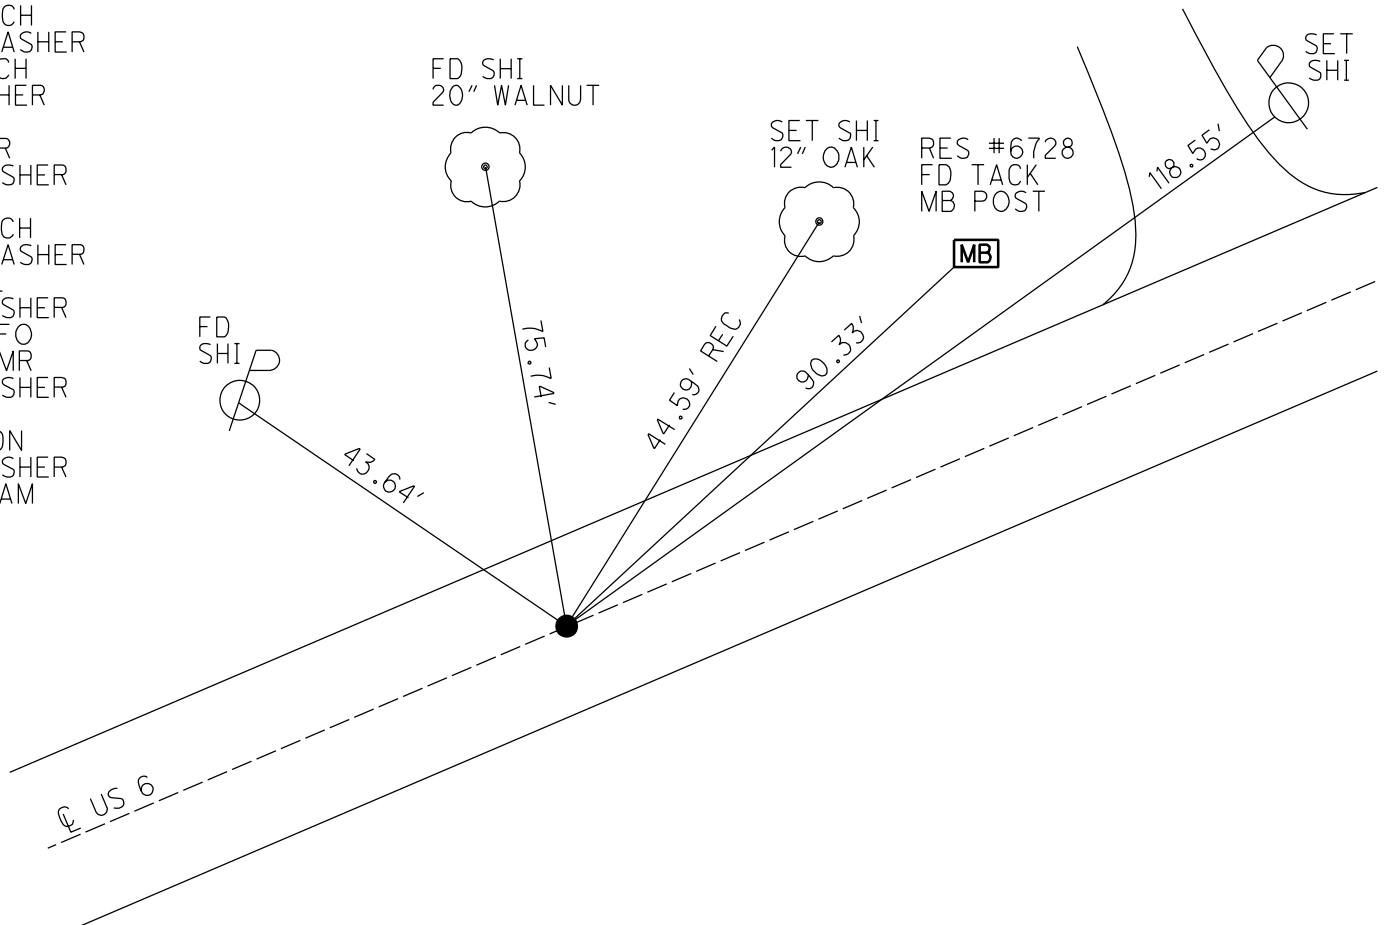

O.D.O.T. DISTRICT 2 SURVEY OFFICE (USE ONLY)

PERSONNEL

REFERENCE NO. 52

SHEET 29 OF 34

NOTES PRESTON-COLVIN

DATE 9/5/24

ROUTE US 6

H.C. NEISE

WEATHER SUNNY

COUNTY SANDUSKY

R.C. BARRIERE

TEMP. 80°

TOWNSHIP TOWNSEND

DWG BY PRESTON-COLVIN PID PAVING TRAIN

T 5 N R 17 E

TYPE MONUMENT MEG/WASHER

ON SURFACE - ~~BELOW~~ ON

OFFSET Q PAVEMENT ON LT : RT

12.4' TO RT EDGE PAVEMENT

STATION: 1642+72

HORZ.DATUM: NAD83 (2011)


GEOID: NAVD88 2018

GRID: NORTHING: 640156.370


EASTING: 1866248.935

LDP: NORTHING: 336603

EASTING: 226343.9

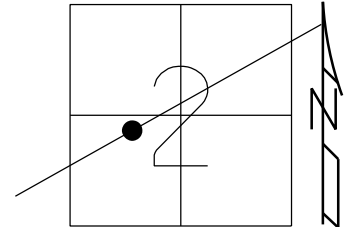

RECORD: P.I.
Δ0° 11' RT
STA. 98+53.4
PREVIOUS MONUMENTS
P.K./WASHER
BOAT SPIKE/WASHER
FD P.K./WASHER
3/16/02, DCH
SET MAG/WASHER
9/25/02, DCH
DNF
11/23/17, DCH
SET MAG/WASHER
8-6-19, JLL
FD MAG/WASHER
2/10/22, JFO
1/20/23, JMR
FD MAG/WASHER
9/5/24, TDN
FD MAG/WASHER
10/3/24, JAM

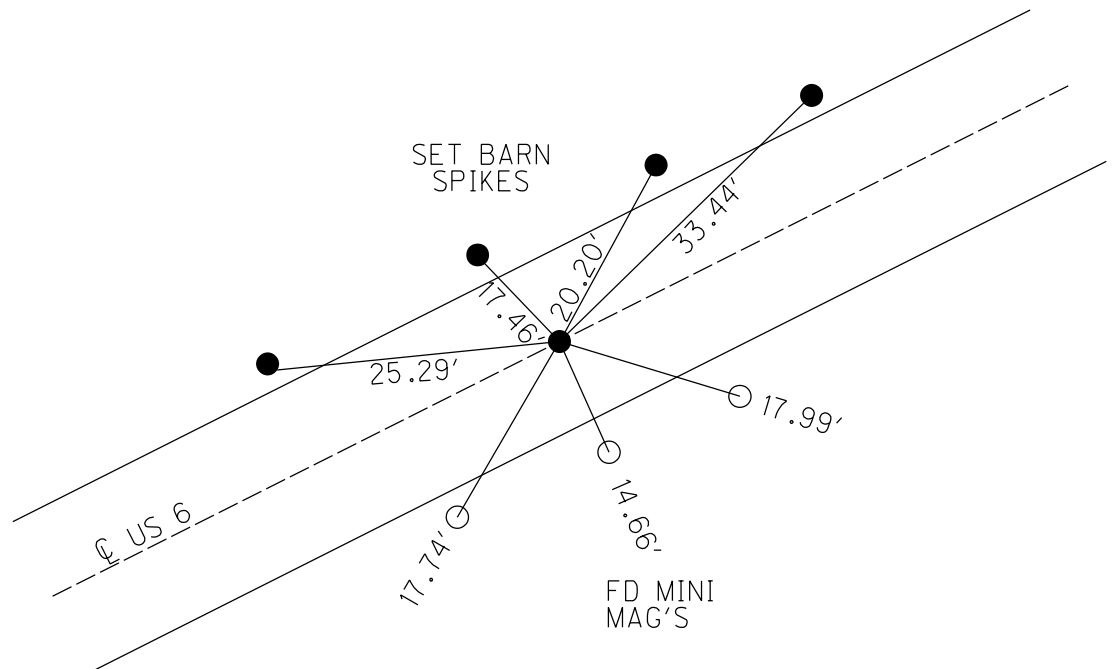

O.D.O.T. DISTRICT 2 SURVEY OFFICE (USE ONLY)

PERSONNEL

REFERENCE NO. 52 A

SHEET 30 OF 34

NOTES PRESTON-COLVIN

DATE 9/5/24

ROUTE US 6

H.C. NEISE

WEATHER SUNNY

COUNTY SANDUSKY

R.C. BARRIERE

TEMP. 85°

TOWNSHIP TOWNSEND

DWG BY PRESTON-COLVIN

PID PAVING TRAIN

T 5 N R 17 E

TYPE MONUMENT MEG/WASHER

ON SURFACE - ~~BELOW~~ ON

OFFSET ¢ PAVEMENT 2.0' LT : ~~RT~~

10.0' TO LT EDGE PAVEMENT

STATION: 1655+80

HORZ.DATUM: NAD83 (2011)


GEOID: NAVD88 2018

GRID: NORTHING: 640674.881


EASTING: 1867448.040

LDP: NORTHING: 336603

EASTING: 226343.9

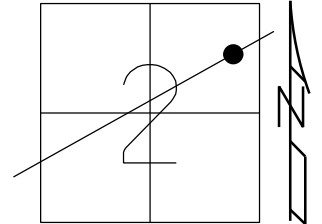

RECORD: P.I.
STA. 111+60.15
 $\Delta = 02^\circ 16' \text{ RT}$
 $T = 113.15'$
 $L = 226.60'$
1931 PHOTOSTAT PLANS
FD P.K./WASHER
3/16/02, DCH
SET MAG/WASHER
9/25/02, DCH
FD MAG/WASHER
REF A52
11/23/17, DCH
SET MAG/WASHER
8/5/19, JLL
FD MAG/WASHER
2/10/22, JFO
SET MAG/WASHER
11/20/23, DSA
FD MAG/WASHER
REF 52A
9/5/24, TDN
FD MAG/WASHER
10/3/24, JAM

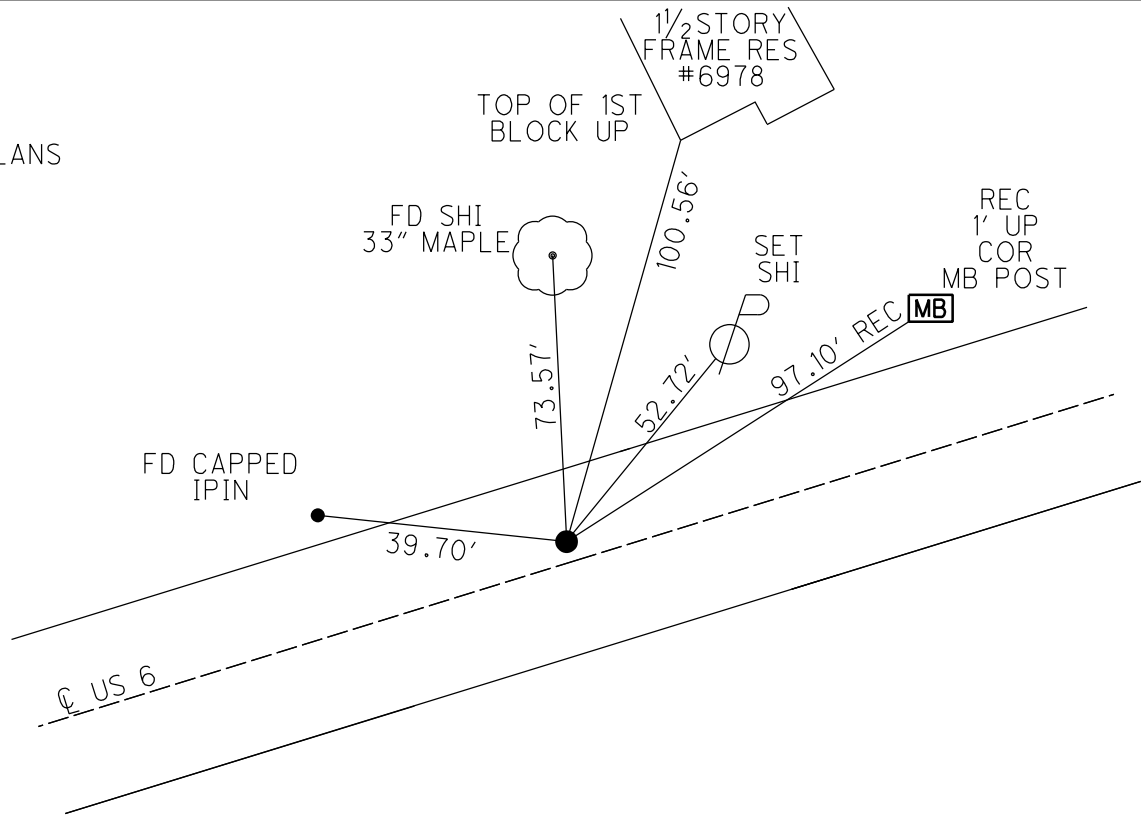

O.D.O.T. DISTRICT 2 SURVEY OFFICE (USE ONLY)

PERSONNEL

REFERENCE NO. 53

SHEET 30 OF 34

NOTES PRESTON-COLVIN

DATE 9/5/24

ROUTE US 6

H.C. NEISE

WEATHER SUNNY

COUNTY SANDUSKY

R.C. BARRIERE

TEMP. 85°

TOWNSHIP TOWNSEND

DWG BY PRESTON-COLVIN PID PAVING TRAIN

T 5 N R 17 E

TYPE MONUMENT MEG/WASHER

ON SURFACE - ~~BELOW~~ ON

OFFSET Q PAVEMENT 0.4' LT : RT

12.6' TO LT EDGE PAVEMENT

STATION: 1672+66

HORZ.DATUM: NAD83 (2011)


GEOID: NAVD88 2018

GRID: NORTHING: 641218.303


EASTING: 1869018.816

LDP: NORTHING: 337747

EASTING: 229106.1

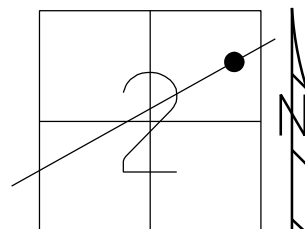

RECORD: P.I.
STA. 128+44.20
 $\Delta = 00^\circ 40'$ LT (PLAN)
PREVIOUS MONUMENTS:
P.K./WASHER
BOAT SPIKE
FD P.K./WASHER
3/16/02, DCH
SET MAG/WASHER
9/25/02 DCH
FD MAG/WASHER
REF 53
11/23/17, DCH
SET MAG/WASHER
8-6-19, JLL
FD MAG/WASHER
2/10/22, JFO
1/20/23, JMR
FD MAG/WASHER
REF 53
9/5/24, TDN
FD MAG/WASHER
10/3/24, JAM

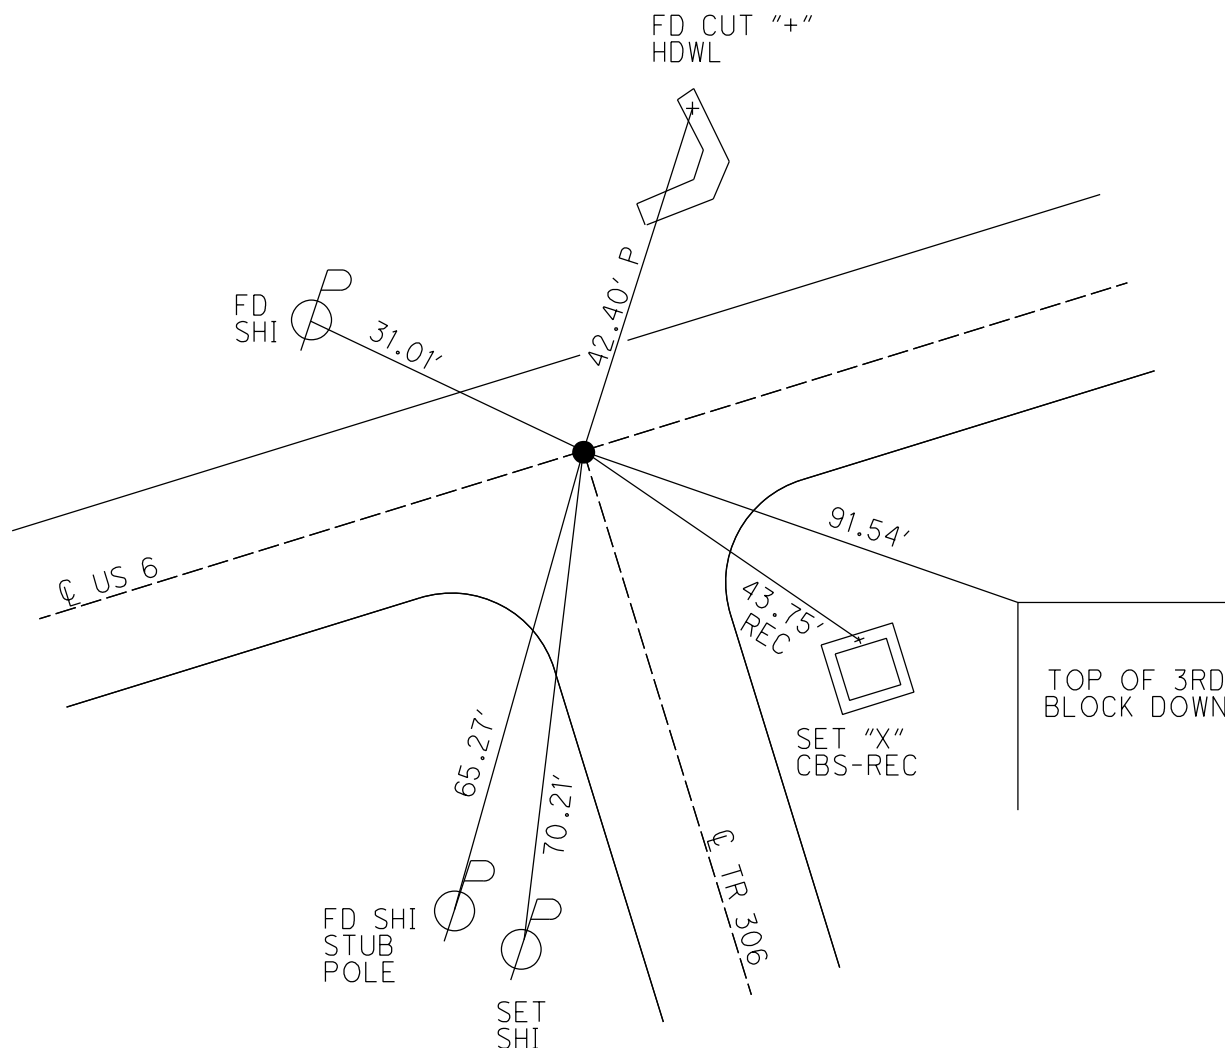

O.D.O.T. DISTRICT 2 SURVEY OFFICE (USE ONLY)

PERSONNEL

REFERENCE NO. 54

SHEET 32 OF 34

NOTES LEU

DATE 8/8/18

ROUTE US 6

H.C. LEU

WEATHER CLOUDY

COUNTY SANDUSKY

R.C. HAGEMeyer

TEMP. 81°

TOWNSHIP TOWNSEND

DWG BY AUBLE

PID PAVETRAIN

SECTION 1

T 5 N R 17 E

TYPE MONUMENT MAG/WASHER

ON SURFACE - ~~BELOW~~ ON

OFFSET Q PAVEMENT 0.7' LT : ~~RT~~

9' TO LT EDGE PAVEMENT


STATION: 1694+22

HORZ.DATUM: NAD83 (2011)


GEOID: 2012A

GRID: NORTHING: 642081.760

EASTING: 1871022.002

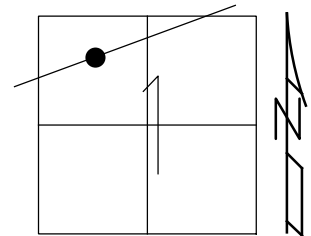

RECORD: P.I.
Δ= 01° 42' RT
STA.150+00
FD BOAT SPIKE
2" DOWN
STA.143+88.70
T= 85.00'
L= 170.00'
FD SM.R.R.SPIKE
4" DOWN
3/16/02, DCH
SET MAG/WASHER
9/26/02, DCH
FD MAG NAIL
REF54
11/23/17, DCH
SET MAG/WASHER
8-6-19, JLL
FD MAG/WASHER
2/10/22, JFO
1/20/23, JMR

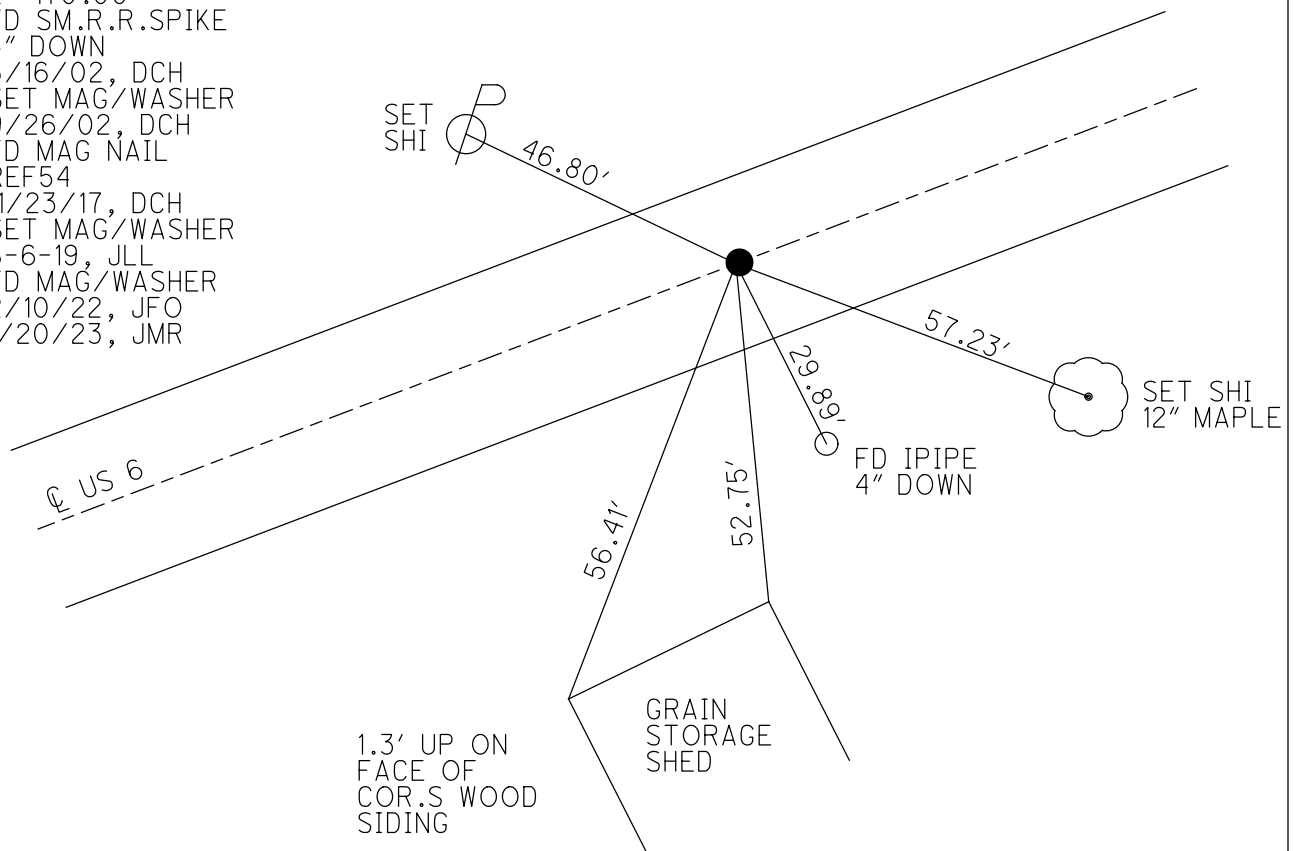

O.D.O.T. DISTRICT 2 SURVEY OFFICE (USE ONLY)

PERSONNEL

REFERENCE NO. 54 A

SHEET 33 OF 34

NOTES LEU

DATE 8/8/18

ROUTE US 6

H.C. LEU

WEATHER SUNNY

COUNTY SANDUSKY

R.C. HAGEMeyer

TEMP. 70

TOWNSHIP TOWNSEND

DWG BY AUBLE

PID 95769

SECTION 1

T 5 N R 17 E

TYPE MONUMENT MAG/WASHER

ON SURFACE - ~~BELOW~~ ON

OFFSET Q PAVEMENT 1.5' LT : RT

10.6' TO RT EDGE PAVEMENT


STATION: 1704+03

HORZ.DATUM: NAD83 (2011)


GEOID: 2012A

GRID: NORTHING: 642417.881

EASTING: 1871941.628

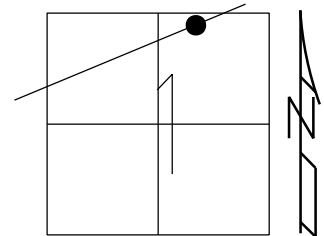

RECORD: P.I.
STA.159+78.84
 $\Delta = 01^{\circ} 55' \text{ LT}$
PREVIOUS MONUMENTS:
P.K./WASHER
BOAT SPIKE
T= 95.84'
L= 191.00'
FD P.K./WASHER
3/16/02, DCH
SET MAG/WASHER
9/26/02 DCH
FD MAG/WASHER
REFA54
11/23/17, DCH
SET MAG/WASHER
7-15-19, JLL
FD MAG/WASHER
2/10/22, JFO
FD MAG/WASHER
10/3/24, JAM

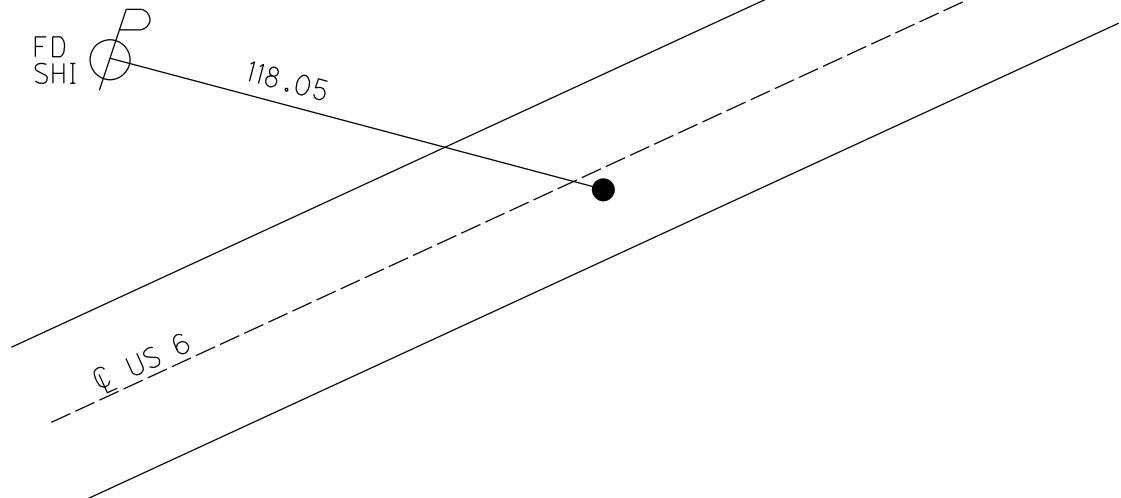

O.D.O.T. DISTRICT 2 SURVEY OFFICE (USE ONLY)

PERSONNEL

REFERENCE NO. 55

SHEET 34 OF 34

NOTES LEU

DATE 8/9/18

ROUTE US 6

H.C. LEU

WEATHER SUNNY

COUNTY SANDUSKY

R.C. HAGEMeyer

TEMP. 70

TOWNSHIP TOWNSEND

DWG BY AUBLE

PID 95769

SECTION 1

T 5 N R 17 E

TYPE MONUMENT BOAT SPIKE/WASHER

~~ON SURFACE~~ - BELOW 4"

OFFSET Q PAVEMENT ON LT : RT

12.0' TO LT EDGE PAVEMENT


STATION: 1714+36

HORZ.DATUM: NAD83 (2011)

GEOID: 2012A

GRID: NORTHING: 642804.881

EASTING: 1872897.843

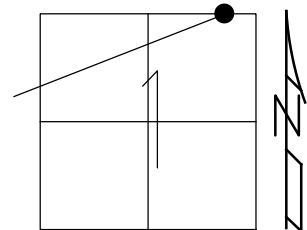

RECORD:

STA. 170+14.50

PREVIOUS MONUMENTS:

P.K./WASHER

BOAT SPIKE/WASHER

FD P.K./WASHER

3/16/02, DCH

SET MAG/WASHER

9/26/02, DCH

FD BOAT SPIKE/WASHER

4" DOWN

REF55

11/23/17, DCH

SET MAG/WASHER

7-15-19, JLL

FD MAG/WASHER

2/10/22, JFO

