

F CR 232
N ERLIN RD

O.D.O.T. DISTRICT 2 SURVEY OFFICE (USE ONLY)

PERSONNEL

REFERENCE NO. 36 A

SHEET 18 OF 19

NOTES AUBLE

DATE 7/26/21

ROUTE US 6

H.C. NIESE

WEATHER CALM

COUNTY SANDUSKY

R.C. AUBLE

TEMP. 77°

TOWNSHIP RILEY

SECTION 16

DWG BY NIESE

PID 108868

T 5 N R 16 E

TYPE MONUMENT MAG/WASHER

ON SURFACE - ~~BELOW~~ ON

OFFSET Q PAVEMENT ON LT : RT

- TO - EDGE PAVEMENT


STATION: 1233+50.83

HORZ.DATUM: NAD83 (2011)


GEOID: 2012A

GRID: NORTHING: 630771.791

EASTING: 1828081.589

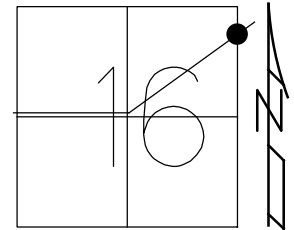

RECORD: P.I.
P.K./WASHER
R.R. SPIKE
STA. 1240+88
SET P.K./WASHER
6/9/02, DCH
FD R.R.SPIKE
6/10/08, DCH
FD R.R.SPIKE
4" DOWN
REF37
8/6/09, DCH
FD R.R.SPIKE
W/DIMPLE
4" DOWN
11/22/17, DCH
8/1/18, JLL
SET MAG/WASHER
7/31/19, JLL
FD MAG/WASHER
7/26/21, TDN
2/10/22, JFO

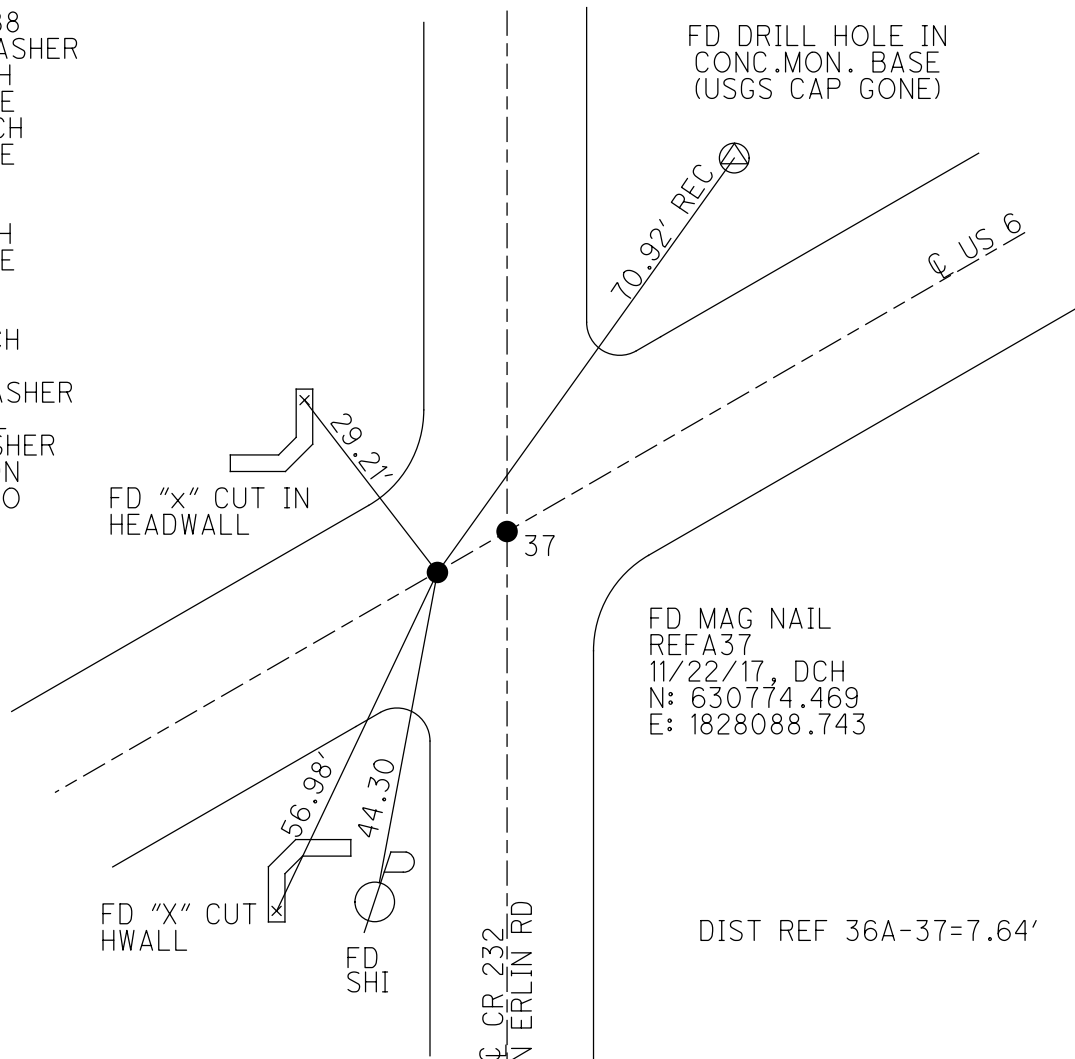

PERSONNEL

REFERENCE NO. 36 A

SHEET 18 OF 19

NOTES AUBLE

DATE 7/26/21

ROUTE US 6

H.C. NIESE

WEATHER CALM

COUNTY SANDUSKY

R.C. AUBLE

TEMP. 77°

TOWNSHIP RILEYDWG BY NIESE

PID 108868

T 5 N R 16 E

TYPE MONUMENT MAG/WASHER

ON SURFACE - ~~BELOW~~ _____ ON

OFFSET C PAVEMENT _____ ON _____ LT : RT _____


_____TO_____EDGE PAVEMENT

STATION: 1233+50.83

HORZ.DATUM: NAD83 (2011)

GEOID: 2012A

GRID: NORTHING: 630771.791

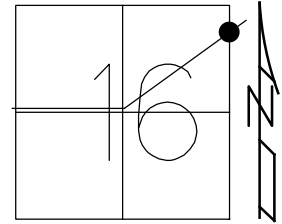EASTING: 1828081.589

RECORD: P.I.
P.K./WASHER
R.R. SPIKE
STA. 1240+88
SET P.K./WASHER
6/9/02, DCH
FD R.R.SPIKE
6/10/08, DCH
FD R.R.SPIKE
4" DOWN
REF37
8/6/09, DCH
FD R.R.SPIKE
W/DIMPLE
4" DOWN
11/22/17, DCH
8/1/18, JLL
SET MAG/WASHER
7/31/19, JLL
FD MAG/WASHER
7/26/31, TDN

FD "X" CUT IN
HEADWALL

FD DRILL HOLE IN
CONC.MON. BASE
(USGS CAP GONE)

70.92' REC

Q US 6

37

FD MAG NAIL
REF A37
11/22/17, DCH
N: 630774.469
E: 1828088.743

DIST REF 36A-37=7.64'

FD "X" CUT ☒
HWALL

FD
SHI

CR 232
W ERLIN RD

O.D.O.T. DISTRICT 2 SURVEY OFFICE (USE ONLY)

PERSONNEL

REFERENCE NO. 37

SHEET 17 OF 17

NOTES LEU

DATE 8/1/18

ROUTE US 6

H.C. LEU

WEATHER CLOUDY

COUNTY SANDUSKY

R.C. TRENKA

TEMP. 68°

TOWNSHIP RILEY

SECTION 16

DWG BY AUBLE

PID 95769

T 5 N R 16 E

TYPE MONUMENT R.R.SPIKE W/DIMPLE

~~ON SURFACE~~ - BELOW 4"

OFFSET Q PAVEMENT 0.5' ~~LT~~ : RT

- TO - EDGE PAVEMENT


STATION: 1233+50.83

HORIZ.DATUM: NAD83 (2011)


GEOID: 2012A

GRID: NORTHING: 630771.791

EASTING: 1828081.589

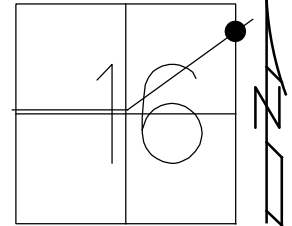

RECORD: P.I.
P.K./WASHER
R.R. SPIKE
STA. 1240+88
SET P.K./WASHER
6/9/02, DCH
FD R.R.SPIKE
6/10/08, DCH
FD R.R.SPIKE
4" DOWN
8/6/09, DCH
FD R.R.SPIKE
W/DIMPLE
4" DOWN
11/22/17, DCH
SET MAG/WASHER
7-31-2019, JLL

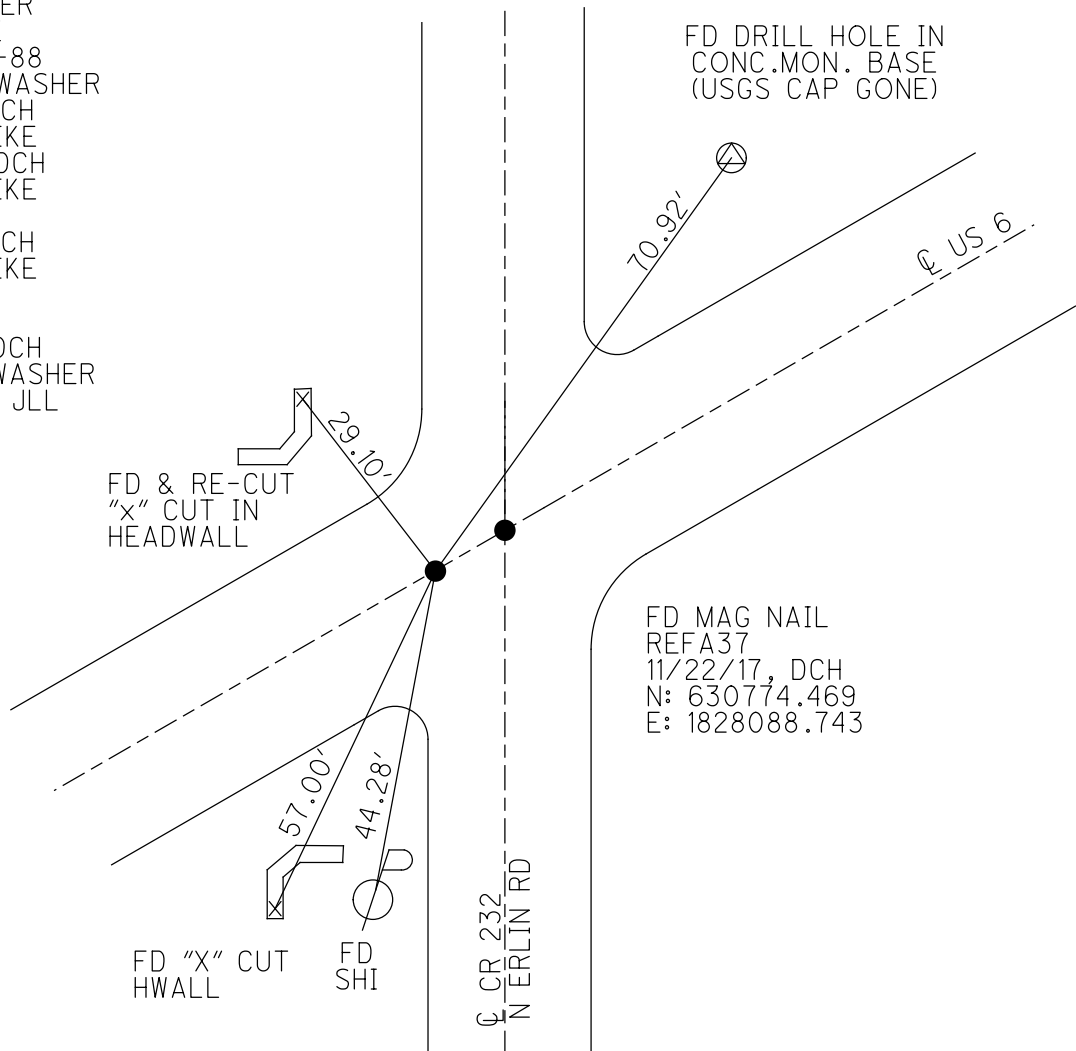

O.D.O.T. DISTRICT 2 SURVEY OFFICE

PERSONNEL

REFERENCE NO. 37

SHEET 17 OF 17

NOTES _____ HUMAN _____

DATE 8/06/09

ROUTE US 6

H.C. HOMAN

WEATHER SUNNY

COUNTY SANDUSKY

R.C. ROUSOS

TEMP. 80°

TOWNSHIP RILEY

SECTION 16

T 5 N R 16 E

TYPE MONUMENT R.R. SPIKE


~~ON SURFACE~~ - BELOW 4"

LEFT - C PAV'T - RIGHT 0.5'

_____ TO _____ EDGE PAVEMENT

S.L.M. 1233+50.83

GPS Northing: 630771.823 Easting: 1828081.621

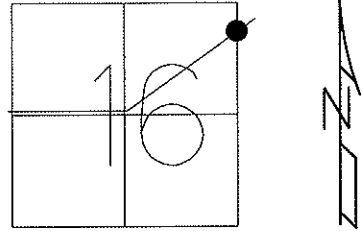

PREVIOUS MONUMENTS:

P.K. & WASHER

R.R. SPIKE

P.I.

OLD STA. 269+10


0+00 SEC. "I" AHEAD

STA. 1240+88

CK PLAN

SAN-6-21.59

1207+01.19

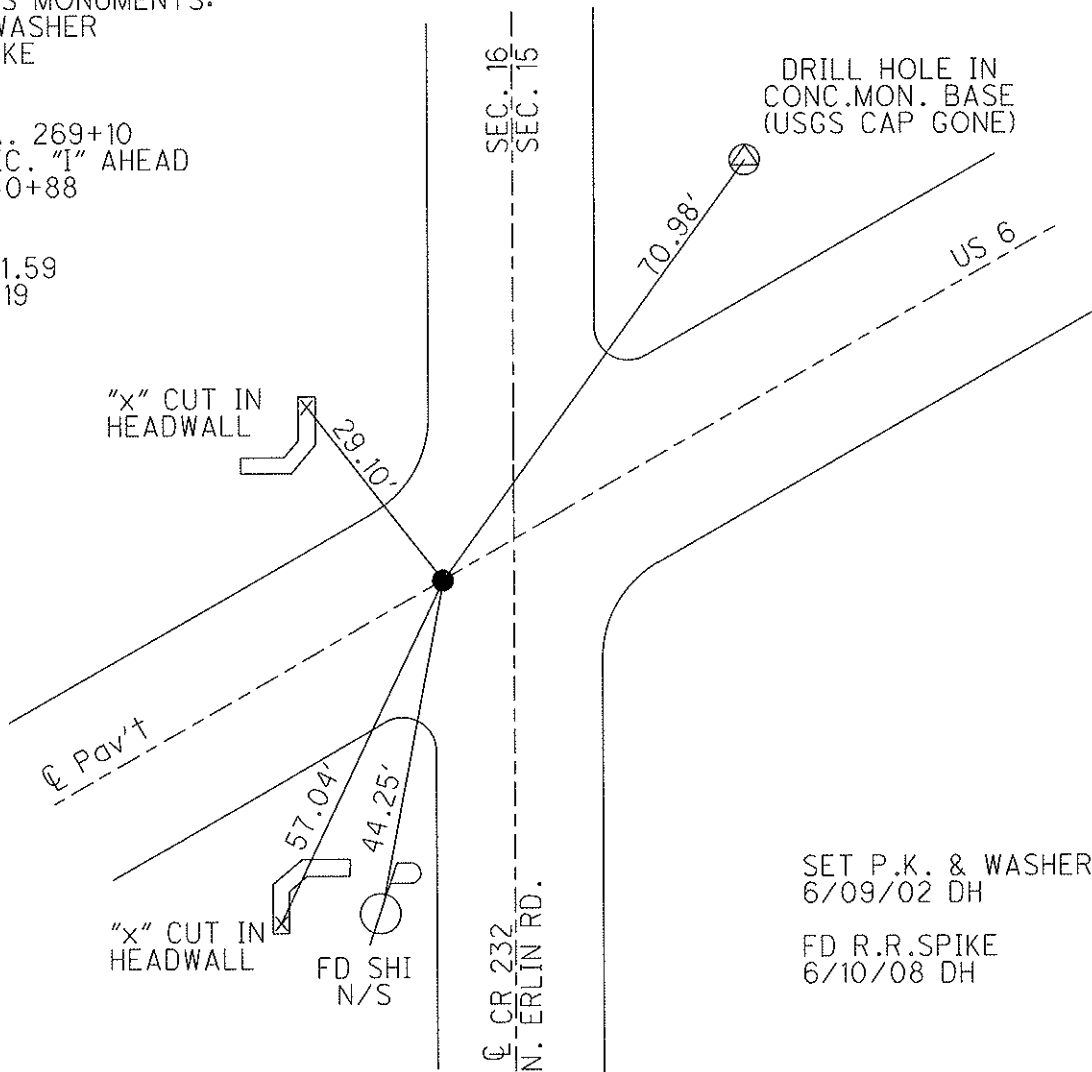

SET P.K. & WASHER
6/09/02 DH

FD R.R.SPIKE
6/10/08 DH

O.D.O.T. DISTRICT 2 SURVEY OFFICE

PERSONNEL

NOTES ROUSOS
H.C. VAN DUSEN
R.C. MOSSER
HOMAN


REFERENCE NO. 37

DATE 3/16/02
WEATHER WINDY
TEMP. 28°

SHEET 1 OF 27

ROUTE SR 6
COUNTY SANDUSKY
TOWNSHIP RILEY
SECTION 16
T 5 N R 16 E

TYPE MONUMENT RR Spike
~~ON SURFACE~~ - BELOW 4"
~~LEFT - C PAVT - RIGHT~~ 0.5'
TO EDGE PAVEMENT
S.L.M. 1240+88

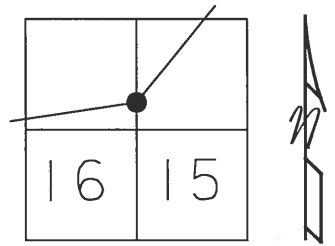


Previous Monuments:
P.K. & Washer
R.R. Spike

Set PK & Washer
6-9-02 DCH

P.I.
Old Sta. 269+10=
0+00 Sec. "I" Ahead

CK Plan
SAN-6-21.59
1207+01.19

Drill Hole In
Conc. Mon. Base
(USGS Cap Gone)

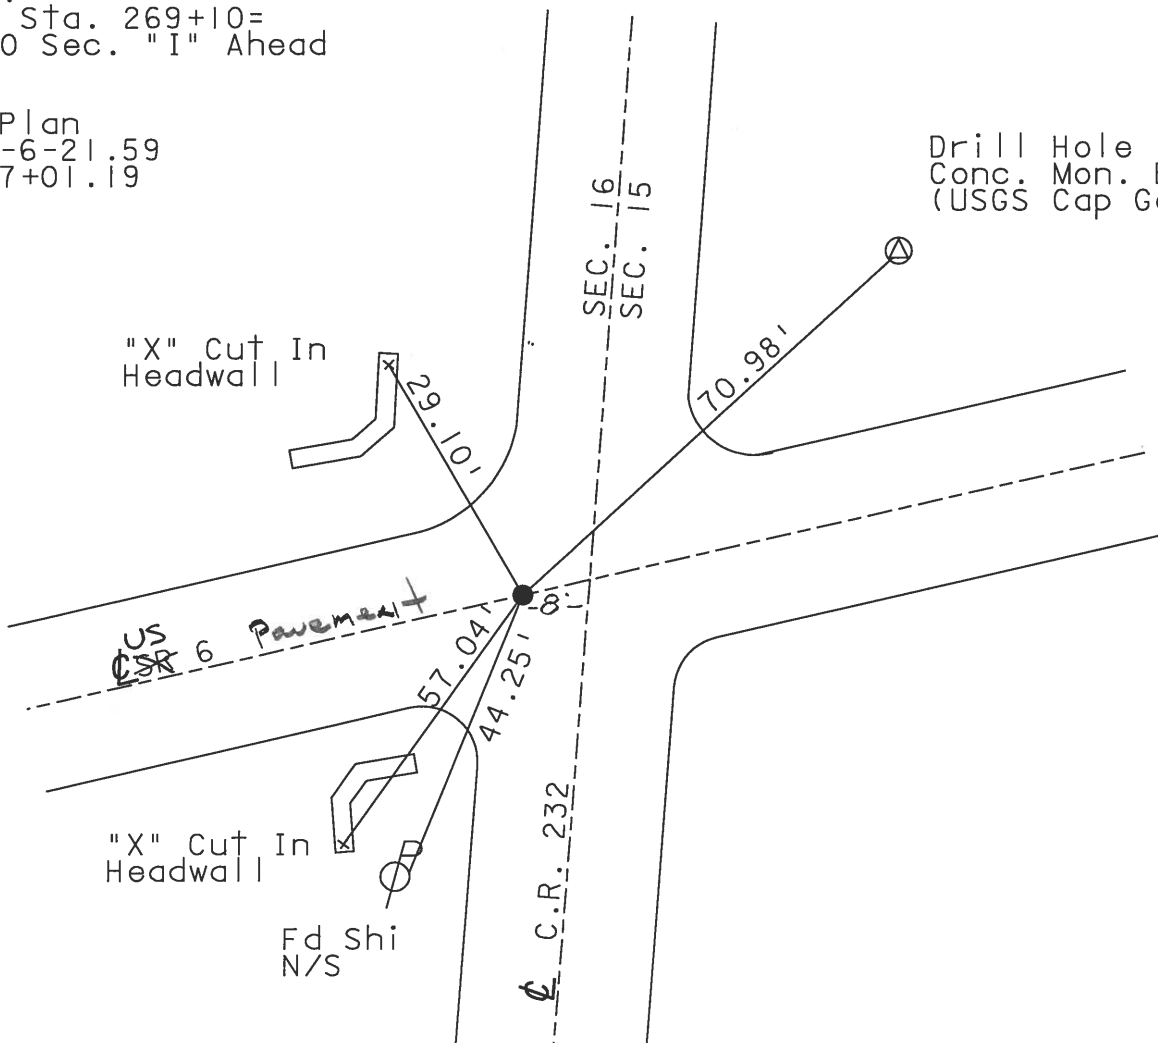

O.D.O.T. DISTRICT 2 SURVEY OFFICE

PERSONNEL

REFERENCE NO. 37

SHEET 13 OF 39

NOTES CHEM 4

H.C. BARBOUR

R.C. GEYMAN

DATE 9-13-1991

WEATHER Sunny

TEMP. 70°

ROUTE 6

COUNTY SANDUSKY

TOWNSHIP 21454

SECTION 16

T5N R16 E


TYPE MONUMENT P.K / WASHER

ON SURFACE - BELOW _____

LEFT - & PAN'T. - RIGHT _____

TO EDGE PAVEMENT

S.L.M. 1240 + 88

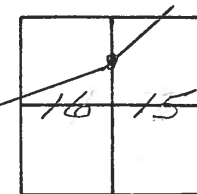

PREVIOUS MONUMENTS:

P.K/WASHER

R. R. SPK.


P. 1.

OLD STA = $269 + 10 =$

0400 SEC. 'T' AHEAD

CK PLAN:
SANI-6-21.59
1207+01.19

"+" IN TRIANGLE
U.S.G.S.

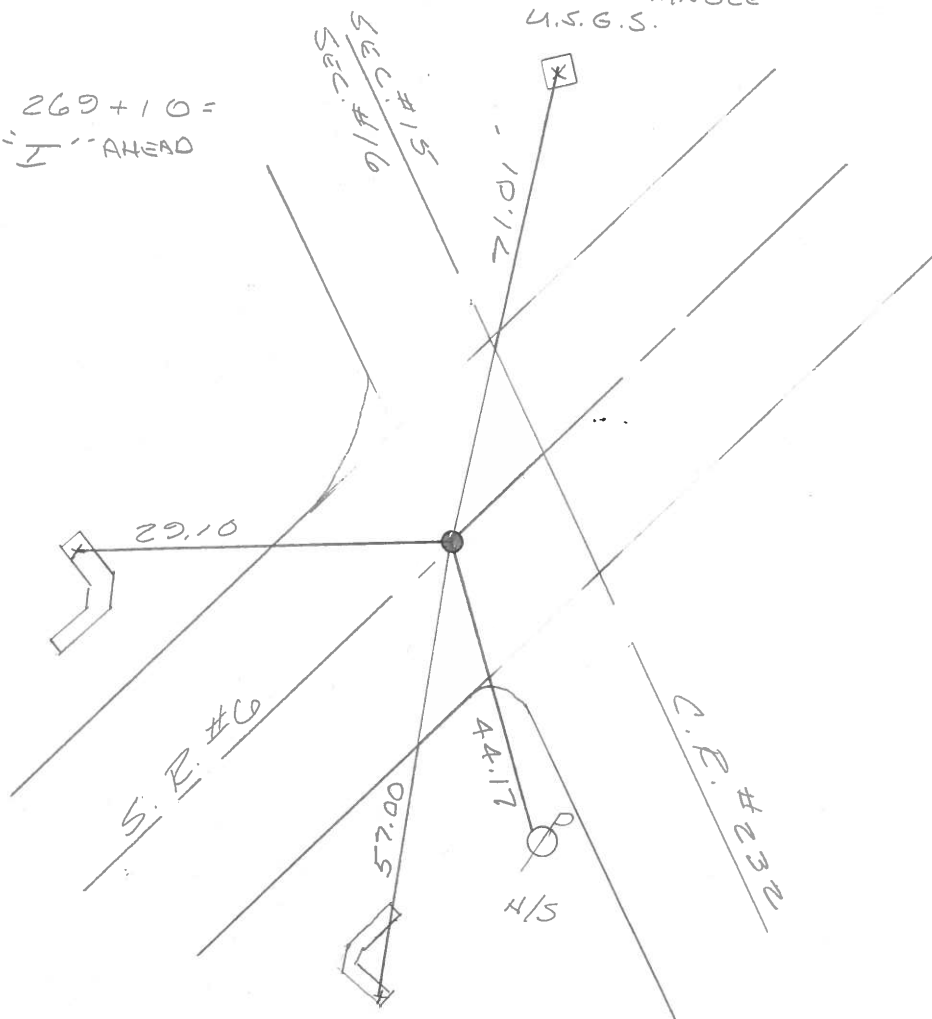

PERSONNEL TITLE PERSONNEL TITLE
 Cronin Schneider
 Geyman Mosser
 Barbour

COUNTY Sandusky

DATE 7/28/75

S. R. #6


WEATHER sunny

SEC. "4" - Fremont - East

TEMP. 75°

DESCRIPTION Ties for Control Points

JOB NO.

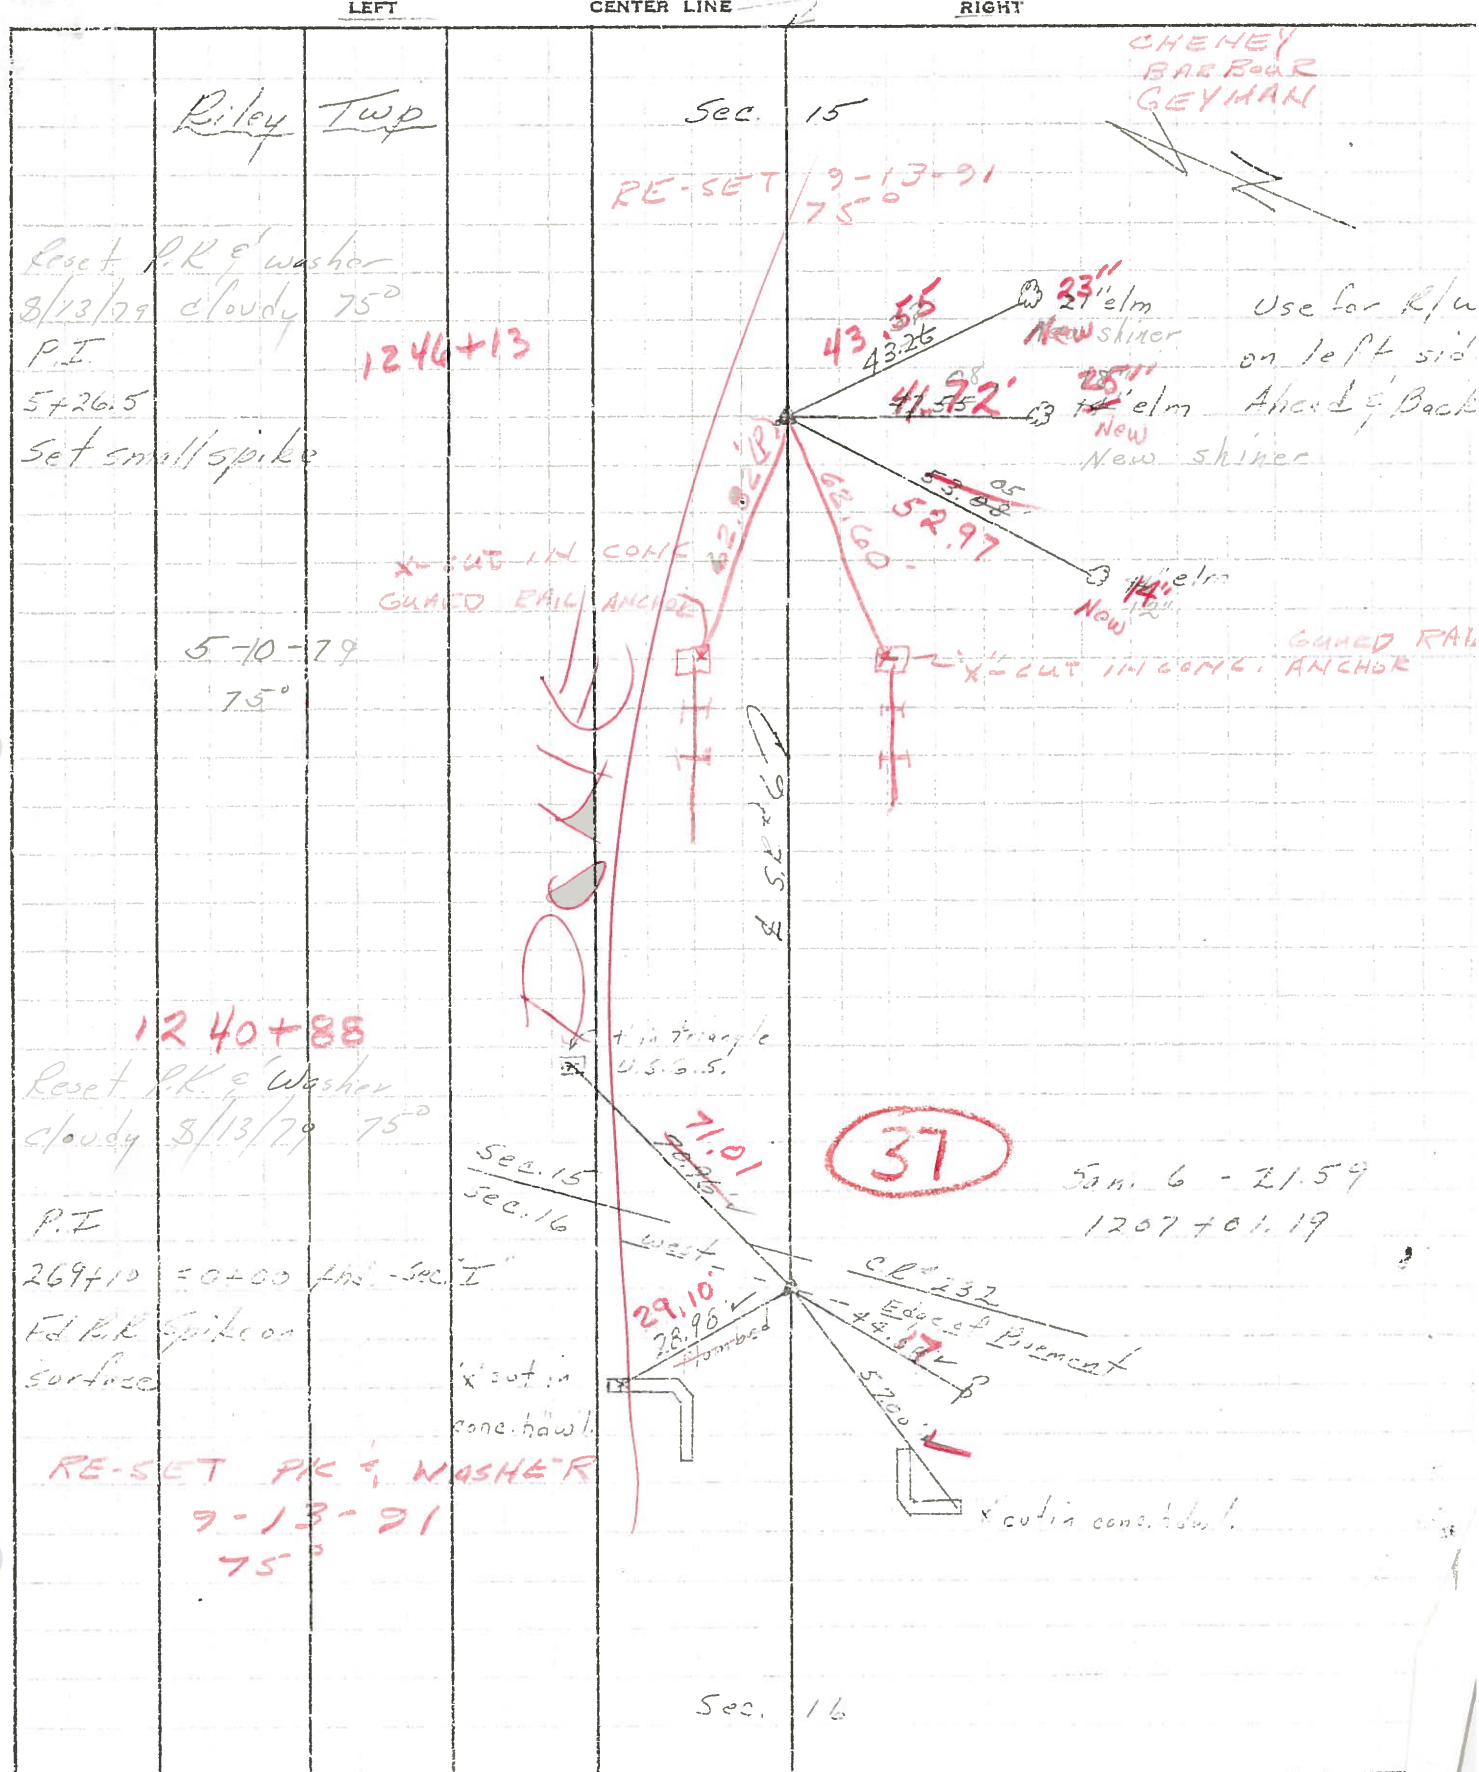

SHEET NO. 7

PERSONNEL

TITLE

PERSONNEL

TITLE

CroninSchneiderCOUNTY SanduskyDATE 7/28/75GeymanMosserS. R. #6WEATHER SunnyBarbourSEC. "F" - Fremont-EastTEMP. 85°DESCRIPTION Ties for Control Points

JOB NO.

LEFT

CENTER LINE

RIGHT

Riley TwpSec. 15

P.I.

5+26.5Set small spike43.2621' elmUse for R/uon left side42.55'14' elmAhead & Back53.0814' elm37

P.I.

269+10 = 0+00 Ahd. - Sec. "I"Ed R.R. Spike on surfaceSec. 15Sec. 16't' in triangleU.S.G.S.20.26'West28.98'Plumbed'x' cut in conc. hdwl.C.R. #232Edge of Pavement14.08'5.700''x' cut in conc. hdwl.San. 6 - 21.591207+01.19Sec. 16

PERSONNEL TITLE PERSONNEL TITLE

Schneider

Potts

COUNTY Sandusky

DATE Dec-1962

Mosser

S. R. U.S. # 6

WEATHER

Barbour

SEC. Fremont-East

TEMP.

Redding

DESCRIPTION Ties for Control Points

JOB NO.

LEFT

CENTER LINE

RIGHT

