

O.D.O.T. DISTRICT 2 SURVEY OFFICE (USE ONLY)

PERSONNEL

REFERENCE NO. 37

SHEET 19 OF 19

NOTES PRESTON-COLVIN

DATE 9-4-24

ROUTE US 6

H.C. NEISE

WEATHER SUNNY

COUNTY SANDUSKY

R.C. BARRIERE

TEMP. 65°

TOWNSHIP RILEY

SECTION 16

DWG BY PRESTON-COLVIN PID PAVING TRAIN

T 5 N R 16 E

TYPE MONUMENT MAG NAIL

ON SURFACE - BELOW ON

OFFSET $\mathcal{Q}$ PAVEMENT ON LT : RT

- TO - EDGE PAVEMENT

STATION: 1233+58

HORIZ.DATUM: NAD83 (2011)


GEOID: NAVD88 2018

GRID: NORTHING: 630774.469


EASTING: 1828088.743

LDP: NORTHING: 326957.7

EASTING: 188246.6

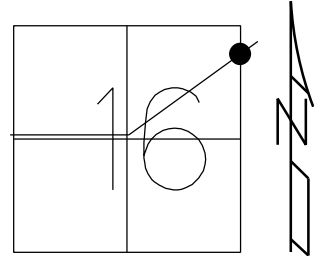

RECORD:
FD MAG NAIL
REF37
N: 630774.469
E: 1828088.743
11/22/17, DCH
FD MAG NAIL
7/26/21, TDN
2/10/22, JFO
FD MAG
REF37
9-4-24, TDN
FD MAG
10/3/24, JAM

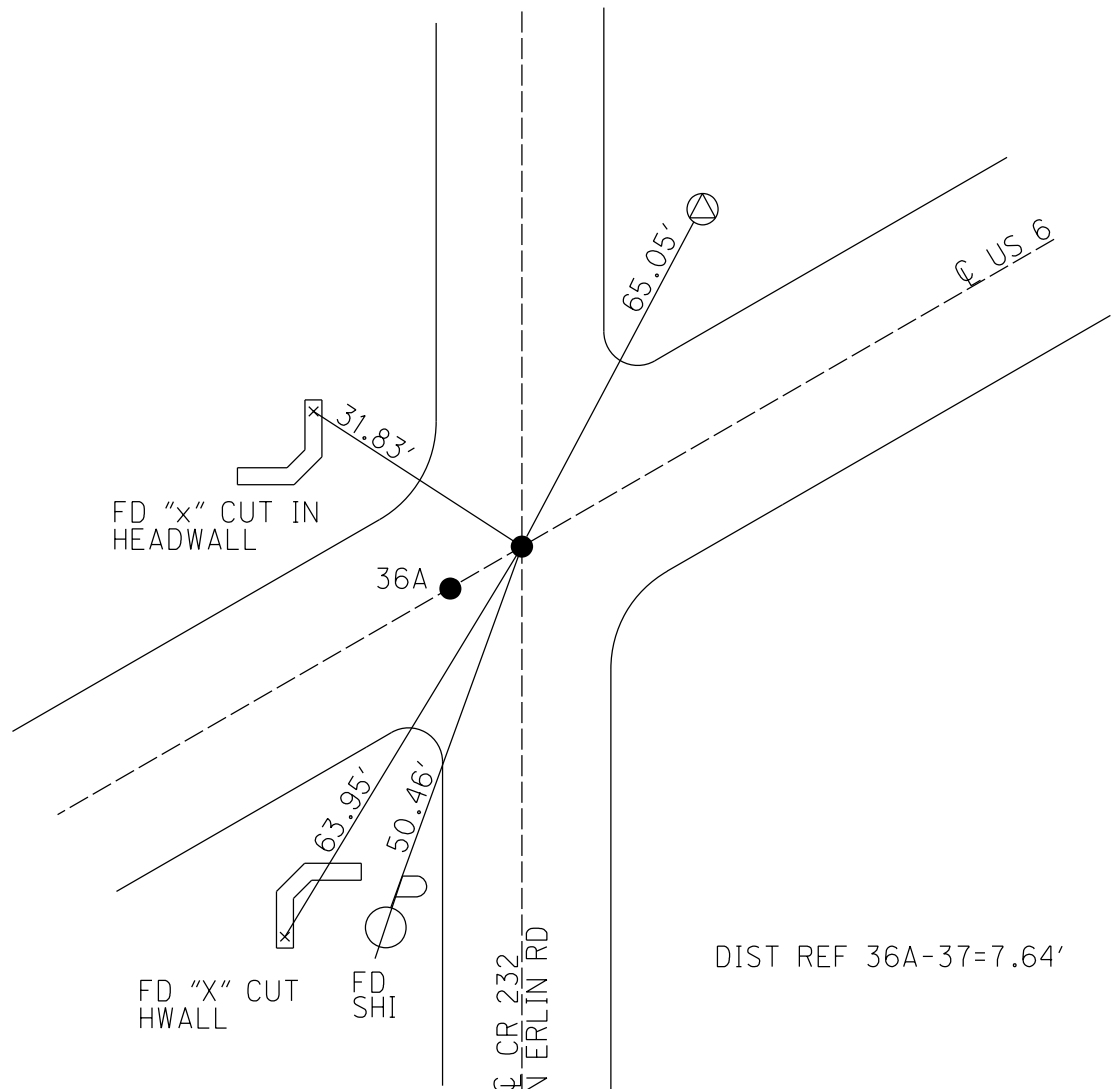

O.D.O.T. DISTRICT 2 SURVEY OFFICE (USE ONLY)

PERSONNEL

REFERENCE NO. 37

SHEET 19 OF 19

NOTES AUBLE

DATE 7/26/21

ROUTE US 6

H.C. NIESE

WEATHER CALM

COUNTY SANDUSKY

R.C. AUBLE

TEMP. 77°

TOWNSHIP RILEY

SECTION 16

DWG BY NIESE

PID 108868

T 5 N R 16 E

TYPE MONUMENT MAG NAIL

ON SURFACE - ~~BELOW~~ ON

OFFSET Q PAVEMENT ON LT : RT

- TO - EDGE PAVEMENT


STATION: 1233+58

HORIZ.DATUM: NAD83 (2011)

GEOID: 2012A

GRID: NORTHING: 630774.469

EASTING: 1828088.743

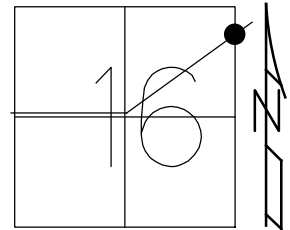

RECORD:

FD MAG NAIL

REFA37

N: 630774.469


E: 1828088.743

11/22/17, DCH

FD MAG NAIL

7/26/21, TDN

2/10/22, JFO

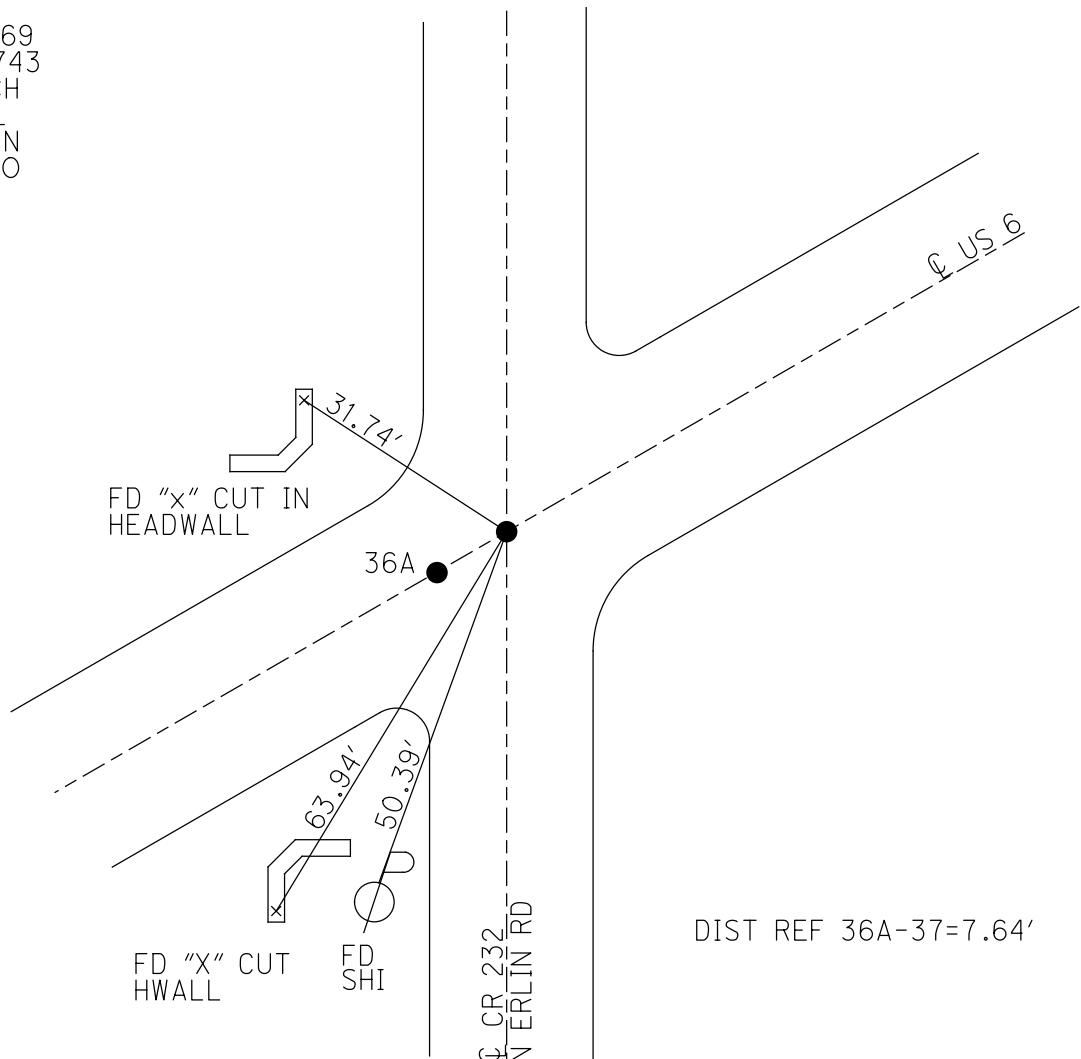

O.D.O.T. DISTRICT 2 SURVEY OFFICE (USE ONLY)

PERSONNEL

REFERENCE NO. 37

SHEET 19 OF 19

NOTES AUBLEDATE 7/26/21ROUTE US 6

H.C. NIESE

WEATHER CALM

COUNTY SANDUSKY

R.C. AUBLE

TEMP. 77°

TOWNSHIP RILEYDWG BY NIESE

PID 108868

T_5_N R_16_E

TYPE MONUMENT MAG NAIL

ON SURFACE - ~~BELOW~~ _____ ON

OFFSET C PAVEMENT ON LT : RT


_____TO_____EDGE PAVEMENT

STATION: 1233+58

HORZ.DATUM: NAD83 (2011)

GEOID: 2012A

GRID: NORTHING: 630774.469

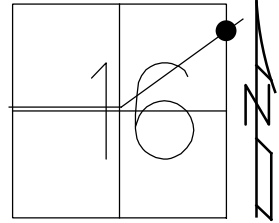EASTING: 1828088.743

RECORD:

FD MAG NAIL

REF A37


N: 630774.469

E: 1828088.743

11/22/17, DCH

FD MAG NAIL

7/26/21, TDN

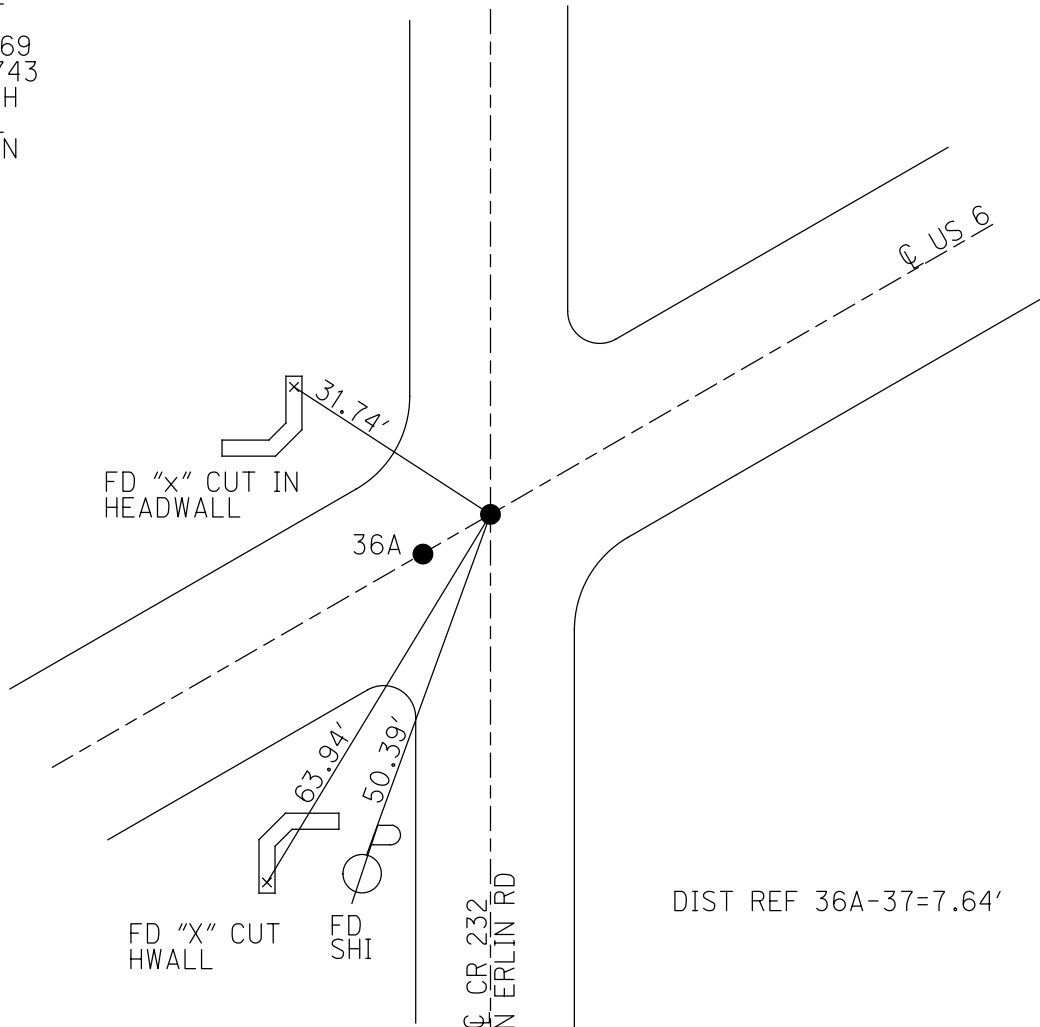

DIST REF 36A-37=7.64'