

O.D.O.T. DISTRICT 2 SURVEY OFFICE (USE ONLY)

PERSONNEL

REFERENCE NO. 37 A

SHEET 1 OF 34

NOTES PRESTON-COLVIN

DATE 9-4-24

ROUTE US 6

H.C. NEISE

WEATHER SUNNY

COUNTY SANDUSKY

R.C. BARRIERE

TEMP. 65°

TOWNSHIP RILEY

SECTION 15

DWG BY PRESTON-COLVIN PID PAVING TRAIN

T 5 N R 16 E

TYPE MONUMENT MAG/WASHER

ON SURFACE - BELOW ON

OFFSET $\varnothing$ PAVEMENT 0.4' LT : RT

- TO - EDGE PAVEMENT

STATION: 1233+58

HORZ.DATUM: NAD83 (2011)


GEOID: NAVD88 2018

GRID: NORTHING: 630956.552


EASTING: 1828574.771

LDP: NORTHING: 327143.1

EASTING: 188731.5

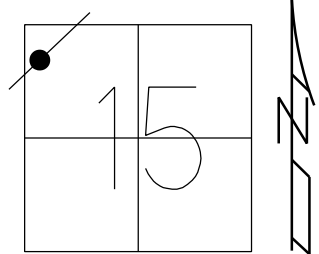

RECORD: P.I.
 OLD STA 5+26.5
 P.K./WASHER
 SMALL SPIKE
 FD P.K./WASHER
 3/16/02, DCH
 SET P.K./WASHER
 6/9/02, DCH
 FD P.K./WASHER
 REFB37
 11/22/17, DCH
 8/1/18, JLL
 SET MAG/WASHER
 7/31/19, JLL
 FD MAG/WASHER
 7/26/21, TDN
 SET MAG/WASHER
 1/28/22, TDN
 FD MAG/WASHER
 REF37A
 9-4-24, TDN
 FD MAG/WASHER
 10-3-24, JAM

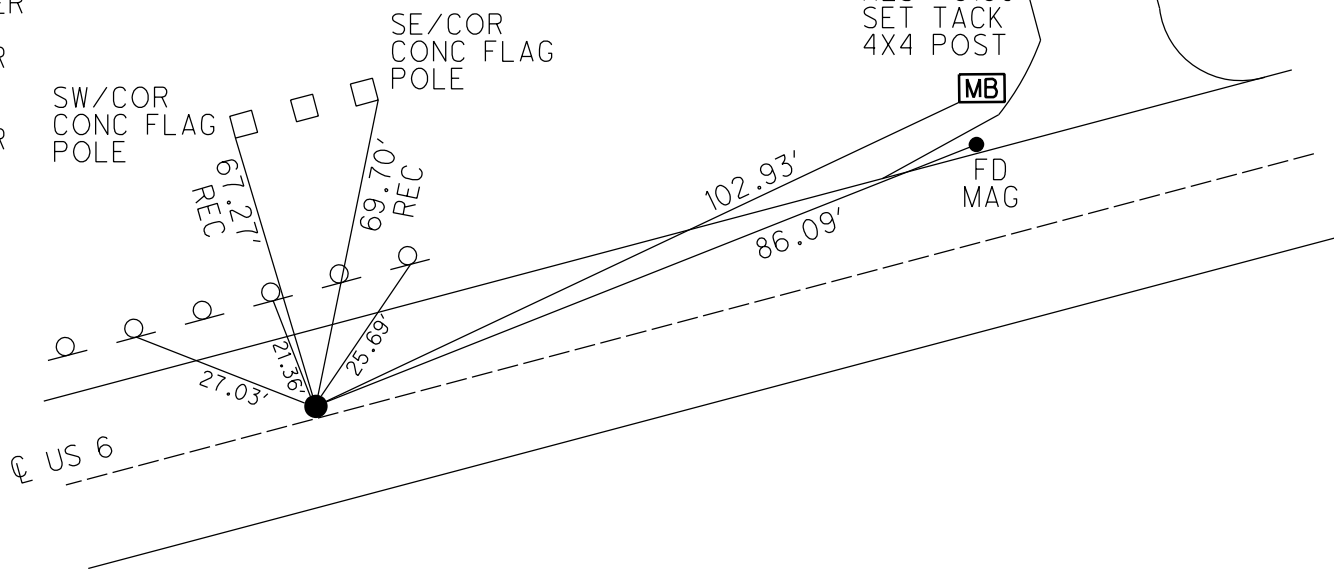

O.D.O.T. DISTRICT 2 SURVEY OFFICE (USE ONLY)

PERSONNEL

REFERENCE NO. 37 A

SHEET 1 OF 34

NOTES AUBLE

DATE 7/26/21

ROUTE US 6

H.C. NIESE

WEATHER CALM

COUNTY SANDUSKY

R.C. AUBLE

TEMP. 72°

TOWNSHIP RILEY

DWG BY NIESE

PID 108868

SECTION 15

T 5 N R 16 E

TYPE MONUMENT MAG/WASHER

ON SURFACE - ~~BELOW~~ ON

OFFSET Q PAVEMENT 0.4' LT : ~~RT~~

- TO - EDGE PAVEMENT


STATION: 1246+13

HORZ.DATUM: NAD83 (2011)


GEOID: NAVD88 2012A

GRID: NORTHING: 630956.552

EASTING: 1828574.771

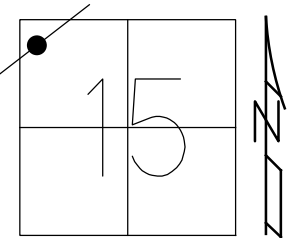

RECORD: P.I.
OLD STA 5+26.5
P.K./WASHER
SMALL SPIKE
FD P.K./WASHER
3/16/02, DCH
SET P.K./WASHER
6/9/02, DCH
FD P.K./WASHER
REFB37
11/22/17, DCH
8/1/18, JLL
SET MAG/WASHER
7/31/19, JLL
FD MAG/WASHER
7/26/21, TDN
SET MAG/WASHER
1/28/22, TDN

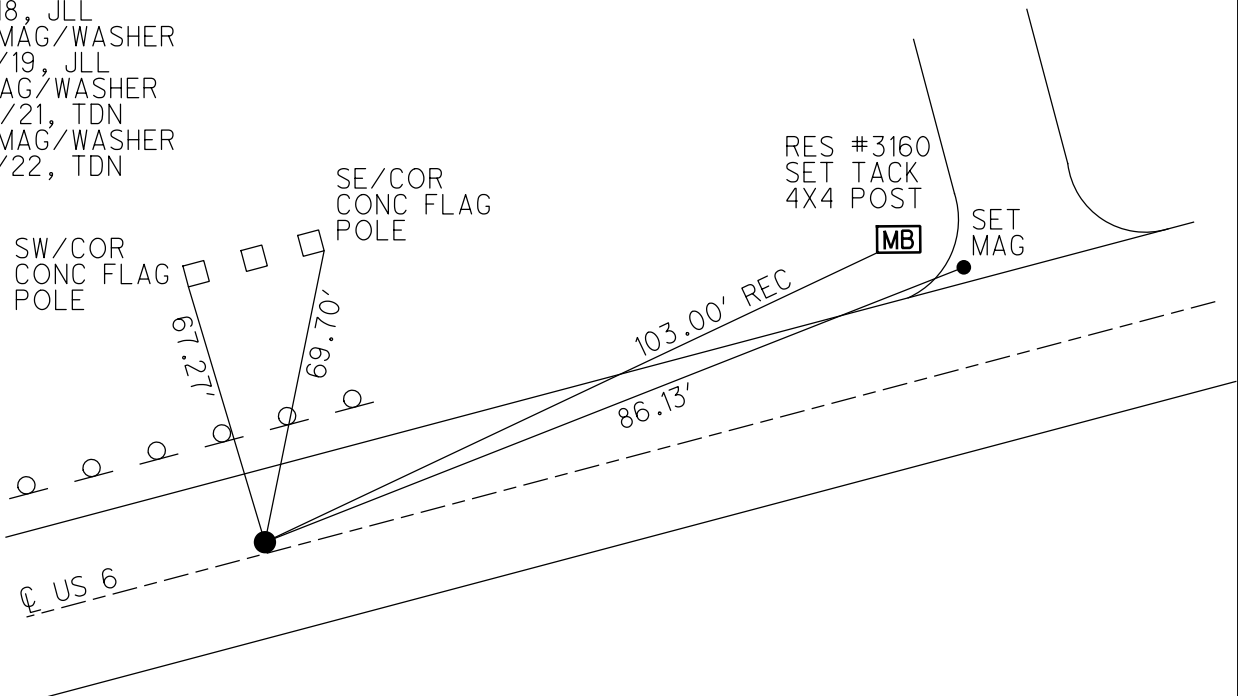

86.13'

O.D.O.T. DISTRICT 2 SURVEY OFFICE (USE ONLY)

PERSONNEL

REFERENCE NO. 37 A

SHEET 1 OF 34

NOTES LEU

DATE 8/1/18

ROUTE US 6

H.C. LEU

WEATHER CLOUDY

COUNTY SANDUSKY

R.C. TRENKA

TEMP. 71°

TOWNSHIP RILEY

DWG BY AUBLE

PID 95769

SECTION 15

T 5 N R 16 E

TYPE MONUMENT P.K./WASHER

ON SURFACE - ~~BELOW~~ ON

OFFSET 0.4' LT : RT

- TO - EDGE PAVEMENT


STATION: 1246+13

HORZ.DATUM: NAD83 (2011)


GEOID: 2012A

GRID: NORTHING: 630956.552

EASTING: 1828574.771

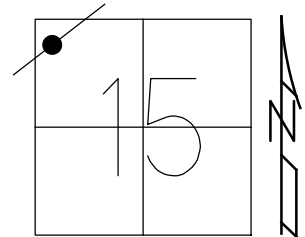


RECORD: P.I.
OLD STA 5+26.5
PREVIOUS MONUMENTS:
P.K./WASHER
SMALL SPIKE
FD P.K./WASHER
3/16/02, DCH
SET PK/WASHER
6/9/02 DCH
FD P.K./WASHER
REFB37
11/22/17, DCH
SET MAG/WASHER
7/31/19, JLL

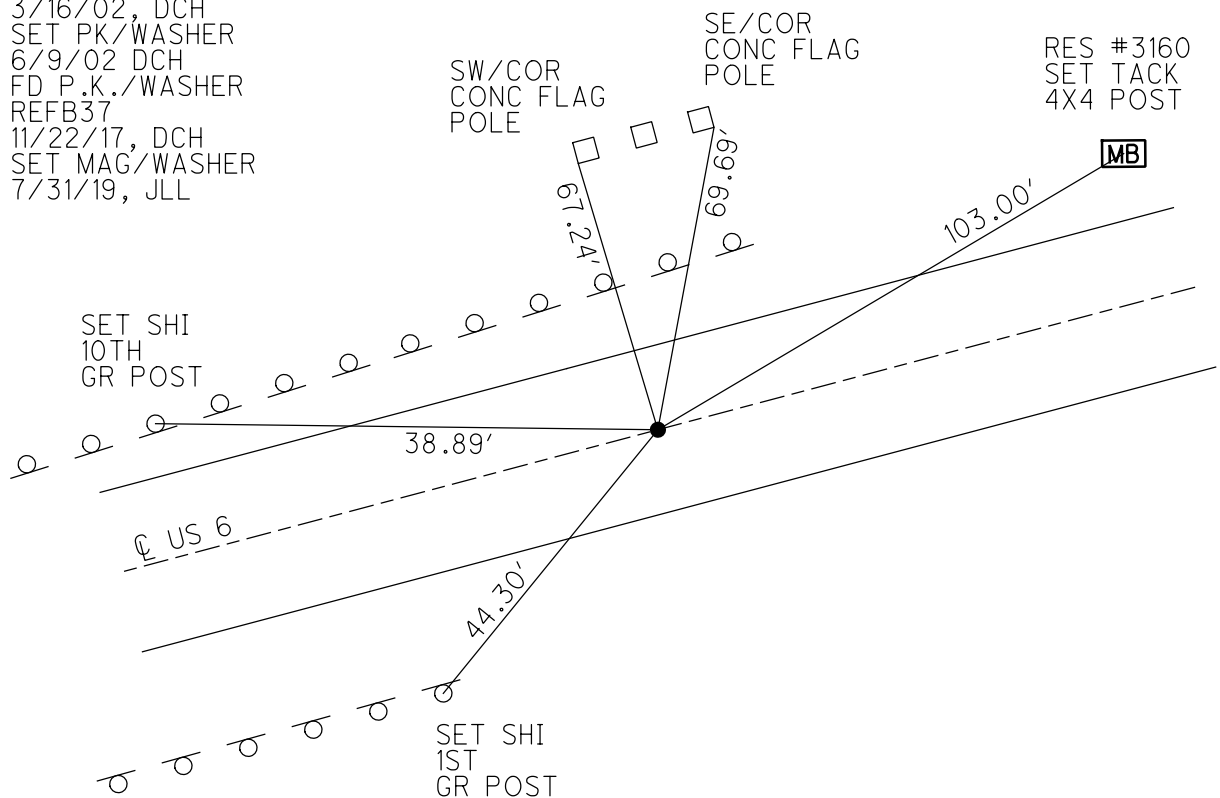


O.D.O.T. DISTRICT 2 SURVEY OFFICE (USE ONLY)

PERSONNEL	REFERENCE NO.	37 A	SHEET	1	OF	31
NOTES	ROUSOS	DATE	03/16/02	ROUTE	US 6	
H.C.	VAN DUSEN	WEATHER	WINDY	COUNTY	SANDUSKY	
R.C.	MOSSER	TEMP.	28°	TOWNSHIP	RILEY	
	HOMAN			SECTION	15	
				T	5	N R 16 E

TYPE MONUMENT PK/WASHER
ON SURFACE - ~~BELOW~~ ON
LEFT - ℄ PAV'T - ~~RIGHT~~ 0.5'
- TO - EDGE PAVEMENT
S.L.M. 1246+13
GRID: NORTHING: - EASTING: -

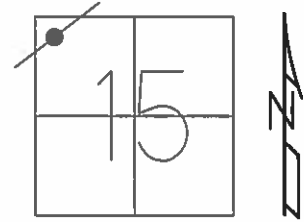

RECORD: PI
OLD STA 5+26.5
PREVIOUS MONUMENTS:
PK/WASHER
SMALL SPIKE
SET PK/WASHER
06/09/02 DCH

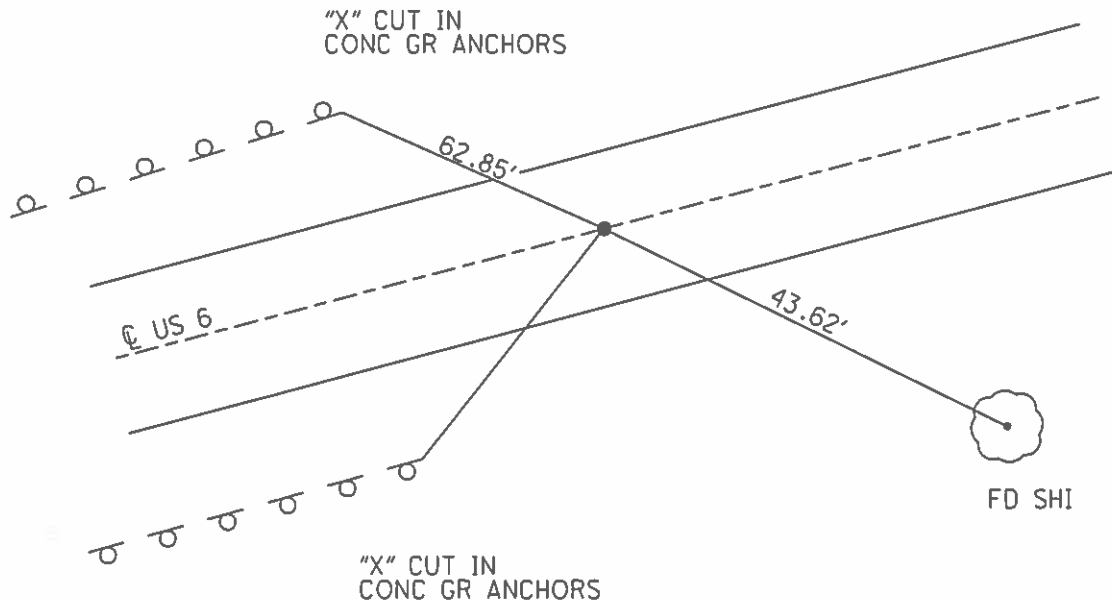

O.D.O.T. DISTRICT 2 SURVEY OFFICE

PERSONNEL

REFERENCE NO. _____

SHEET 14 OF 39

NOTES CHENEY

H.C. BARRON

R.C. GEYMAN

DATE 9-13-1991

WEATHER SUNNY

TEMP. 75°

ROUTE 6

COUNTY SANDUSKY

TOWNSHIP RILEY

SECTION 15

T 5 N R 16 E

TYPE MONUMENT P.K. / WASHER


ON SURFACE - BELOW

LEFT - & PAV'T. - RIGHT

 TO EDGE PAVEMENT

S.L.M. 1246+13

37A

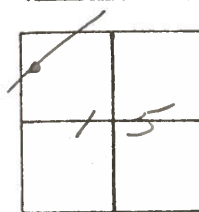


PREVIOUS MONUMENTS:

P.K. / WASHER

SMALL SPIKE

P.I.

OLD STA. = 5+26.5

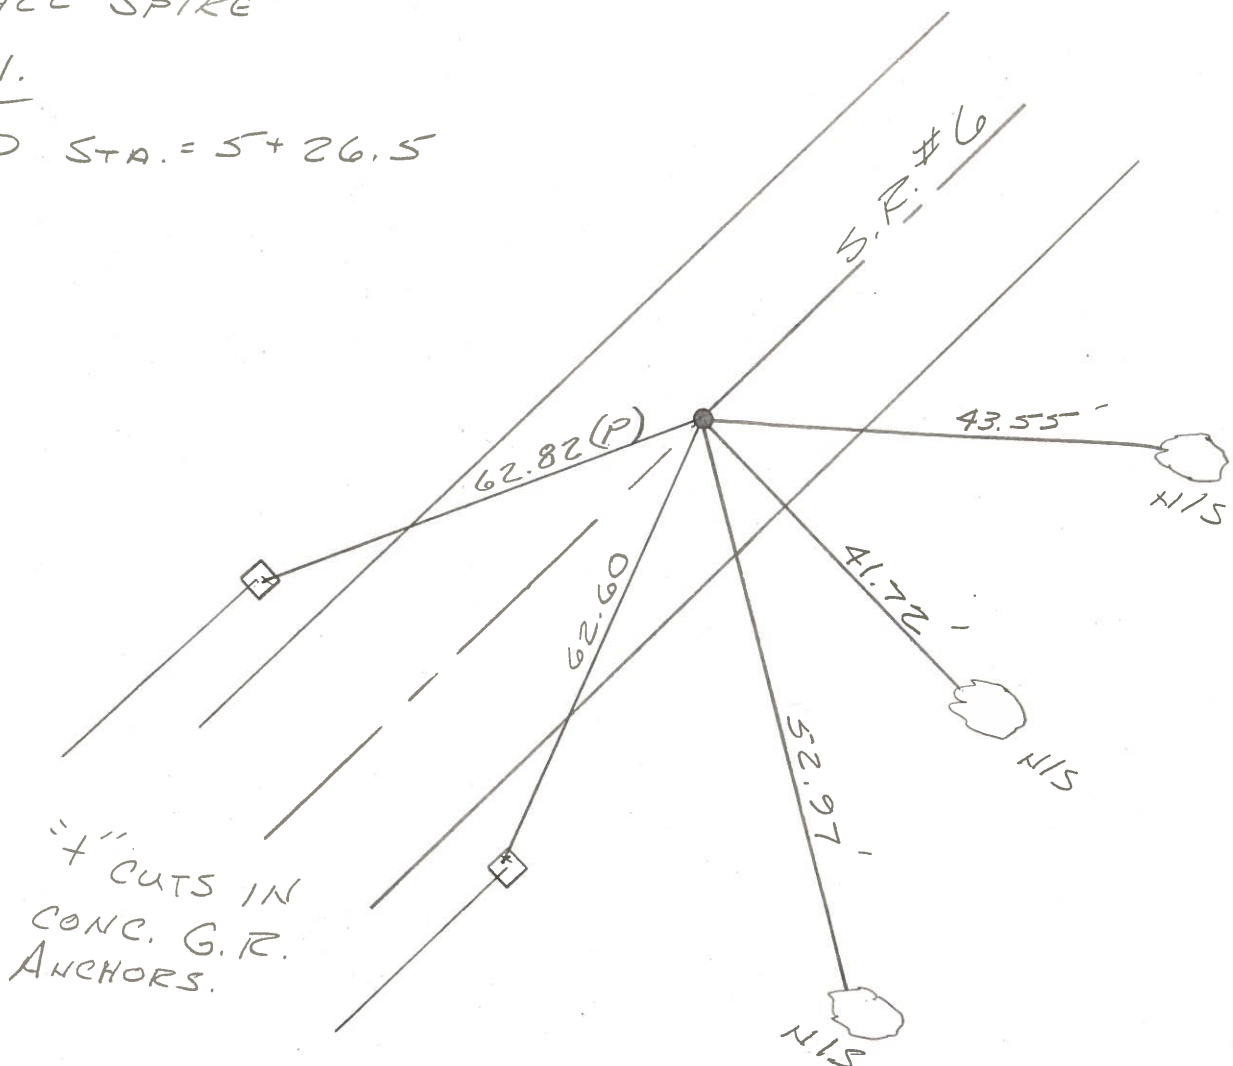

PERSONNEL	TITLE	PERSONNEL	TITLE
Green		Schneider	
Geyman		Mosser	
		Barbour	

COUNTY SandwichDATE 7/28/95S. R. #6WEATHER SunnySEC. "4" - Fremont - EastTEMP. 75°DESCRIPTION Ties for Control Points

JOB NO.

