

O.D.O.T. DISTRICT 2 SURVEY OFFICE (USE ONLY)

PERSONNEL

REFERENCE NO. 38 AA

SHEET 4 OF 34

NOTES PRESTON-COLVIN

DATE 9-4-24

ROUTE US 6

H.C. NEISE

WEATHER SUNNY

COUNTY SANDUSKY

R.C. BARRIERE

TEMP. 68°

TOWNSHIP RILEY

SECTION 15

DWG BY PRESTON-COLVIN PID PAVING TRAIN

T 5 N R 16 E

TYPE MONUMENT MAG/WASHER

ON SURFACE - BELOW ON

OFFSET Q PAVEMENT ON LT : RT

11.4' TO RT EDGE PAVEMENT

STATION: 1306+95.85

HORIZ.DATUM: NAD83 (2011)


GEOID: NAVD88 2018

GRID: NORTHING: 633708.080


EASTING: 1834012.783

LDP: NORTHING: 329932.2

EASTING: 194150.7

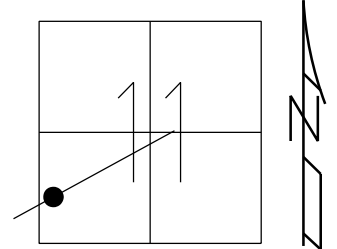

RECORD:
FD MAG NAIL
REFAA37
11/22/17, JLL
SET MAG/WASHER
7/20/22, JMR
FD MAG/WASHER
1/20/23, JMR
FD MAG/WASHER
REF38AA
9-4-24, TDN
FD MAG/WASHER
10-3-24, JAM

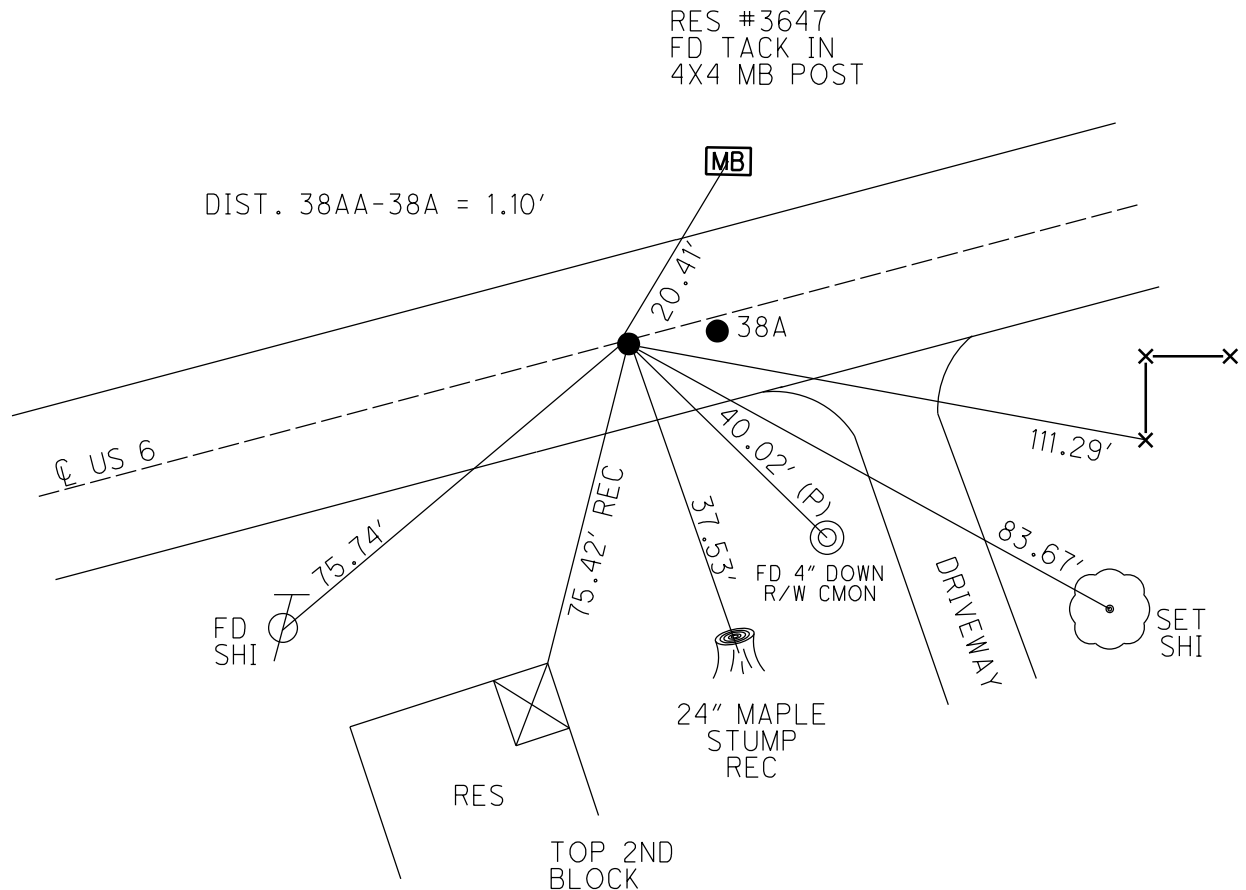

O.D.O.T. DISTRICT 2 SURVEY OFFICE (USE ONLY)

PERSONNEL

REFERENCE NO. 38 AA

SHEET 4 OF 34

NOTES RHOADES

DATE 7/20/22

ROUTE US 6

H.C. RHOADES

WEATHER CLOUDY

COUNTY SANDUSKY

R.C. WHITAKER

TEMP. 82°

TOWNSHIP RILEY

SECTION 15

DWG BY RHOADES

PID PAVETRAIN

T 5 N R 16 E

TYPE MONUMENT MAG/WASHER

ON SURFACE - ~~BELOW~~ ON

OFFSET Q PAVEMENT ON ~~LT~~ : ~~RT~~

11.4' TO RT EDGE PAVEMENT


STATION: 1306+95.85

HORIZ.DATUM: NAD83 (2011)

GEOID: 2012A

GRID: NORTHING: 633708.080

EASTING: 1834012.783

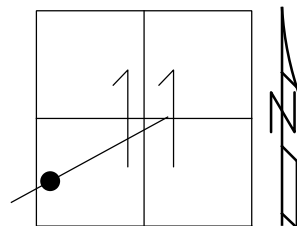

RECORD:

FD MAG NAIL

REFAA37

11/22/17, JLL


SET MAG/WASHER

7/20/22, JMR

FD MAG/WASHER

1/20/23, JMR

RES #3647
FD TACK IN
4X4 MB POST

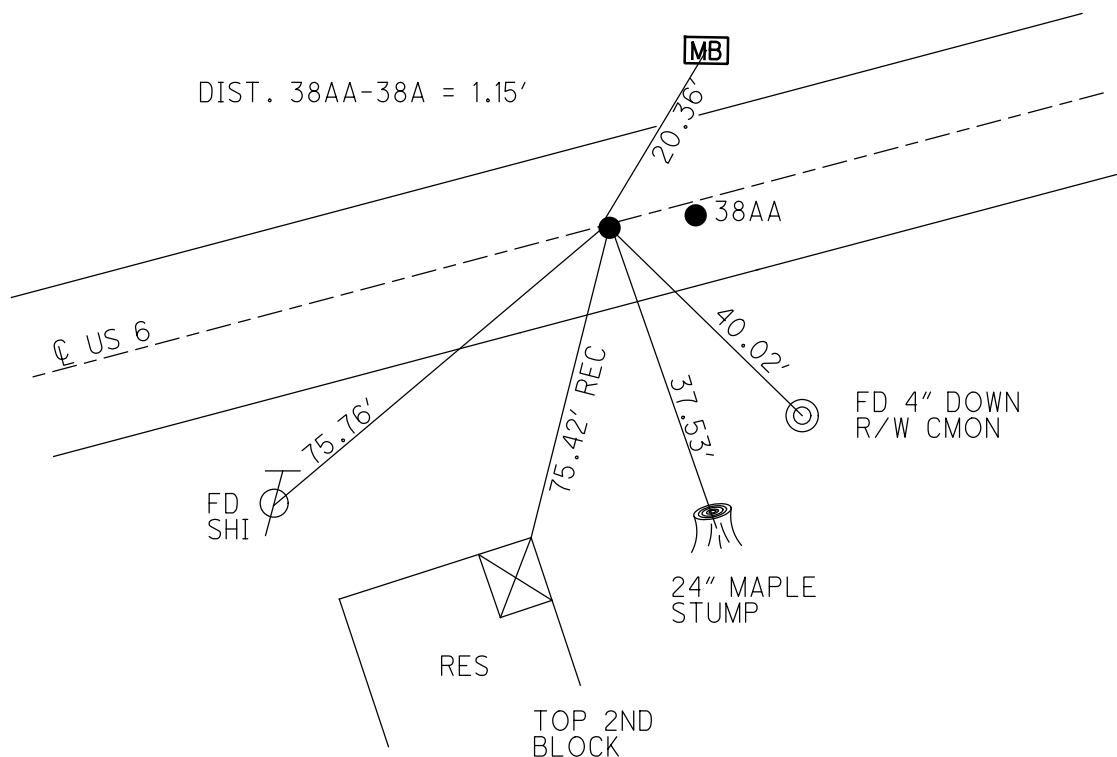

O.D.O.T. DISTRICT 2 SURVEY OFFICE (USE ONLY)

PERSONNEL

REFERENCE NO. 38 AA

SHEET 4 OF 34

NOTES RHOADES

DATE 7/20/22

ROUTE US 6

H.C. RHOADES

WEATHER CLOUDY

COUNTY SANDUSKY

R.C. WHITAKER

TEMP. 82°

TOWNSHIP RILEY

DWG BY RHOADES PID PAVE TRAIN

SECTION 15

T 5 N R 16 E

TYPE MONUMENT MAG/WASHER

ON SURFACE - ~~BELOW~~ ON

OFFSET CL PAVEMENT ON ~~LT~~ : ~~RT~~

11.4' TO RT EDGE PAVEMENT


STATION: 1306+95.85

HORZ.DATUM: NAD83 (2011)


GEOID: 2012A

GRID: NORTHING: 633708.080

EASTING: 1834012.783

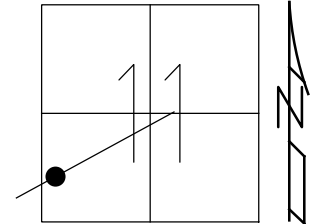

RECORD:
FD MAG NAIL
REFAA37
11/22/17, JLL
SET MAG/WASHER
7/20/22, JMR

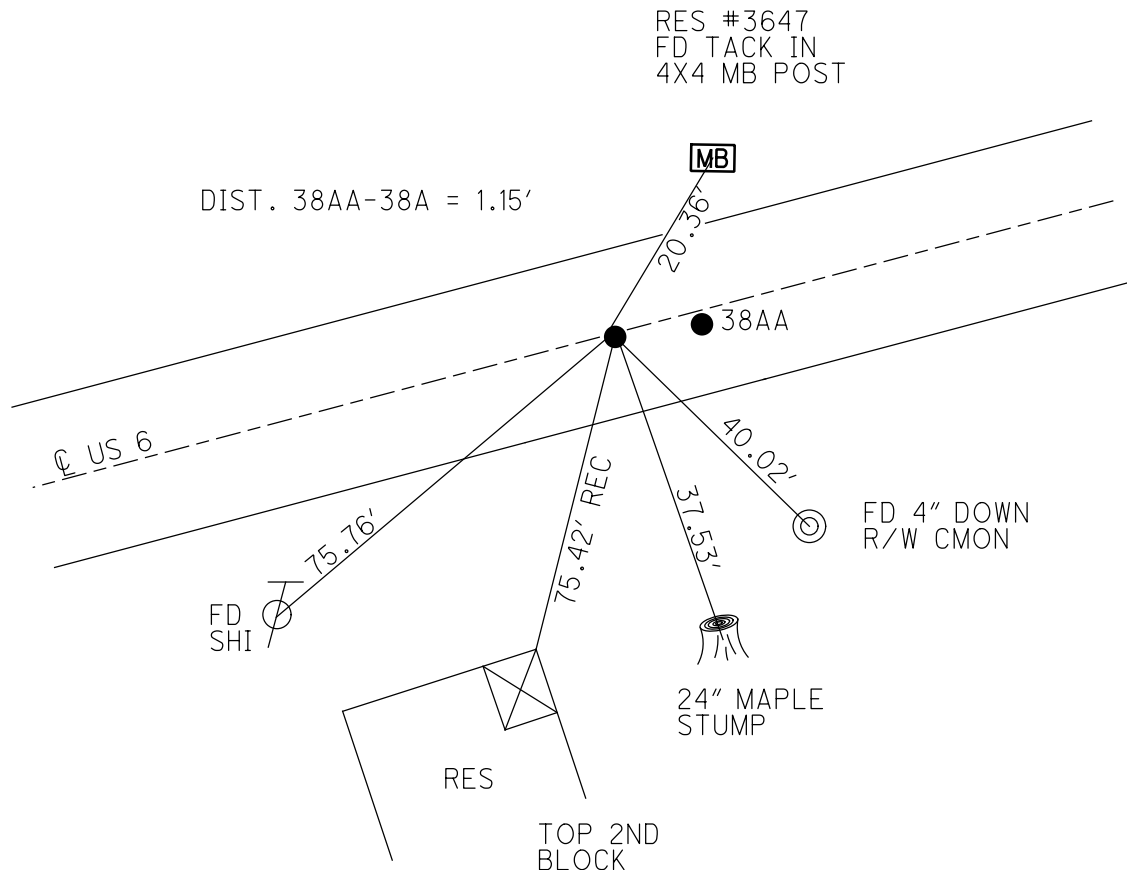

O.D.O.T. DISTRICT 2 SURVEY OFFICE (USE ONLY)

PERSONNEL

REFERENCE NO. 38 AA

SHEET 4 OF 34

NOTES LEU

DATE 8/1/18

ROUTE US 6

H.C. LEU

WEATHER CLOUDY

COUNTY SANDUSKY

R.C. TRENKA

TEMP. 84°

TOWNSHIP RILEY

SECTION 15

DWG BY AUBLE

PID 95769

T 5 N R 16 E

TYPE MONUMENT MAG NAIL

ON SURFACE - ~~BELOW~~ ON

OFFSET Q PAVEMENT ON ~~LT~~ : ~~RT~~

11.4' TO RT EDGE PAVEMENT


STATION: 1306+95.85

HORZ.DATUM: NAD83 (2011)


GEOID: 2012A

GRID: NORTHING: 633708.080

EASTING: 1834012.783

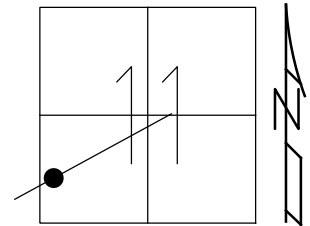

RECORD:
FD MAG NAIL
REFAA37
11/22/17, JLL

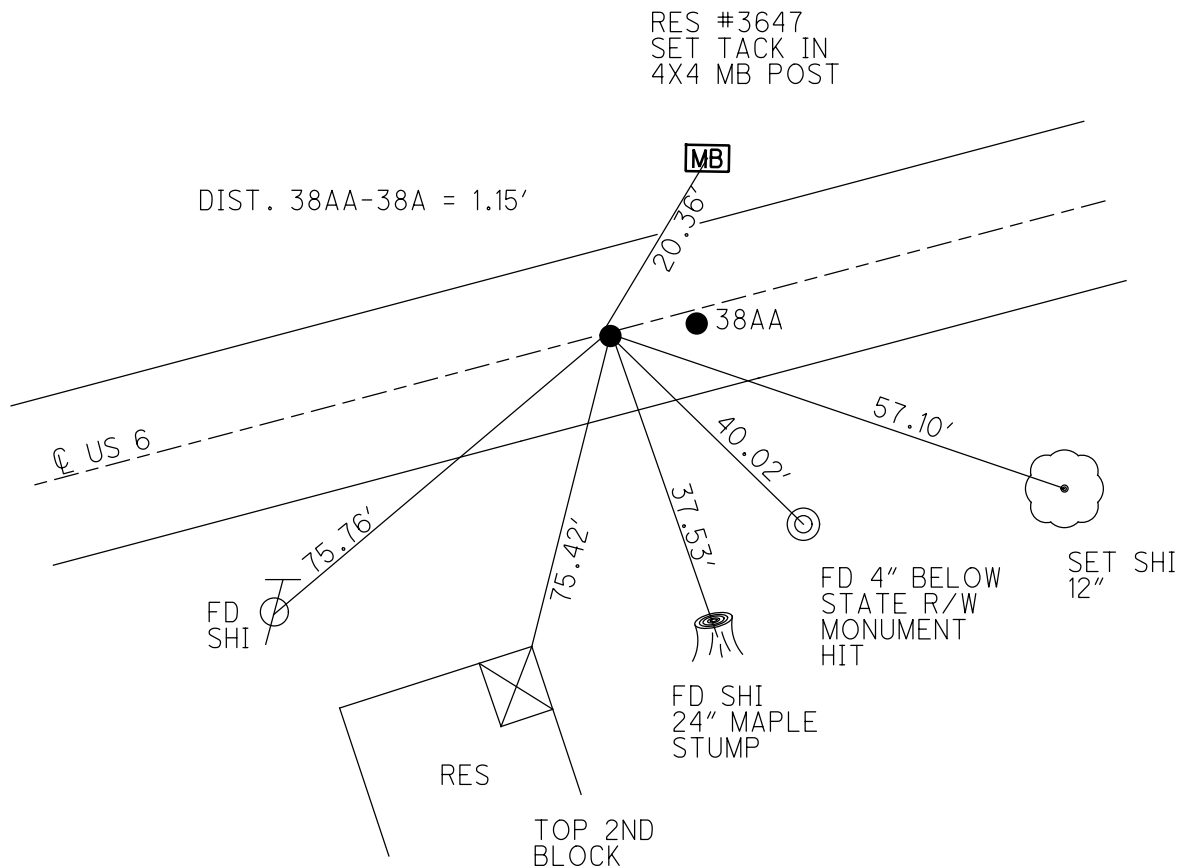

O.D.O.T. DISTRICT 2 SURVEY OFFICE (USE ONLY)

PERSONNEL

REFERENCE NO. 38 AA

SHEET 4 OF 34

NOTES LEU

DATE 8/1/18

ROUTE US 6

H.C. LEU

WEATHER CLOUDY

COUNTY SANDUSKY

R.C. TRENKA

TEMP. 84°

TOWNSHIP RILEY

DWG BY AUBLE PID 95769

SECTION 15

T 5 N R 16 E

TYPE MONUMENT MAG NAIL

ON SURFACE - ~~BELOW~~ ON

OFFSET Q PAVEMENT ON ~~LT~~ : ~~RT~~

11.4' TO RT EDGE PAVEMENT


STATION: 1306+95.85

HORIZ.DATUM: NAD83 (2011)

GEOID: 2012A

GRID: NORTHING: 633708.080

EASTING: 1834012.783

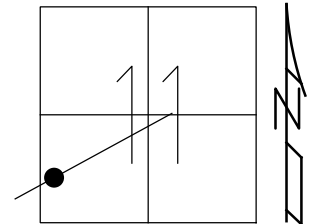

RECORD:
FD MAG NAIL
REFAA37
11/22/17, JLL

