

O.D.O.T. DISTRICT 2 SURVEY OFFICE (USE ONLY)

PERSONNEL

REFERENCE NO. 38 A

SHEET 5 OF 34

NOTES PRESTON-COLVIN

DATE 9-4-24

ROUTE US 6

H.C. NEISE

WEATHER SUNNY

COUNTY SANDUSKY

R.C. BARRIERE

TEMP. 68°

TOWNSHIP RILEY

SECTION 15

DWG BY PRESTON-COLVIN PID PAVING TRAIN

T 5 N R 16 E

TYPE MONUMENT MAG/WASHER

ON SURFACE - BELOW ON

OFFSET $\angle$ PAVEMENT ON RT : RT

11.4' TO RT EDGE PAVEMENT

STATION: 1306+97

HORZ.DATUM: NAD83 (2011)


GEOID: NAVD88 2018

GRID: NORTHING: 633708.682


EASTING: 1834013.681

LDP: NORTHING: 329932.8

EASTING: 194151.6

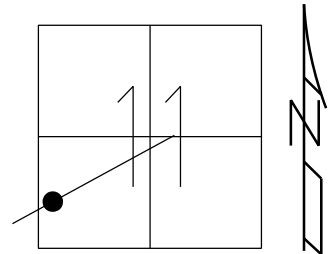

RECORD: P.I.
PREVIOUS MONUMENTS:
SM SPIKE/WASHER
P.K./WASHER
STA. 66+29.58
FD P.K./WASHER
3" DOWN
3/16/02, DCH
SET P.K./WASHER
6/9/02, DCH
SET MAG/WASHER
8-2-19, JLL
FD MAG/WASHER
7/20/22,
1/20/23, JMR
FD MAG/WASHER
REF38AA
9-4-24, TDN
FD MAG/WASHER
10-3-24, JAM

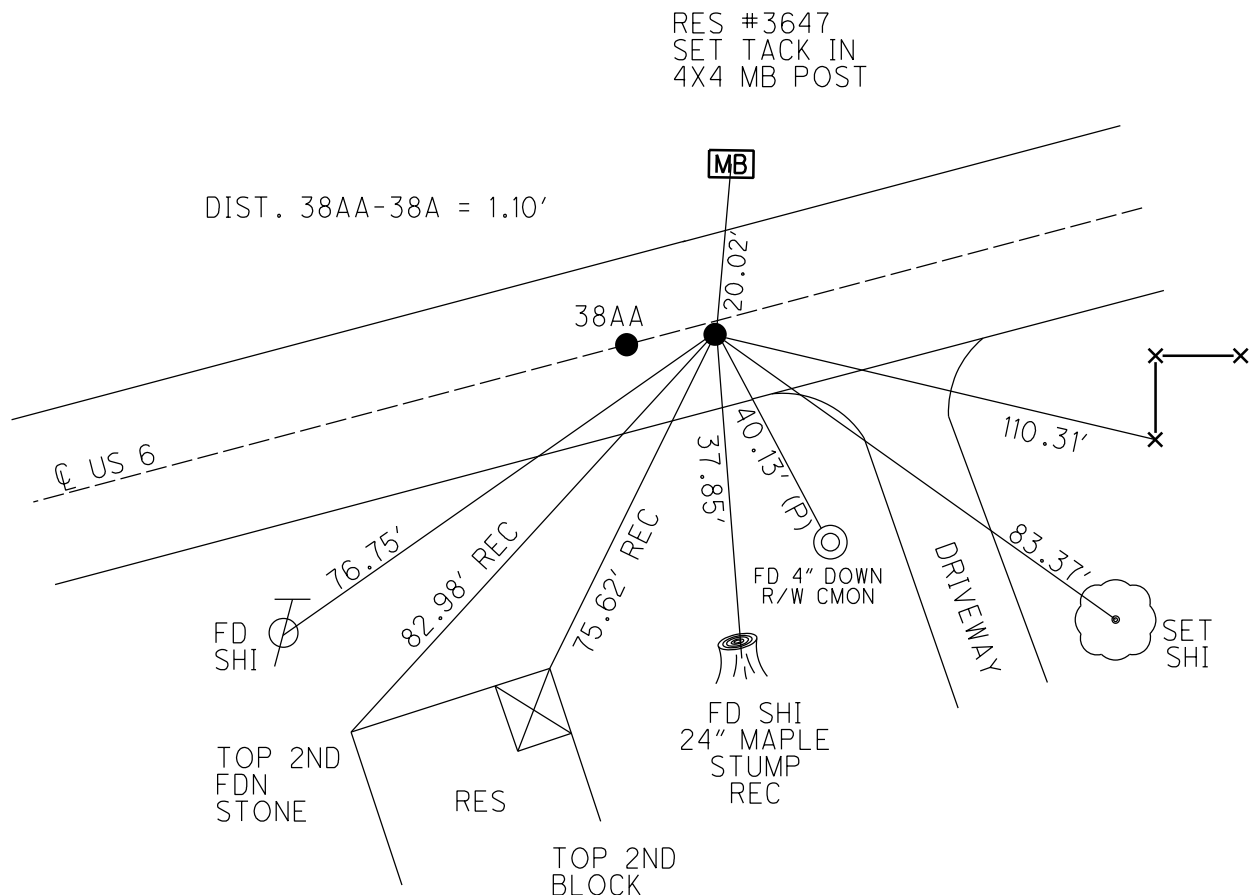

O.D.O.T. DISTRICT 2 SURVEY OFFICE (USE ONLY)

PERSONNEL

REFERENCE NO. 38 A

SHEET 5 OF 34

NOTES LEU

DATE 8/1/18

ROUTE US 6

H.C. LEU

WEATHER CLOUDY

COUNTY SANDUSKY

R.C. TRENKA

TEMP. 84°

TOWNSHIP RILEY

SECTION 15

DWG BY AUBLE

PID PAVETRAIN

T 5 N R 16 E

TYPE MONUMENT P.K./WASHER

ON SURFACE - ~~BELOW~~ ON

OFFSET 11.4' TO RT EDGE PAVEMENT LT : RT


STATION: 1306+97

HORIZ.DATUM: NAD83 (2011)

GEOID: 2012A


GRID: NORTHING: 633708.682

EASTING: 1834013.681

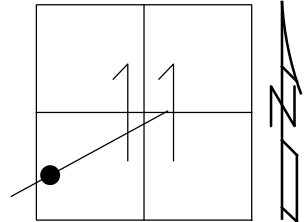

RECORD: P.I.
PREVIOUS MONUMENTS:
SM SPIKE/WASHER
P.K./WASHER
STA. 66+29.58
FD P.K./WASHER
3" DOWN
3/16/02, DCH
SET P.K./WASHER
6/9/02, DCH
SET MAG/WASHER
8-2-19, JLL
FD MAG/WASHER
7/20/22,
1/20/23, JMR

DIST. 38AA-38A = 1.15'

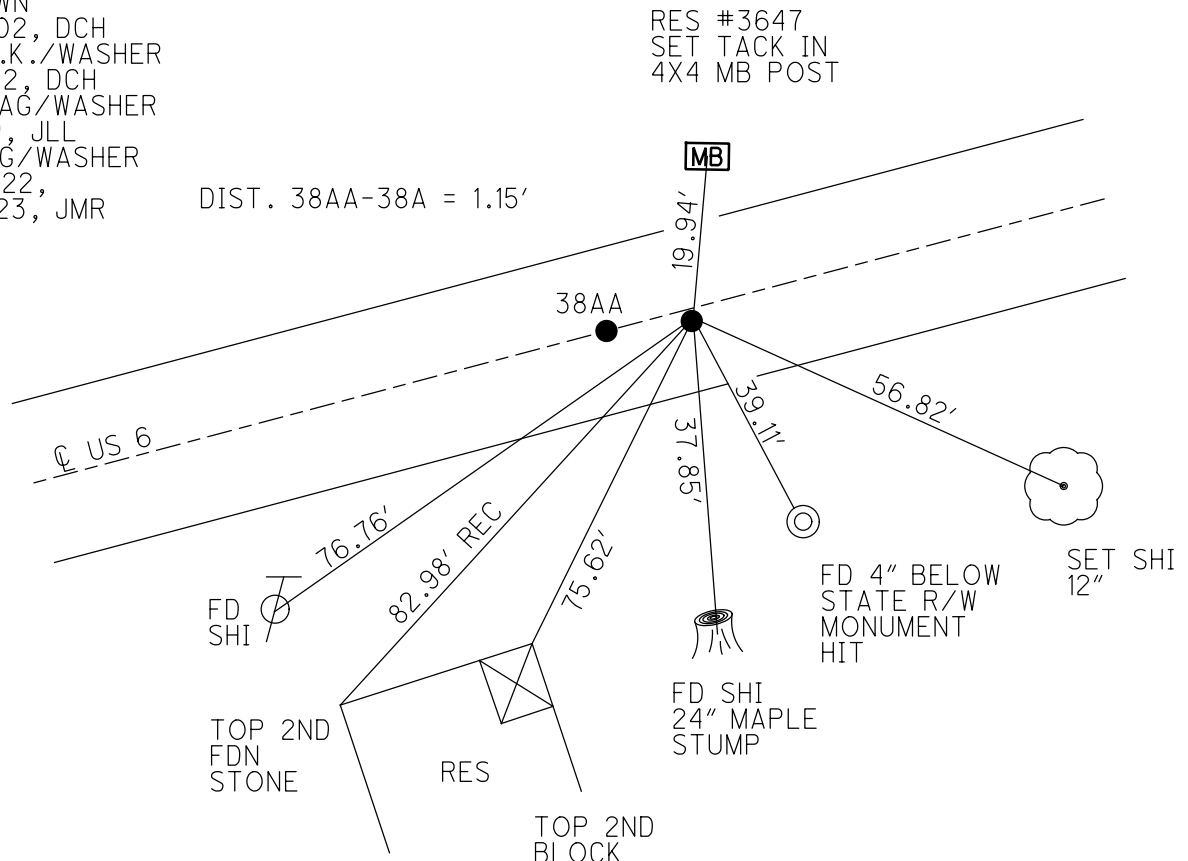

O.D.O.T. DISTRICT 2 SURVEY OFFICE (USE ONLY)

PERSONNEL

REFERENCE NO. 38 A

SHEET 5 OF 34

NOTES LEU

DATE 8/1/18

ROUTE US 6

H.C. LEU

WEATHER CLOUDY

COUNTY SANDUSKY

R.C. TRENKA

TEMP. 84°

TOWNSHIP RILEY

SECTION 15

DWG BY AUBLE

PID 95769

T 5 N R 16 E

TYPE MONUMENT P.K./WASHER

ON SURFACE - ~~BELOW~~ ON

OFFSET Q PAVEMENT ON ~~LT~~ : ~~RT~~

11.4' TO RT EDGE PAVEMENT


STATION: 1306+97

HORZ.DATUM: NAD83 (2011)

GEOID: 2012A

GRID: NORTHING: 633708.682


EASTING: 1834013.681

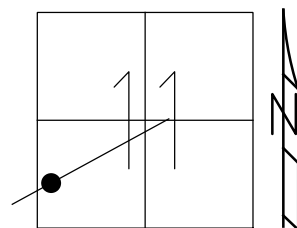

RECORD: P.I.
PREVIOUS MONUMENTS:
SM SPIKE/WASHER
P.K./WASHER
STA. 66+29.58
FD P.K./WASHER
3" DOWN
3/16/02, DCH
SET P.K./WASHER
6/9/02, DCH
SET MAG/WASHER
8-2-19, JLL
FD MAG/WASHER
7/20/22, JMR

DIST. 38AA-38A = 1.15'

RES #3647
SET TACK IN
4X4 MB POST

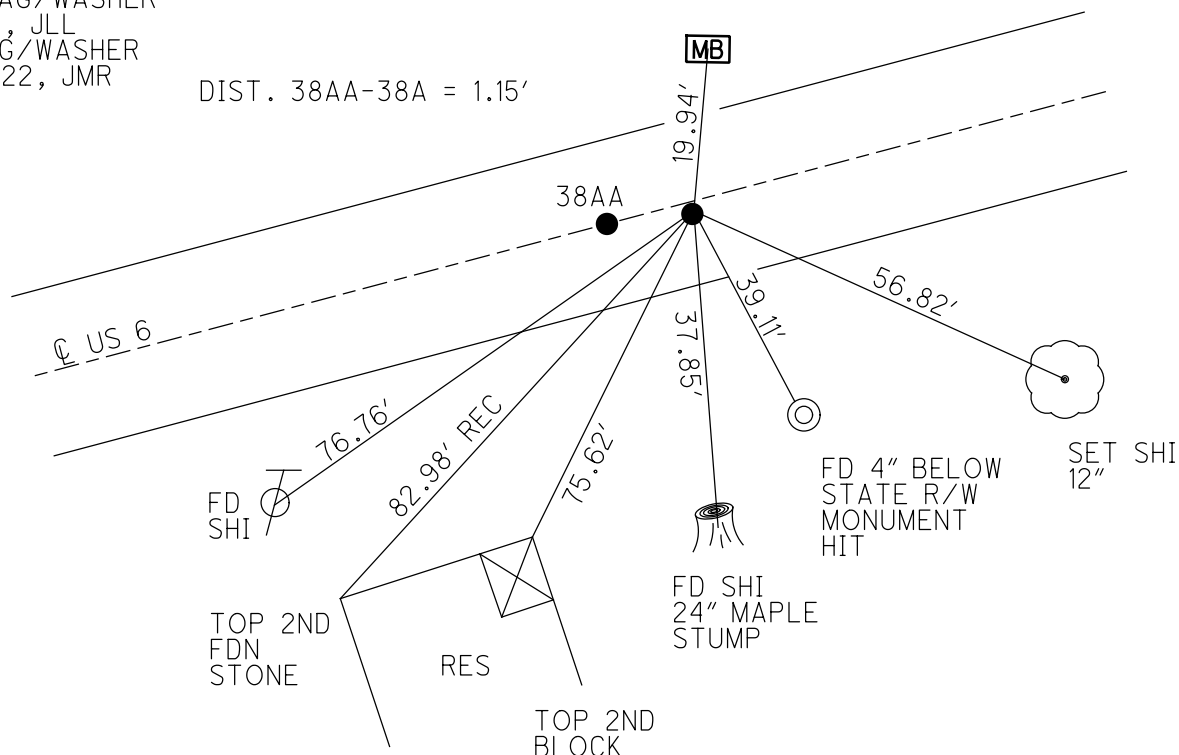

O.D.O.T. DISTRICT 2 SURVEY OFFICE (USE ONLY)

PERSONNEL

REFERENCE NO. 38 A

SHEET 5 OF 34

NOTES LEU

DATE 8/1/18

ROUTE US 6

H.C. LEU

WEATHER CLOUDY

COUNTY SANDUSKY

R.C. TRENKA

TEMP. 84°

TOWNSHIP RILEY

SECTION 15

DWG BY AUBLE PID 95769

T 5 N R 16 E

TYPE MONUMENT P.K./WASHER

ON SURFACE - ~~BELOW~~ ON

OFFSET Q PAVEMENT ON ~~LT~~ : ~~RT~~

11.4' TO RT EDGE PAVEMENT


STATION: 1306+97

HORZ.DATUM: NAD83 (2011)

GEOID: 2012A


GRID: NORTHING: 633708.682

EASTING: 1834013.681

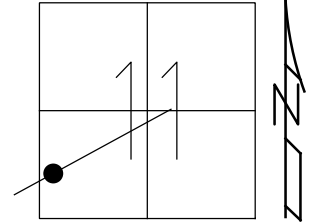

RECORD: P.I.
PREVIOUS MONUMENTS:
SM SPIKE/WASHER
P.K./WASHER
STA. 66+29.58
FD P.K./WASHER
3" DOWN
3/16/02, DCH
SET P.K./WASHER
6/9/02, DCH
SET MAG/WASHER
8-2-19, JLL

RES #3647
SET TACK IN
4X4 MB POST

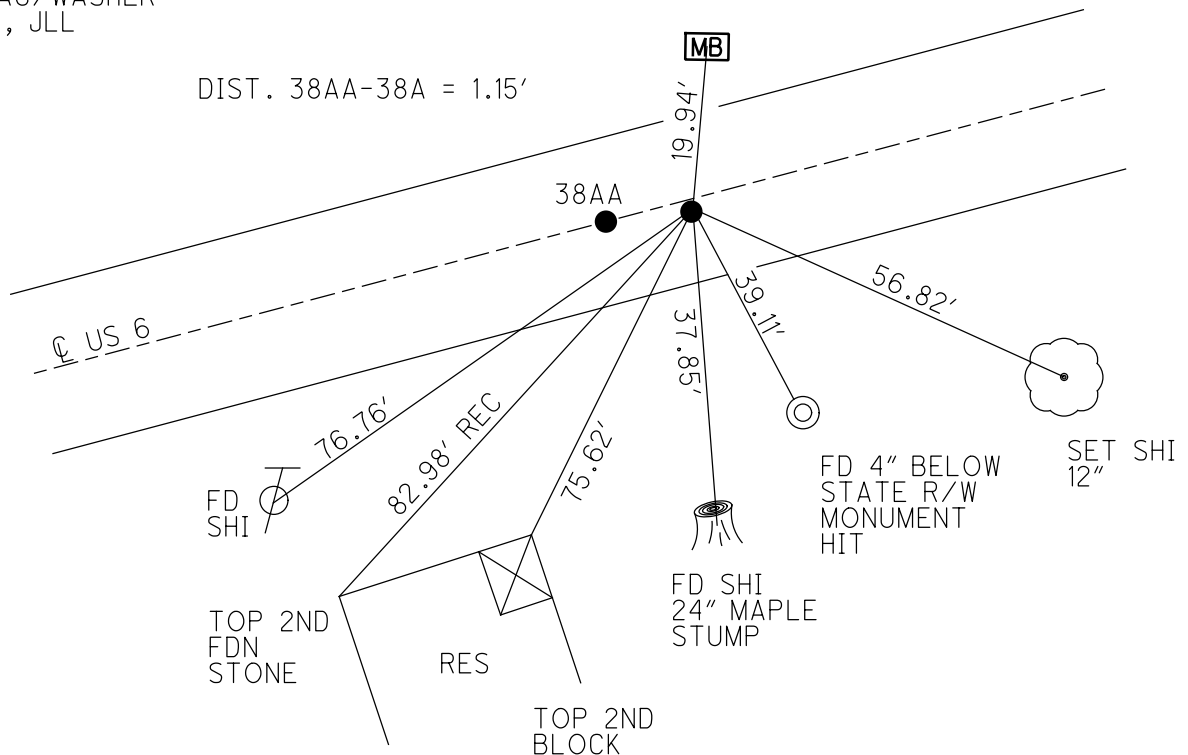

O.D.O.T. DISTRICT 2 SURVEY OFFICE (USE ONLY)

PERSONNEL

REFERENCE NO. 38 A

SHEET 5 OF 34

NOTES LEU

DATE 8/1/18

ROUTE US 6

H.C. LEU

WEATHER CLOUDY

COUNTY SANDUSKY

R.C. TRENKA

TEMP. 84°

TOWNSHIP RILEY

DWG BY AUBLE PID 95769

SECTION 15

T 5 N R 16 E

TYPE MONUMENT P.K./WASHER

ON SURFACE - ~~BELOW~~ ON

OFFSET 0 PAVEMENT ON ~~LT~~ : ~~RT~~

11.4' TO RT EDGE PAVEMENT


STATION: 1306+97

HORZ.DATUM: NAD83 (2011)

GEOID: 2012A

GRID: NORTHING: 633708.682


EASTING: 1834013.681

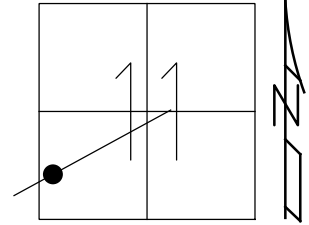

RECORD: P.I.
PREVIOUS MONUMENTS:
SM SPIKE/WASHER
P.K./WASHER
STA. 66+29.58
FD P.K./WASHER
3" DOWN
3/16/02, DCH
SET P.K./WASHER
6/9/02, DCH
SET MAG/WASHER
8-2-19, JLL

RES #3647
SET TACK IN
4X4 MB POST


DIST. 38AA-38A = 1.15'

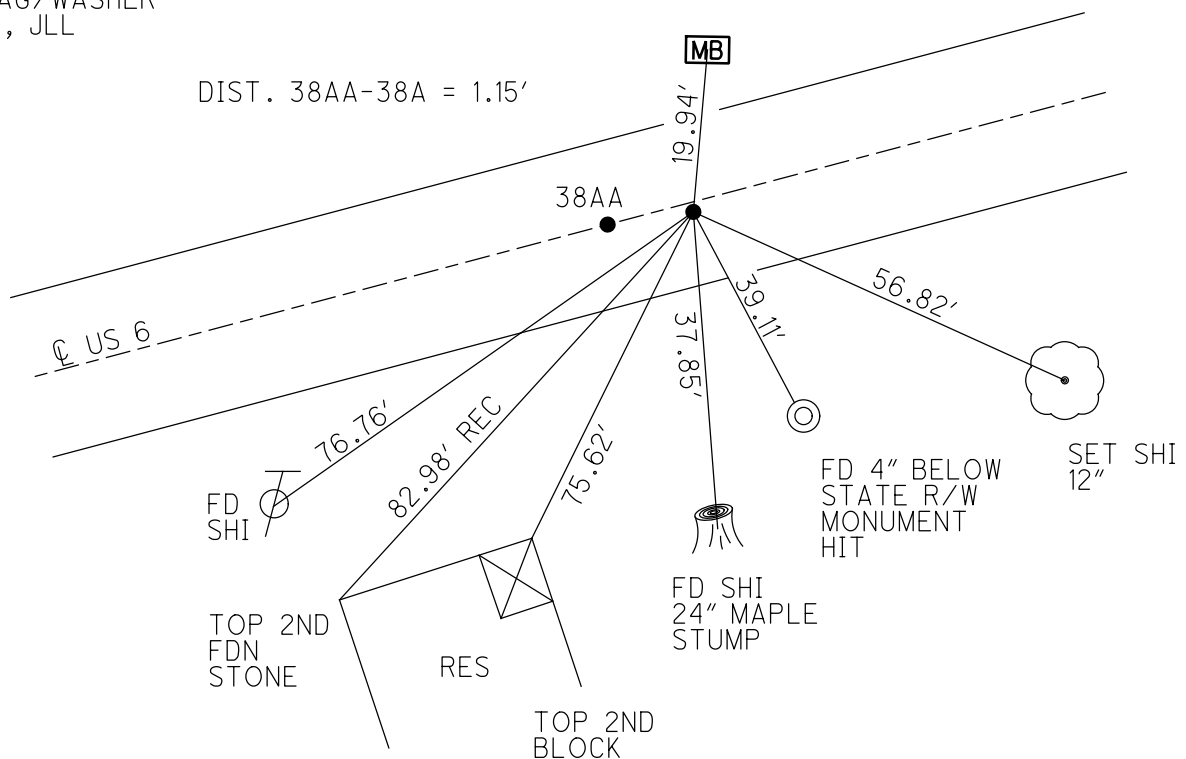


O.D.O.T. DISTRICT 2 SURVEY OFFICE (USE ONLY)

PERSONNEL _____ REFERENCE NO. 38 A SHEET 4 OF 31
 NOTES ROUSOS DATE 03/16/02 ROUTE US 6
 H.C. VAN DUSEN WEATHER WINDY COUNTY SANDUSKY
 R.C. MOSSER TEMP. 28° TOWNSHIP RILEY
 _____ SECTION 11
 _____ T 5 N R 16 E

TYPE MONUMENT _____ PK/WASHER _____
~~ON SURFACE~~ - BELOW _____ 3"
~~LEFT~~ - CL PAV'T - ~~RIGHT~~ _____ ON _____
11.4' TO RT EDGE PAVEMENT
 S.L.M. _____ 1306+97
 GRID: NORTHING: _____ EASTING: _____

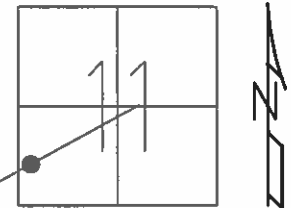

RECORD:
 PREVIOUS MONUMENTS:
 SM SPK/WASHER
 PK/WASHER
 PI 66+29.58
 SET PK/WASHER
 06/09/02 DCH

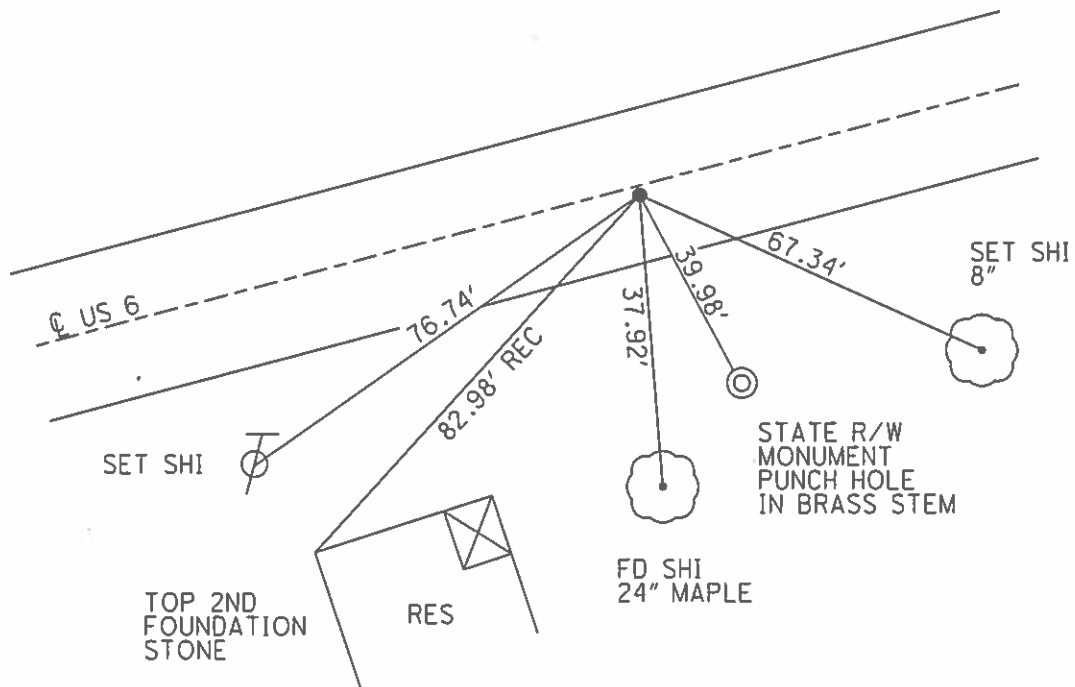

O.D.O.T. DISTRICT 2 SURVEY OFFICE

PERSONNEL

REFERENCE NO. 38-A

SHEET 5 OF 27

NOTES ROUSOS

DATE 3/16/02

ROUTE SR 6

H.C. VAN DUSEN

WEATHER WINDY

COUNTY SANDUSKY

R.C. MOSSER

TEMP. 28°

TOWNSHIP RILEY

HOMAN

SECTION 11

T5 N R16 E


TYPE MONUMENT P.K. WASHER

~~ON SURFACE~~ - BELOW 3"

~~LEFT - C PAV'T - RIGHT~~ ON

11.4' TO RT EDGE PAVEMENT

S.L.M. 1306+97

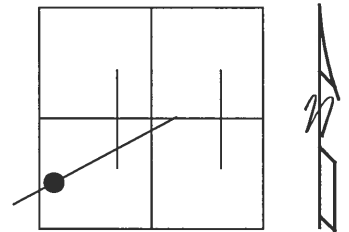

PREVIOUS MONUMENTS:

SM. SPK. / WASHER


PK / WASHER

P.I. 66+29.58

SET PK AND WASHER

6-9-02

DCH

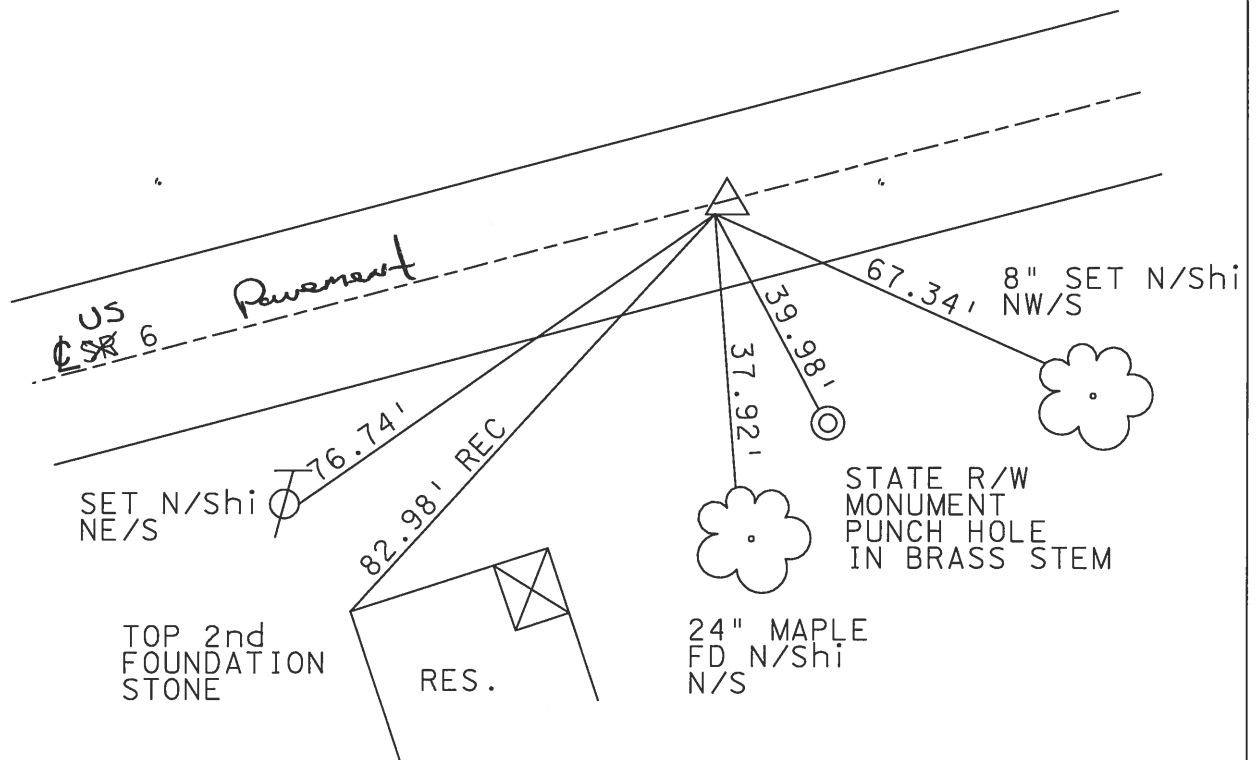

O.D.O.T. DISTRICT 2 SURVEY OFFICE

PERSONNEL

REFERENCE NO. _____

SHEET 17 OF 39

NOTES CHENEY

H.C. KIPPLE

R.C. BARBOUR

DATE 9-16-1971

WEATHER SUNNY

TEMP. 85°

ROUTE 6

COUNTY SANDUSKY

TOWNSHIP PILE Y

SECTION 11

T 5 N R 16 E

TYPE MONUMENT P.K. / WASHER


ON SURFACE - BELOW

~~LEFT~~ - & PAV'T. - RIGHT

TO EDGE PAVEMENT

S.L.M. 1306+97

38A

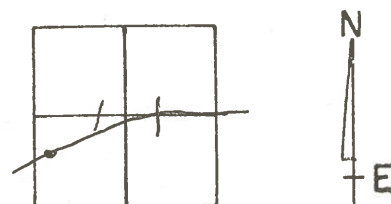


PREVIOUS MONUMENTS:

SM. SPK / WASHER

PK / WASHER

P.I. 66+29.58

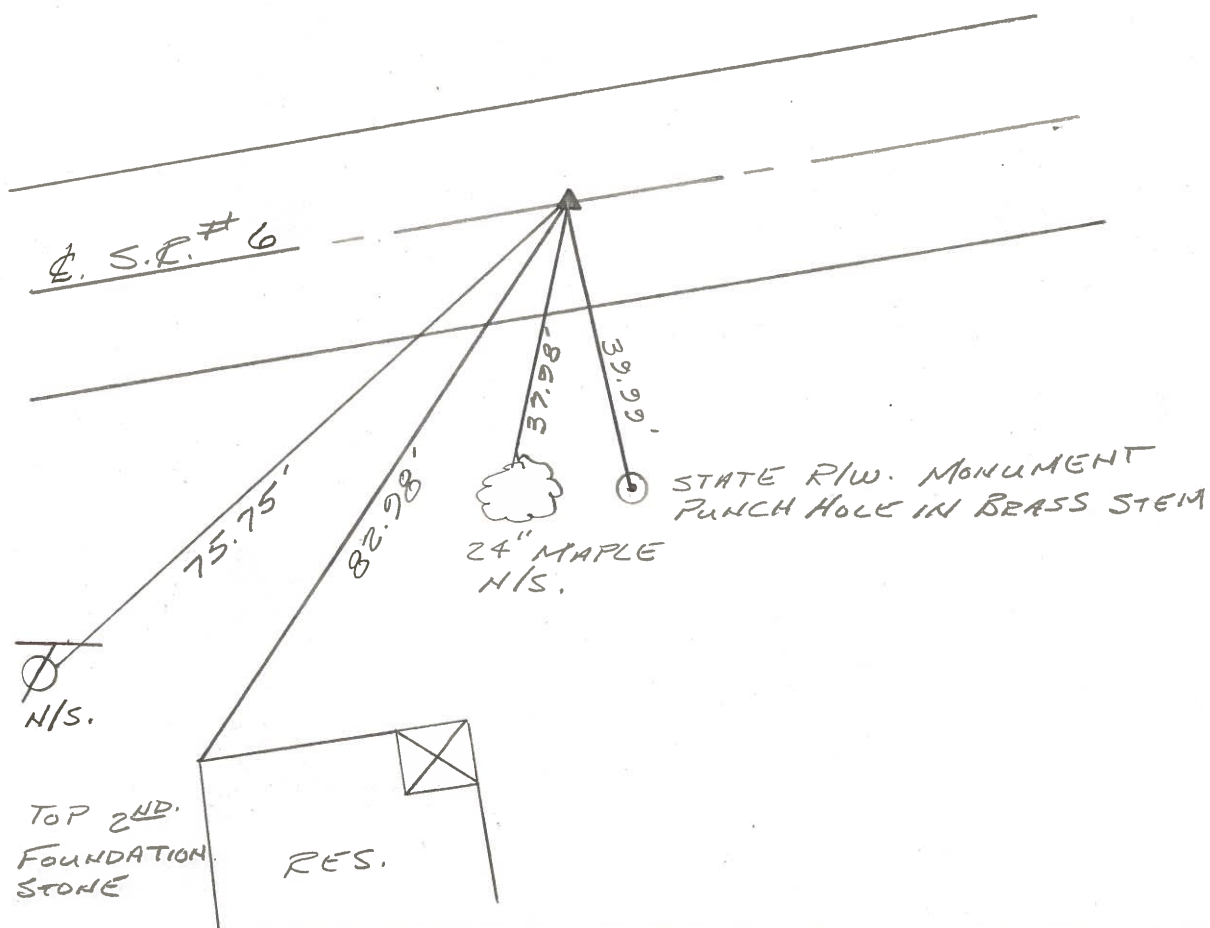

PERSONNEL	TITLE	PERSONNEL	TITLE	COUNTY	DATE	S. R.	WEATHER	TEMP
Cronin		Schneider		Sandusky	7/29/75	#6	Sunny	75°
Ash		Masser						
Coyne		Barbour						

DESCRIPTION Ties for Control Points JOB NO. 1329+

