


PERSONNEL	REFERENCE NO. <u>39</u>	SHEET <u>6</u> OF <u>34</u>
NOTES <u>PRESTON-COLVIN</u>	DATE <u>9-4-24</u>	ROUTE <u>US 6</u>
H.C. <u>NEISE</u>	WEATHER <u>SUNNY</u>	COUNTY <u>SANDUSKY</u>
R.C. <u>BARRIERE</u>	TEMP. <u>68°</u>	TOWNSHIP <u>RILEY</u>
		SECTION <u>11</u>
DWG BY <u>PRESTON-COLVIN</u>	PID <u>PAVING TRAIN</u>	T <u>5</u> N R <u>16</u> E
TYPE MONUMENT <u>MAG/WASHER</u>		
ON SURFACE - BELOW <u>ON</u>		
OFFSET <u>12.7'</u> TO <u>LT</u> EDGE PAVEMENT	<u>1.6'</u> LT : RT	
STATION: <u>1329+37</u>		
HORZ.DATUM: <u>NAD83 (2011)</u>	GEOID: <u>NAVD88 2018</u>	
GRID: NORTHING: <u>634615.966</u>	EASTING: <u>1836069.682</u>	
LDP: NORTHING: <u>330854.3</u>	EASTING: <u>196201.4</u>	

RECORD:
STA.88+87
SM.SPIKE/WASHER
FD P.K./WASHER
3/16/02, DCH
SET P.K./WASHER
6/10/02, DCH
FD SM.R.R.SPIKE
4" DOWN
REF39
11/22/17, JLL
SET MAG/WASHER
8-2-19, JLL
FD MAG/WASHER
2/10/22, JFO
1/20/23,
12/28/23, JMR
FD MEG/WASHER
REF39
9/4/24, TDN
FD MEG/WASHER
10/3/24, JAM

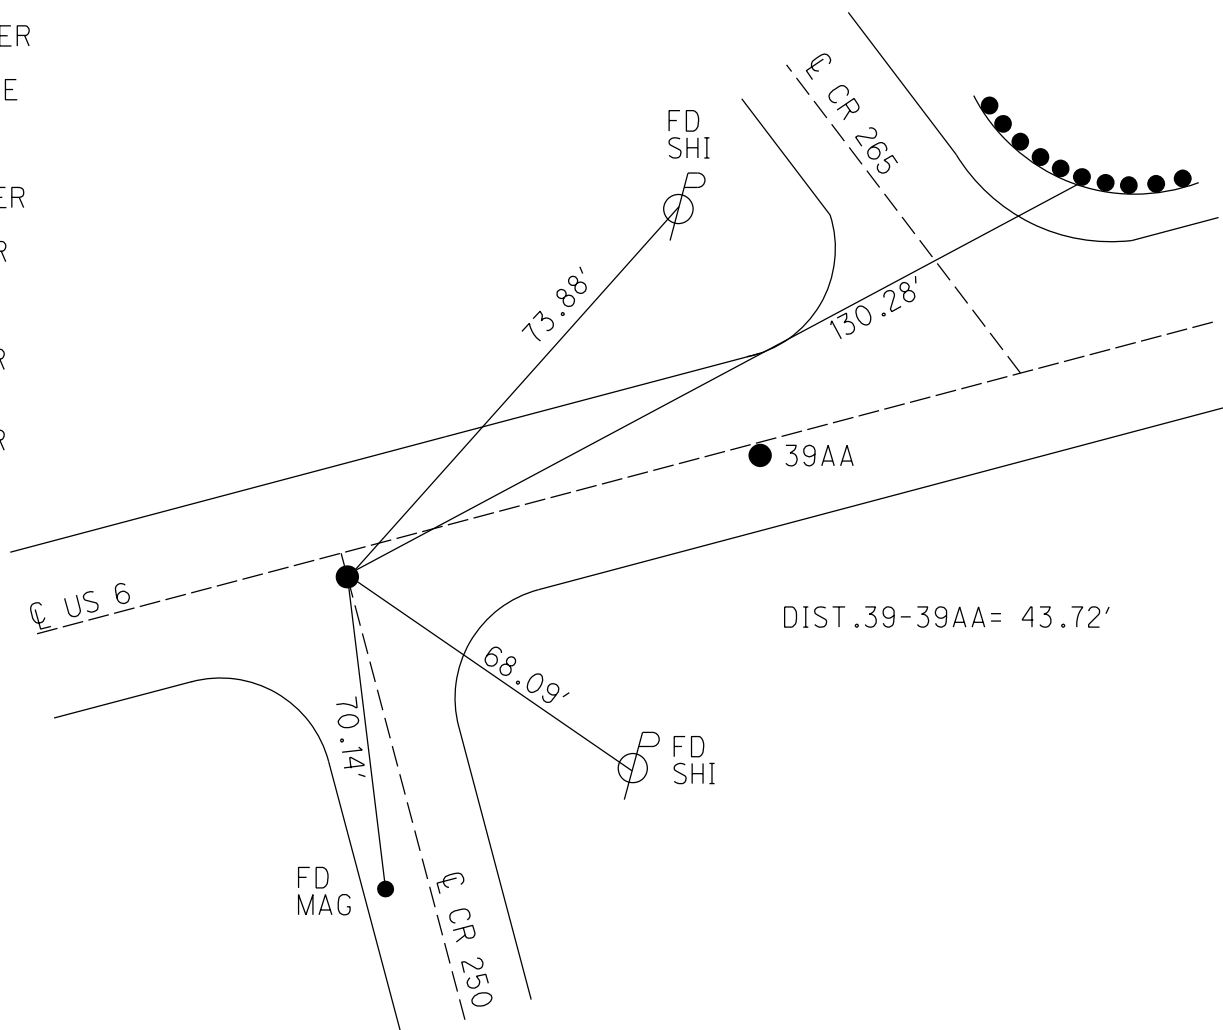


O.D.O.T. DISTRICT 2 SURVEY OFFICE (USE ONLY)


PERSONNEL	REFERENCE NO. <u>39</u>	SHEET <u>6</u> OF <u>34</u>
NOTES <u>MILLER</u>	DATE <u>12/28/23</u>	ROUTE <u>US 6</u>
H.C. <u>RHOADES</u>	WEATHER <u>RAIN</u>	COUNTY <u>SANDUSKY</u>
R.C. <u>MILLER</u>	TEMP. <u>44°</u>	TOWNSHIP <u>RILEY</u>
		SECTION <u>11</u>
DWG BY <u>MILLER</u>	PID <u>PAVETRAIN</u>	T <u>5</u> N R <u>16</u> E

TYPE MONUMENT MAG/WASHER
 ON SURFACE - ~~BELOW~~ ON
 OFFSET CL PAVEMENT 1.6' LT : RT
12.7' TO LT EDGE PAVEMENT
 STATION: 1329+37

HORZ.DATUM: NAD83 (2011) GEOID: NAVD88 2018
 GRID: NORTHING: 634615.966 EASTING: 1836069.682

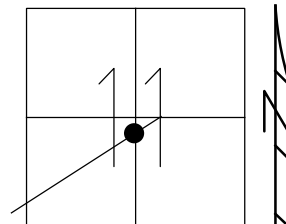

RECORD:
 STA.88+87
 SM.SPIKE/WASHER
 FD P.K./WASHER
 3/16/02, DCH
 SET P.K./WASHER
 6/10/02, DCH
 FD SM.R.R.SPIKE
 4" DOWN
 REF39
 11/22/17, JLL
 SET MAG/WASHER
 8-2-19, JLL
 FD MAG/WASHER
 2/10/22, JFO
 1/20/23,
 12/28/23, JMR

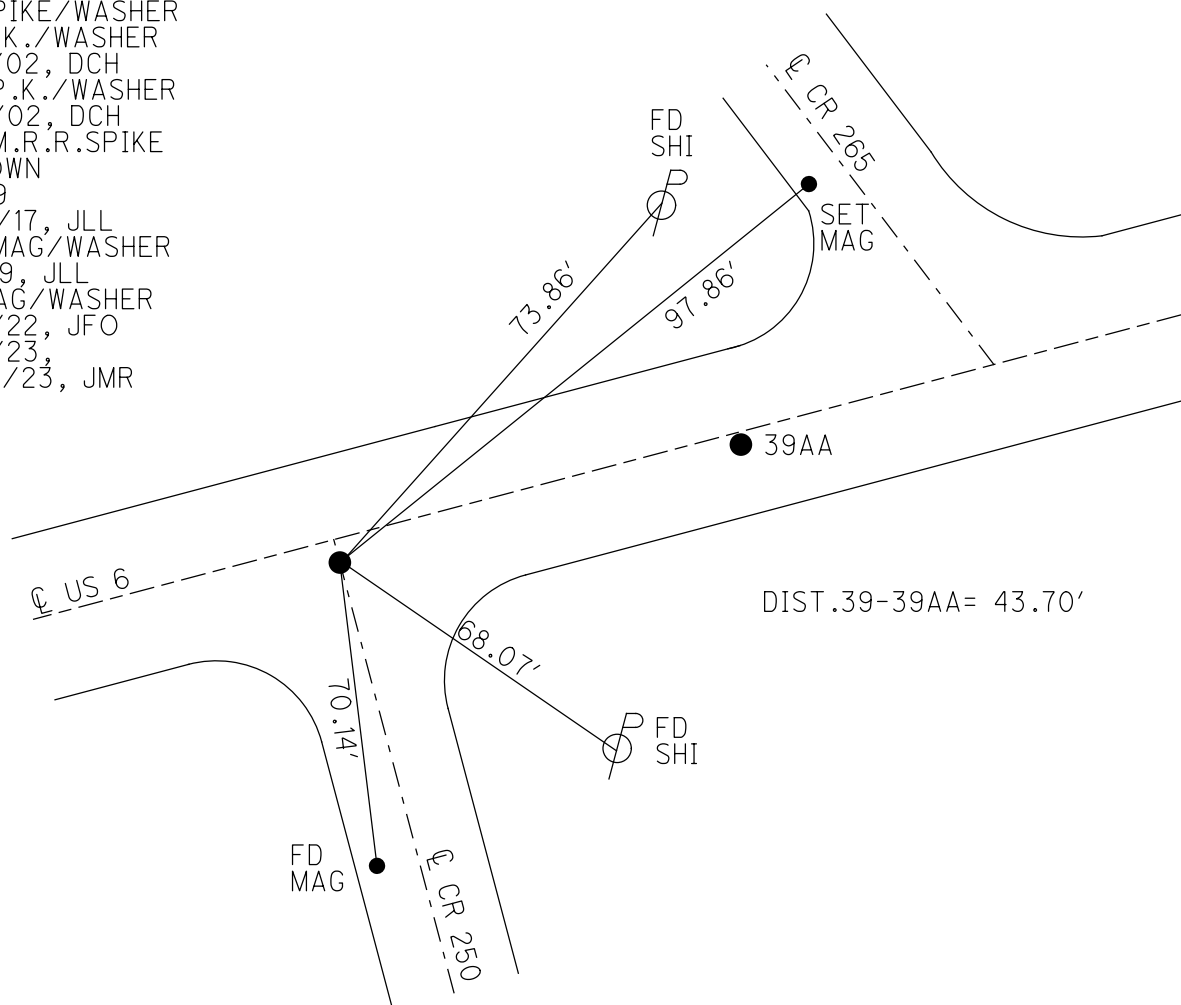

O.D.O.T. DISTRICT 2 SURVEY OFFICE (USE ONLY)

PERSONNEL

REFERENCE NO. 39

SHEET 6 OF 34

NOTES LEU

DATE 8/1/18

ROUTE US 6

H.C. LEU

WEATHER CLOUDY

COUNTY SANDUSKY

R.C. TRENKA

TEMP. 73°

TOWNSHIP RILEY

SECTION 11

DWG BY AUBLE

PID PAVETRAIN

T 5 N R 16 E

TYPE MONUMENT SM.R.R.SPIKE

ON SURFACE - ~~BELOW~~ ON

OFFSET Q PAVEMENT 1.6' ~~LT~~ : RT

12.7' TO LT EDGE PAVEMENT


STATION: 1329.37

HORZ.DATUM: NAD83 (2011)


GEOID: 2012A

GRID: NORTHING: 634615.966

EASTING: 1836069.682

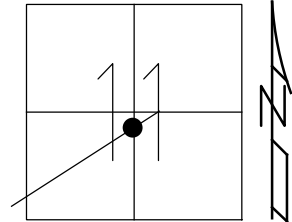

RECORD:
PREV. MONUMENTS:
SM SPIKE/WASHER
STA. 88+87
FD P.K./WASHER
3/16/02, DCH
SET P.K./WASHER
6/10/02, DCH
FD SM.R.R.SPIKE
4" DOWN
REF39
11/22/17, JLL
SET MAG/WASHER
8-2-19, JLL
FD MAG/WASHER
2/10/22, JFO
1/20/23, JMR

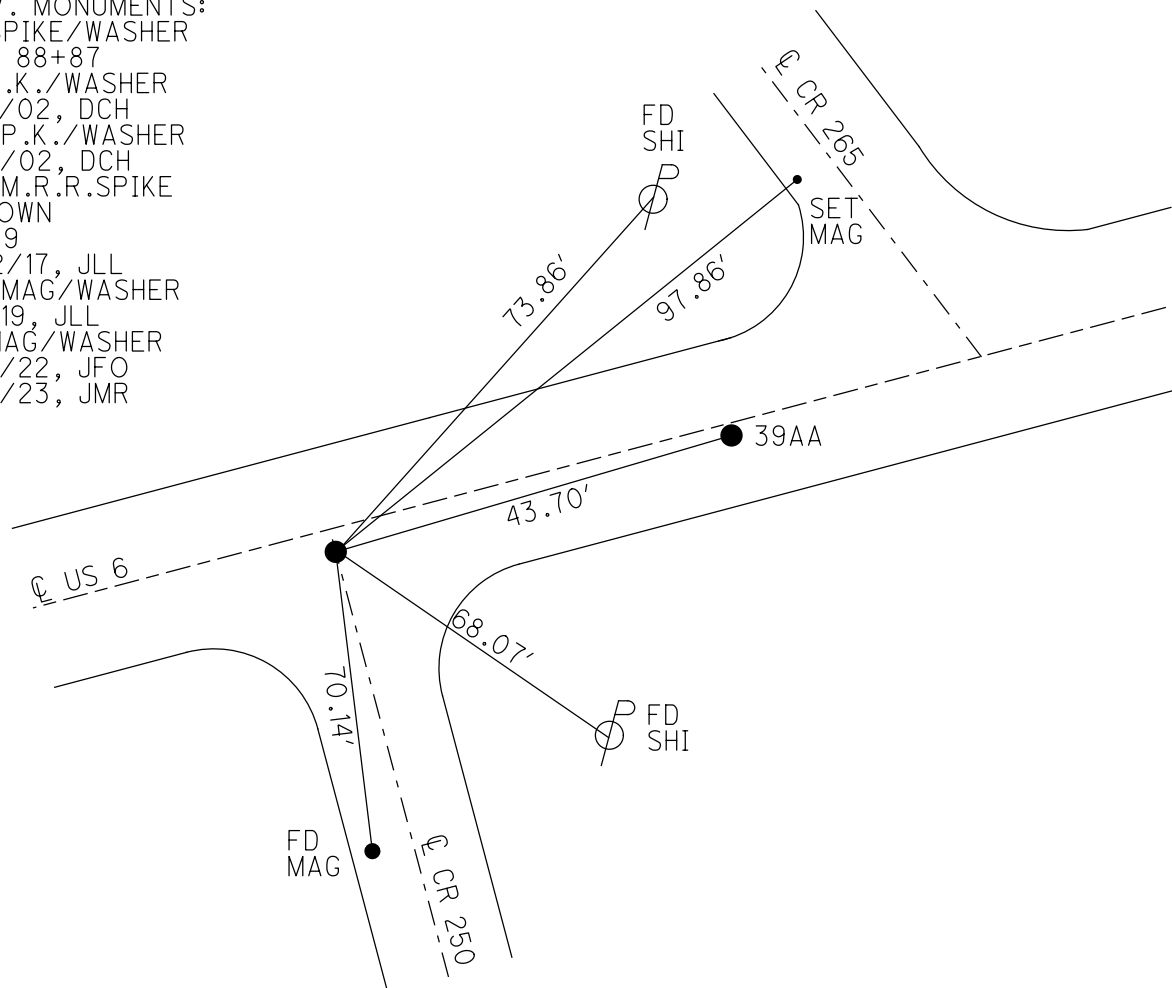

O.D.O.T. DISTRICT 2 SURVEY OFFICE (USE ONLY)

PERSONNEL

REFERENCE NO. 39

SHEET 6 OF 34

NOTES LEU
H.C. LEU
R.C. TRENKA

DATE 8/1/18
WEATHER CLOUDY
TEMP. 73°

ROUTE US 6
COUNTY SANDUSKY
TOWNSHIP RILEY
SECTION 11
T 5 N R 16 E

DWG BY AUBLE PID 95769

TYPE MONUMENT SM.R.R.SPIKE

ON SURFACE - ~~BELOW~~ ON

OFFSET Q PAVEMENT 1.6' ~~LT~~ : RT
12.7' TO LT EDGE PAVEMENT


STATION: 1329.37

HORZ.DATUM: NAD83 (2011)


GEOID: 2012A

GRID: NORTHING: 634615.966

EASTING: 1836069.682

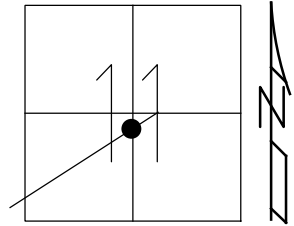

RECORD:
PREV. MONUMENTS:
SM SPIKE/WASHER
STA. 88+87
FD P.K./WASHER
3/16/02, DCH
SET P.K./WASHER
6/10/02, DCH
FD SM.R.R.SPIKE
4" DOWN
REF39
11/22/17, JLL
SET MAG/WASHER
8-2-19, JLL
FD MAG/WASHER
2/10/22, JFO

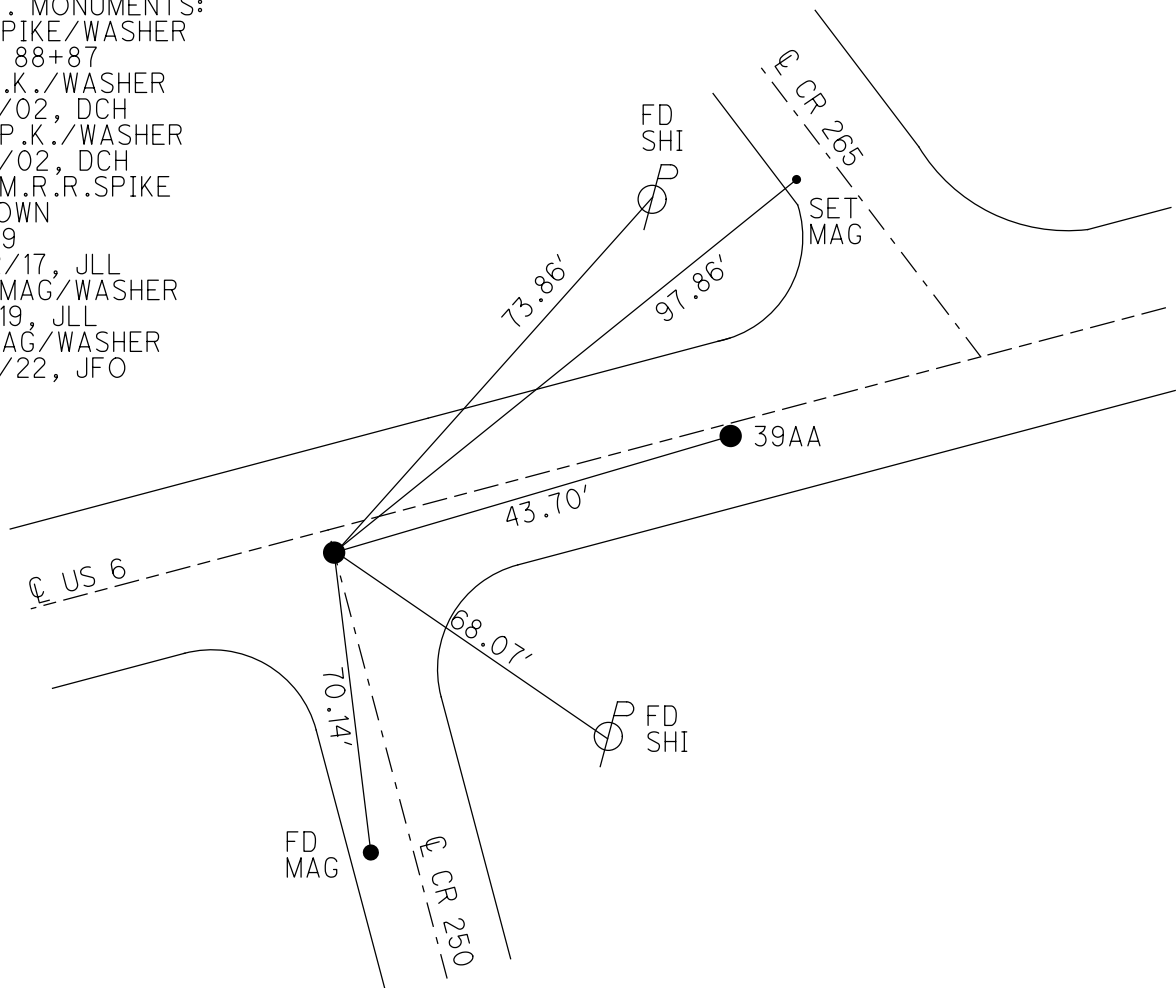

O.D.O.T. DISTRICT 2 SURVEY OFFICE (USE ONLY)

PERSONNEL

REFERENCE NO. 39

SHEET 6 OF 34

NOTES LEU

DATE 8/1/18

ROUTE US 6

H.C. LEU

WEATHER CLOUDY

COUNTY SANDUSKY

R.C. TRENKA

TEMP. 73°

TOWNSHIP RILEY

DWG BY AUBLE

PID 95769

SECTION 11

T 5 N R 16 E

TYPE MONUMENT SM.R.R.SPIKE

ON SURFACE - ~~BELOW~~ ON

OFFSET CL PAVEMENT 1.6' LT : RT

12.7' TO LT EDGE PAVEMENT


STATION: 1329.37

HORZ.DATUM: NAD83 (2011)


GEOID: 2012A

GRID: NORTHING: 634615.966

EASTING: 1836069.682

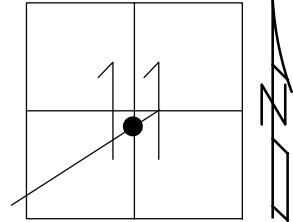


RECORD:
PREV. MONUMENTS:
SM SPIKE/WASHER
STA. 88+87
FD P.K./WASHER
3/16/02, DCH
SET P.K./WASHER
6/10/02, DCH
FD SM.R.R.SPIKE
4" DOWN
REF39
11/22/17, JLL
SET MAG/WASHER
8-2-19, JLL

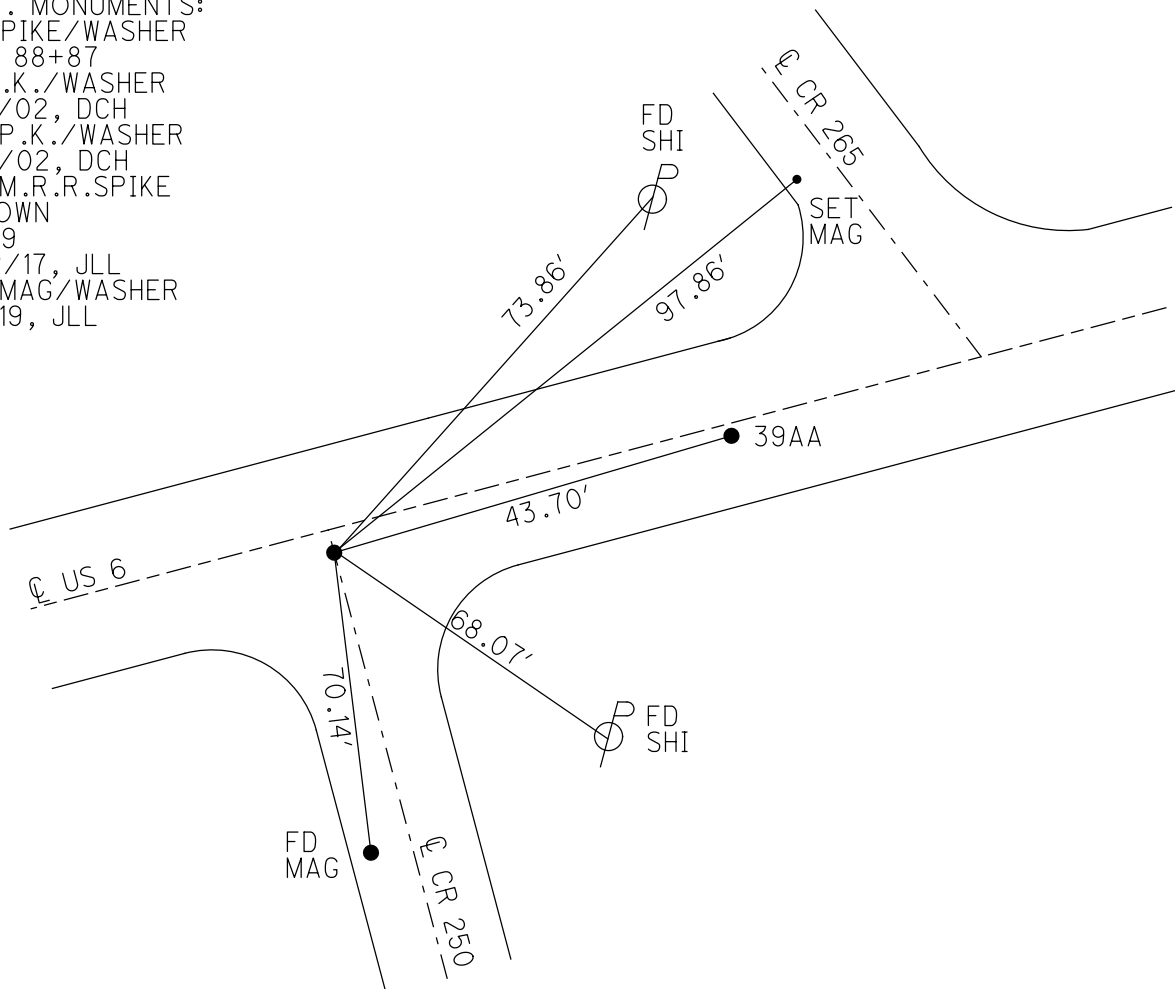


O.D.O.T. DISTRICT 2 SURVEY OFFICE (USE ONLY)

PERSONNEL _____ REFERENCE NO. 39 SHEET 5 OF 31
 NOTES ROUSOS DATE 03/16/02 ROUTE US 6
 H.C. VAN DUSEN WEATHER WINDY COUNTY SANDUSKY
 R.C. MOSSER TEMP. 28° TOWNSHIP RILEY
HOMAN SECTION 11
 T 5 N R 16 E

TYPE MONUMENT PK/WASHER
 ON SURFACE - ~~BELOW~~ ON
~~LEFT~~ - ℄ PAV'T - RIGHT 1'
12.7' TO LT EDGE PAVEMENT
 S.L.M. 1329+37
 GRID: NORTHING: - EASTING: -

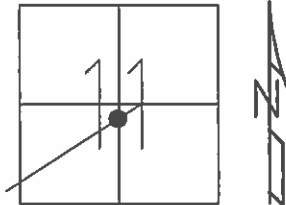

RECORD:
 PREVIOUS STATIONS & MONUMENTS:
 89+25
 PK/WASHER
 SM SPK/WASHER
 88+87
 PK/WASHER
 SM SPK/WASHER
 SET PK/WASHER
 06/10/02 DCH

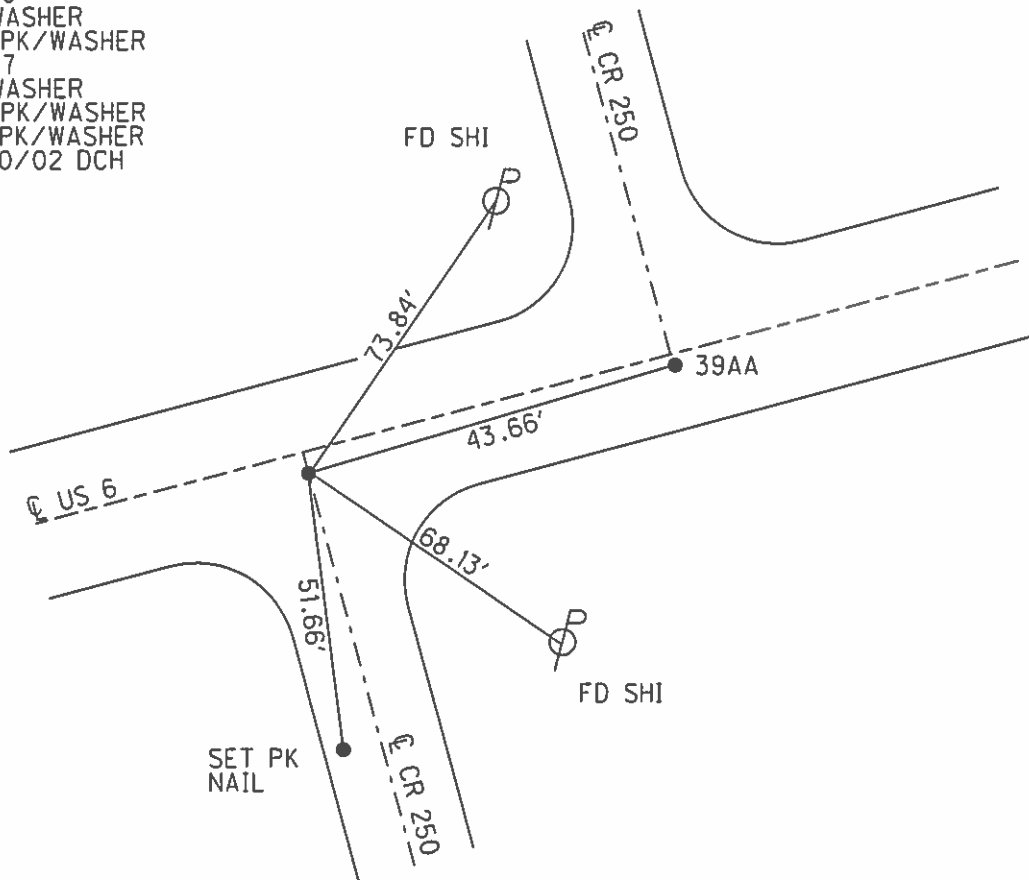

O.D.O.T. DISTRICT 2 SURVEY OFFICE

PERSONNEL

NOTES ROUSOS
H.C. VAN DUSEN
R.C. MOSSER
HOMAN


REFERENCE NO. 39

DATE 3/16/02
WEATHER WINDY
TEMP. 28°

SHEET 6 OF 27

ROUTE SR 6
COUNTY SANDUSKY
TOWNSHIP RILEY
SECTION 11
T 5 N R 16 E


TYPE MONUMENT P.K. WASHER
ON SURFACE - ~~BELOW~~ ON
~~LEFT~~ - Q PAV'T - RIGHT BOTH 1'
TO EDGE PAVEMENT A 12.7' TO LT EDGE
S.L.M. A 1329+37 B 1329+80

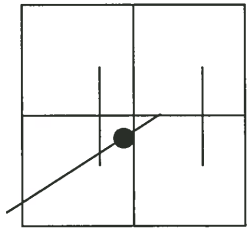

PREVIOUS STATIONS & MONUMENTS:

89+25
PK & WASHER
SM. SPK & WASHER
88+87
PK & WASHER
SM. SPK & WASHER

SET PK'S AND WASHER'S
6-10-02
DCH

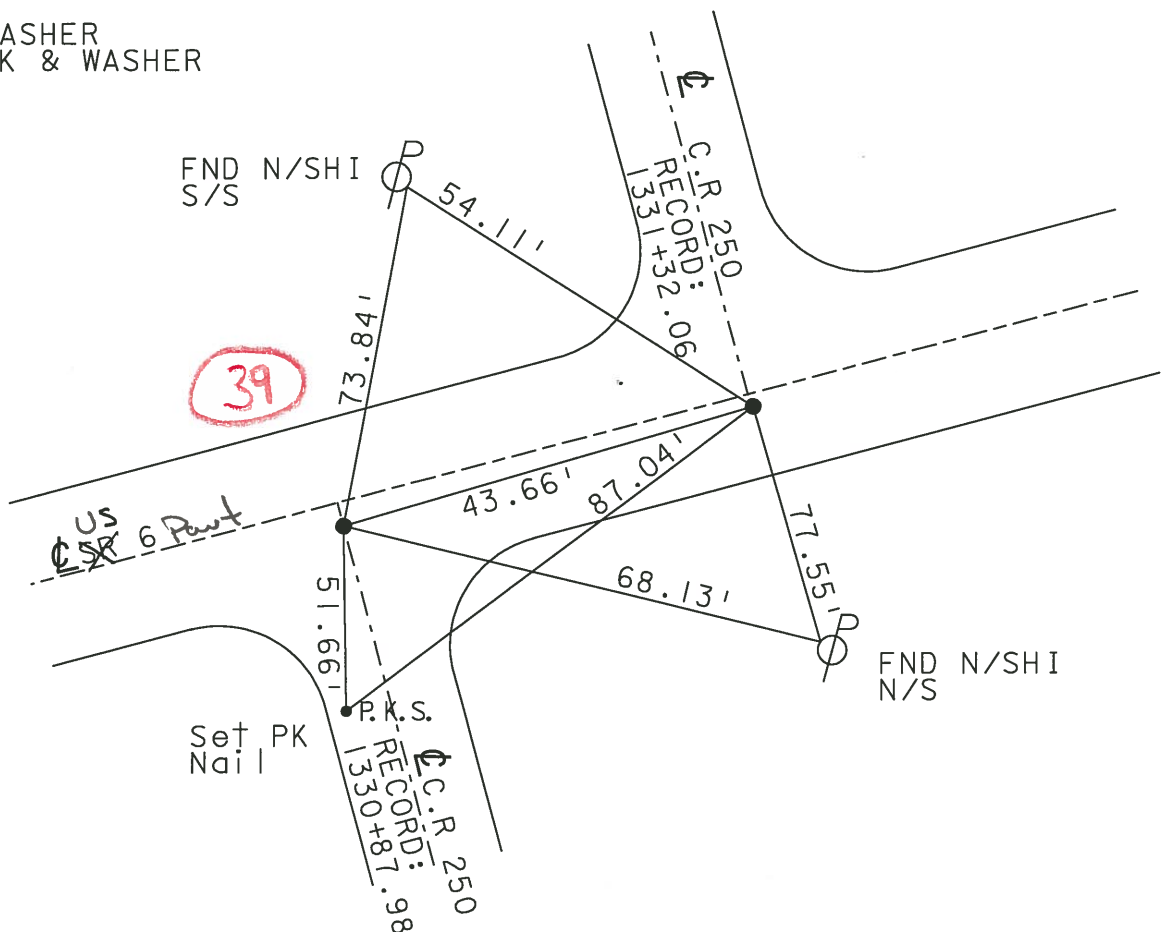

O.D.O.T. DISTRICT 2 SURVEY OFFICE

PERSONNEL

REFERENCE NO. 39

SHEET 18 OF 32

NOTES CHENEY

H.C. PIPPLE

R.C. BARBOUR

DATE 2-16-1991

WEATHER SUNNY

TEMP. 85°

ROUTE 6

COUNTY SANDUSKY

TOWNSHIP PILEY

SECTION 11

T 5 N R 16 E


TYPE MONUMENT PKs/WASHERS

ON SURFACE - BELOW

~~LEFT~~ - & PAV'T. - RIGHT BOTH - 1'

TO EDGE PAVEMENT

S.L.M. 1229+37 & 1229+80

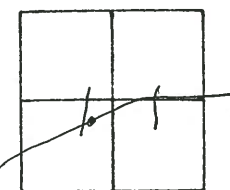

PREVIOUS STATIONS & MONUMENTS:

89+25


PK/WASHER

SM. SPR/WASHER

88+87

PK/WASHER

SM. SPR/WASHER

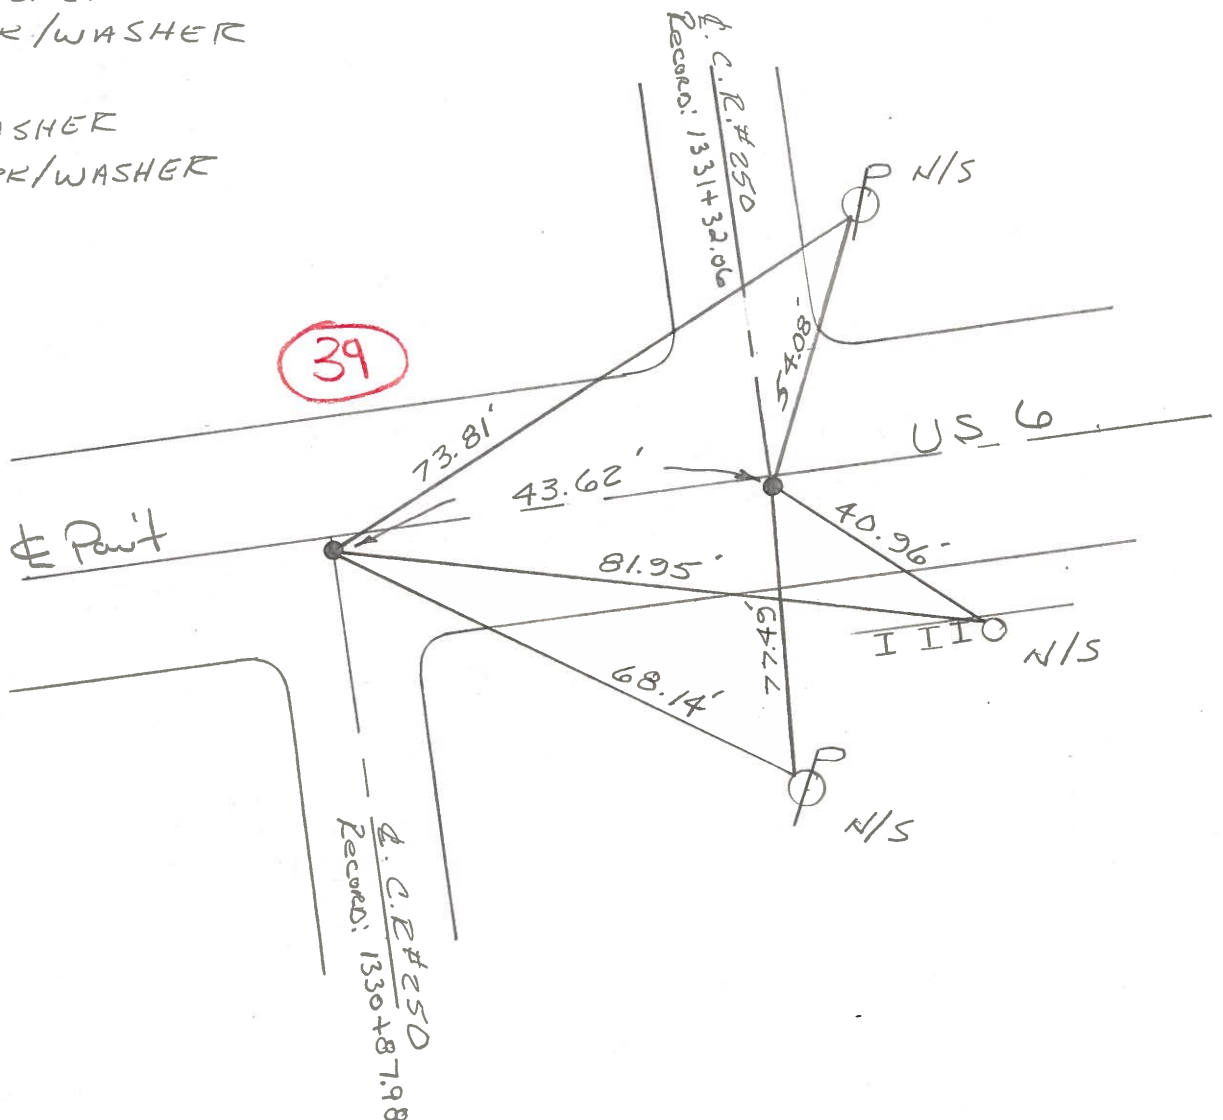

PERSONNEL	TITLE	PERSONNEL	TITLE
Grimm		Schneider	
Asst		Messer	
Geyman		Barbour	


COUNTY Sandusky DATE 7/29/75

S. R. #6 WEATHER sunny

SEC. I - Fremont - East TEMP. 75°

DESCRIPTION Ties for Central Point

JOB NO.

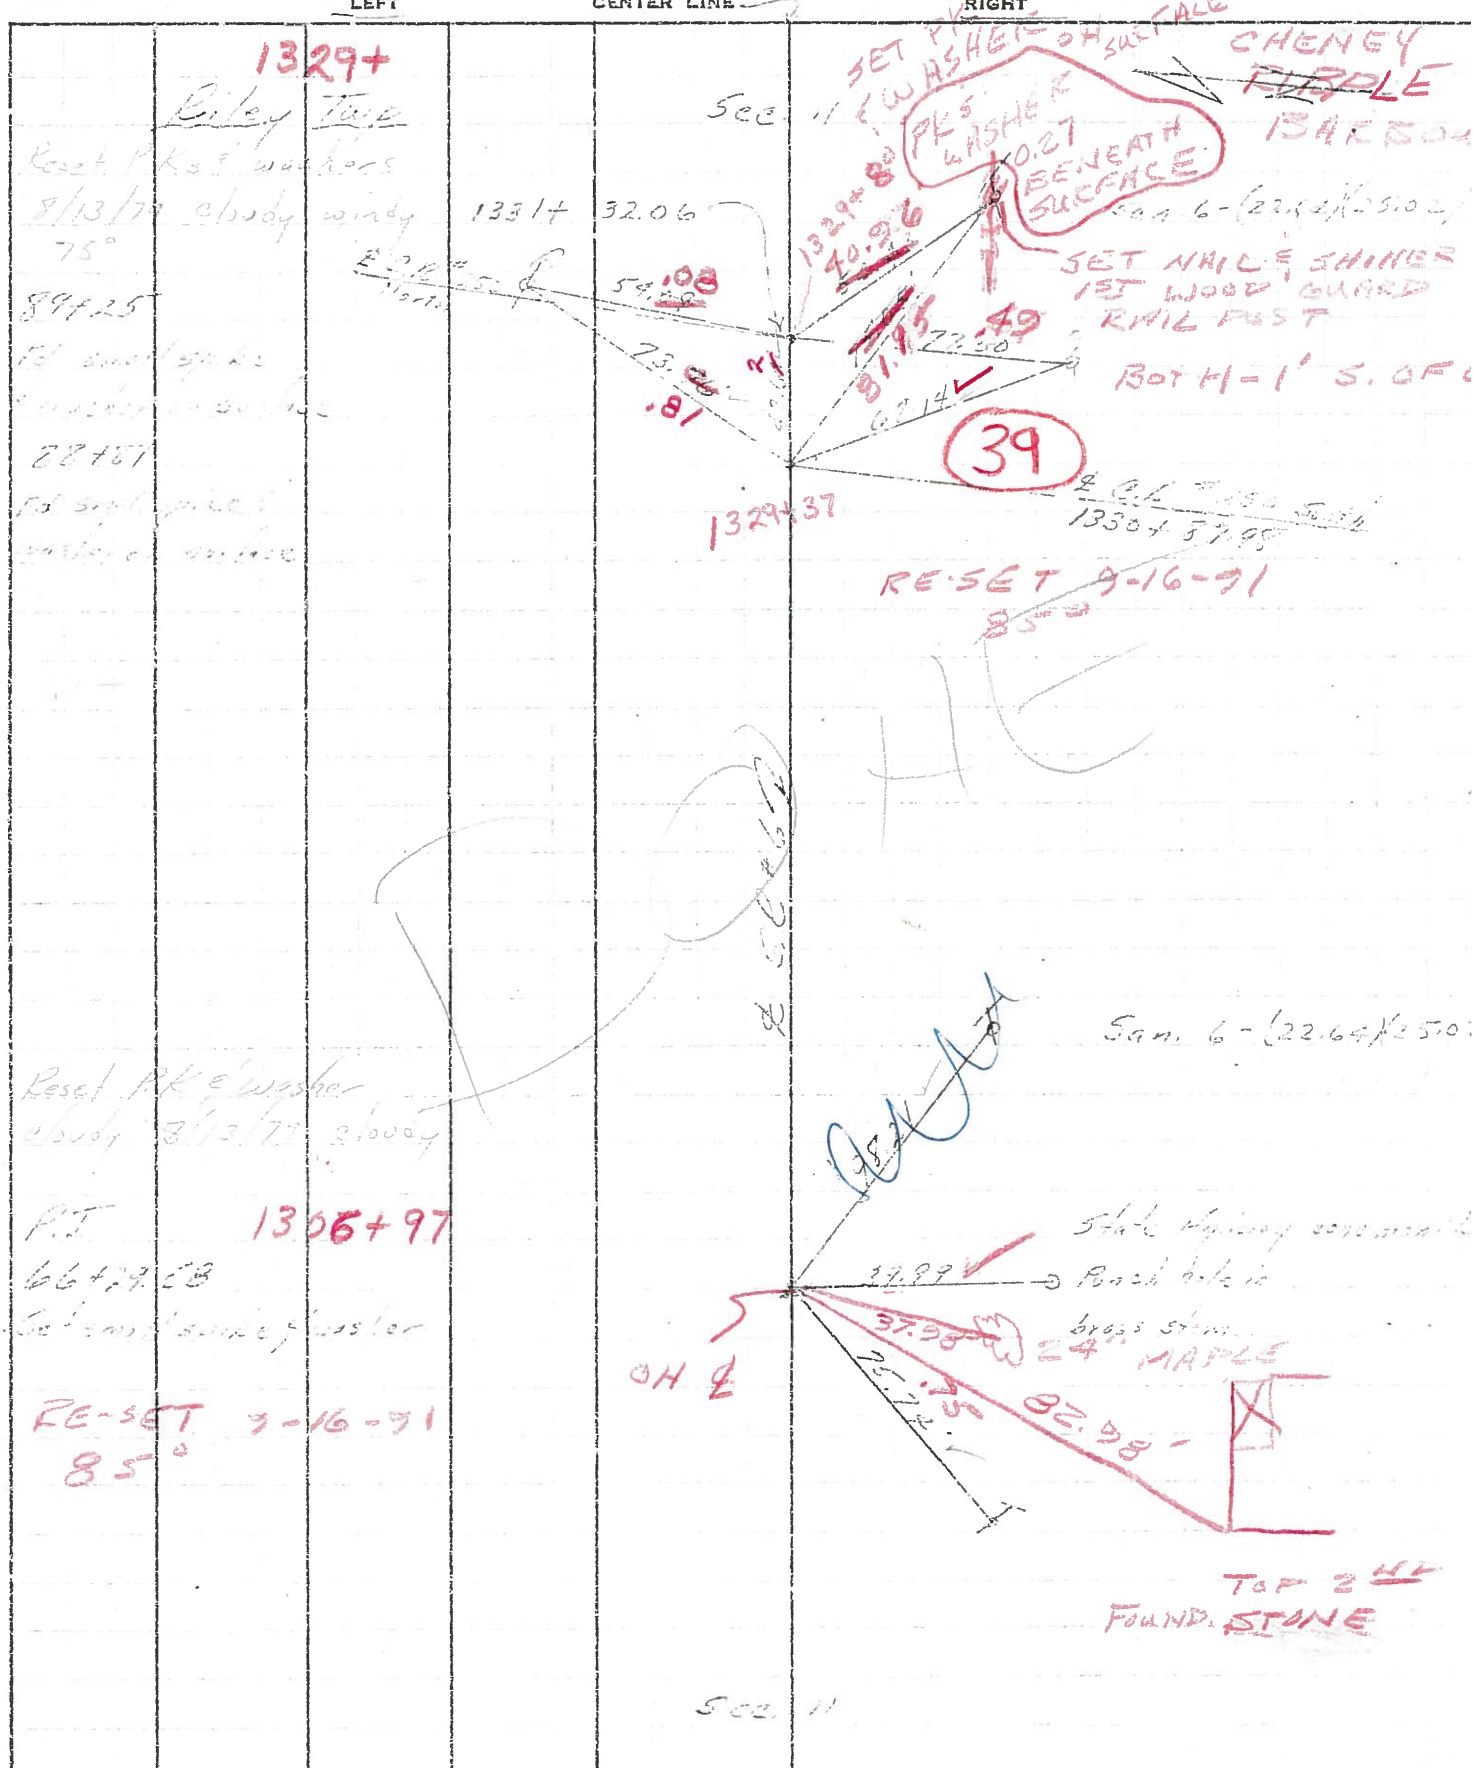

PERSONNEL	TITLE	PERSONNEL	TITLE	COUNTY	DATE	WEATHER	TEMP.
Cronin		Schneider		Sandusky	7/29/75	sunny	75°
Ash		Mosser		S. R. #6			
Geyman		Barbour		SEC. I - Fremont - East			

DESCRIPTION Ties for Control Points JOB NO. _____

