


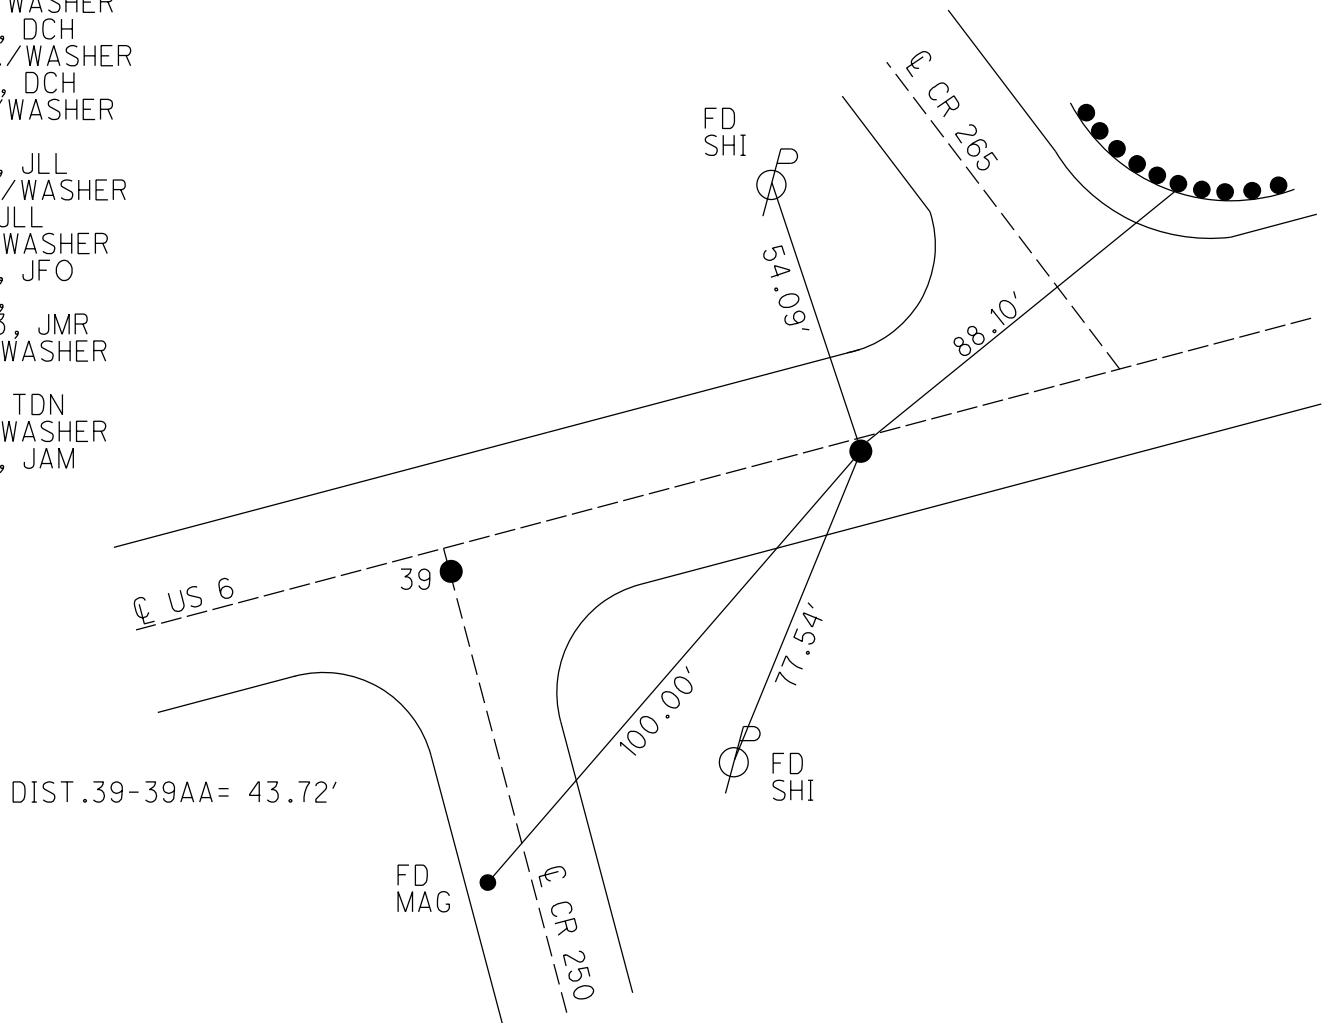

O.D.O.T. DISTRICT 2 SURVEY OFFICE (USE ONLY)

PERSONNEL

REFERENCE NO. 39 AA

SHEET 7 OF 34

NOTES MILLER

DATE 12/28/23

ROUTE US 6

H.C. RHOADES

WEATHER RAIN

COUNTY SANDUSKY

R.C. MILLER

TEMP. 44°

TOWNSHIP RILEY

SECTION

11DWG BY RHOADES PID PAVETRAIN

T 5 N R 16 E

TYPE MONUMENT MAG/WASHER

ON SURFACE - ~~BELOW~~ _____ ON

OFFSET @ PAVEMENT 1.5' ~~1.75'~~ : RT


13.0' TO LT EDGE PAVEMENT

STATION: 1329+80


HORZ.DATUM: NAD83 (2011)

GEOID: NAVD88 2018

GRID: NORTHING: 634633.565

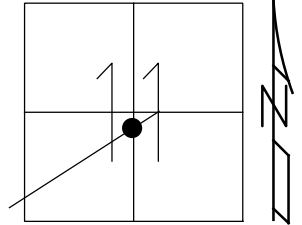EASTING: 1836109.668

RECORD:
STA.89+25
P.K./WASHER
FD P.K./WASHER
3/16/02, DCH
SET P.K./WASHER
6/10/02, DCH
FD P.K./WASHER
REFA39
11/22/17, JLL
SET MAG/WASHER
8-2-19, JLL
FD MAG/WASHER
2/10/22, JFO
1/20/23,
12/28/23, JMR

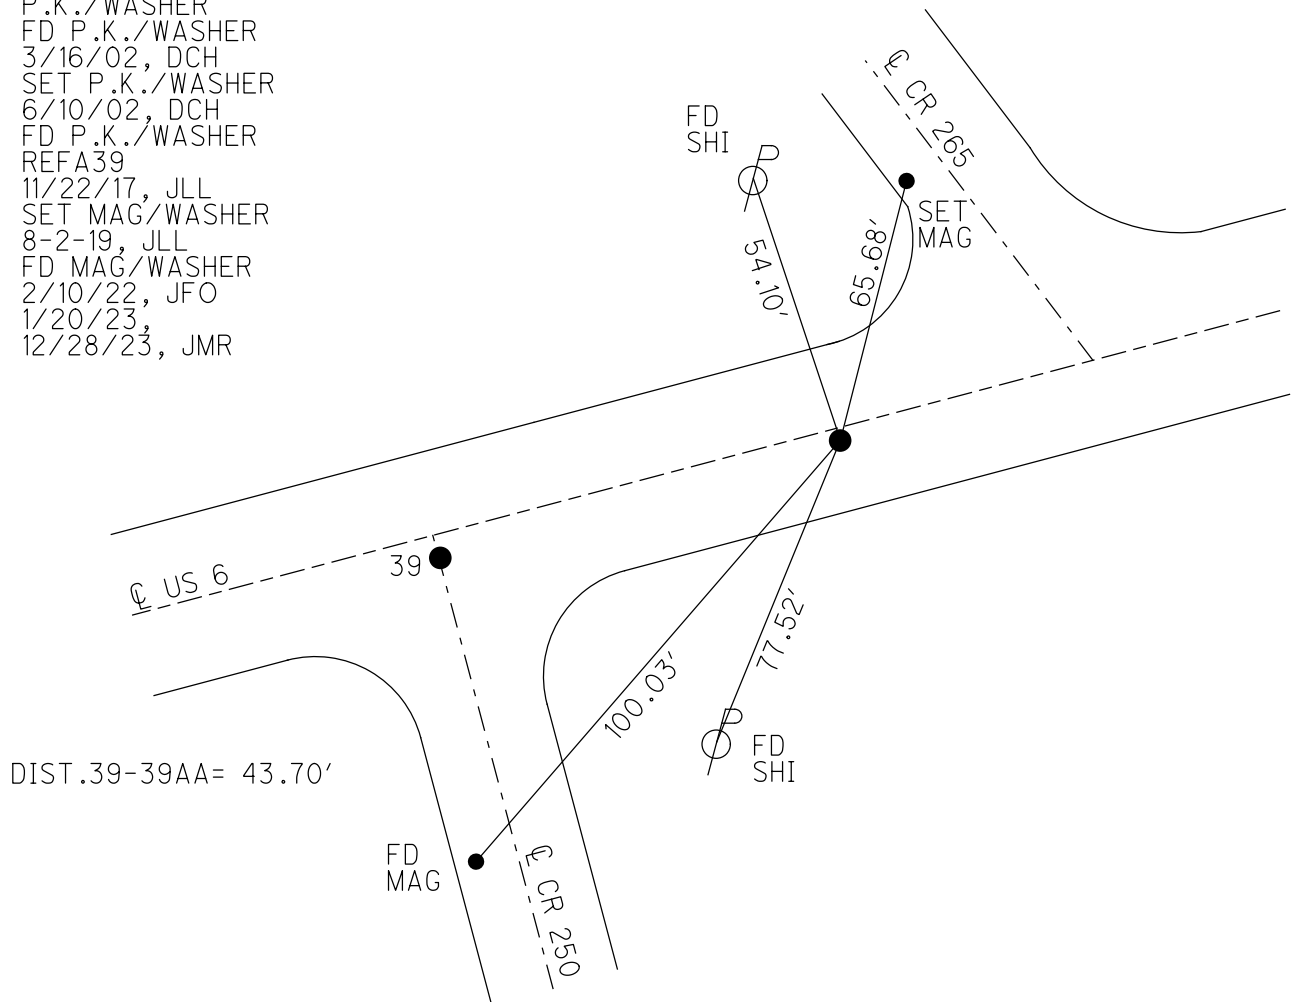

O.D.O.T. DISTRICT 2 SURVEY OFFICE (USE ONLY)

PERSONNEL

REFERENCE NO. 39 AA

SHEET 7 OF 34

NOTES LEU

DATE 8/1/18

ROUTE US 6

H.C. LEU

WEATHER CLOUDY

COUNTY SANDUSKY

R.C. TRENKA

TEMP. 73°

TOWNSHIP RILEY

SECTION 11

DWG BY AUBLE

PID PAVETRAIN

T 5 N R 16 E

TYPE MONUMENT P.K./WASHER

ON SURFACE - ~~BELOW~~ ON

OFFSET Q PAVEMENT 1.5' LT : RT

13.0' TO LT EDGE PAVEMENT


STATION: 1329+80

HORIZ.DATUM: NAD83 (2011)


GEOID: 2012A

GRID: NORTHING: 634633.565

EASTING: 1836109.668

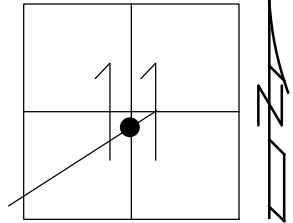

RECORD:
PREV. MONUMENTS:
PK/WASHER
STA. 89+25
FD P.K./WASHER
3/16/02, DCH
SET P.K./WASHER
6/10/02, DCH
FD P.K./WASHER
REFA39
11/22/17, JLL
SET MAG/WASHER
8-2-19, JLL
FD MAG/WASHER
2/10/22, JFO
1/20/23, JMR

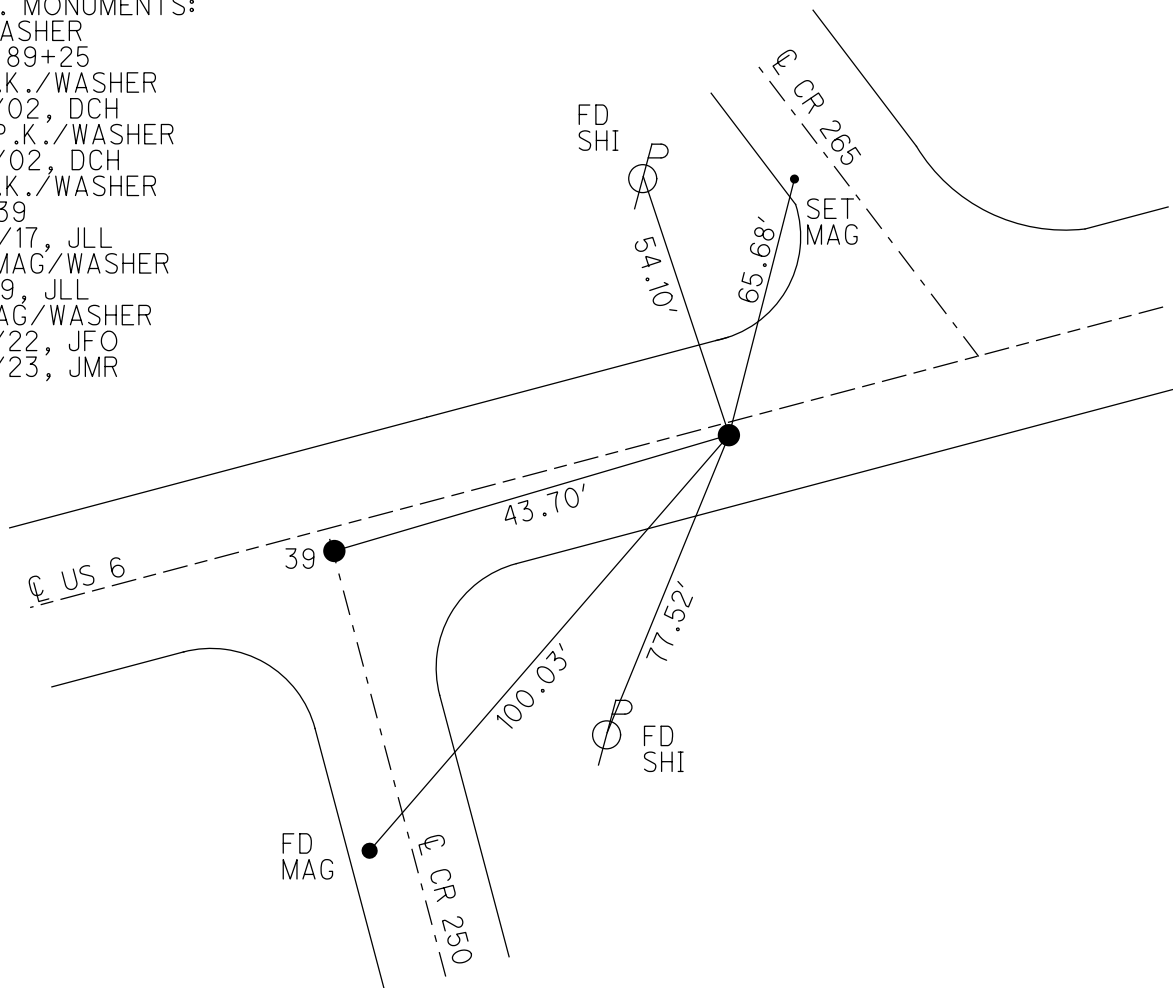

O.D.O.T. DISTRICT 2 SURVEY OFFICE (USE ONLY)

PERSONNEL

REFERENCE NO. 39 AA

SHEET 7 OF 34

NOTES LEU

DATE 8/1/18

ROUTE US 6

H.C. LEU

WEATHER CLOUDY

COUNTY SANDUSKY

R.C. TRENKA

TEMP. 73°

TOWNSHIP RILEY

SECTION 11

DWG BY AUBLE

PID 95769

T 5 N R 16 E

TYPE MONUMENT P.K./WASHER

ON SURFACE - ~~BELOW~~ ON

OFFSET Q PAVEMENT 1.5' LT : RT

13.0' TO LT EDGE PAVEMENT


STATION: 1329+80

HORIZ.DATUM: NAD83 (2011)


GEOID: 2012A

GRID: NORTHING: 634633.565

EASTING: 1836109.668

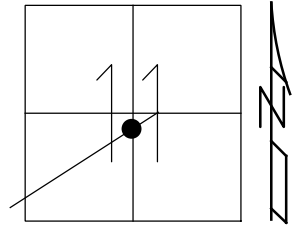

RECORD:
PREV. MONUMENTS:
PK/WASHER
STA. 89+25
FD P.K./WASHER
3/16/02, DCH
SET P.K./WASHER
6/10/02, DCH
FD P.K./WASHER
REFA39
11/22/17, JLL
SET MAG/WASHER
8-2-19, JLL
FD MAG/WASHER
2/10/22, JFO

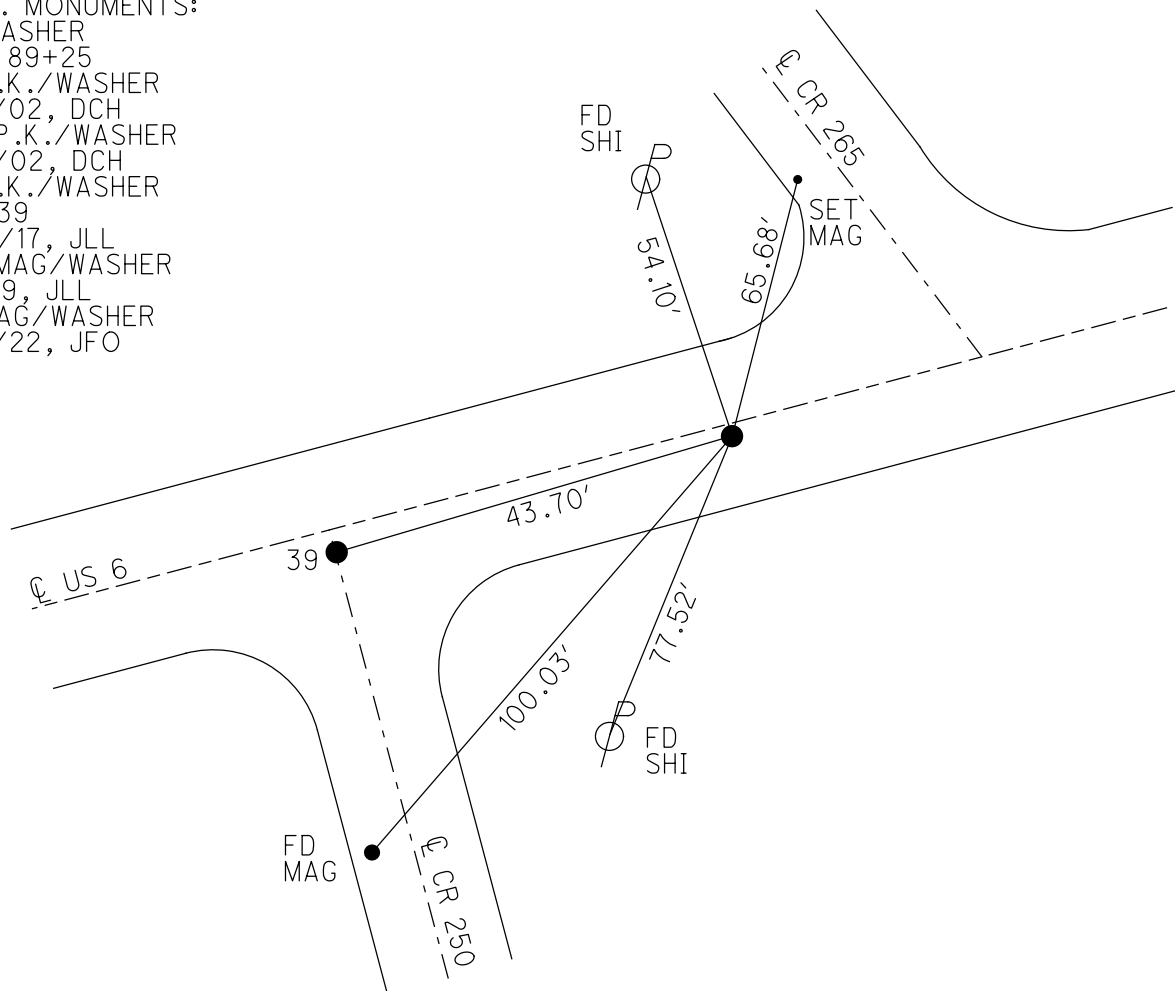

O.D.O.T. DISTRICT 2 SURVEY OFFICE (USE ONLY)

PERSONNEL

REFERENCE NO. 39 AA

SHEET 7 OF 34

NOTES LEU
H.C. LEU
R.C. TRENKA

DATE 8/1/18
WEATHER CLOUDY
TEMP. 73°

ROUTE US 6
COUNTY SANDUSKY
TOWNSHIP RILEY
SECTION 11
T 5 N R 16 E

DWG BY AUBLE PID 95769

TYPE MONUMENT P.K./WASHER

ON SURFACE - ~~BELOW~~ ON

OFFSET Q PAVEMENT 1.5' LT : RT
13.0' TO LT EDGE PAVEMENT


STATION: 1329+80

HORIZ.DATUM: NAD83 (2011)


GEOID: 2012A

GRID: NORTHING: 634633.565

EASTING: 1836109.668

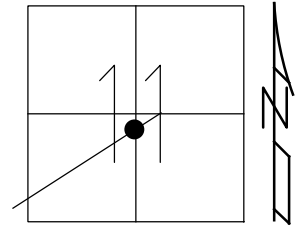


RECORD:
PREV. MONUMENTS:
PK/WASHER
STA. 89+25
FD P.K./WASHER
3/16/02, DCH
SET P.K./WASHER
6/10/02, DCH
FD P.K./WASHER
REFA39
11/22/17, JLL
SET MAG/WASHER
8-2-19, JLL

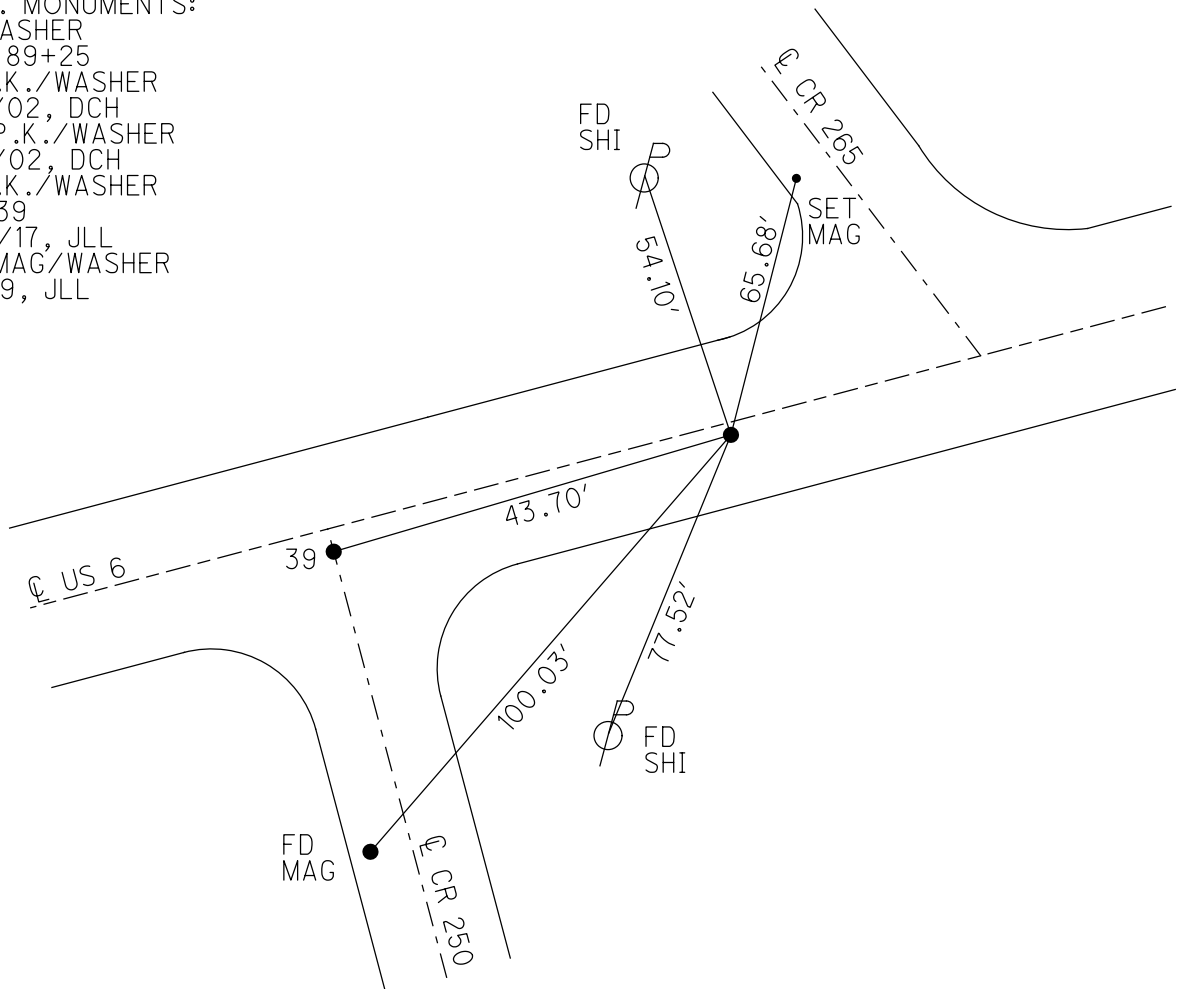


O.D.O.T. DISTRICT 2 SURVEY OFFICE (USE ONLY)

PERSONNEL _____ REFERENCE NO. 39 AA SHEET 6 OF 31
 NOTES ROUSOS DATE 03/16/02 ROUTE US 6
 H.C. VAN DUSEN WEATHER WINDY COUNTY SANDUSKY
 R.C. MOSSER TEMP. 28° TOWNSHIP RILEY
 _____ SECTION 11
 _____ T 5 N R 16 E

TYPE MONUMENT PK/WASHER
 ON SURFACE - ~~BELOW~~ ON
~~LEFT~~ - ℄ PAV'T - RIGHT 1"
13.0' TO LT EDGE PAVEMENT
 S.L.M. 1329+80
 GRID: NORTHING: - EASTING: -

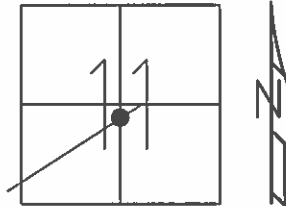

RECORD:
 PREVIOUS STATIONS & MONUMENTS:
 89+25
 PK/WASHER
 SM SPK/WASHER
 88+87
 PK/WASHER
 SM SPK/WASHER
 SET PK/WASHER
 06/10/02
 DCH

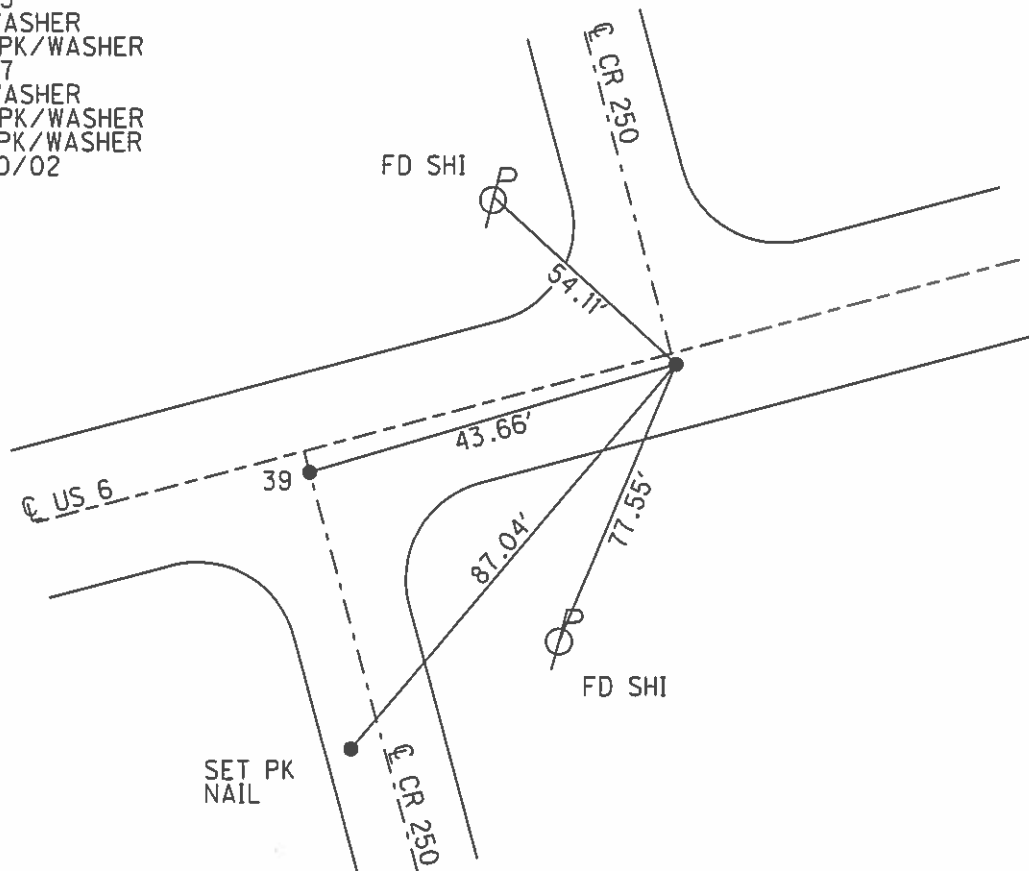

O.D.O.T. DISTRICT 2 SURVEY OFFICE

PERSONNEL

REFERENCE NO. 39


SHEET 6 OF 27

NOTES ROUSOS
H.C. VAN DUSEN
R.C. MOSSER
HOMAN

DATE 3/16/02
WEATHER WINDY
TEMP. 28°

ROUTE SR 6
COUNTY SANDUSKY
TOWNSHIP RILEY
SECTION 11
T 5 N R 16 E


TYPE MONUMENT P.K. WASHER
ON SURFACE - ~~BELOW~~ ON ON
~~LEFT~~ - Q PAV'T - RIGHT BOTH 1'
TO EDGE PAVEMENT A 12.7' TO LT EDGE
S.L.M. A 1329+37 B 1329+80 B 13.0' TO LT EDGE

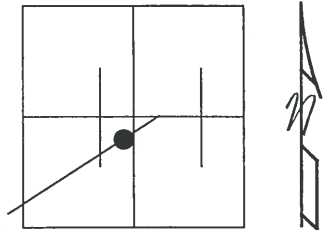

PREVIOUS STATIONS & MONUMENTS:

89+25
PK & WASHER
SM. SPK & WASHER
88+87
PK & WASHER
SM. SPK & WASHER

SET PK'S AND WASHER'S
6-10-02
DCH

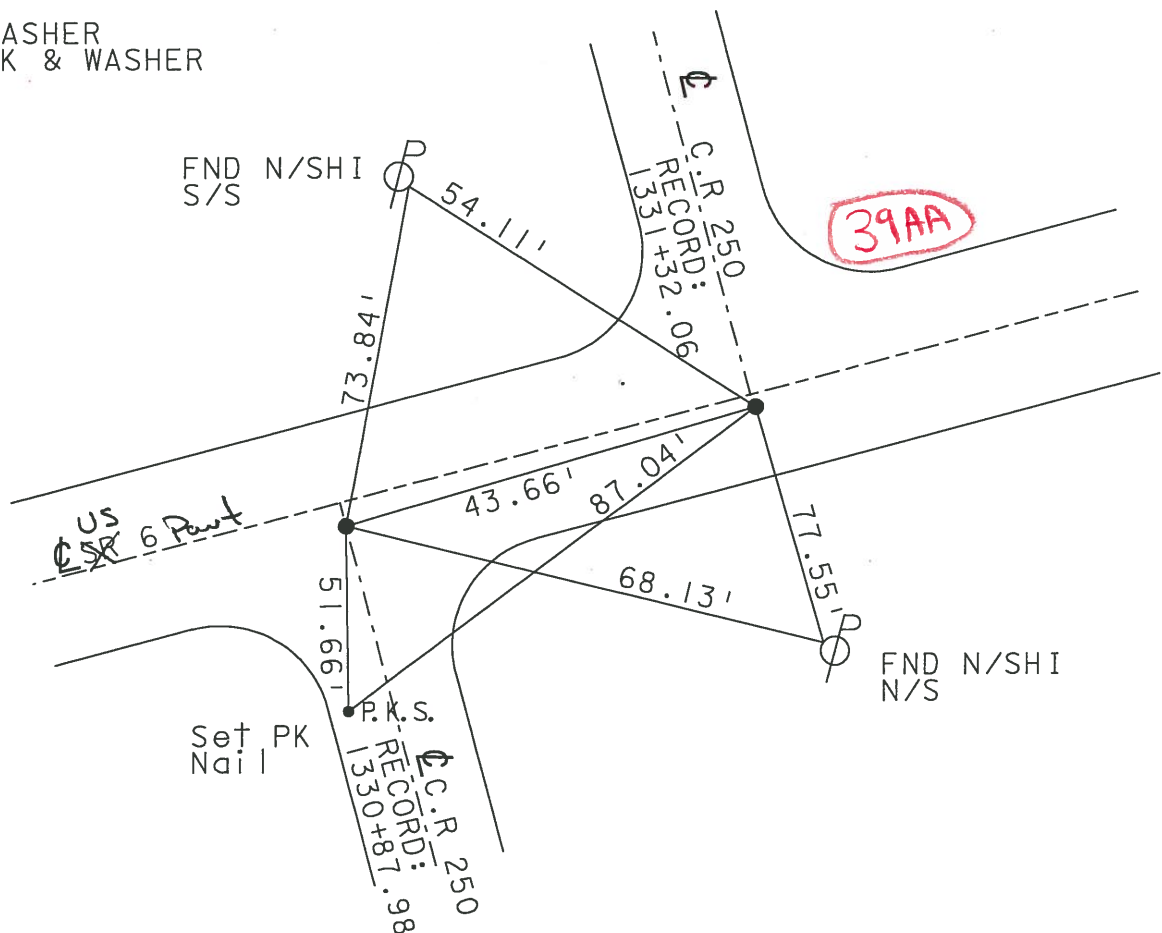

O.D.O.T. DISTRICT 2 SURVEY OFFICE

PERSONNEL

REFERENCE NO. 39

SHEET 18 OF 39

NOTES CHENEY

H.C. RIPPLE

R.C. BARBOUR

DATE 2-16-1991

WEATHER SUNNY

TEMP. 85°

ROUTE 6

COUNTY SANDUSKY

TOWNSHIP PLEY

SECTION 11

T5N R16E


TYPE MONUMENT PKs/WASHERS

ON SURFACE - BELOW

LEFT - & PAW'T. - RIGHT BOTH - 1'

TO EDGE PAVEMENT

S.L.M. 1229+37 & 1229+80

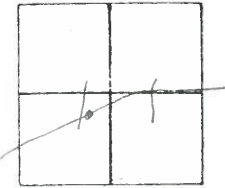

PREVIOUS STATIONS & MONUMENTS:

89+25


PK/WASHER

SM. SPK/WASHER

88+87

PK/WASHER

SM. SPK/WASHER

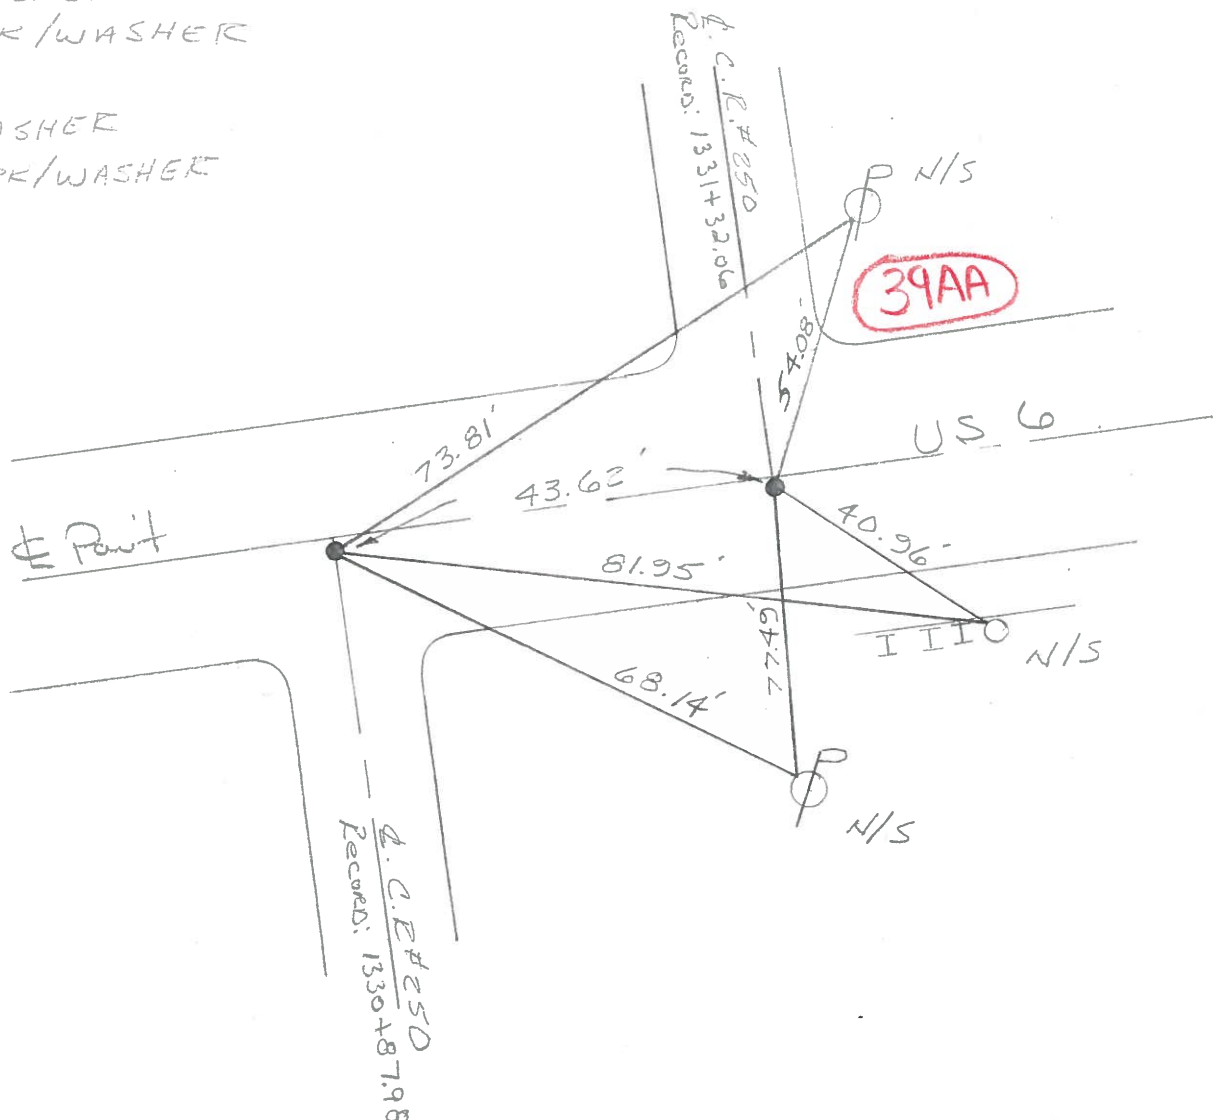

PERSONNEL	TITLE	PERSONNEL	TITLE
Cravin		Schneider	
Ash		Masser	
Cooper		Barbour	

COUNTY Sandusky DATE 7/29/75

S. R. #6 WEATHER SUNNY

SEC. I - Fremont East TEMP 75°

DESCRIPTION Ties for Control Points

JOB NO.

